	INDEX TO DRAWINGS
SHEET NO.	DESCRIPTION
	TITLE SHEET
2	STANDARD PLANS SUMMARY
3	TYPICAL SECTION
4	ROADWAY PLAN
5	DETAIL PLAN
6	PAVEMENT MARKING
	LEGENDS, DETAILS & NOTES
7	SIGNING, PAVEMENT
	MARKING, & TRAFFIC
	SIGNAL PLAN
·	•
	•
· · · · · · · · · · · · · · · · · · ·	
· ·	

STATE OF HAWAII

DEPARTMENT OF TRANSPORTATION
HIGHWAYS DIVISION
HONOLULU, HAWAII


"AS-BUILT"
PLANS FOR


HALEAKALA HIGHWAY

RIGHT TURN LANE AT PUKALANI STREET PROJECT NO. 37C-01-91

DISTRICT OF MAKAWAO

ISLAND OF MAUI

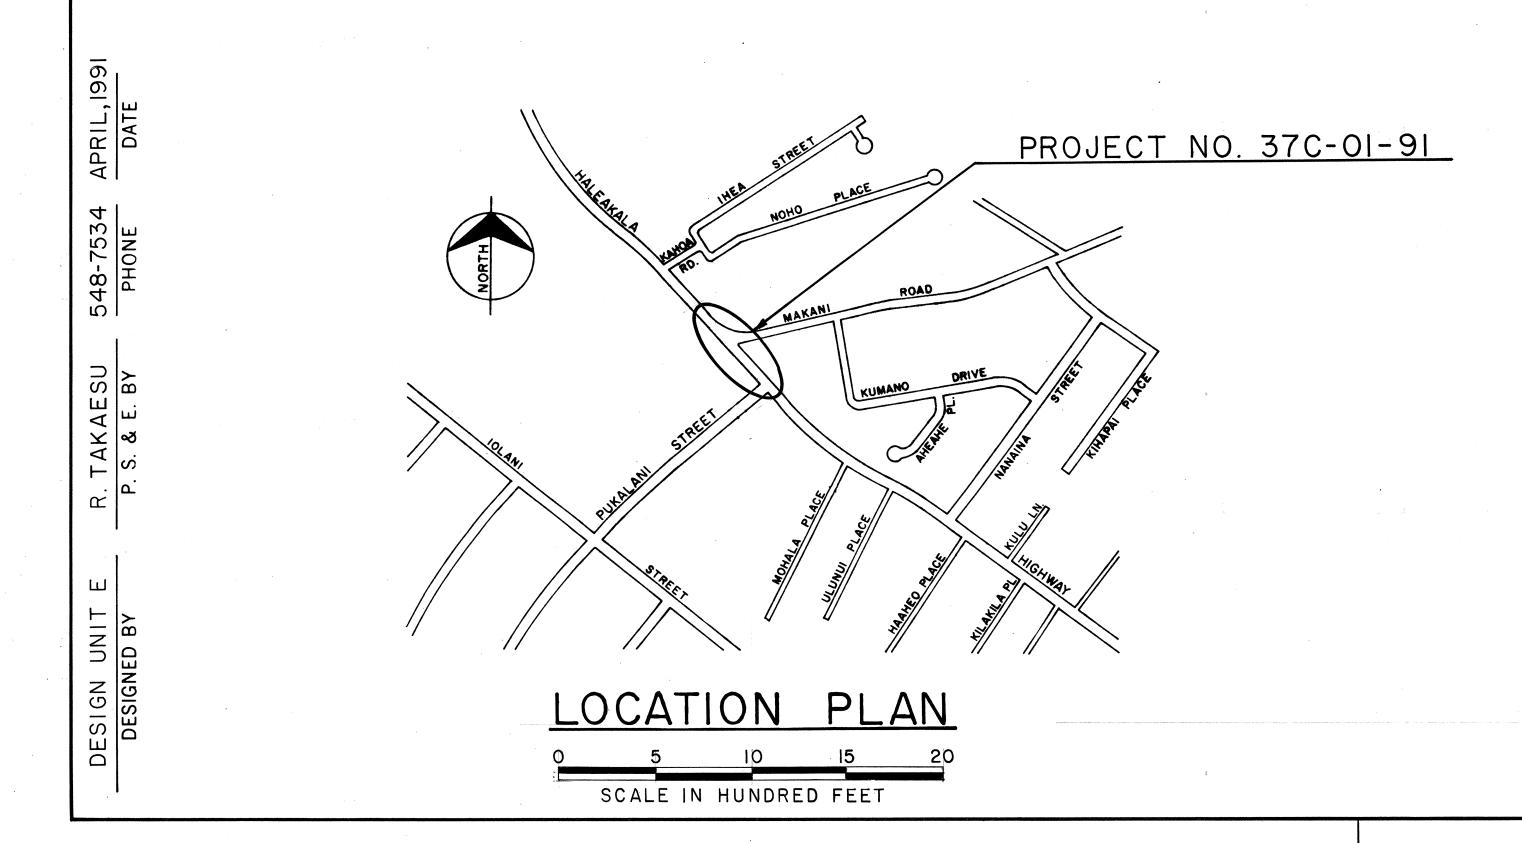

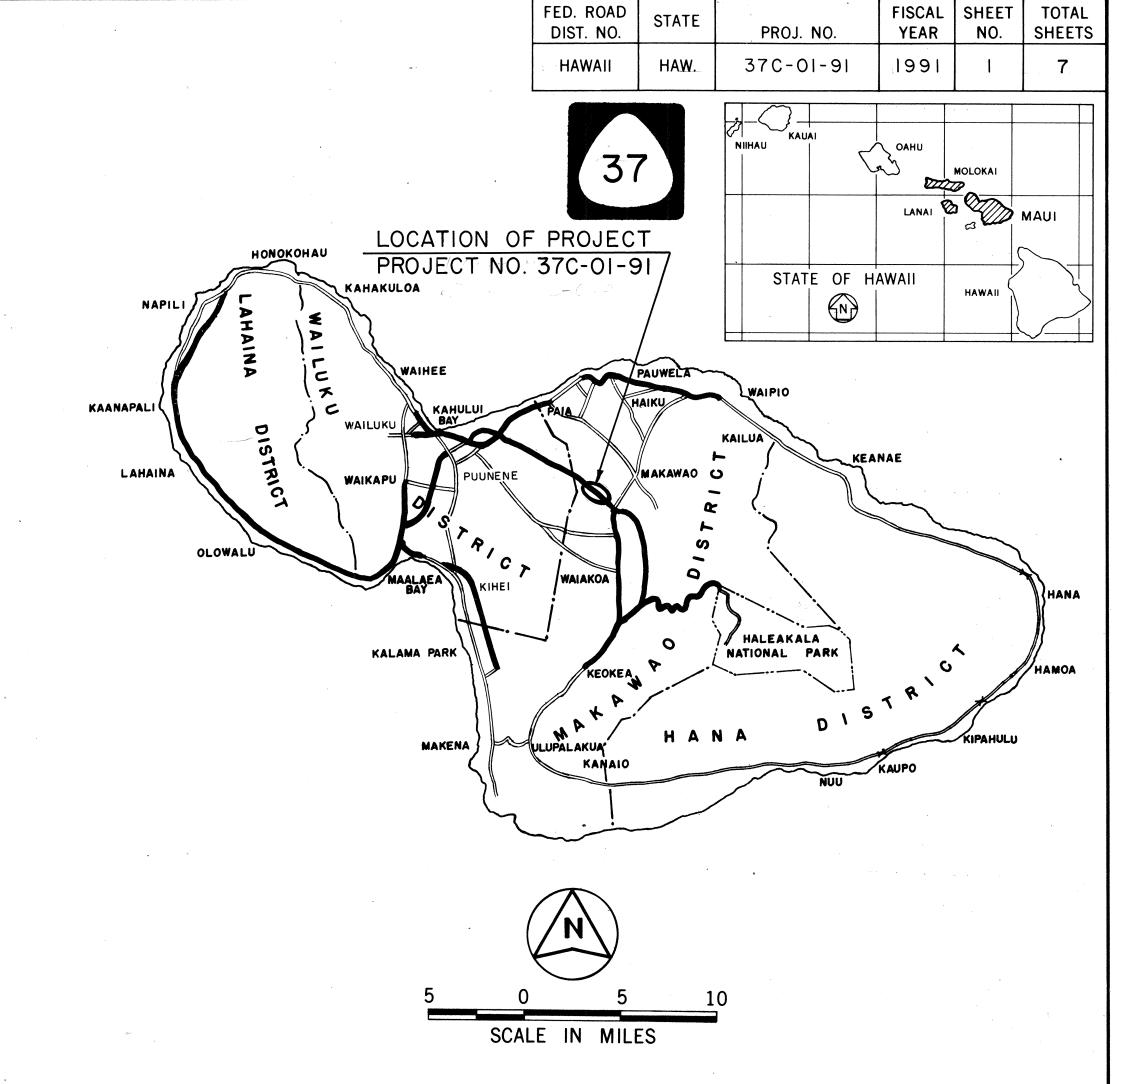

FEDERAL AID PROJECTS PREVIOUSLY CONSTRUCTE OR UNDER CONSTRUCTION

MILE POST 6.53 TO MILE POST 6.63

CHANGES MADE DURING CONSTRUCTION HAVE BEEN INCORPORATED ON THESE PLANS EXCEPT CHANGES IN THE ORIGINAL THEORETICAL QUANTITIES, FOR ACTUAL QUANTITIES, REFER TO PROJECT LEDGER AND/OR COMPUTATION BOOK.

RESIDENT ENGINEER B-29-95
DATE

DEPARTMENT OF TRANSPORTATION
STATE OF HAWAII

APPROVED:

DIR. OF TRANSPORTATION

DATE