


FED. ROAD DIST. NO.	STATE	PROJ. NO.	FISCAL YEAR	SHEET NO.	TOTAL SHEETS
HAWAII	HAW.	37C-01-91	1991	3	7


GENERAL NOTES:

- The scope of work for this project consists of constructing a right turn lane from Haleakala Highway into Pukalani Street. Improvements consist of pavement widening, constructing A.C. swale, relocating anchor and guy wire, traffic controller and signs and installing pavement markers, striping, crosswalk and stop bar.
- The Contractor's attention is directed to Subsection 107.13 - Public Convenience and Safety Section 645 - Traffic Control of the Special Provisions and Subsection 107.21 - Contractor's Responsibility for Utility Property and Services of the Standard Specifications.
- The existence and location of underground utilities and structures as shown on the plans are from the latest available data but the accuracy is not guaranteed. The encountering of other obstacles during the course of the work is possible. The Contractor shall be held liable for any damages incurred to the existing facilities and/or improvements as a result of his operations.
- The Contractor shall take all measures necessary to insure that safe and easily accessible passage is provided at all times for pedestrians who must travel in or near the construction zone. Payment shall be considered incidental to various contract items.
- The Contractor attention is directed to Subsection 108.01 Subletting of Contract of the Standard Specifications.

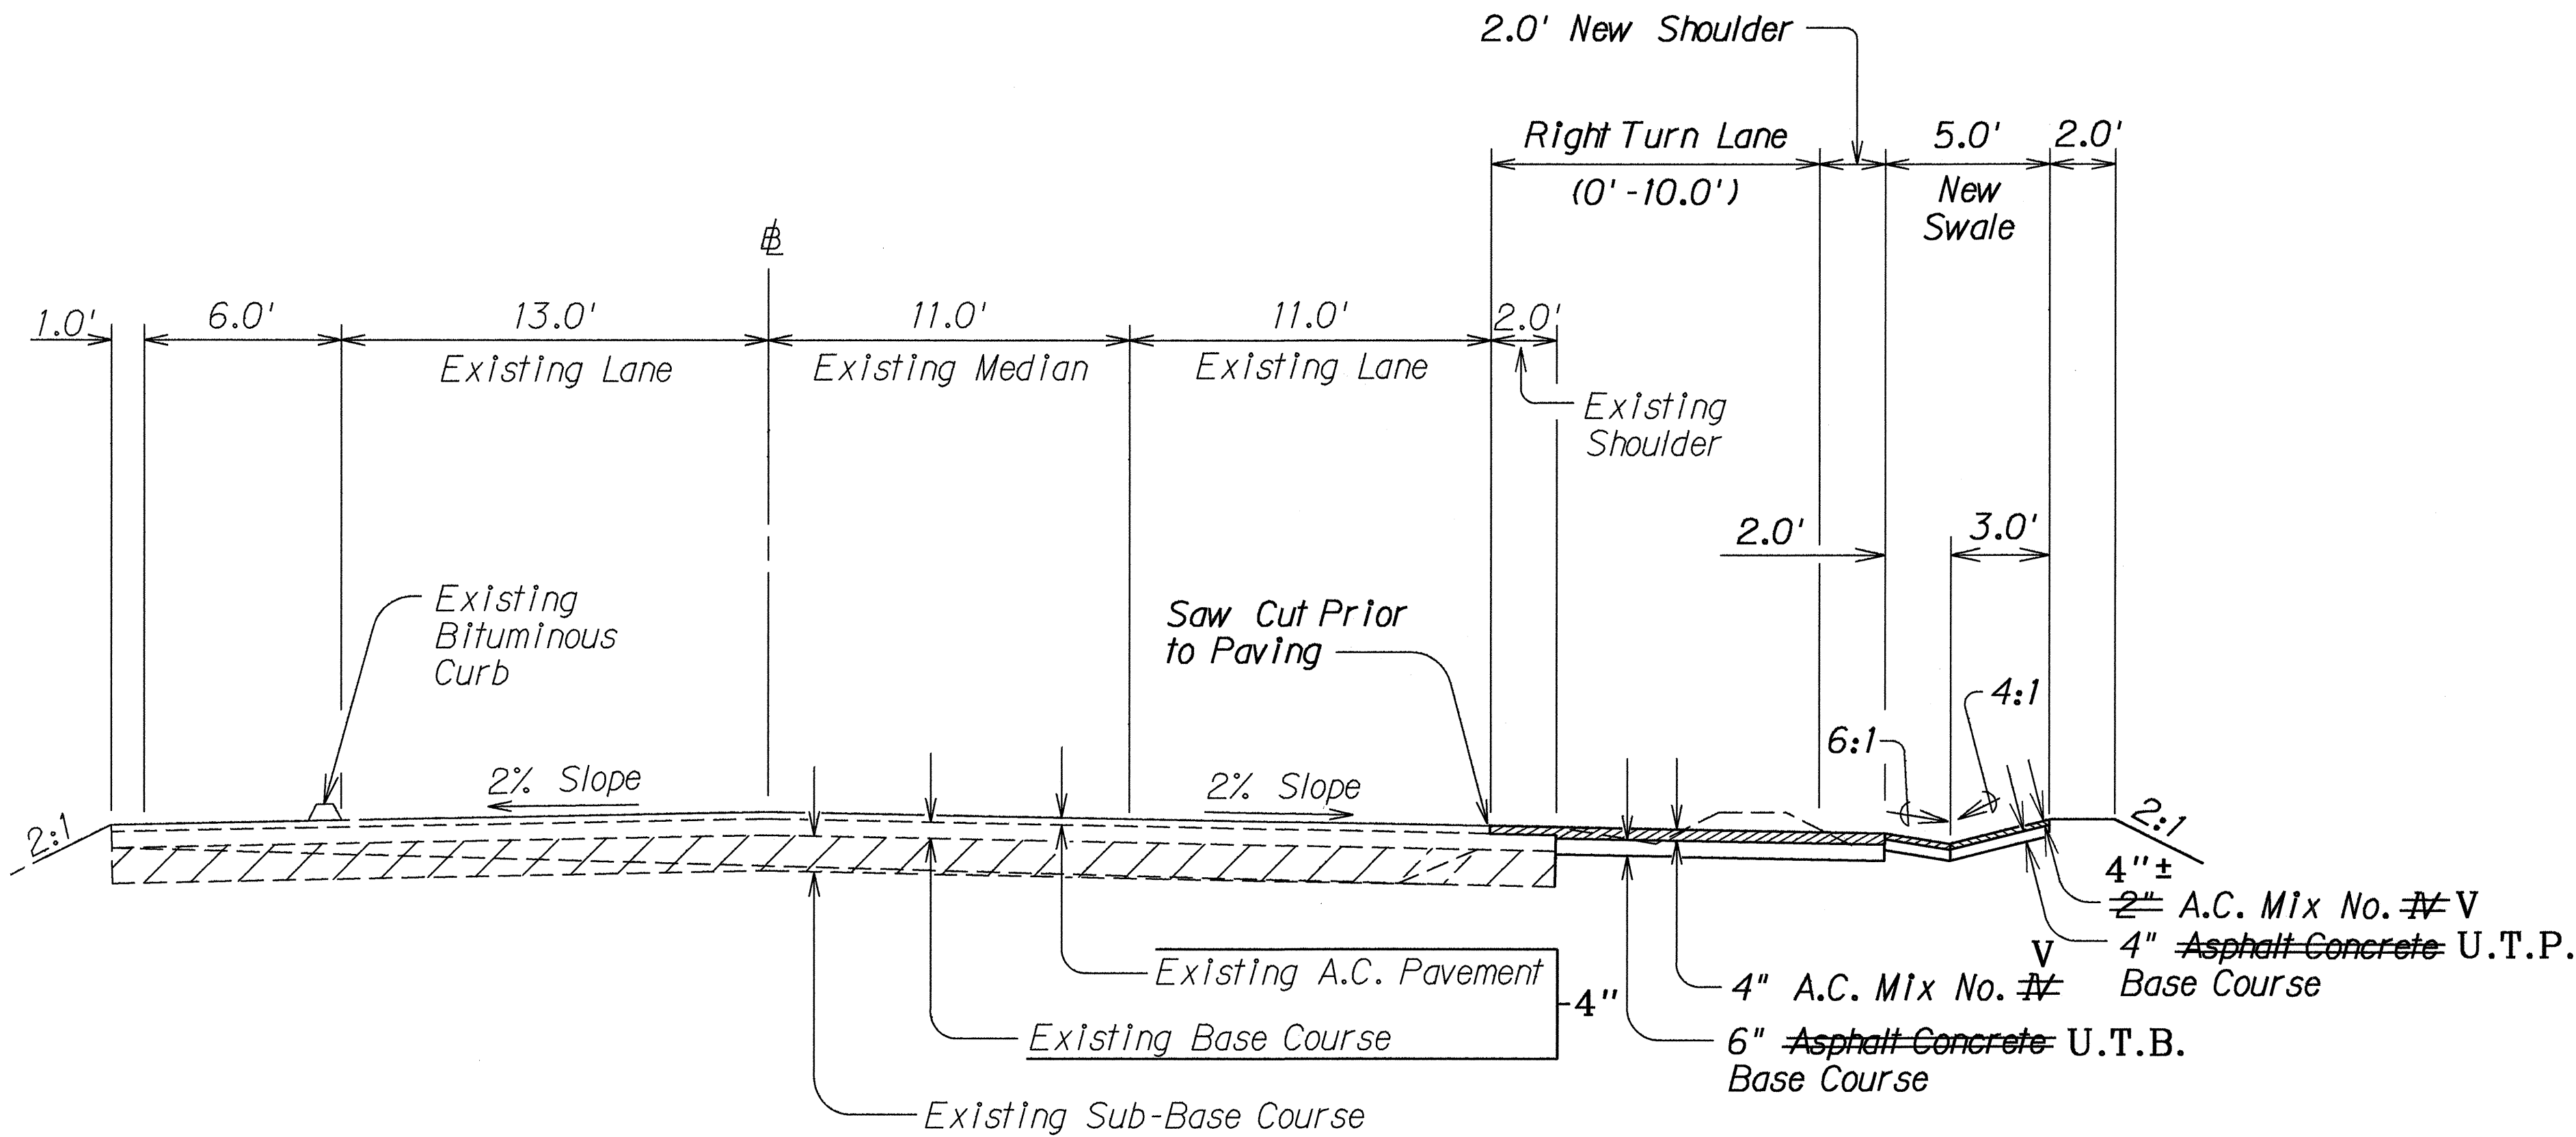

TYPICAL ROAD SECTION

Scale: 1/4" = 1' - 0"

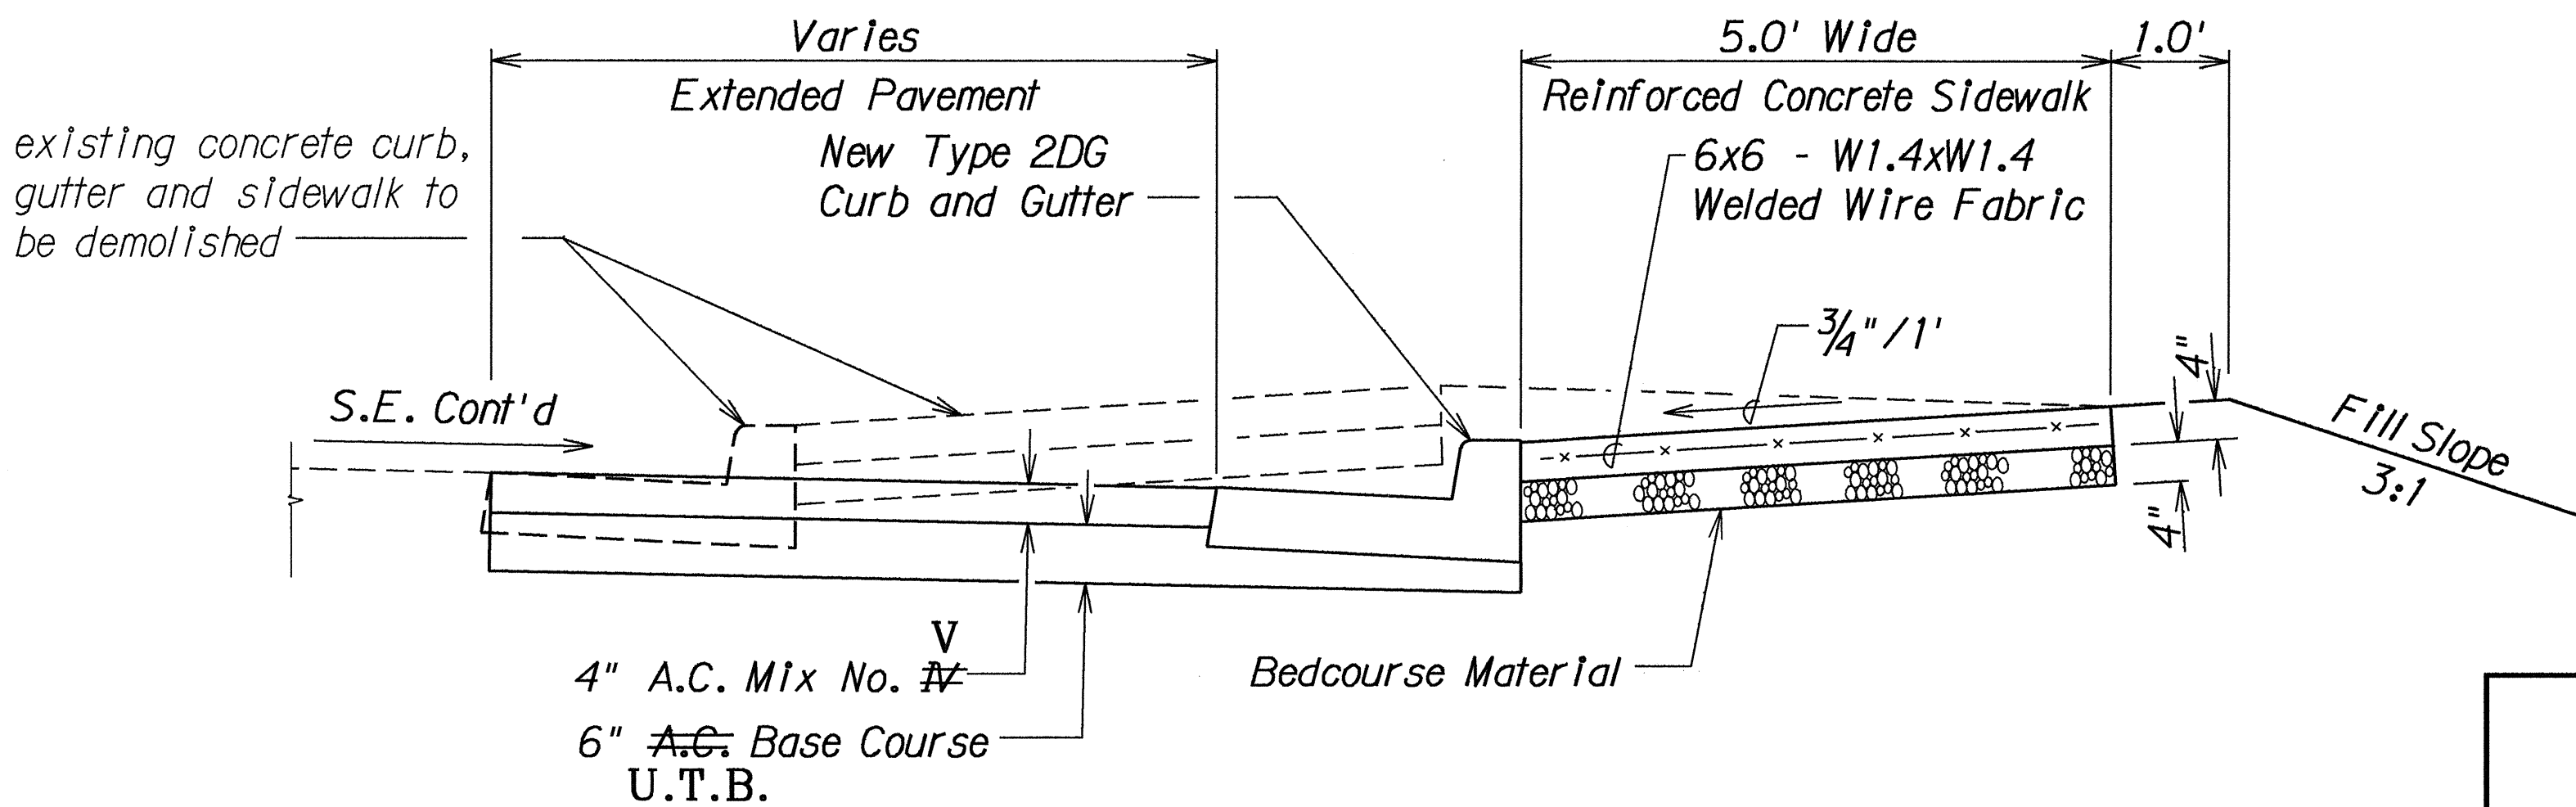

REINFORCED CONCRETE SIDEWALK DETAIL

Not to Scale

LEGEND FOR AS-BUILT POSTINGS

- Squiggly line for as-built deletion
- Double line for as-built deletion
- Text for as-built posting

STATE OF HAWAII
DEPARTMENT OF TRANSPORTATION
HIGHWAYS DIVISION

TYPICAL SECTION

HALEAKALA HIGHWAY
RIGHT TURN LANE
AT PUKALANI STREET

Project No. 37C-01-91

Scale: 1/4" = 1' - 0"

Date: July, 1991

SHEET No. 1 OF 1 SHEETS