7'	INDEX TO DRAWINGS		
SHEET NO.	DESCRIPTION		
	TITLE SHEET		
2			
3-4			
5-18			
19-20 SUPERELEVATION DIAGRAM			
21-22 BORING LOG			
23	ACCESS TO TANK SITE		
24	ACCESS TO FEED SITE		
¥ 25−39	DRAINAGE PLANS & DETAIL		
40-43	INLET DETAILS FOR 54"CULVERT		
44-55	SIGNING & MARKING PLAN		
56-66	CROSS SECTIONS		

*C.O.39S-I IS A SUPPLEMENT PLAN SHEET TO CONTRACT PLANS. NEW TOTAL = 67 STATE OF HAWAII


DEPARTMENT OF TRANSPORTATION


HIGHWAYS DIVISION HONOLULU, HAWAII

"AS-BUILT"
PLANS FOR

HALEAKALA HIGHWAY

PUKALANI SECTION - PHASE II
HAMAKUA DITCH TO KULA JUNCTION
PROJECT NO. 37C-01-92

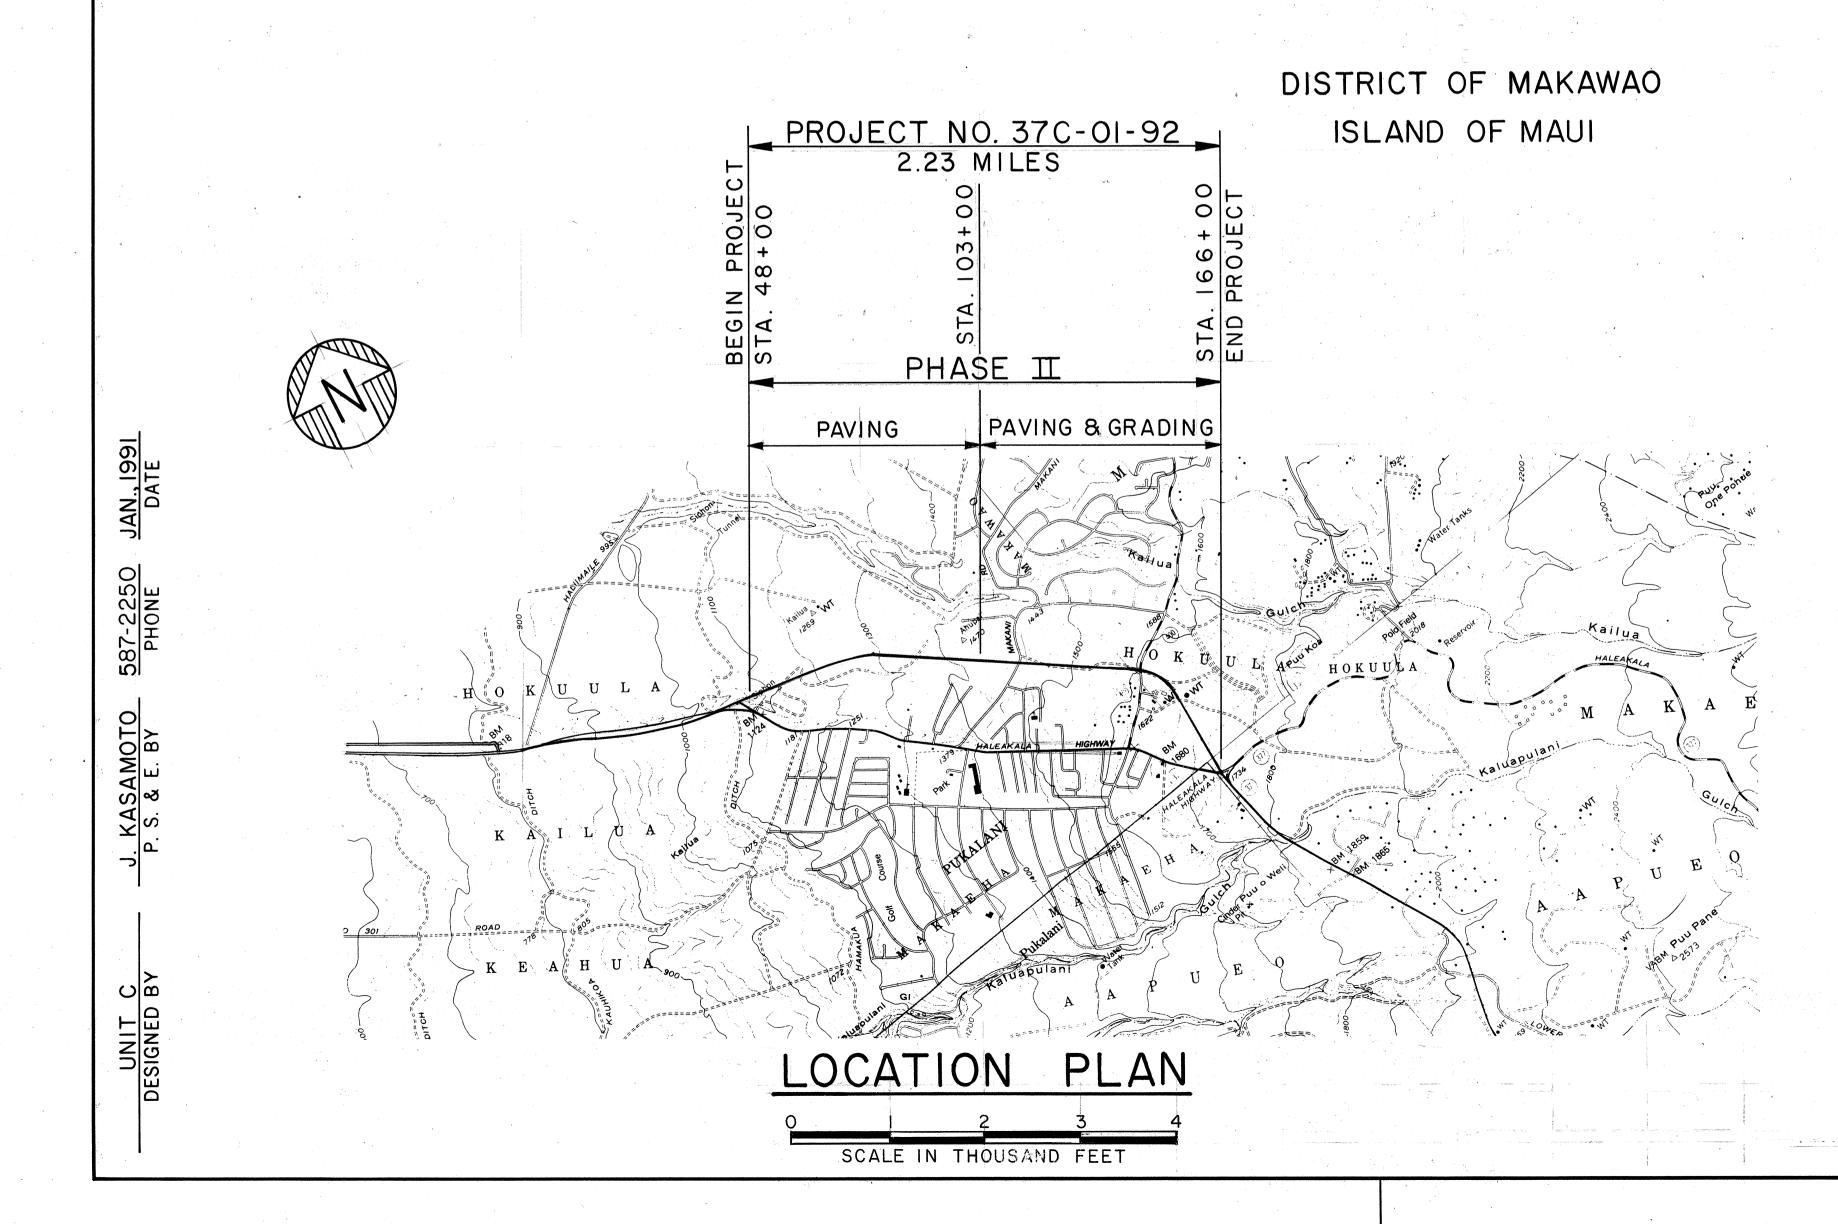

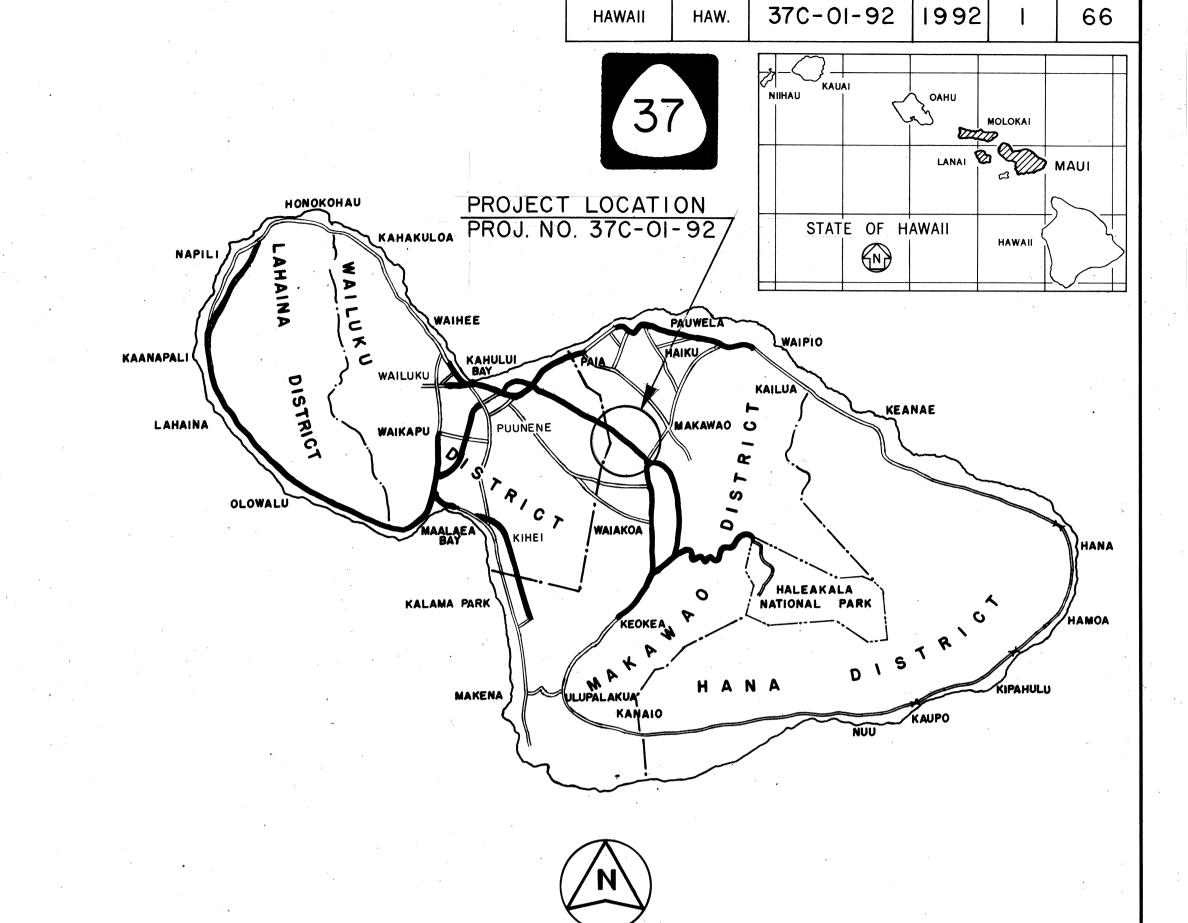

FED. ROAD DIST. NO.

STATE

FEDERAL AID PROJECTS PREVIOUSLY CONSTRUCTED OR UNDER CONSTRUCTION

MILE POST <u>5.66</u> TO MILE POST <u>7.89</u>

SCALE IN MILES

CHANGES MADE DURING CONSTRUCTION HAVE
BEEN INCORPORATED ON THESE PLANS EXCEPT
CHANGES IN THE ORIGINAL THEORETICAL
QUANTITIES. FOR ACTUAL QUANTITIES, REFER TO
PROJECT LEDGER AND/OR COMPUTATION BOOK.

RESIDENT ENGINEER

3/22/99 DATE

APPROVED: FOR WORK IN COUNTY RIGHT OF WAY

SINGLE TO BETTE DEPARTMENT OF WATER SUPPLY
COUNTY OF MAUI

APPROVED: FOR WORK IN COUNTY	RIGHT OF W
George N Kaya	10/28/9
DIRECTOR DEPARTMENT OF PUBLIC WORKS COUNTY OF MAUI	DATE

	,
DEPARTMENT OF TRANSPOR	RTATION
STATE OF HAWAII	
APPROVED:	* * * * * * * * * * * * * * * * * * *
A Pana	11/8/91
DIR. OF TRANSPORTATION	DATE

FISCAL SHEET TOTAL YEAR NO. SHEETS