	INDEX TO DRAWINGS
SHEET NO.	DESCRIPTION
1	TITLE SHEET
2	STANDARD PLANS SUMMARY
3 – 4	PAVEMENT MARKING PLANS
5 – 6	TRAFFIC SIGNAL PLANS
7	LOOP DETECTOR DETAILS
8	SWING SIGN BRACKET DETAIL

4

STATE OF HAWAII

DEPARTMENT OF TRANSPORTATION

HIGHWAYS DIVISION
HONOLULU, HAWAII

"AS-BUILT"


PLANS FOR

HALEAKALA HIGHWAY (PUKALANI BY-PASS) TRAFFIC SIGNALS AT MAKAWAO AVENUE PROJECT NO. 37B-02-94

DISTRICT OF MAKAWAO
ISLAND OF MAUI

PROJECT LOCATION

PUKALANI C.C. GOLF COURSE

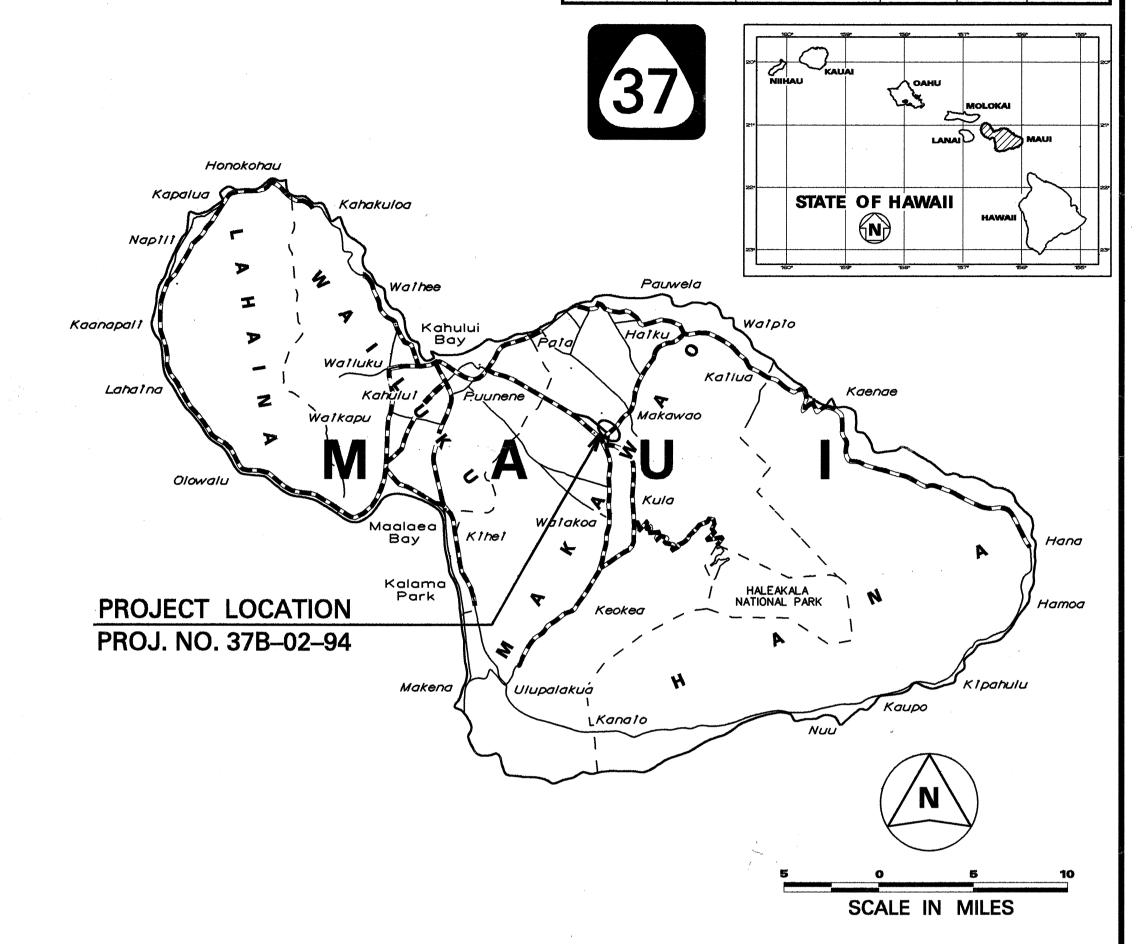

----- FEDERAL AID PROJECTS PREVIOUSLY CONSTRUCTED
OR UNDER CONSTRUCTION

37B-02-94

MILE POST 7.09 TO MILE POST 7.20

CHANGES MADE DURING CONSTRUCTION HAVE BEEN INCORPORATED ON THESE PLANS EXCEPT CHANGES IN THE ORIGINAL THEORETICAL QUANTITIES. FOR ACTUAL QUANTITIES, REFER TO PROJECT LEDGER AND/OR COMPUTATION BOOK.

RESIDENT ENGINEER

6/24/96 DATE

LAYOUT PLAN

o 1 2

SCALE IN THOUSAND FEET

HALEAKALA HIGHWAY

HALEAKALA

(PUKALANI BY-PASS)

PUKALANI

DEPARTMENT OF TRANSPORTATION STATE OF HAWAII

APPROVED:

DIR. OF TRANSPORTATION DATE

pttsht.dgn

1