


LEGEND FOR AS-BUILT POSTINGS	
	Squiggly line for as-built deletion
	Double line for as-built deletion
Roadway	Text for as-built posting

TRAFFIC SIGNAL SYSTEM CONDUIT AND CABLE SCHEDULE												
	DELTA ITEM NO. (Δ)											
	1	2	3	4	5	6	7	8	9	10	11	12
QUANTITY OF 2" C, SEE NOTE NO. 1	1	1	1	1	2	2	3	2	6	2	1	7
QUANTITY OF 26/C #14 CONTROL CABLE					1	1	1	1	2			2
QUANTITY OF 2/C #14 SHIELDED LOOP DETECTOR, FLASHER AND PEDESTRIAN PB CABLE	1	2	4	1	3	1	7	6	14	1		14
QUANTITY OF 3/C #6										1	1	1

NOTE: 1. ALL CONDUITS SHALL BE SCHEDULE 80 PVC, UNLESS OTHERWISE NOTED.
* EXISTING CONDUITS

FED. ROAD DIST. NO.	STATE	PROJ. NO.	FISCAL YEAR	SHEET NO.	TOTAL SHEETS
HAWAII	HAW.	37B-02-94	1995	6	8

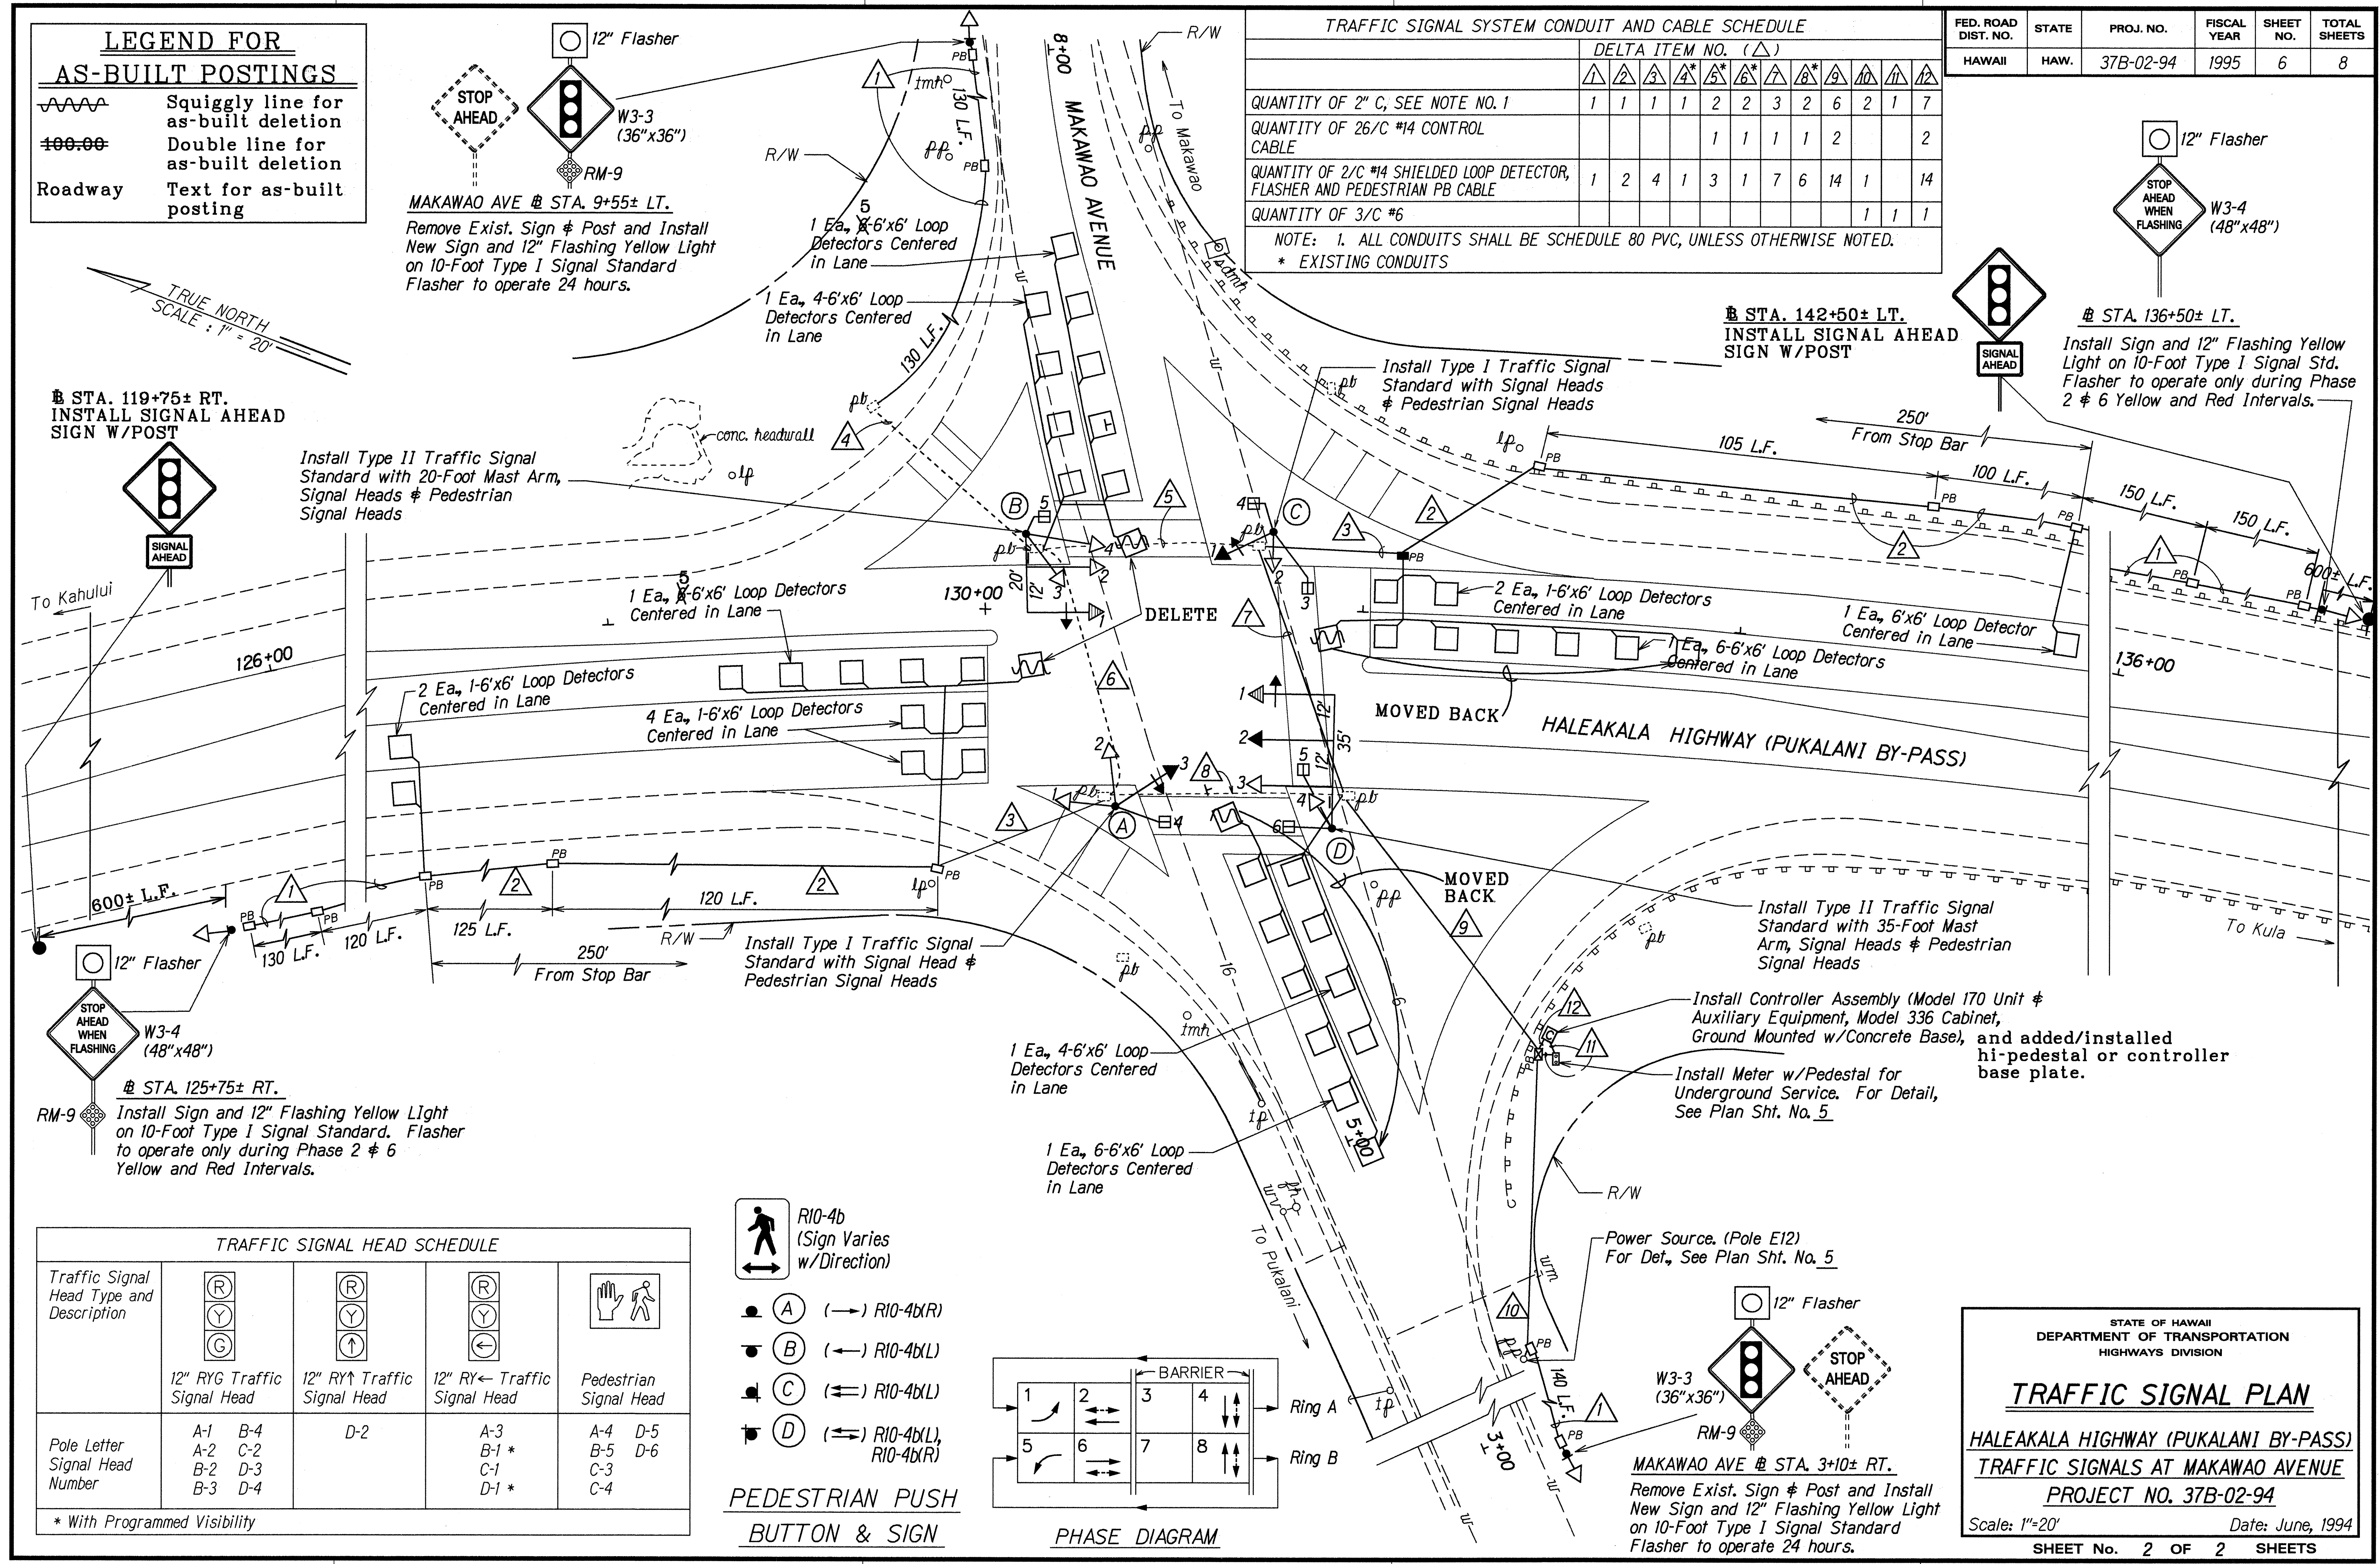


TRAFFIC SIGNAL HEAD SCHEDULE					
Traffic Signal Head Type and Description					
	12" RYG Traffic Signal Head	12" RY Traffic Signal Head	12" RY Traffic Signal Head	Pedestrian Signal Head	
Pole Letter	A-1	D-2	A-3	A-4	D-5
Signal Head	B-2		B-1 *	B-5	D-6
Number	C-2		C-1	C-3	
	B-3		D-1 *	C-4	

* With Programmed Visibility

R10-4b (Sign Varies w/Direction)

A (→) R10-4b(R)
 B (←) R10-4b(L)
 C (↔) R10-4b(L)
 D (↔) R10-4b(L), R10-4b(R)

PEDESTRIAN PUSH BUTTON & SIGN

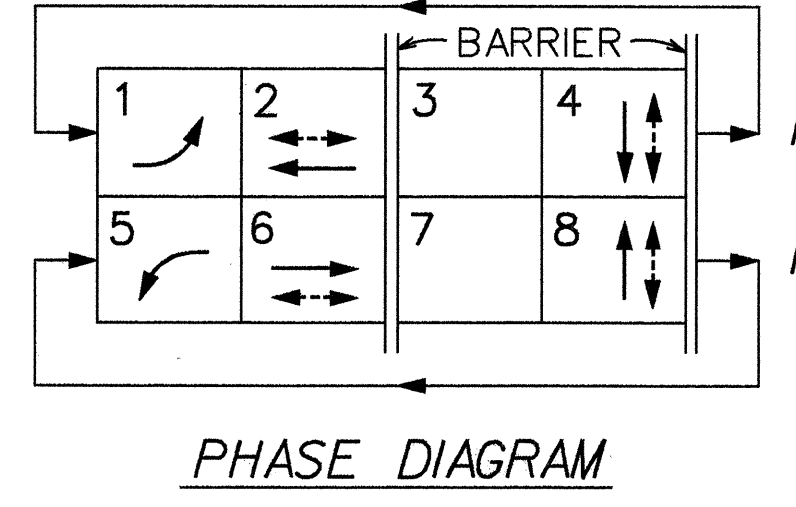

STATE OF HAWAII
DEPARTMENT OF TRANSPORTATION
HIGHWAYS DIVISION

TRAFFIC SIGNAL PLAN

HALEAKALA HIGHWAY (PUKALANI BY-PASS)
TRAFFIC SIGNALS AT MAKAWAO AVENUE
PROJECT NO. 37B-02-94

Scale: 1"=20' Date: June, 1994

SHEET No. 2 OF 2 SHEETS

DATE: 7/94
 SURVEY PLANNED BY: [blank]
 DRAWN BY: [blank]
 NOTED BY: [blank]
 DESIGNED BY: [blank]
 QUANTITIES BY: [blank]
 CHECKED BY: [blank]