4.	
	INDEX TO DRAWINGS
SHEET NO.	DESCRIPTION
ı	TITLE SHEET
2	STANDARD PLANS SUMMARY
3	LEGEND AND NOTES
4	TRAFFIC SIGNAL PLAN
5	TRAFFIC SIGNAL DETAILS
	(A.Y.
•	
	,
	,

STATE OF HAWAII

OF TRANSPORTATION DEPARTMENT HIGHWAYS DIVISION HONOLULU, HAWAII


"AS BUILT"

PLANS FOR

HALEAKALA HIGHWAY TRAFFIC SIGNALS AT NORTH FIREBREAK ROAD

PROJECT NO. 37B-01-94

DISTRICT OF WAILUKU ISLAND OF MAUI

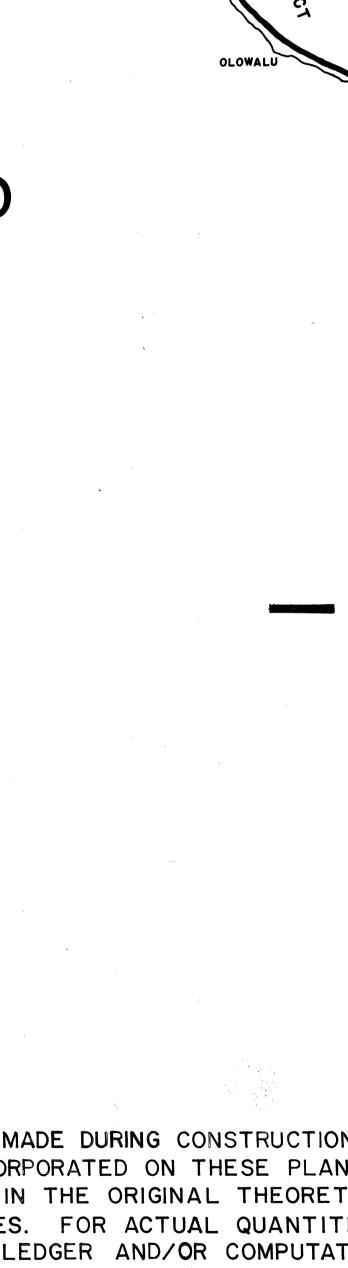

LOCATION OF PROJECT STATE OF HAWAII

FED. ROAD DIST. NO.

FEDERAL AID PROJECTS PREVIOUSLY CONSTRUCTED OR UNDER CONSTRUCTION

MILE POST _ 0.61 TO MILE POST _ 0.79

PROJECT LOCATION KAHULUI BAY **587-2174** PHONE LAYOUT PLAN SCALE IN MILES

CHANGES MADE DURING CONSTRUCTION HAVE BEEN INCORPORATED ON THESE PLANS EXCEPT CHANGES IN THE ORIGINAL THEORETICAL QUANTITIES. FOR ACTUAL QUANTITIES, REFER TO PROJECT LEDGER AND/OR COMPUTATION BOOK.

11-8-95 DATE

DEPARTMENT OF TRANSPORTATION STATE OF HAWAII APPROVED: FORDIR. OF TRANSPORTATION

FISCAL SHEET TOTAL YEAR NO. SHEETS

1995

PROJ. NO.

37B-01-94