	INDEX TO DRAWINGS
SHEET NO.	DESCRIPTION
1	TITLE SHEET
2	STANDARD PLANS SUMMARY
. 3	GENERAL NOTES
4 – 5	TYPICAL SECTIONS AND DETAILS
6 – 17	ROADWAY PLAN
18	DRAINAGE DETAILS
19	GUARDRAIL DETAILS
20	PAVEMENT MARKING LEGEND, DETAILS
	& NOTES
21	TRAFFIC SIGN SUMMARY
22 – 23	MISCELLANEOUS SUMMARIES
24	SIGN PANEL LAYOUT & NOTES
25 – 35	SIGN & PAVEMENT MARKING PLAN

STATE OF HAWAII


DEPARTMENT OF TRANSPORTATION


HIGHWAYS DIVISION
HONOLULU, HAWAII
"AS-BUILT"
PLANS FOR

KULA HIGHWAY RESURFACING KULA JUNCTION TOWARDS LOWER KULA ROAD

AND KEKAULIKE AVENUE TO KULA SANATORIUM FED. AID PROJECT NO. STP-037-1(18)

DISTRICT OF MAKAWAO
ISLAND OF MAUI

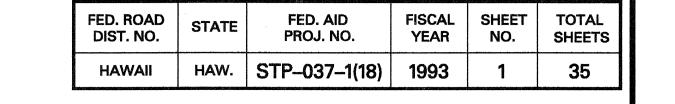


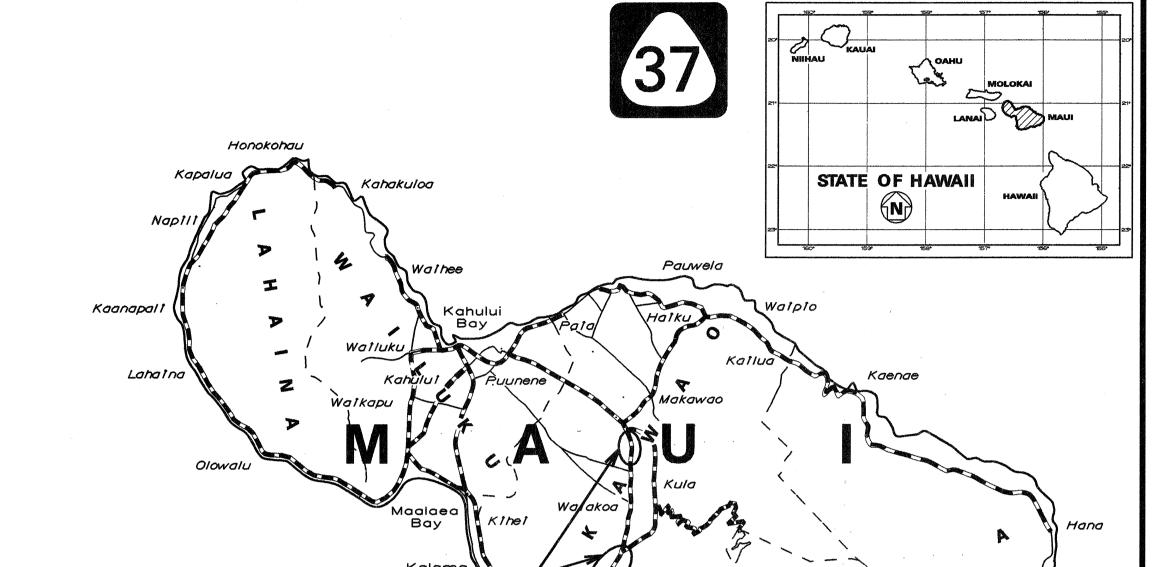

CHANGES MADE DURING CONSTRUCTION HAVE BEEN INCORPORATED ON THESE PLANS EXCEPT CHANGES IN THE ORIGINAL THEORETICAL QUANTITIES. FOR ACTUAL QUANTITIES, REFER TO PROJECT LEDGER AND/OR COMPUTATION BOOK.


PROJECT LOCATIONS

FED. AID PROJ. NO. STP-037-1(18)

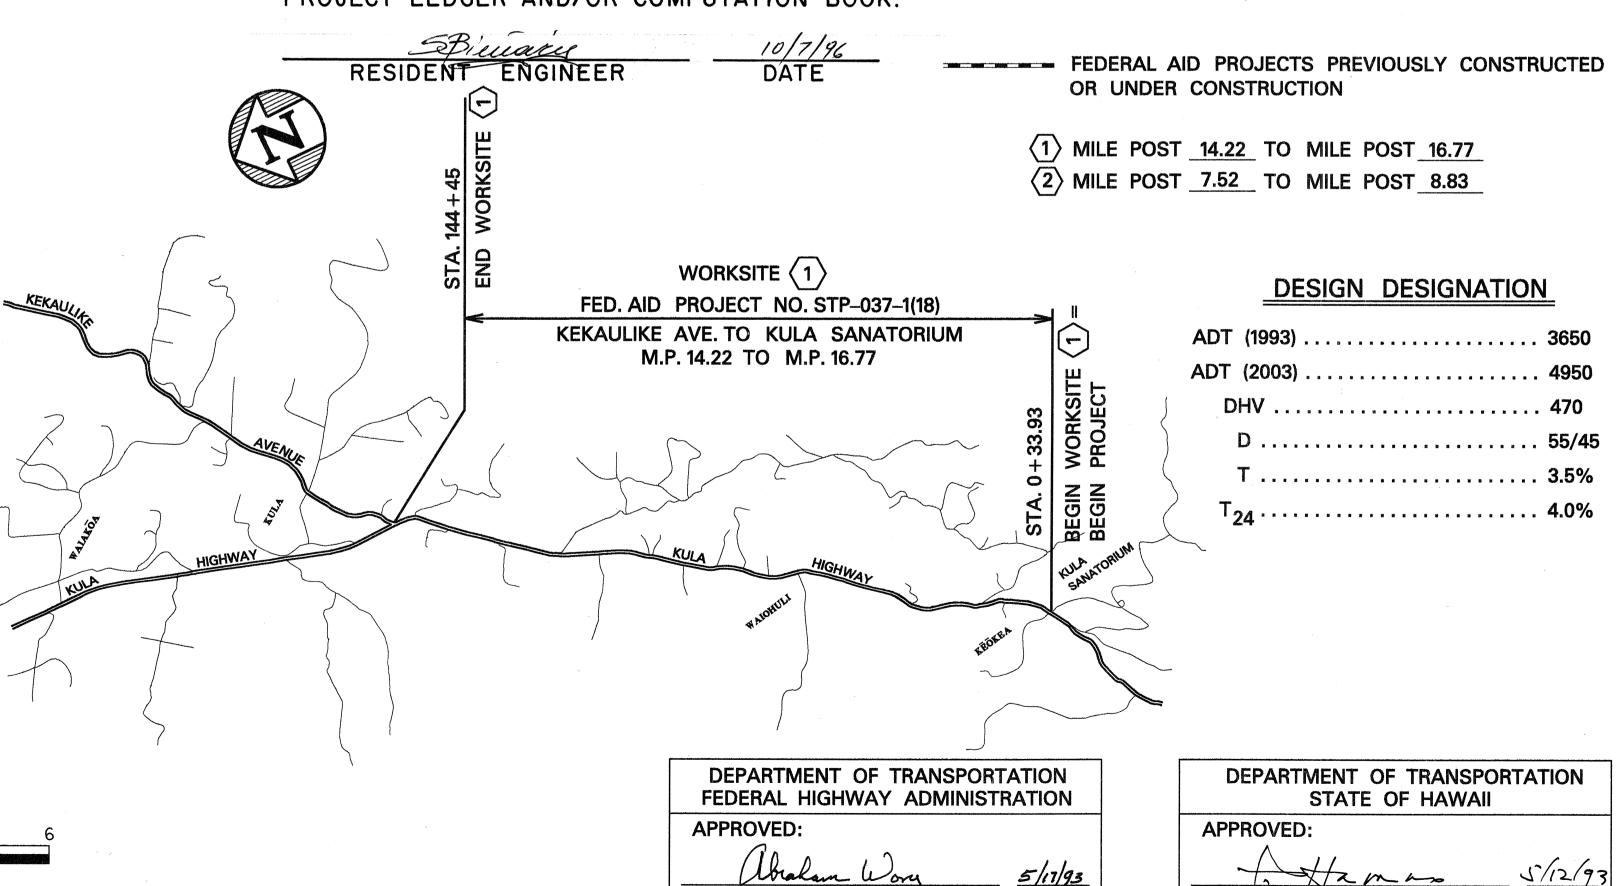

for DIVISION ADMINISTRATOR

DATE

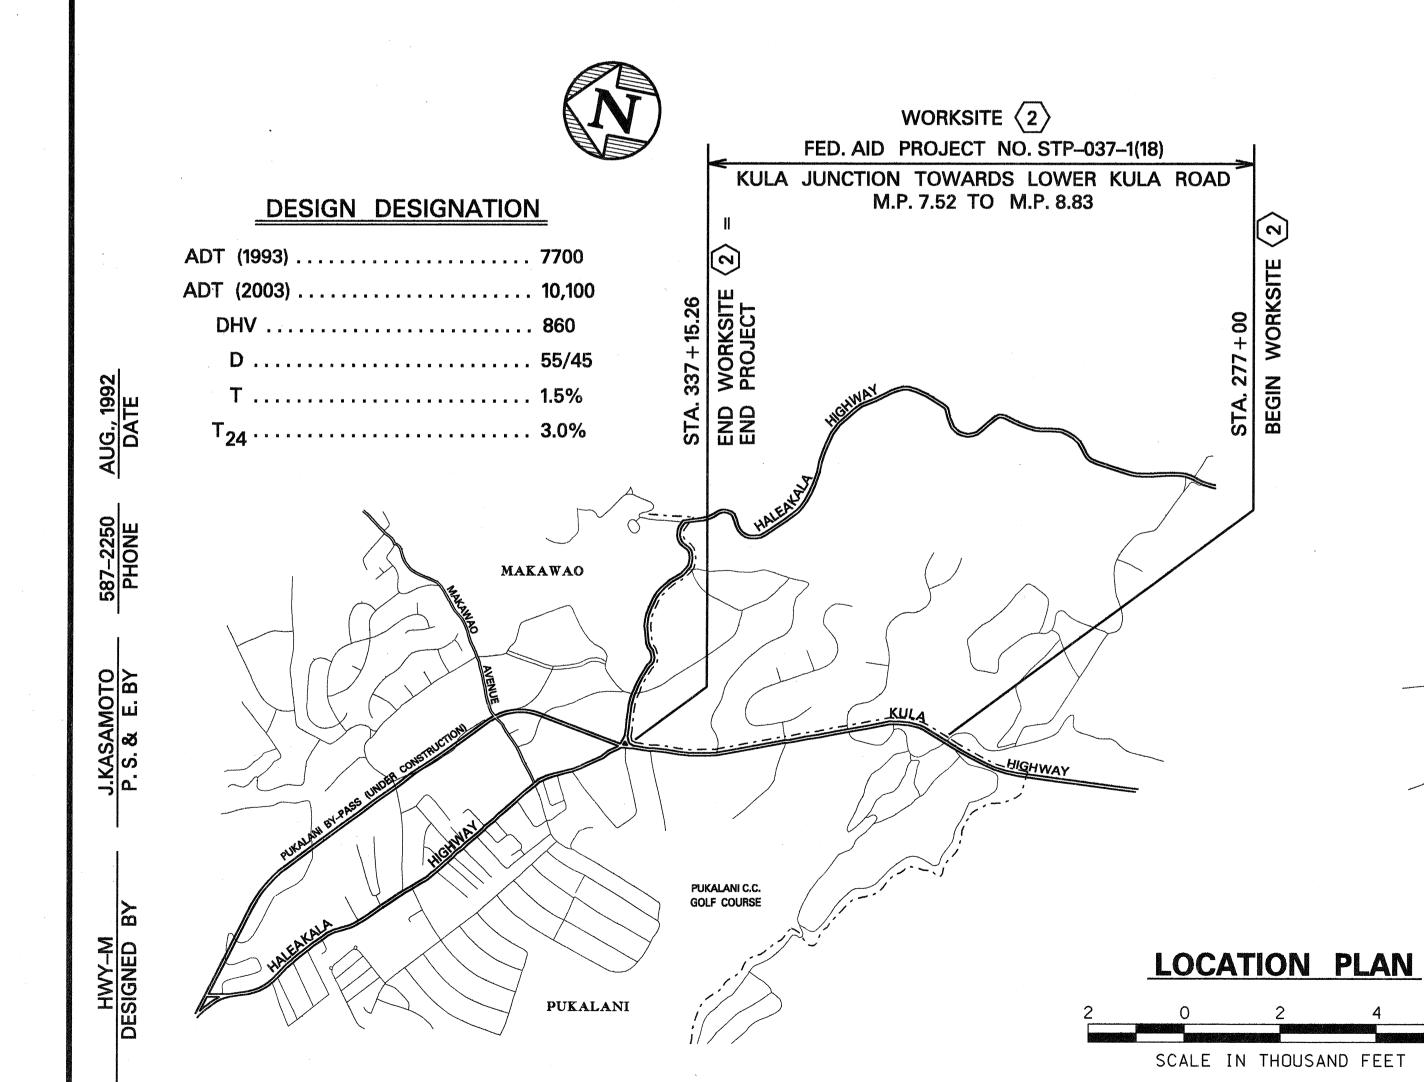

How DIR. OF TRANSPORTATION

DATÉ