



FED. ROAD DIST. NO.	STATE	PROJ. NO.	FISCAL YEAR	SHEET NO.	TOTAL SHEETS
HAWAII	HAW.	37E-01-93M	1993	4	26

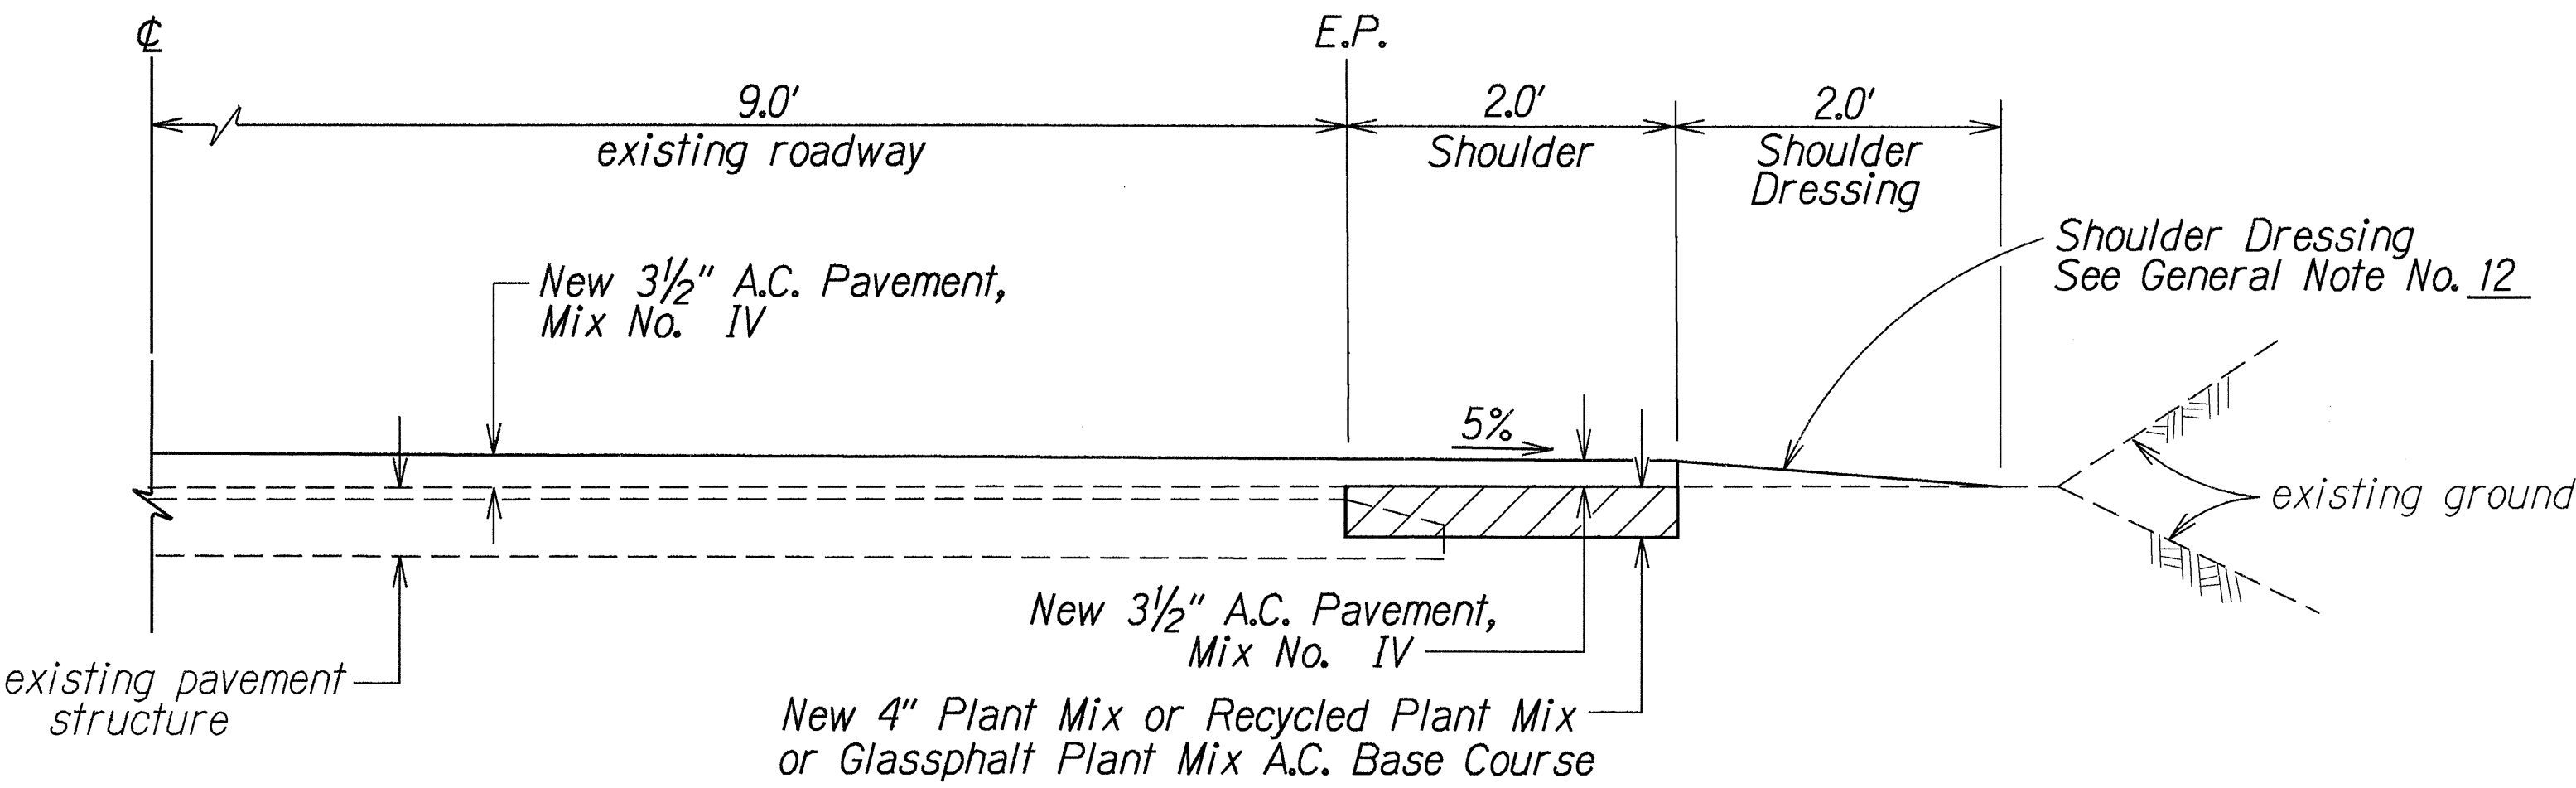


NOTE:
 The entire project roadway shall be resurfaced with 3 1/2" of A.C. Pavement, Mix No. IV. The A.C. Pavement, Mix No. IV shall be applied in two lifts. The first lift (leveling course) should be 1 1/2" followed by 2".


TYPICAL ROADWAY AND SHOULDER SECTION
 Not To Scale

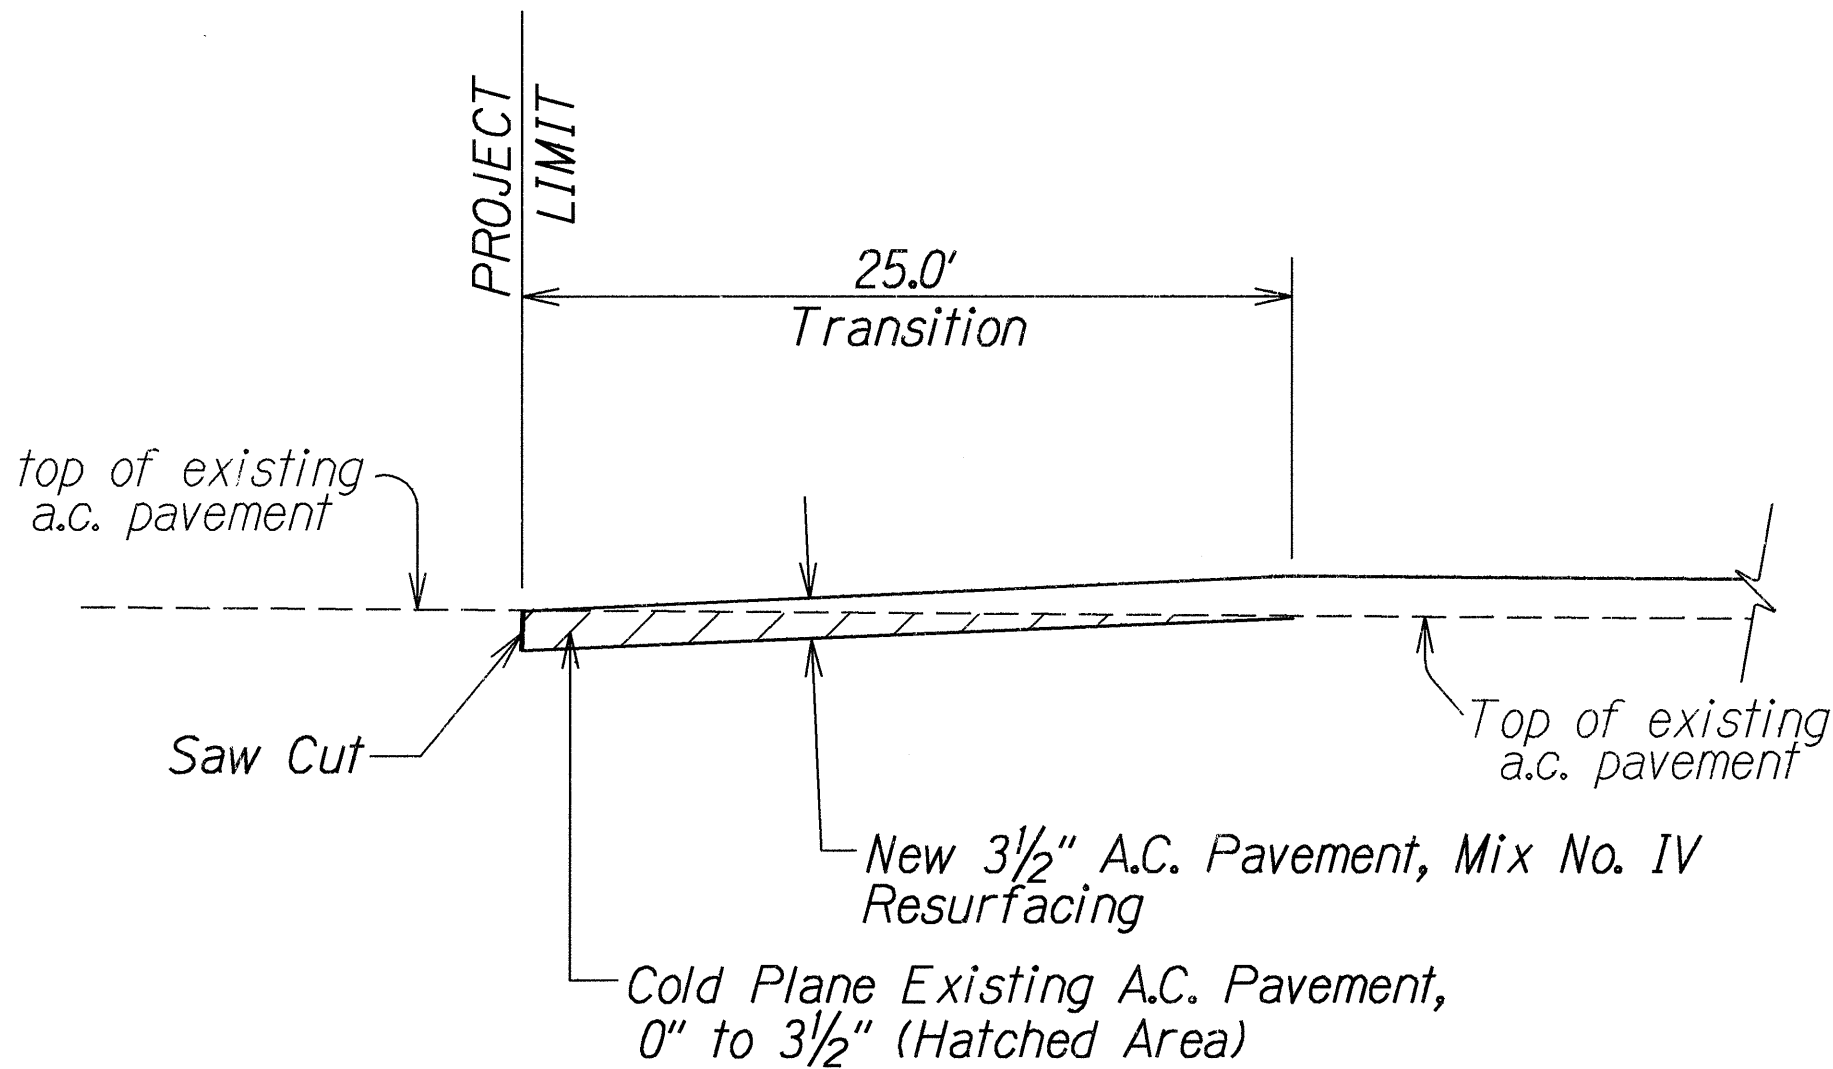


COLD PLANED TRANSITION TO EXISTING A.C. PAVEMENT DETAIL
BEGIN AND END OF PROJECT
 Not To Scale

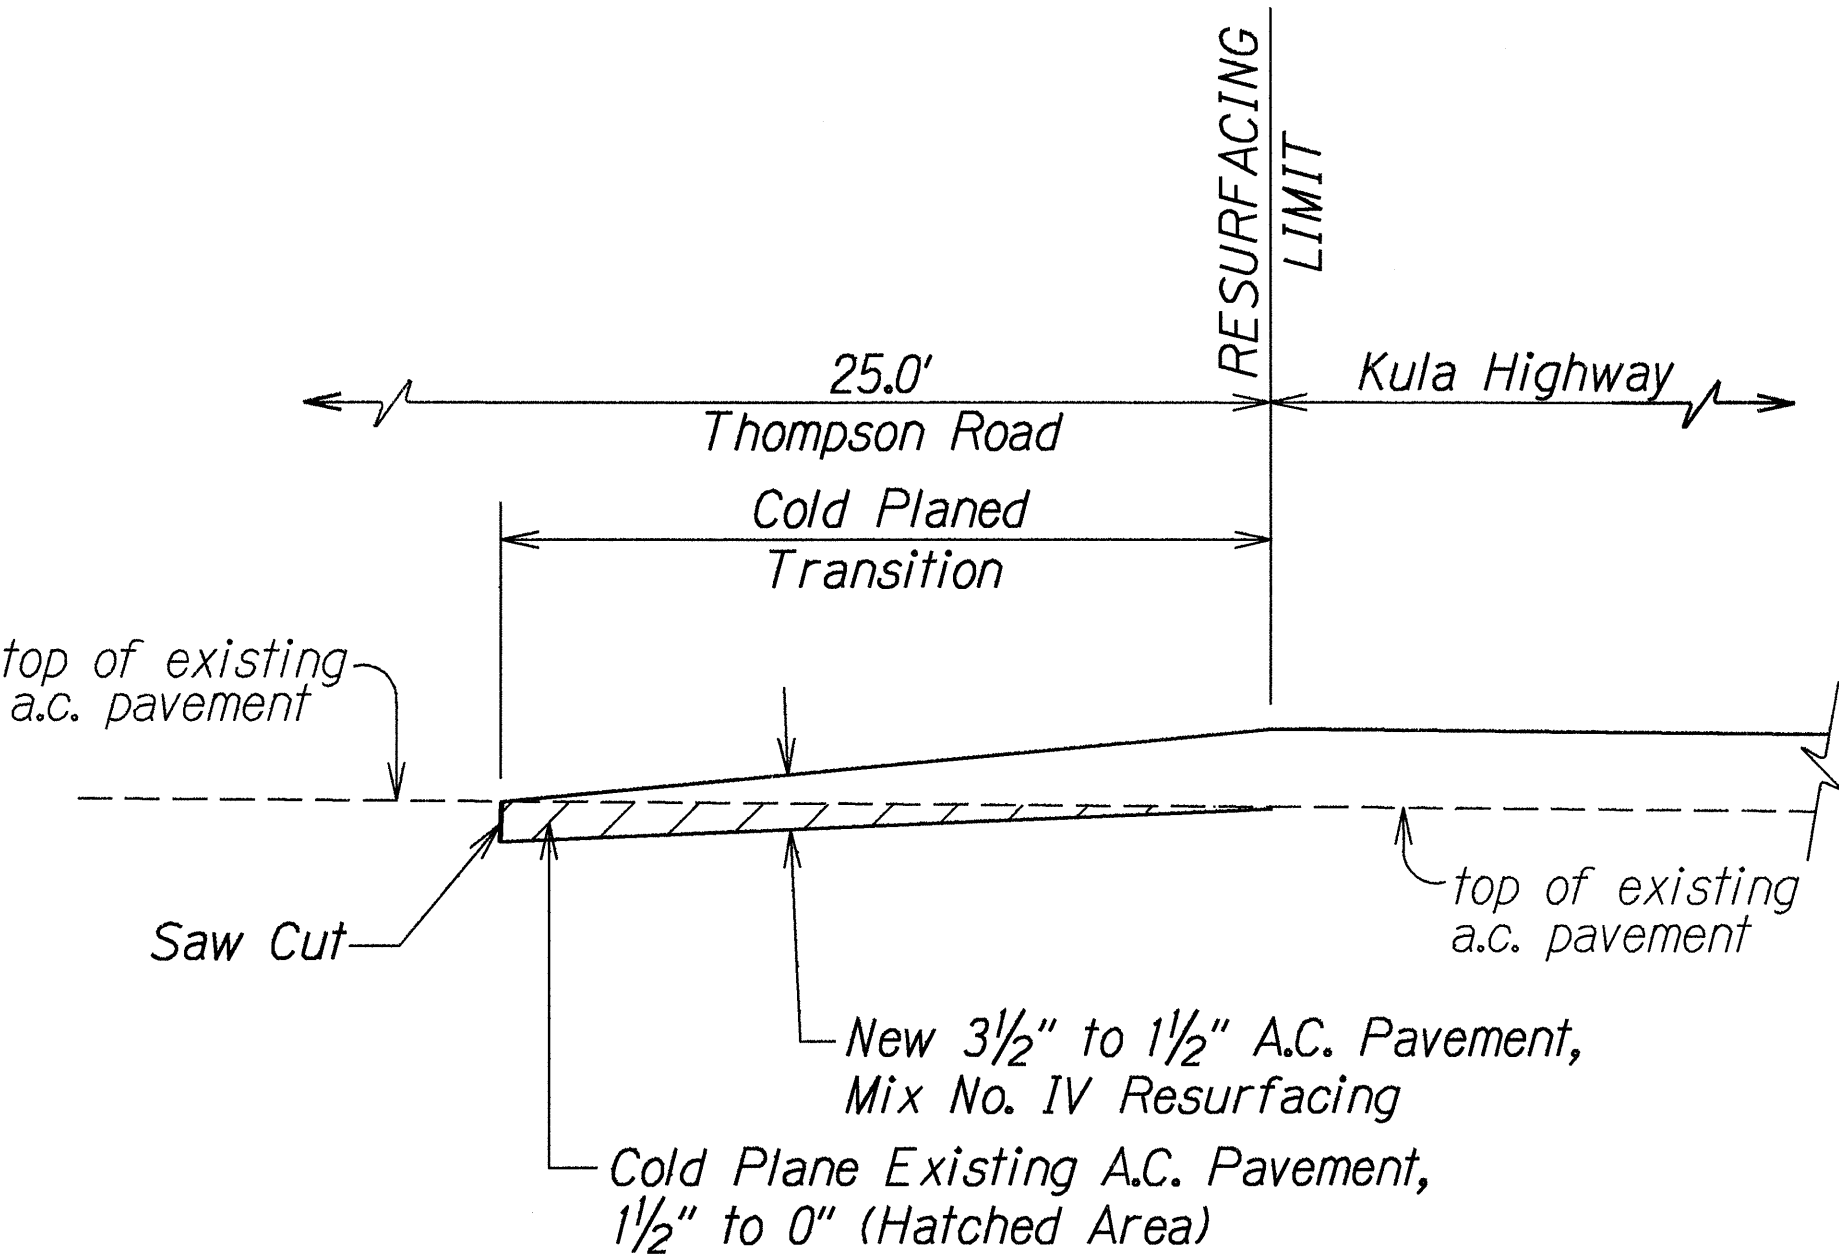

COLD PLANED TRANSITION TO EXISTING A.C. PAVEMENT DETAIL
Thompson Road
 Not To Scale

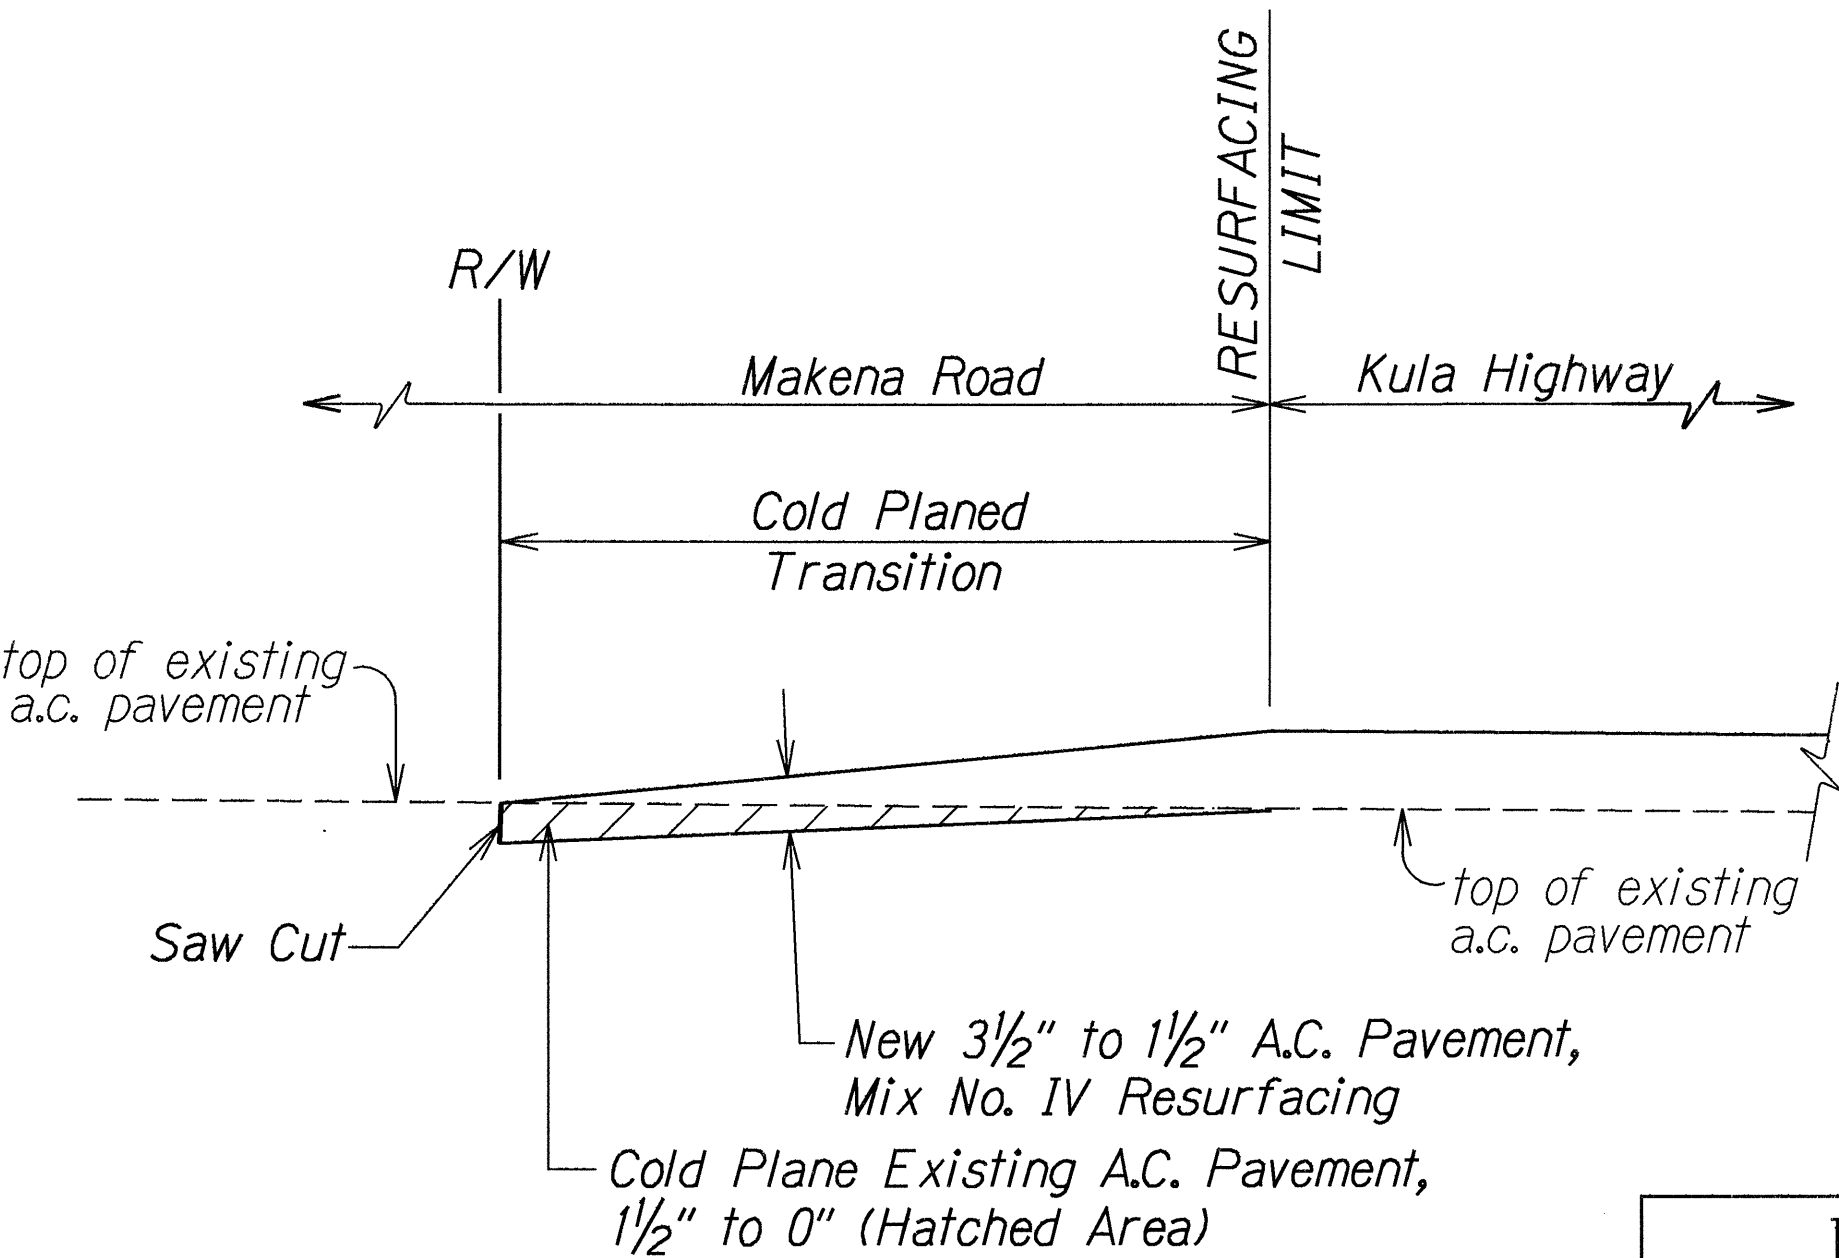

COLD PLANED TRANSITION TO EXISTING A.C. PAVEMENT DETAIL
Makena Road
 Not To Scale

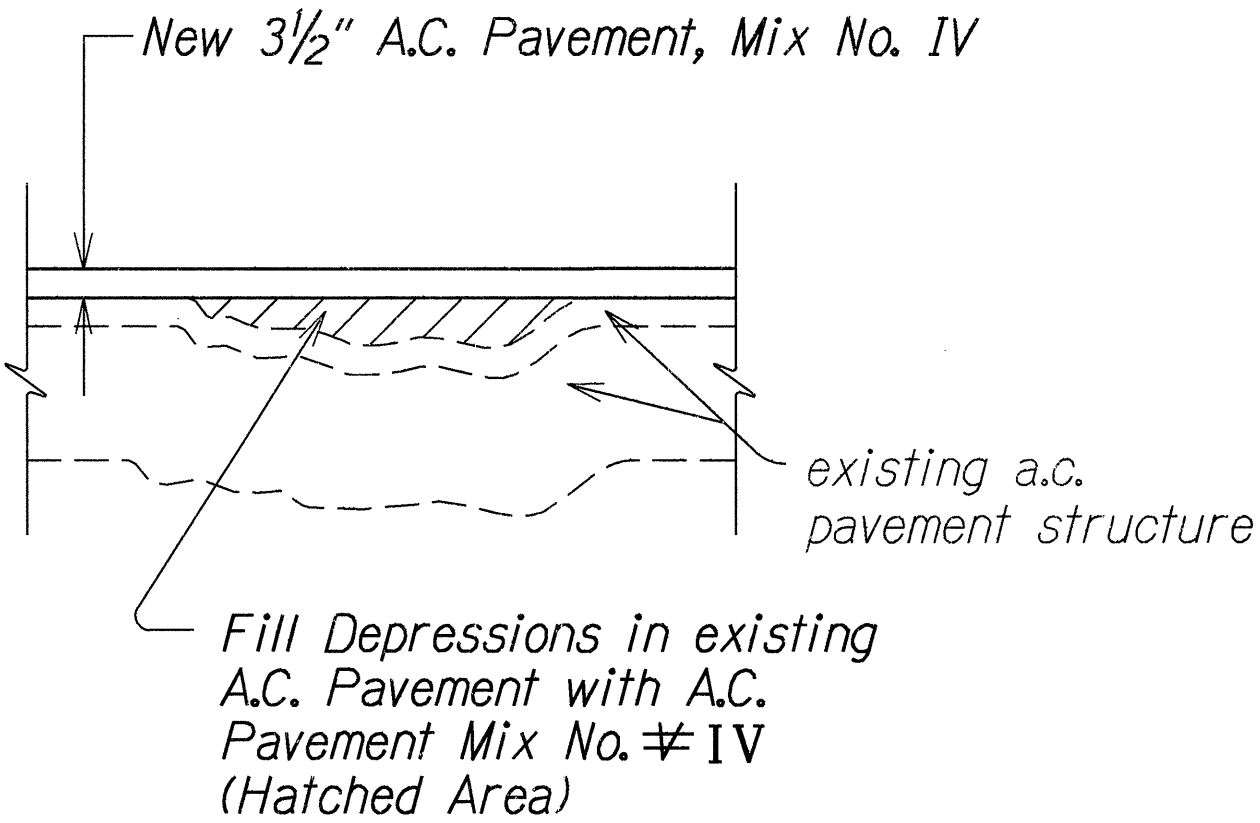

LEVELING DETAIL
 Not To Scale

LEGEND FOR AS-BUILT POSTINGS	
	Squiggly line for as-built deletion
	Double line for as-built deletion
Roadway	Text for as-built posting

STATE OF HAWAII
DEPARTMENT OF TRANSPORTATION
HIGHWAYS DIVISION

TYPICAL SECTIONS
KULA HIGHWAY RESURFACING
Kula Sanatorium to Makena Road
Project No. 37E-01-93M

Scale: As Shown
Date: April, 1993

SHEET No. 1 OF 1 SHEETS

SURVEY PLOTTED BY	DATE
DRAWN BY	
TRACED BY	
NOTE BOOK	
QUANTITIES BY	
CHECKED BY	
No.	