•		
The second second second		INDEX TO DRAWINGS
	SHEET NO.	DESCRIPTION
The Second Section 19 Co.	1	TITLE SHEET
	2	STANDARD PLANS SUMMARY
	3	TRAFFIC LEGEND & NOTES
	4	PAVEMENT MARKING & STRIPING PLAN
	5	TRAFFIC SIGNAL LEGEND, DETAILS AND NOTES
	6	TRAFFIC SIGNAL PLAN
	7	SWING SIGN BRACKET DETAIL
	8	LOOP DETECTOR DETAILS
I		• ;
		· · · · · · · · · · · · · · · · · · ·

STATE OF HAWAII

DEPARTMENT OF TRANSPORTATION

HIGHWAYS DIVISION
HONOLULU, HAWAII
"AS-BUILT"

PLANS FOR


HALEAKALA HIGHWAY


TRAFFIC SIGNALS AT KULA JUNCTION FEDERAL-AID PROJECT NO. STP-037-1(20)

DISTRICT OF MAKAWAO
ISLAND OF MAUI

LAYOUT PLAN

SCALE IN THOUSAND FEET

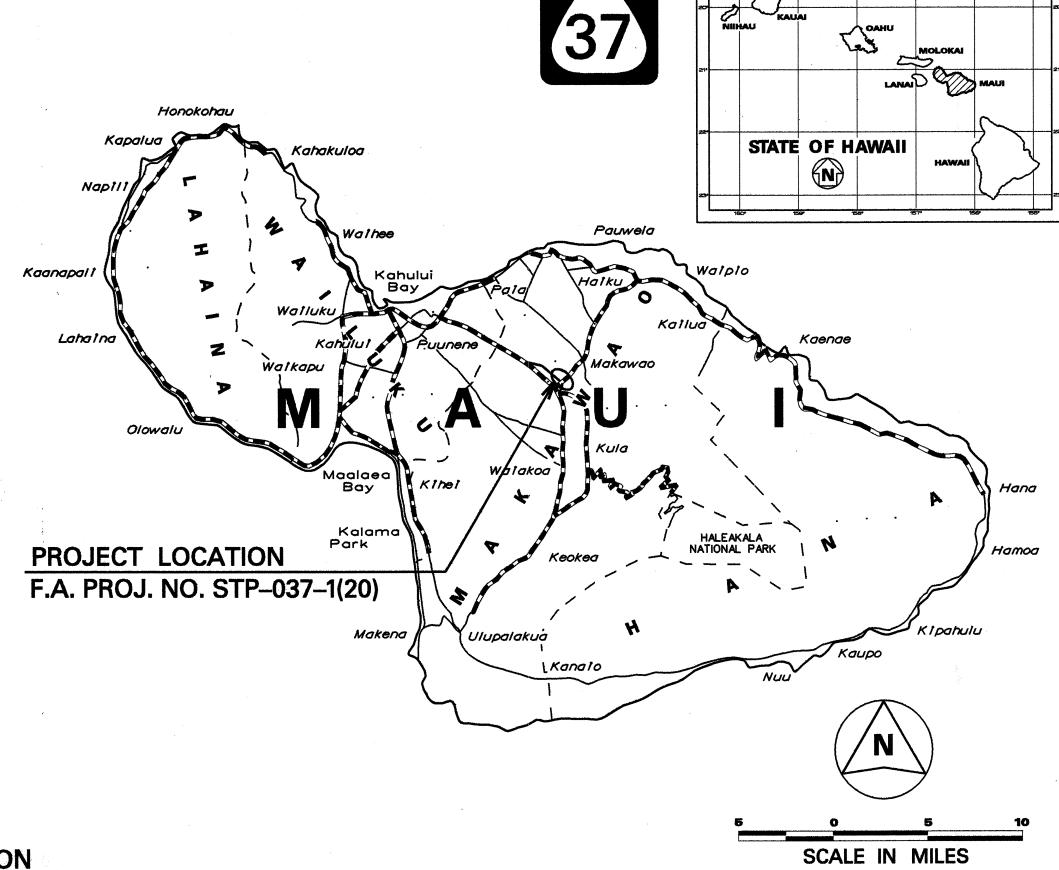

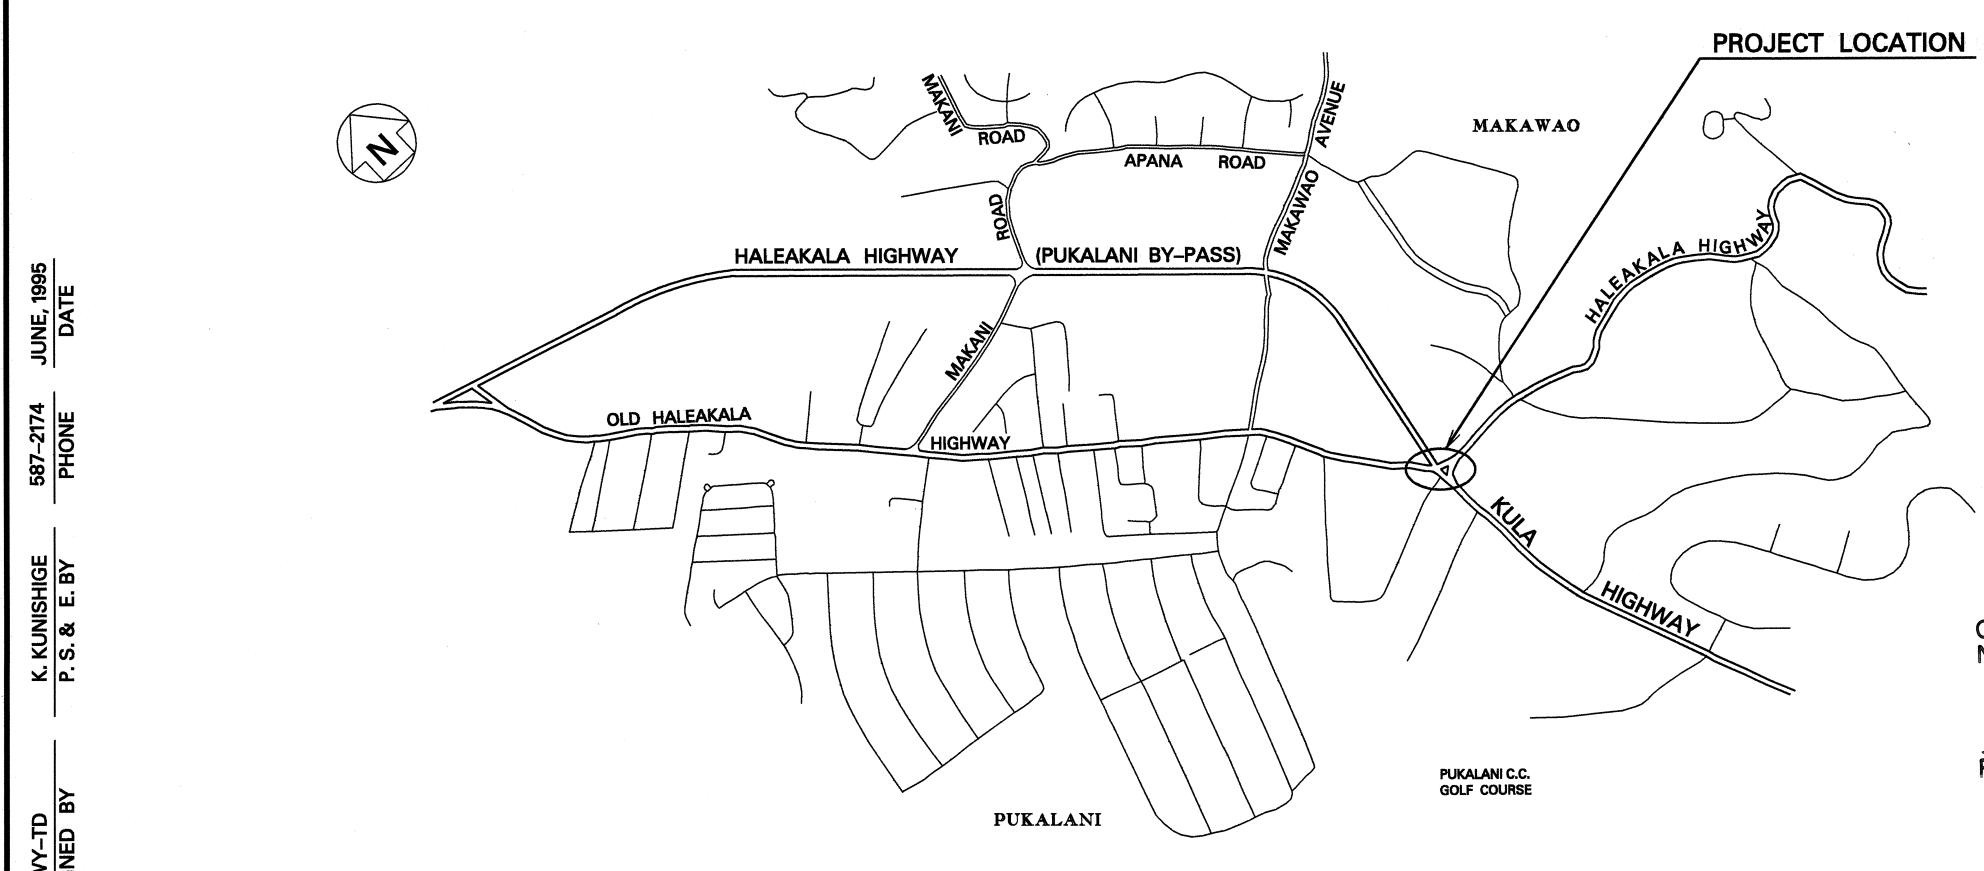

---- FEDERAL AID PROJECTS PREVIOUSLY CONSTRUCTED OR UNDER CONSTRUCTION

FED. AID PROJ. NO.

STP-037-1(20)

FISCAL YEAR

MILE POST 7.50 TO MILE POST 7.60

DESIGN DESIGNATION

CHANGES MADE DURING CONSTRUCTION HAVE BEEN NOTED IN RED ON THESE TRACINGS AND CHECKED BY

RESIDENT ENGINEER DATE

DEPARTMENT OF TRANSPORTATION STATE OF HAWAII		
APPROVED:		
tage Sayashih	7/25/95	
DIR. OF TRANSPORTATION	DATE	