

TRAFFIC SIGNAL SYSTEM CONDUIT AND CABLE SCHEDULE

	DELTA ITEM NO. (Δ)								
	1	2	3	4	5	6	7	8	9
QUANTITY OF 2" CONDUIT, SEE NOTE NO. 1	4	4	2*	2*	2*	2*	1	1	1
QUANTITY OF 26/C #14 CONTROL CABLE	2	2	1	1	1	1			
QUANTITY OF 2/C #14 SHIELDED LOOP DETECTOR AND PEDESTRIAN PB CABLE	8	8	5	2	1	3	3	1	
QUANTITY OF 3/C #6 POWER CABLE									1


NOTE: 1. ALL CONDUITS SHALL BE SCHEDULE 80 PVC, UNLESS OTHERWISE NOTED.
* EXISTING CONDUITS

FED. ROAD DIST. NO.	STATE	FED. AID PROJ. NO.	FISCAL YEAR	SHEET NO.	TOTAL SHEETS
HAWAII	HAW.	STP-037-1(20)	1996	6	8

TRAFFIC SIGNAL HEAD SCHEDULE

Traffic Signal Head Type and Description				
	12" RY< Traffic Signal Head	12" RY↑ Traffic Signal Head	12" RY← Traffic Signal Head	Pedestrian Signal Head
Pole Letter Signal Head Number	A-3 D-1 B-1 D-2 C-3	A-2 C-2	* A-1 B-3 * C-1 D-3	A-4 C-5 B-4 D-4 B-5 D-5 C-4 E-1

* With Programmed Visibility

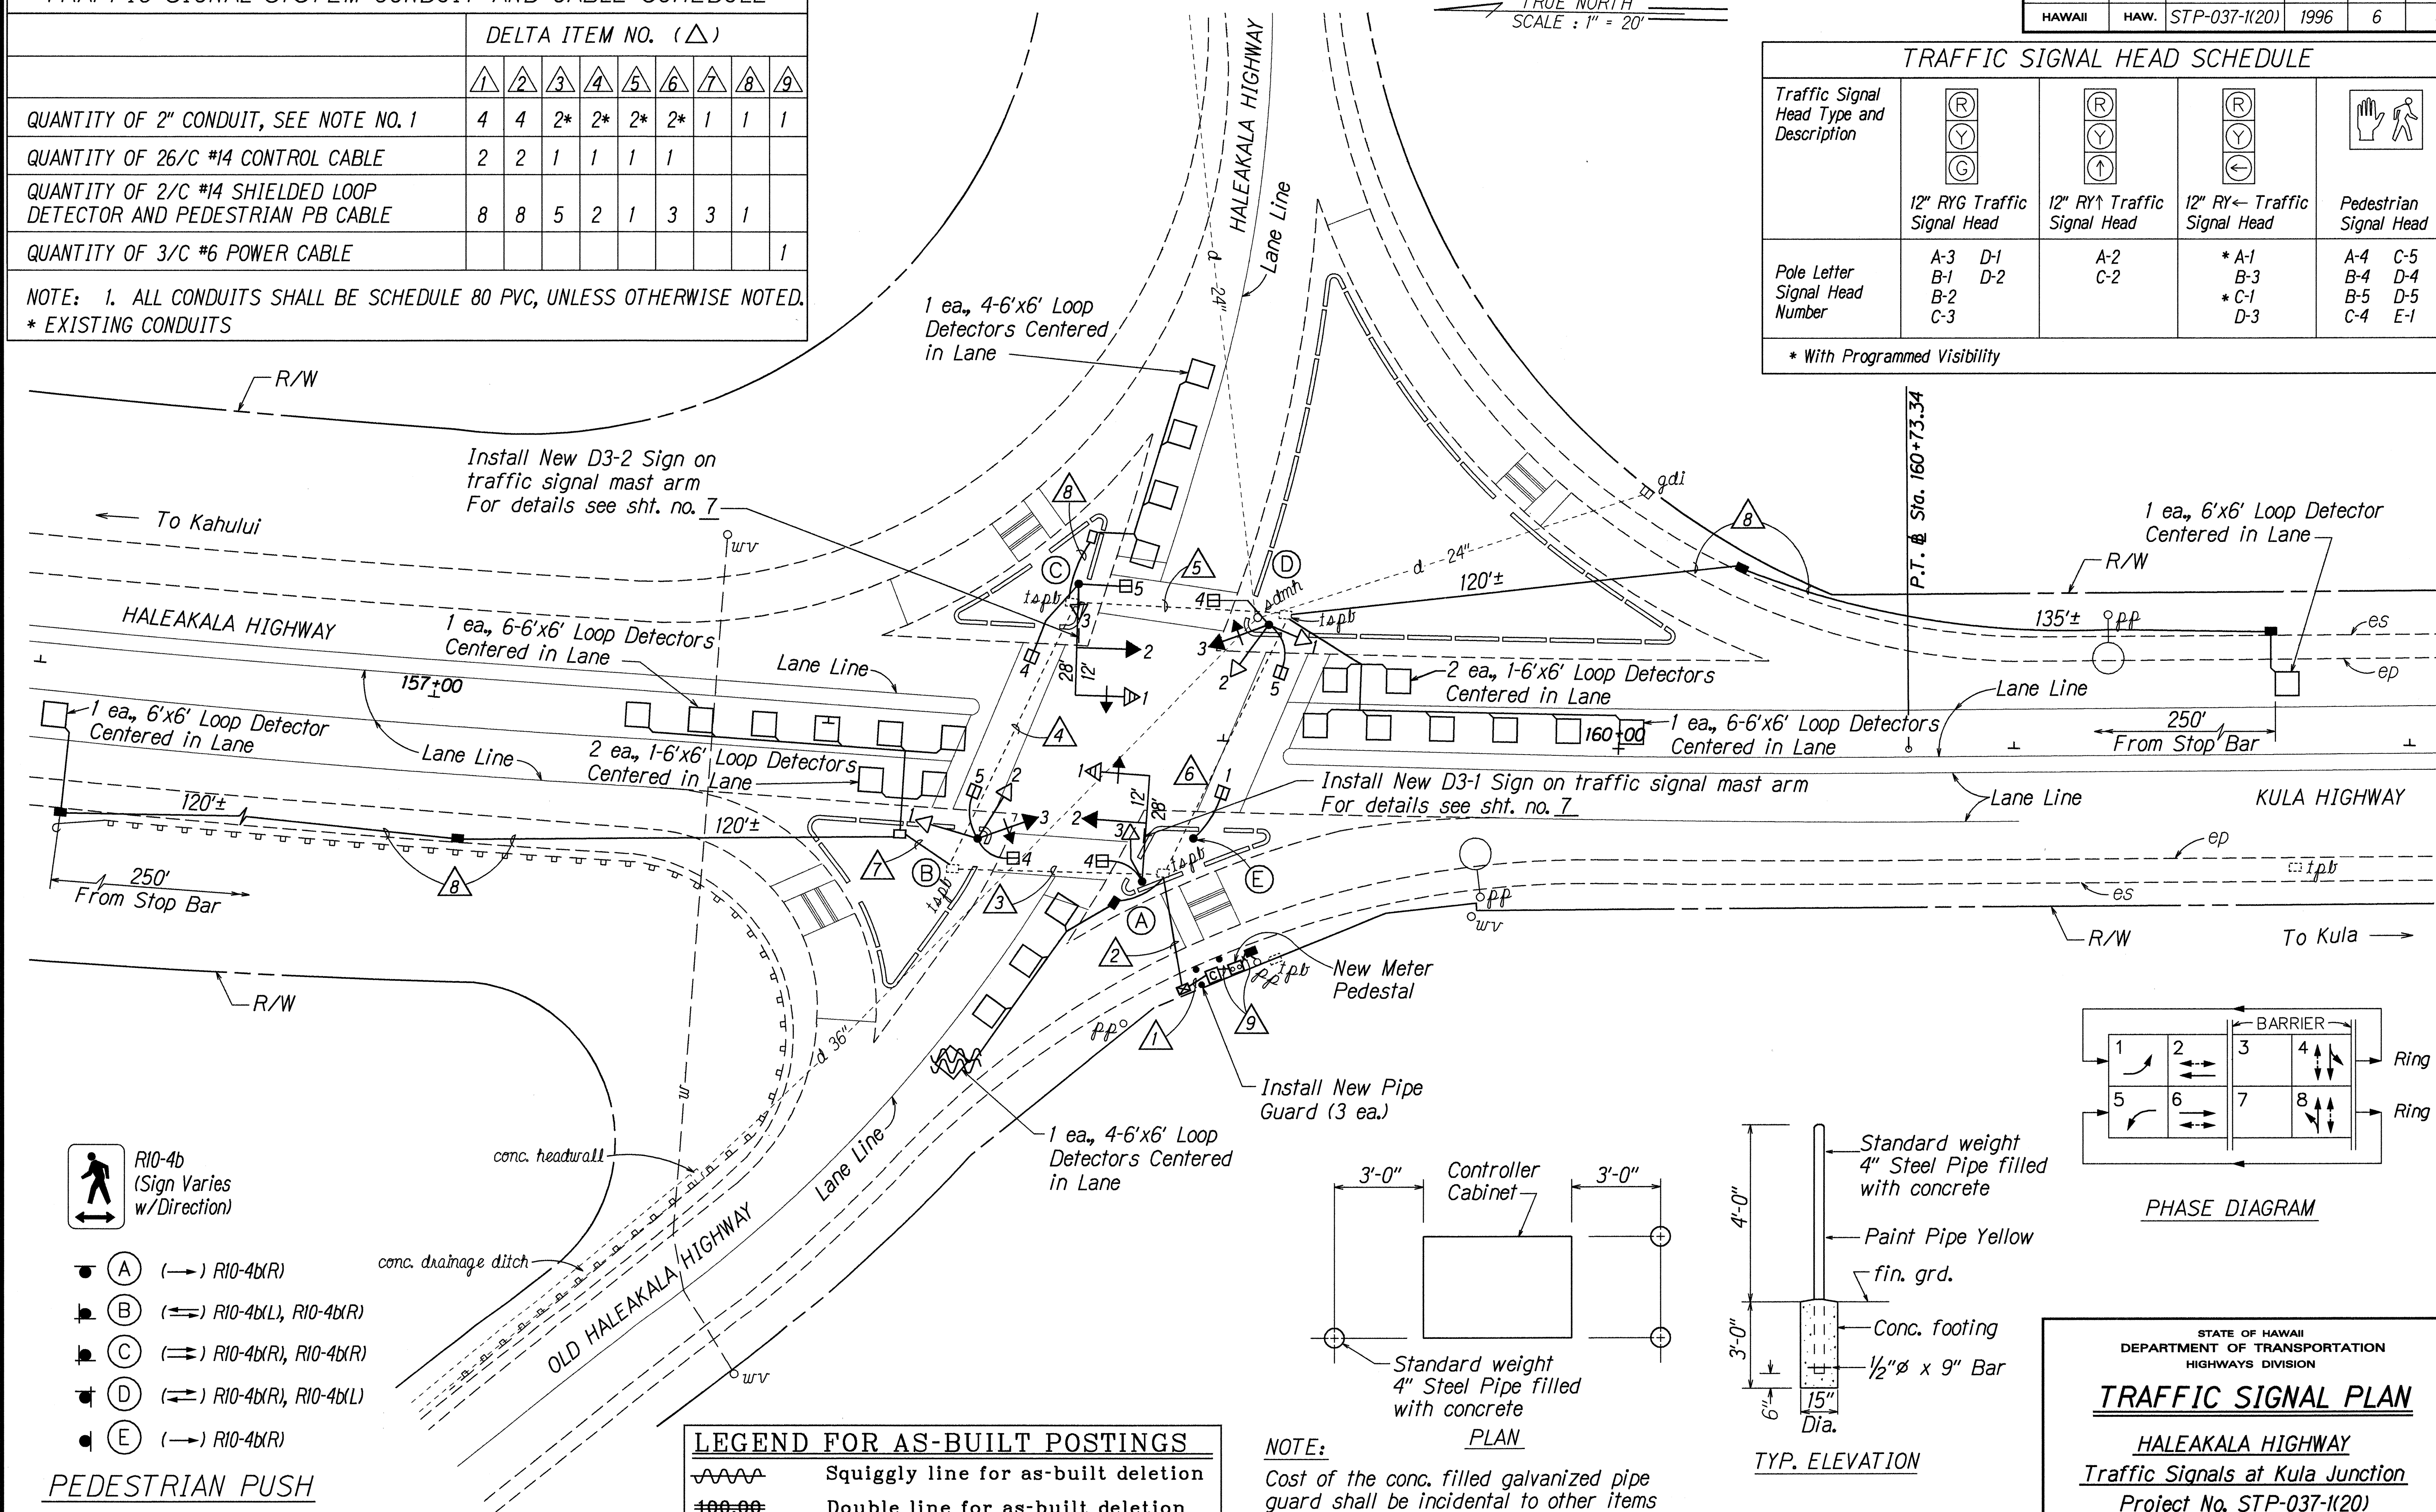


- (A) (→) R10-4b(R)
- (B) (↔) R10-4b(L), R10-4b(R)
- (C) (↔) R10-4b(R), R10-4b(L)
- (D) (↔) R10-4b(R), R10-4b(L)
- (E) (→) R10-4b(R)

PEDESTRIAN PUSH
BUTTON W/SIGN (NEW)



LEGEND FOR AS-BUILT POSTINGS

	Squiggly line for as-built deletion
	Double line for as-built deletion
Roadway	Text for as-built posting

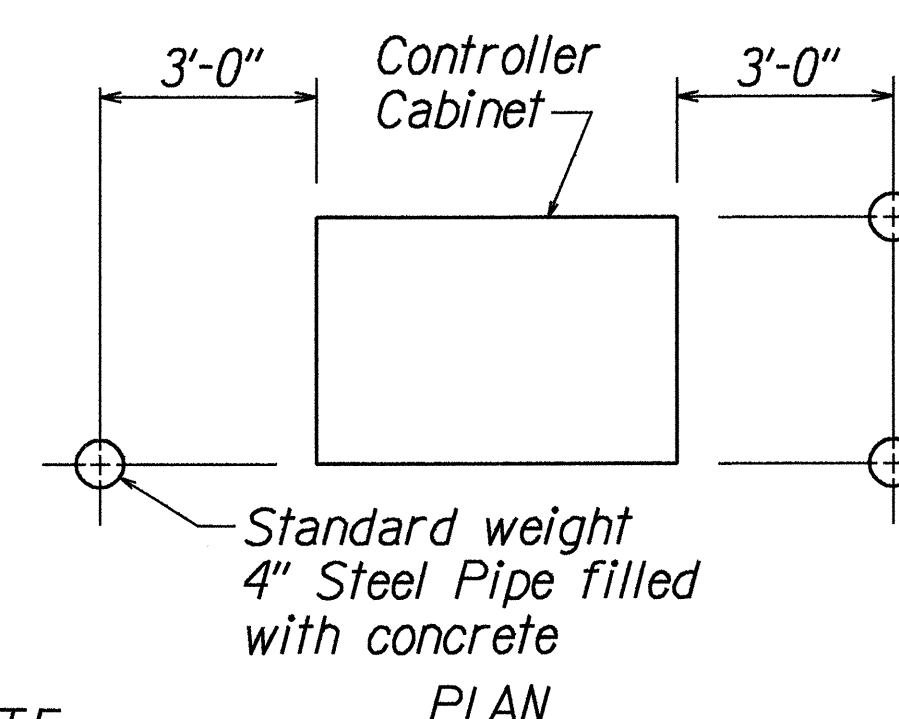

NOTE:
Cost of the conc. filled galvanized pipe guard shall be incidental to other items of work.

PIPE GUARD DETAIL
Not to Scale

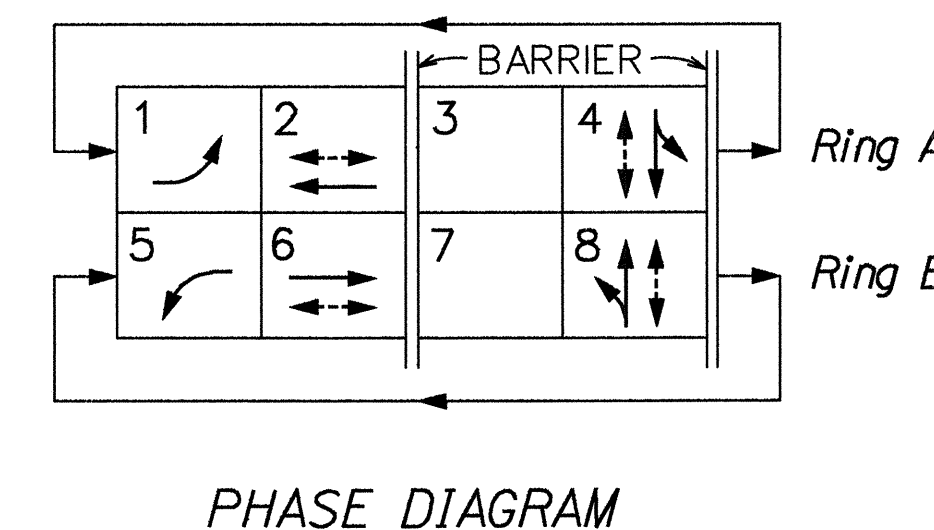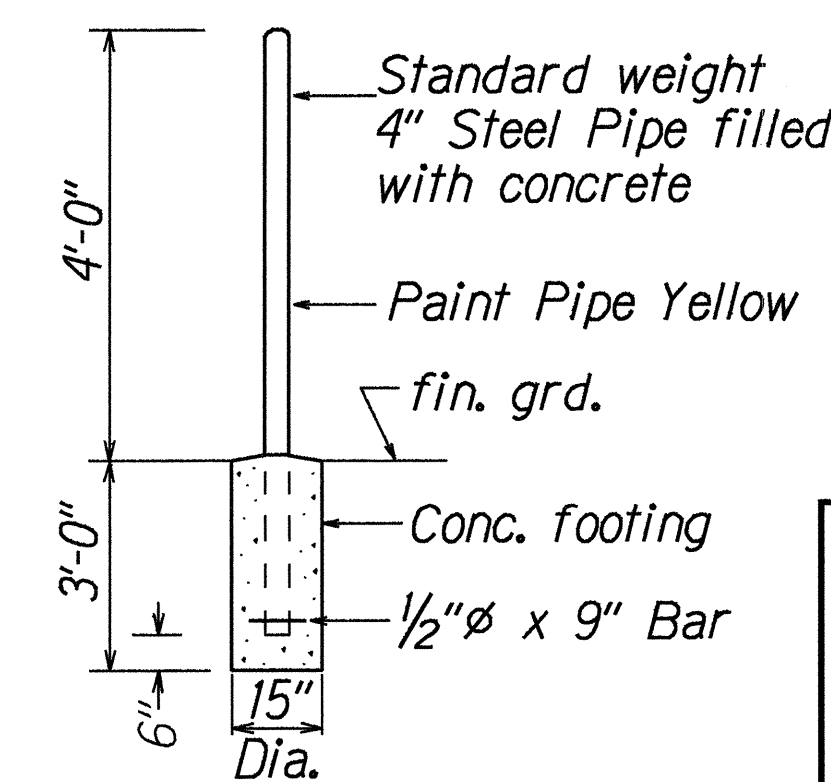

STATE OF HAWAII
DEPARTMENT OF TRANSPORTATION
HIGHWAYS DIVISION

TRAFFIC SIGNAL PLAN

HALEAKALA HIGHWAY
Traffic Signals at Kula Junction
Project No. STP-037-1(20)

Scale: 1"=20'-0" Date: June, 1995

SHEET No. 2 OF 2 SHEETS