


FED. ROAD DIST. NO.	STATE	PROJ. NO.	FISCAL YEAR	SHEET NO.	TOTAL SHEETS
HAWAII	HAW.	37C-01-97	1998	7	10

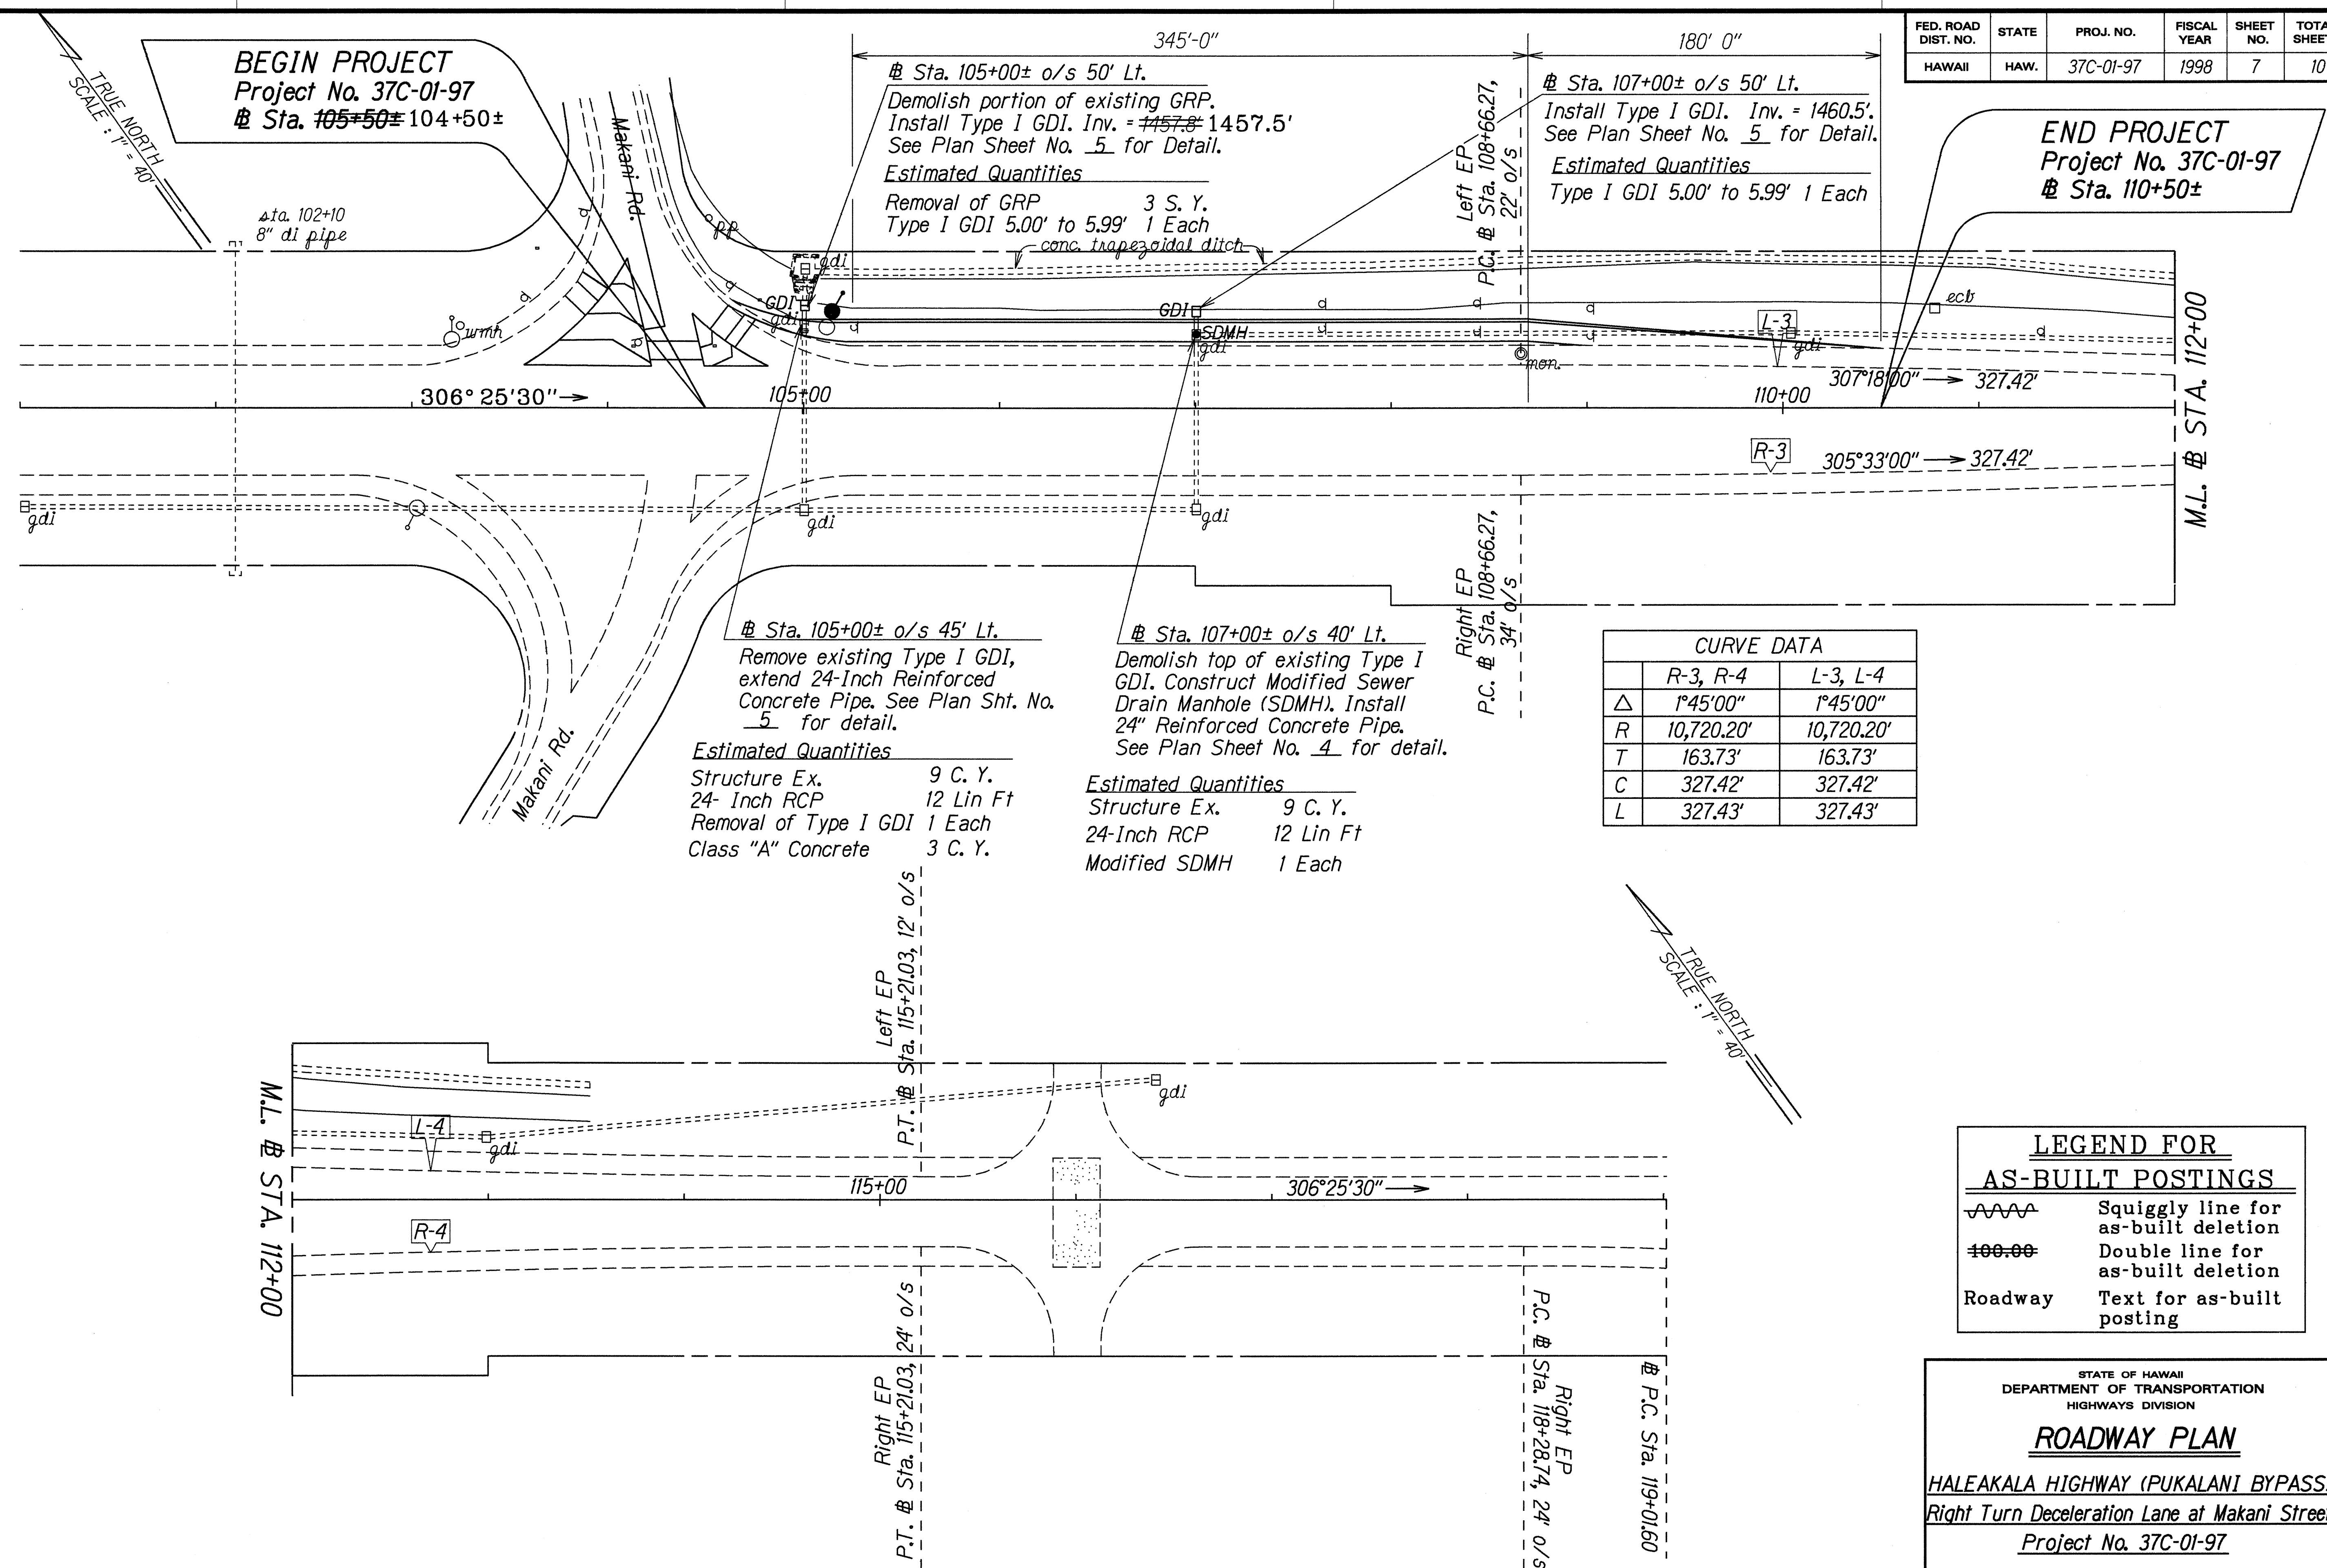

ORIGINAL PLAN	DATE: 2/97
DESIGNED BY: L. Medina	CHECKED BY: L. Medina
QUANTITIES BY: L. Medina	
CHECKED BY: L. Medina	

"AS-BUILT"