


FED. ROAD DIST. NO.	STATE	FED. AID PROJ. NO.	FISCAL YEAR	SHEET NO.	TOTAL SHEETS
HAWAII	HAW.	STP-037-1(21)	1998	40	40

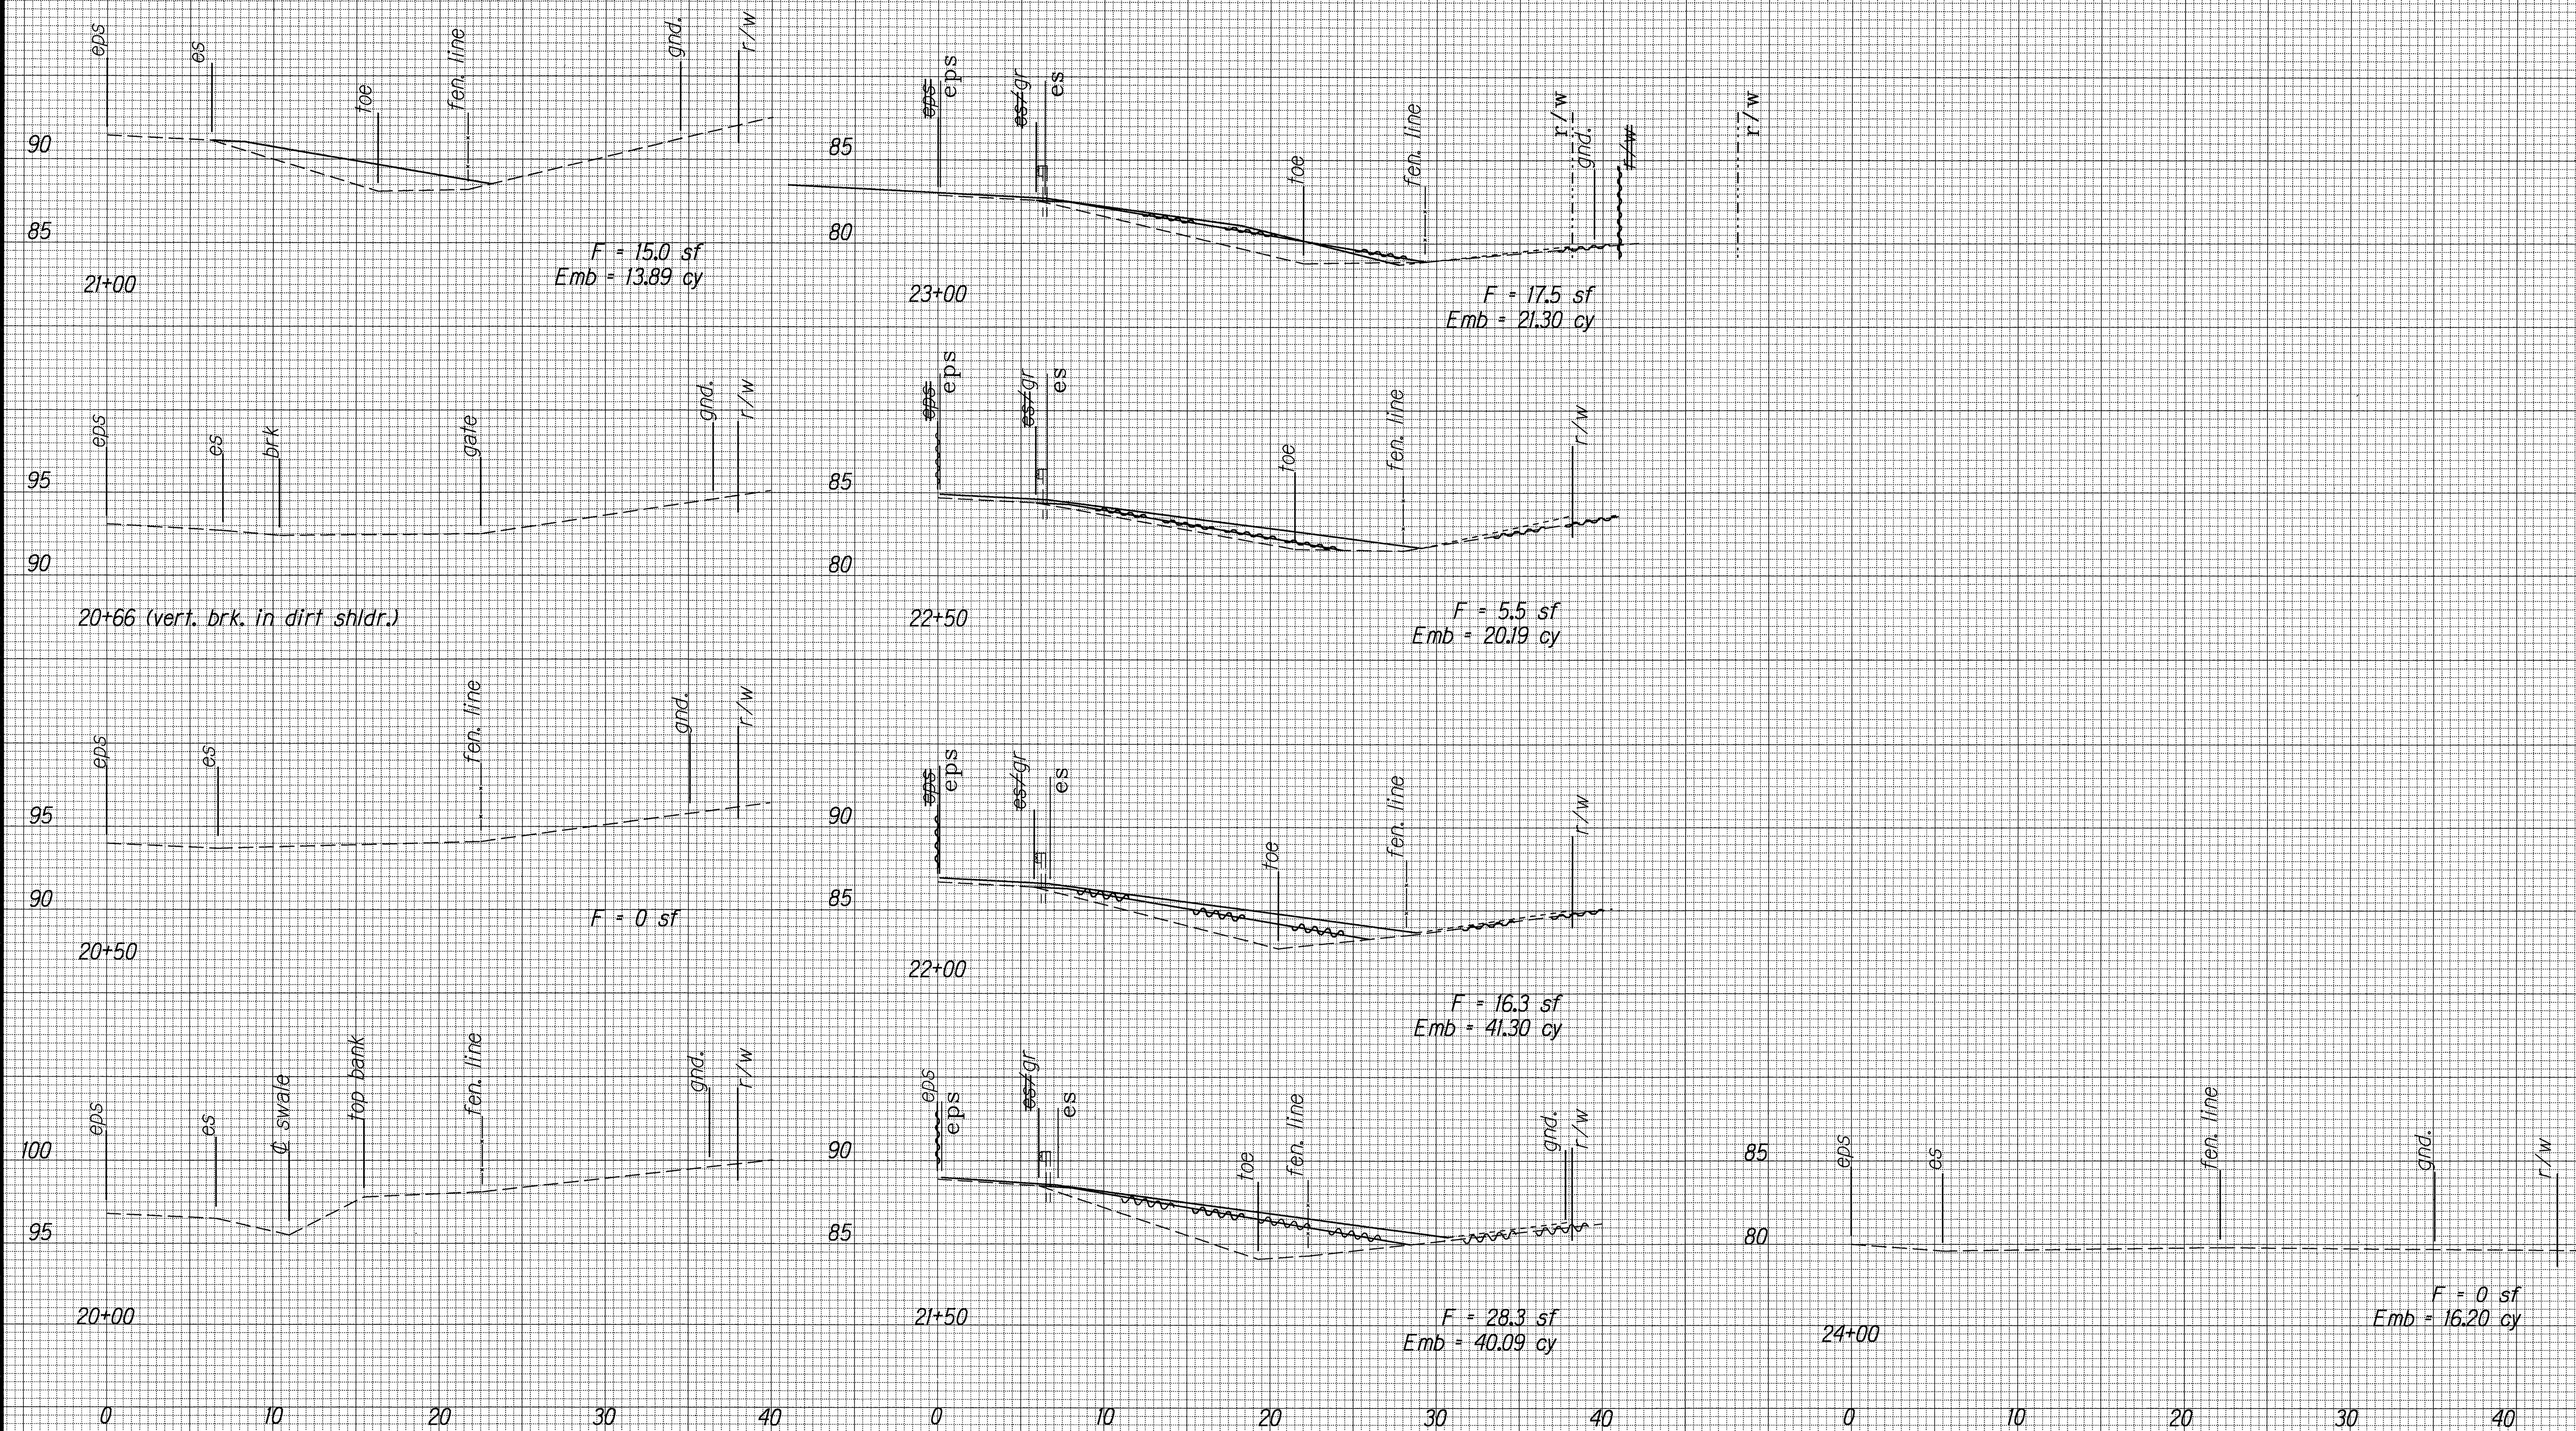

CROSS SECTIONS - KULA HIGHWAY STA. 20+00 TO 24+00
Scale: Horiz. 1 Inch = 5 Feet
Vert. 1 Inch = 5 Feet

DESIGNED BY	DATE
DRAWN BY	Mar. 1998
CHECKED BY	
NOTED BY	
QUANTITIES BY	
ORIGINAL PLAN	