

INDEX TO DRAWINGS	
SHEET NO.	DESCRIPTION
1	TITLE SHEET
2	LAYOUT PLAN
3	STANDARD PLAN SUMMARY
4	GENERAL NOTES AND LEGEND
5	MISCELLANEOUS NOTES
6	MISCELLANEOUS DETAILS
7-54	ROADWAY PLANS
55-64	GUARDRAIL DETAILS
65	GRADING PLAN
66	DRAINAGE SUMMARY
67-68	EROSION CONTROL

STATE OF HAWAII
DEPARTMENT OF TRANSPORTATION
HIGHWAYS DIVISION
HONOLULU, HAWAII



"AS-BUILT"

PLANS FOR
KULA HIGHWAY REPAIR AND MAINTENANCE
AT VARIOUS LOCATIONS
PROJECT NO. 37CD-01-02M

DISTRICT OF MAKAWAO
ISLAND OF MAUI

PROJECT NO. 37CD-01-02M

FED. ROAD DIST. NO.	STATE	PROJ. NO.	FISCAL YEAR	SHEET NO.	TOTAL SHEETS
HAWAII	HAW.	37CD-01-02M	2002	1	68

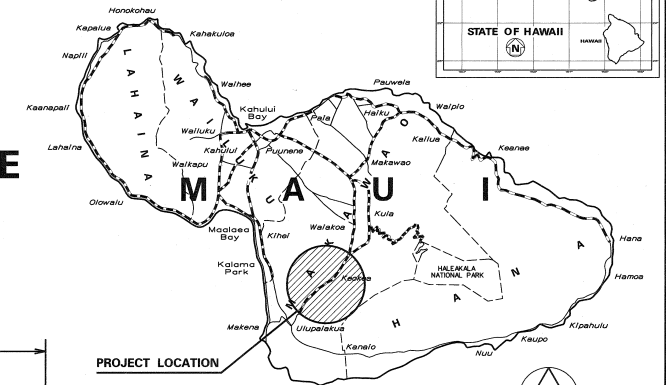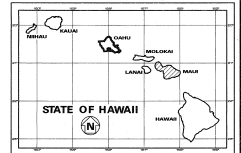

SCALE IN MILES

----- FEDERAL AID PROJECTS PREVIOUSLY CONSTRUCTED OR UNDER CONSTRUCTION

MILE POST 7.5 TO MILE POST 17.0

DESIGNED BY P. Chung
OKAHARA & ASSOCIATES, INC.
873-3535
June 2002
DATE

ORIGINAL	DATE
DESIGNED BY	
TRACED BY	
CHECKED BY	
IN CHARGE	
DATE	



SCALE IN THOUSAND FEET

NO SIGNIFICANT CHANGES WERE MADE DURING CONSTRUCTION OF THESE PLANS EXCEPT CHANGES IN THE ORIGINAL THRESHOLD, REBAR, AND ACTUAL QUANTITIES, REFER TO PROJECT LOGS AND/OR CONSTRUCTION BOOK.

DEPARTMENT OF TRANSPORTATION
STATE OF HAWAII
APPROVED: *Don M. Spence* 5-13-02
DIR. OF TRANSPORTATION DATE