



FED. ROAD DIST. NO.	STATE	FED. AID PROJ. NO.	FISCAL YEAR	SHEET NO.	TOTAL SHEETS
HAWAII	HAW.	NH-037-1(24)	2005	58	288

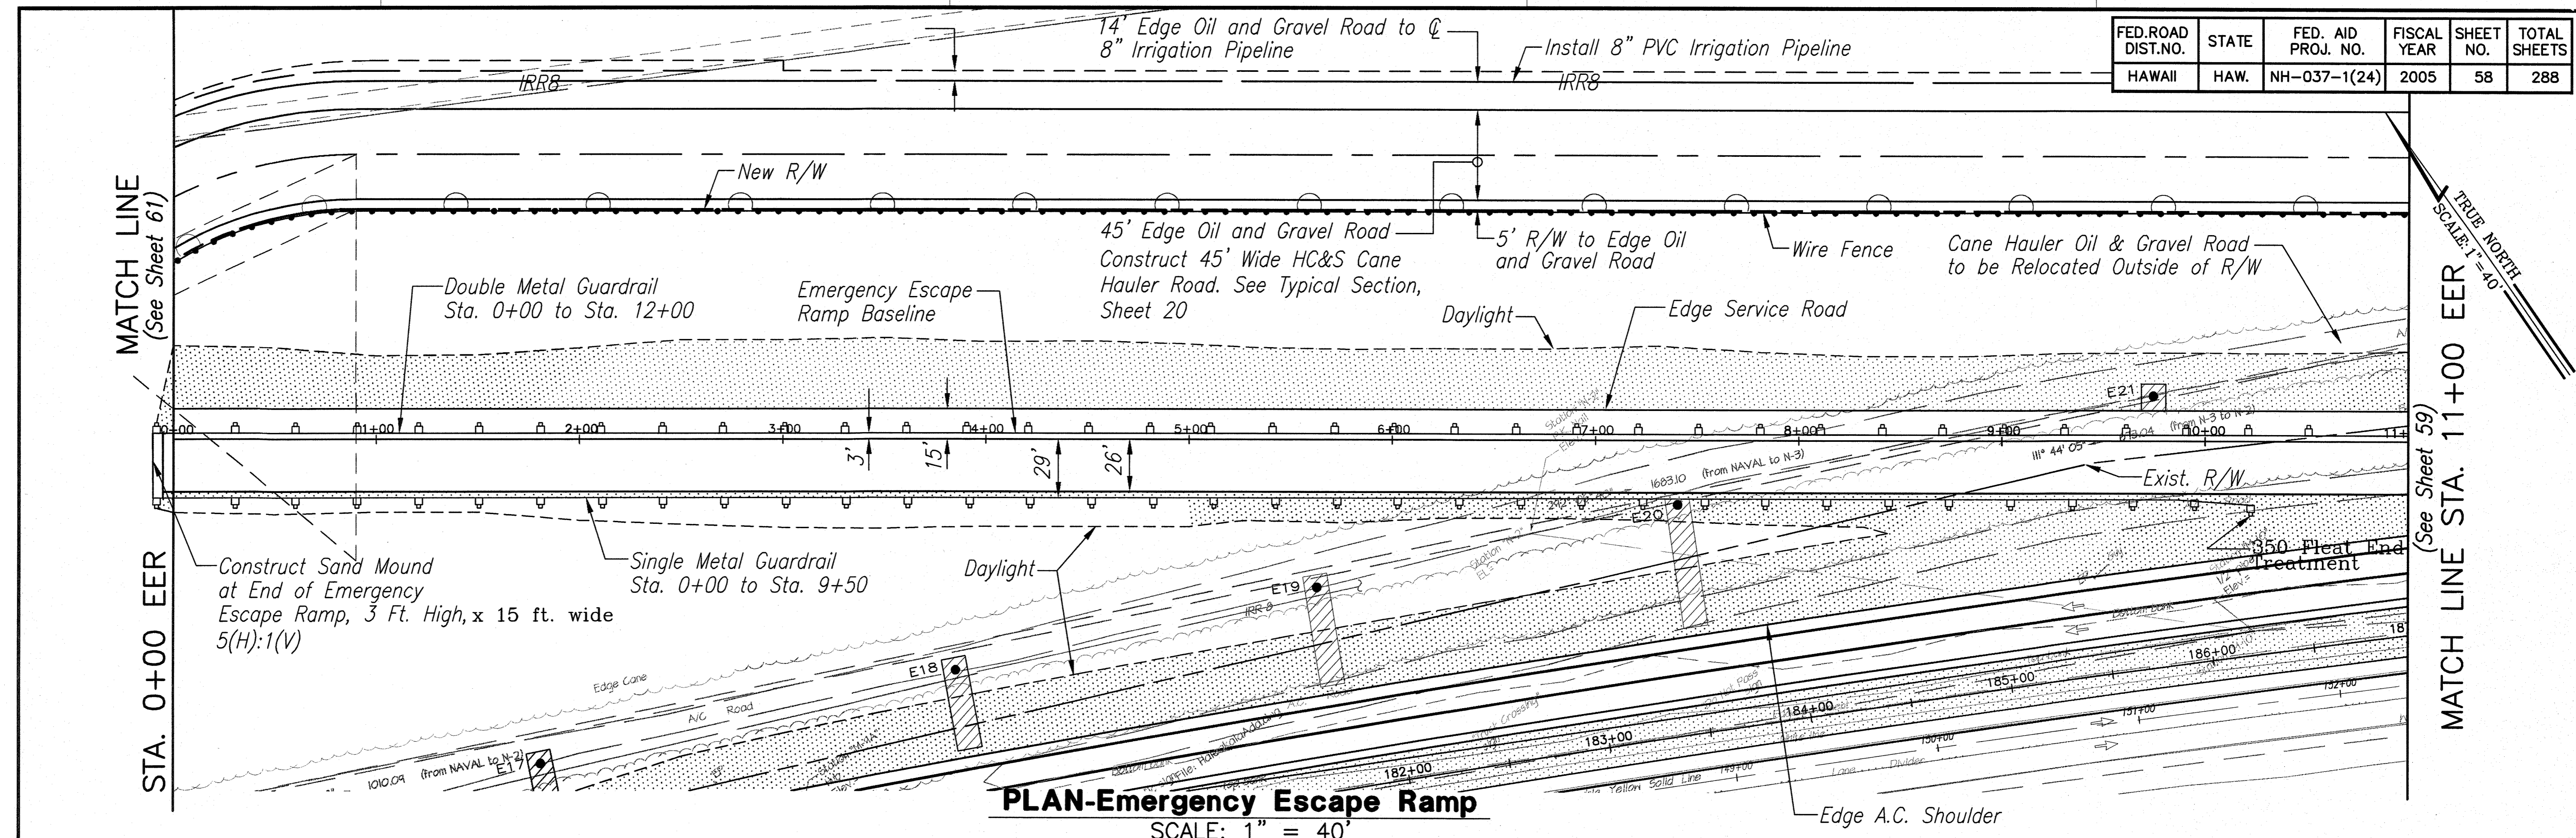


PLAN-Emergency Escape Ramp
SCALE: 1" = 40'

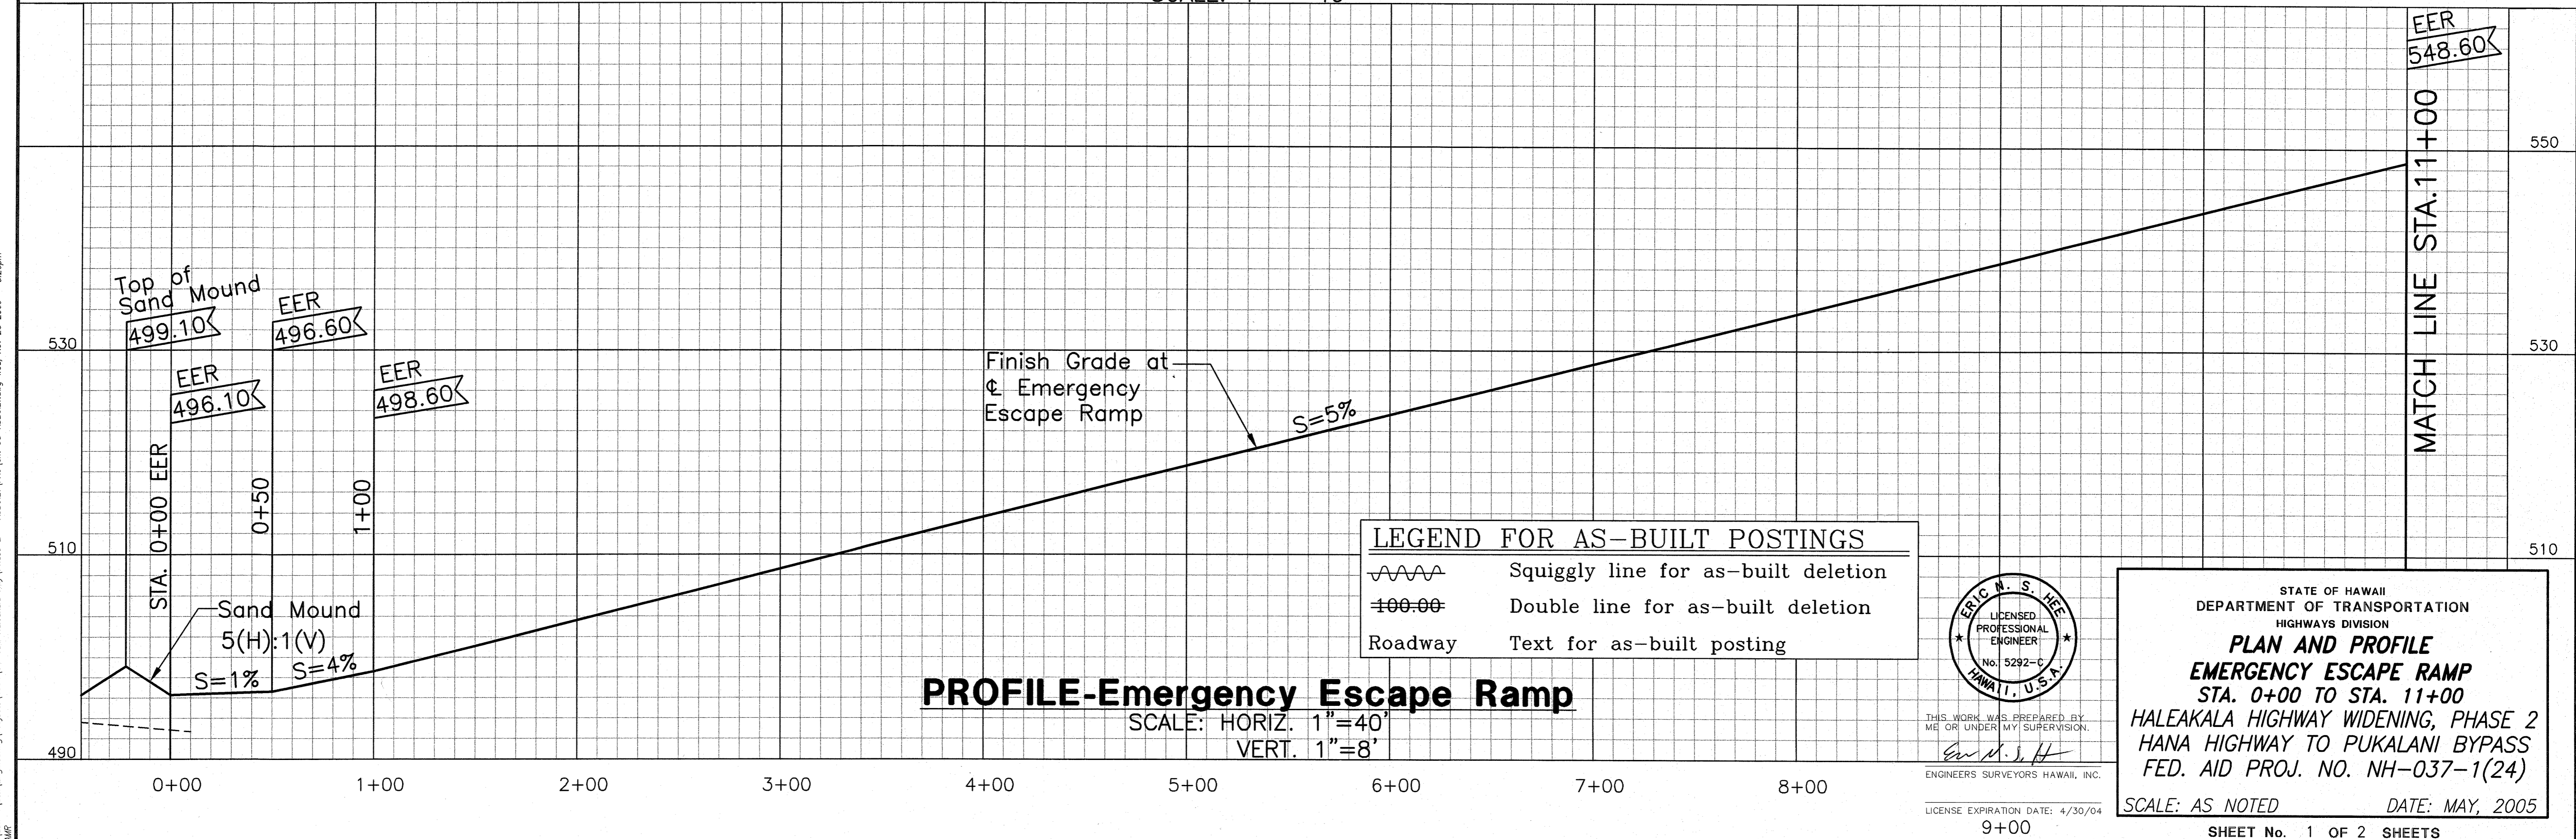

PROFILE-Emergency Escape Ramp
SCALE: HORIZ. 1" = 40'
VERT. 1" = 8'

LEGEND FOR AS-BUILT POSTINGS

	Squiggly line for as-built deletion
	Double line for as-built deletion
	Roadway Text for as-built posting

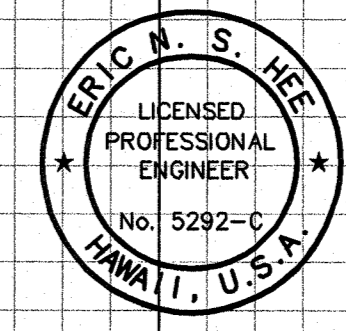

STATE OF HAWAII
DEPARTMENT OF TRANSPORTATION
HIGHWAYS DIVISION

**PLAN AND PROFILE
EMERGENCY ESCAPE RAMP**
STA. 0+00 TO STA. 11+00
HALEAKALA HIGHWAY WIDENING, PHASE 2
HANA HIGHWAY TO PUKALANI BYPASS
FED. AID PROJ. NO. NH-037-1(24)

SCALE: AS NOTED DATE: MAY, 2005

ENGINEERS SURVEYORS HAWAII, INC.
LICENSE EXPIRATION DATE: 4/30/04


SHEET No. 1 OF 2 SHEETS

ORIGINAL PLAN	DATE
BY	
DESIGNED BY	
QUANTITIES BY	
CHECKED BY	
No.	


11-Ein-1 (en) Engineering Projects 119941 (P-05) Haleakala Hwy Phase 2 - AS-BUILT PLAN (P) 05-AS-BUILT Long Wal, Nov 25 2009 - 5:26pm

AS-BUILT

FED. ROAD DIST. NO.	STATE	FED. AID PROJ. NO.	FISCAL YEAR	SHEET NO.	TOTAL SHEETS
HAWAII	HAW.	NH-037-1(24)	2005	59	288

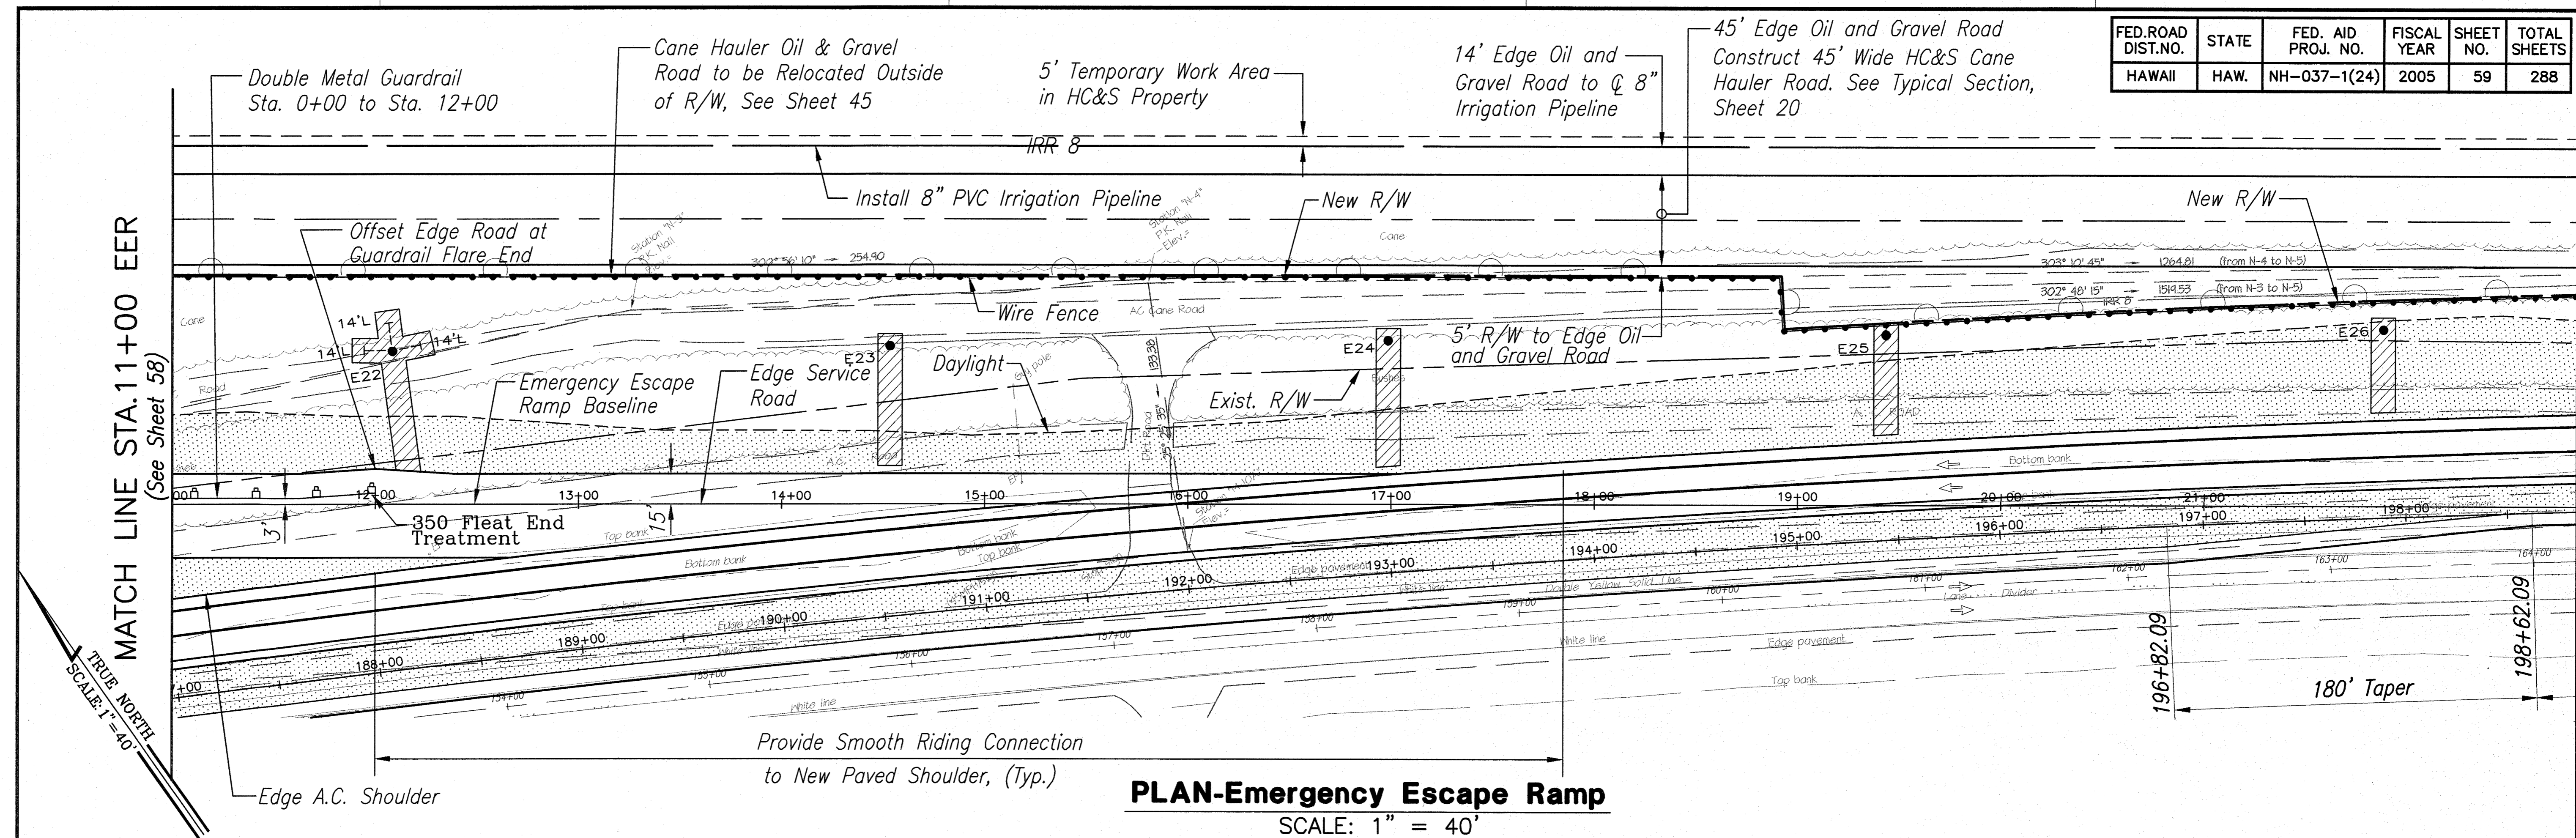

PLAN-Emergency Escape Ramp
SCALE: 1" = 40'

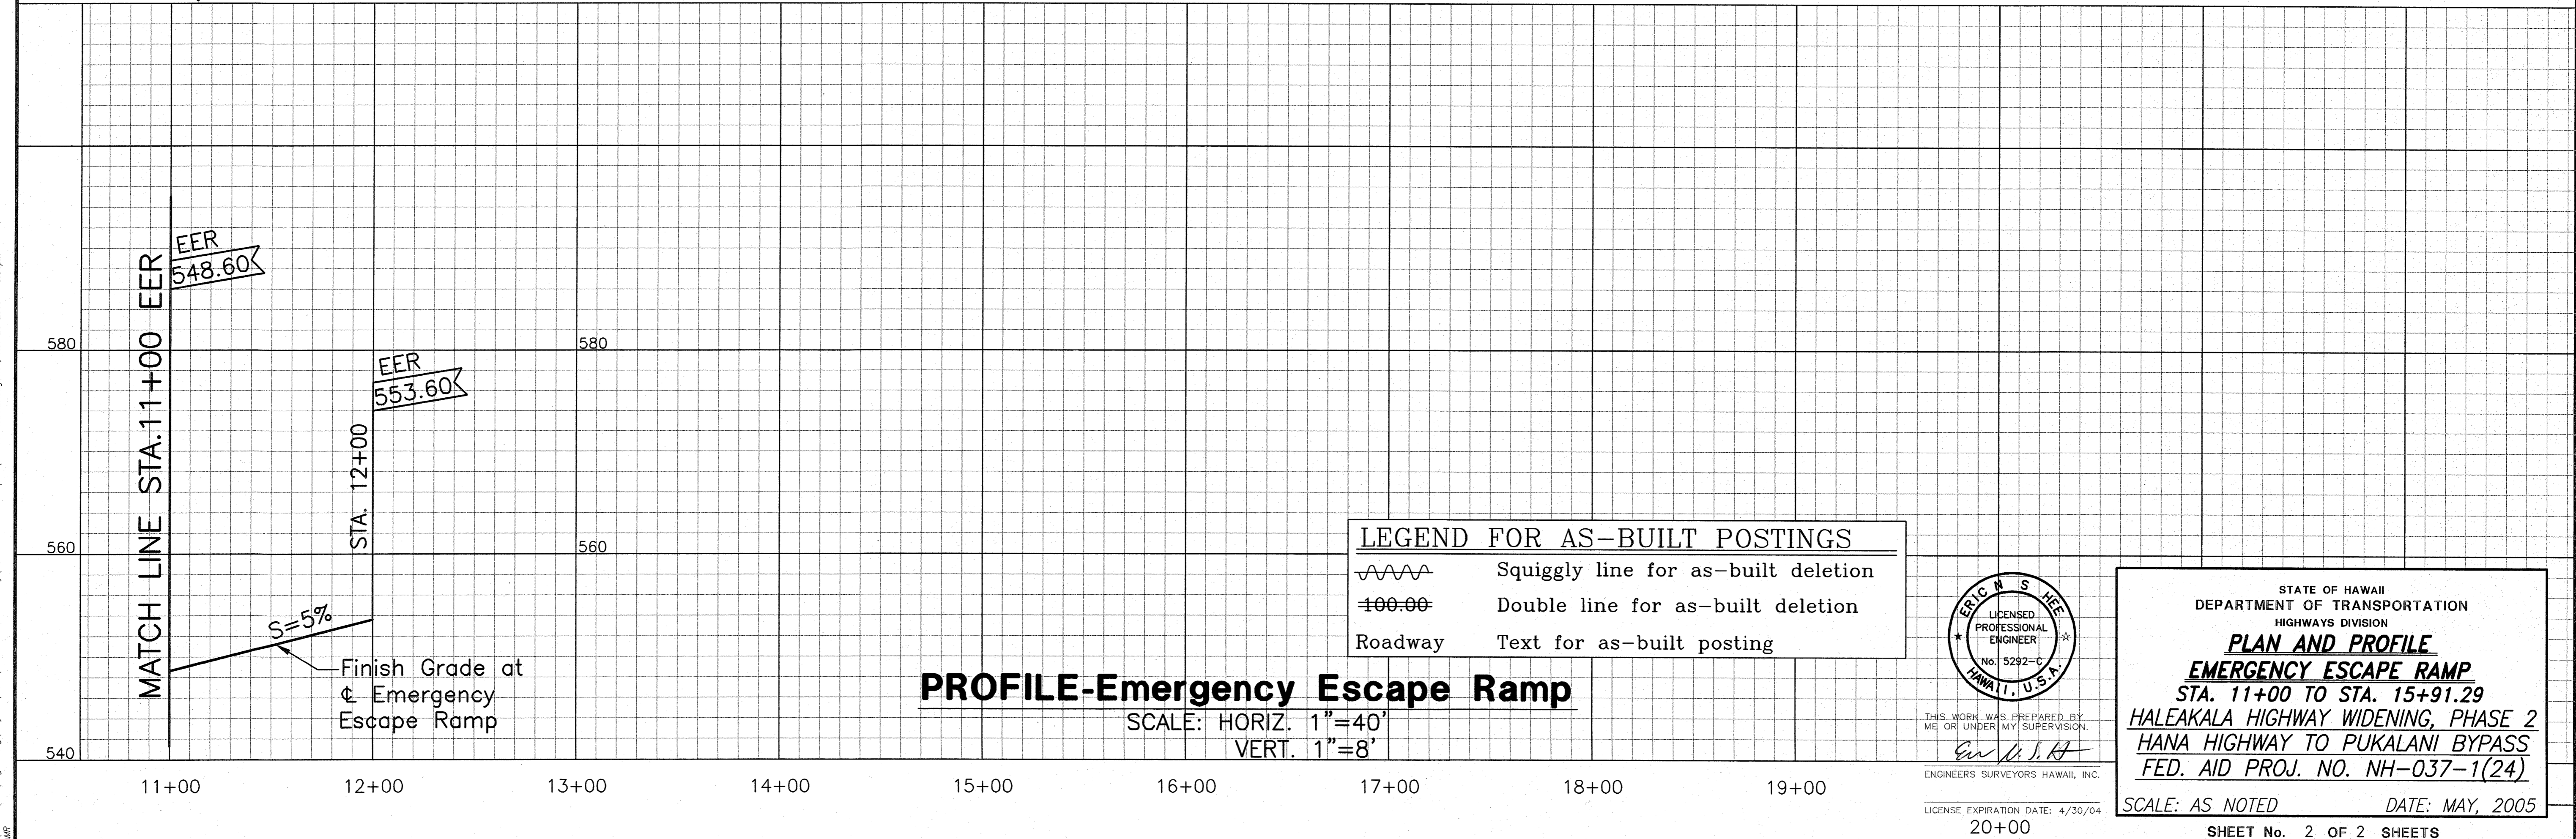

PROFILE-Emergency Escape Ramp
SCALE: HORIZ. 1" = 40'
VERT. 1" = 8'

LEGEND FOR AS-BUILT POSTINGS

	Squiggly line for as-built deletion
	Double line for as-built deletion
	Text for as-built posting



STATE OF HAWAII
DEPARTMENT OF TRANSPORTATION
HIGHWAYS DIVISION
PLAN AND PROFILE
EMERGENCY ESCAPE RAMP
STA. 11+00 TO STA. 15+91.29
HALEAKALA HIGHWAY WIDENING, PHASE 2
HANA HIGHWAY TO PUKALANI BYPASS
FED. AID PROJ. NO. NH-037-1(24)
SCALE: AS NOTED DATE: MAY, 2005
SHEET No. 2 OF 2 SHEETS

THIS WORK WAS PREPARED BY ME OR UNDER MY SUPERVISION.
Eric W. S. Hee
ENGINEERS SURVEYORS HAWAII, INC.
LICENSE EXPIRATION DATE: 4/30/04
20+00

ORIGINAL PLAN	DATE
DESIGNED BY	
TRACED BY	
DESIGNED BY	
QUANTITIES BY	
CHECKED BY	
No.	

\\Esh-1\enr\Engineering\Projects\1994\1994-05\Haleakala Hwy\Phase 2 - AS-BUILT\PLAN\PHASE 2 - AS-BUILT\Plan 59-AS-BUILT Ramp Widen, Nov 25 2009 - 5:31pm

AS-BUILT