

SUMMARY OF ESTIMATED QUANTITIES


ITEM NO.	CONTRACT ITEM	QUANTITY	UNIT
202.0500	REMOVAL OF HEADWALLS AT EXISTING CULVERT FOR WATERWAY STRUCTURE NO. 3	L.S.	L.S.
202.0501	REMOVAL OF HEADWALLS AT EXISTING CULVERT FOR WATERWAY STRUCTURE NO. 4	L.S.	L.S.
202.0601	REMOVAL OF EXISTING WING WALL AT EXISTING HAIKU CULVERT NO. 1	L.S.	L.S.
202.0603	REMOVAL OF EXISTING WING WALL AT EXISTING LOWRIE BRIDGE NO. 3	L.S.	L.S.
202.0604	REMOVAL OF EXISTING WING WALL AT EXISTING KAUIHIKOA CULVERT NO. 4	L.S.	L.S.
206.6001	STRUCTURE EXCAVATION FOR WATERWAY STRUCTURE NO. 1	L.S.	L.S.
206.6002	STRUCTURE EXCAVATION FOR WATERWAY STRUCTURE NO. 2	L.S.	L.S.
206.6003	STRUCTURE EXCAVATION FOR WATERWAY STRUCTURE NO. 3	L.S.	L.S.
206.6004	STRUCTURE EXCAVATION FOR WATERWAY STRUCTURE NO. 4	L.S.	L.S.
206.6101	STRUCTURE EXCAVATION FOR NEW RETROFIT CONCRETE END POST FOR EXISTING HAIKU CULVERT NO. 1	L.S.	L.S.
206.6103	STRUCTURE EXCAVATION FOR NEW RETROFIT CONCRETE END POST FOR EXISTING LOWRIE BRIDGE NO. 3	L.S.	L.S.
206.6104	STRUCTURE EXCAVATION FOR NEW RETROFIT CONCRETE END POST FOR EXISTING KAUIHIKOA CULVERT NO. 4	L.S.	L.S.
206.7201	STRUCTURE BACKFILL FOR WATERWAY STRUCTURE NO. 1	L.S.	L.S.
206.7202	STRUCTURE BACKFILL FOR WATERWAY STRUCTURE NO. 2	L.S.	L.S.
206.7203	STRUCTURE BACKFILL FOR WATERWAY STRUCTURE NO. 3	L.S.	L.S.
206.7204	STRUCTURE BACKFILL FOR WATERWAY STRUCTURE NO. 4	L.S.	L.S.
206.7301	STRUCTURE BACKFILL FOR NEW RETROFIT CONCRETE END POST FOR EXISTING HAIKU CULVERT NO. 1	L.S.	L.S.
206.7303	STRUCTURE BACKFILL FOR NEW RETROFIT CONCRETE END POST FOR EXISTING LOWRIE BRIDGE NO. 3	L.S.	L.S.
206.7304	STRUCTURE BACKFILL FOR NEW RETROFIT CONCRETE END POST FOR EXISTING KAUIHIKOA CULVERT NO. 4	L.S.	L.S.
503.1091	CONCRETE IN WATERWAY STRUCTURE NO. 1	L.S.	L.S.
503.1092	CONCRETE IN WATERWAY STRUCTURE NO. 2	L.S.	L.S.
503.1093	CONCRETE IN WATERWAY STRUCTURE NO. 3	L.S.	L.S.
503.1094	CONCRETE IN WATERWAY STRUCTURE NO. 4	L.S.	L.S.
503.6001	CONCRETE IN NEW RETROFIT CONCRETE END POST FOR EXISTING HAIKU CULVERT NO. 1	L.S.	L.S.
503.6003	CONCRETE IN NEW RETROFIT CONCRETE END POST FOR EXISTING LOWRIE BRIDGE NO. 3	L.S.	L.S.
503.6004	CONCRETE IN NEW RETROFIT CONCRETE END POST FOR EXISTING KAUIHIKOA CULVERT NO. 4	L.S.	L.S.
504.4501	12-INCHES PRESTRESSED PLANKS FOR WATERWAY STRUCTURE NO. 1	L.S.	L.S.
504.4502	12-INCHES PRESTRESSED PLANKS FOR WATERWAY STRUCTURE NO. 2	L.S.	L.S.
504.4503	18-INCHES PRESTRESSED PLANKS FOR WATERWAY STRUCTURE NO. 3	L.S.	L.S.
504.4504	10-INCHES PRESTRESSED PLANKS FOR WATERWAY STRUCTURE NO. 4	L.S.	L.S.
507.0101	METAL RAILING FOR WATERWAY STRUCTURE NO. 1	L.S.	L.S.
507.0102	METAL RAILING FOR WATERWAY STRUCTURE NO. 2	L.S.	L.S.
507.0103	METAL RAILING FOR WATERWAY STRUCTURE NO. 3	L.S.	L.S.
507.0104	METAL RAILING FOR WATERWAY STRUCTURE NO. 4	L.S.	L.S.
507.0201	METAL BIKE RAILING FOR EXISTING HAIKU CULVERT NO. 1	L.S.	L.S.
507.0203	METAL BIKE RAILING FOR EXISTING LOWRIE BRIDGE NO. 3	L.S.	L.S.
507.0204	METAL BIKE RAILING FOR EXISTING KAUIHIKOA CULVERT NO. 4	L.S.	L.S.
507.1003	CONCRETE PARAPET BUILD-UP FOR EXISTING LOWRIE BRIDGE NO. 3	L.S.	L.S.
507.7101	CONCRETE PARAPET FOR WATERWAY STRUCTURE NO. 1 (INCLUDING END POST)	L.S.	L.S.
507.7102	CONCRETE PARAPET FOR WATERWAY STRUCTURE NO. 2 (INCLUDING END POST)	L.S.	L.S.
507.7103	CONCRETE PARAPET FOR WATERWAY STRUCTURE NO. 3 (INCLUDING END POST)	L.S.	L.S.
507.7104	CONCRETE PARAPET FOR WATERWAY STRUCTURE NO. 4 (INCLUDING END POST)	L.S.	L.S.
602.0091	REINFORCING STEEL FOR WATERWAY STRUCTURE NO. 1	L.S.	L.S.
602.0092	REINFORCING STEEL FOR WATERWAY STRUCTURE NO. 2	L.S.	L.S.
602.0093	REINFORCING STEEL FOR WATERWAY STRUCTURE NO. 3	L.S.	L.S.
602.0094	REINFORCING STEEL FOR WATERWAY STRUCTURE NO. 4	L.S.	L.S.
602.1091	REINFORCING STEEL FOR NEW RETROFIT CONCRETE END POST FOR EXISTING HAIKU CULVERT NO. 1	L.S.	L.S.
602.1093	REINFORCING STEEL FOR NEW RETROFIT CONCRETE END POST FOR EXISTING LOWRIE BRIDGE NO. 3	L.S.	L.S.
602.1094	REINFORCING STEEL FOR NEW RETROFIT CONCRETE END POST FOR EXISTING KAUIHIKOA CULVERT NO. 4	L.S.	L.S.
606.9001	GUARDRAIL TYPE "A" FOR EXISTING HAIKU CULVERT NO. 1	L.S.	L.S.
606.9002	GUARDRAIL TYPE "B" FOR EXISTING BOX CULVERT NO. 2	L.S.	L.S.
606.9003	GUARDRAIL TYPE "C" FOR EXISTING LOWRIE BRIDGE NO. 3	L.S.	L.S.

FED. ROAD DIST. NO.	STATE	FED. AID PROJ. NO.	FISCAL YEAR	SHEET NO.	TOTAL SHEETS
HAWAII	HAW.	NH-037-1(24)	2005	234	288

INDEX TO DRAWINGS

DRAW NO.	DESCRIPTION
S-1	INDEX TO DRAWINGS, SUMMARY OF ESTIMATED QUANTITIES
S-2	STRUCTURAL NOTES, ABBREVIATIONS
S-3	WATERWAY STRUCTURE NO. 1 - BRIDGE LAYOUT PLAN, CROSS SECTION
S-4	WATERWAY STRUCTURE NO. 1 - FOUNDATION / FRAMING PLAN, SLAB ELEVATION PLAN, LONGITUDINAL SECTION / ELEVATION
S-5	WATERWAY STRUCTURE NO. 2 - BRIDGE LAYOUT PLAN, CROSS SECTION, LONGITUDINAL SECTION / ELEVATION
S-6	WATERWAY STRUCTURE NO. 2 - FOUNDATION / FRAMING PLAN, SLAB ELEVATION PLAN
S-7	WATERWAY STRUCTURE NO. 3 - BRIDGE LAYOUT PLAN, LONGITUDINAL SECTION / ELEVATION
S-8	WATERWAY STRUCTURE NO. 3 - FOUNDATION / FRAMING PLAN, SLAB ELEVATION PLAN, CROSS SECTION
S-9	WATERWAY STRUCTURE NO. 4 - BRIDGE LAYOUT PLAN, LONGITUDINAL SECTION / ELEVATION, CROSS SECTION
S-10	WATERWAY STRUCTURE NO. 4 - FOUNDATION / FRAMING PLAN, SLAB ELEVATION PLAN
S-11	TYPICAL BRIDGE FOUNDATION / FRAMING PLAN
S-12	FOUNDATION AND FRAMING DETAILS
S-13	PRESTRESSED PLANK DETAILS
S-14	PRESTRESSED PLANK DETAILS, METAL RAILING DETAILS
S-15	END POST DETAILS
S-16	EXISTING WATERWAY STRUCTURE NO. 1 - LAYOUT PLAN
S-17	EXISTING WATERWAY STRUCTURE NO. 2 - LAYOUT PLAN
S-18	EXISTING WATERWAY STRUCTURE NO. 3 - LAYOUT PLAN
S-19	EXISTING WATERWAY STRUCTURE NO. 4 - LAYOUT PLAN
S-20	GUARDRAIL TYPE "A" AND TYPE "B" DETAILS
S-21	METAL BIKE RAILING DETAIL
S-22	GUARDRAIL TYPE "C" DETAILS
S-23	GUARDRAIL DETAILS
S-24	GUARDRAIL DETAILS
S-25	RETROFIT CONCRETE END POST DETAILS
S-26	RETROFIT CONCRETE END POST DETAILS

DATE	_____
SURVEY PLOTTED BY	_____
DRAWN BY	_____
TRACED BY	_____
DESIGNED BY	_____
CHECKED BY	_____
ORIGINAL PLAN	_____
NOTE BOOK	_____
No.	_____

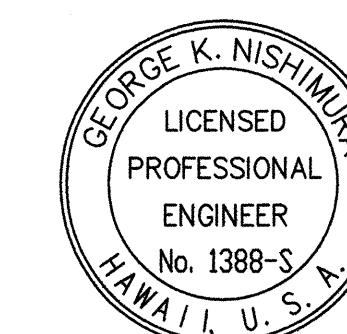

THIS WORK WAS PREPARED BY ME OR UNDER MY SUPERVISION.
 SIGNATURE
 04/30/06
 EXPIRATION DATE OF PROFESSIONAL LICENSE

STATE OF HAWAII
 DEPARTMENT OF TRANSPORTATION
 HIGHWAYS DIVISION

INDEX TO DRAWINGS, SUMMARY OF ESTIMATED QUANTITIES

HALEAKALA HIGHWAY WIDENING, PHASE 2
 HANA HIGHWAY TO PUKALANI BYPASS
 FED. AID PROJ. NO. NH-037-1(24)

SCALE: AS NOTED DATE: MAY 2005


SHEET No. S-1 OF 26 SHEETS

STRUCTURAL NOTES

FED.ROAD DIST.NO.	STATE	FED. AID PROJ. NO.	FISCAL YEAR	SHEET NO.	TOTAL SHEETS
HAWAII	HAW.	NH-037-1(24)	2005	235	288

- GENERAL SPECIFICATIONS: HAWAII STANDARD SPECIFICATIONS FOR ROAD, BRIDGE, AND PUBLIC WORKS CONSTRUCTION, 1994, TOGETHER WITH SPECIAL PROVISIONS PREPARED FOR THIS CONTRACT.
- DESIGN SPECIFICATIONS: AASHTO LRFD BRIDGE DESIGN SPECIFICATIONS, 2ND EDITION, 1998, INCLUDING SUBSEQUENT INTERIM REVISIONS.
- LOADS:
 - DEAD LOADS:
 - AN ALLOWANCE OF 25 PSF (FROM CURB-TO-CURB) HAS BEEN PROVIDED FOR IN THE DESIGN FOR FUTURE WEARING SURFACE.
 - AN ALLOWANCE OF 150 PLF (AT EACH SIDE OF THE BRIDGE) HAS BEEN PROVIDED FOR IN THE DESIGN FOR FUTURE UTILITIES.
 - LIVE LOAD: HL-93
 - SEISMIC LOAD:
 - ACCELERATION COEFFICIENT = 0.26
 - SEISMIC PERFORMANCE ZONE = 3
 - IMPORTANCE CATEGORY = CRITICAL BRIDGE
 - SOIL PROFILE TYPE I (S = 1.0)
 - RAILING TEST LEVEL = TL-4
- MATERIALS:
 - MINIMUM CONCRETE COMPRESSIVE STRENGTH (AT 28 DAYS):
 - ALL CONCRETE (EXCEPT PRESTRESSED PLANKS) = 4,000 PSI
 - ALL REINFORCING STEEL SHALL CONFORM TO ASTM A615, GRADE 60, UNLESS NOTED OTHERWISE.
 - TETRAGUARD AS20 SHRINKAGE REDUCING ADMIXTURE, ECLIPSE PLUS SHRINKAGE REDUCING ADMIXTURE, OR AN APPROVED EQUAL, SHALL BE INCLUDED IN THE CONCRETE MIX (EXCEPT THE CONCRETE MIX FOR THE PRESTRESSED PLANKS). THE REQUIRED DOSAGE SHALL BE 96 OUNCES PER CUBIC YARD OF CONCRETE OR AS RECOMMENDED BY THE ADMIXTURE MANUFACTURER. ADDITION OF THE SHRINKAGE REDUCING ADMIXTURE SHALL BE AS RECOMMENDED BY THE ADMIXTURE MANUFACTURER.
 - FOR MATERIALS OF PRESTRESSED PLANKS, SEE APPLICABLE PRESTRESSED PLANK NOTES.
 - THRU BOLTS FOR GUARDRAIL CONNECTION TO END POST SHALL CONFORM TO AASHTO M164 (ASTM A325), UNLESS OTHERWISE NOTED.
 - ALL STRUCTURAL STEEL SHALL CONFORM TO ASTM A36 AND BE HOT-DIP GALVANIZED AFTER FABRICATION.
 - METAL THRIE BEAM, TERMINAL CONNECTOR, BACKUP PLATE AND TRANSITION SECTION SHALL BE FABRICATED FROM 10 GAGE STEEL, HOT-DIP GALVANIZED AFTER FABRICATION AND CONFORM TO THE REQUIREMENTS OF AASHTO M180.
 - W6X25 METAL POSTS AND PLATE SHALL BE HOT-DIP GALVANIZED AFTER FABRICATION.
 - ALL WELDING SHALL BE IN ACCORDANCE WITH THE LATEST EDITION OF AWS D1.1 "STRUCTURAL WELDING CODE". WELDS SHALL HAVE A MINIMUM ULTIMATE STRENGTH OF 70,000 PSI.
 - ALL ANCHOR BOLTS, WASHERS AND NUTS SHALL BE ASTM A325, TYPE I, HOT-DIP GALVANIZED AFTER FABRICATION, UNLESS OTHERWISE NOTED.
 - ALL THREADED RODS SHALL BE ASTM A449, TYPE I, HOT-DIP GALVANIZED AFTER FABRICATION, UNLESS OTHERWISE NOTED.
 - EPOXY ADHESIVE SHALL BE "CLASS VAL" OR "DOUBLE CARTRIDGE" TYPE. EPOXIES THAT REQUIRE MANUAL MEASURING OR MIXING WILL NOT BE ALLOWED. EPOXY SHALL MEET THE REQUIREMENTS OF ASTM C881, TYPE IV, GRADE 3, CLASS C.
 - A CORROSION INHIBITING ADMIXTURE SHALL BE INCLUDED IN THE CONCRETE MIX FOR THE PRESTRESSED PLANKS. THE CORROSION INHIBITING ADMIXTURE SHALL CONTAIN A MINIMUM OF 30% CALCIUM NITRITE BY MASS AND SHALL BE ADDED AT A DOSAGE RATE OF 4.0 GALLONS PER CUBIC YARD OF CONCRETE. THE ADMIXTURE SHALL BE RHEOCRETE CNI CALCIUM NITRITE-BASED CORROSION INHIBITOR, DCI S CORROSION INHIBITOR, OR AN APPROVED EQUAL. ADDITION OF CORROSION INHIBITING ADMIXTURE SHALL BE AS RECOMMENDED BY THE MANUFACTURER.
 - REINFORCING STEEL TO BE WELDED SHALL CONFORM TO ASTM A706, GRADE 60.
- REINFORCEMENT:
 - UNLESS OTHERWISE NOTED, THE COVERING MEASURED FROM THE SURFACE OF THE CONCRETE TO THE FACE OF ANY REINFORCING BARS SHALL BE AS FOLLOWS:
 - DECK TOP BARS = 2" CLEAR (WITH TOLERANCES OF -0 INCH AND +3/8 INCH)
 - PARAPETS, END POSTS, AND CURBS = 2" CLEAR
 - FORMED SURFACES EXPOSED TO EARTH AND WEATHER = 2" CLEAR
 - BOTTOM AND SIDES OF FOOTINGS AND WHERE CONCRETE IS DEPOSITED ON GRADE = 3" CLEAR
 - BOTTOM OF PRESTRESSED PLANKS = 1" CLEAR (WITH TOLERANCE OF -0 INCH)
 - MINIMUM CLEAR SPACING BETWEEN PARALLEL BARS SHALL BE 1-1/2 TIMES THE DIAMETER OF THE BAR (FOR NON BUNDLED BARS) OR 1-1/2 TIMES THE DIAMETER DERIVED FROM THE EQUIVALENT TOTAL AREA OF THE BARS (FOR BUNDLED BARS), BUT IN NO CASE SHALL THE CLEAR DISTANCE BETWEEN THE PARALLEL BARS BE LESS THAN 1-1/2 TIMES THE MAXIMUM SIZE OF THE COARSE AGGREGATE OR 1-1/2 INCHES.
 - ALL DIMENSIONS RELATING TO REINFORCING BARS (E.G., SPACING OF BARS, ETC.) ARE TO CENTER OF BARS, UNLESS OTHERWISE NOTED.
 - REINFORCING BARS SHALL BE DETAILED IN ACCORDANCE WITH AASHTO LRFD BRIDGE DESIGN SPECIFICATIONS, 2ND EDITION, 1998, INCLUDING SUBSEQUENT INTERIM REVISIONS, UNLESS OTHERWISE NOTED.
 - REINFORCING BARS SHALL BE SECURELY TIED AT ALL INTERSECTIONS AND LAP SPLICES EXCEPT WHERE THE SPACING OF THE INTERSECTIONS IS LESS THAN 12 INCHES IN EACH DIRECTION, IN WHICH CASE ALTERNATE INTERSECTIONS SHALL BE TIED.

- GENERAL CONSTRUCTION NOTES:
 - SEE STANDARD SPECIFICATIONS AND SPECIAL PROVISIONS.
 - ALL ITEMS NOTED INCIDENTAL WILL NOT BE PAID FOR SEPARATELY.
 - STANDARD DETAIL DRAWINGS REFER TO ALL STRUCTURES IN GENERAL, EXCEPT FOR MODIFICATIONS AS MAY BE REQUIRED FOR SPECIAL CONDITIONS. FOR SUCH MODIFICATIONS, REFER TO THE CORRESPONDING DETAILED DRAWINGS.
 - THE CONTRACTOR SHALL COMPLY WITH ALL CONSTRUCTION PERMITS FOR THIS PROJECT. IN ADDITION, THE CONTRACTOR SHALL COMPLY WITH ALL APPLICABLE LAWS OF THE FEDERAL, STATE AND COUNTY GOVERNMENTS.
 - UNLESS OTHERWISE NOTED, ALL VERTICAL DIMENSIONS ARE MEASURED PLUMB.
 - THE CONTRACTOR SHALL VERIFY ALL SITE CONDITIONS BEFORE COMMENCING WITH WORK.
 - THE CONTRACTOR SHALL VERIFY THE LOCATION OF ALL UNDERGROUND UTILITY LINES AND NOTIFY THE RESPECTIVE OWNERS BEFORE COMMENCING THE WORK OF EXCAVATION.
 - FOR CONCRETE FINISH, SEE STANDARD SPECIFICATIONS.
 - UNLESS OTHERWISE NOTED, ALL EXPOSED CONCRETE EDGES SHALL BE CHAMFERED 3/4" X 3/4".
 - THE CONTRACTOR SHALL TAKE PRECAUTIONARY MEASURES TO PROTECT THE EXISTING CONCRETE DITCHES DURING CONSTRUCTION OF THE NEW WATERWAY STRUCTURES. ANY DAMAGE TO THE EXISTING CONCRETE DITCHES SHALL BE REPAIRED AT NO COST TO THE STATE.
 - ALL CUT REINFORCING BARS DURING REMOVAL OF EXISTING CONCRETE SHALL BE BURNT BACK AND COATED WITH EPOXY.
 - THE CONTRACTOR SHALL VERIFY DIMENSIONS OF THE EXISTING STRUCTURE BEFORE COMMENCING WITH WORK.
- PRESTRESSED PLANK BEARING SURFACE:
 - PRESTRESSED PLANK BEARING SURFACE SHALL BE SMOOTH AND SLOPED TO MATCH THE FINISH ROADWAY SLOPE.
 - PRESTRESSED PLANKS SHALL BE SET ON A FRESH LAYER OF MORTAR TO INSURE FULL BEARING.
 - PRESTRESSED PLANK SHELF ELEVATIONS SHALL BE DETERMINED BY THE CONTRACTOR. SHELF ELEVATIONS SHALL TAKE INTO CONSIDERATION THE CONCRETE TOPPING THICKNESS, PRESTRESSED PLANK THICKNESS, ROADWAY SLOPE, AND THE CALCULATED, OR IF AVAILABLE, THE ACTUAL CAMBER OF THE PRESTRESSED PLANKS.
- INSTALLATION OF GUARDRAIL AT EXISTING STRUCTURES:
 - THE CONTRACTOR SHALL VERIFY THE LOCATION AND DIMENSIONS OF THE EXISTING STRUCTURE PRIOR TO INSTALLATION OF GUARDRAIL POSTS (GUARDRAIL TYPE "A" AND "B").
 - REINFORCING BARS IN THE EXISTING STRUCTURE SHALL NOT BE CUT OR DAMAGED DURING DRILLING OPERATIONS FOR CONCRETE CURB REINFORCING BARS (GUARDRAIL TYPE "C"). THE NEW CONCRETE CURB REINFORCING BARS SHALL BE OFFSET AS REQUIRED TO AVOID THE EXISTING REINFORCING BARS.
 - THE CONCRETE CURB REINFORCING BARS SHALL BE PLACED SUCH THAT THEY WILL NOT INTERFERE WITH THE DRILLING AND EPOXY PLACEMENT OF THE GUARDRAIL POST ANCHOR BOLTS (GUARDRAIL TYPE "C").
- FOUNDATION:
 - THESE FOUNDATION NOTES WERE BASED ON RECOMMENDATIONS CONTAINED IN A GEOTECHNICAL ENGINEERING EXPLORATION REPORT BY ERNEST K. HIRATA & ASSOCIATES, INC. DATED JANUARY 24, 2000. THE REPORT SHALL BE CONSIDERED AS PART OF THE CONSTRUCTION DOCUMENTS AND ITS RECOMMENDATIONS SHALL BE IMPLEMENTED UNLESS OTHERWISE DIRECTED BY THE GEOTECHNICAL ENGINEER. THE CONTRACTOR MAY OBTAIN A COPY OF THE REPORT AT THE STATE OF HAWAII, DEPARTMENT OF TRANSPORTATION - HIGHWAYS DIVISION UPON REQUEST.
 - SOIL DESIGN PARAMETERS:
 - HORIZONTAL EARTH PRESSURE:
 - FREESTANDING (ACTIVE) = 40 PCF
 - RESTRAINED (AT-REST) = 55 PCF
 - PASSIVE EARTH PRESSURE = 300 PCF (3,000 PSF MAXIMUM)
 - COEFFICIENT OF FRICTION:
 - STRENGTH LIMIT STATE = 0.40
 - EXTREME EVENT LIMIT STATE = 0.50
 - ALLOWABLE SOIL BEARING PRESSURE:
 - STRENGTH LIMIT STATE = 4,500 PSF
 - EXTREME EVENT LIMIT STATE = 7,500 PSF
 - DYNAMIC LATERAL EARTH PRESSURE:
 - SOIL UNIT WEIGHT = 110 PCF
 - FRICTION ANGLE = 28-DEGREES
 - STRUCTURAL BACKFILL:
 - STRUCTURAL BACKFILL SHALL BE IN ACCORDANCE WITH THE REQUIREMENTS FOR STRUCTURE BACKFILL MATERIAL AS INDICATED IN SECTION 703.20 OF THE HAWAII STANDARD SPECIFICATIONS FOR ROAD, BRIDGE, AND PUBLIC WORKS CONSTRUCTION, 1994 AND THE SPECIAL PROVISIONS.
 - PLACEMENT OF THE STRUCTURAL BACKFILL SHALL BE IN ACCORDANCE WITH THE STANDARD SPECIFICATIONS AND THE SPECIAL PROVISIONS.

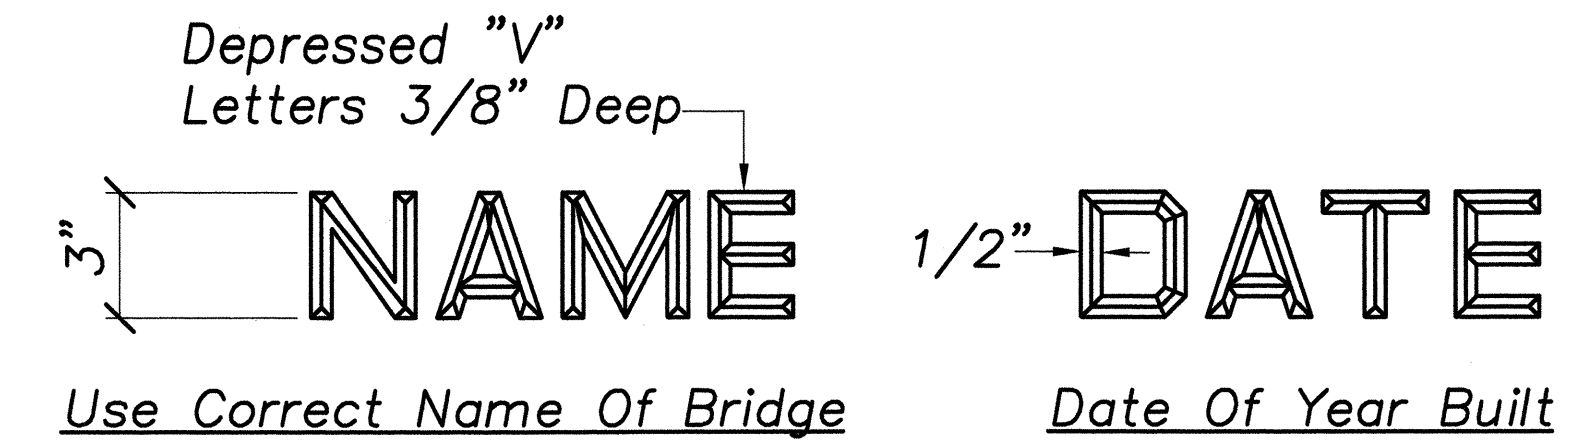


- Note:
- Name And Date Shall Be Placed At The Trailing End Post On Each Side Of The Roadway.
 - Exact Details And Spacing Of Letters And Figures And Location Shall Be As Directed By The Engineer. Gothic Letters And Figures Approximating Dimensions Shown Will Be Acceptable If Approved By The Engineer.

TYPICAL DETAIL OF LETTERS AND FIGURES AT CONCRETE END POST
Not To Scale

ABBREVIATIONS

♦	DIAMETER	LB., LBS.	POUND, POUNDS
#	NUMBER OR POUND	L.F.	LINEAR FEET
A.B.	ANCHOR BOLT	L.S.	LUMP SUM
A.C.	ASPHALT CONCRETE	MAX.	MAXIMUM
AZ.	AZIMUTH	MIN.	MINIMUM
BOT., BOTT., B	BOTTOM	NO., #	NUMBER
C.J.	CONSTRUCTION JOINT	N.F.	NEAR FACE
CL	CENTERLINE	N.T.S.	NOT TO SCALE
C.G.	CENTER OF GRAVITY		
CLR., CL.	CLEAR	O.C.	ON CENTER
CONC.	CONCRETE	PCF	POUNDS PER CUBIC FEET
CONT.	CONTINUOUS	PL., P	PLATE
C.Y.	CUBIC YARD	PSF	POUNDS PER SQUARE FEET
DBL.	DOUBLE	PSI	POUNDS PER SQUARE INCH
DET.	DETAIL	PVC.	POLYVINYL CHLORIDE
D.I.	DUCTILE IRON		
DIA.	DIAMETER	R. RAD.	RADIUS
DN.	DOWN	REBAR	REINFORCING BAR
DWG.	DRAWING	REF.	REFERENCE
E.F.	EACH FACE	REINF.	REINFORCED, REINFORCING, REINFORCEMENT
E.J.	EXPANSION JOINT	R.O.W.	RIGHT-OF-WAY
ELEV., EL.	ELEVATION		
E.W.	EACH WAY	SHT.	SHEET
EXP.	EXPANSION	SL.	SLOPE
F.B.	FLAT BAR	STA.	STATION
F.F.	FAR FACE	STD.	STANDARD
G	GIRDER	STIRR.	STIRRUP
GALV.	GALVANIZED	SYM., SYMM.	SYMMETRICAL
G.J.	GROOVED JOINT	S.S.	STAINLESS STEEL
HORIZ., H	HORIZONTAL	THK., TH.	THICK
IN.	INCH	TYP.	TYPICAL
JT.	JOINT	VERT., V	VERTICAL
K	KIPS	W/	WITH
KSI	KIPS PER SQUARE INCH		

SUBMITTALS PLOTTED BY: _____ DATE: _____
 DRAWN BY: _____
 DESIGNED BY: _____
 CHECKED BY: _____
 ORIGINAL PLAN NO. _____

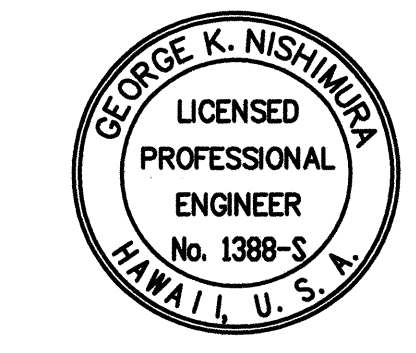

THIS WORK WAS PREPARED BY ME OR UNDER MY SUPERVISION.
 SIGNATURE
 04/30/06
 EXPIRATION DATE OF PROFESSIONAL LICENSE


STATE OF HAWAII
 DEPARTMENT OF TRANSPORTATION
 HIGHWAYS DIVISION
STRUCTURAL NOTES

HALEAKALA HIGHWAY WIDENING, PHASE 2
 HANA HIGHWAY TO PUKALANI BYPASS
 FED. AID PROJ. NO. NH-037-1(24)


SCALE: AS NOTED DATE: MAY 2005

SHEET No. 5-2 OF 26 SHEETS

FED. ROAD DIST. NO.	STATE	FED. AID PROJ. NO.	FISCAL YEAR	SHEET NO.	TOTAL SHEETS
HAWAII	HAW.	NH-037-1(24)	2005	236	288

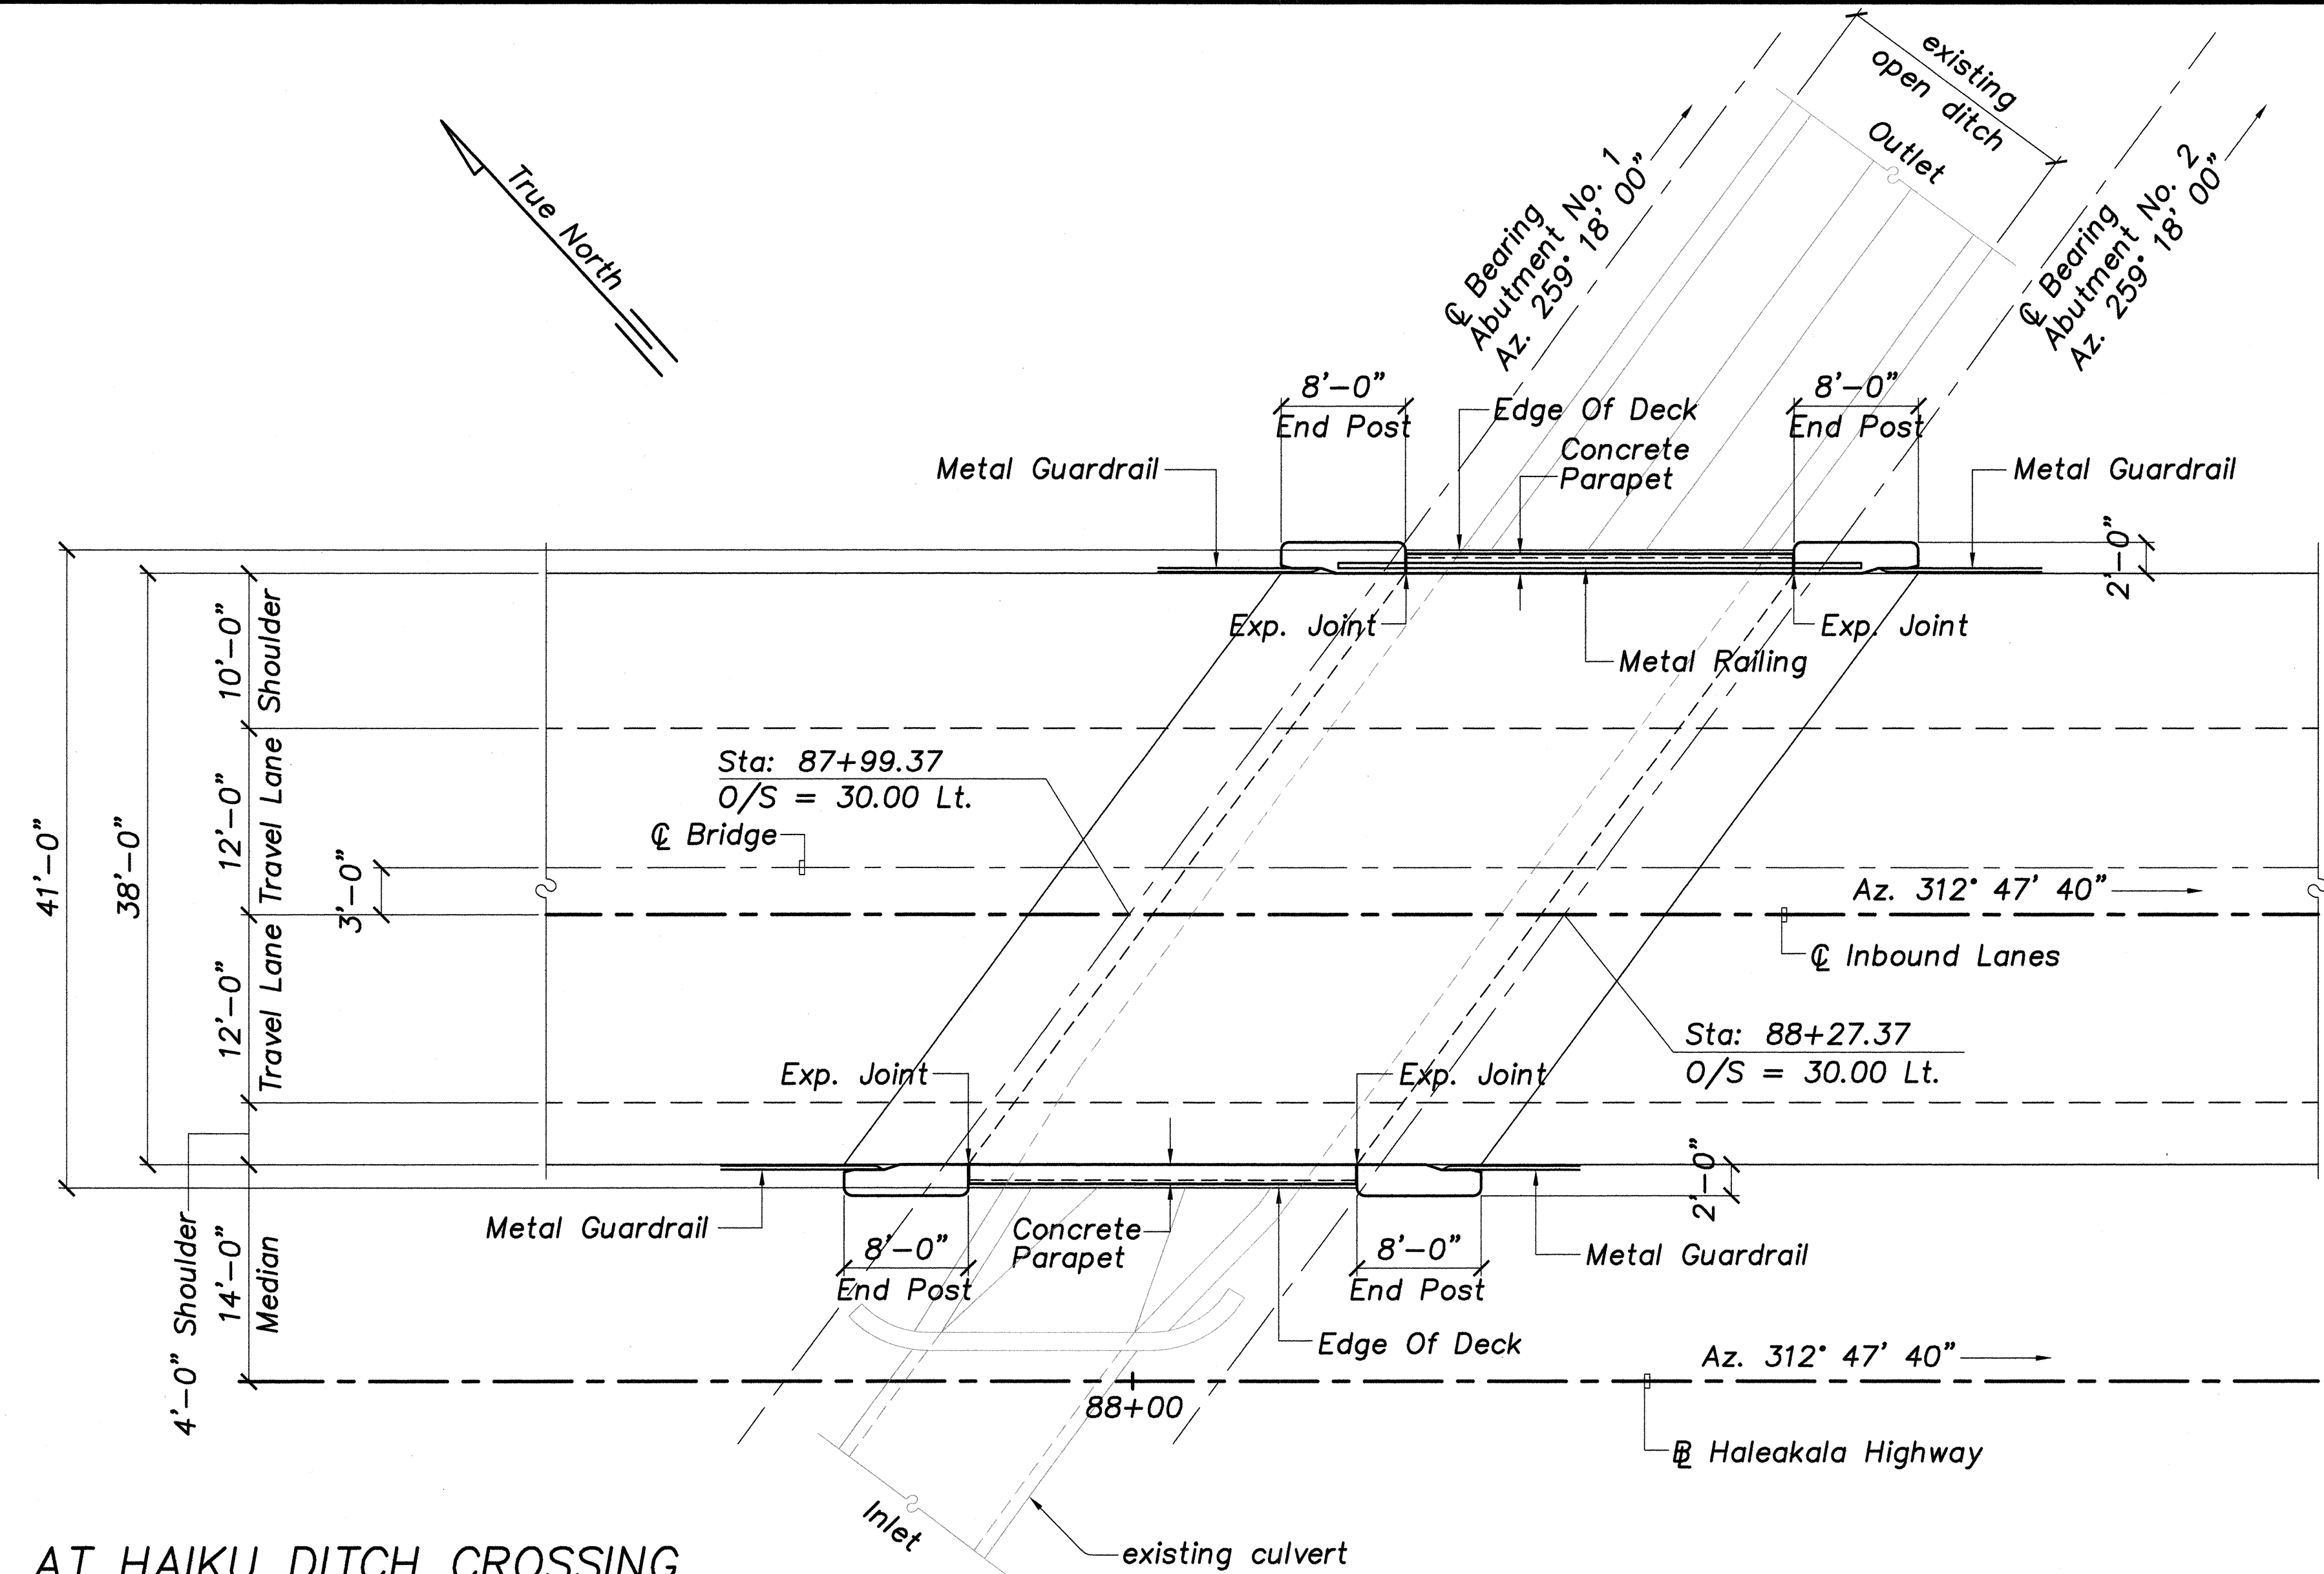


AT HAIKU DITCH CROSSING
WATERWAY STRUCTURE NO. 1 BRIDGE LAYOUT PLAN
 Scale: 1/8"=1'-0"

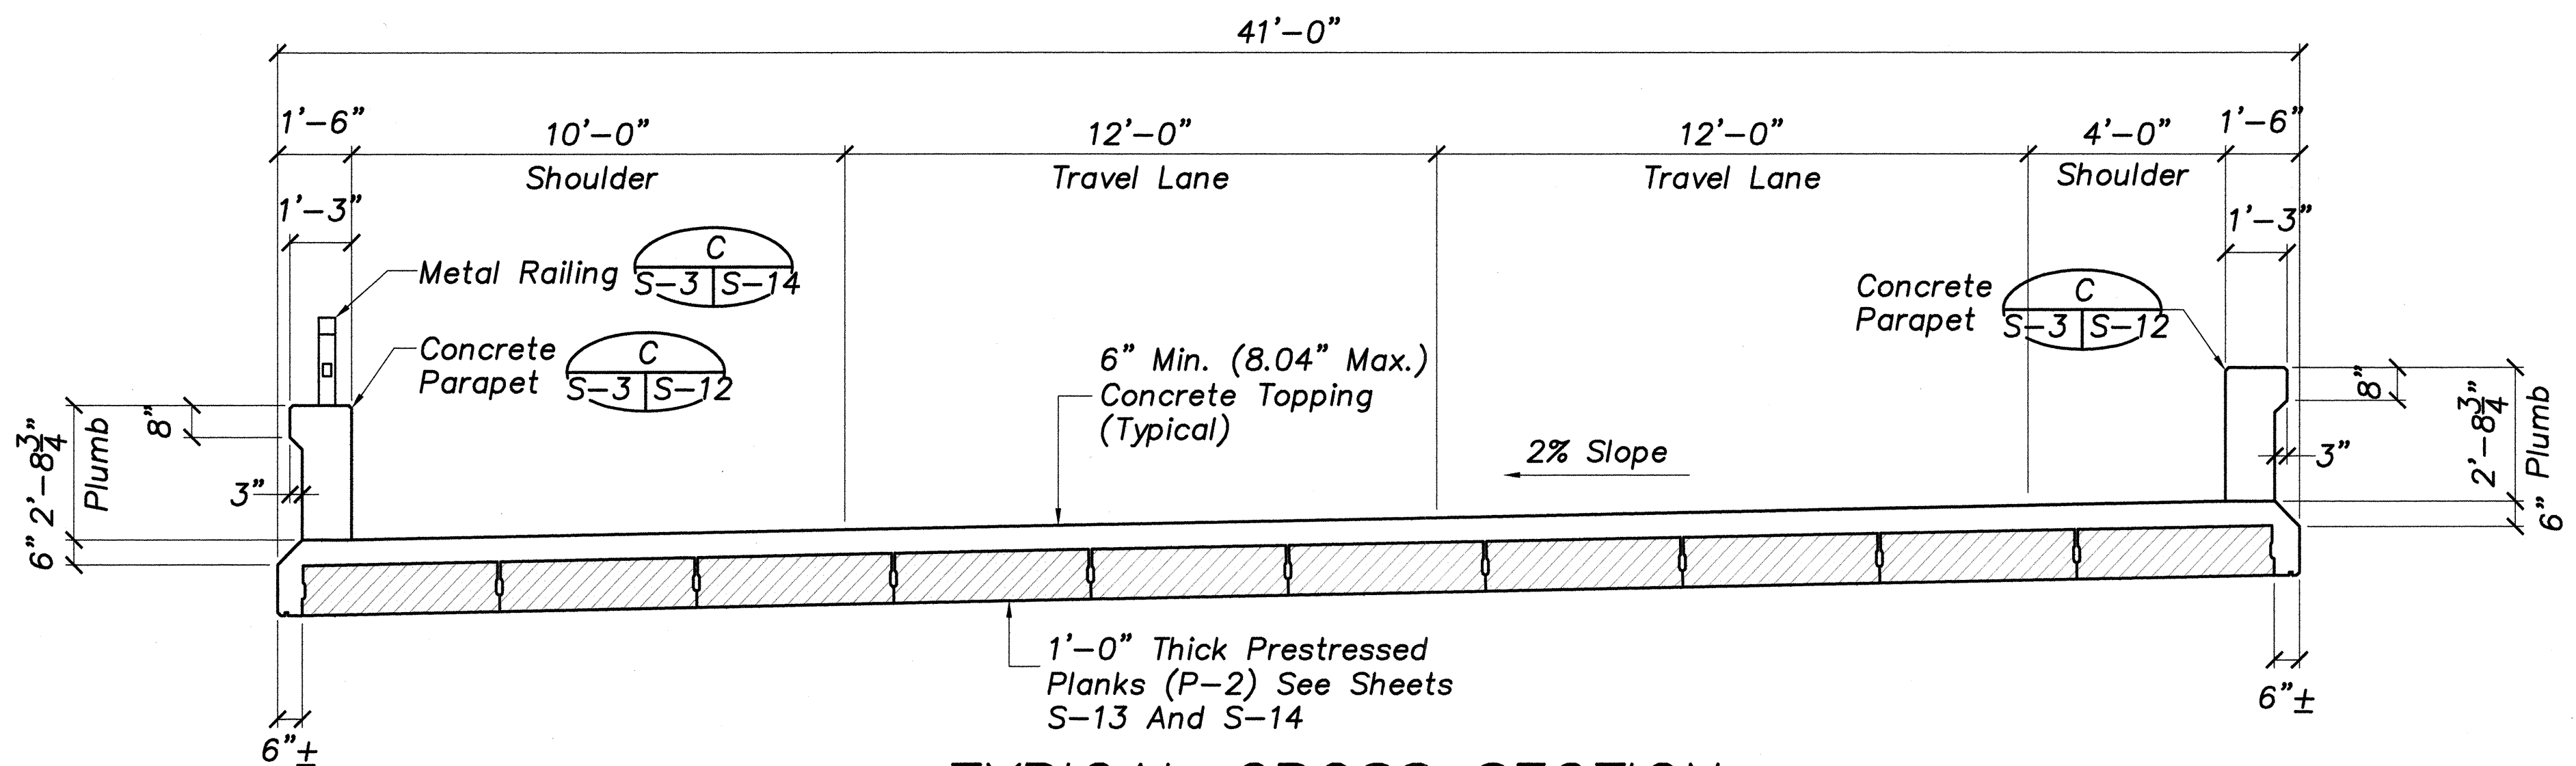

TYPICAL CROSS SECTION
 Scale: 3/8"=1'-0"

DATE	_____
SURVEY OBTAINED BY	_____
DRAWN BY	_____
DESIGNED BY	_____
CHECKED BY	_____
NO. _____	

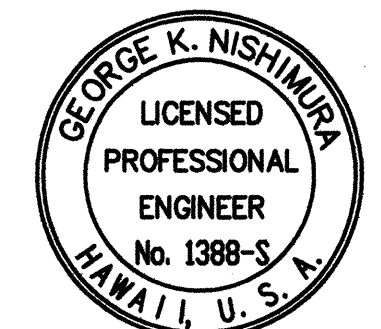

THIS WORK WAS PREPARED BY ME/US UNDER MY SUPERVISION.
 SIGNATURE
 04/30/06
 EXPIRATION DATE OF PROFESSIONAL LICENSE


STATE OF HAWAII
 DEPARTMENT OF TRANSPORTATION
 HIGHWAYS DIVISION
WATERWAY STRUCTURE NO. 1
 BRIDGE LAYOUT PLAN, CROSS SECTION

HALEAKALA HIGHWAY WIDENING, PHASE 2
 HANA HIGHWAY TO PUKALANI BYPASS
 FED. AID PROJ. NO. NH-037-1(24)

SCALE: AS NOTED DATE: MAY 2005


SHEET No. S-3 OF 26 SHEETS

FED. ROAD DIST. NO.	STATE	FED. AID PROJ. NO.	FISCAL YEAR	SHEET NO.	TOTAL SHEETS
HAWAII	HAW.	NH-037-1(24)	2005	237	288

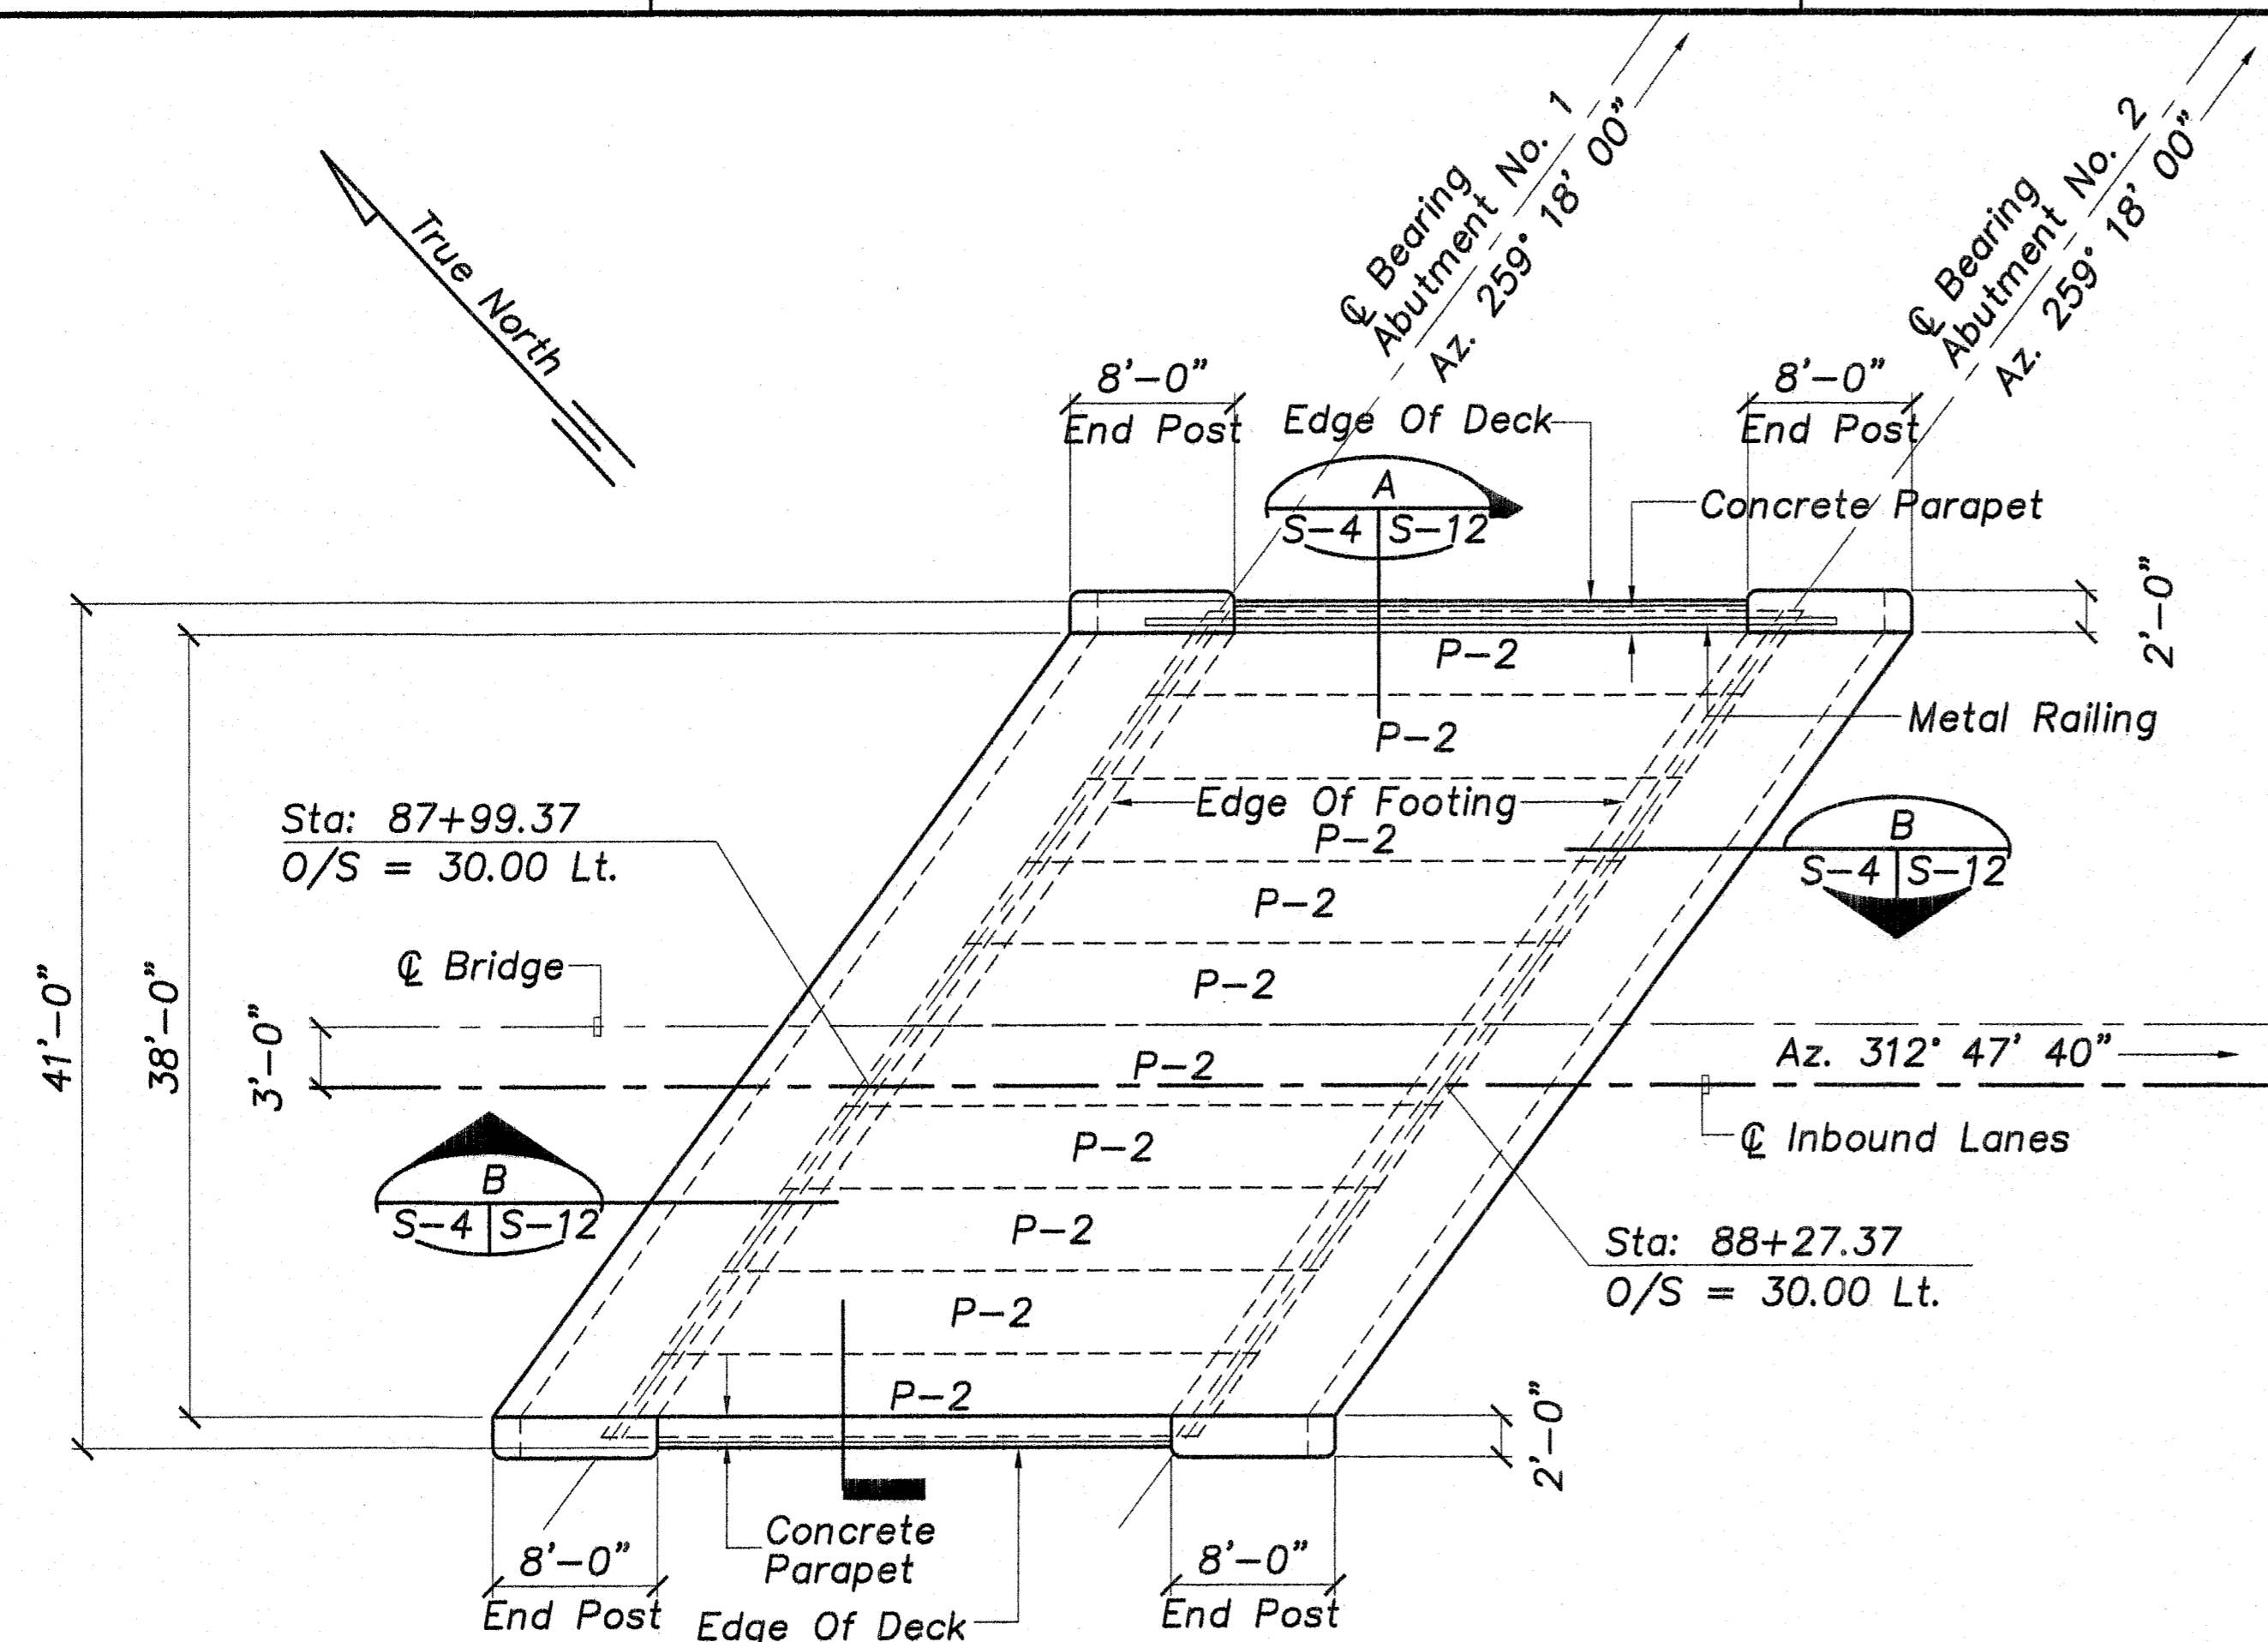


AT HAIKU DITCH CROSSING
 WATERWAY STRUCTURE NO. 1 FOUNDATION / FRAMING PLAN

Scale: 1/8"=1'-0"

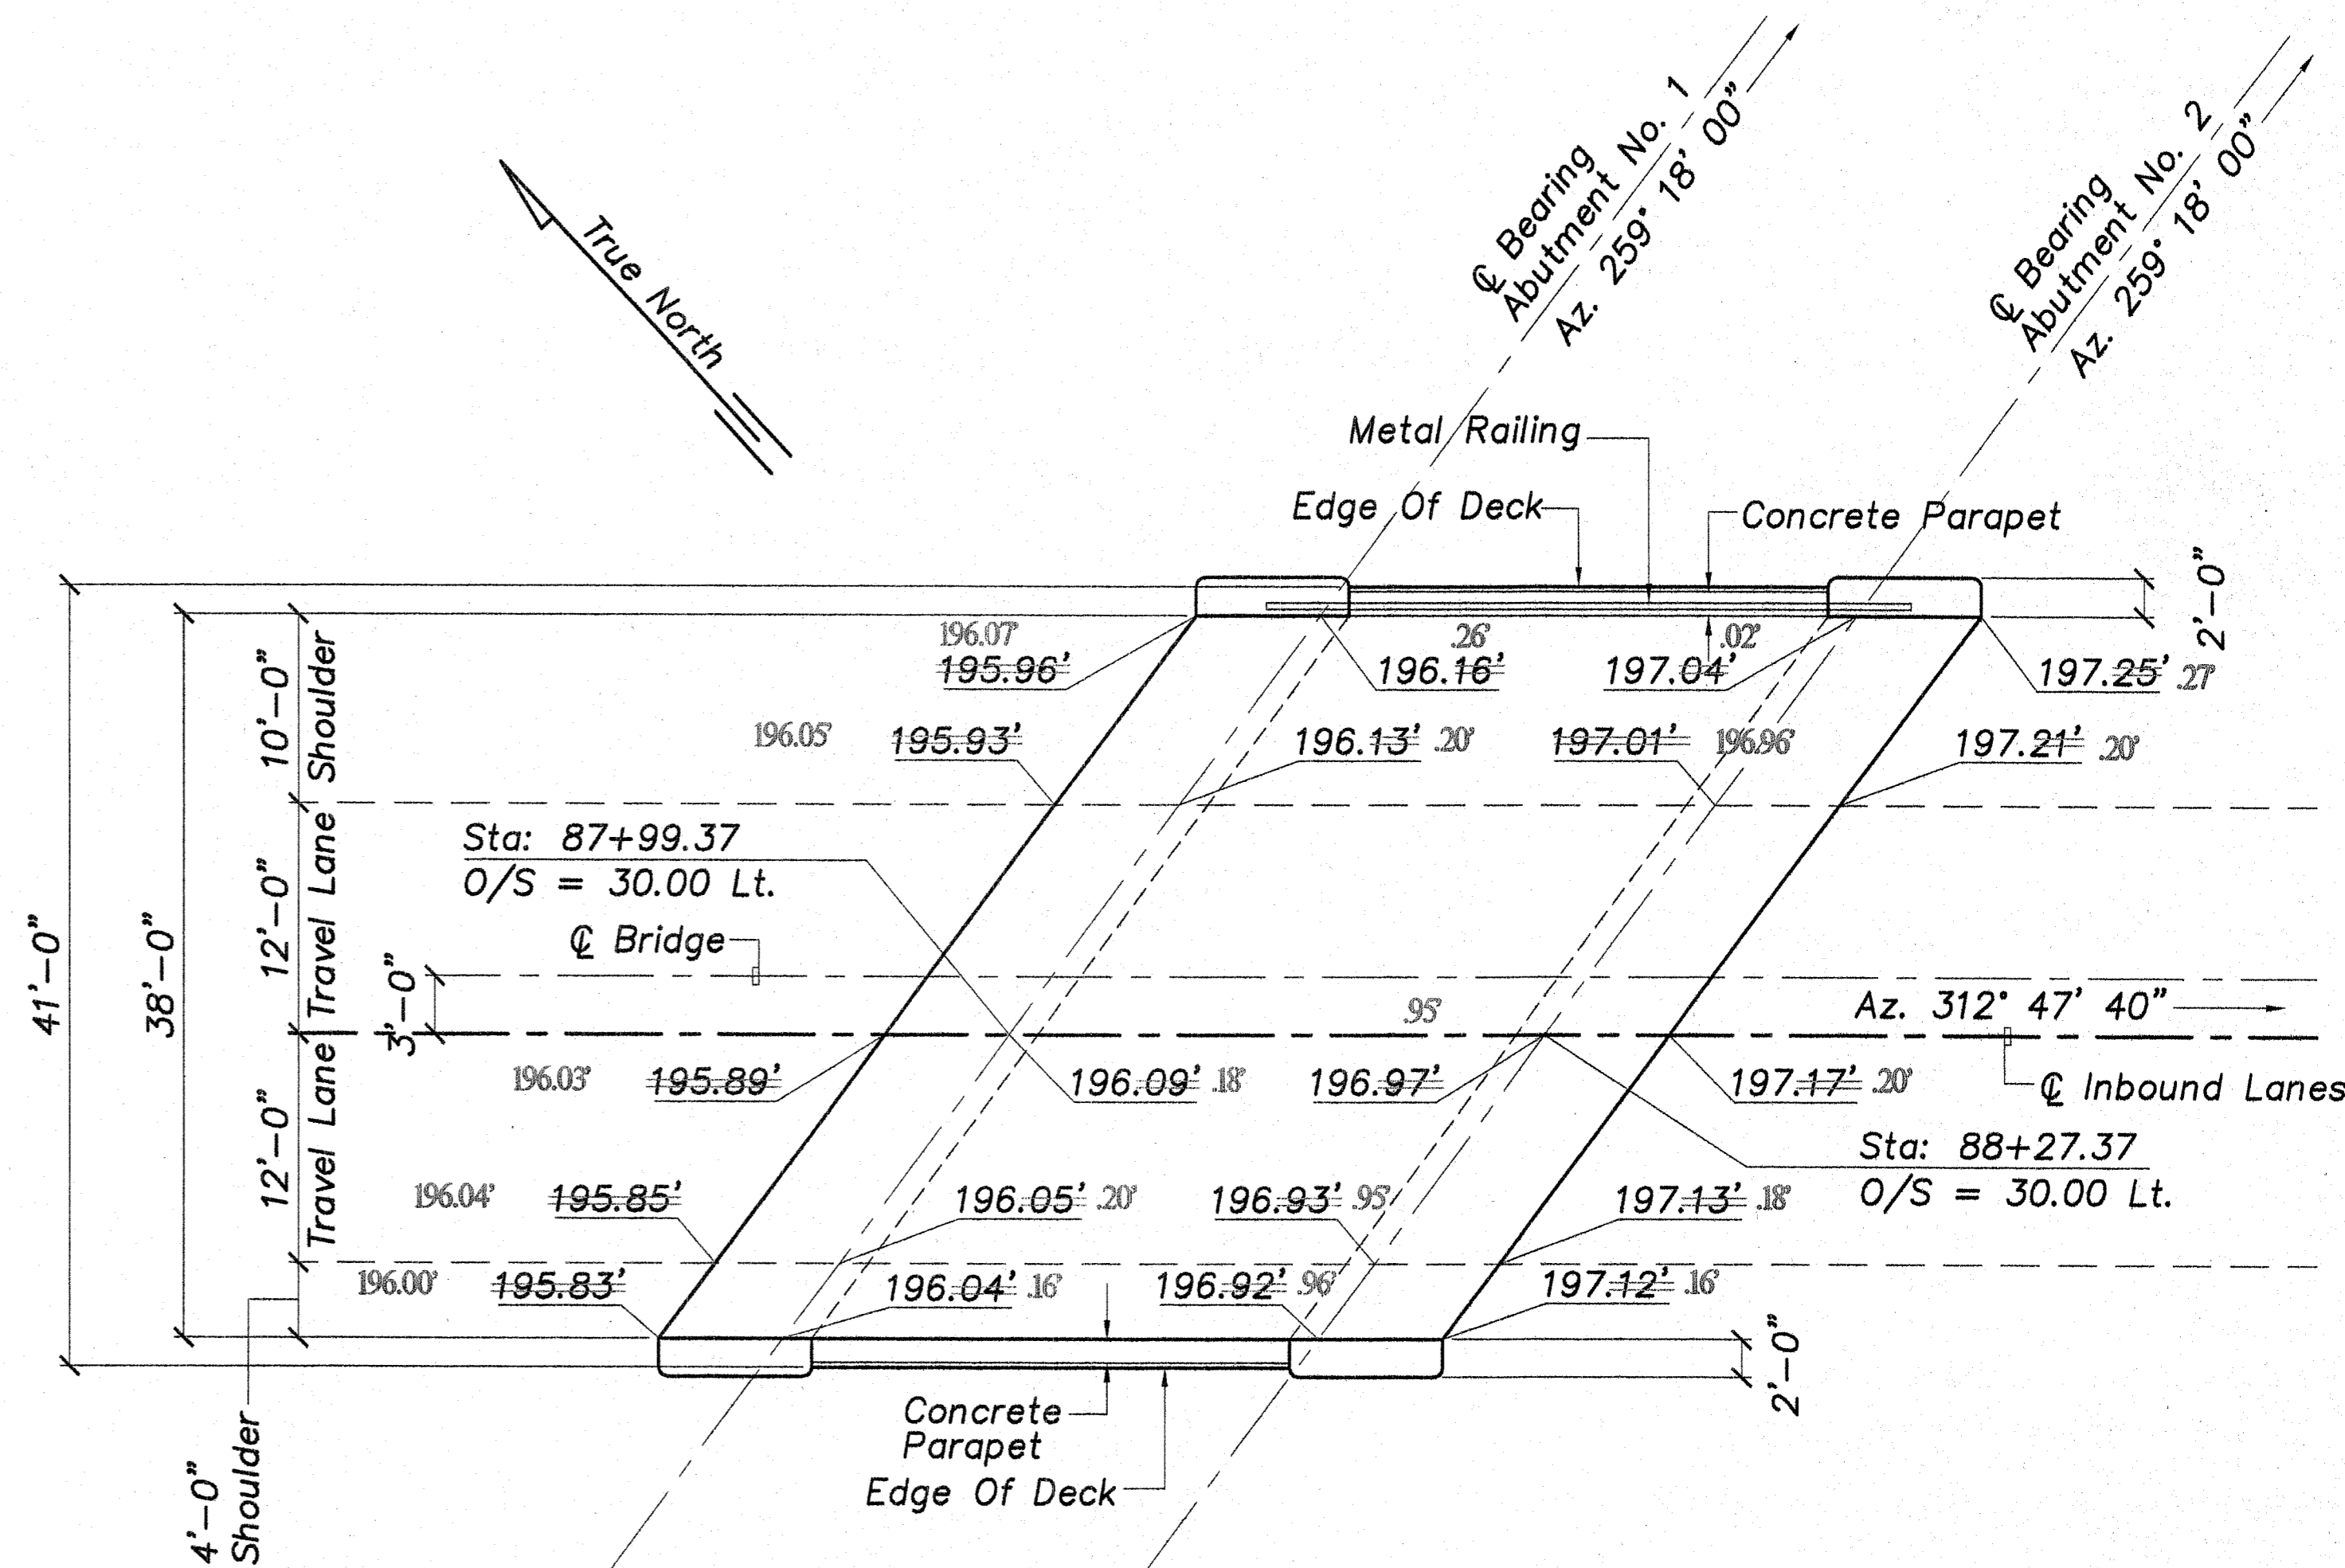

AT HAIKU DITCH CROSSING
 WATERWAY STRUCTURE NO. 1 SLAB ELEVATION PLAN

Scale: 1/8"=1'-0"

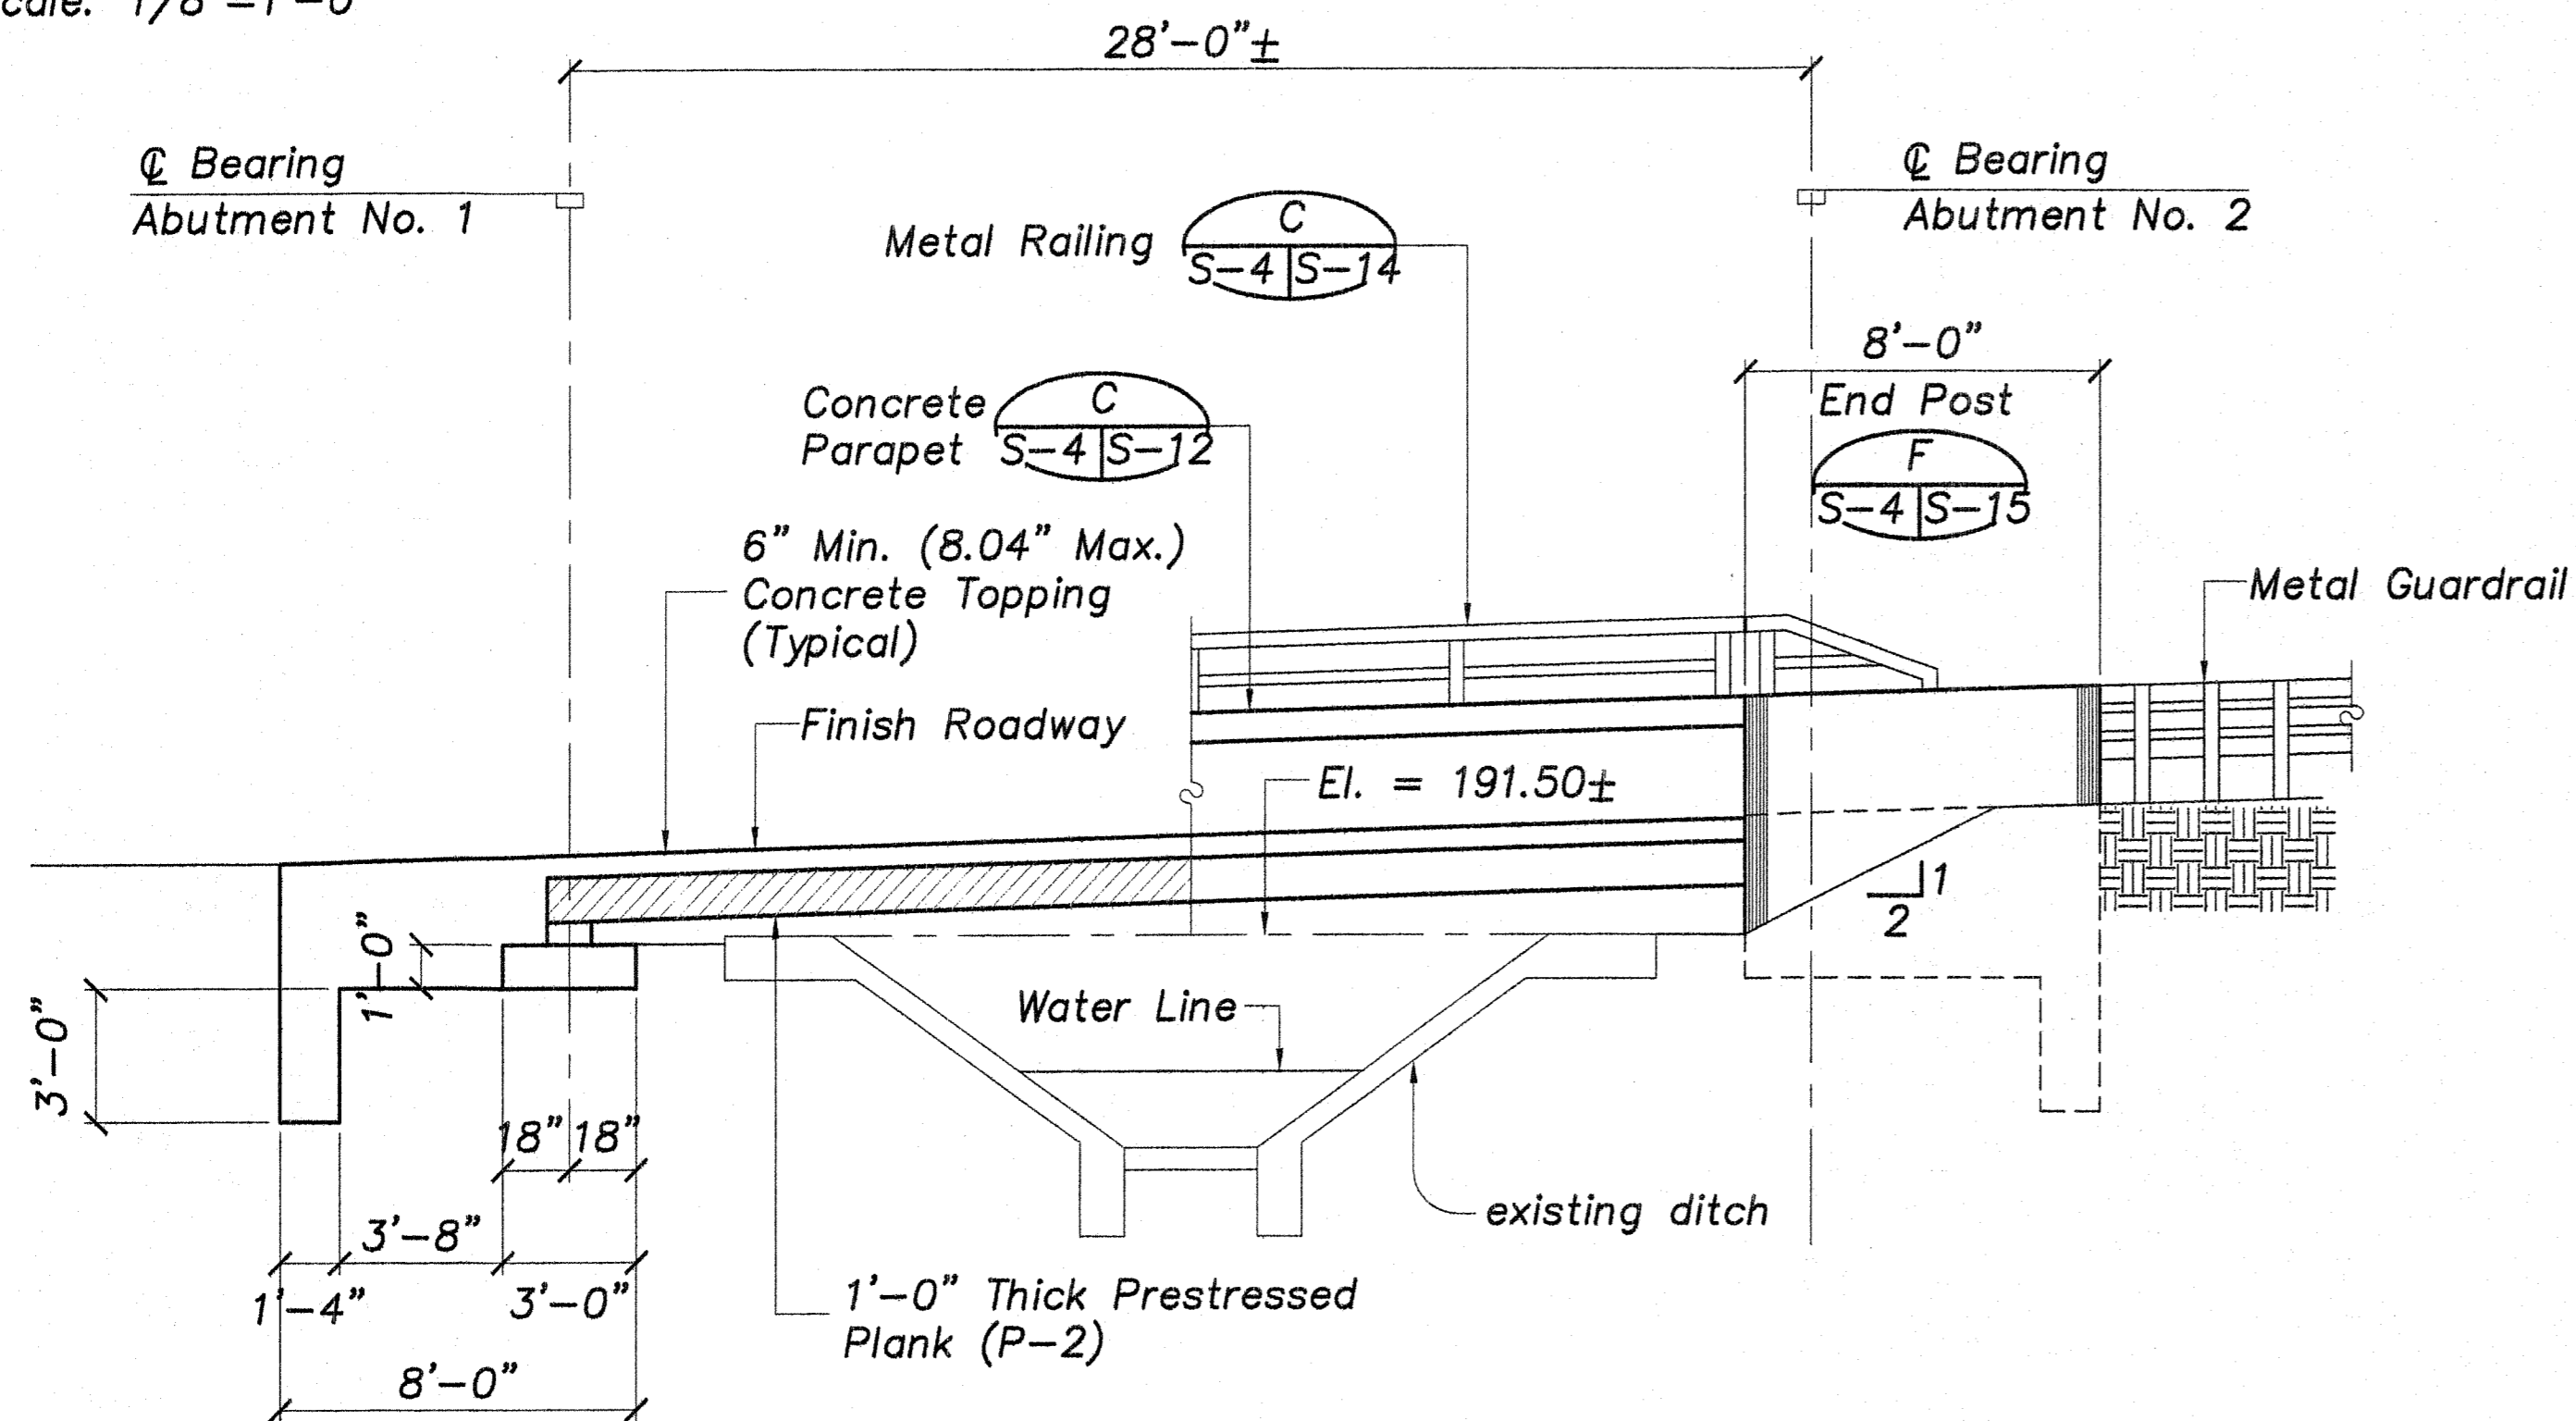

TYPICAL LONGITUDINAL SECTION / ELEVATION

Scale: 1/4"=1'-0"

DATE	_____
SURVEY PLOTTED BY	_____
DRAWN BY	_____
TRACED BY	_____
CHECKED BY	_____
NO. _____	

LEGEND FOR AS-BUILT POSTINGS	
	Squiggly line for as-built deletion
	Double line for as-built deletion
Roadway	Text for as-built posting




THIS WORK WAS PREPARED BY ME OR UNDER MY SUPERVISION.
 SIGNATURE
 EXPIRATION DATE OF PROFESSIONAL LICENSE


STATE OF HAWAII
 DEPARTMENT OF TRANSPORTATION
 HIGHWAYS DIVISION
 WATERWAY STRUCTURE NO. 1
 FOUNDATION / FRAMING PLAN, SLAB
 ELEV. PLAN, LONG. SECTION / ELEVATION
 HALEAKALA HIGHWAY WIDENING, PHASE 2
 HANA HIGHWAY TO PUKALANI BYPASS
 FED. AID PROJ. NO. NH-037-1(24)
 SCALE: AS NOTED DATE: MAY 2005
 SHEET No. S-4 OF 26 SHEETS

AS-BUILT


FED. ROAD DIST. NO.	STATE	FED. AID PROJ. NO.	FISCAL YEAR	SHEET NO.	TOTAL SHEETS
HAWAII	HAW.	NH-037-1(24)	2005	238	288

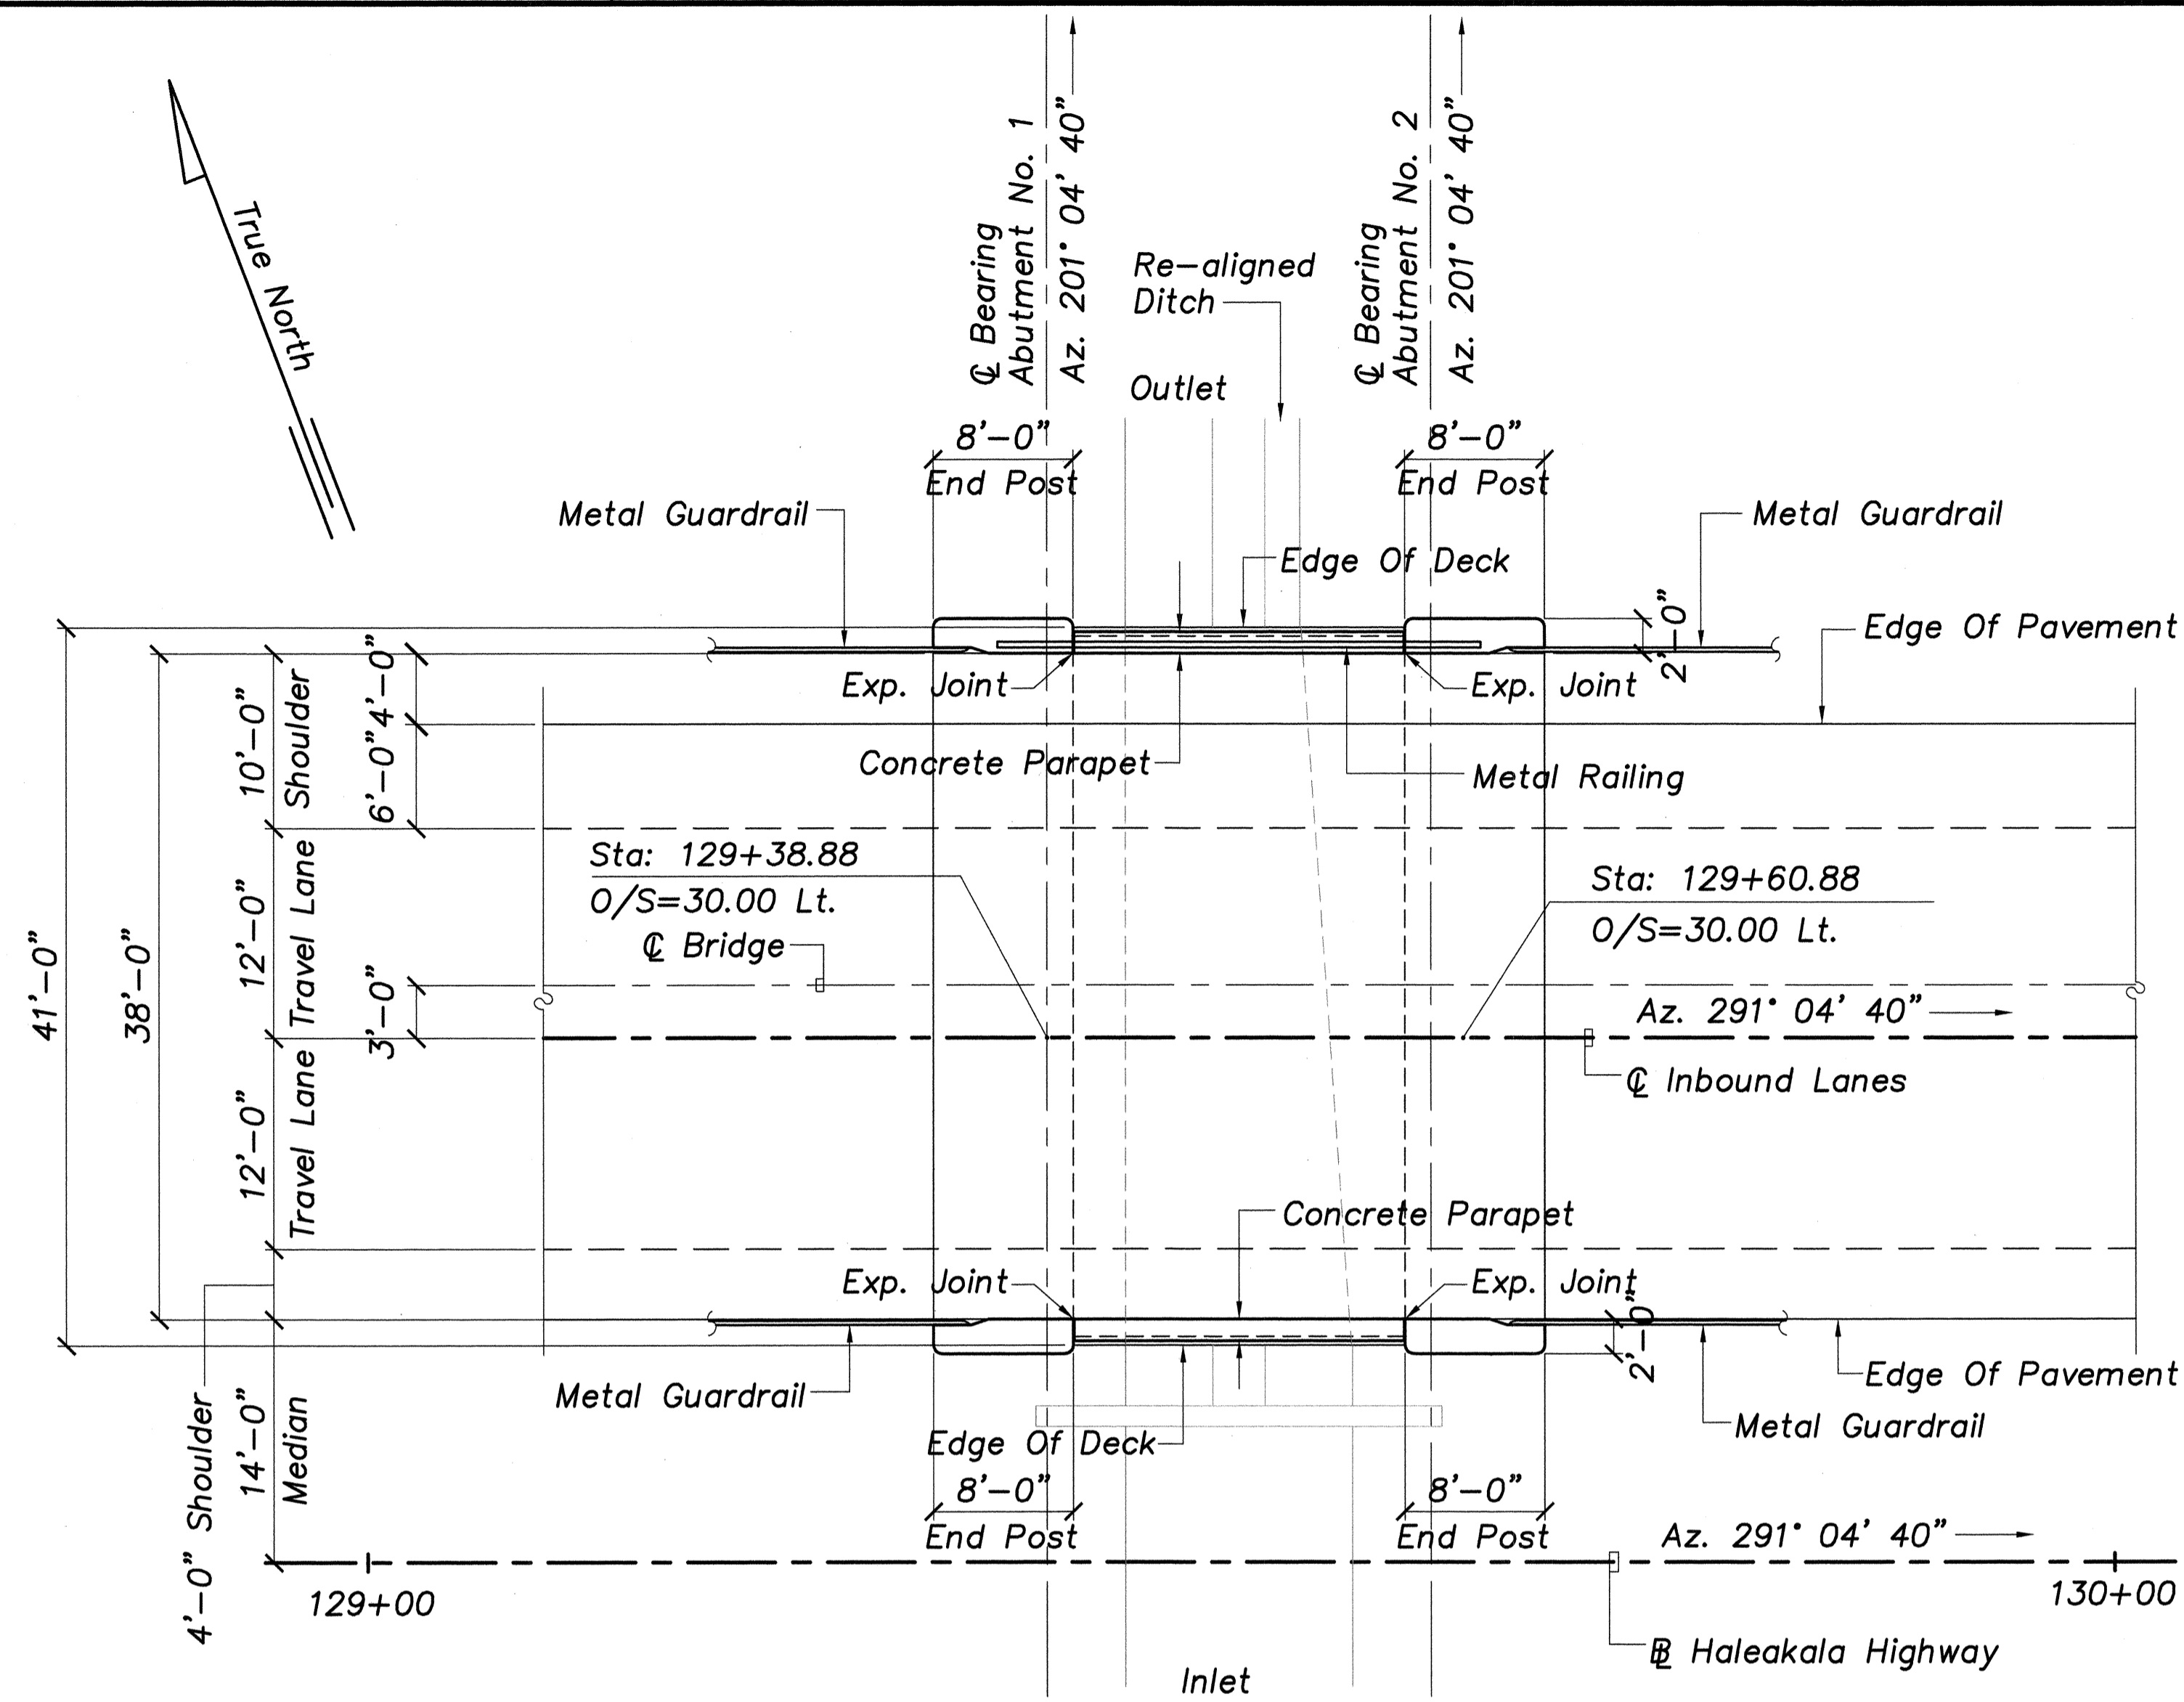

**AT BOX CULVERT CROSSING
WATERWAY STRUCTURE NO. 2 LAYOUT PLAN**
Scale: 1/8"=1'-0"

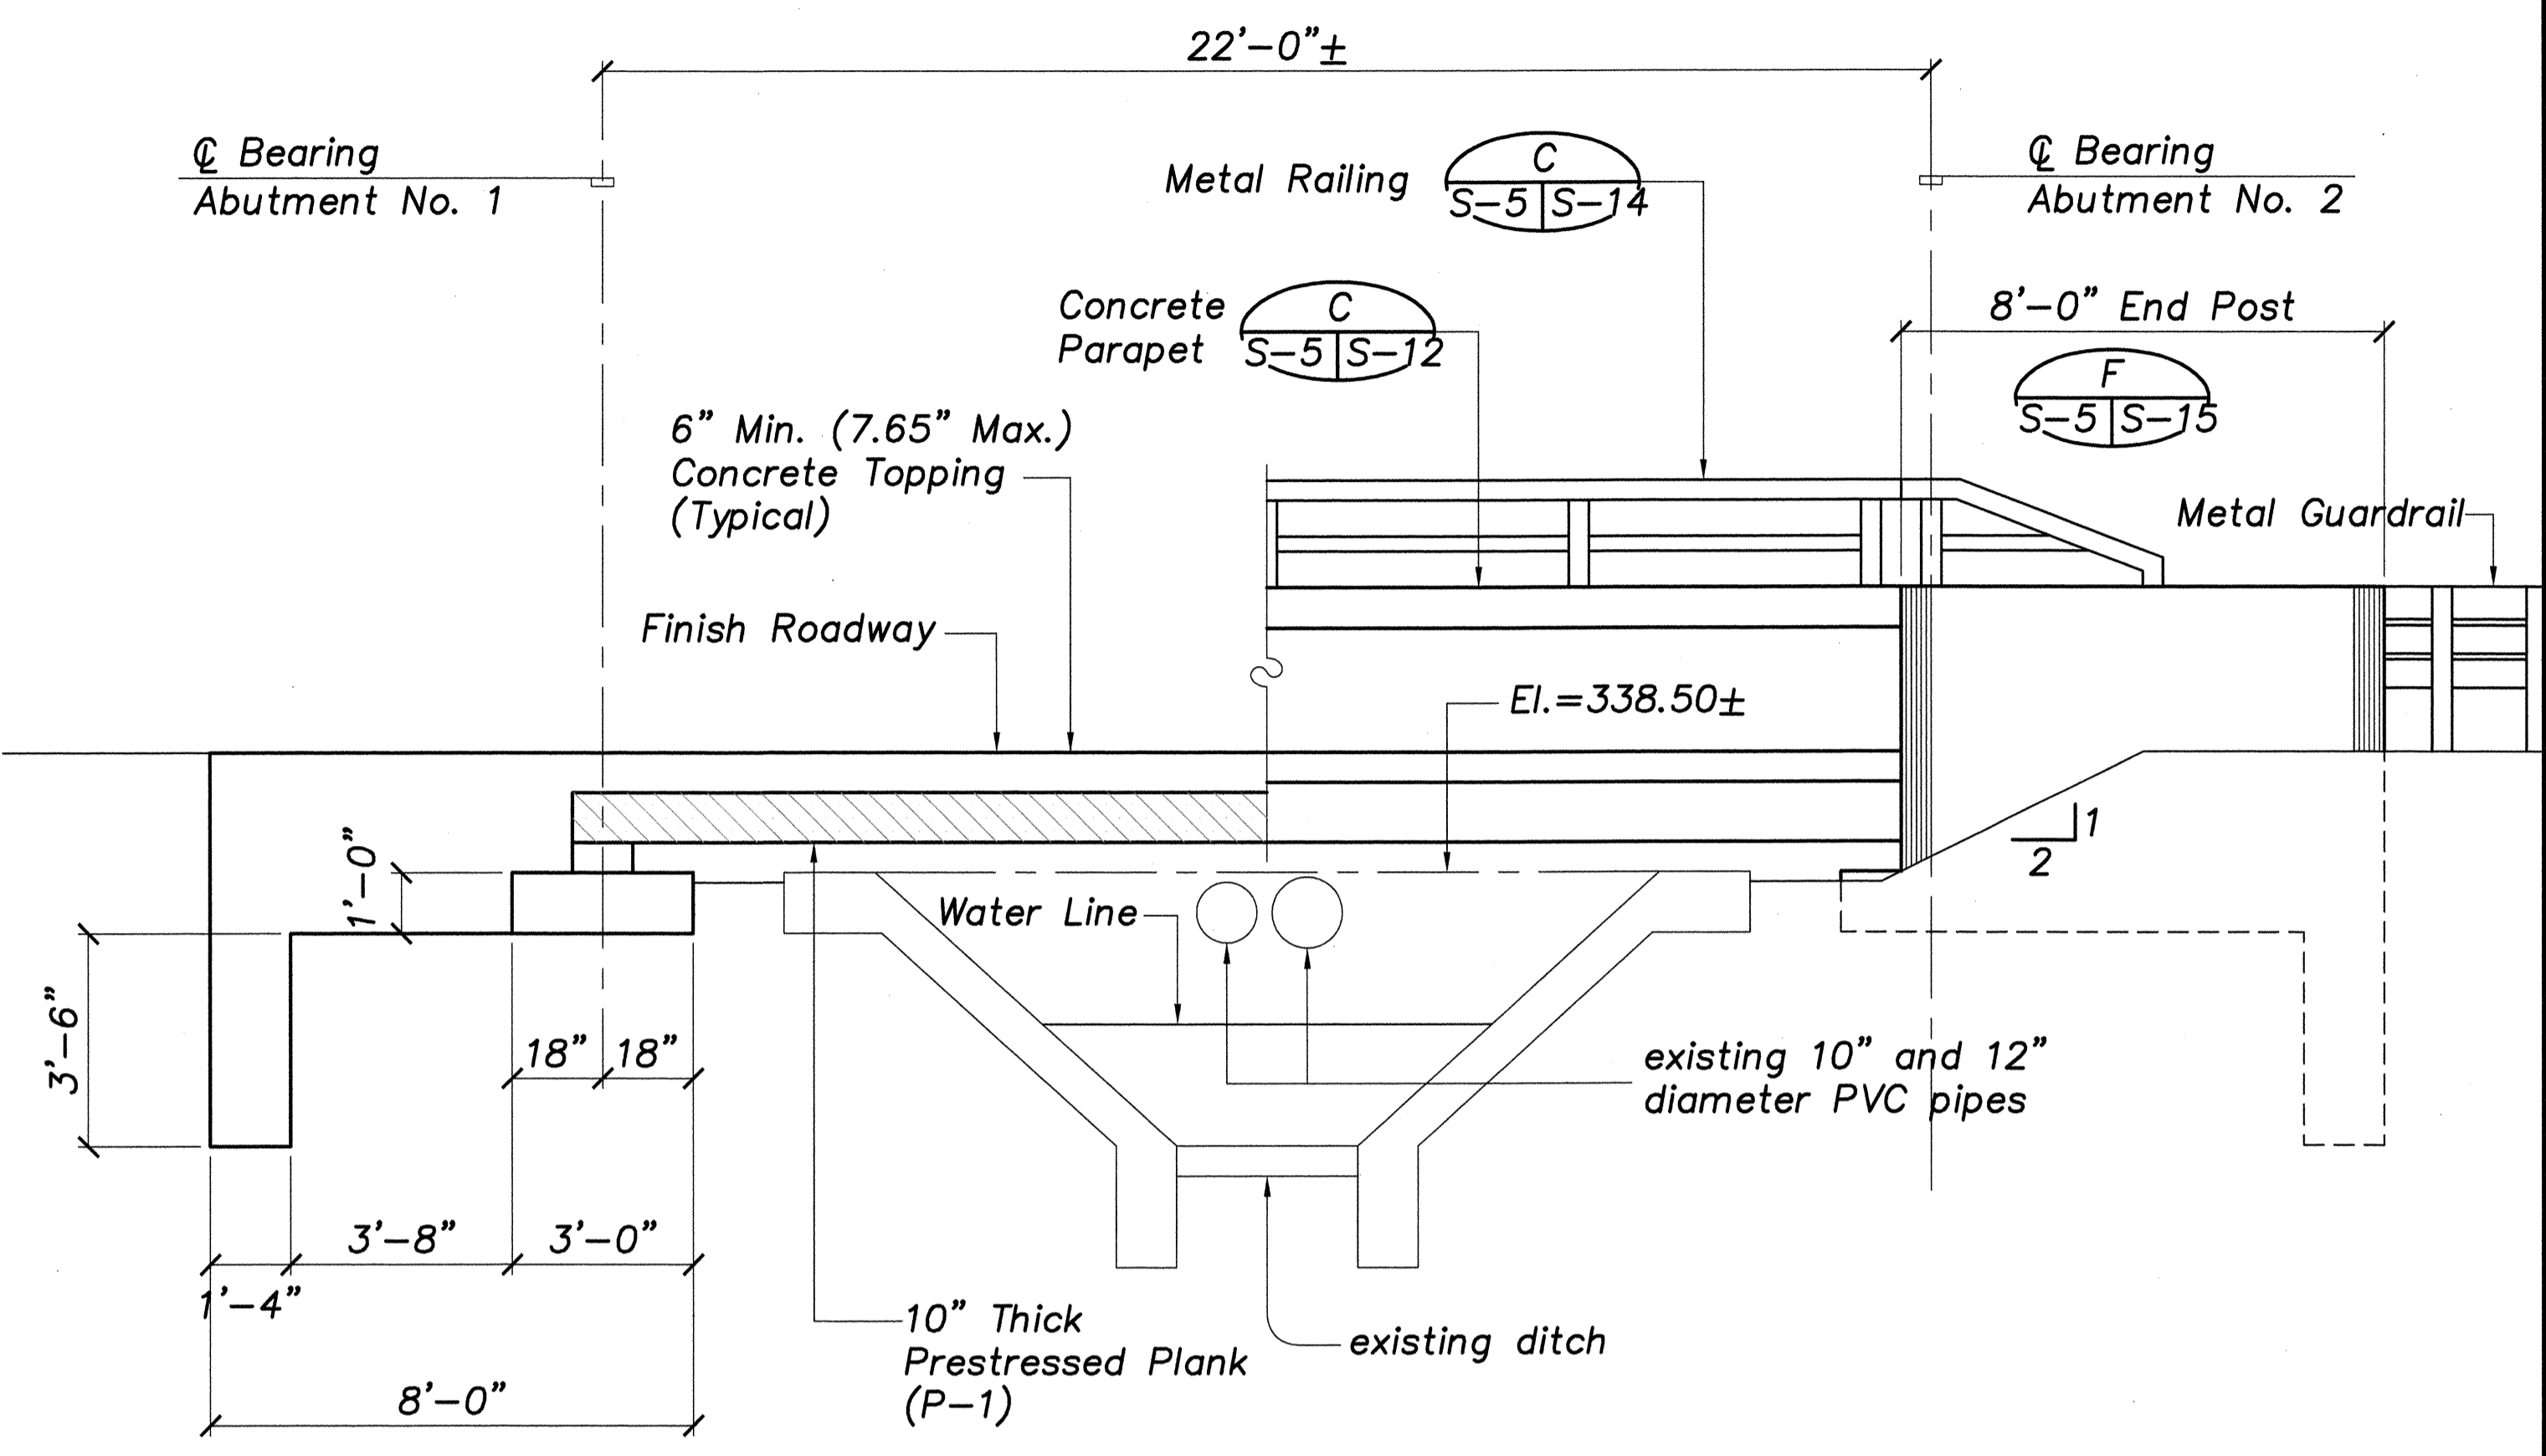


TYPICAL LONGITUDINAL SECTION / ELEVATION
Scale: 3/8"=1'-0"

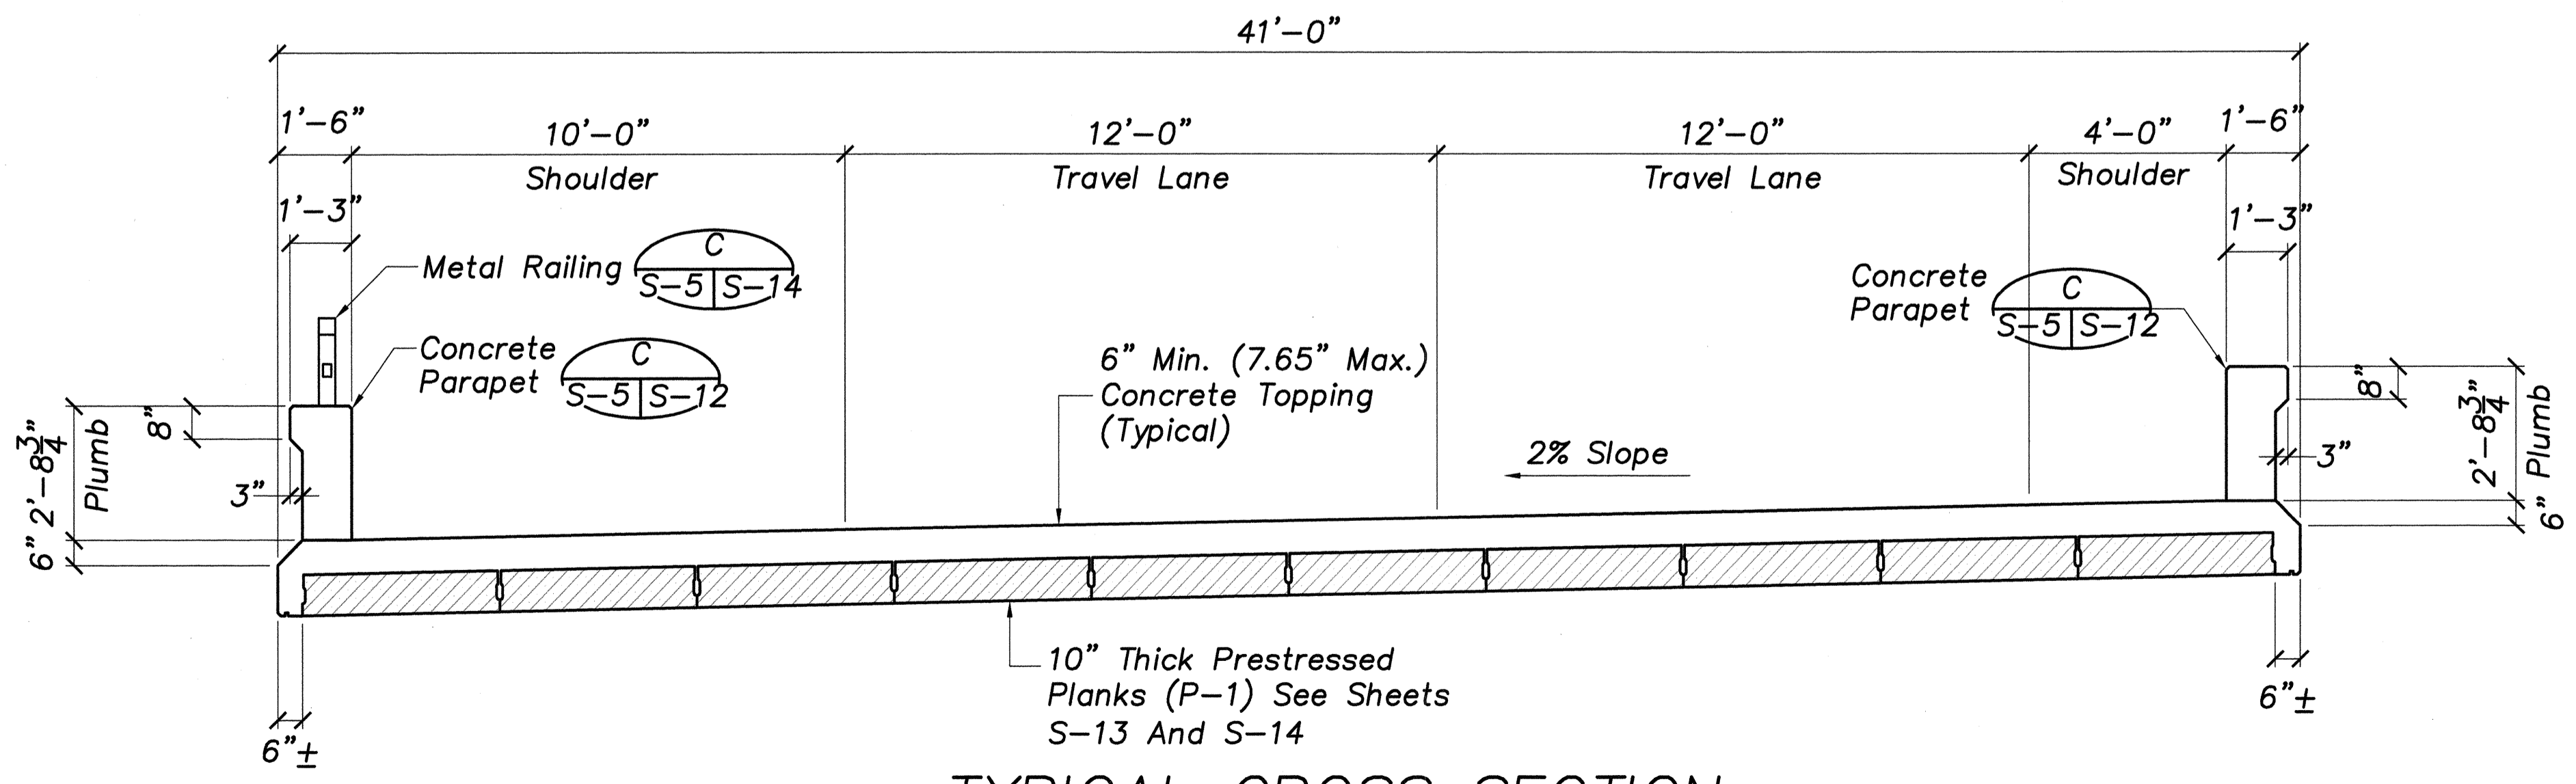

TYPICAL CROSS SECTION
Scale: 3/8"=1'-0"


DESIGNED BY	DATE
DRAWN BY	
CHECKED BY	
APPROVED BY	
NO. _____	

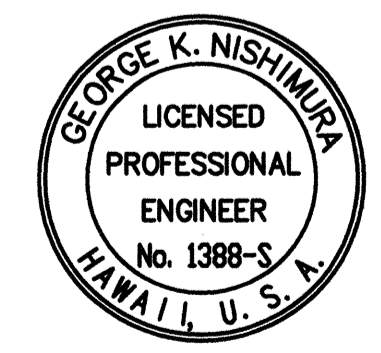


THIS WORK WAS PREPARED BY ME OR UNDER MY SUPERVISION.
SIGNATURE
04/30/06
EXPIRATION DATE OF PROFESSIONAL LICENSE

STATE OF HAWAII
DEPARTMENT OF TRANSPORTATION
HIGHWAYS DIVISION
WATERWAY STRUCTURE NO. 2
BRIDGE LAYOUT PLAN, CROSS SECTION,
LONGITUDINAL SECTION / ELEVATION
HALEAKALA HIGHWAY WIDENING, PHASE 2
HANA HIGHWAY TO PUKALANI BYPASS
FED. AID PROJ. NO. NH-037-1(24)
SCALE: AS NOTED DATE: MAY 2005
SHEET No. 5-5 OF 26 SHEETS

FED. ROAD DIST. NO.	STATE	FED. AID PROJ. NO.	FISCAL YEAR	SHEET NO.	TOTAL SHEETS
HAWAII	HAW.	NH-037-1(24)	2005	239	288

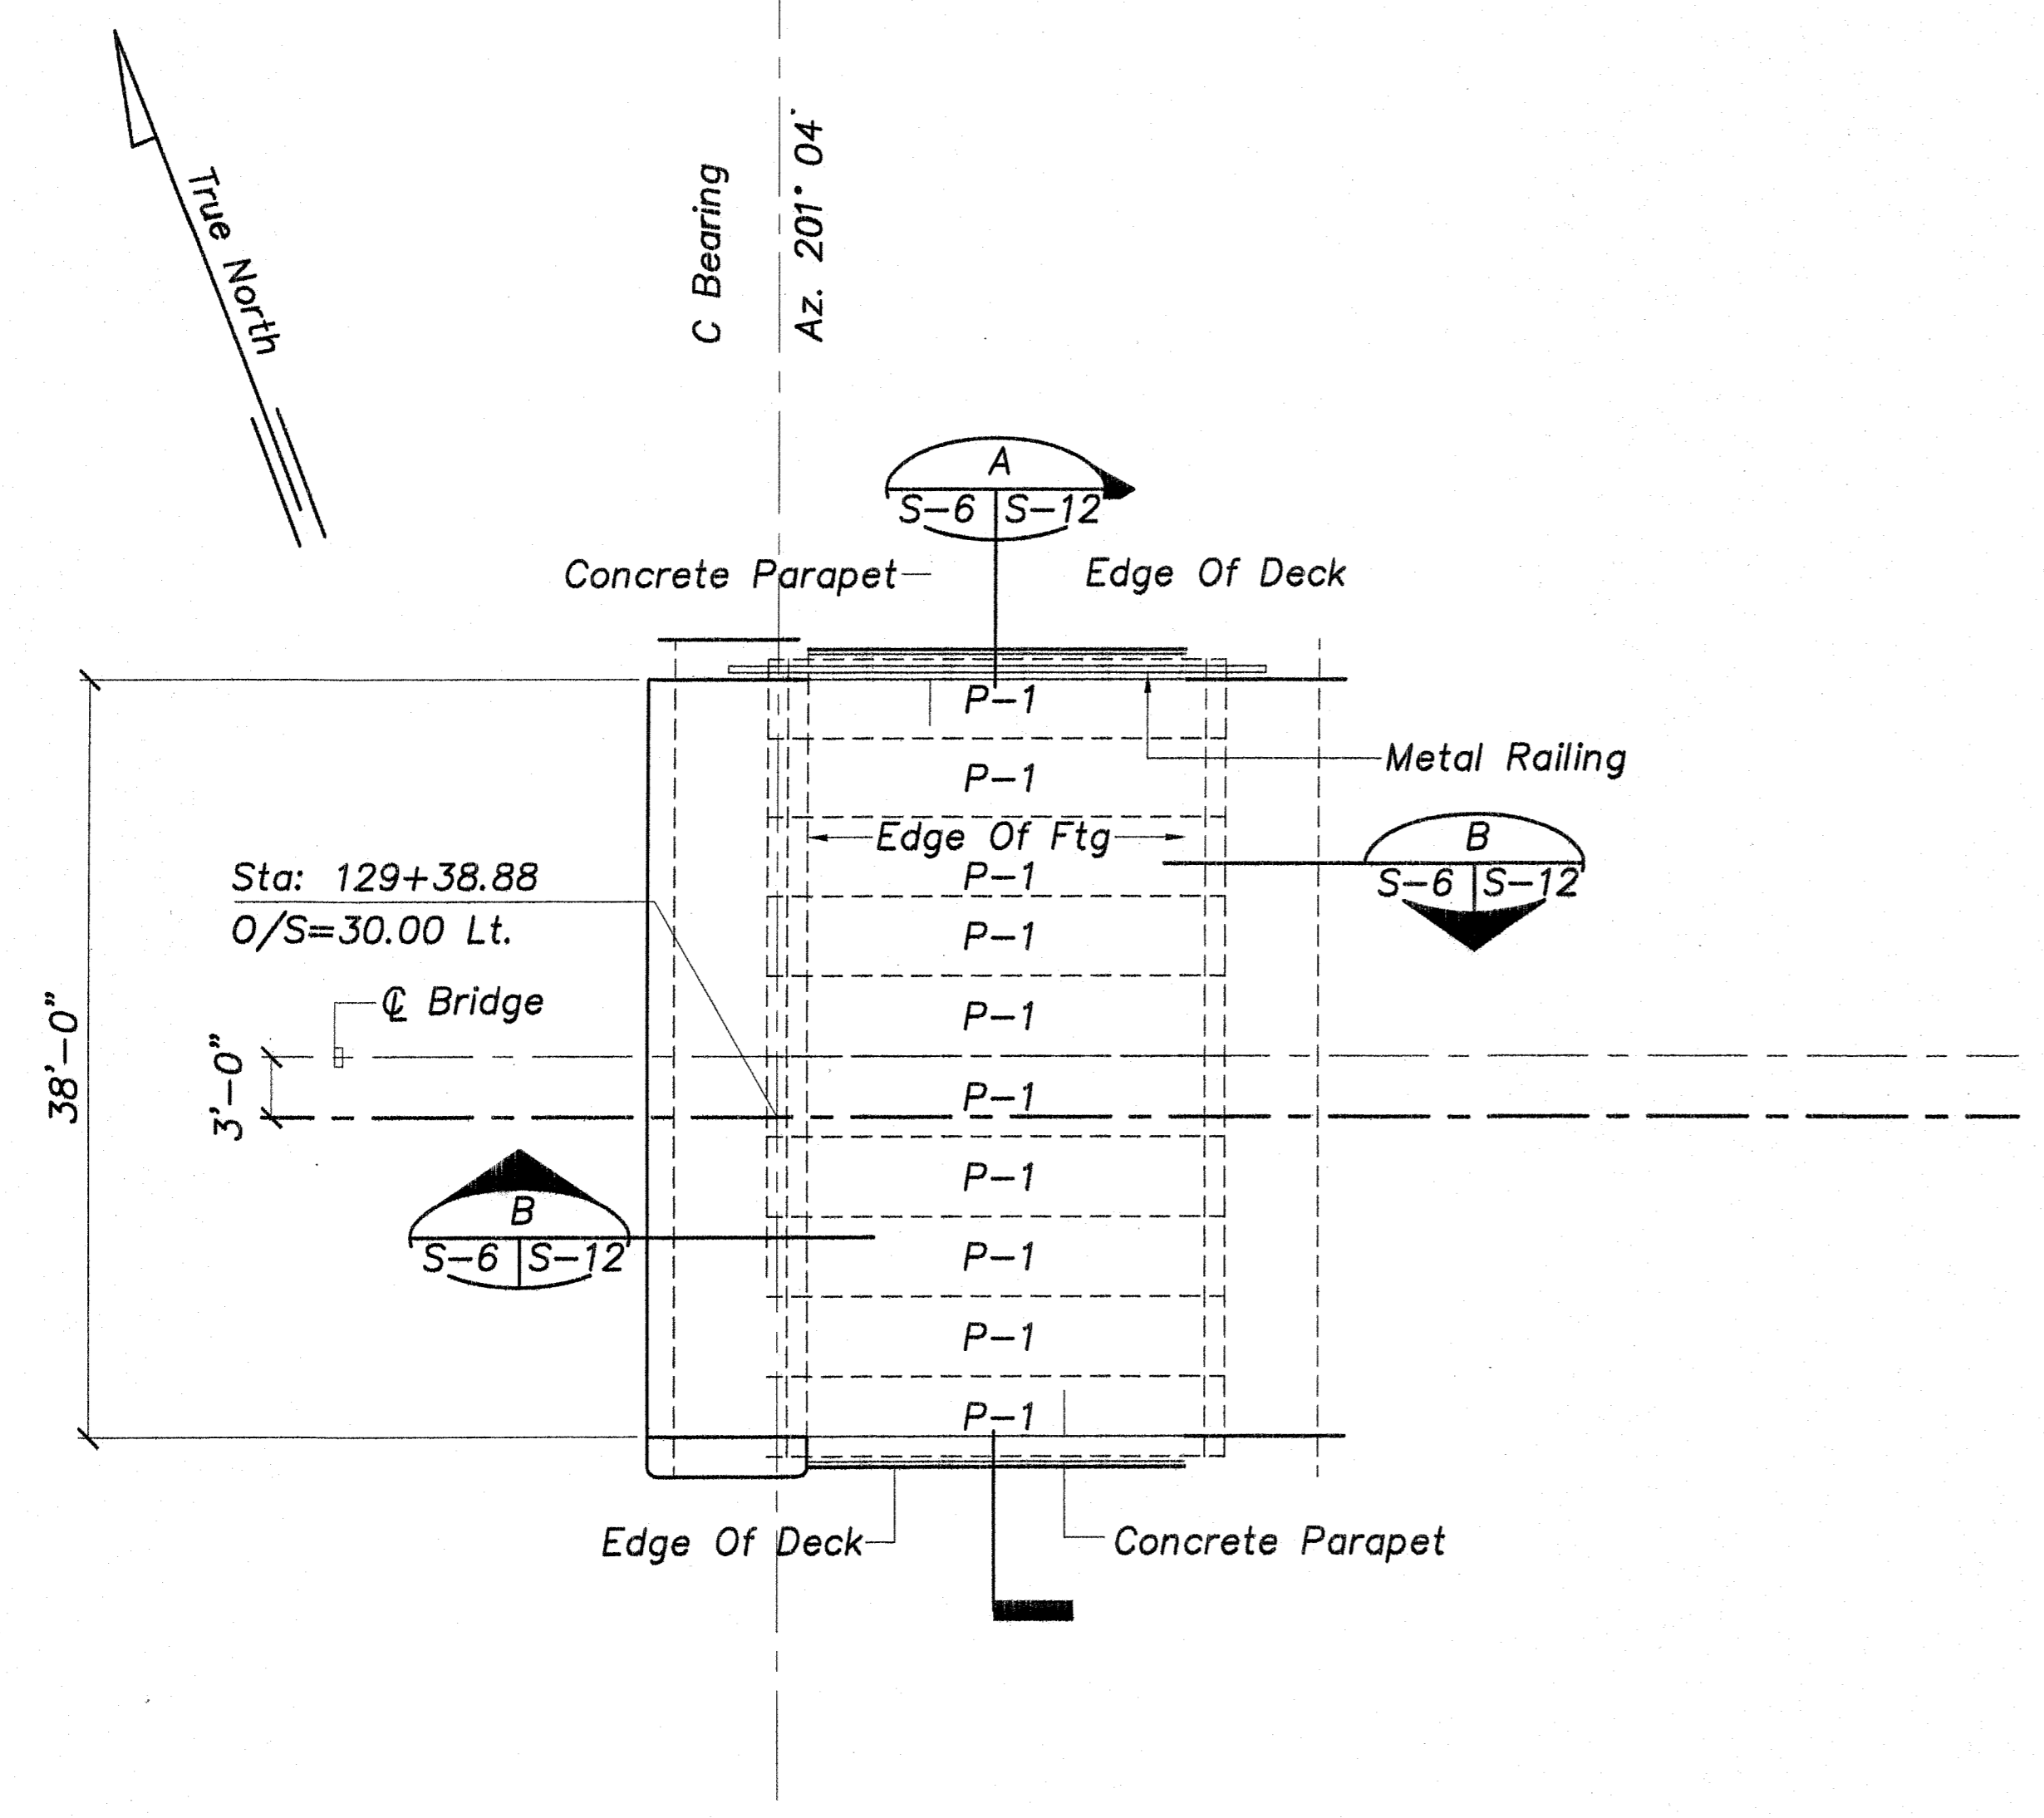

AT BOX CULVERT CROSSING
WATERWAY STRUCTURE NO. 2 FOUNDATION / FRAMING PLAN
 Scale: 1/8"=1'-0"

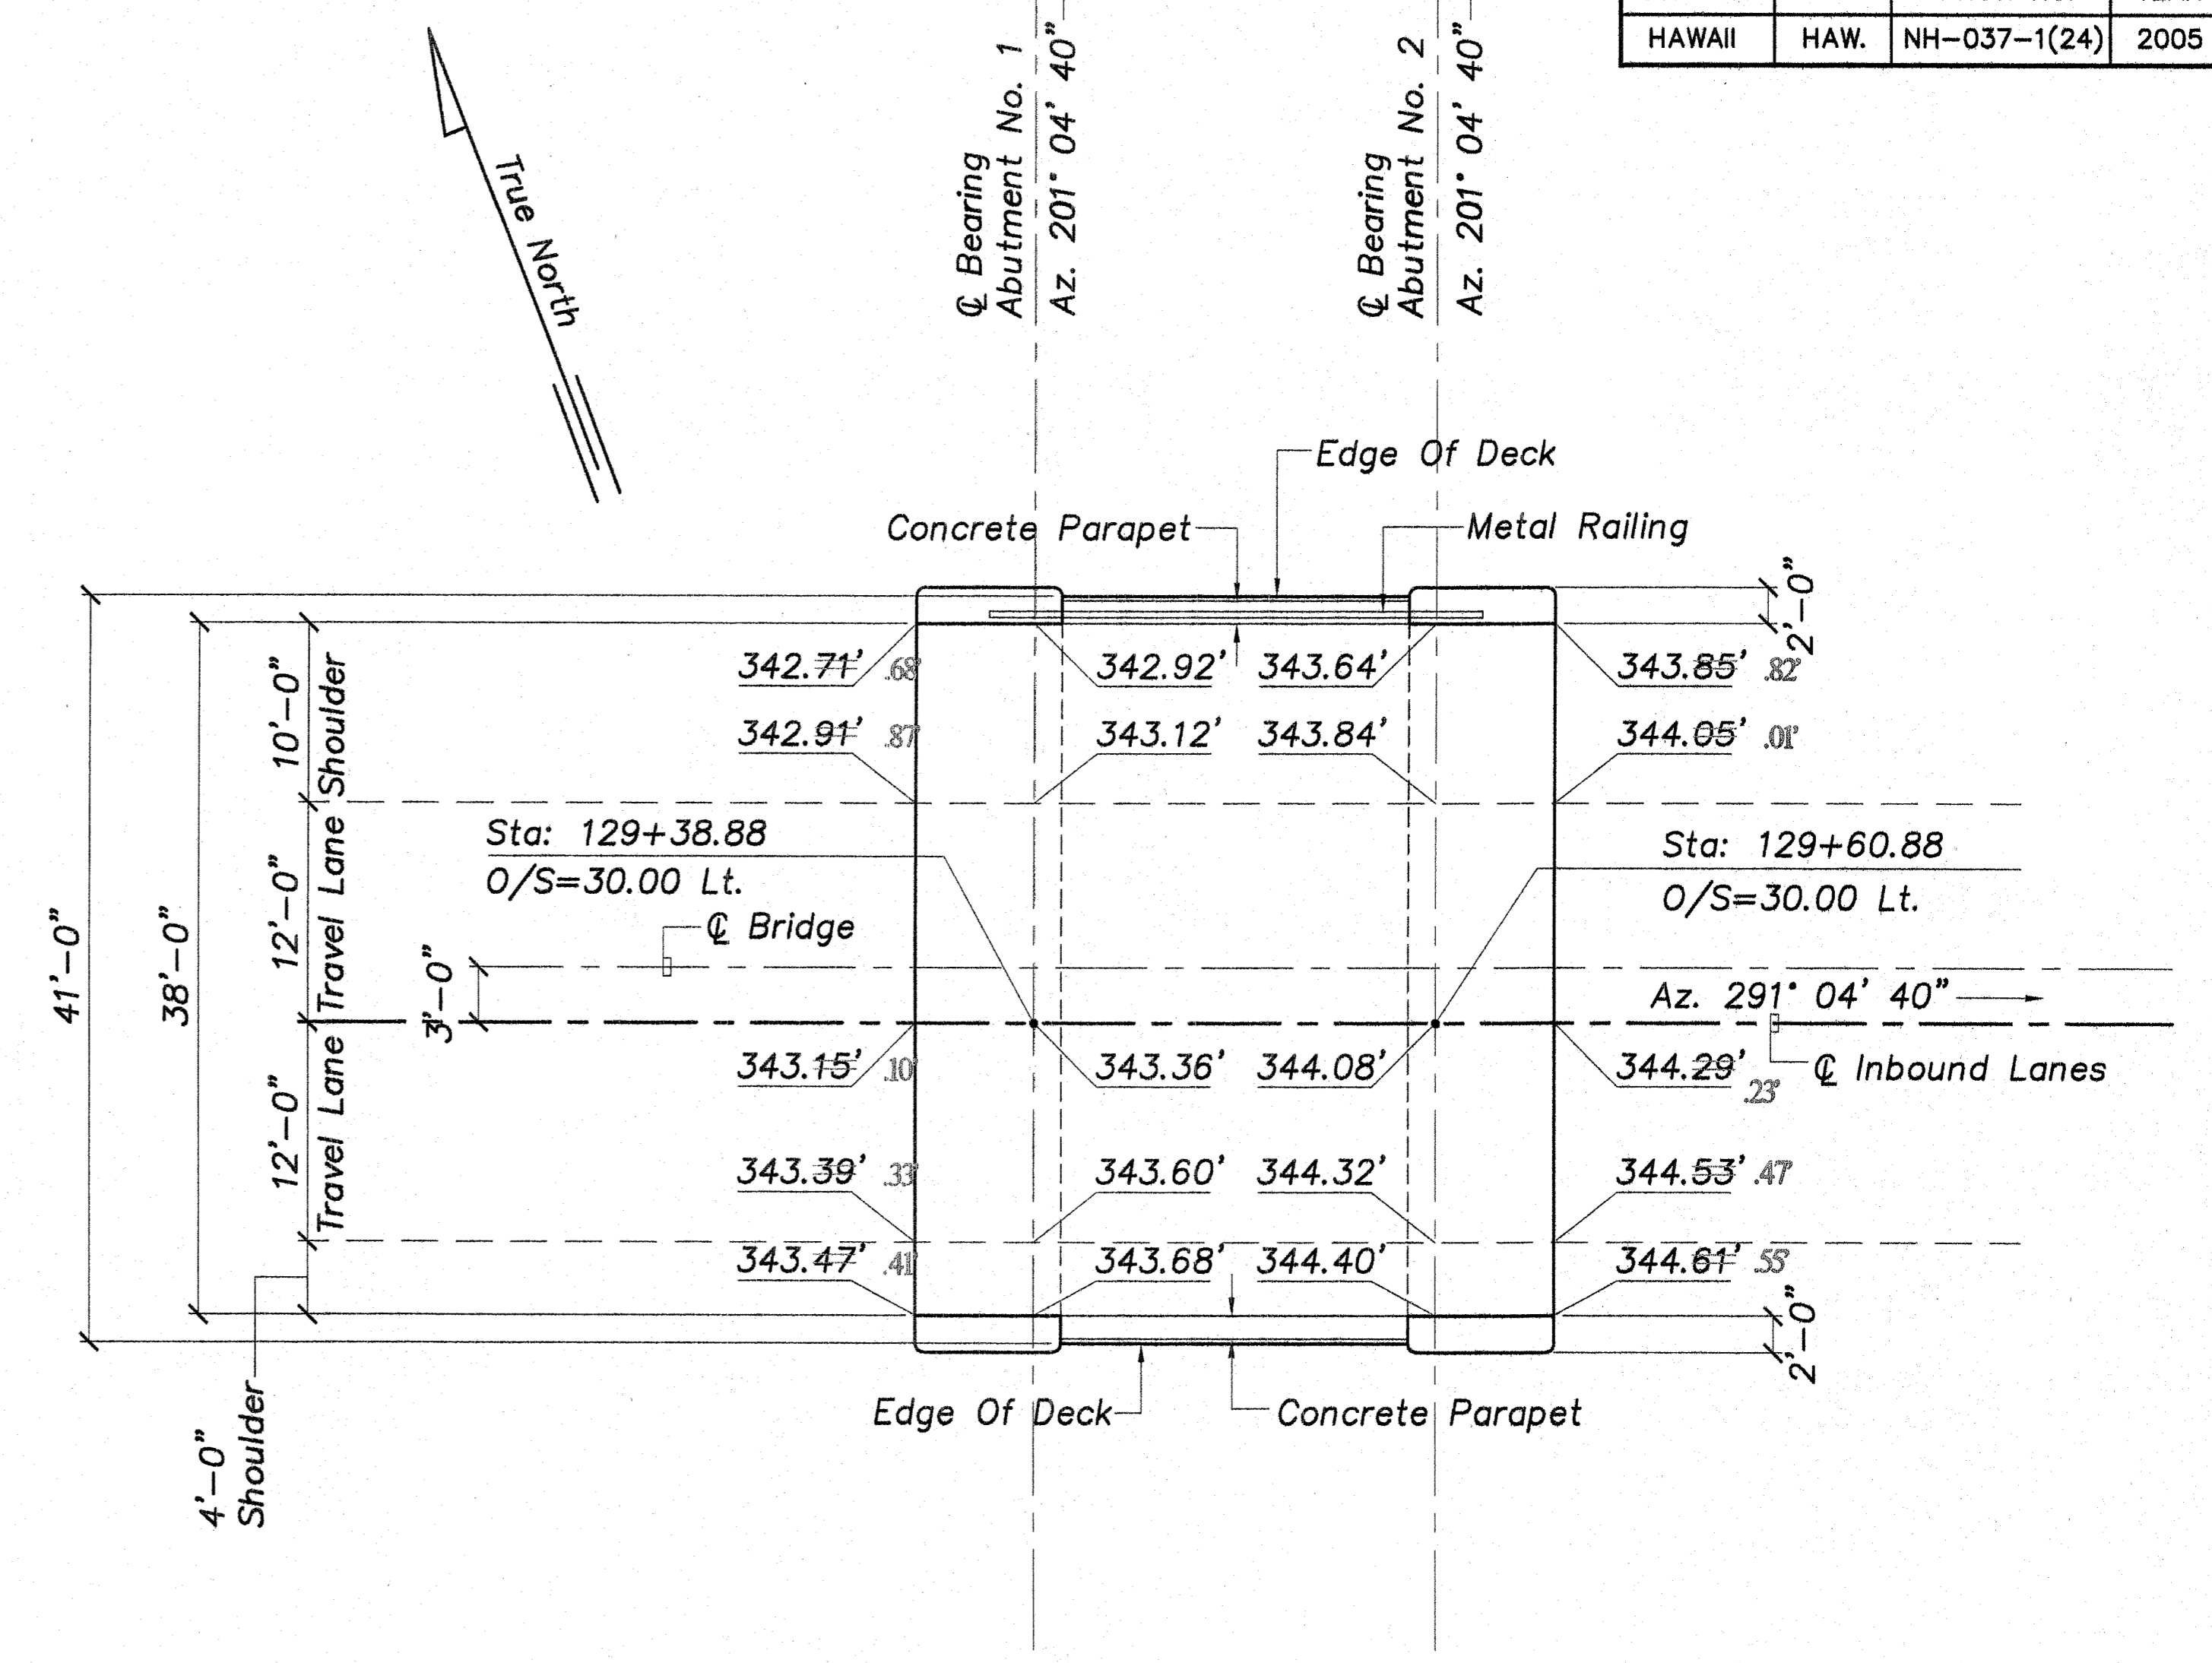

AT BOX CULVERT CROSSING
WATERWAY STRUCTURE NO. 2 SLAB ELEVATION PLAN
 Scale: 1/8"=1'-0"

DESIGNED BY	DATE
DRAWN BY	
CHECKED BY	
APPROVED BY	
ORIGINAL PLAN No.	



LEGEND FOR AS-BUILT POSTINGS	
	Squiggly line for as-built deletion
	Double line for as-built deletion
	Roadway Text for as-built posting

THIS WORK WAS PREPARED BY
 MEMBER UNDER MY SUPERVISION.

 SIGNATURE
 04/30/10
 EXPIRATION DATE OF PROFESSIONAL LICENSE

STATE OF HAWAII
 DEPARTMENT OF TRANSPORTATION
 HIGHWAYS DIVISION
WATERWAY STRUCTURE NO. 2
FOUNDATION / FRAMING PLAN
SLAB ELEVATION PLAN
 HALEAKALA HIGHWAY WIDENING, PHASE 2
 HANA HIGHWAY TO PUKALANI BYPASS
 FED. AID PROJ. NO. NH-037-1(24)
 SCALE: AS NOTED DATE: MAY 2005
 SHEET No. S-6 OF 26 SHEETS


FED. ROAD DIST. NO.	STATE	FED. AID PROJ. NO.	FISCAL YEAR	SHEET NO.	TOTAL SHEETS
HAWAII	HAW.	NH-037-1(24)	2005	240	288

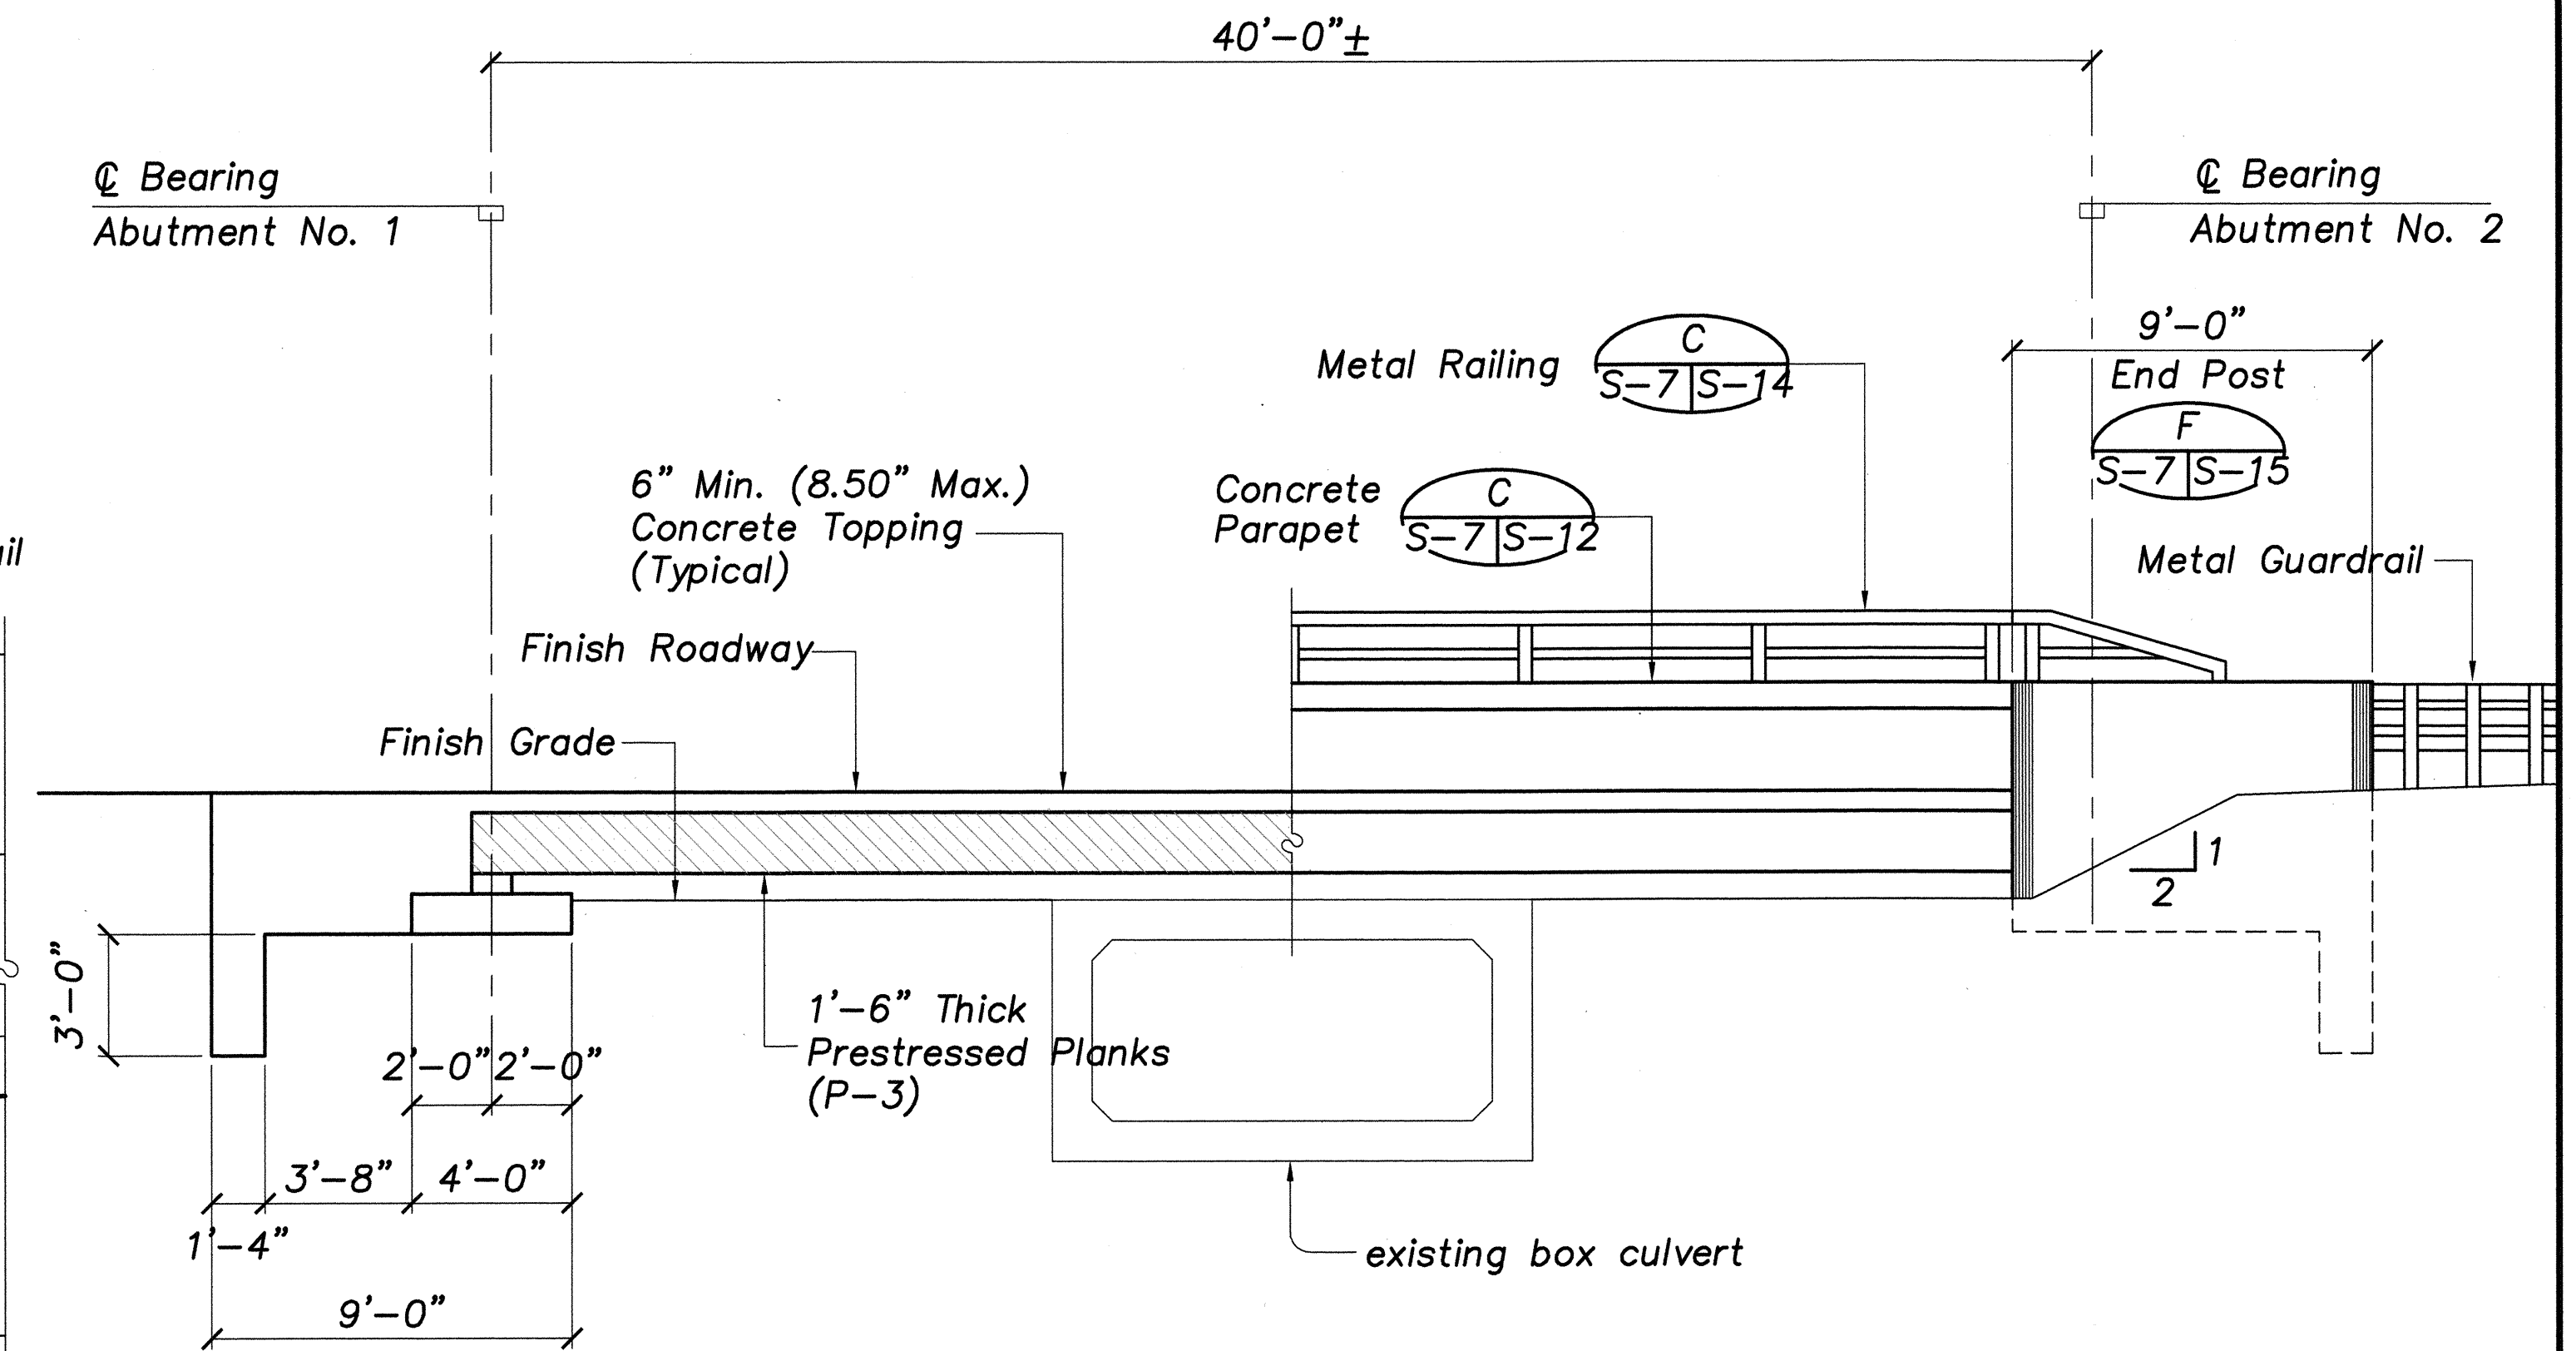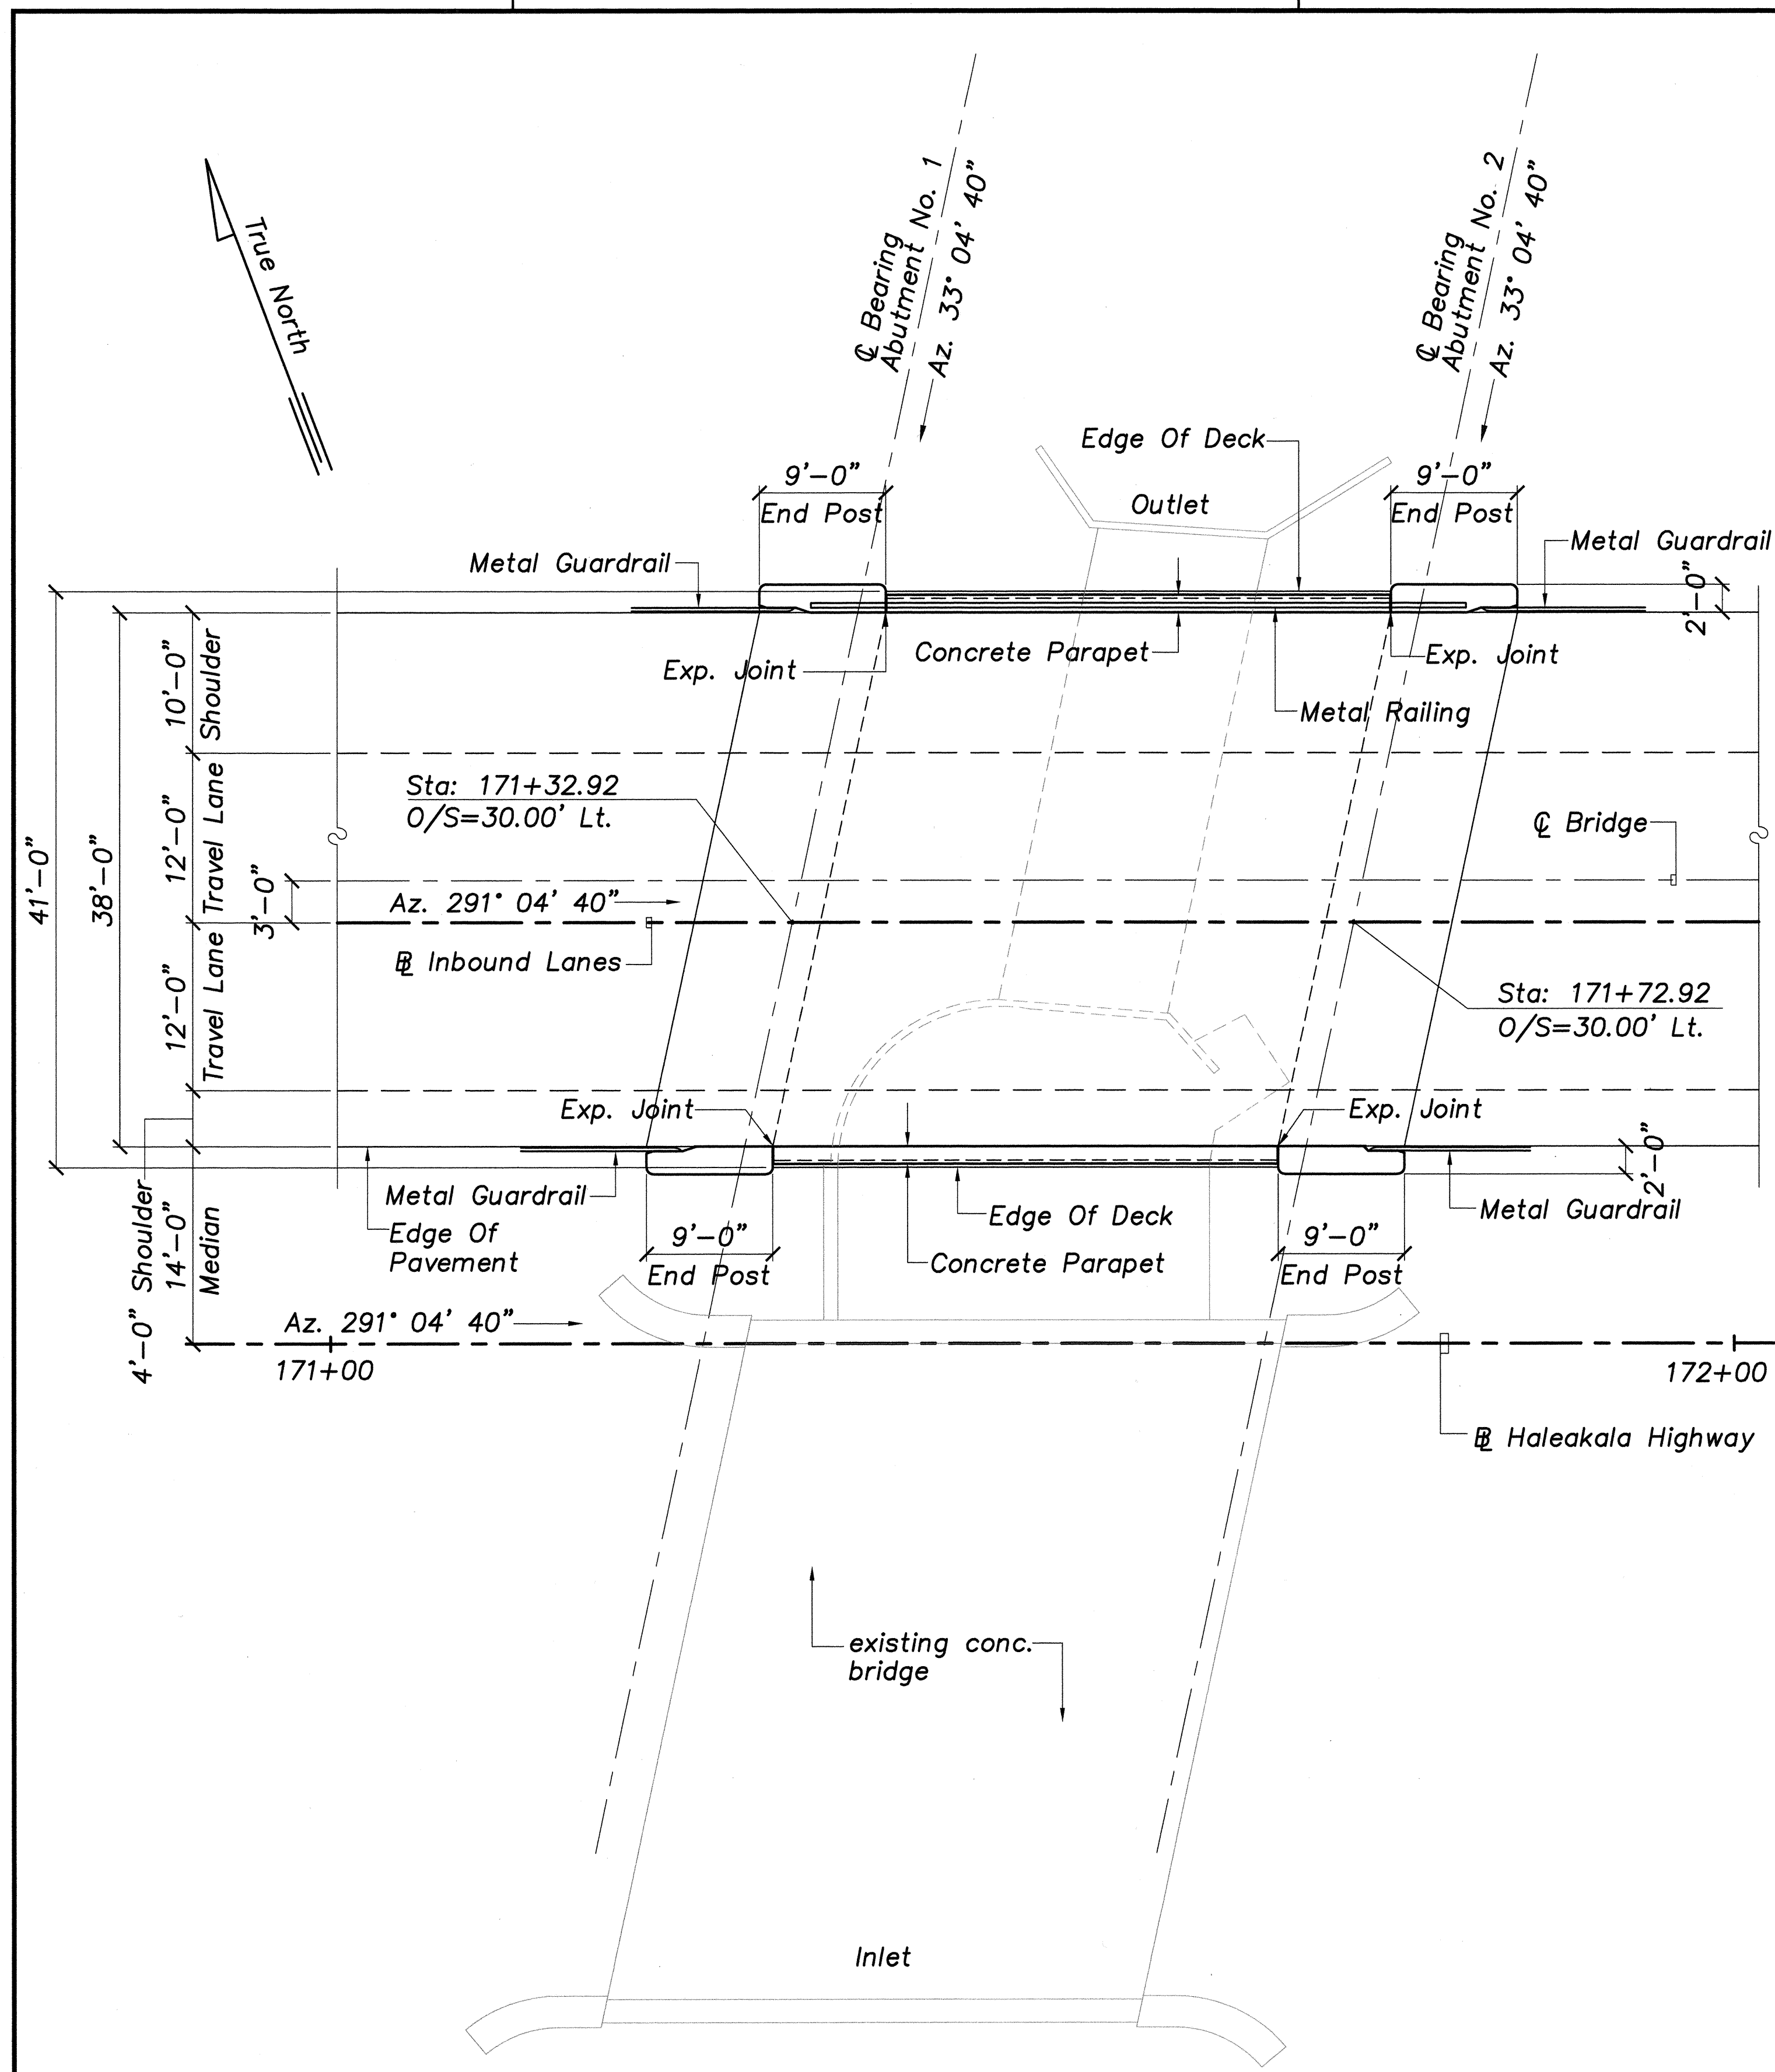

TYPICAL LONGITUDINAL SECTION / ELEVATION
Scale: 1/4"=1'-0"


AT LOWRIE DITCH CROSSING
WATERWAY STRUCTURE NO. 3 BRIDGE LAYOUT PLAN
Scale: 1/8"=1'-0"

DESIGNED BY	DATE
CHECKED BY	
APPROVED BY	
NO. _____	

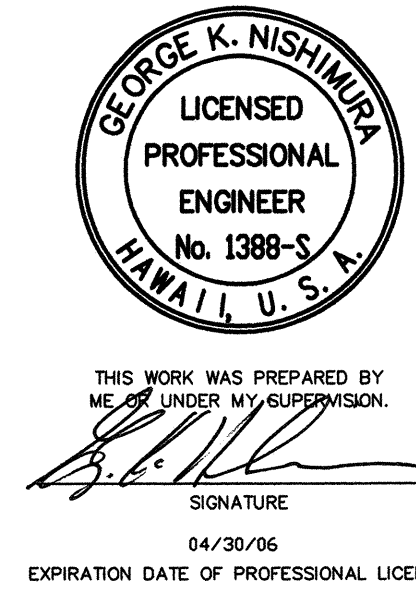


STATE OF HAWAII
DEPARTMENT OF TRANSPORTATION
HIGHWAYS DIVISION
WATERWAY STRUCTURE NO. 3
BRIDGE LAYOUT PLAN, LONGITUDINAL SECTION / ELEVATION
HALEAKALA HIGHWAY WIDENING, PHASE 2
HANA HIGHWAY TO PUKALANI BYPASS
FED. AID PROJ. NO. NH-037-1(24)
SCALE: AS NOTED DATE: MAY 2005
SHEET No. S-7 OF 26 SHEETS


FED. ROAD DIST. NO.	STATE	FED. AID PROJ. NO.	FISCAL YEAR	SHEET NO.	TOTAL SHEETS
HAWAII	HAW.	NH-037-1(24)	2005	C.O. 242	288

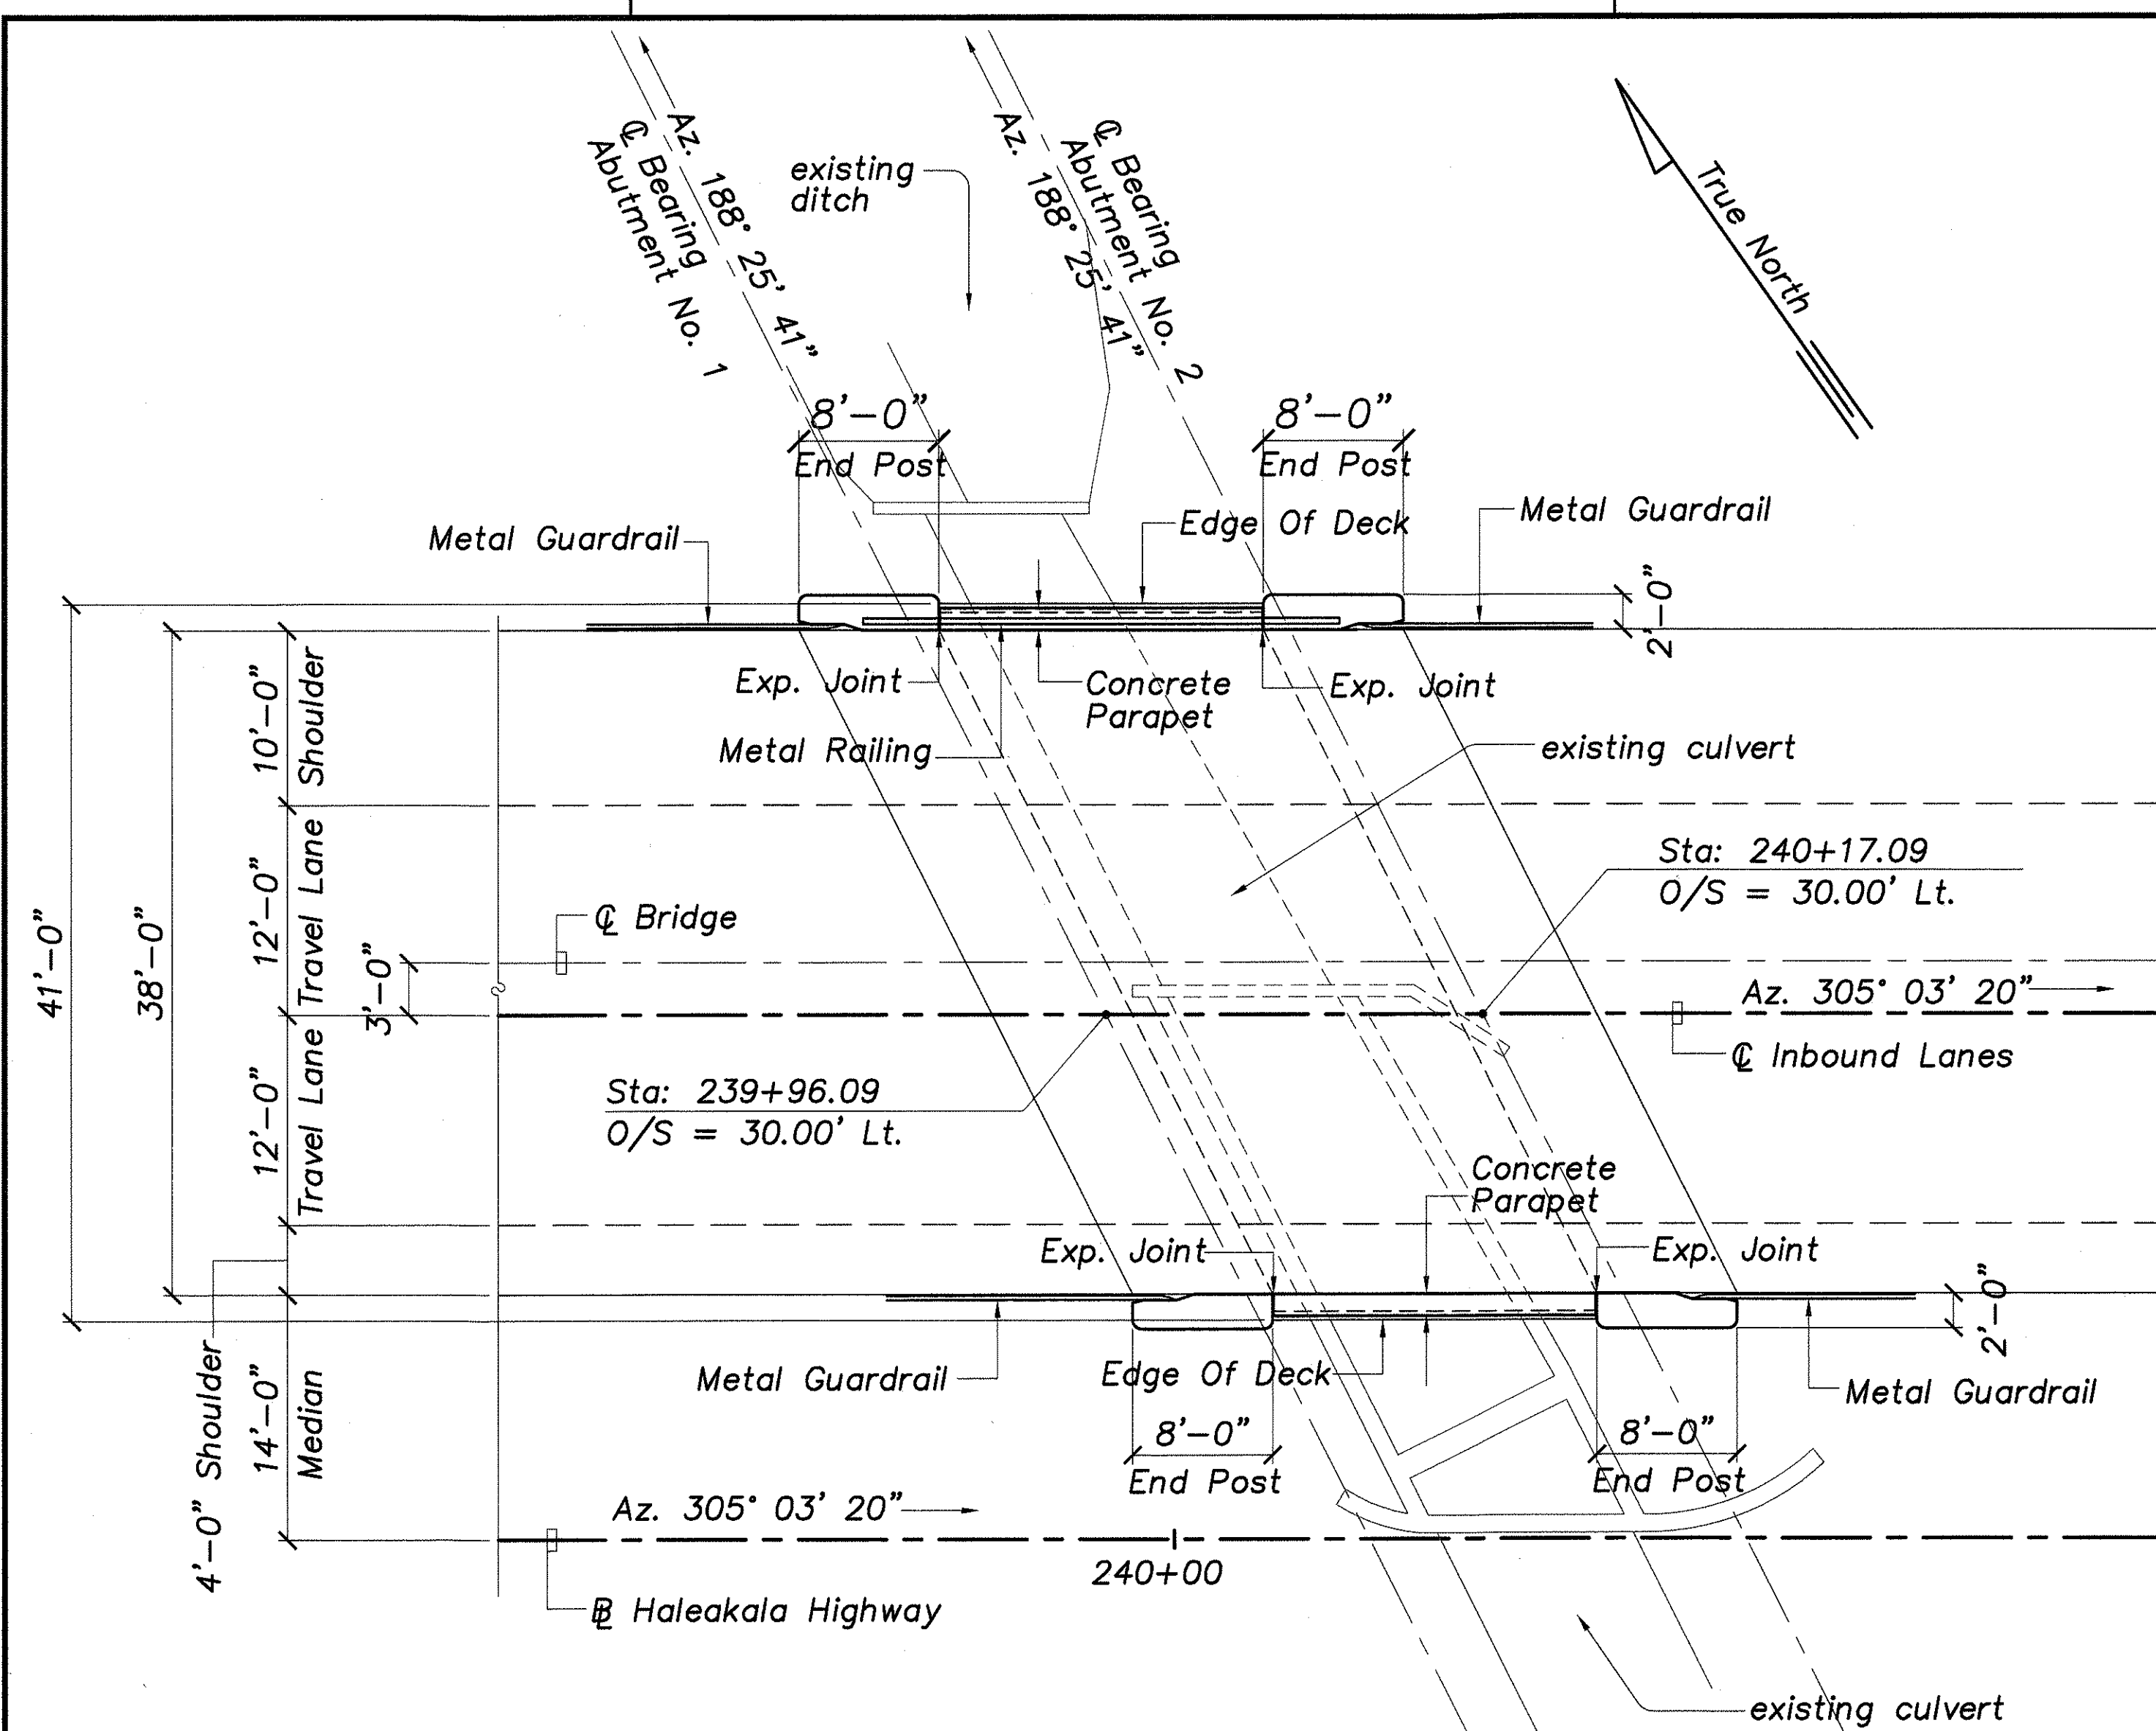

AT KAHIKOA DITCH CROSSING
 WATERWAY STRUCTURE NO. 4 BRIDGE LAYOUT PLAN
 Scale: 1/8"=1'-0"

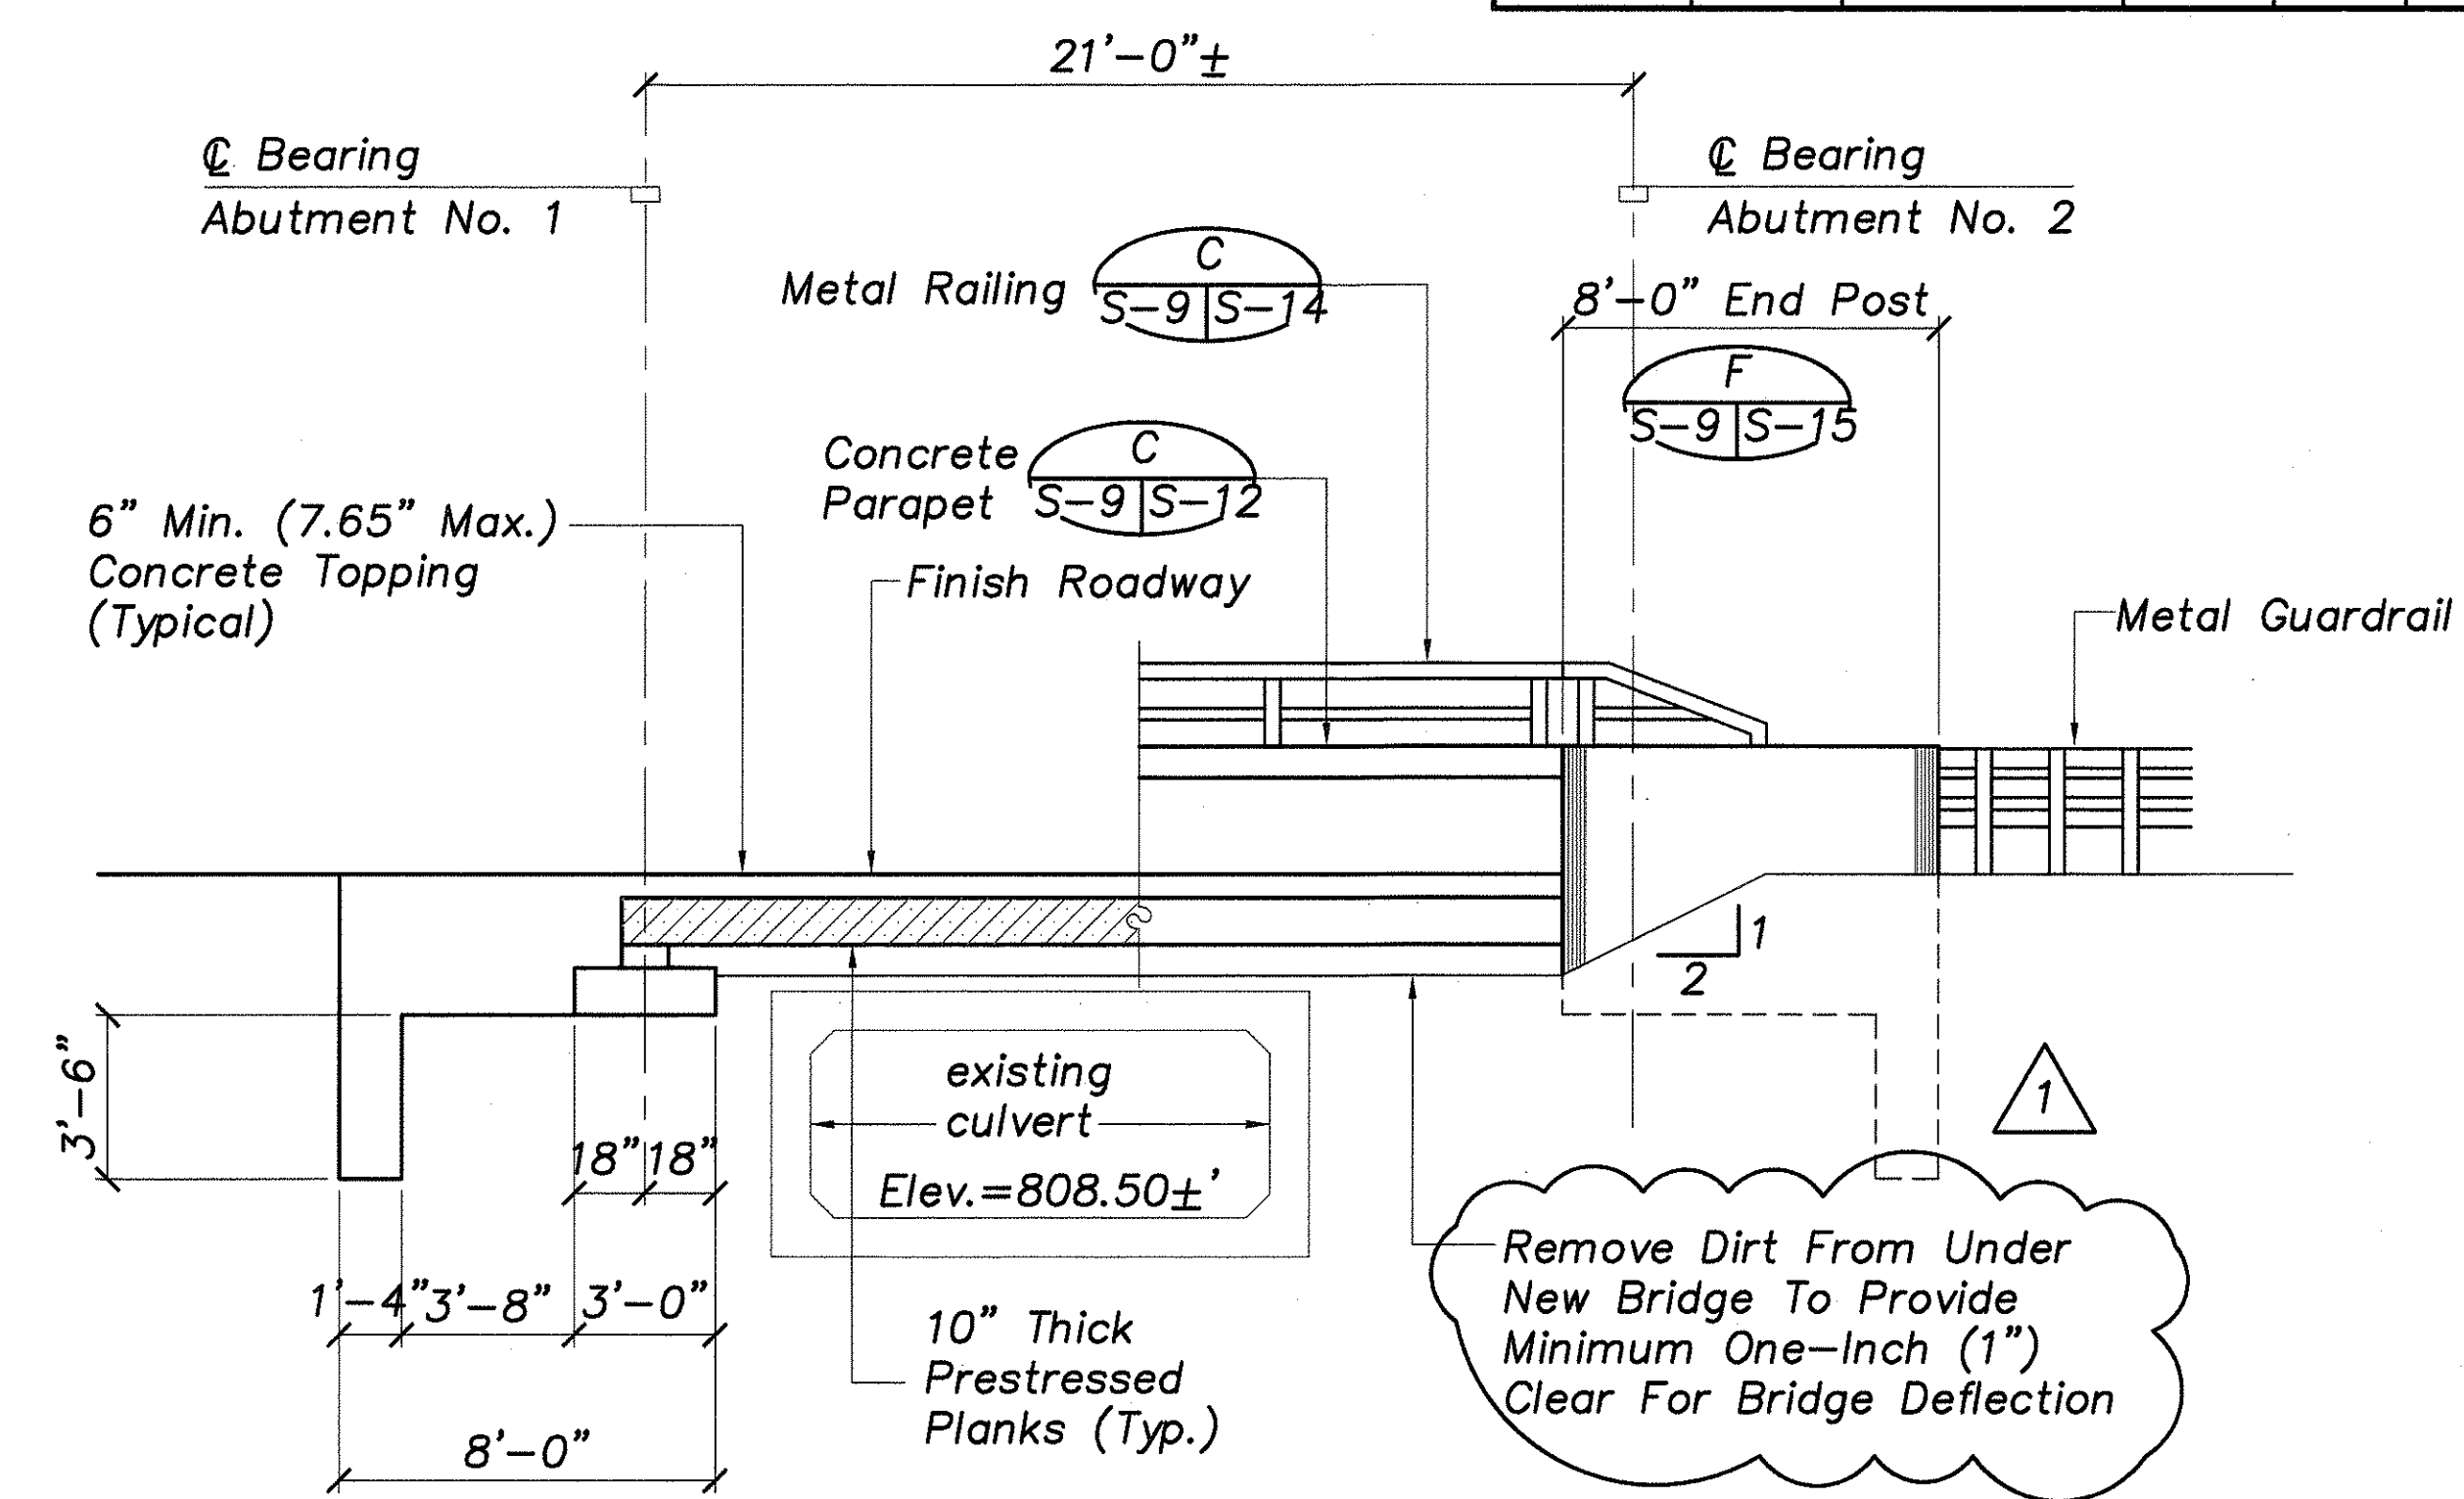


TYPICAL LONGITUDINAL SECTION / ELEVATION
 Scale: 1/4"=1'-0"

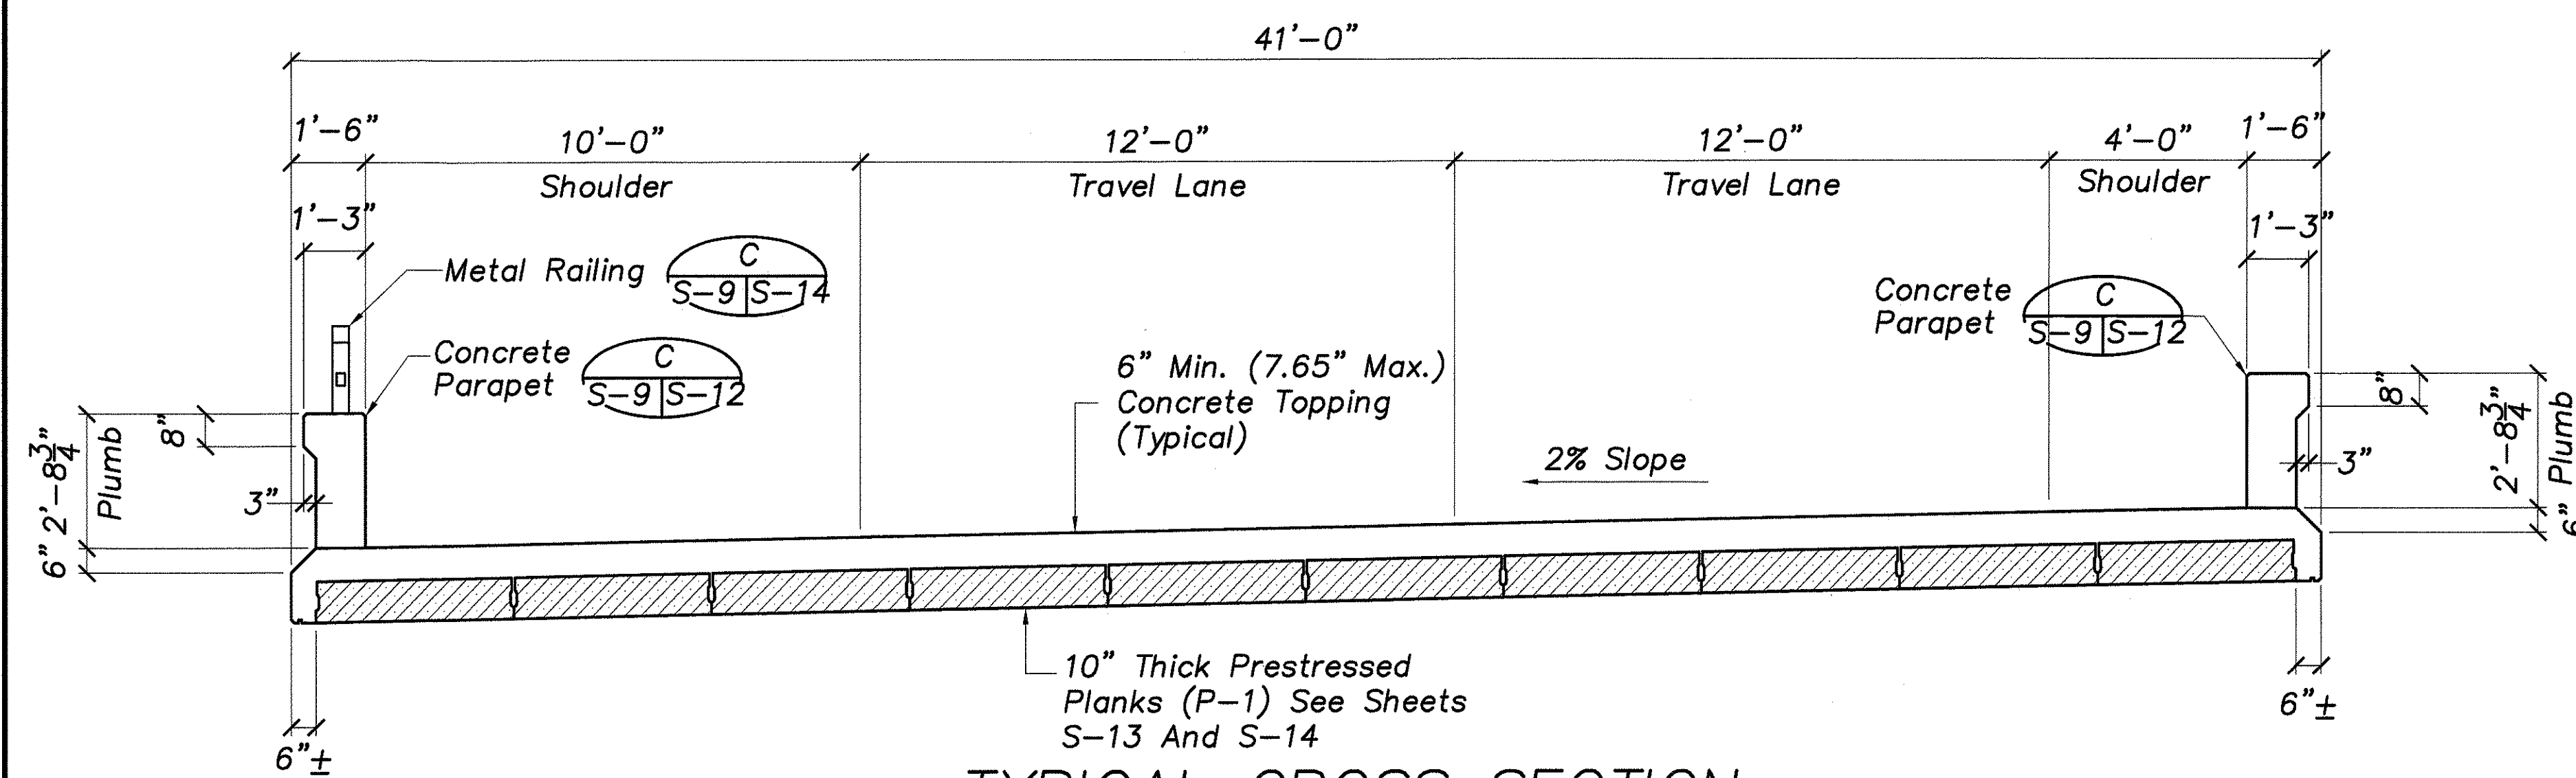

TYPICAL CROSS SECTION
 Scale: 3/8"=1'-0"


DATE	
SURVEY PLOTTED BY	
DRAWN BY	
TRACED BY	
DESIGNED BY	
CHECKED BY	
NO. BOOK	
ORIGINAL PLAN	

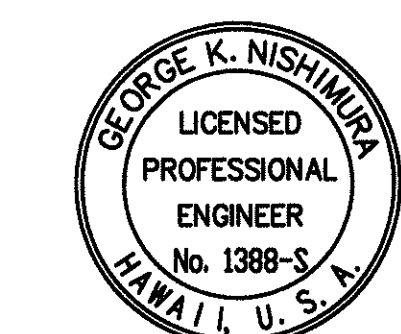

THIS WORK WAS PREPARED BY ME OR UNDER MY SUPERVISION.
 SIGNATURE
 04/30/06
 EXPIRATION DATE OF PROFESSIONAL LICENSE


3/24/07	1	Added Callout
Date		Revision
STATE OF HAWAII DEPARTMENT OF TRANSPORTATION HIGHWAYS DIVISION WATERWAY STRUCTURE NO. 4 BRIDGE LAYOUT PLAN, LONGITUDINAL SECTION / ELEVATION, CROSS SECTION HALEAKALA HIGHWAY WIDENING, PHASE 2 HANA HIGHWAY TO PUKALANI BYPASS FED. AID PROJ. NO. NH-037-1(24) SCALE: AS NOTED DATE: MAY 2005 SHEET No. S-9 OF 26 SHEETS		

FED. ROAD DIST. NO.	STATE	FED. AID PROJ. NO.	FISCAL YEAR	SHEET NO.	TOTAL SHEETS
HAWAII	HAW.	NH-037-1(24)	2005	C.O. 243	288

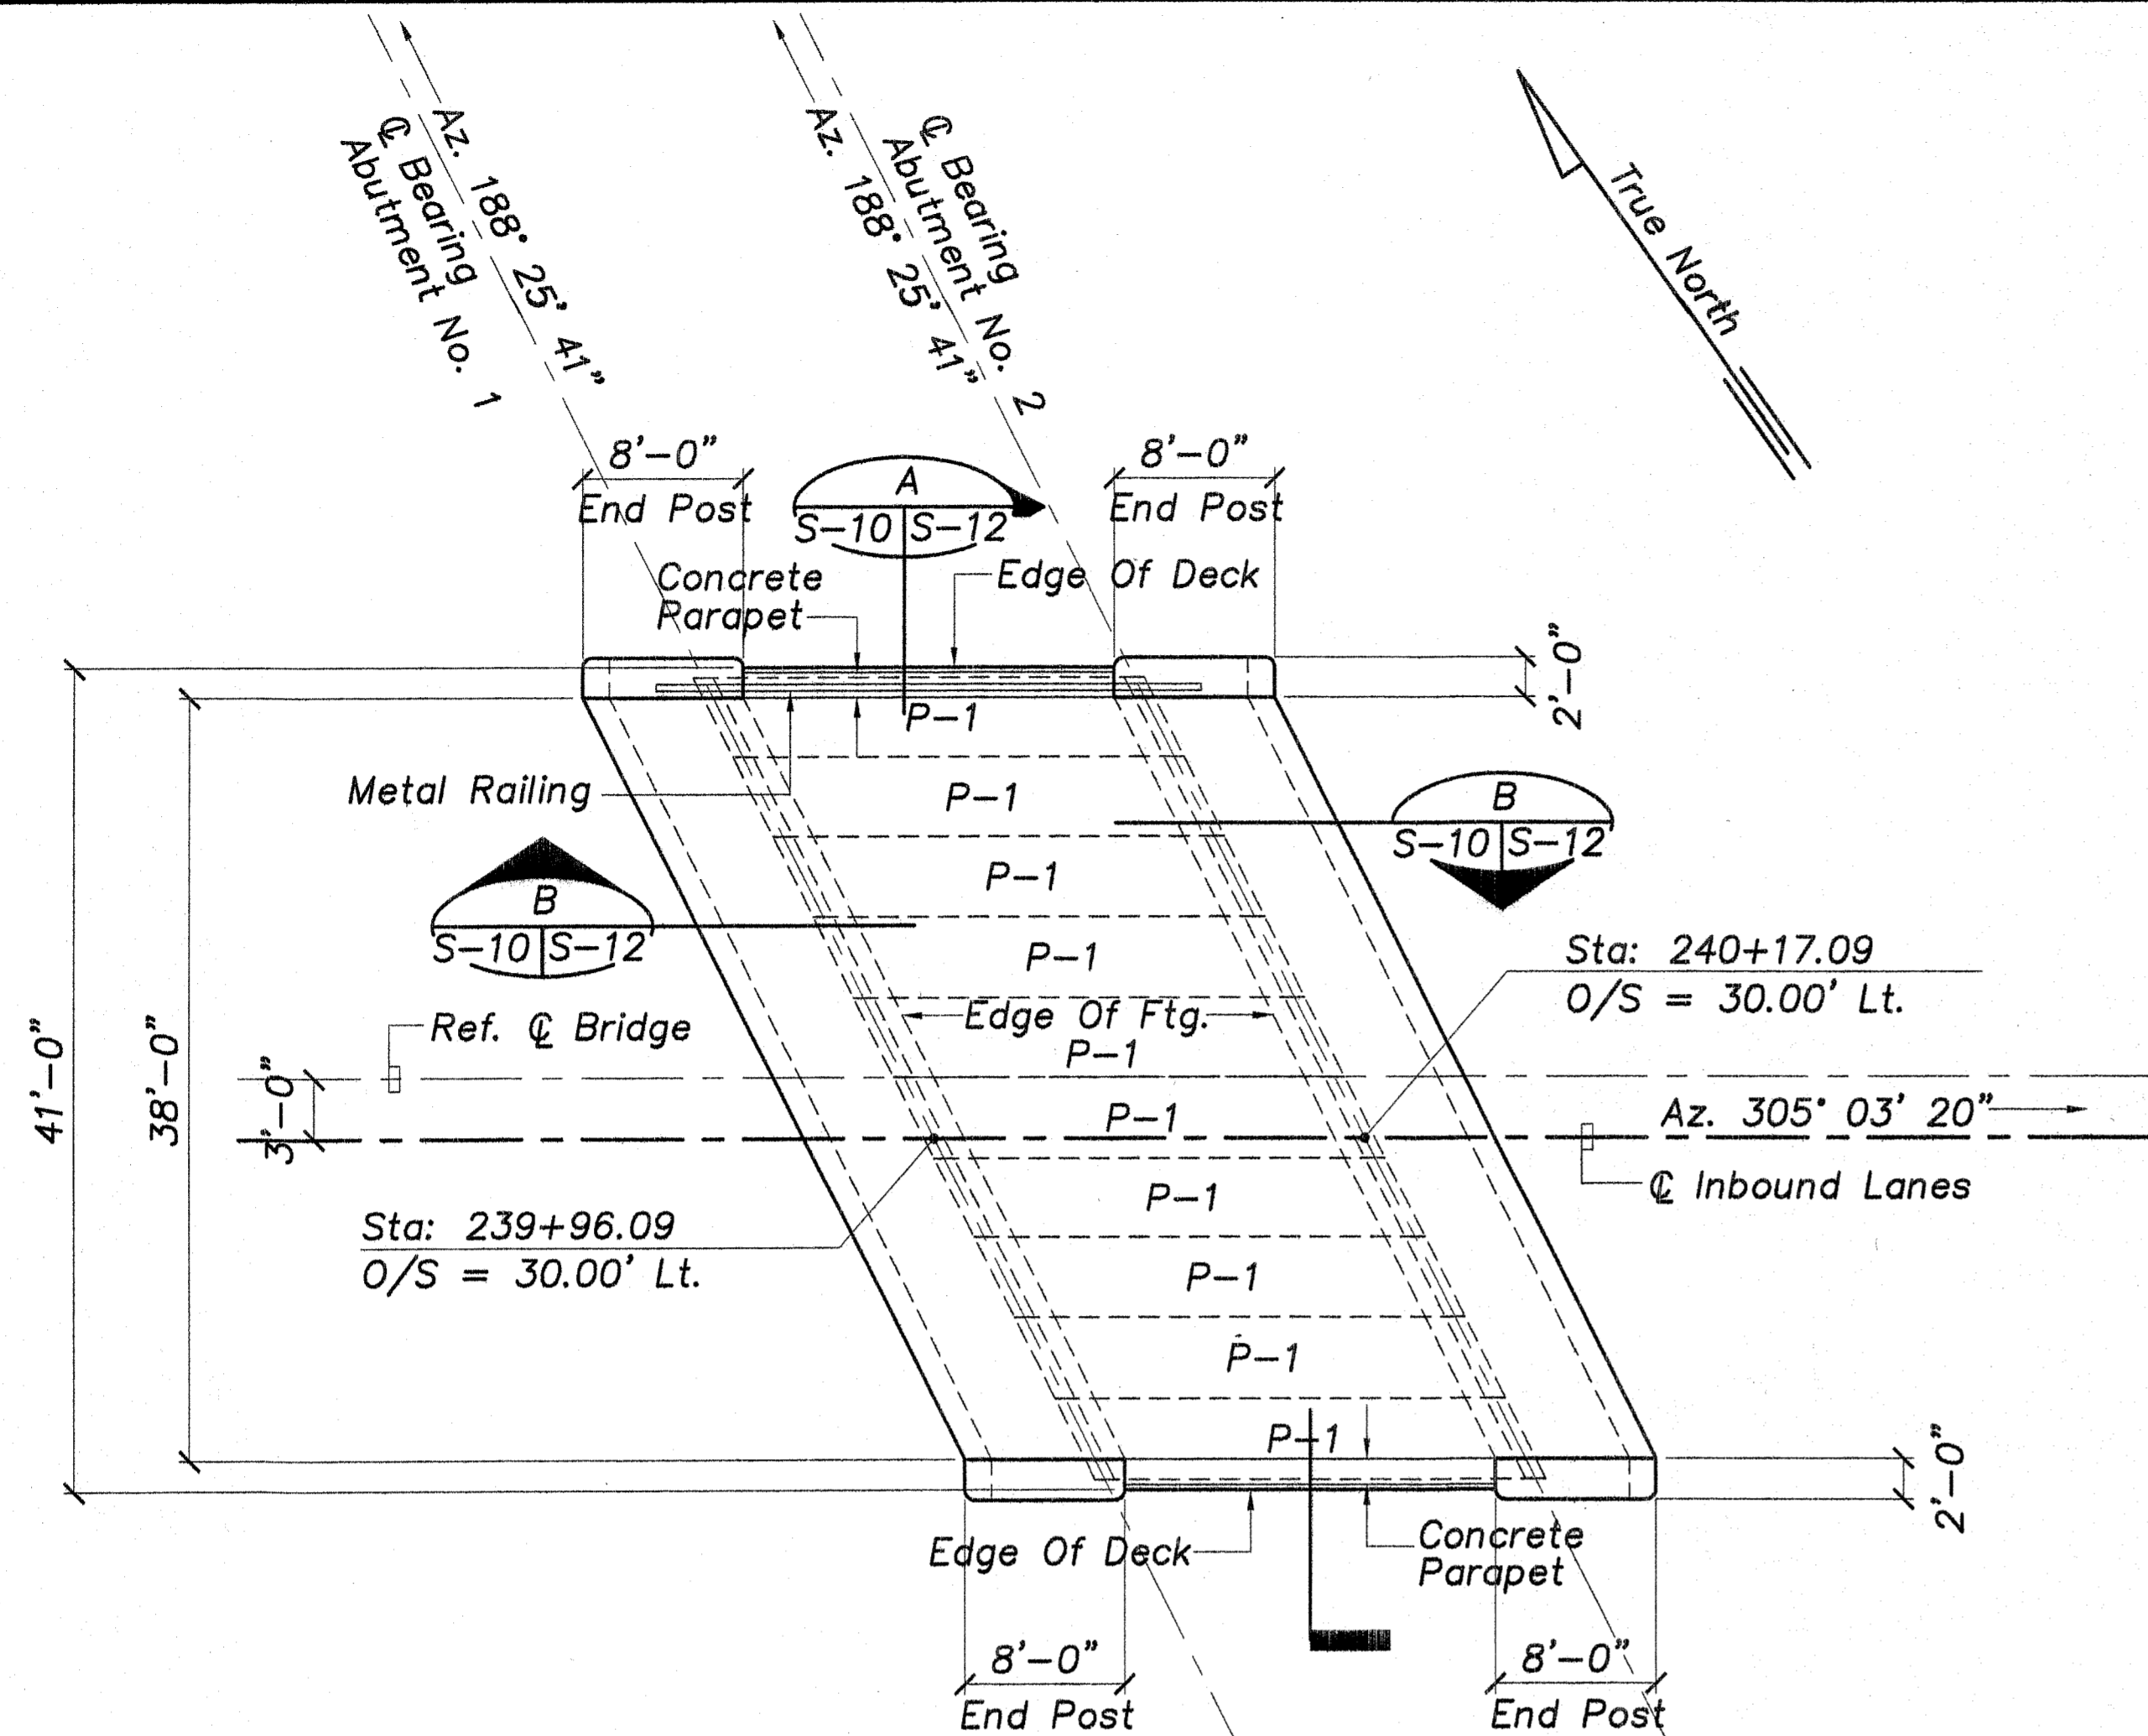

AT KAHIKOA DITCH CROSSING
 WATERWAY STRUCTURE NO. 4 FOUNDATION / FRAMING PLAN

Scale: 1/8"=1'-0"

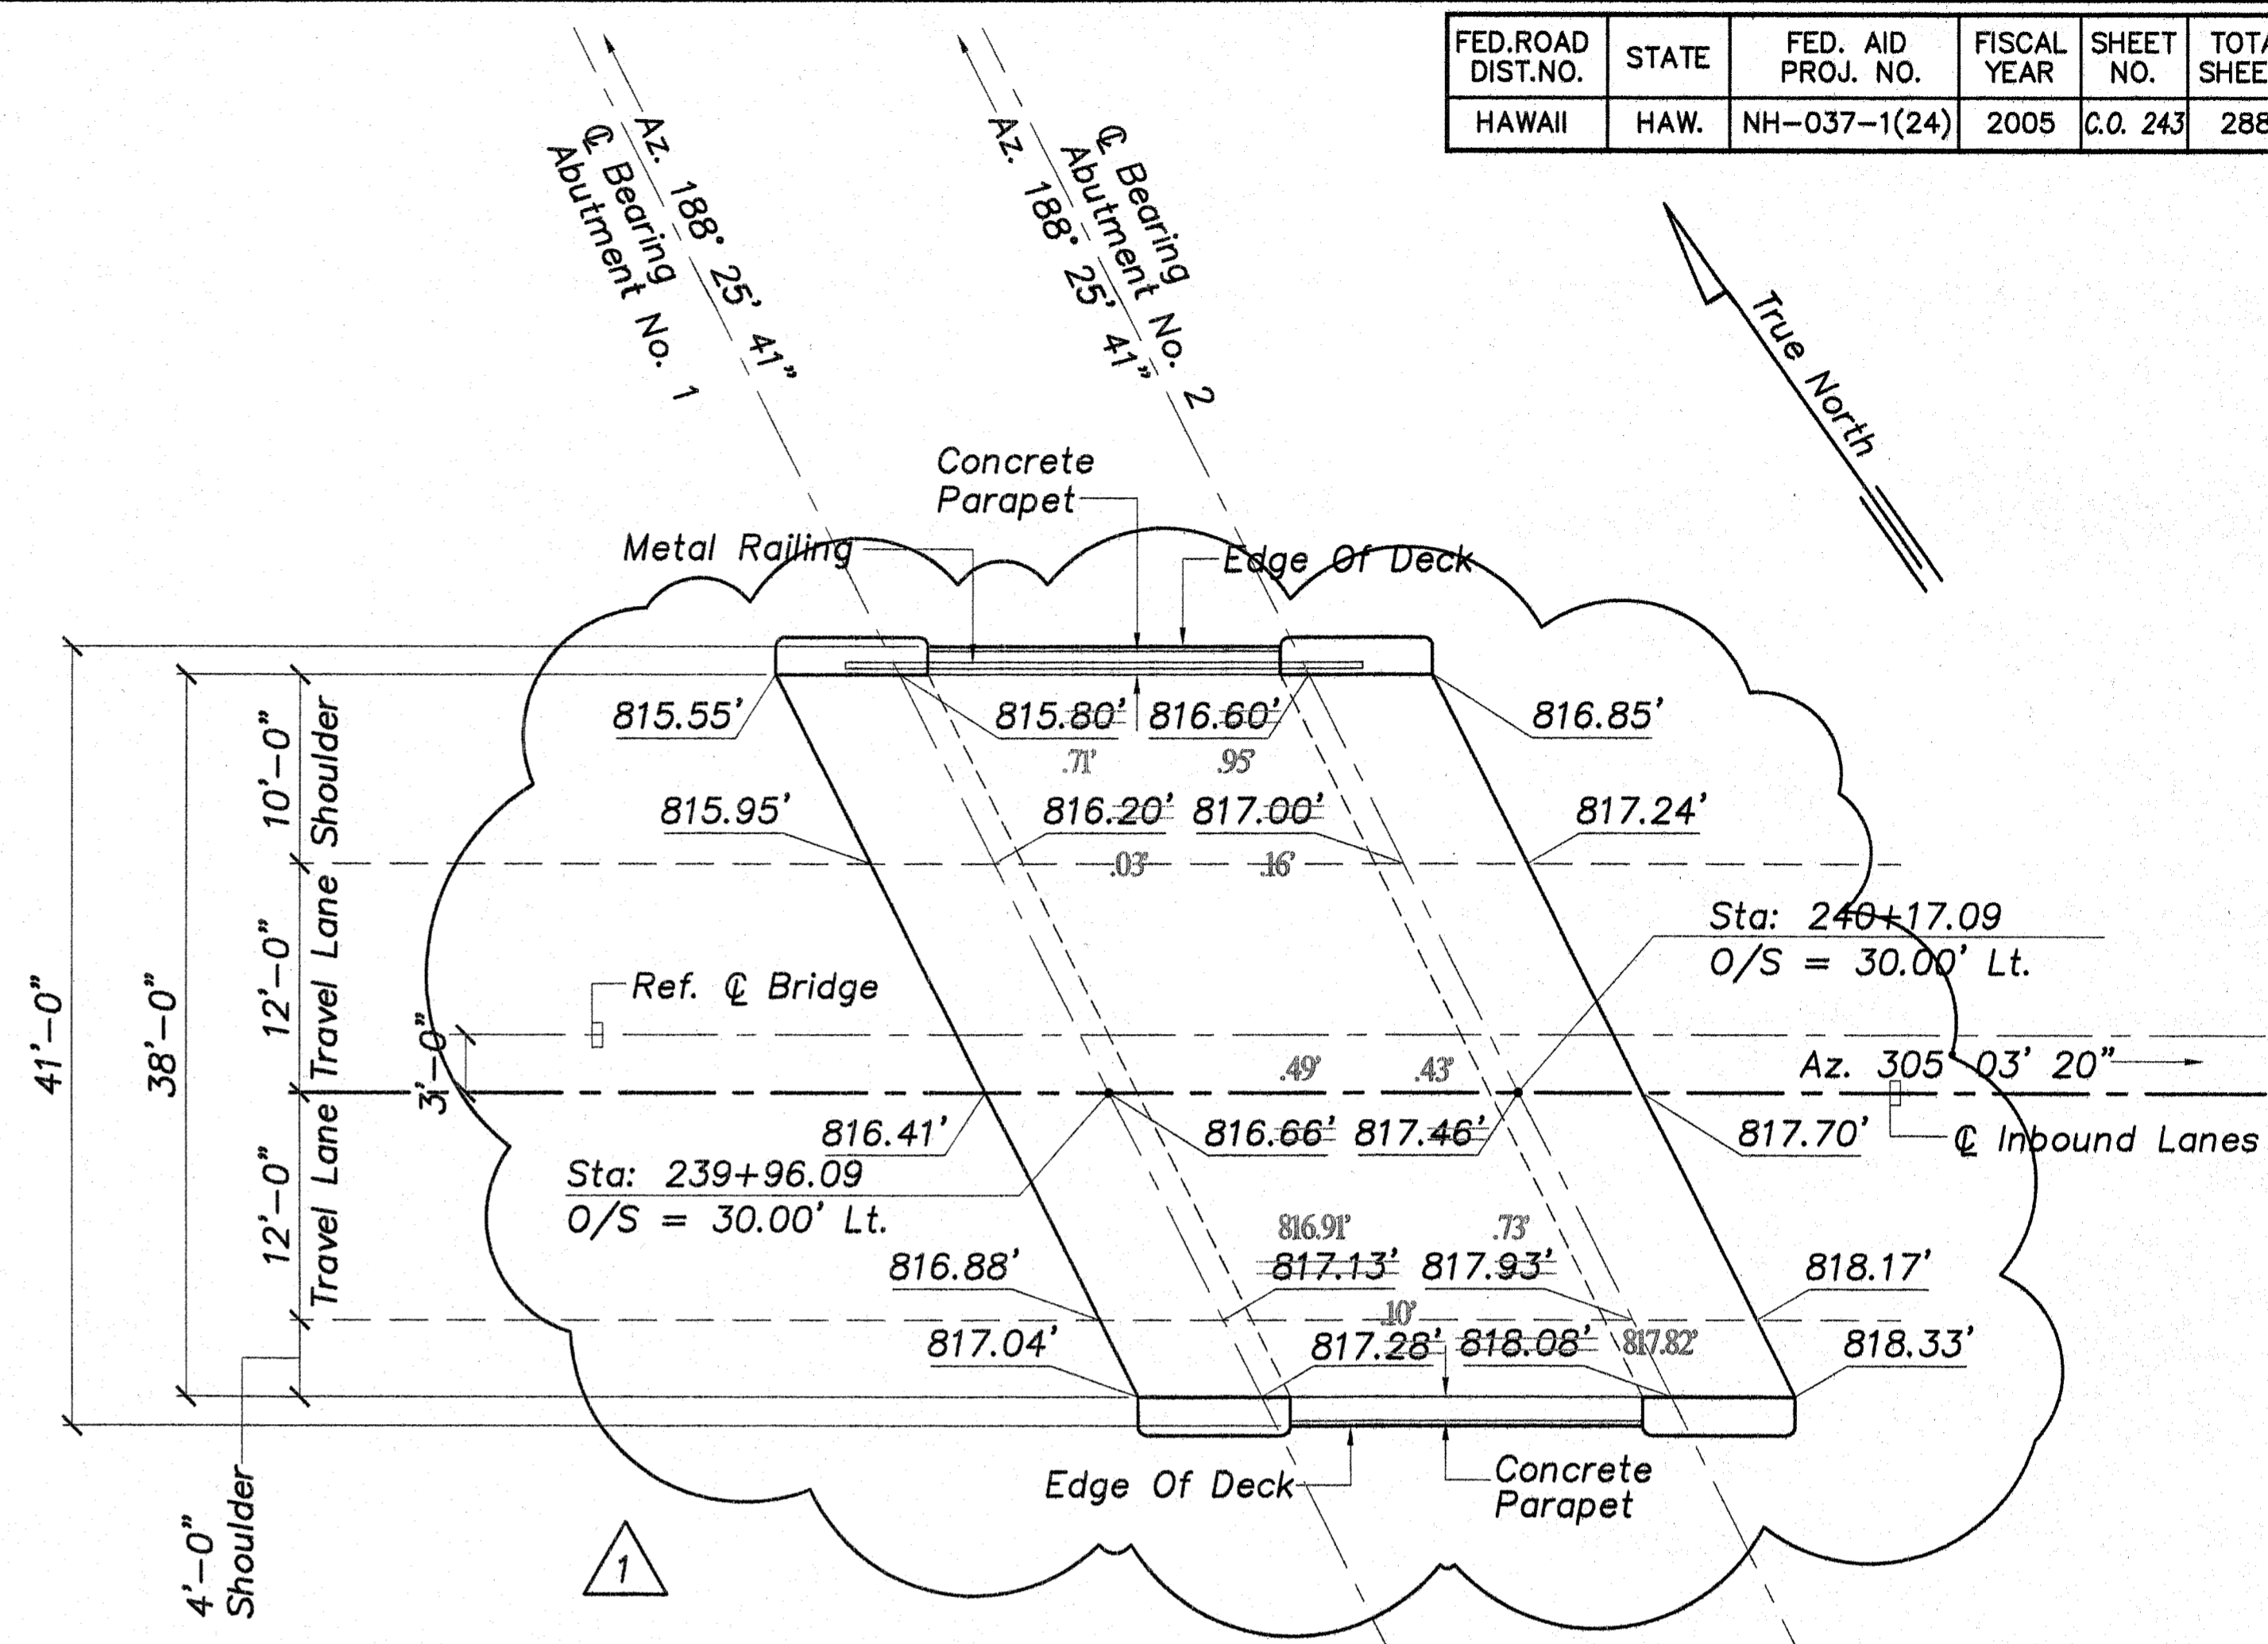

AT KAHIKOA DITCH CROSSING
 WATERWAY STRUCTURE NO. 4 SLAB ELEVATION PLAN

Scale: 1/8"=1'-0"

SURVEY PLOTTED BY	DATE
DRAWN BY	
TRACED BY	
CHECKED BY	
NO. OF SHEETS	
CHECKED BY	
NO.	

LEGEND FOR AS-BUILT POSTINGS	
	Squiggly line for as-built deletion
	Double line for as-built deletion
	Roadway Text for as-built posting



THIS WORK WAS PREPARED BY
 ME OR UNDER MY SUPERVISION
 SIGNATURE
 04/30/10
 EXPIRATION DATE OF PROFESSIONAL LICENSE

3/24/07	1	Revised Bridge Deck Finish Grades
Date		Revision


STATE OF HAWAII
 DEPARTMENT OF TRANSPORTATION
 HIGHWAYS DIVISION
**WATERWAY STRUCTURE NO. 4
 FOUNDATION / FRAMING PLAN,
 SLAB ELEVATION PLAN**
 HALEAKALA HIGHWAY WIDENING, PHASE 2
 HANA HIGHWAY TO PUKALANI BYPASS
 FED. AID PROJ. NO. NH-037-1(24)
 SCALE: AS NOTED DATE: MAY 2005

AS-BUILT


C.O. 243

SHEET No. S-10 OF 26 SHEETS


FED. ROAD DIST. NO.	STATE	FED. AID PROJ. NO.	FISCAL YEAR	SHEET NO.	TOTAL SHEETS
HAWAII	HAW.	NH-037-1(24)	2005	244	288

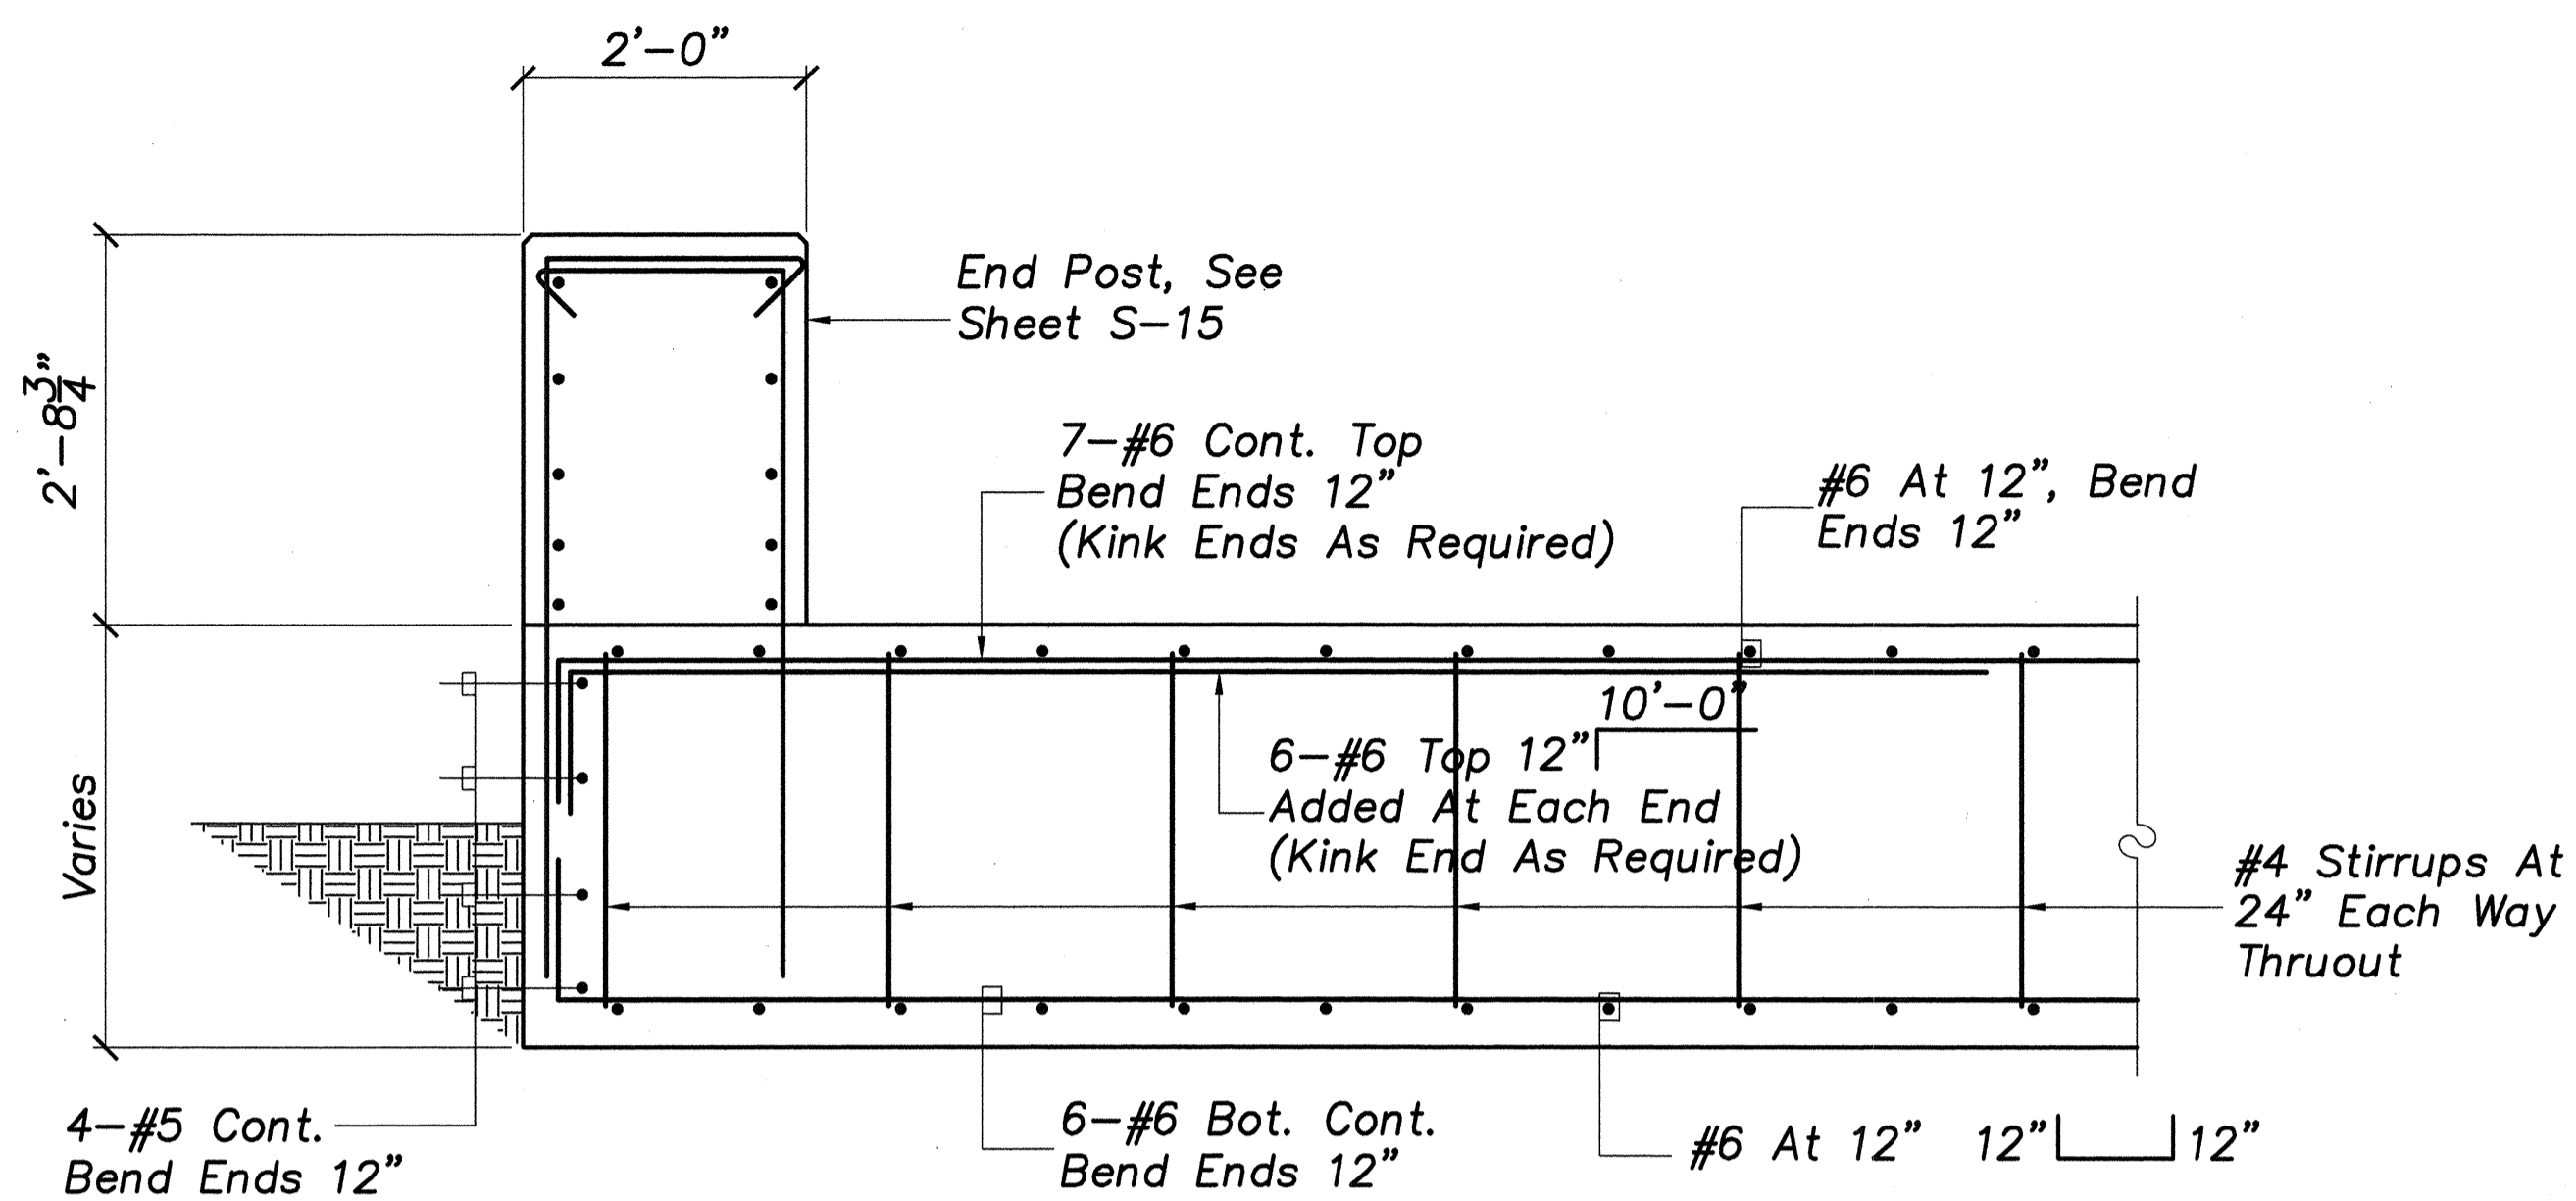

SECTION A
S-11|S-11 Scale: 3/4"=1'-0"

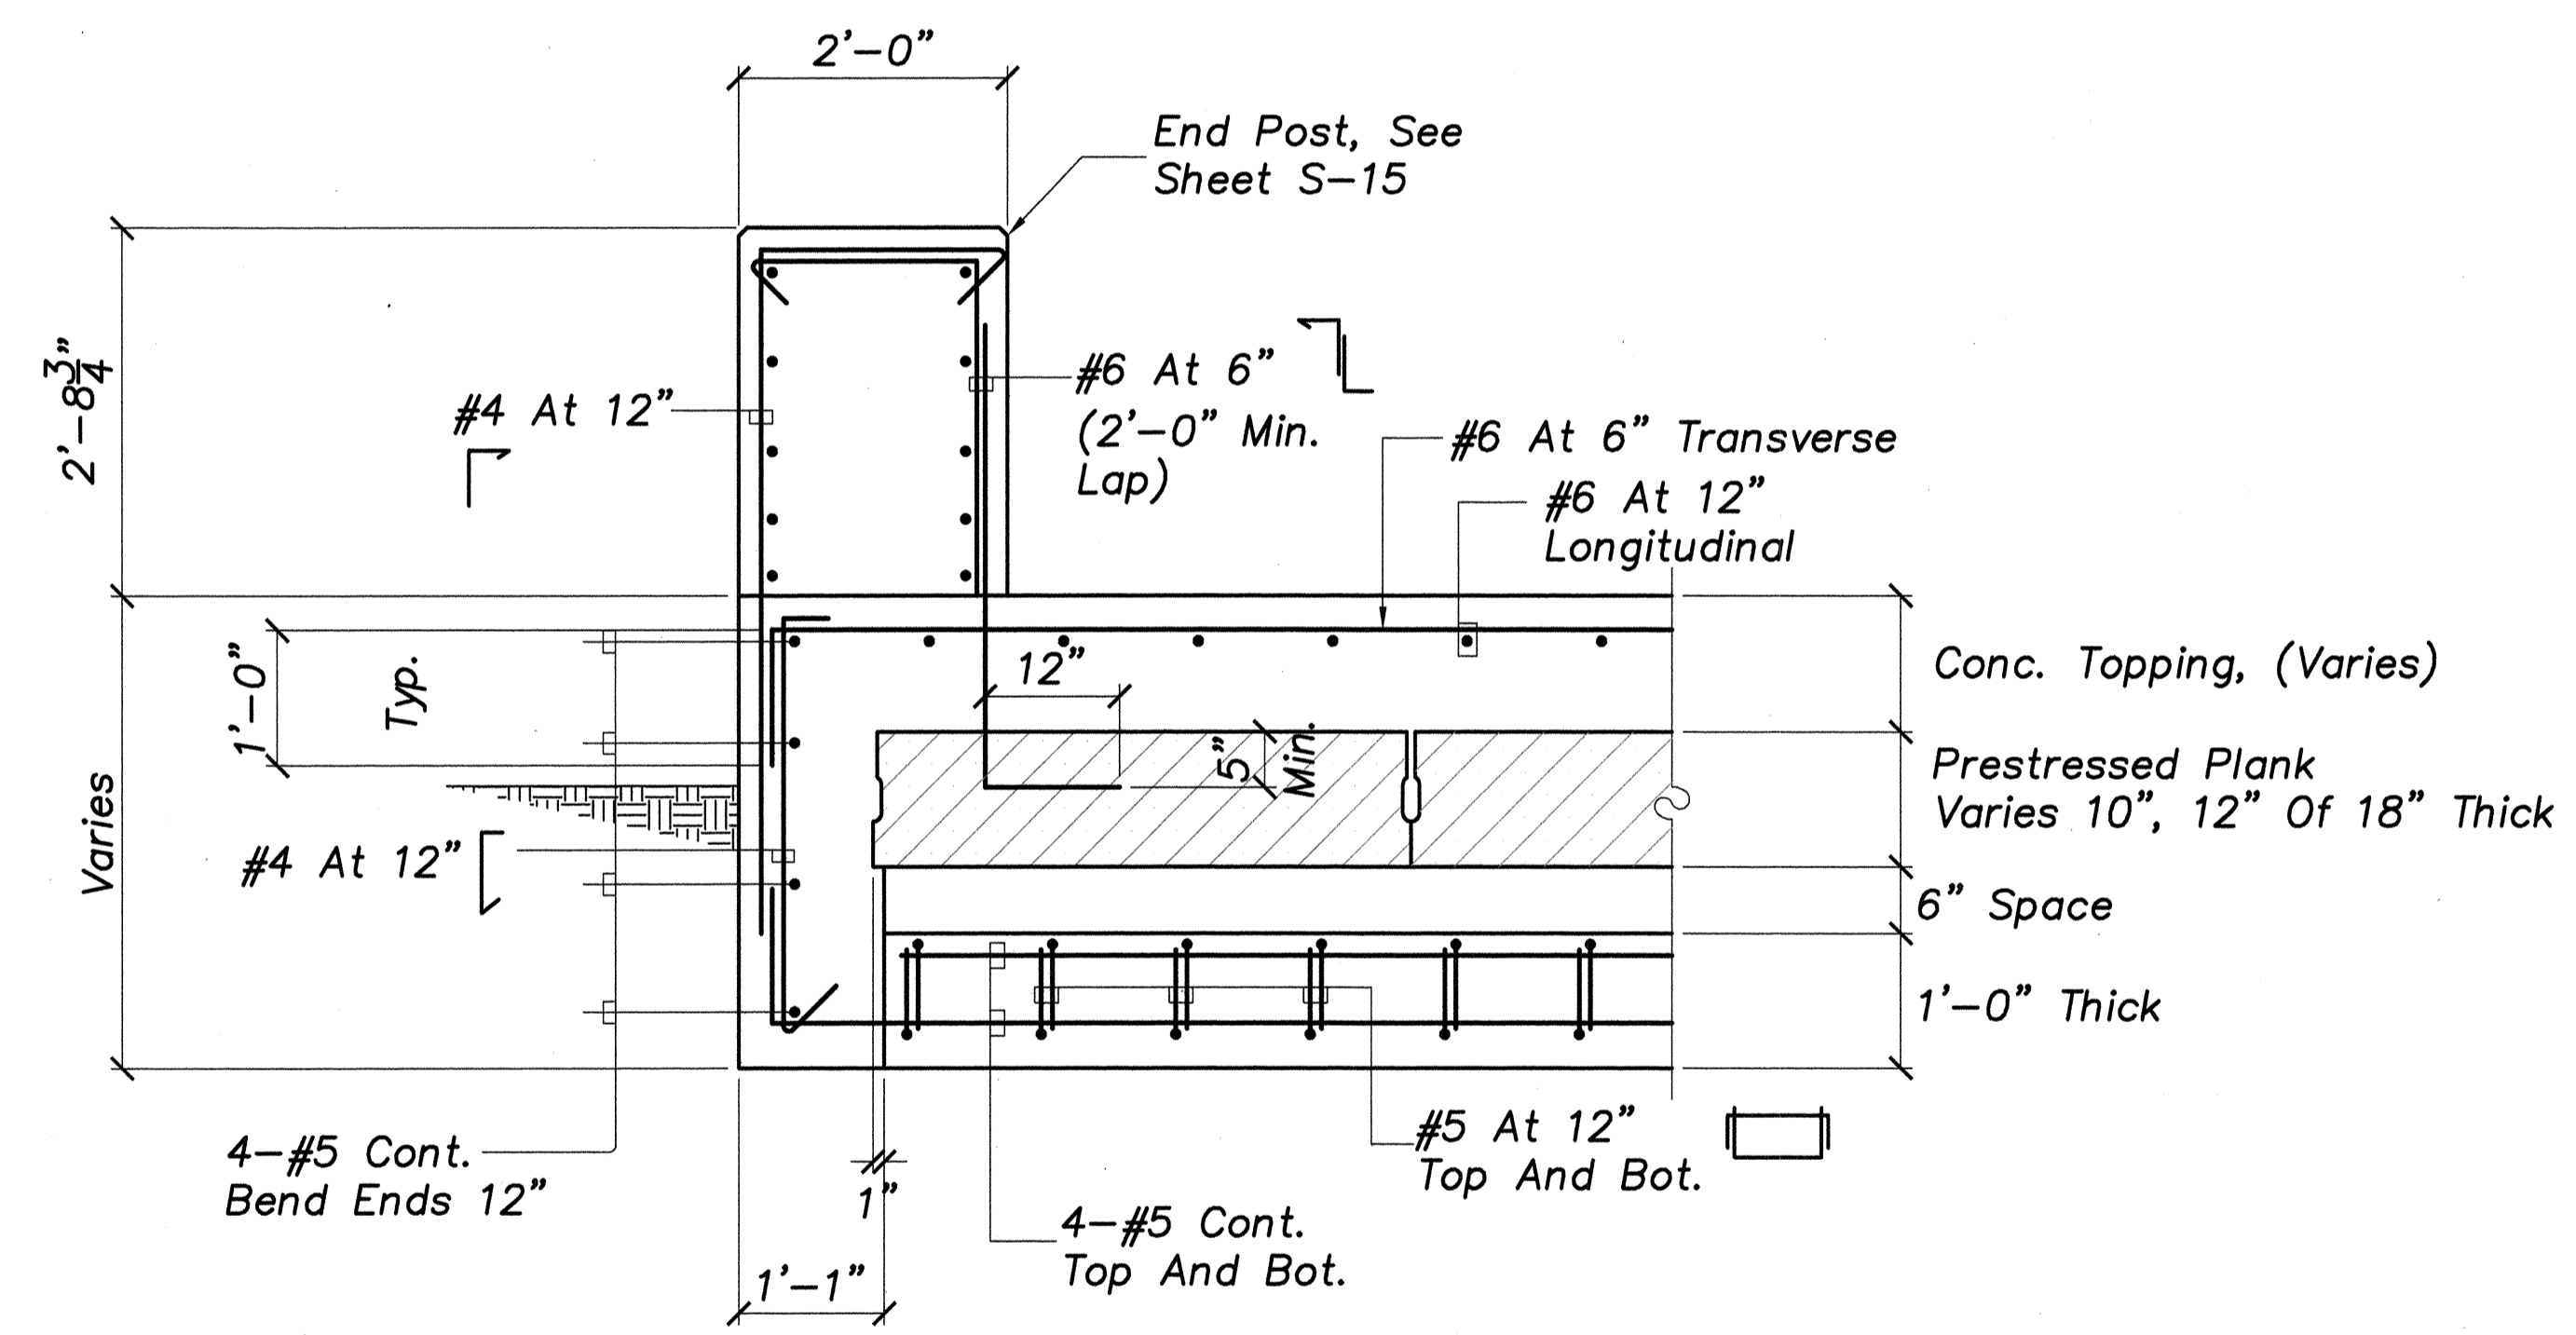


SECTION B
S-11|S-11 Scale: 3/4"=1'-0"

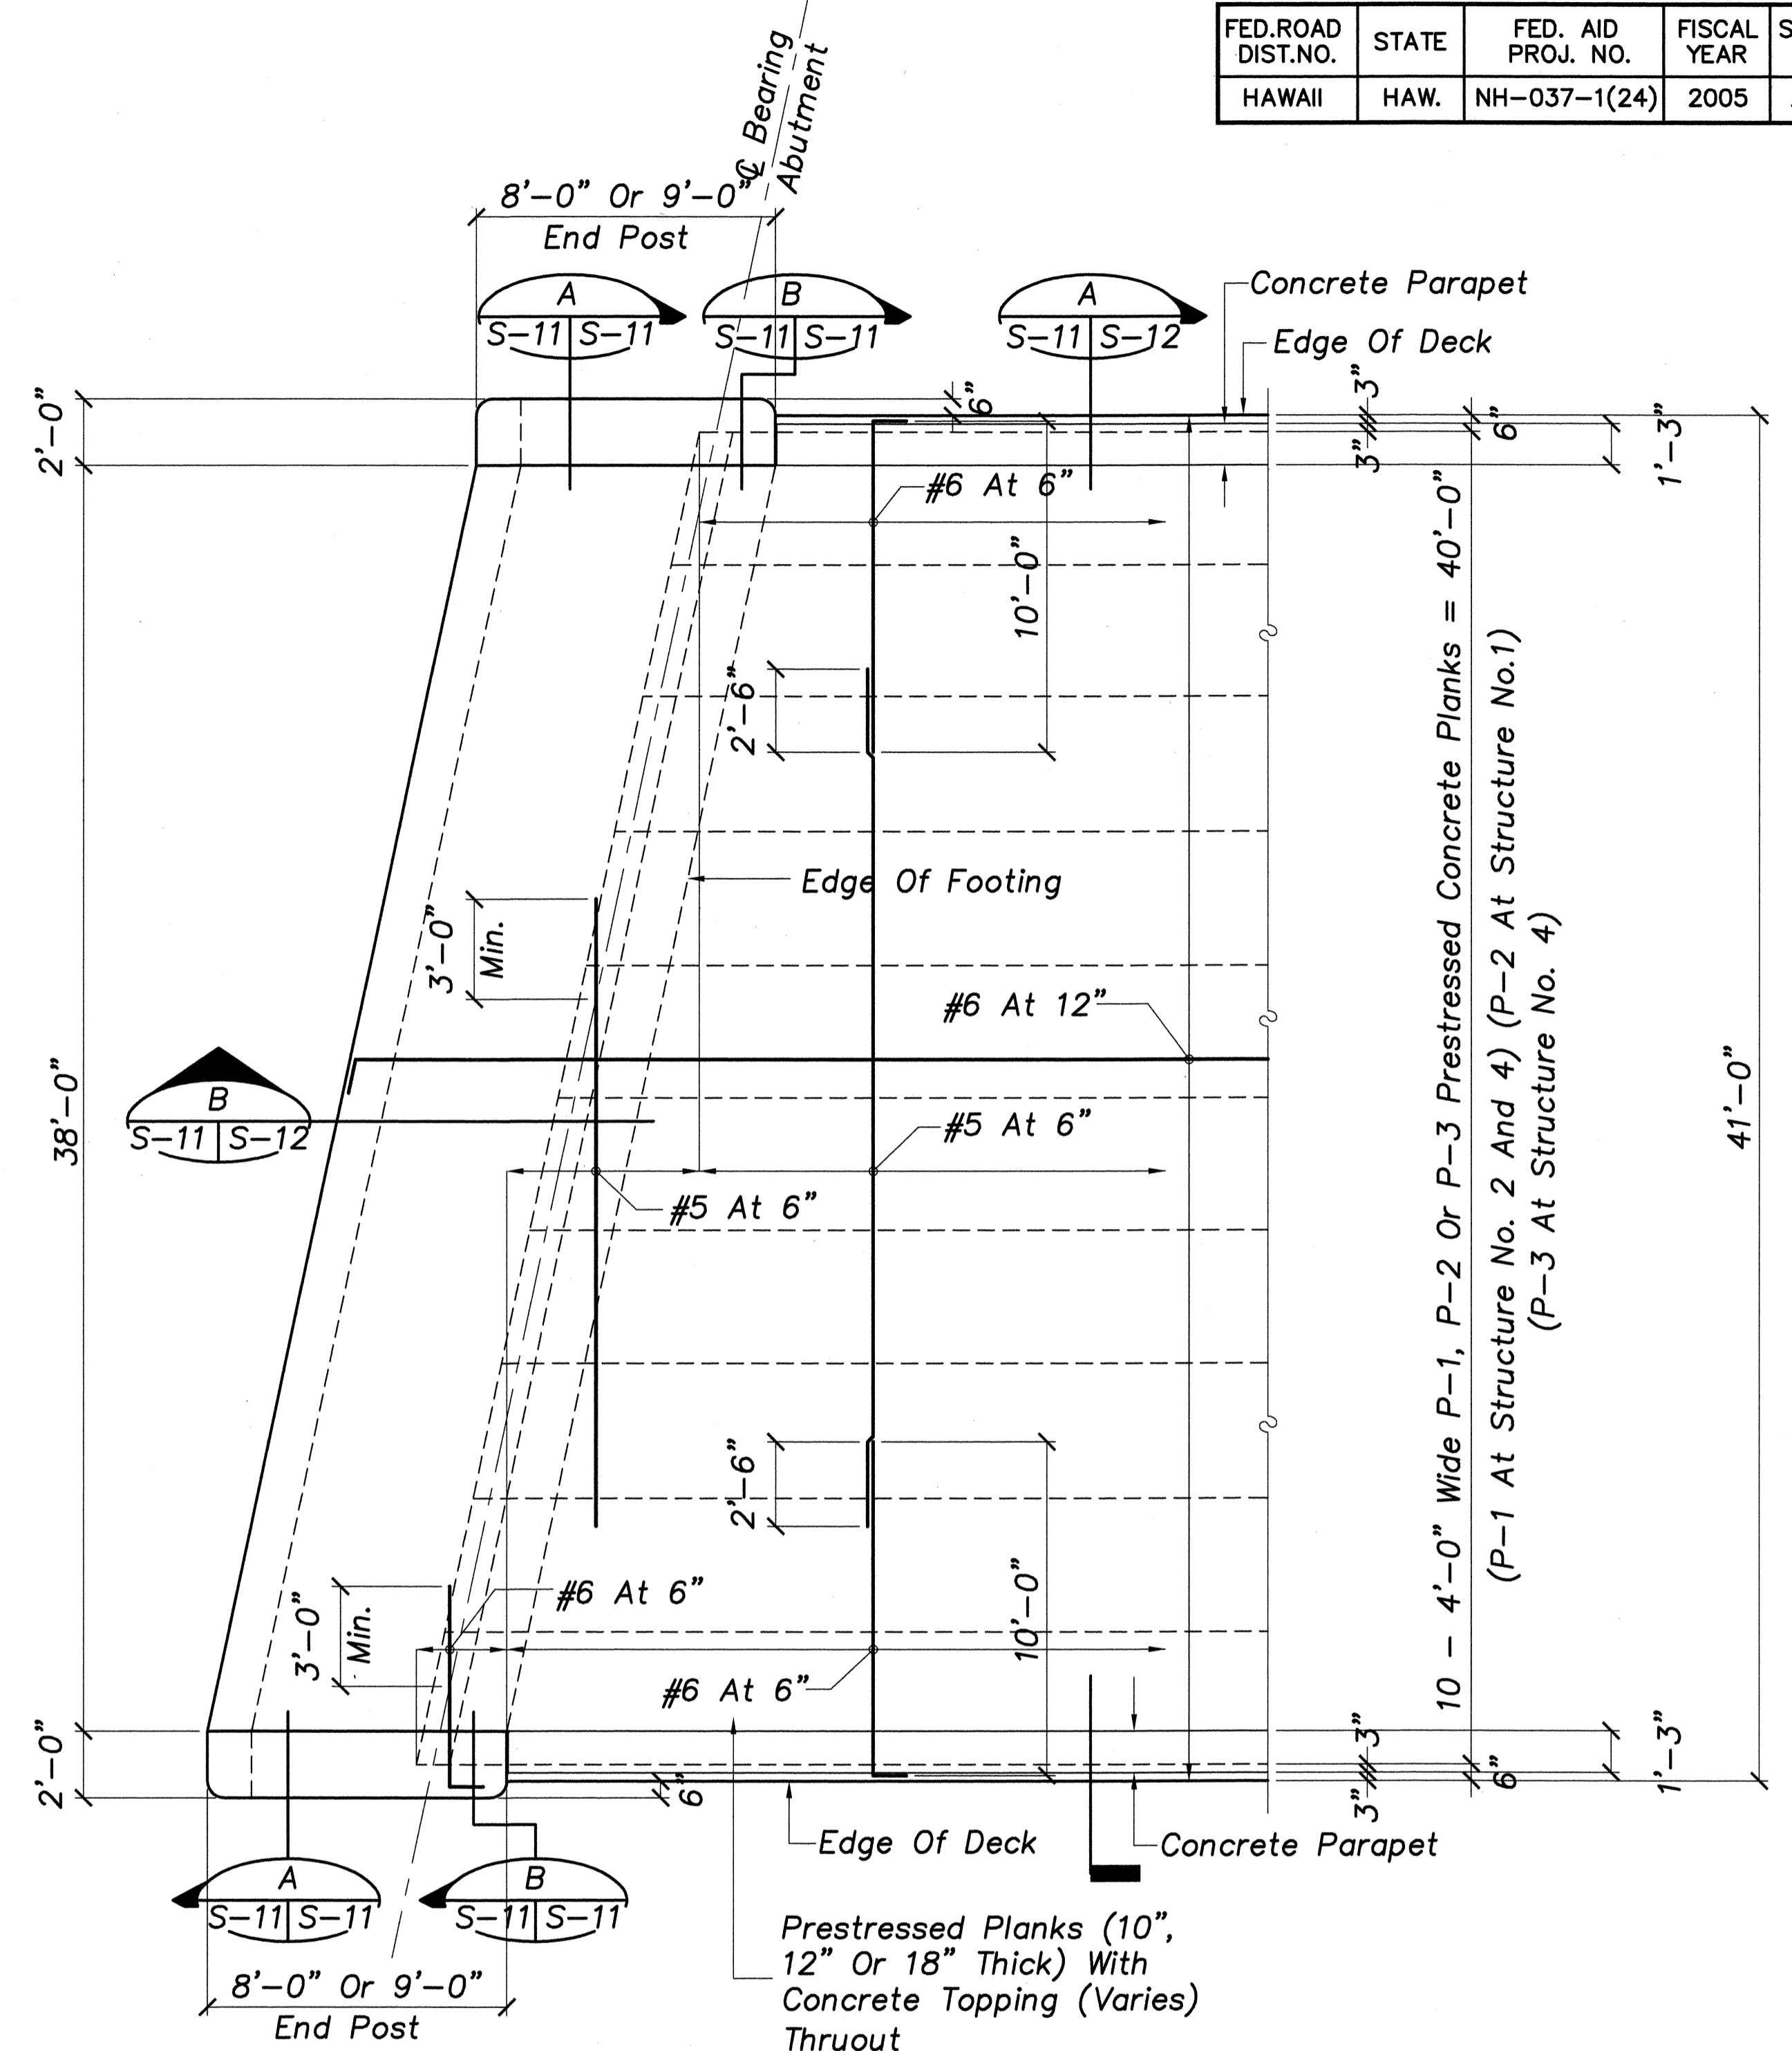

(BRIDGE SYMMETRICAL ABOUT ϕ SPAN)
TYPICAL BRIDGE FOUNDATION / FRAMING PLAN
Scale: 1/4"=1'-0"


DATE	_____
DESIGNED BY	_____
CHECKED BY	_____
NO. _____	_____

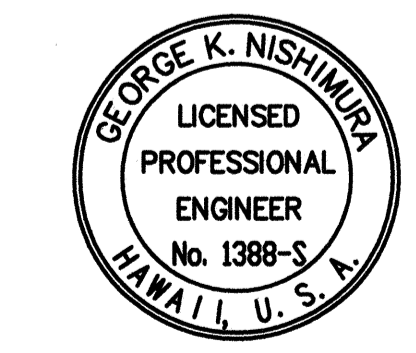

THIS WORK WAS PREPARED BY ME OR UNDER MY SUPERVISION.
SIGNATURE
04/30/06
EXPIRATION DATE OF PROFESSIONAL LICENSE

STATE OF HAWAII
DEPARTMENT OF TRANSPORTATION
HIGHWAYS DIVISION
TYPICAL BRIDGE FOUNDATION / FRAMING PLAN
HALEAKALA HIGHWAY WIDENING, PHASE 2
HANA HIGHWAY TO PUKALANI BYPASS
FED. AID PROJ. NO. NH-037-1(24)
SCALE: AS NOTED DATE: MAY 2005
SHEET No. S-11 OF 26 SHEETS

FED. ROAD DIST. NO.	STATE	FED. AID PROJ. NO.	FISCAL YEAR	SHEET NO.	TOTAL SHEETS
HAWAII	HAW.	NH-037-1(24)	2005	245	288

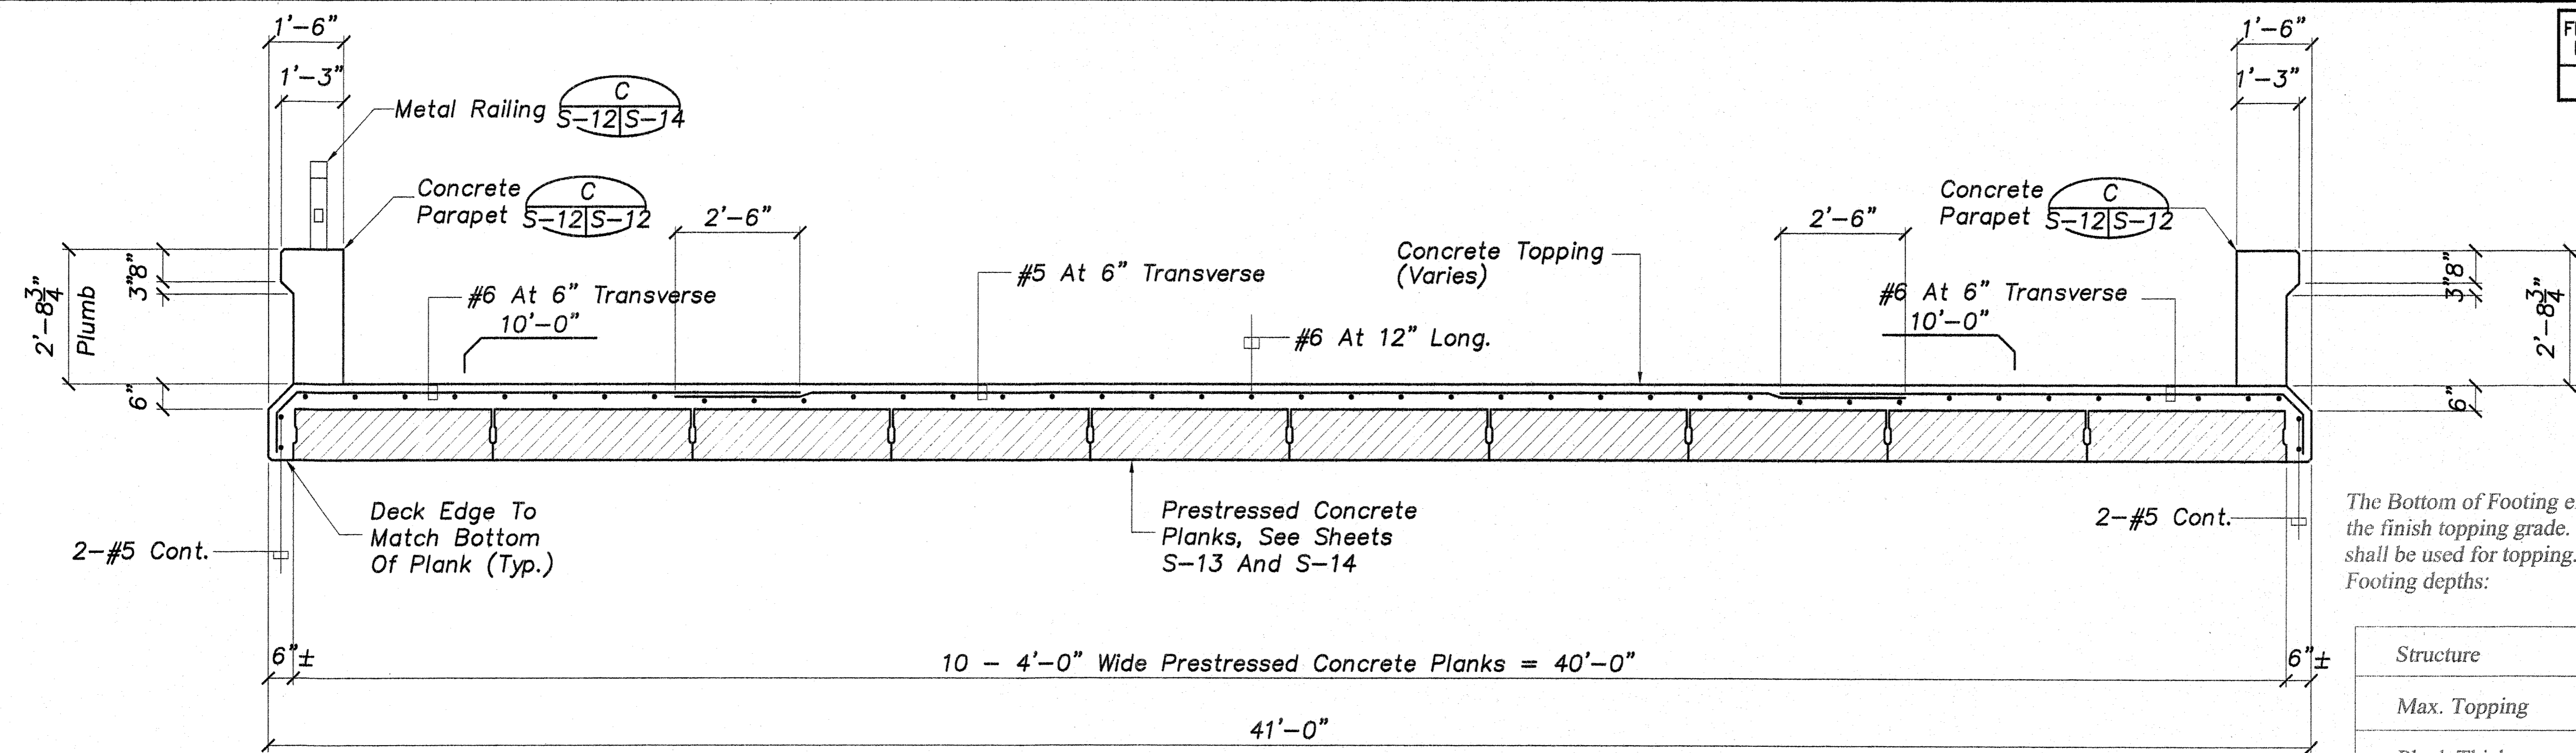


TYPICAL CROSS SECTION
 S-4, S-6, S-8, S-12 Scale: 1/2"=1'-0"
 S-10, S-11


The Bottom of Footing elevation shall be determined by calculating down from the finish topping grade. The maximum topping thickness given on the plans shall be used for topping. The following are the Finish Grade to Bottom of Footing depths:

Structure	No. 1	No. 2	No. 3	No. 4
Max. Topping	8.04"	7.65"	8.50"	7.65"
Plank Thickness	12"	10"	18"	10"
Seat Height	6"	6"	6"	6"
Footing Thickness	12"	12"	12"	12"
Depth	38.04" (3.17')	35.65" (2.97')	44.50" (3.71')	35.65" (2.97')


It should be noted that the depth shall be constant and that the Bottom of Footing shall be sloped from edge of deck to edge of deck and from approach edge to centerline bearing.

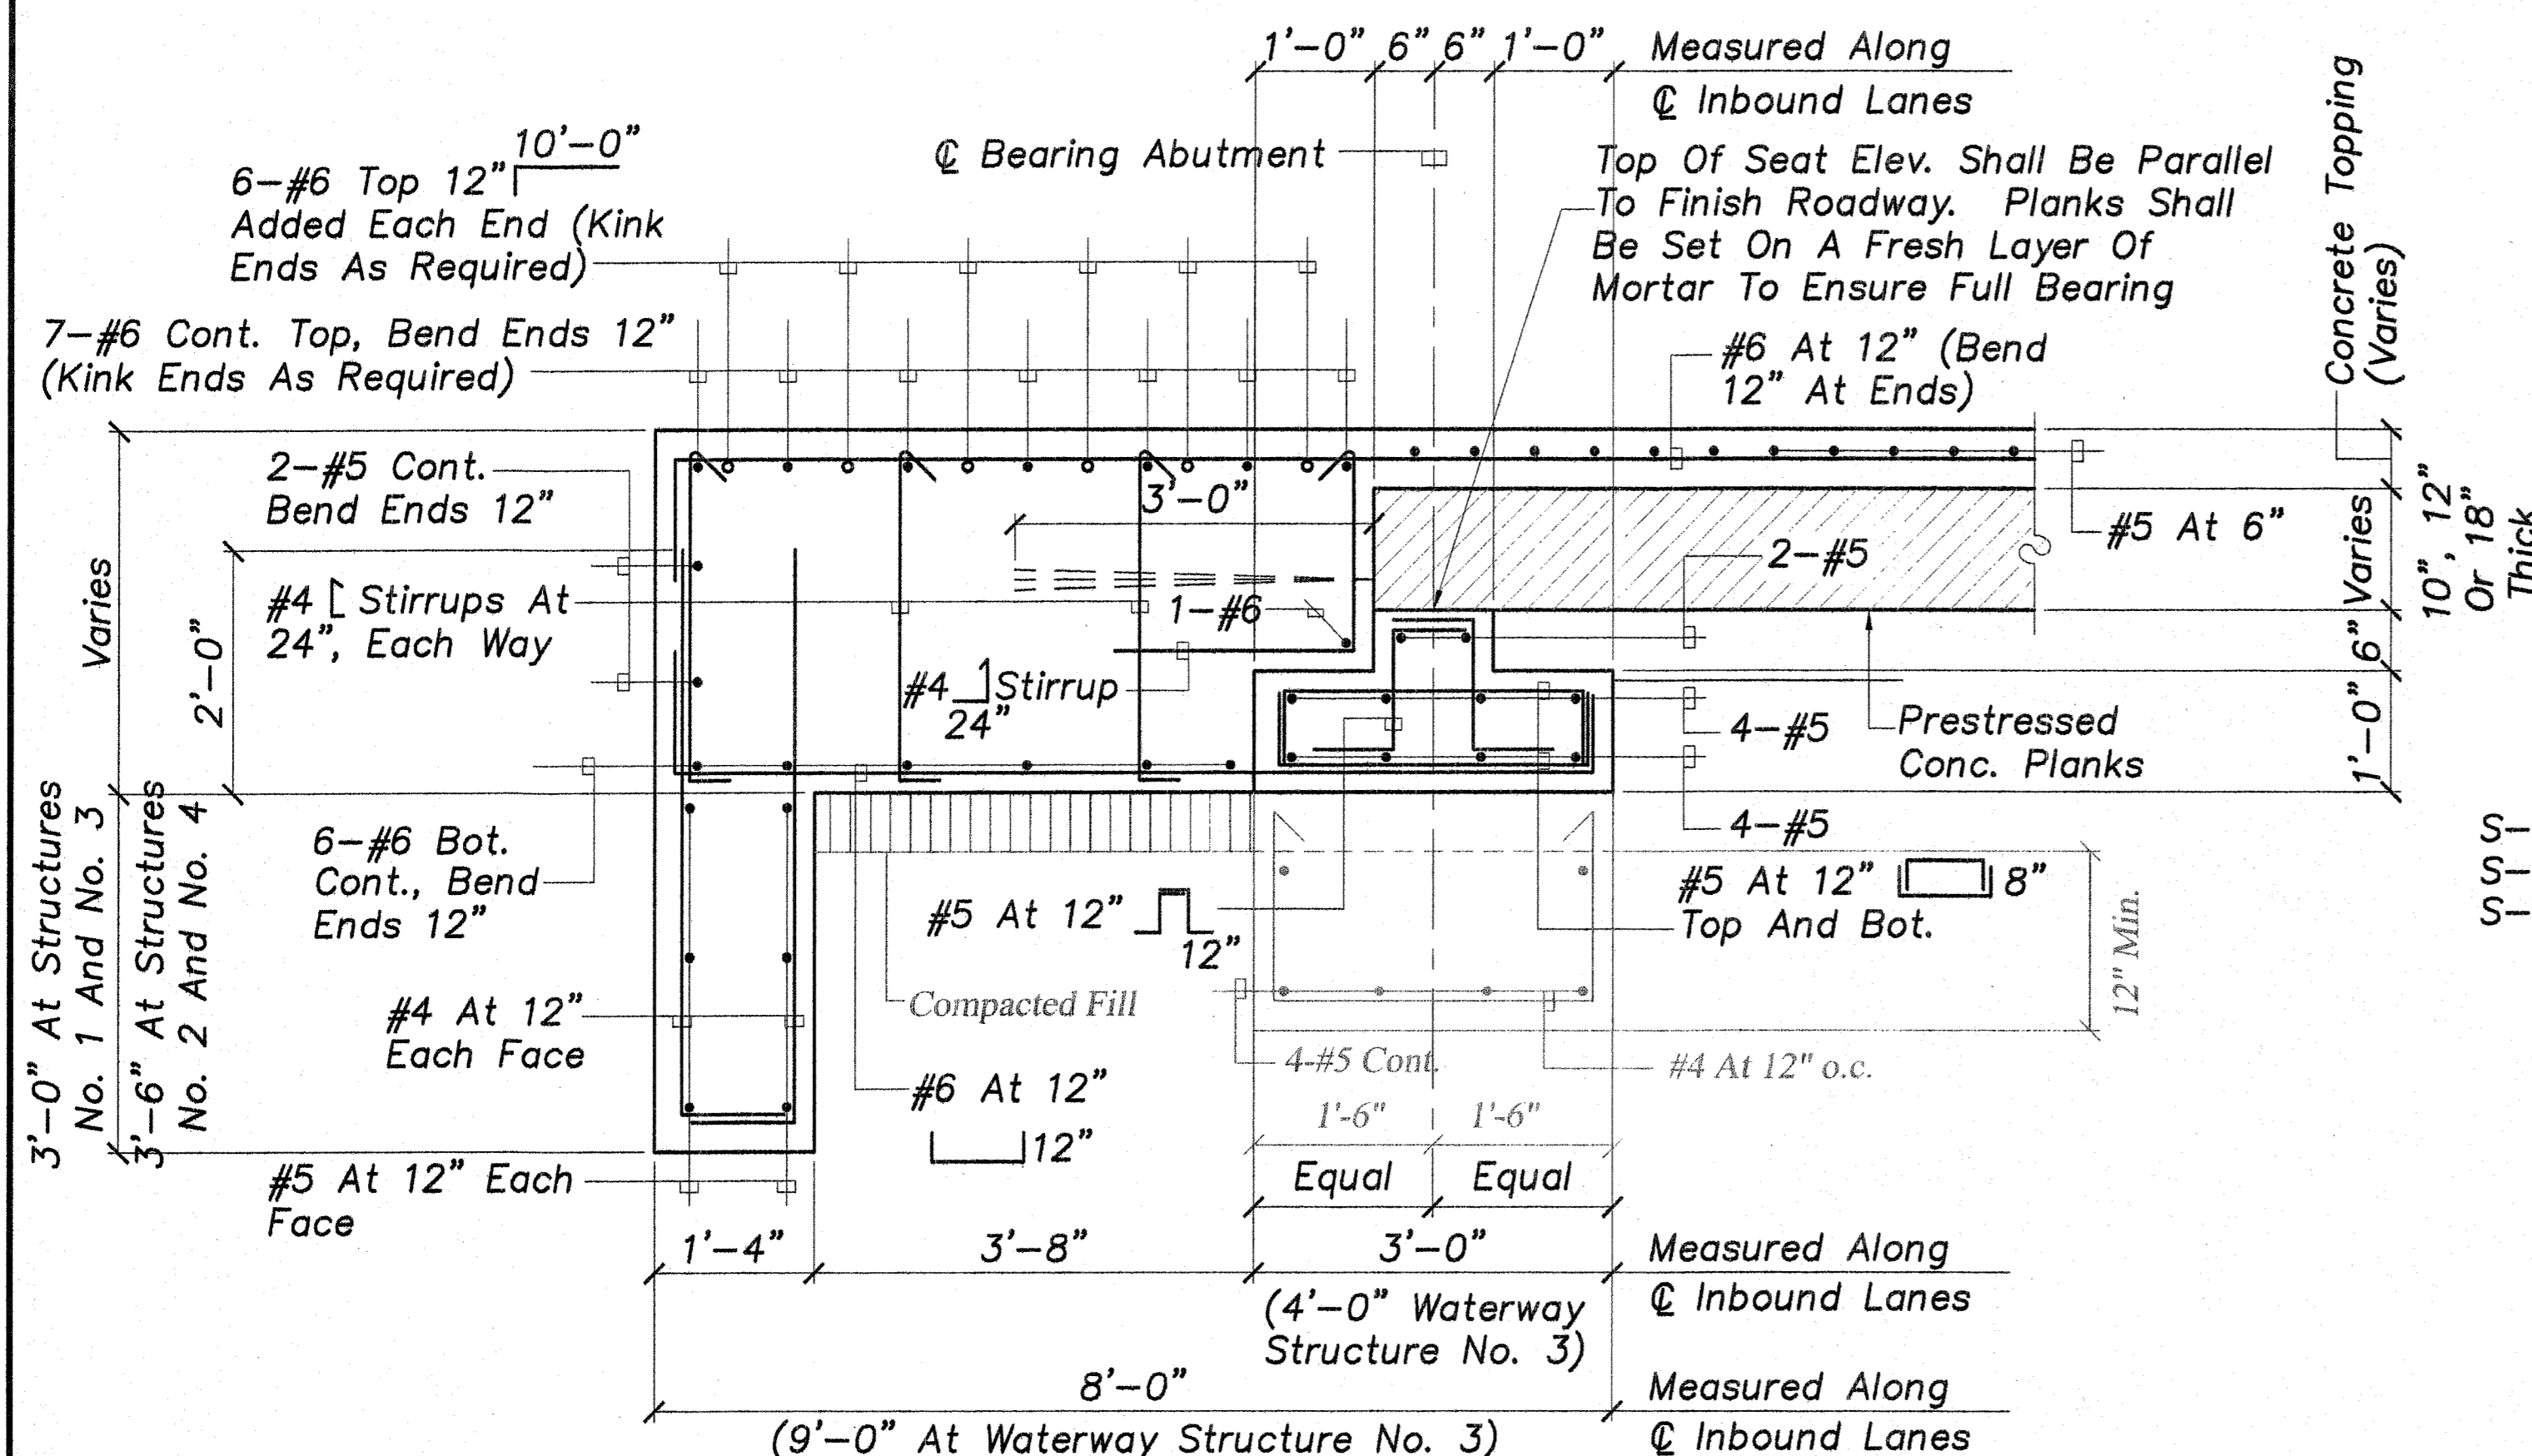

TYPICAL ABUTMENT SECTION
 S-4, S-6, S-8, S-12 Scale: 3/4"=1'-0"
 S-10, S-11

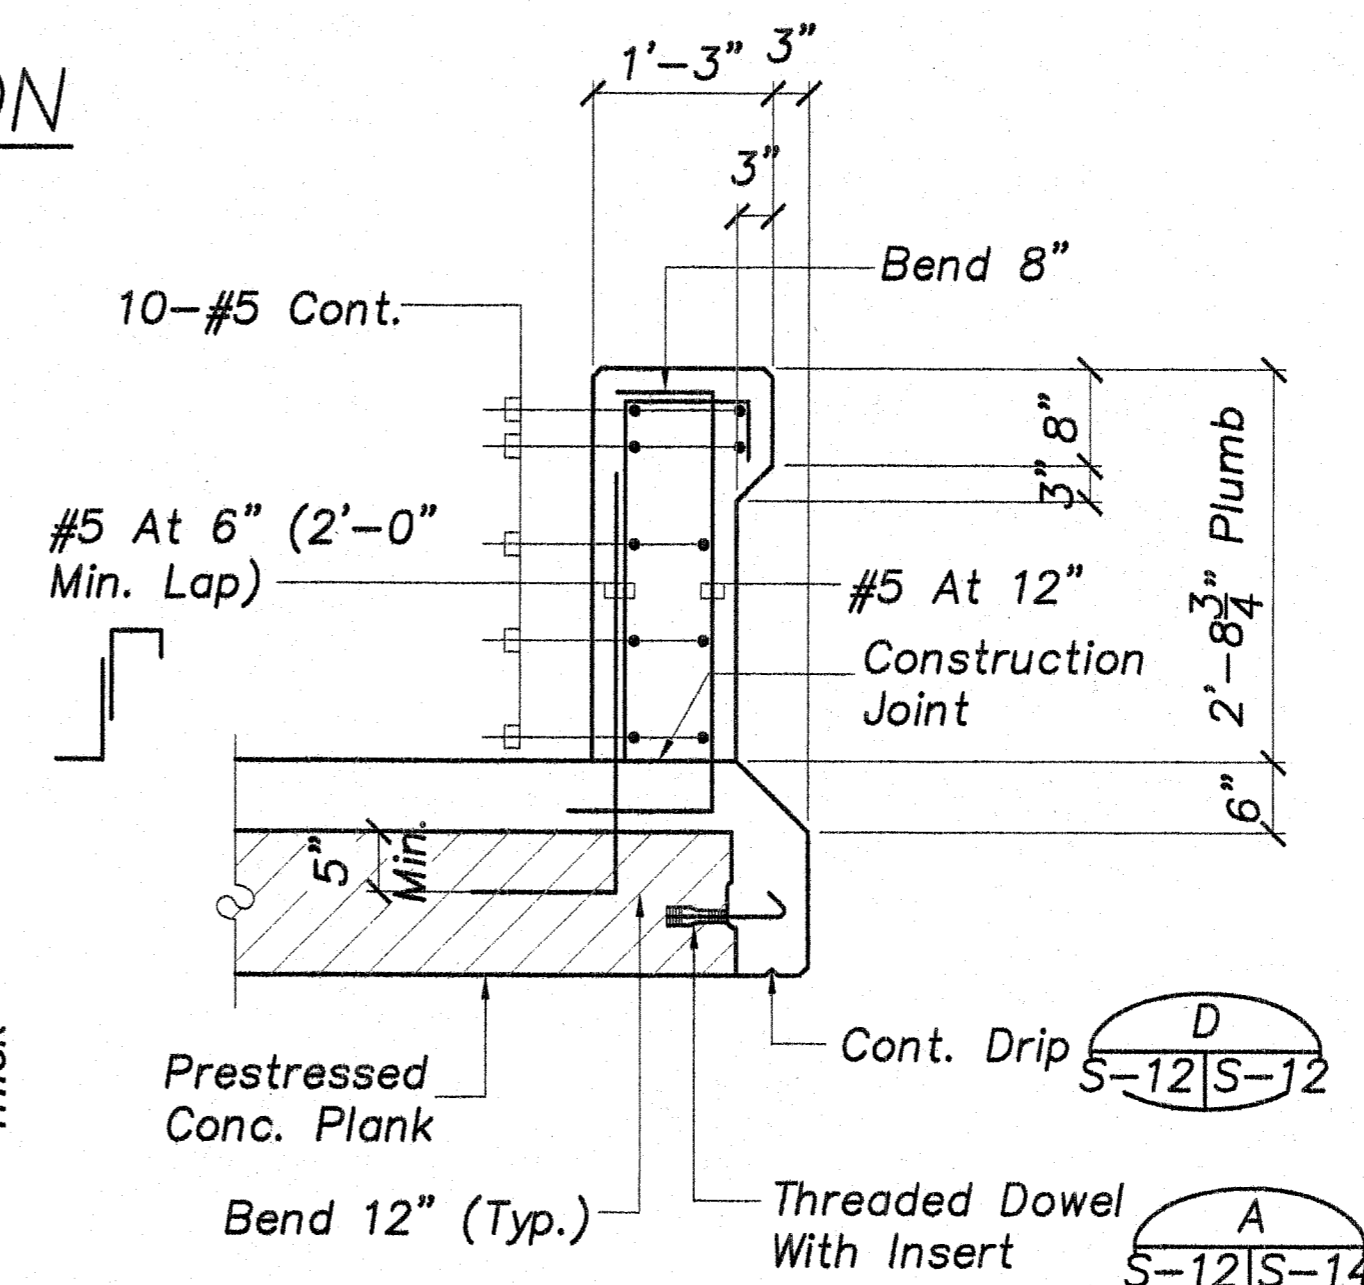

CONC. PARAPET DETAIL
 S-3, S-4, S-5, S-7, S-8, S-12 Scale: 3/4"=1'-0"
 S-9, S-12

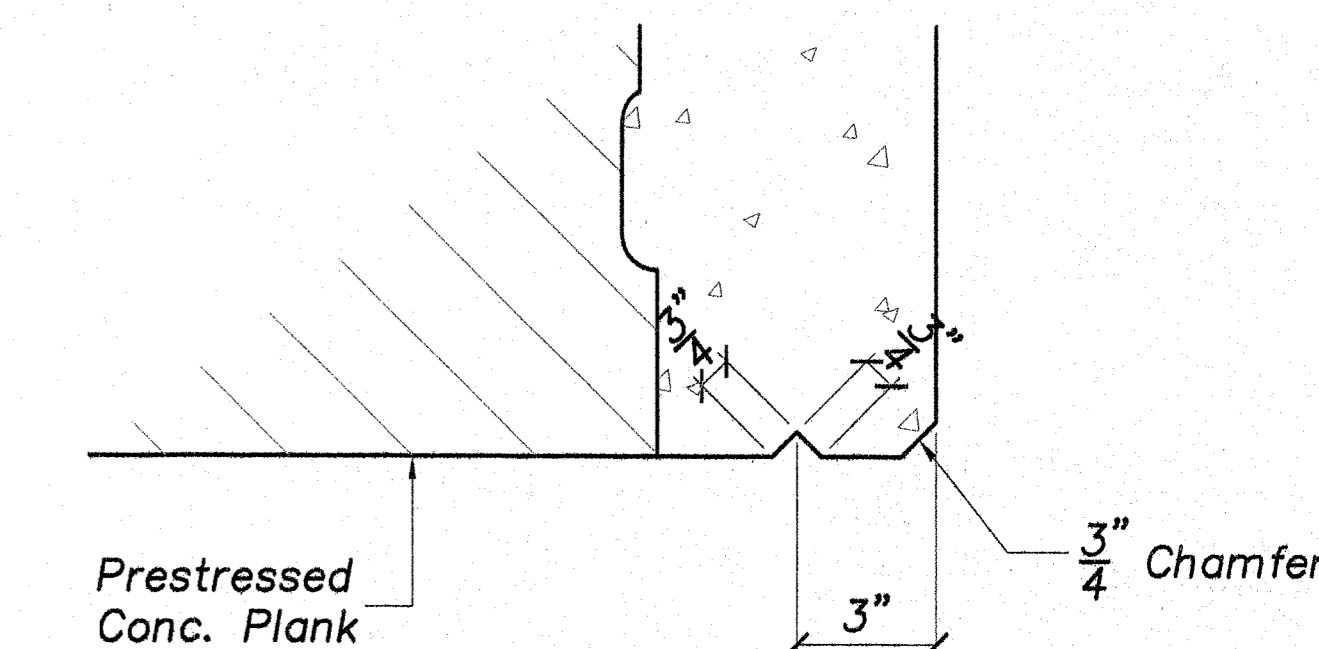


CONT. DRIP DETAIL
 S-12, S-12 Scale: 3"=1'-0"

SURVEY PLOTTED BY	DATE
DRAWN BY	
CHECKED BY	
QUANTITIES BY	
NOTE BOOK	
CHECKED BY	
No.	

LEGEND FOR AS-BUILT POSTINGS

	Squiggly line for as-built deletion
	Double line for as-built deletion
Roadway	Text for as-built posting

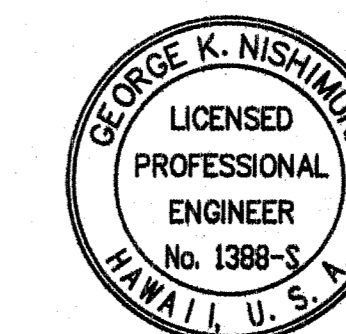



THIS WORK WAS PREPARED BY ME OR UNDER MY SUPERVISION.
 SIGNATURE
 04/30/10
 EXPIRATION DATE OF PROFESSIONAL LICENSE

STATE OF HAWAII
 DEPARTMENT OF TRANSPORTATION
 HIGHWAYS DIVISION
FOUNDATION AND FRAMING DETAILS

**HALEAKALA HIGHWAY WIDENING, PHASE 2
 HANA HIGHWAY TO PUKALANI BYPASS
 FED. AID PROJ. NO. NH-037-1(24)**

SCALE: AS NOTED DATE: MAY 2005
 SHEET No. S-12 OF 26 SHEETS

FED. ROAD DIST. NO.	STATE	FED. AID PROJ. NO.	FISCAL YEAR	SHEET NO.	TOTAL SHEETS
HAWAII	HAW.	NH-037-1(24)	2005	246	288

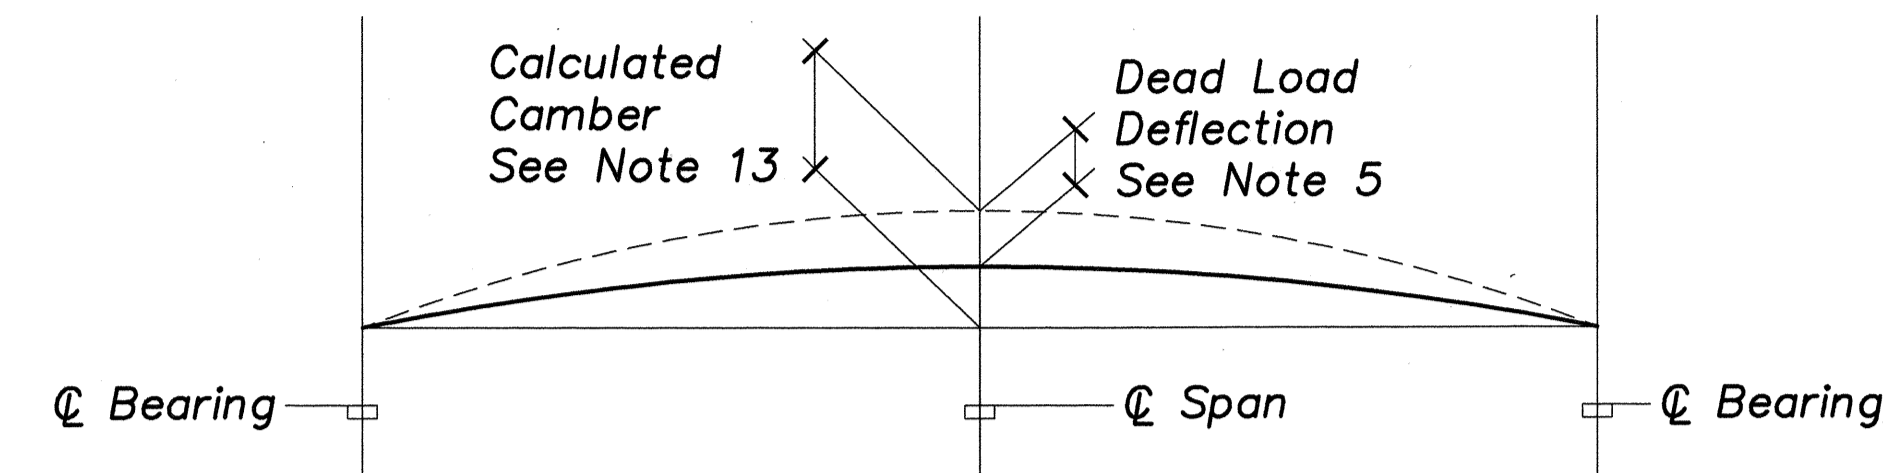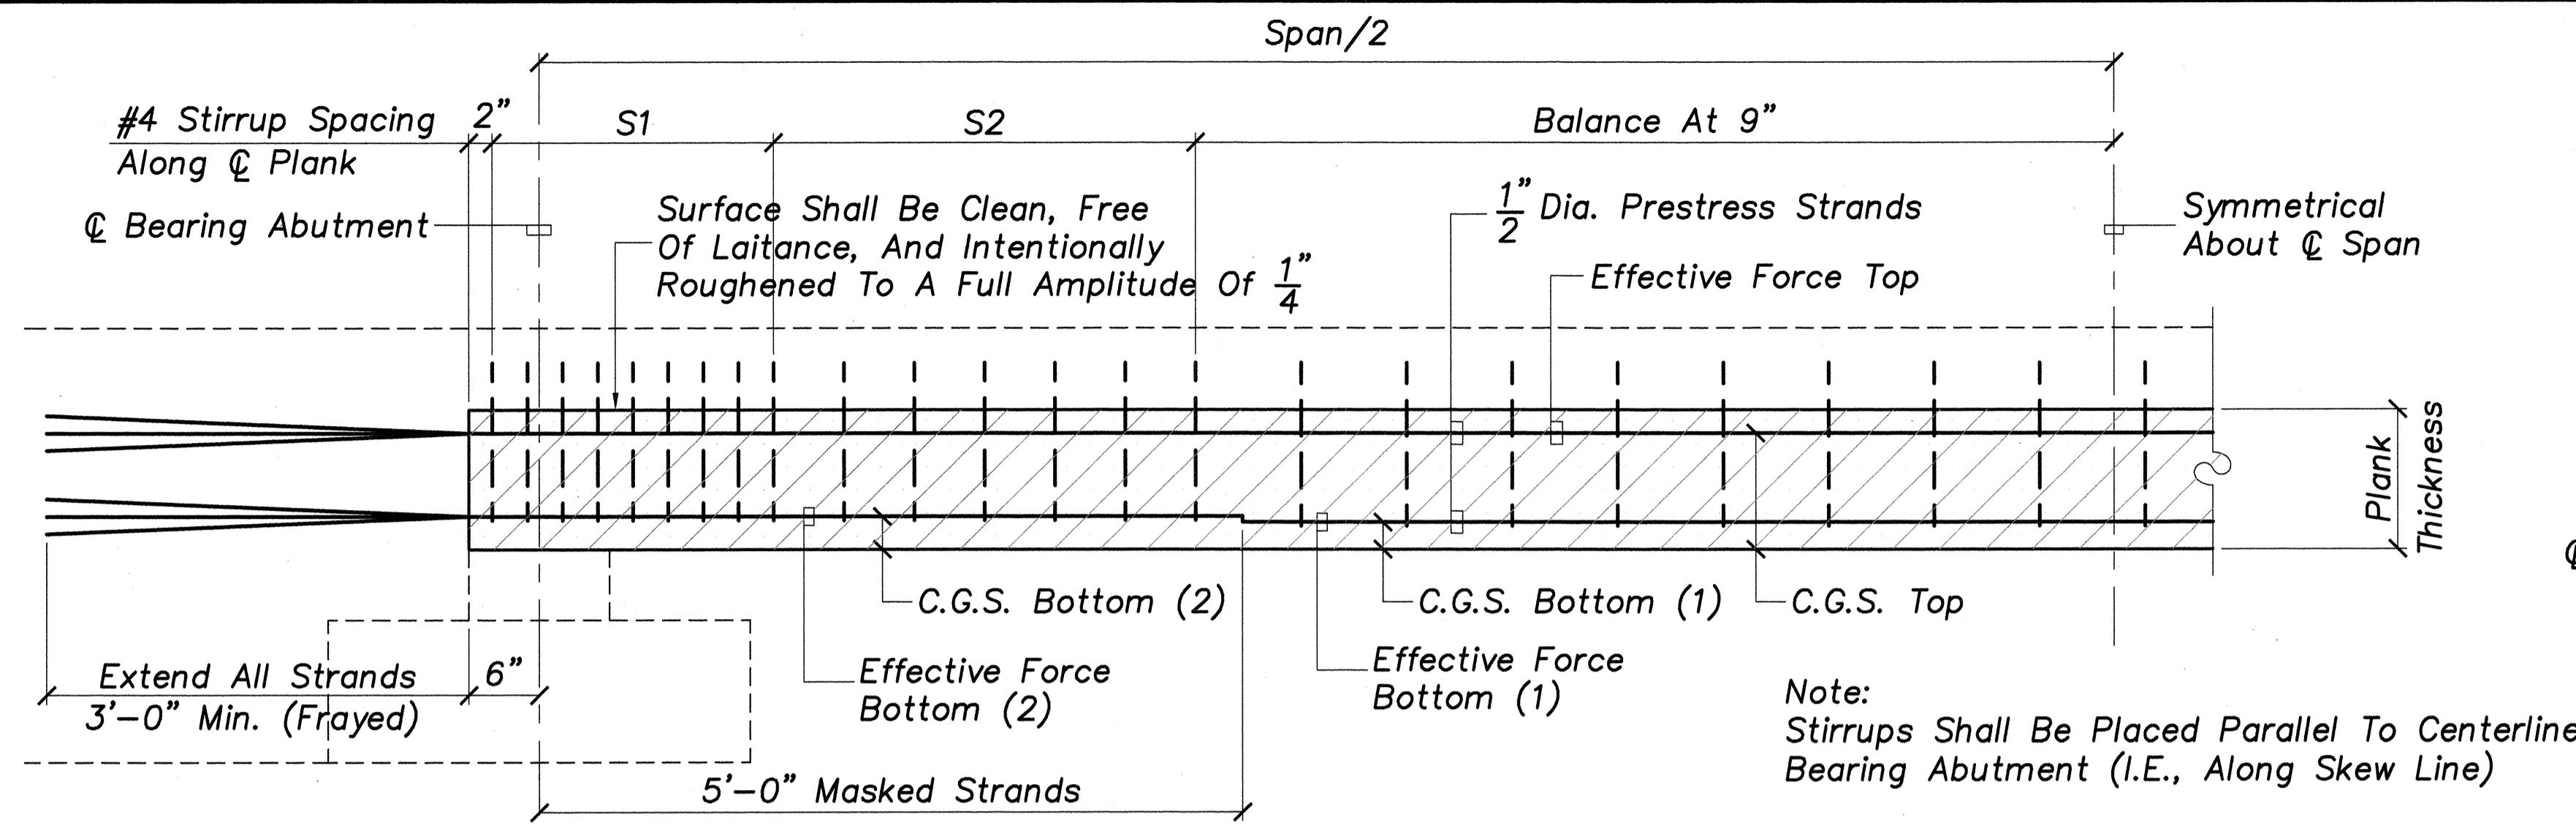

TYPICAL PRESTRESSED PLANK ELEVATION
Not To Scale

PLANK CAMBER DIAGRAM
Not To Scale


PRESTRESSED PLANK TABLE

Plank	Plank Thickness	C.G.S. Bottom (1)	C.G.S. Bottom (2)	C.G.S. Top	Effective Force Bottom (1)	Effective Force Bottom (2)	Effective Force Top	S1	S2	Calculated Camber	Dead Load Deflection	Remarks
P-1	10"	2.42"	—	8.00"	437.0 KIPS	—	92.0 KIPS	8 At 3"	8 At 6"	-0.65"	0.11"	No Masked Strands
P-2	1'-0"	2.80"	2.91"	10.00"	587.5 KIPS	517.0 KIPS	94.0 KIPS	8 At 3"	12 At 6"	-1.04"	0.17"	
P-3	1'-6"	3.50"	3.75"	16.00"	837.0 KIPS	558.0 KIPS	93.0 KIPS	12 At 3"	16 At 6"	-1.50"	0.21"	

PRESTRESSED PLANK NOTES

- MINIMUM CONCRETE COMPRESSIVE STRENGTH (AT 28 DAYS) OF PRESTRESSED PLANKS SHALL BE AS FOLLOWS:
A) FINAL CONCRETE STRENGTH = 6,000 PSI
B) CONCRETE STRENGTH AT TRANSFER = 4,500 PSI
- PRESTRESSING STRANDS SHALL BE SEVEN WIRE 1/2" DIAMETER LOW RELAXATION STEEL STRANDS (AREA = 0.153 SQ. IN.), WITH AN ULTIMATE STRENGTH OF 270 KSI. FOR PROPERTIES, SEE STANDARD SPECIFICATIONS.
- NON-PRESTRESSED REINFORCING STEEL SHALL BE GRADE 60, UNLESS OTHERWISE NOTED ON PLANS. FOR PROPERTIES, SEE STANDARD SPECIFICATIONS.
- EFFECTIVE PRESTRESSING FORCE IS AFTER ALL LOSSES. LOSSES SHALL TAKE INTO CONSIDERATION CREEP, SHRINKAGE, ELASTIC SHORTENING AND RELAXATION OF PRESTRESSING STEEL.
- DEAD LOAD DEFLECTION IS DUE TO WEIGHT OF THE CONCRETE TOPPING.
- STRAND PATTERN SHALL BE SYMMETRICAL ABOUT THE CENTERLINE OF THE PRESTRESSED PLANK.
- STRAND RELEASE SEQUENCE SHALL NOT INDUCE ANY LATERAL DEFLECTION OF THE PRESTRESSED PLANK.
- THE CONTRACTOR SHALL SUBMIT HIS PROPOSED STRAND PATTERN AND RELEASING SEQUENCE TO THE ENGINEER FOR REVIEW.
- DURING CURING, CARE SHALL BE TAKEN TO AVOID ANY LATERAL DEFLECTION OF THE PRESTRESSED PLANK DUE TO IMPROPER ORIENTATION.
- LIFTING DEVICES SHALL BE PLACED AS CLOSE AS POSSIBLE TO THE CENTERLINE BEARING OF THE PRESTRESSED PLANK. DETAILS AND LOCATIONS OF LIFTING DEVICES SHALL BE SUBMITTED TO THE ENGINEER FOR REVIEW. SUCH REVIEW DOES NOT RELIEVE THE CONTRACTOR OF HIS RESPONSIBILITIES IF THE PRESTRESSED PLANK IS DAMAGED DUE TO FAILURE OF THE LIFTING DEVICES.
- ELASTIC SHORTENING SHALL BE INCLUDED IN DETERMINING THE LENGTH OF THE PRESTRESSED PLANKS.
- THE CONTRACTOR SHALL INCORPORATE ALL INSERTS, DOWELS AND OTHER EMBEDDED ITEMS REQUIRED IN THE PRESTRESSED PLANKS DURING FABRICATION.
- THE CALCULATED CAMBER INCLUDES THE EFFECTS OF THE INITIAL PRESTRESS FORCE AND THE WEIGHT OF THE PRESTRESSED PLANK AT THE TIME OF PLACEMENT. NEGATIVE VALUES INDICATE A NET UPWARD DEFLECTION. THE ACTUAL CAMBER SHALL NOT EXCEED THE CALCULATED CAMBER BY MORE THAN 1-INCH. PRESTRESSED PLANKS EXCEEDING THE CALCULATED CAMBER BY MORE THAN 1-INCH WILL BE REJECTED.
- A CORROSION INHIBITING ADMIXTURE SHALL BE INCLUDED IN THE CONCRETE MIX FOR THE PRESTRESSED PLANKS. THE CORROSION INHIBITING ADMIXTURE SHALL CONTAIN A MINIMUM OF 30% CALCIUM NITRITE BY MASS AND SHALL BE ADDED AT A DOSAGE RATE OF 4.0 GALLONS PER CUBIC YARD OF CONCRETE. THE ADMIXTURE SHALL BE RHEOCRETE CNI CALCIUM NITRITE-BASED CORROSION INHIBITOR, DCI S CORROSION INHIBITOR, OR AN APPROVED EQUAL. ADDITION OF CORROSION INHIBITING ADMIXTURE SHALL BE AS RECOMMENDED BY THE MANUFACTURER.

DATE
DESIGNED BY
CHECKED BY
NO.

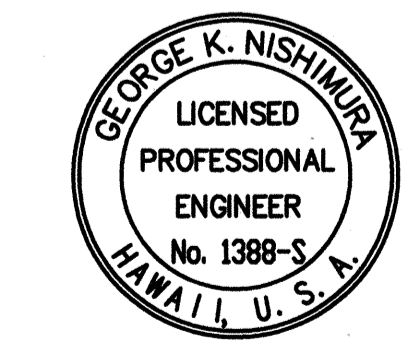


THIS WORK WAS PREPARED BY ME OR UNDER MY SUPERVISION.
SIGNATURE
04/30/06
EXPIRATION DATE OF PROFESSIONAL LICENSE

STATE OF HAWAII
DEPARTMENT OF TRANSPORTATION
HIGHWAYS DIVISION
PRESTRESSED PLANK DETAILS


HALEAKALA HIGHWAY WIDENING, PHASE 2
HANA HIGHWAY TO PUKALANI BYPASS
FED. AID PROJ. NO. NH-037-1(24)

SCALE: AS NOTED DATE: MAY 2005
SHEET No.S-13 OF 26 SHEETS


FED. ROAD DIST. NO.	STATE	FED. AID PROJ. NO.	FISCAL YEAR	SHEET NO.	TOTAL SHEETS
HAWAII	HAW.	NH-037-1(24)	2005	247	288

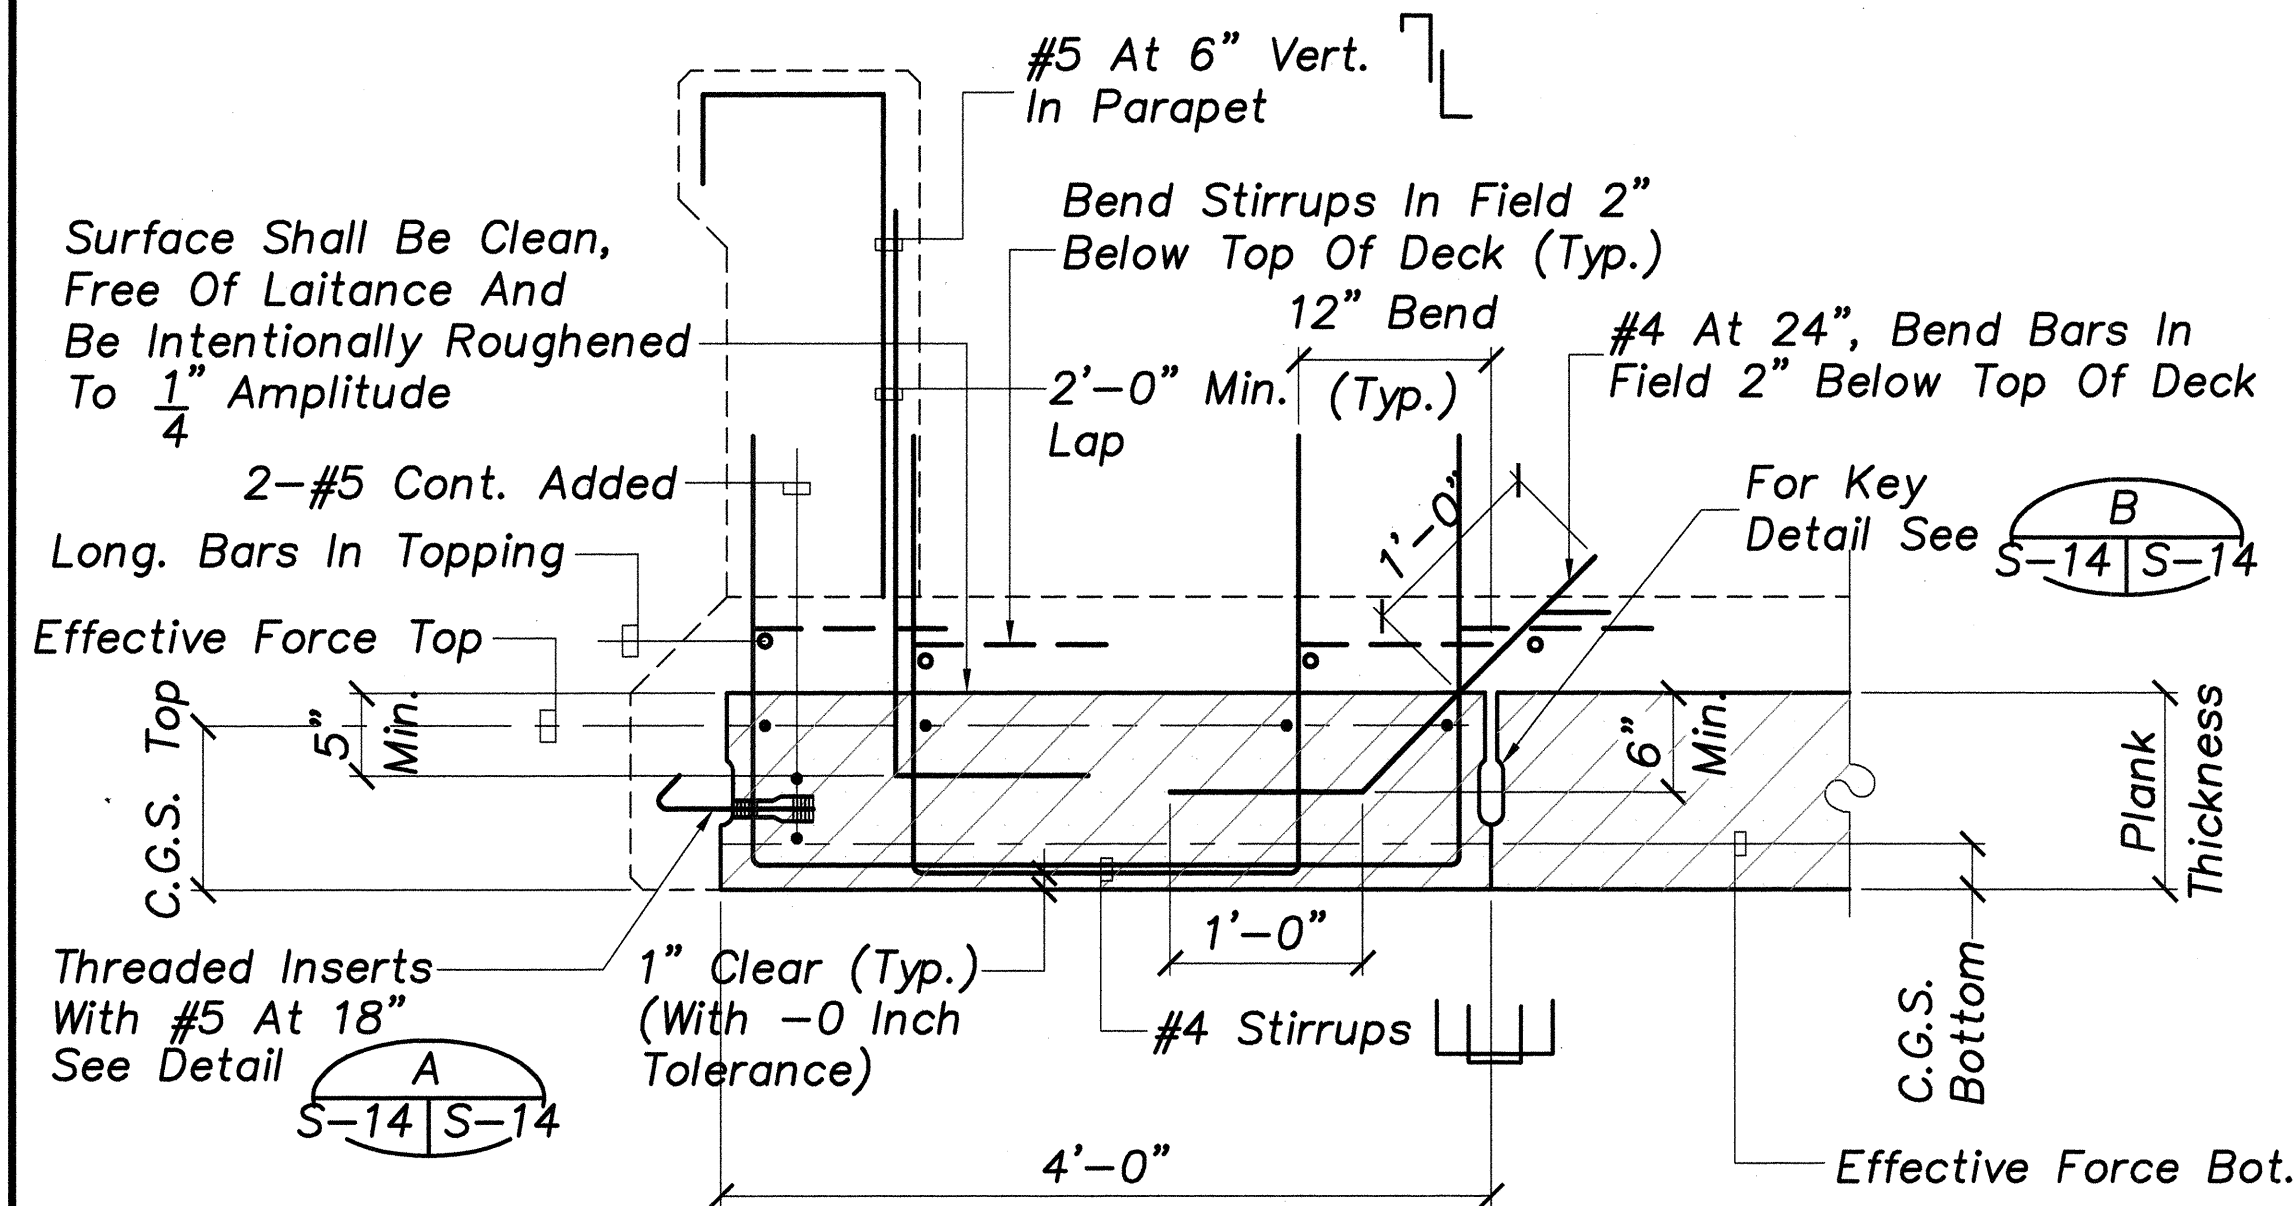


Note:
Stirrups Shall Be Placed Parallel To Centerline Bearing Abutment (I.E., Along Skew Line)
(At Concrete Parapet)
EXTERIOR PLANK SECTION
Scale: 1"=1'-0"

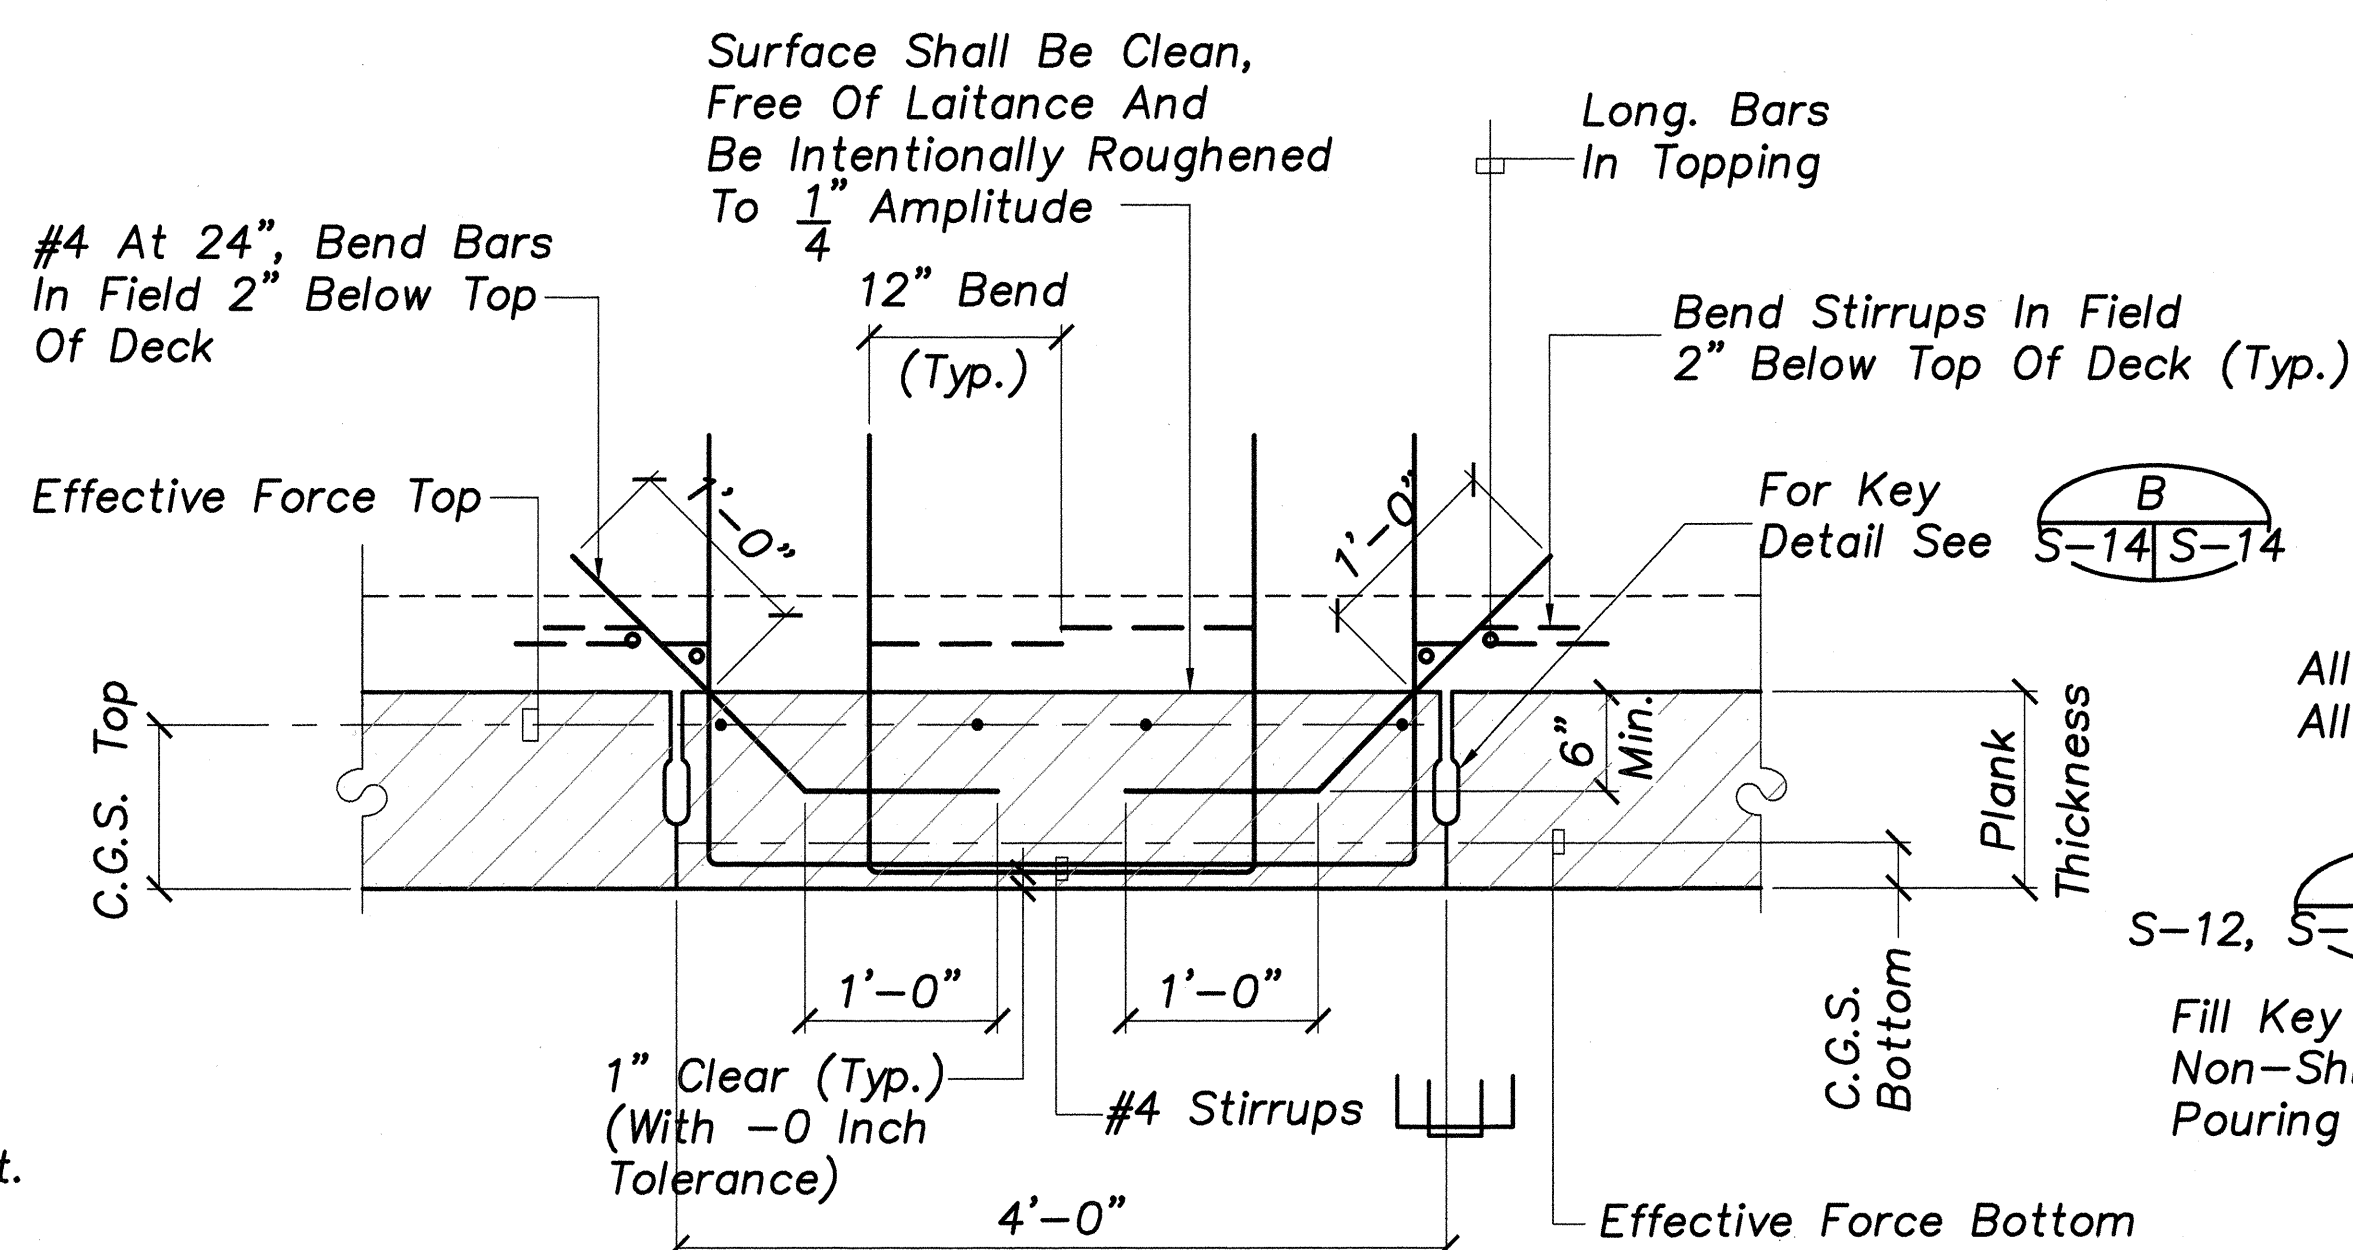


Note:
Stirrups Shall Be Placed Parallel To Centerline Bearing Abutment (I.E., Along Skew Line)
INTERIOR PLANK SECTION
Scale: 1"=1'-0"

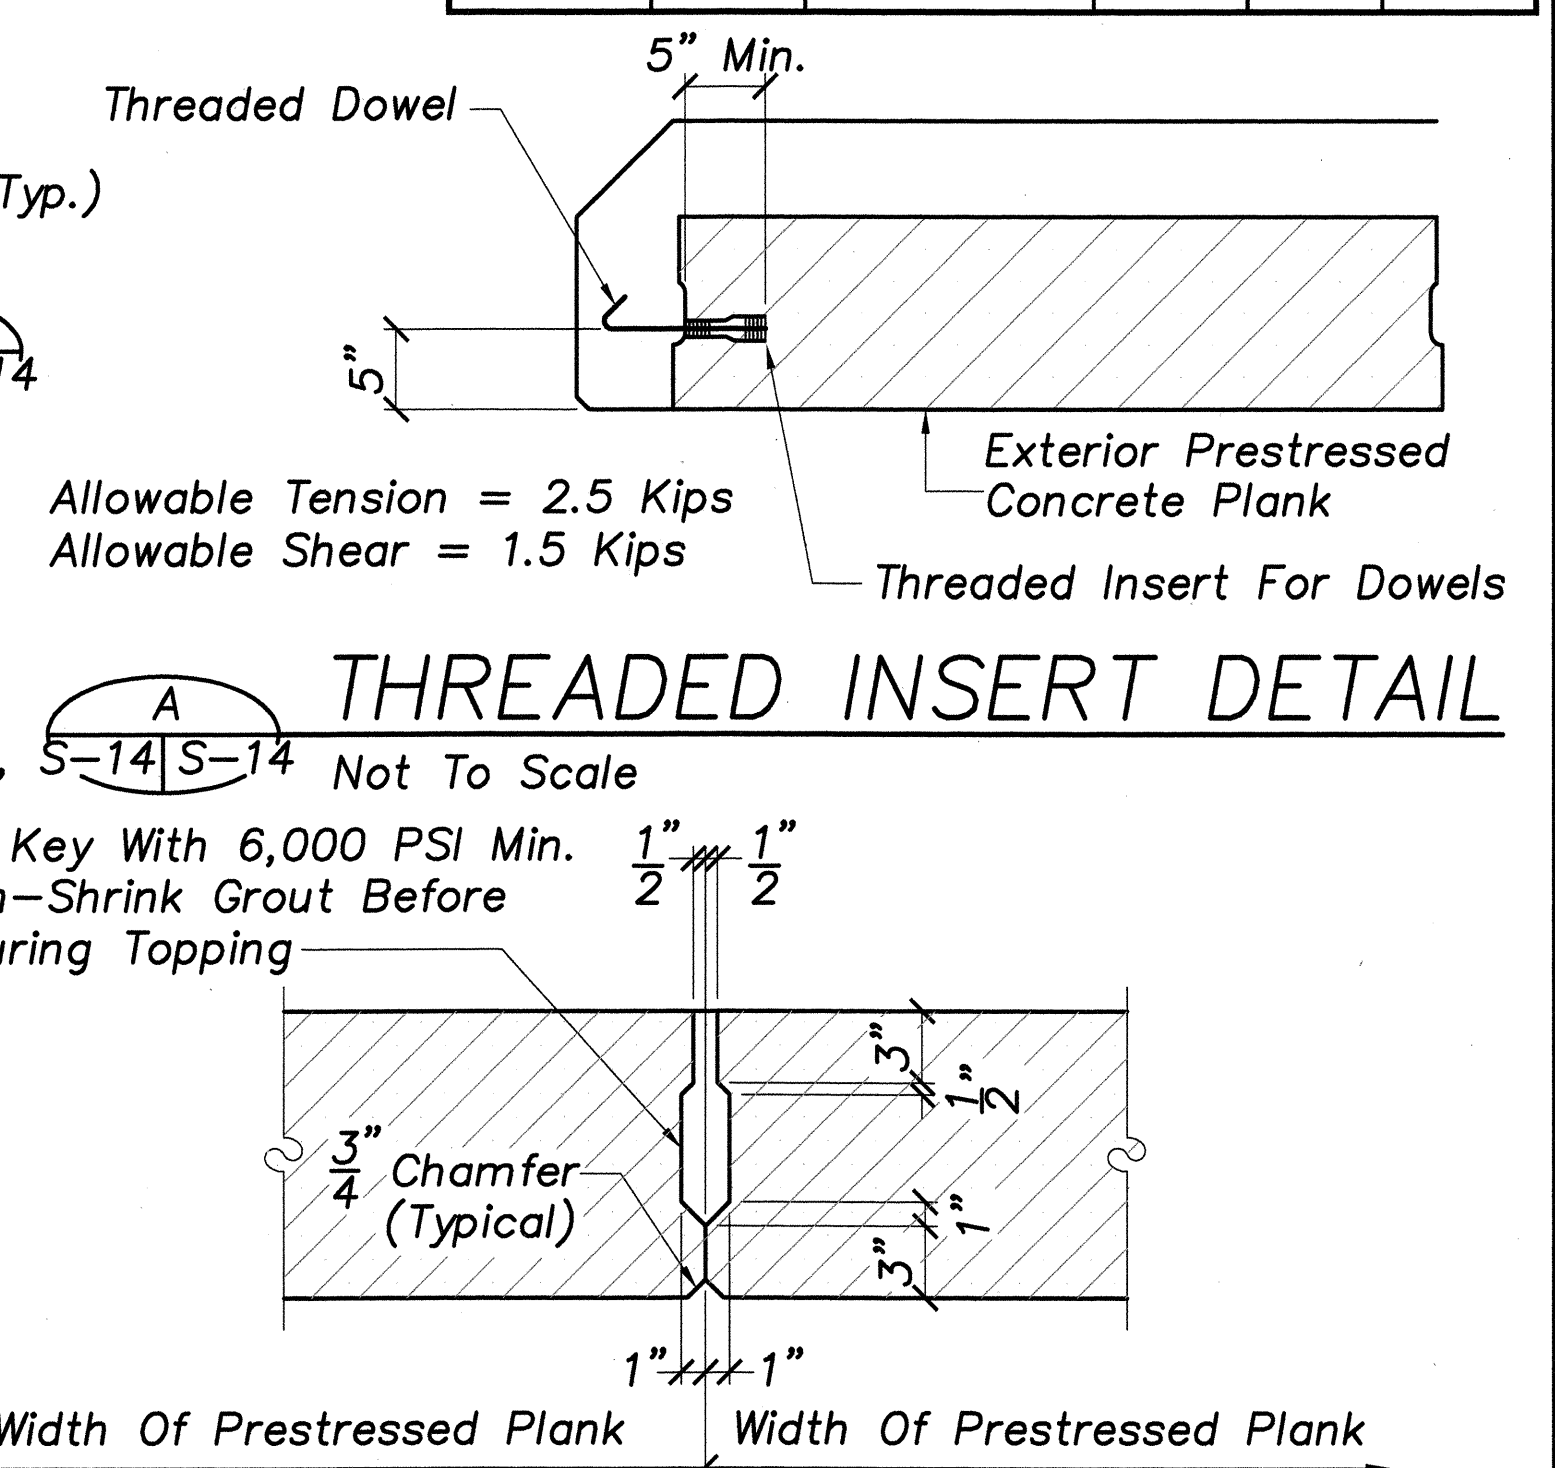

Allowable Tension = 2.5 Kips
Allowable Shear = 1.5 Kips
THREADED INSERT DETAIL
S-12, S-14 Not To Scale
Fill Key With 6,000 PSI Min. Non-Shrink Grout Before Pouring Topping
Note:
Non-Shrink Grout Shall Be Incidental To Concrete.
KEY DETAIL
Scale: 1 1/2"=1'-0"

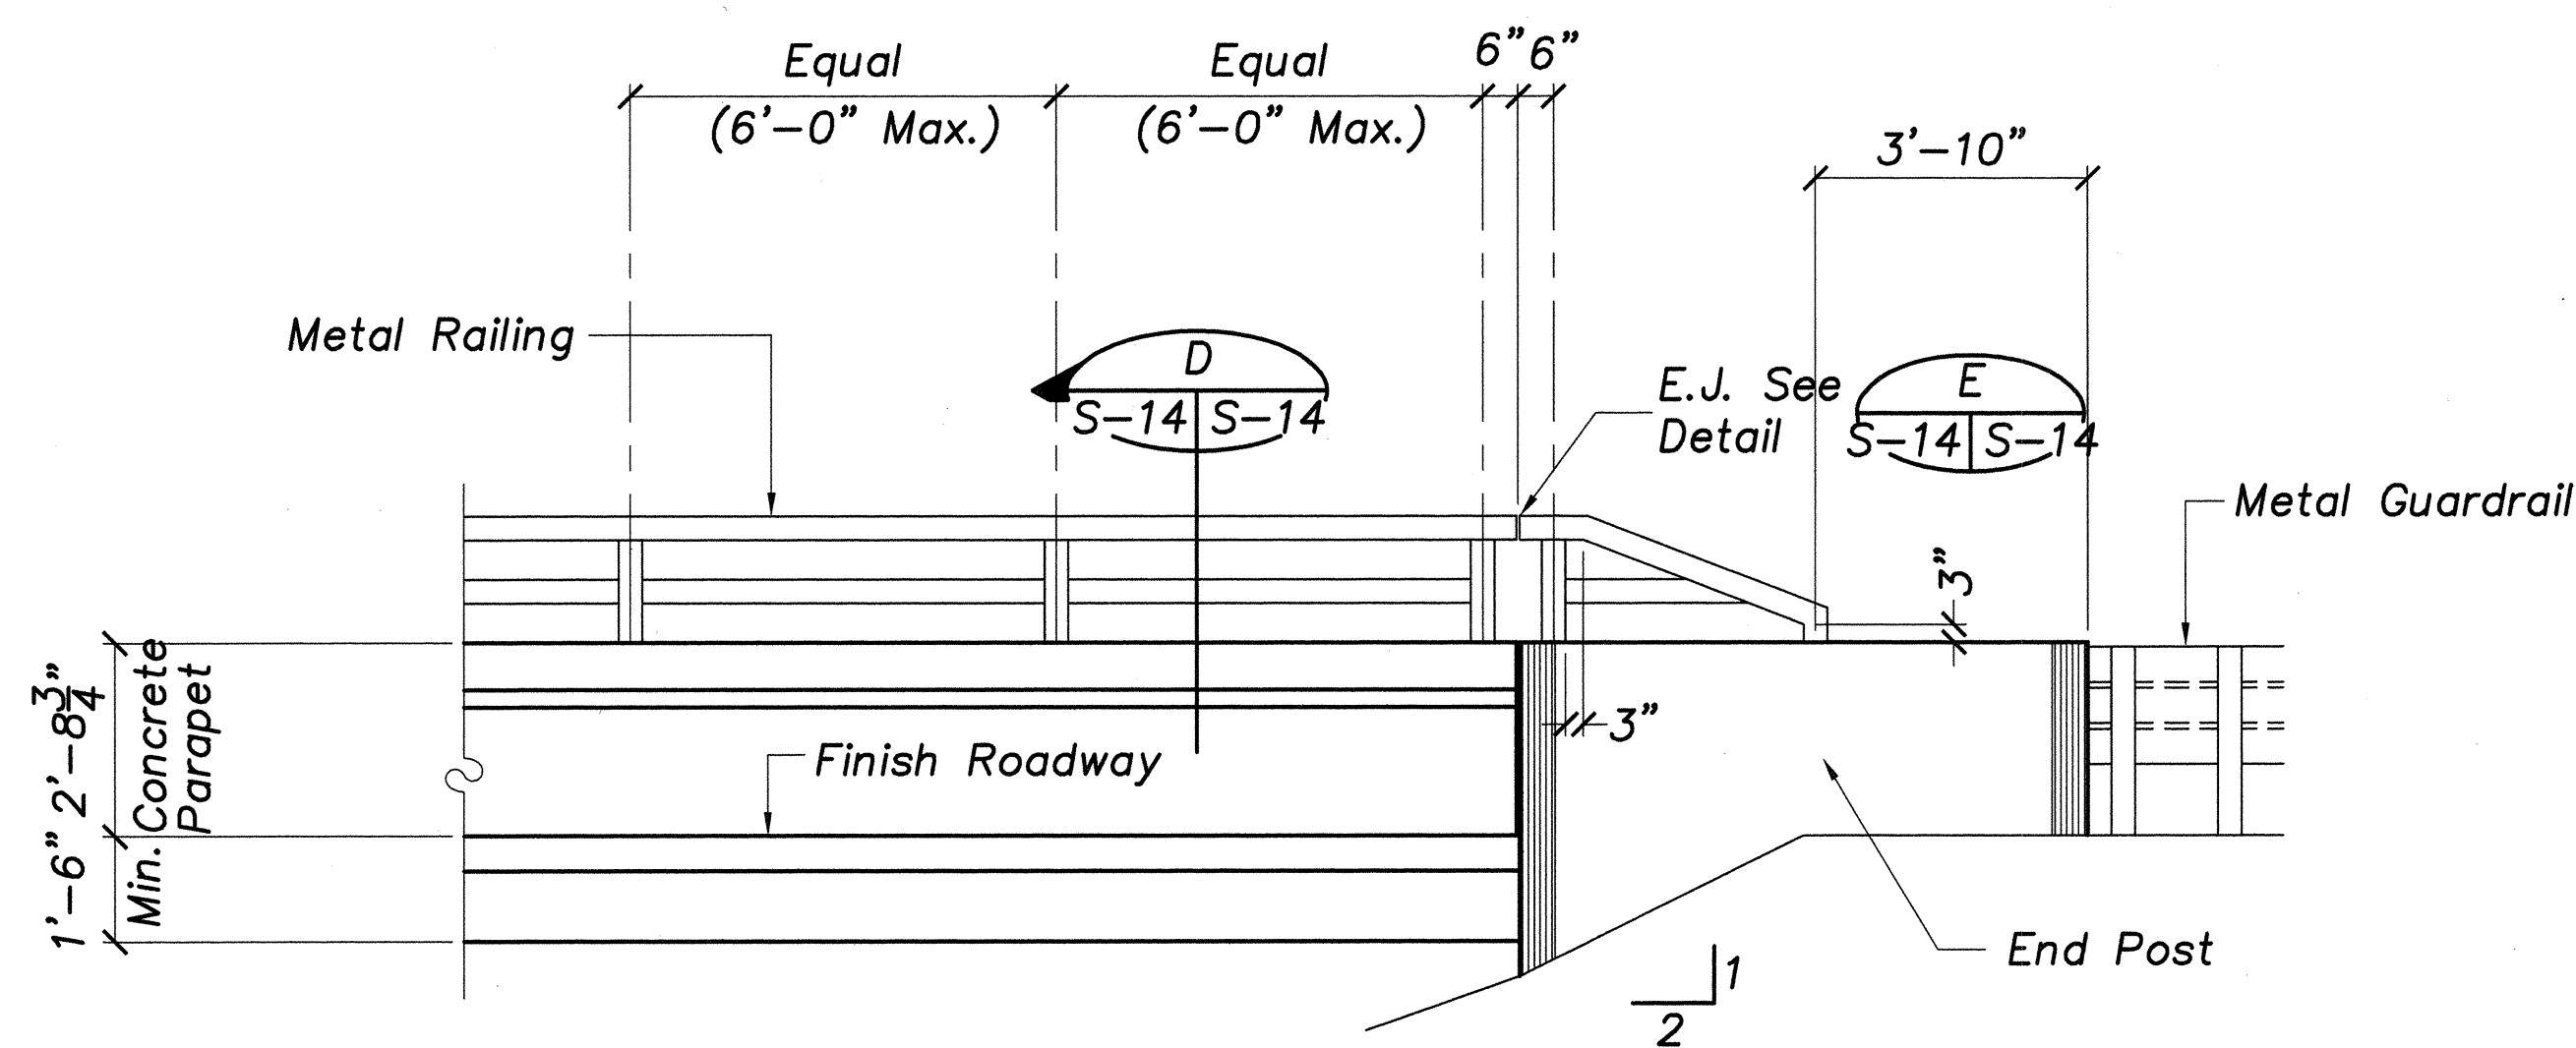


TYPICAL PARAPET AND METAL RAILING ELEVATION
Scale: 3/8"=1'-0"

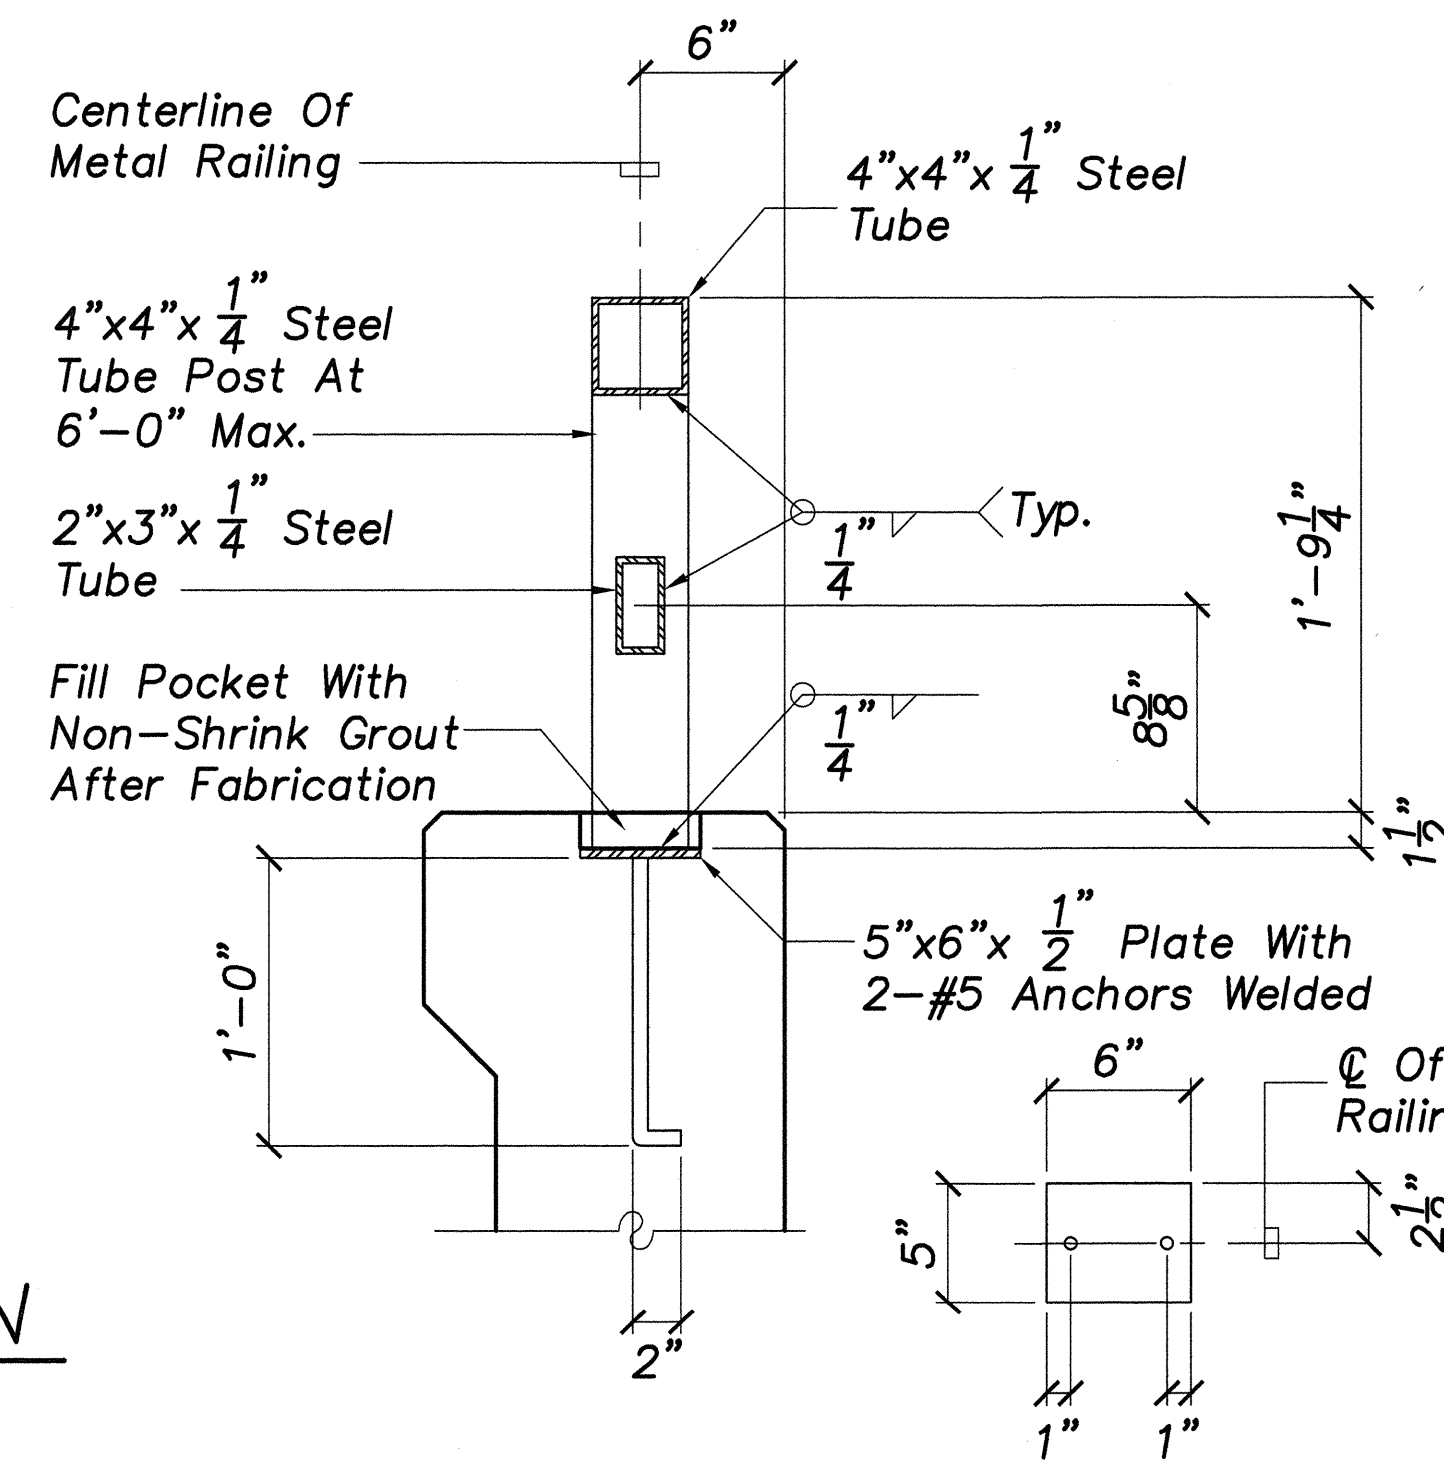

- Note:
1. Grind All Exposed Welded Joints On Metal Railing Smooth.
 2. Metal Railing Assembly Shall Be Hot Dipped Galvanized After Fabrication.
 3. Reinforcing Bars To Be Welded Shall Conform To ASTM A706, Grade 60.

METAL RAILING DETAIL
Scale: 1 1/2"=1'-0"

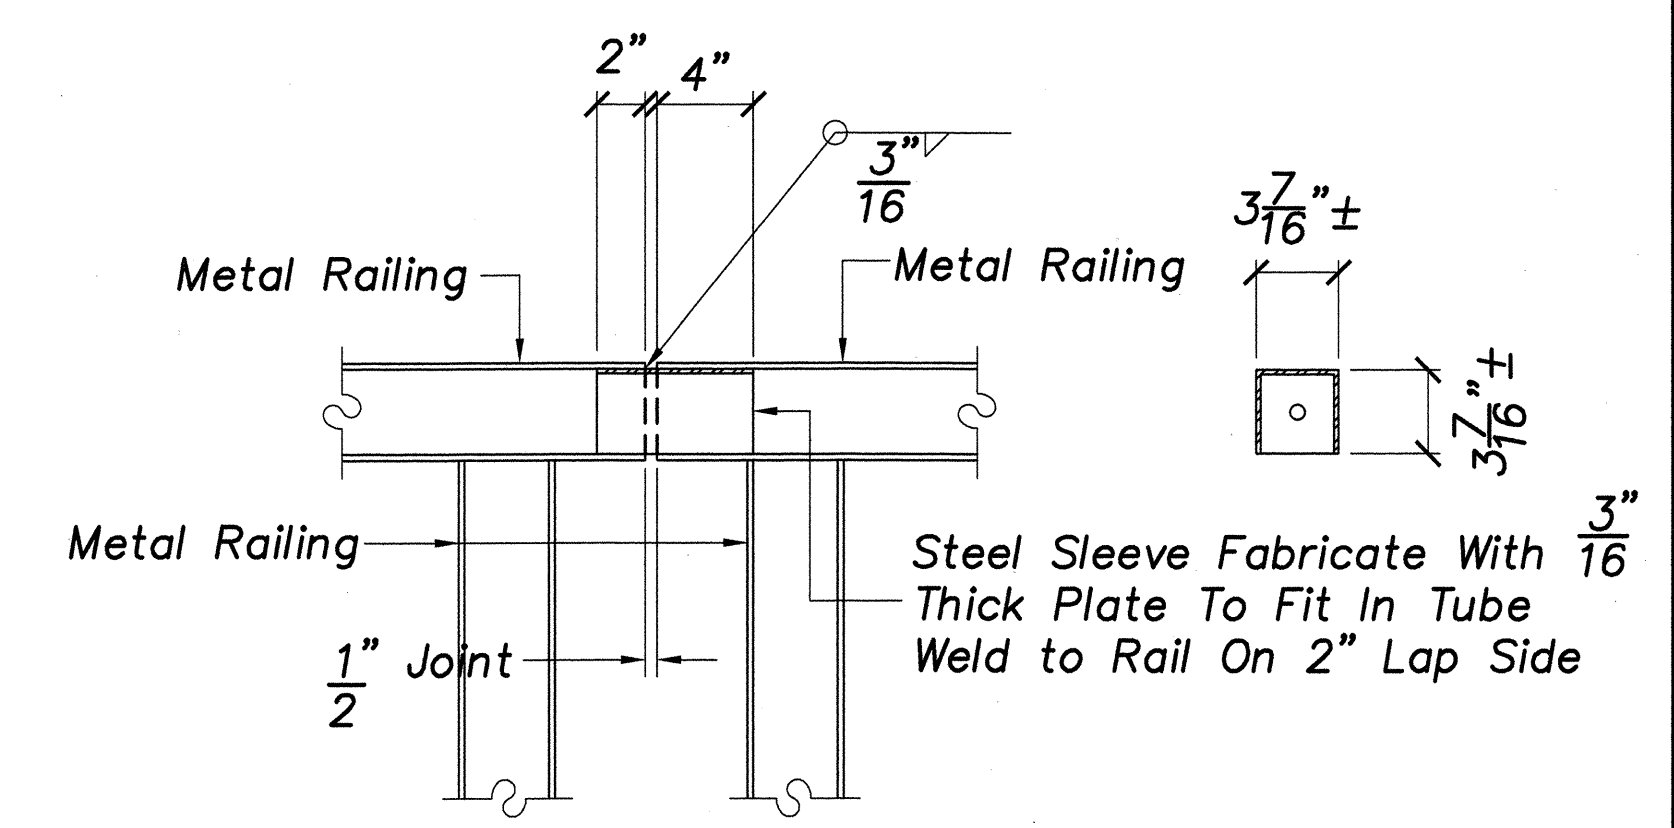


METAL RAILING EXPANSION JOINT DETAIL
Scale: 1 1/2"=1'-0"

SURVEY PLOTTED BY: _____
 DRAWN BY: _____
 DESIGNED BY: _____
 CHECKED BY: _____
 ORIGINAL PLAN NO. _____

GEORGE K. NISHIMURA
 LICENSED PROFESSIONAL ENGINEER
 No. 1388-S
 HAWAII, U.S.A.
 THIS WORK WAS PREPARED BY ME OR UNDER MY SUPERVISION.
 SIGNATURE
 04/30/06
 EXPIRATION DATE OF PROFESSIONAL LICENSE


STATE OF HAWAII
 DEPARTMENT OF TRANSPORTATION
 HIGHWAYS DIVISION
PRESTRESSED PLANK DETAILS
METAL RAILING DETAILS
 HALEAKALA HIGHWAY WIDENING, PHASE 2
 HANA HIGHWAY TO PUKALANI BYPASS
 FED. AID PROJ. NO. NH-037-1(24)
 SCALE: AS NOTED DATE: MAY 2005
SHEET No. S-14 OF 26 SHEETS

FED. ROAD DIST. NO.	STATE	FED. AID PROJ. NO.	FISCAL YEAR	SHEET NO.	TOTAL SHEETS
HAWAII	HAW.	NH-037-1(24)	2005	248	288

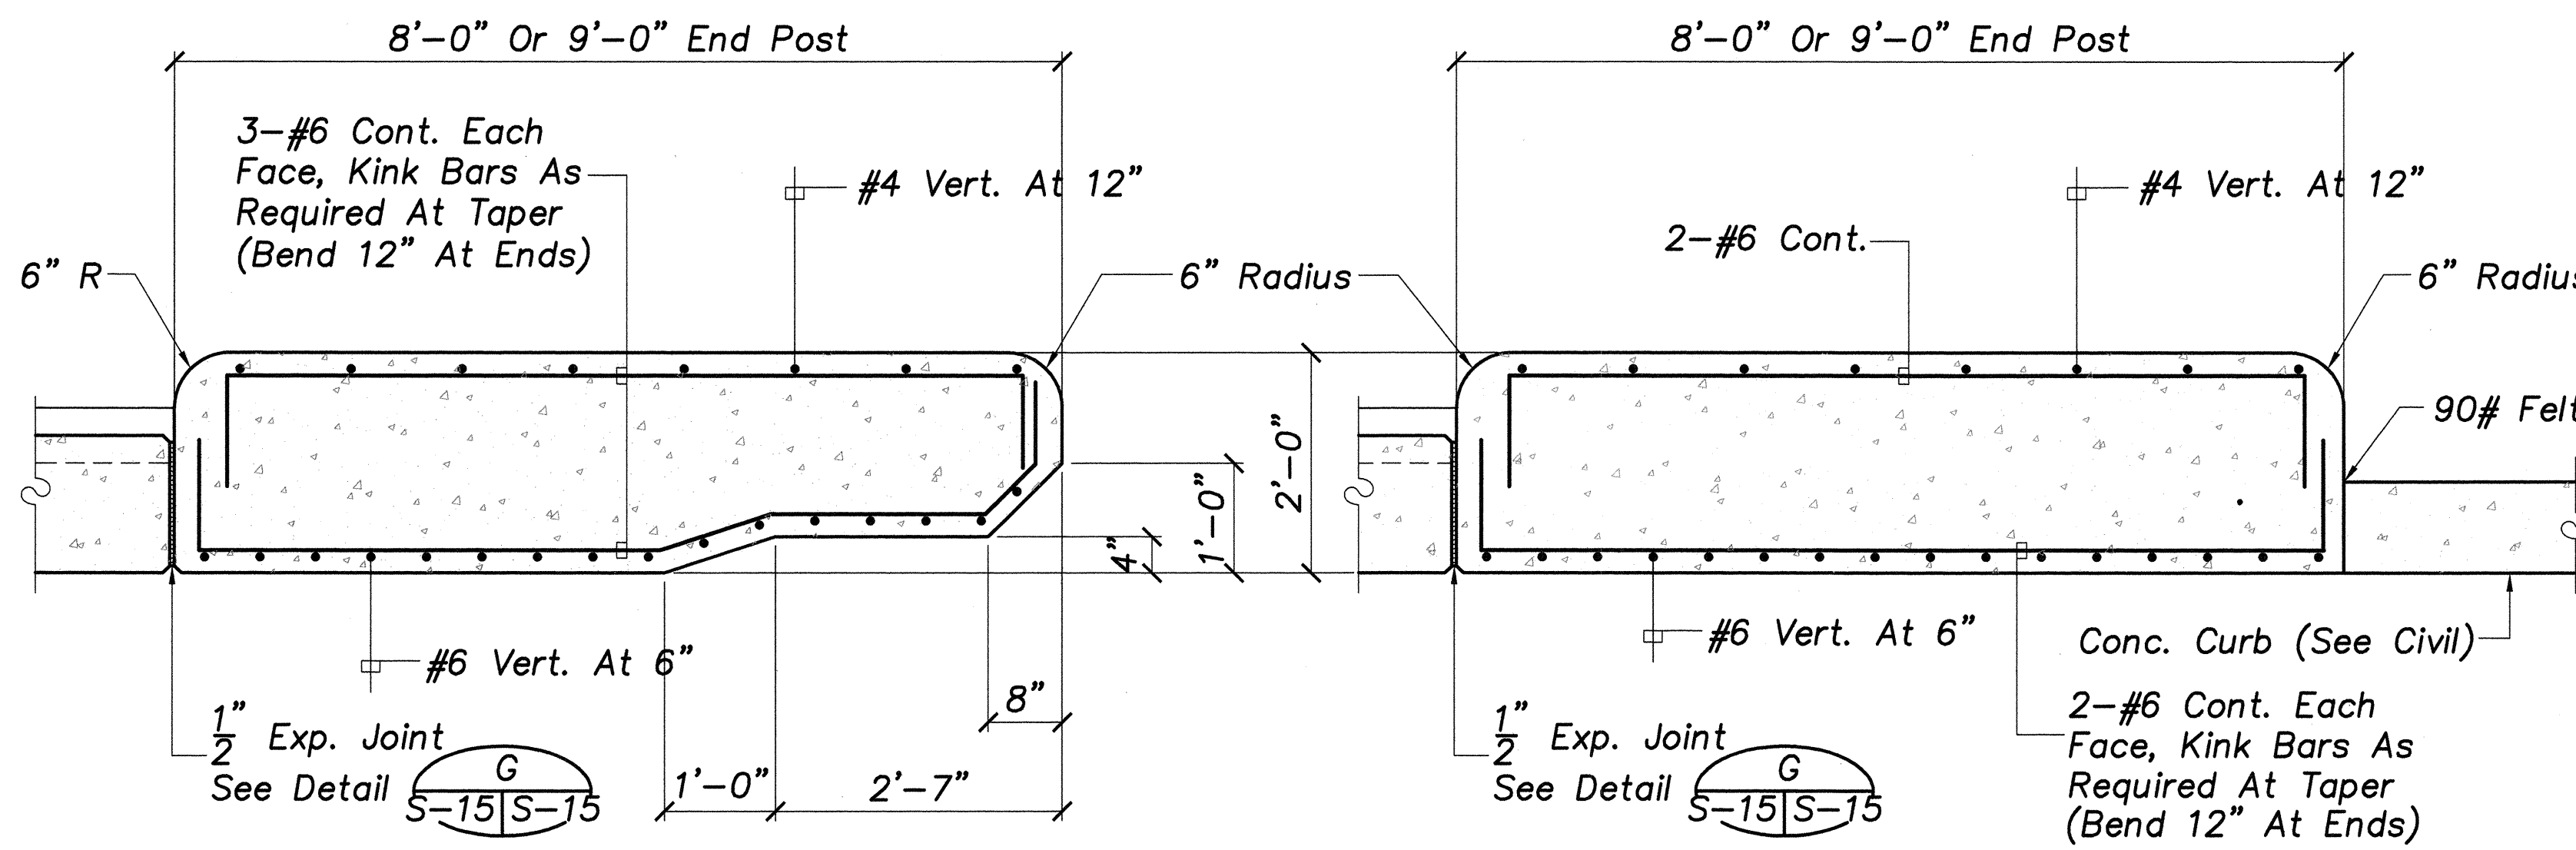


SECTION A
S-15|S-15 Scale: 3/4"=1'-0"


SECTION B
S-15|S-15 Scale: 3/4"=1'-0"

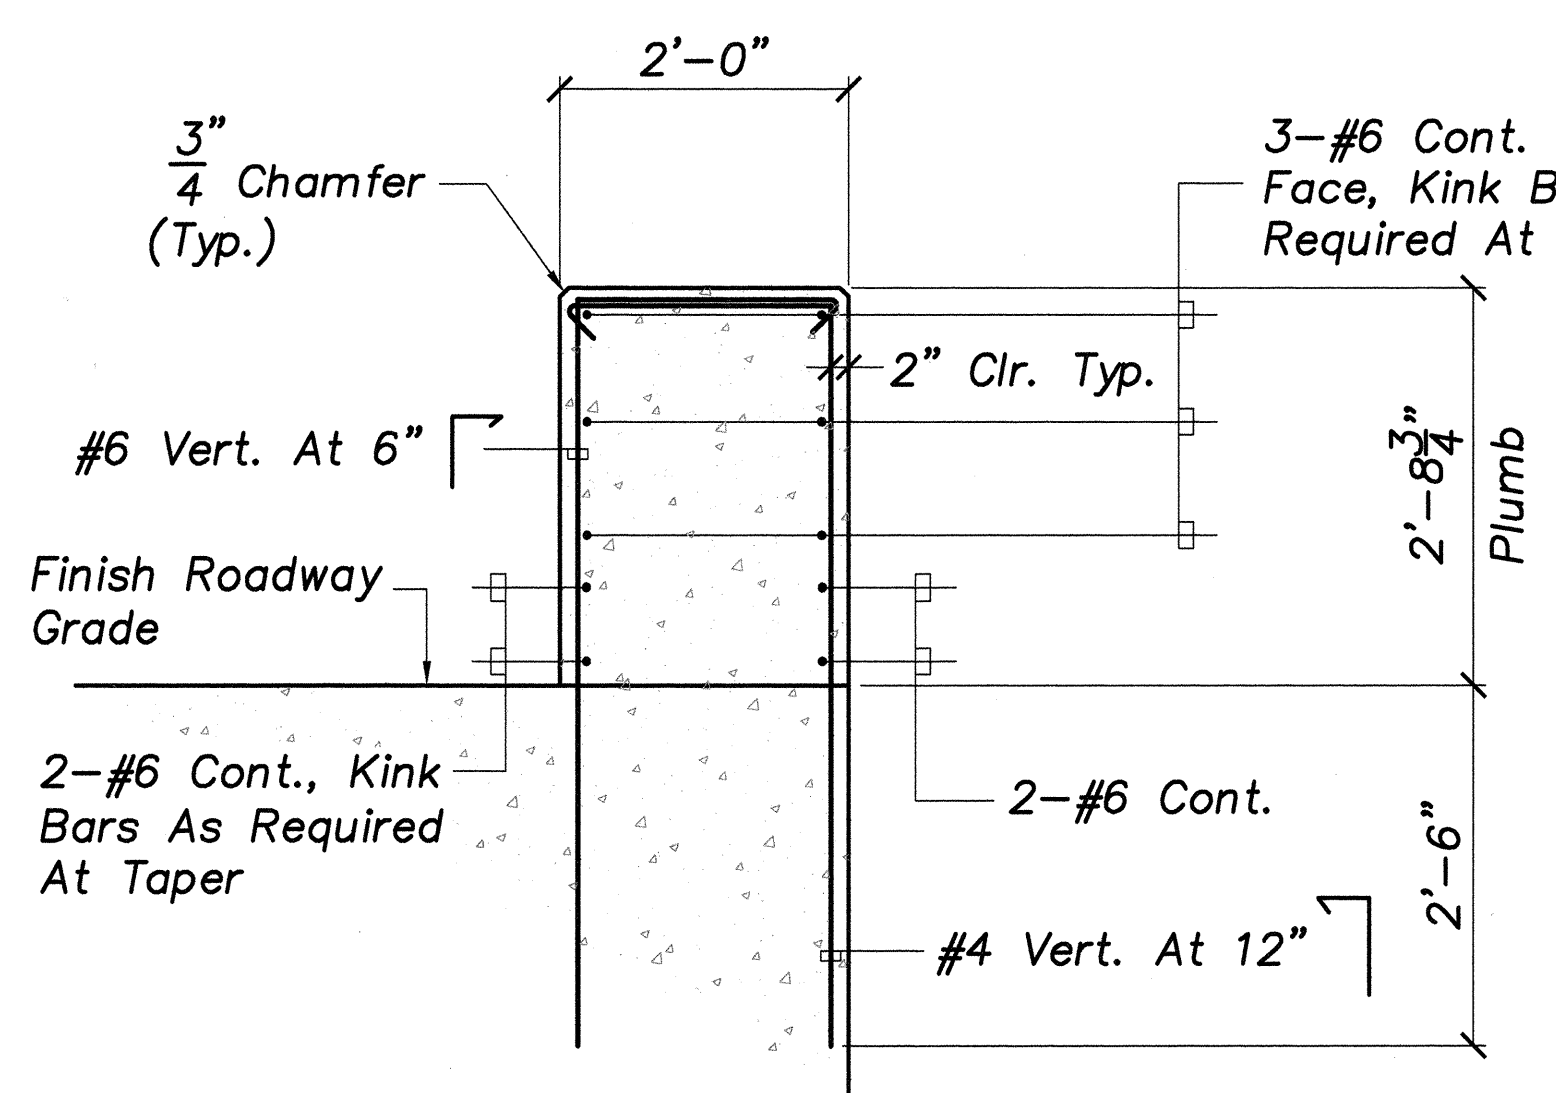


SECTION C
S-15|S-15 Scale: 3/4"=1'-0"

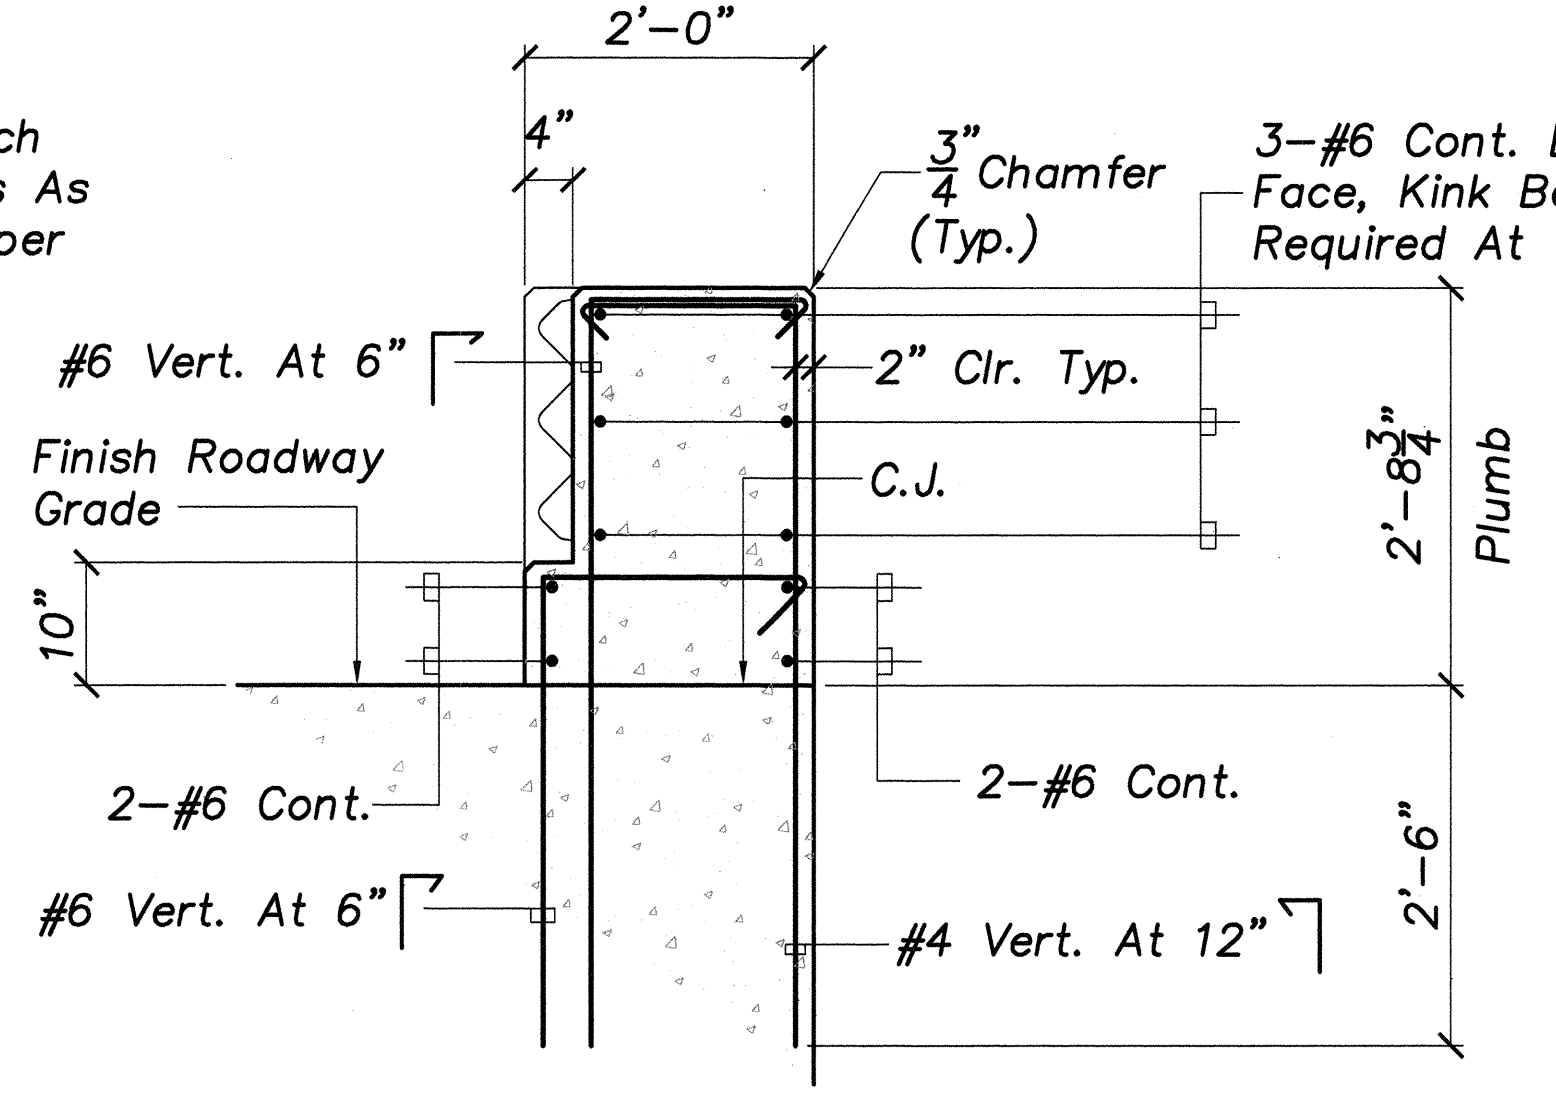


SECTION D
S-15|S-15 Scale: 3/4"=1'-0"

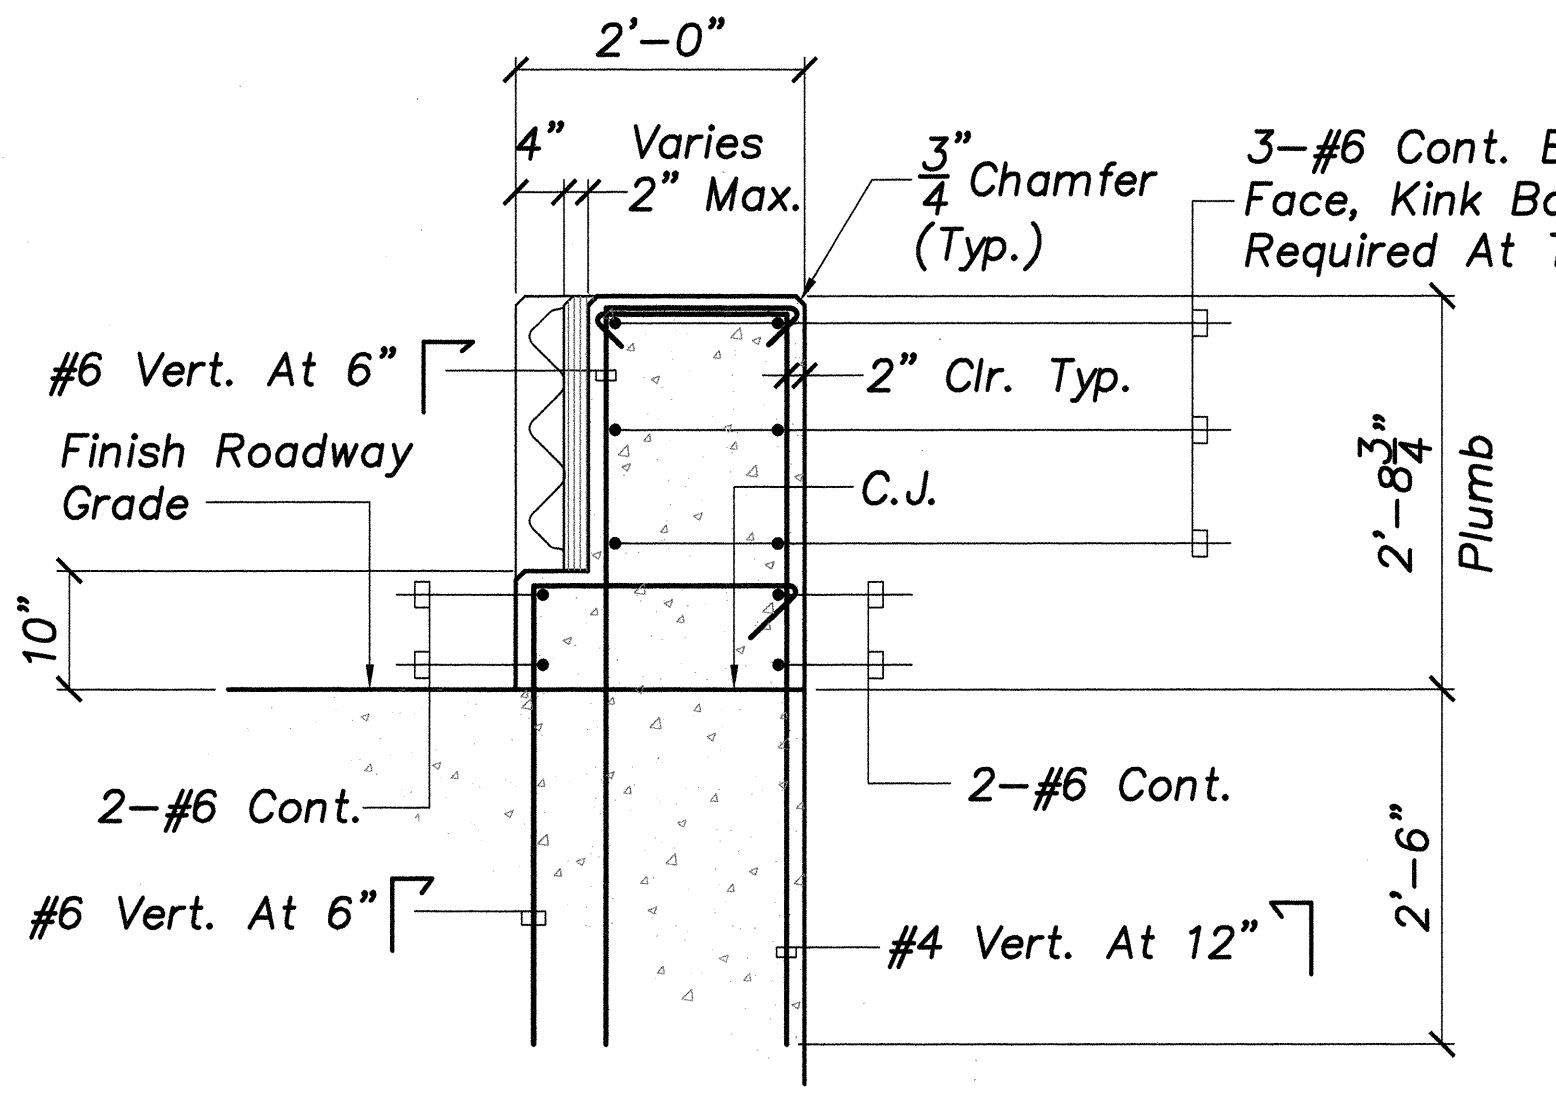


SECTION E
S-15|S-15 Scale: 3/4"=1'-0"

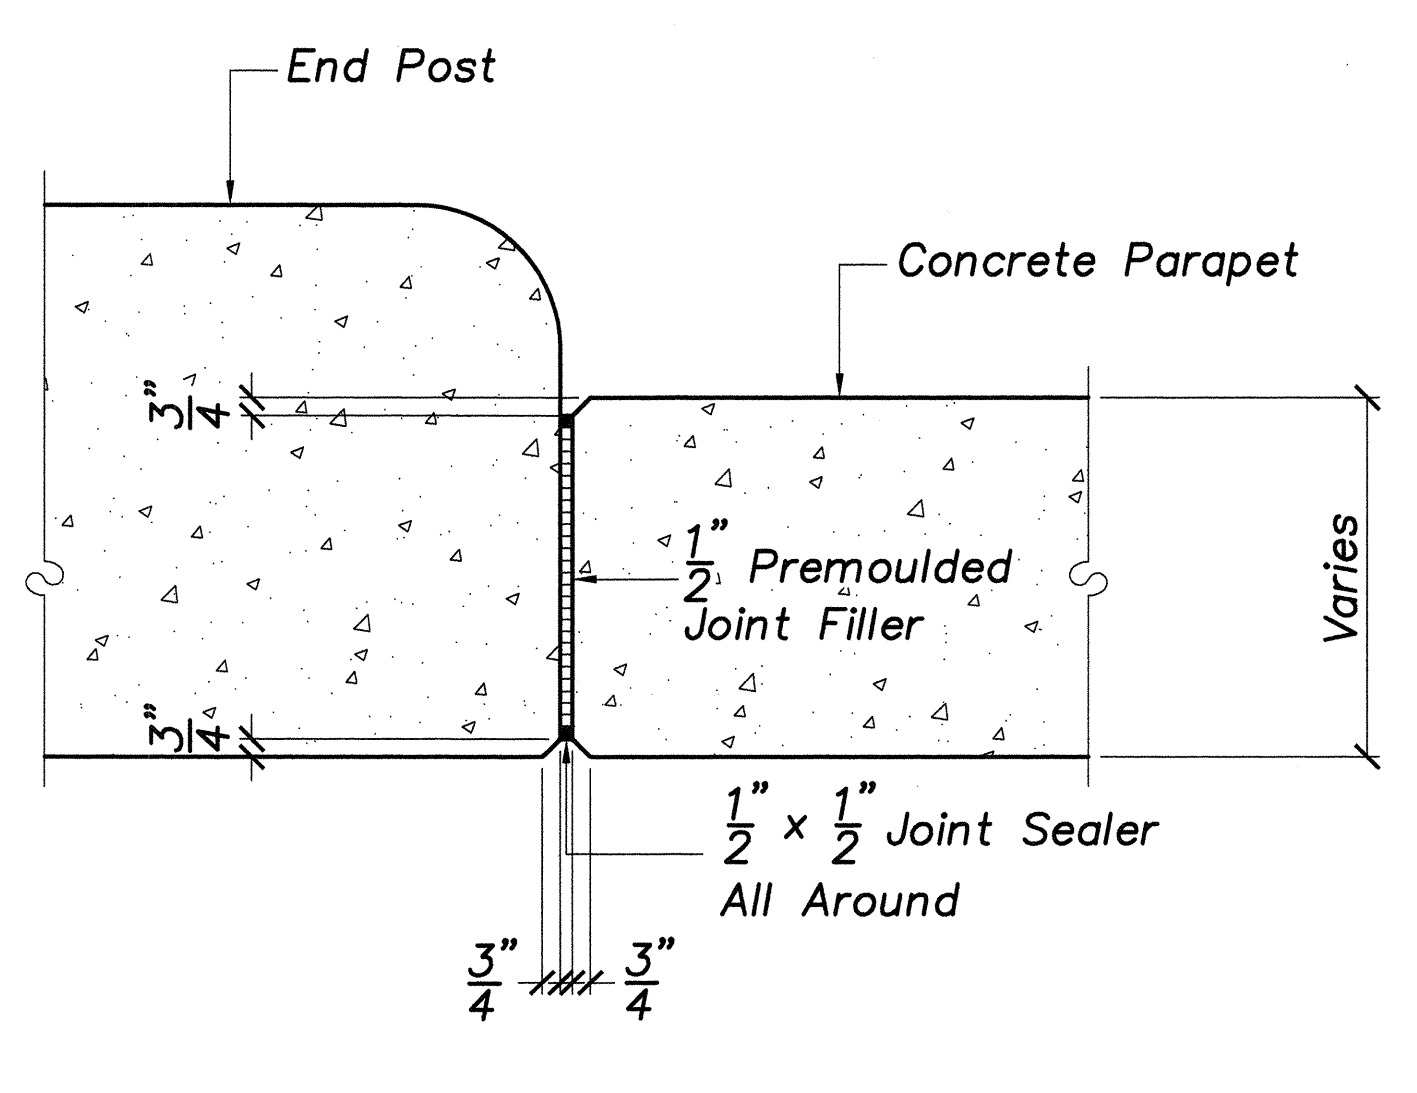

SECTION G
S-15|S-15 Not To Scale
EXP. JOINT AT CONC. PARAPET

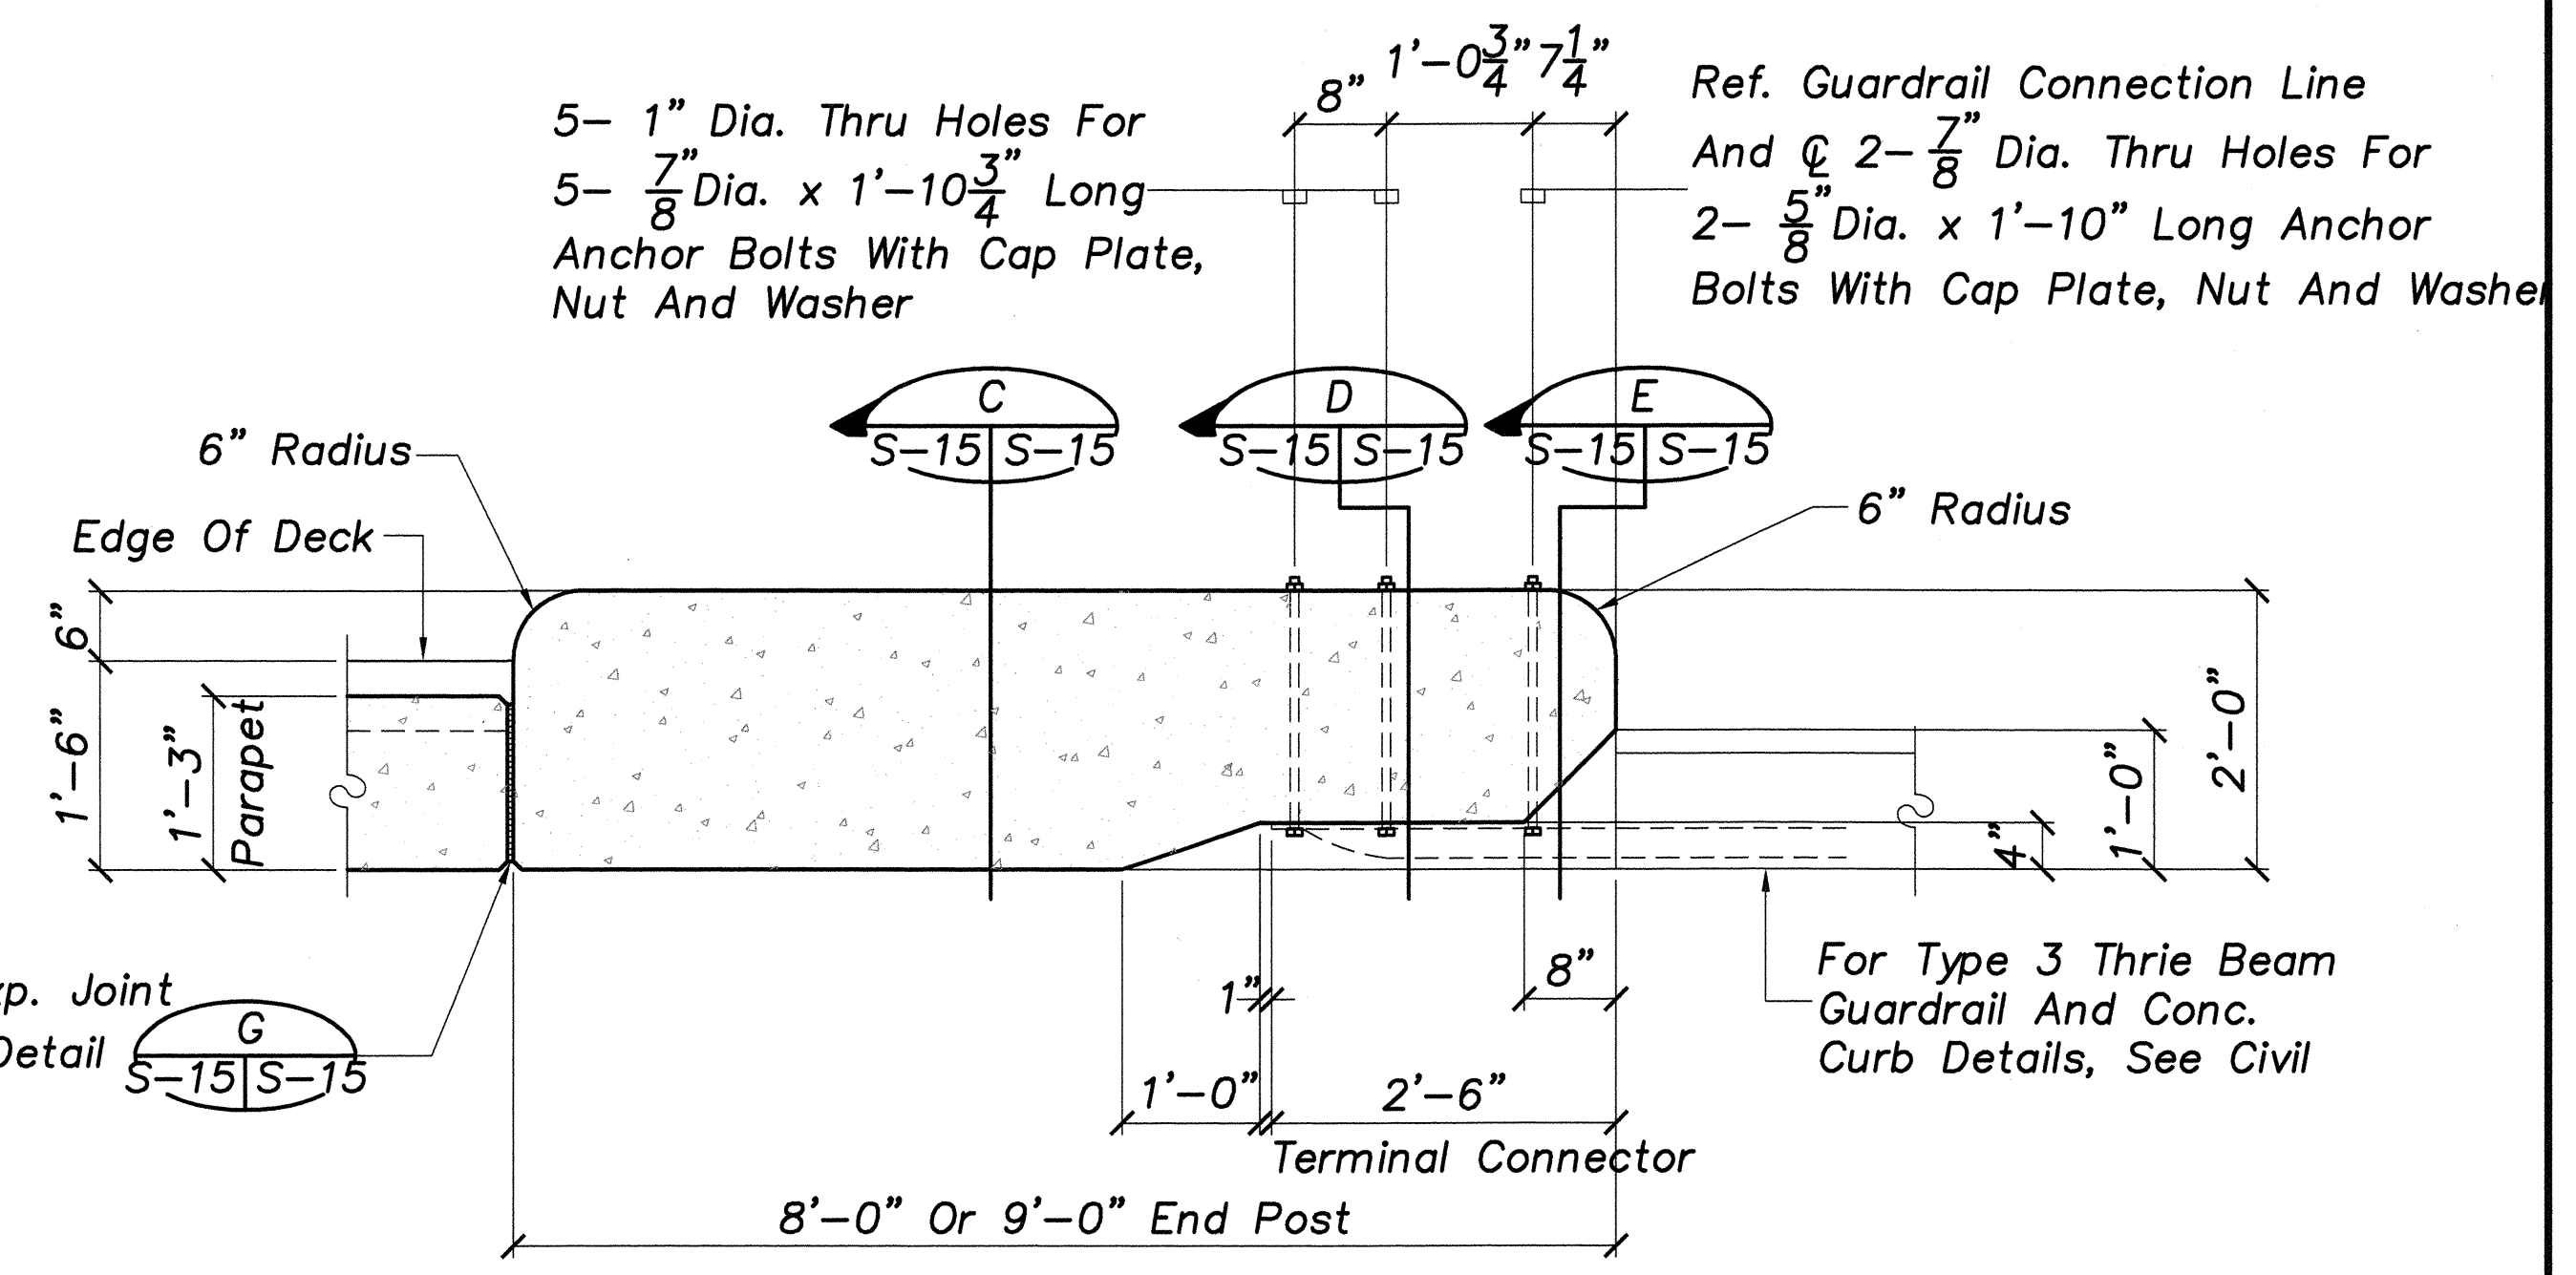


PLAN VIEW

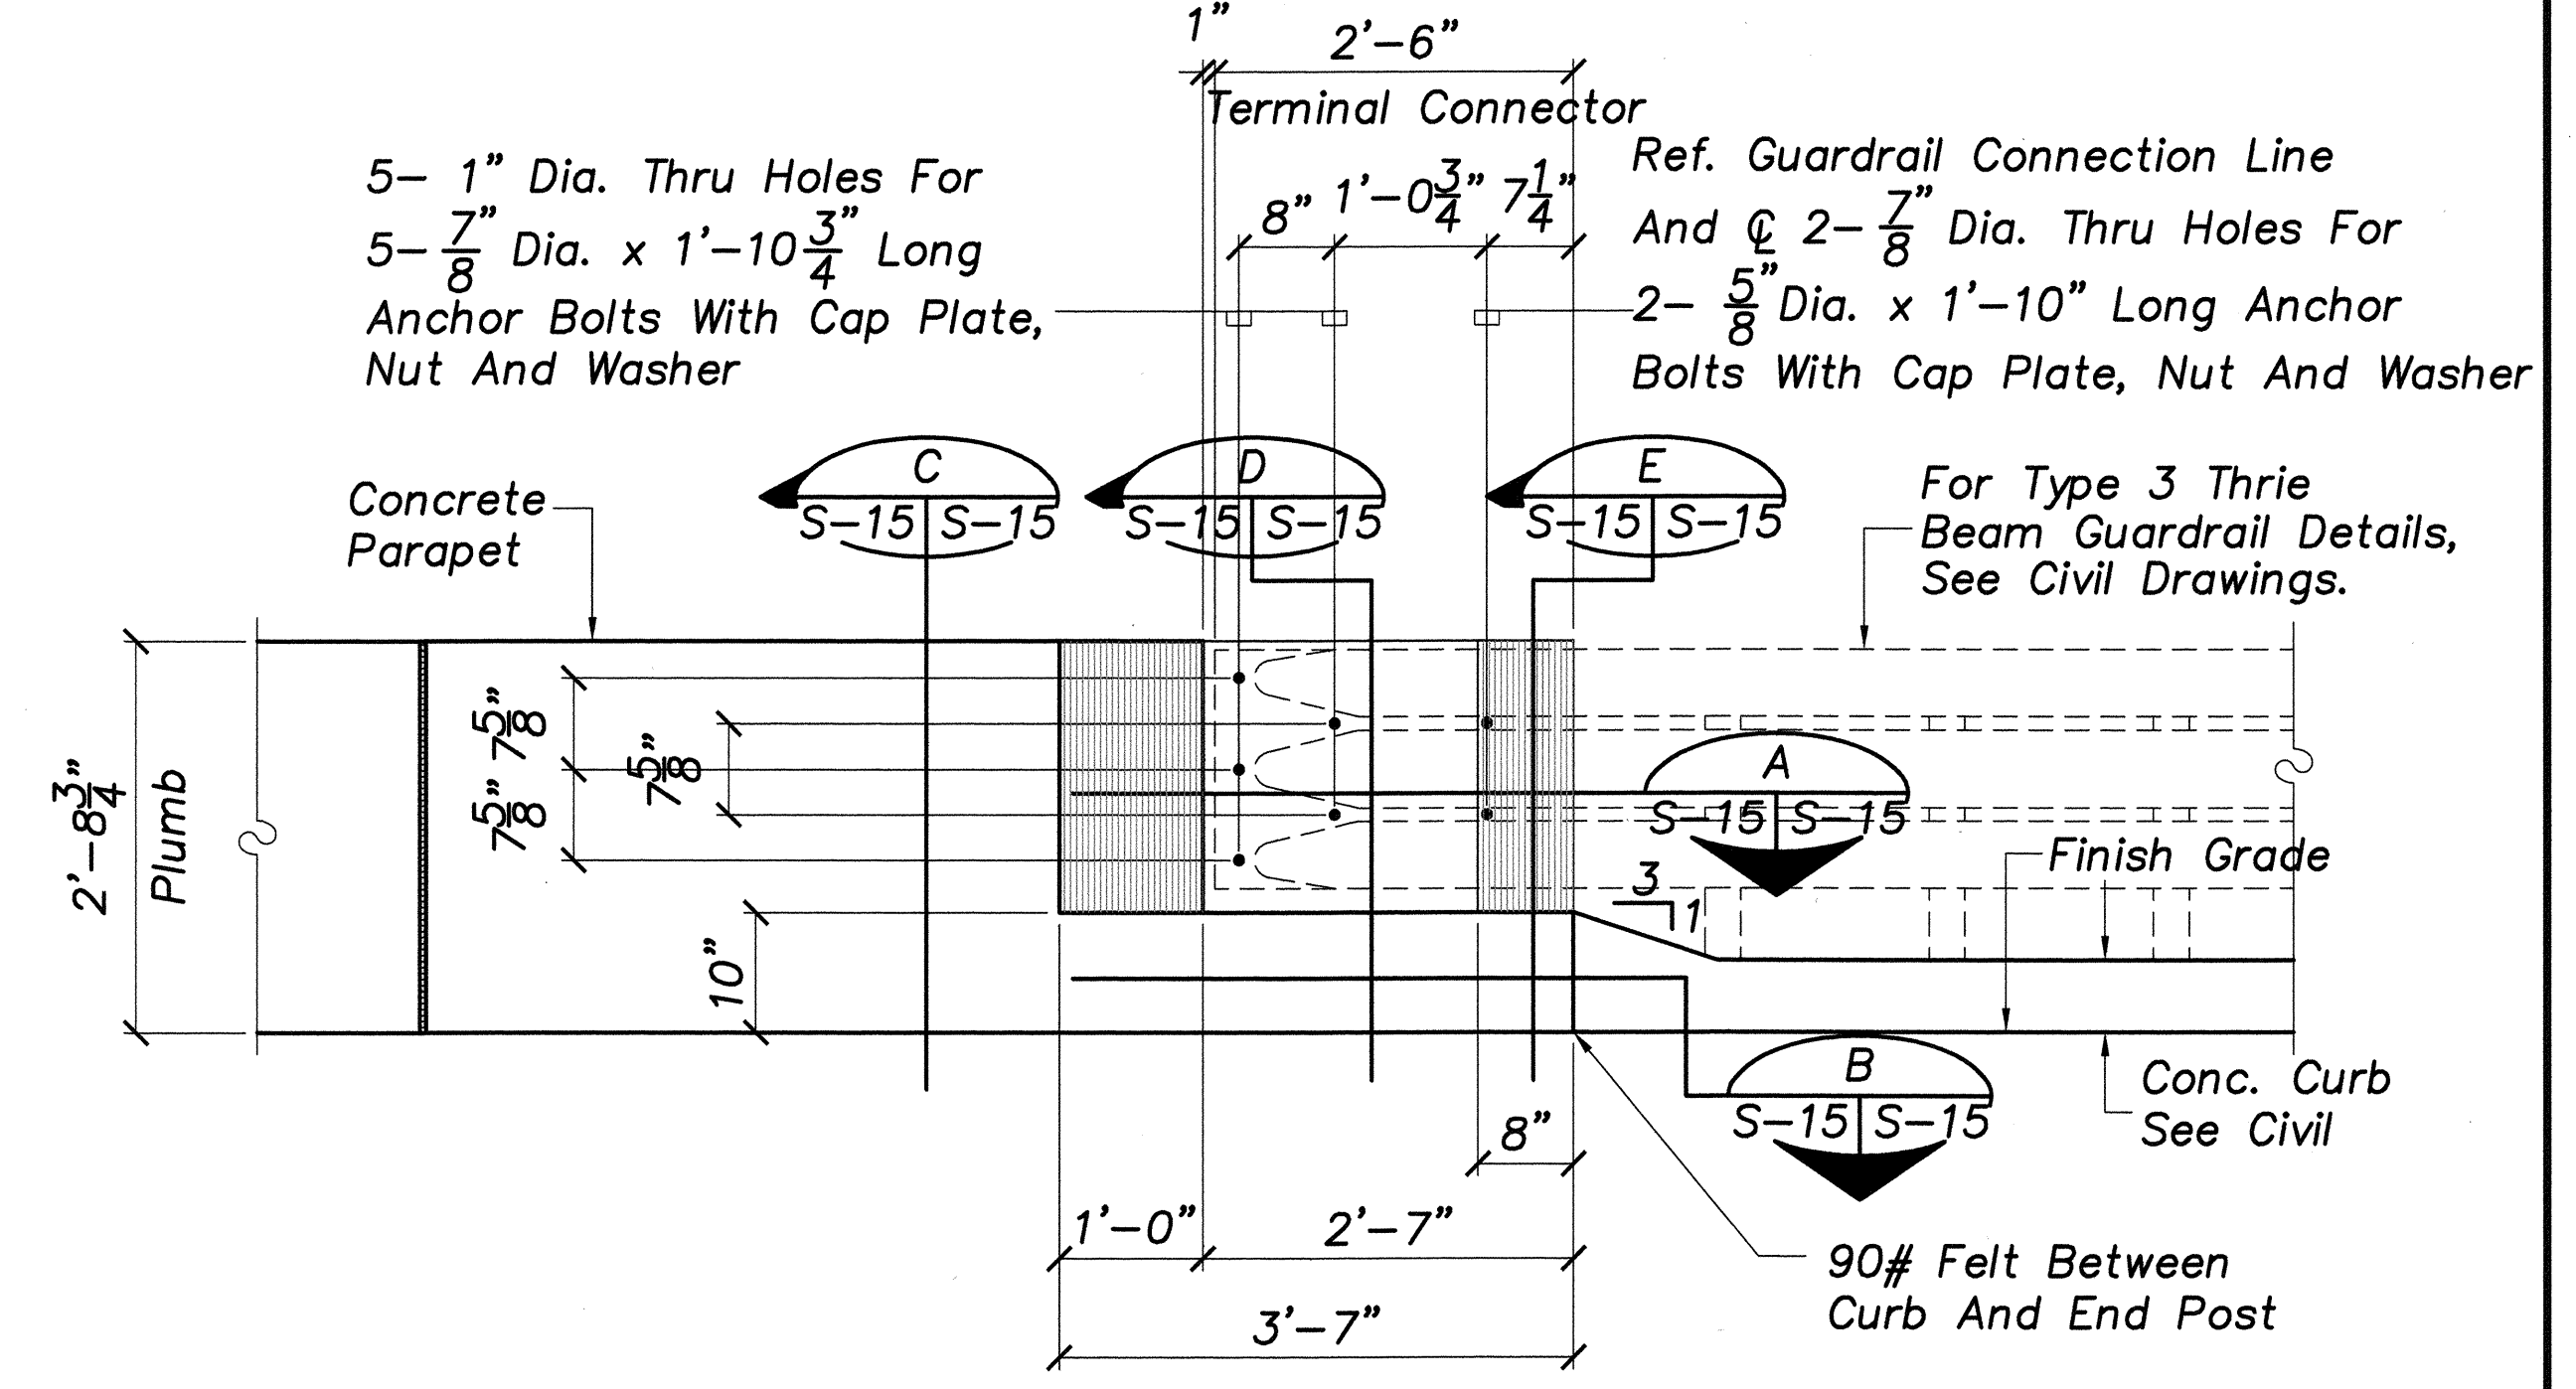

ELEVATION

PARAPET TO GUARDRAIL CONNECTION DETAIL
S-4, S-5, S-15 Scale: 3/4"=1'-0"
S-7, S-9

DATE
DESIGNED BY
CHECKED BY
QUANTITIES BY
REVISIONS
NO.

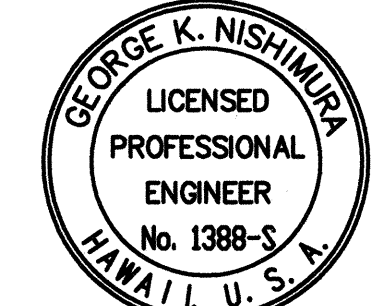



THIS WORK WAS PREPARED BY ME OR UNDER MY SUPERVISION.
SIGNATURE
04/30/06
EXPIRATION DATE OF PROFESSIONAL LICENSE

STATE OF HAWAII
DEPARTMENT OF TRANSPORTATION
HIGHWAYS DIVISION
END POST DETAILS


HALEAKALA HIGHWAY WIDENING, PHASE 2
HANA HIGHWAY TO PUKALANI BYPASS
FED. AID PROJ. NO. NH-037-1(24)

SCALE: AS NOTED DATE: MAY 2005

FED. ROAD DIST. NO.	STATE	FED. AID PROJ. NO.	FISCAL YEAR	SHEET NO.	TOTAL SHEETS
HAWAII	HAW.	NH-037-1(24)	2005	249	288

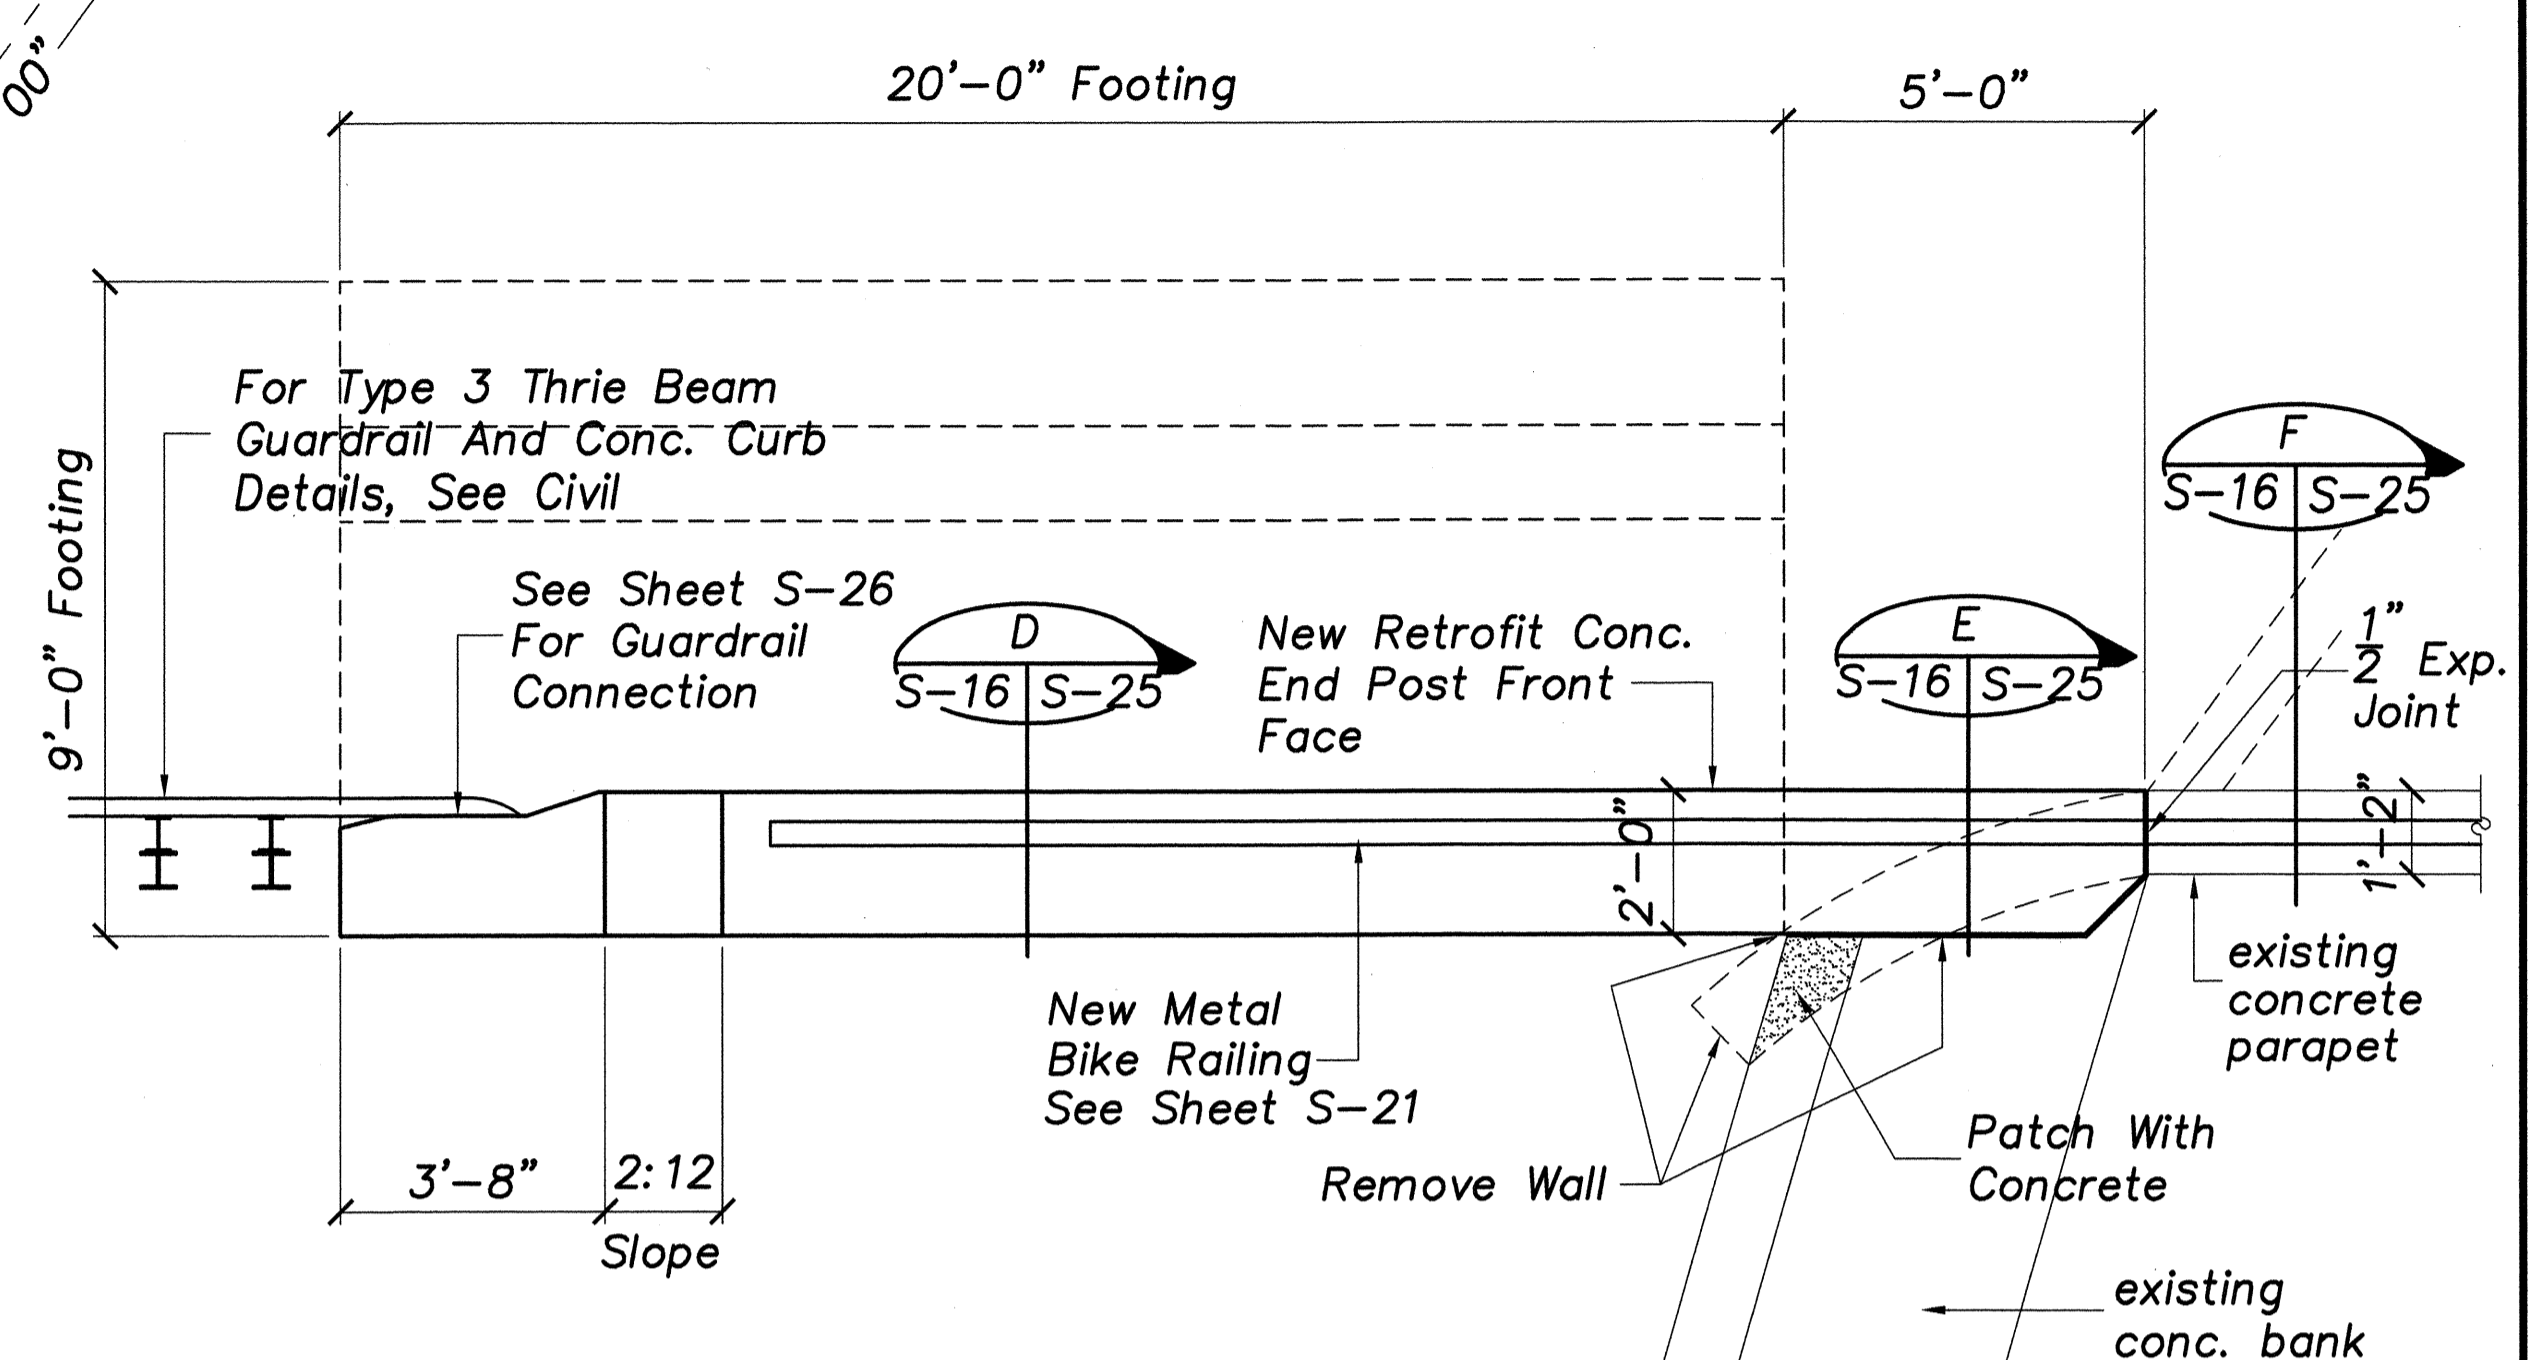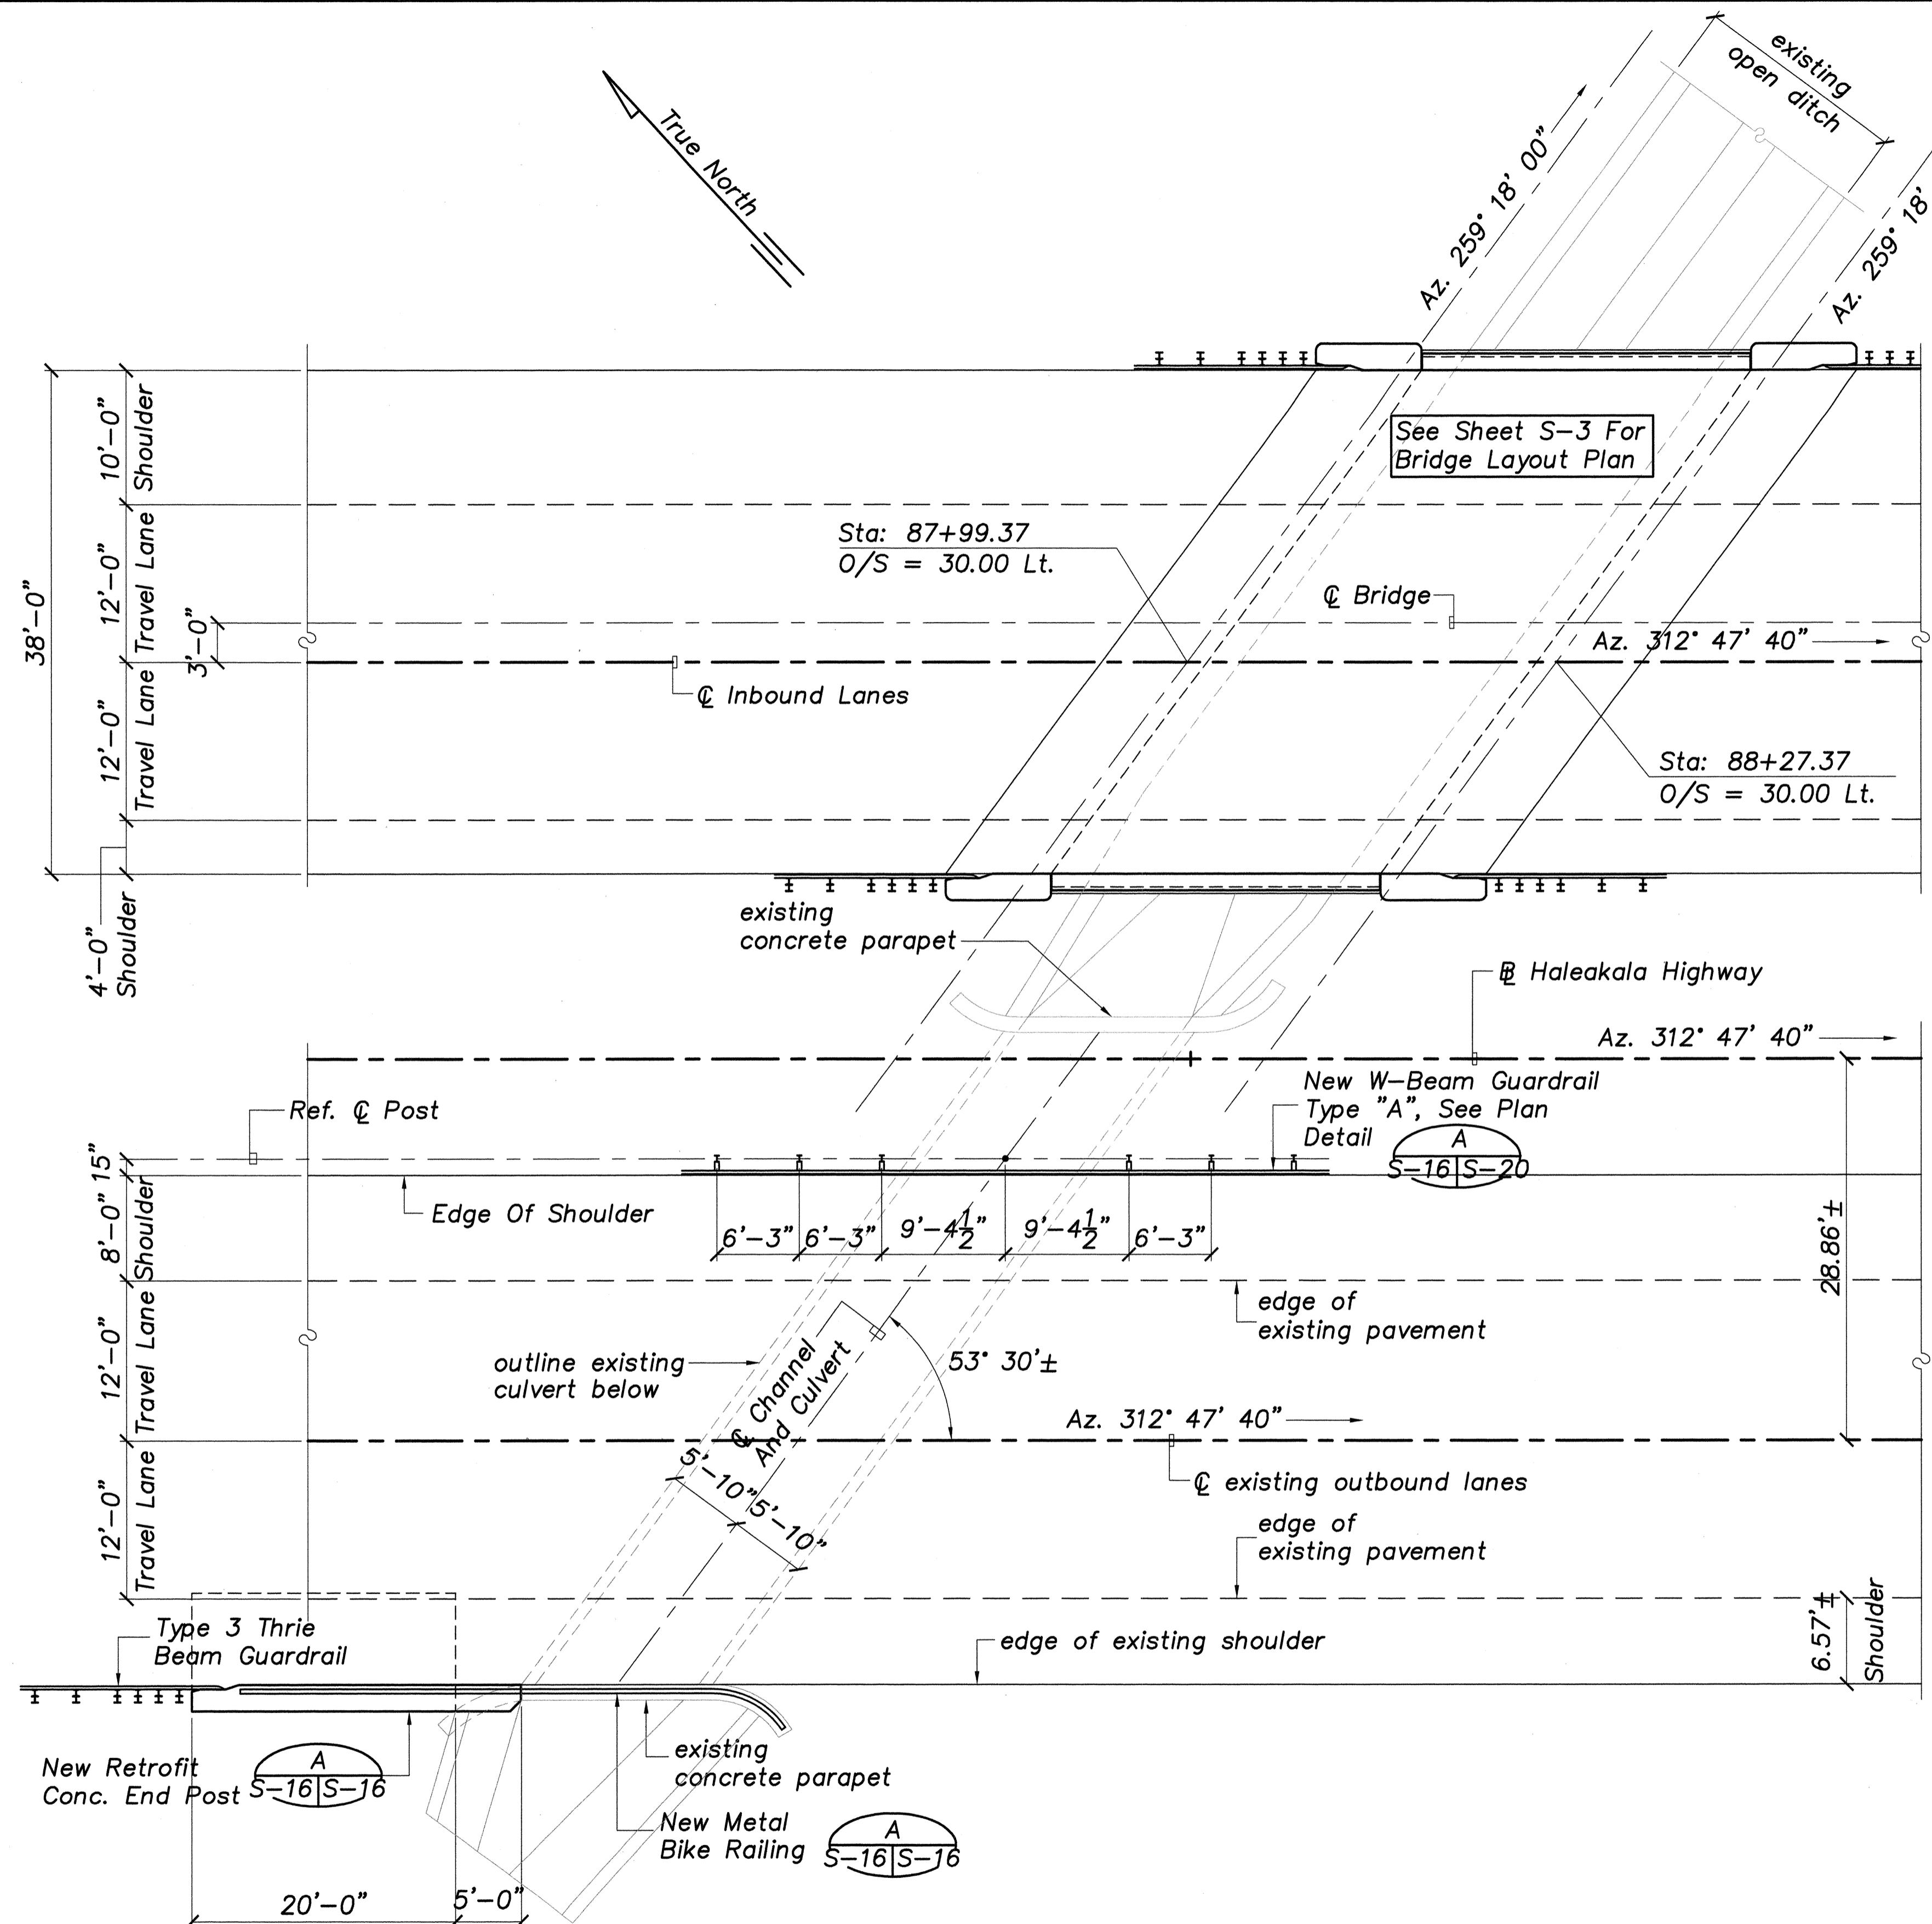

CONCRETE END POST PLAN
Scale: 3/8"=1'-0"

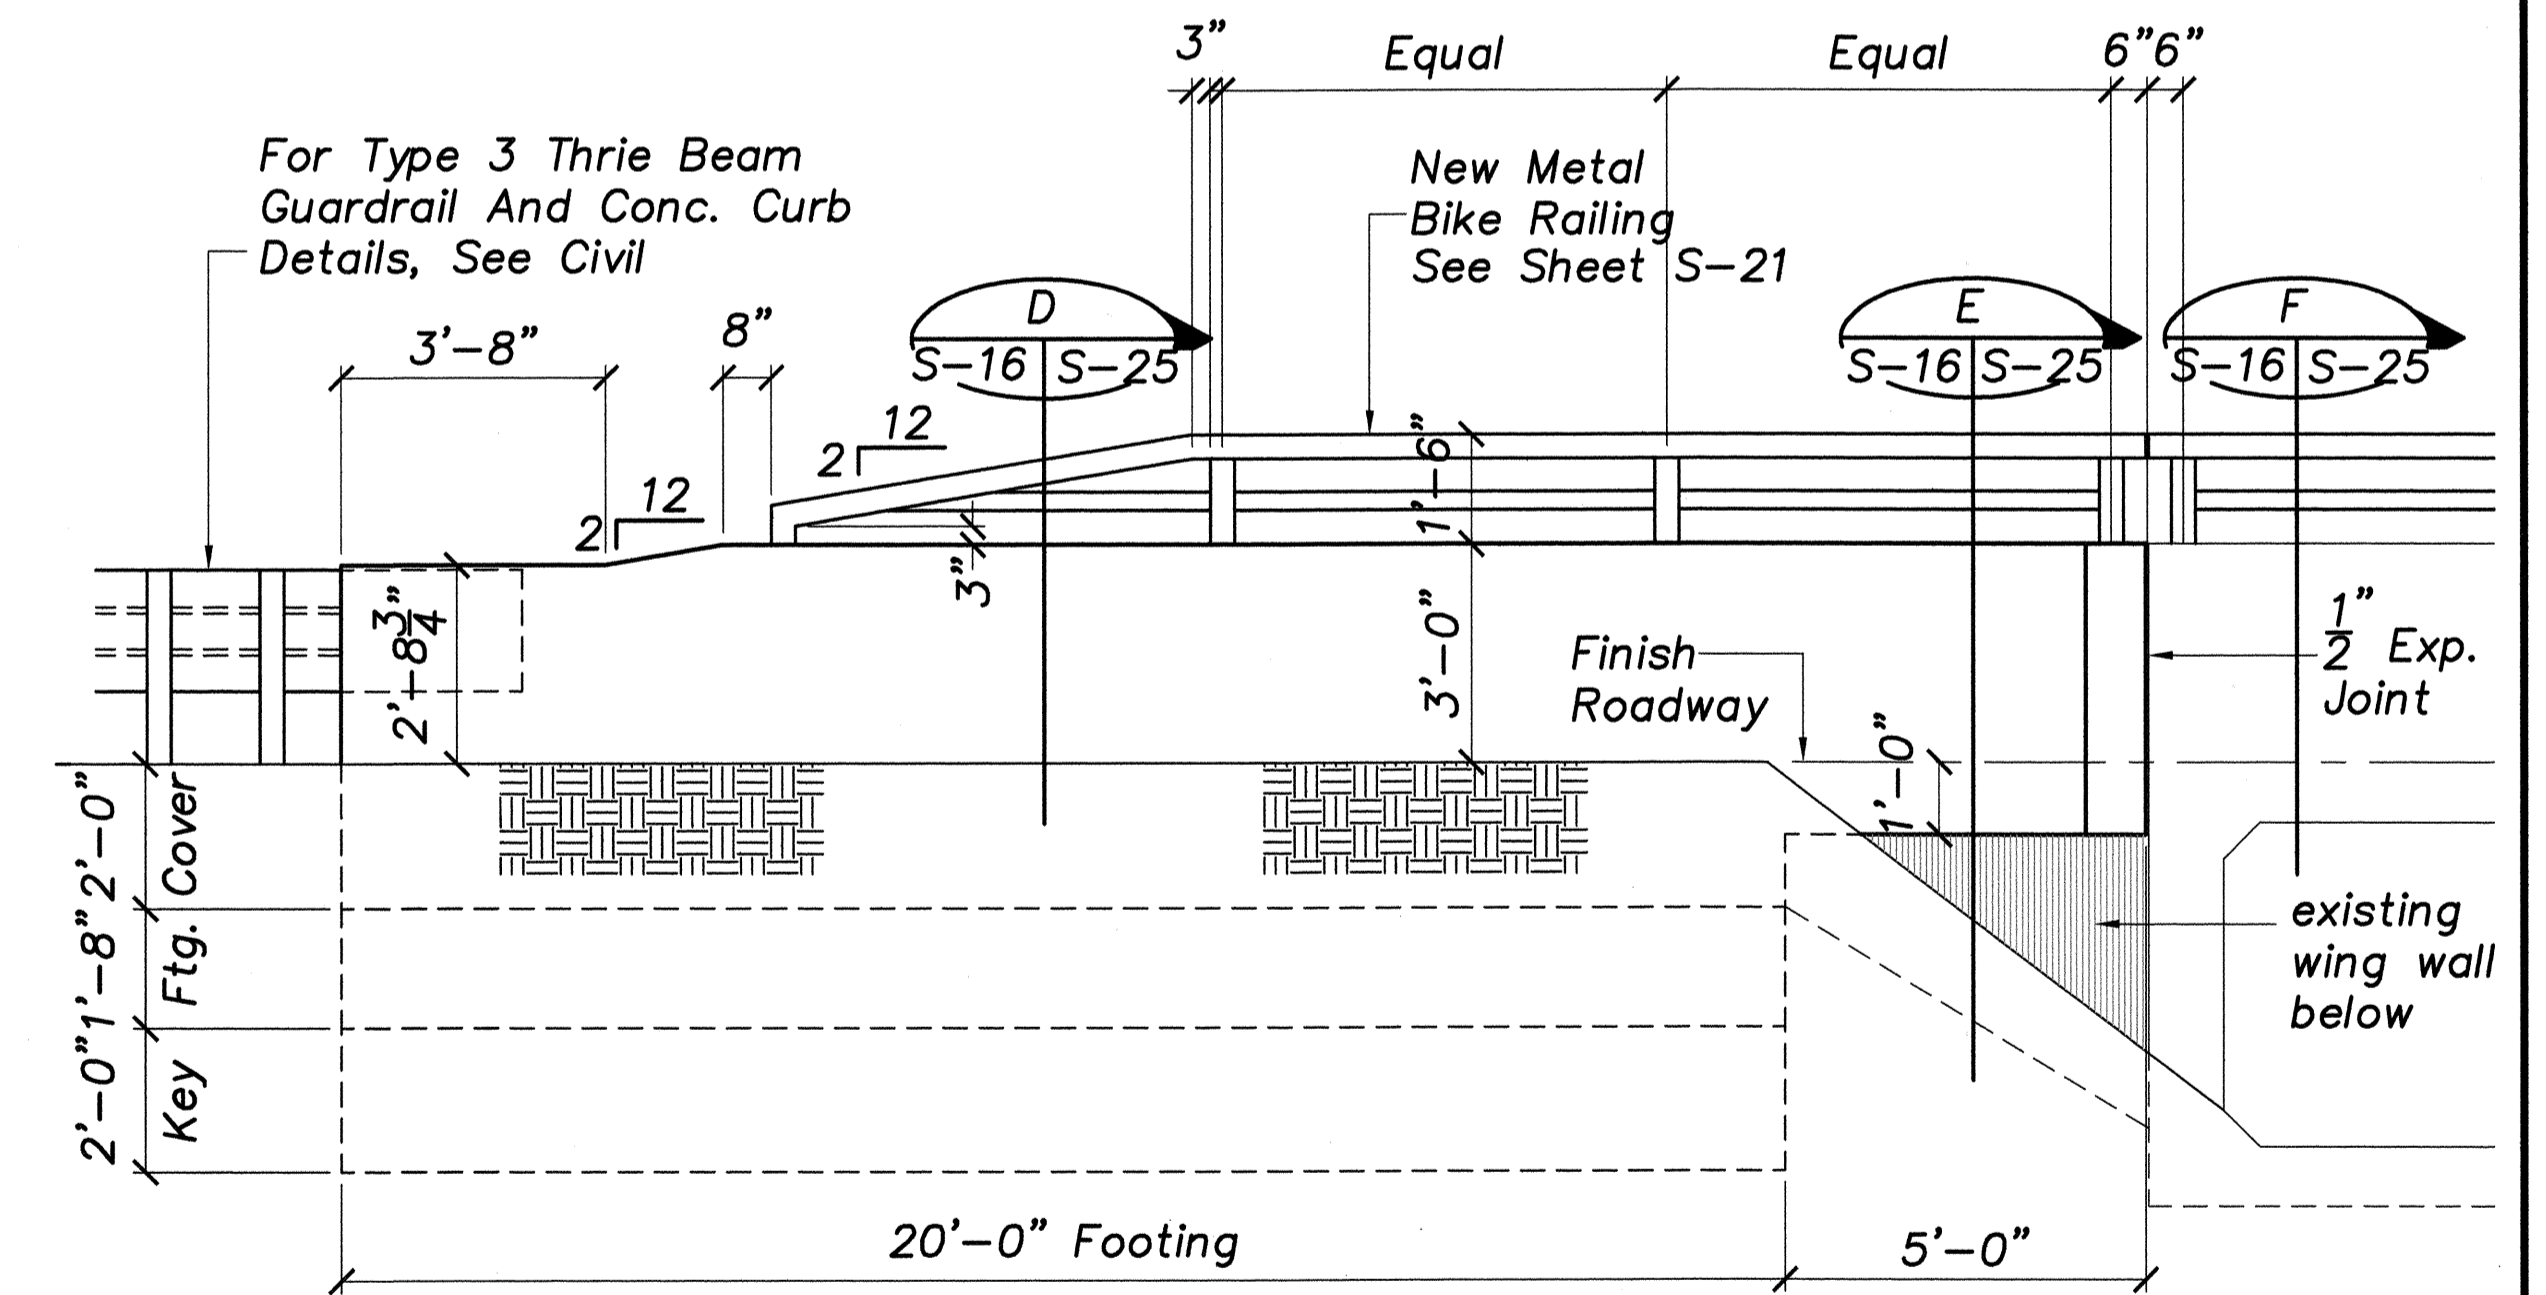

CONCRETE END POST ELEVATION
Scale: 3/8"=1'-0"


**AT HAIKU DITCH CROSSING
EXISTING WATERWAY STRUCTURE NO. 1 LAYOUT PLAN**
Scale: 1/8"=1'-0"

DATE _____
SURVEY PLOTTED BY _____
DRAWN BY _____
DESIGNED BY _____
CHECKED BY _____
ORIGINAL PLAN No. _____
NOTE BOOK No. _____

GEORGE K. NISHIMURA
LICENSED PROFESSIONAL ENGINEER
No. 1388-S
HAWAII, U. S. A.
THIS WORK WAS PREPARED BY ME OR UNDER MY SUPERVISION.
SIGNATURE
04/30/05
EXPIRATION DATE OF PROFESSIONAL LICENSE

STATE OF HAWAII
DEPARTMENT OF TRANSPORTATION
HIGHWAYS DIVISION
**EXISTING WATERWAY STRUCTURE NO. 1
LAYOUT PLAN**
HALEAKALA HIGHWAY WIDENING, PHASE 2
HANA HIGHWAY TO PUKALANI BYPASS
FED. AID PROJ. NO. NH-037-1(24)
SCALE: AS NOTED DATE: MAY 2005
SHEET No. S-16 OF 26 SHEETS



FED. ROAD DIST. NO.	STATE	FED. AID PROJ. NO.	FISCAL YEAR	SHEET NO.	TOTAL SHEETS
HAWAII	HAW.	NH-037-1(24)	2005	250	288

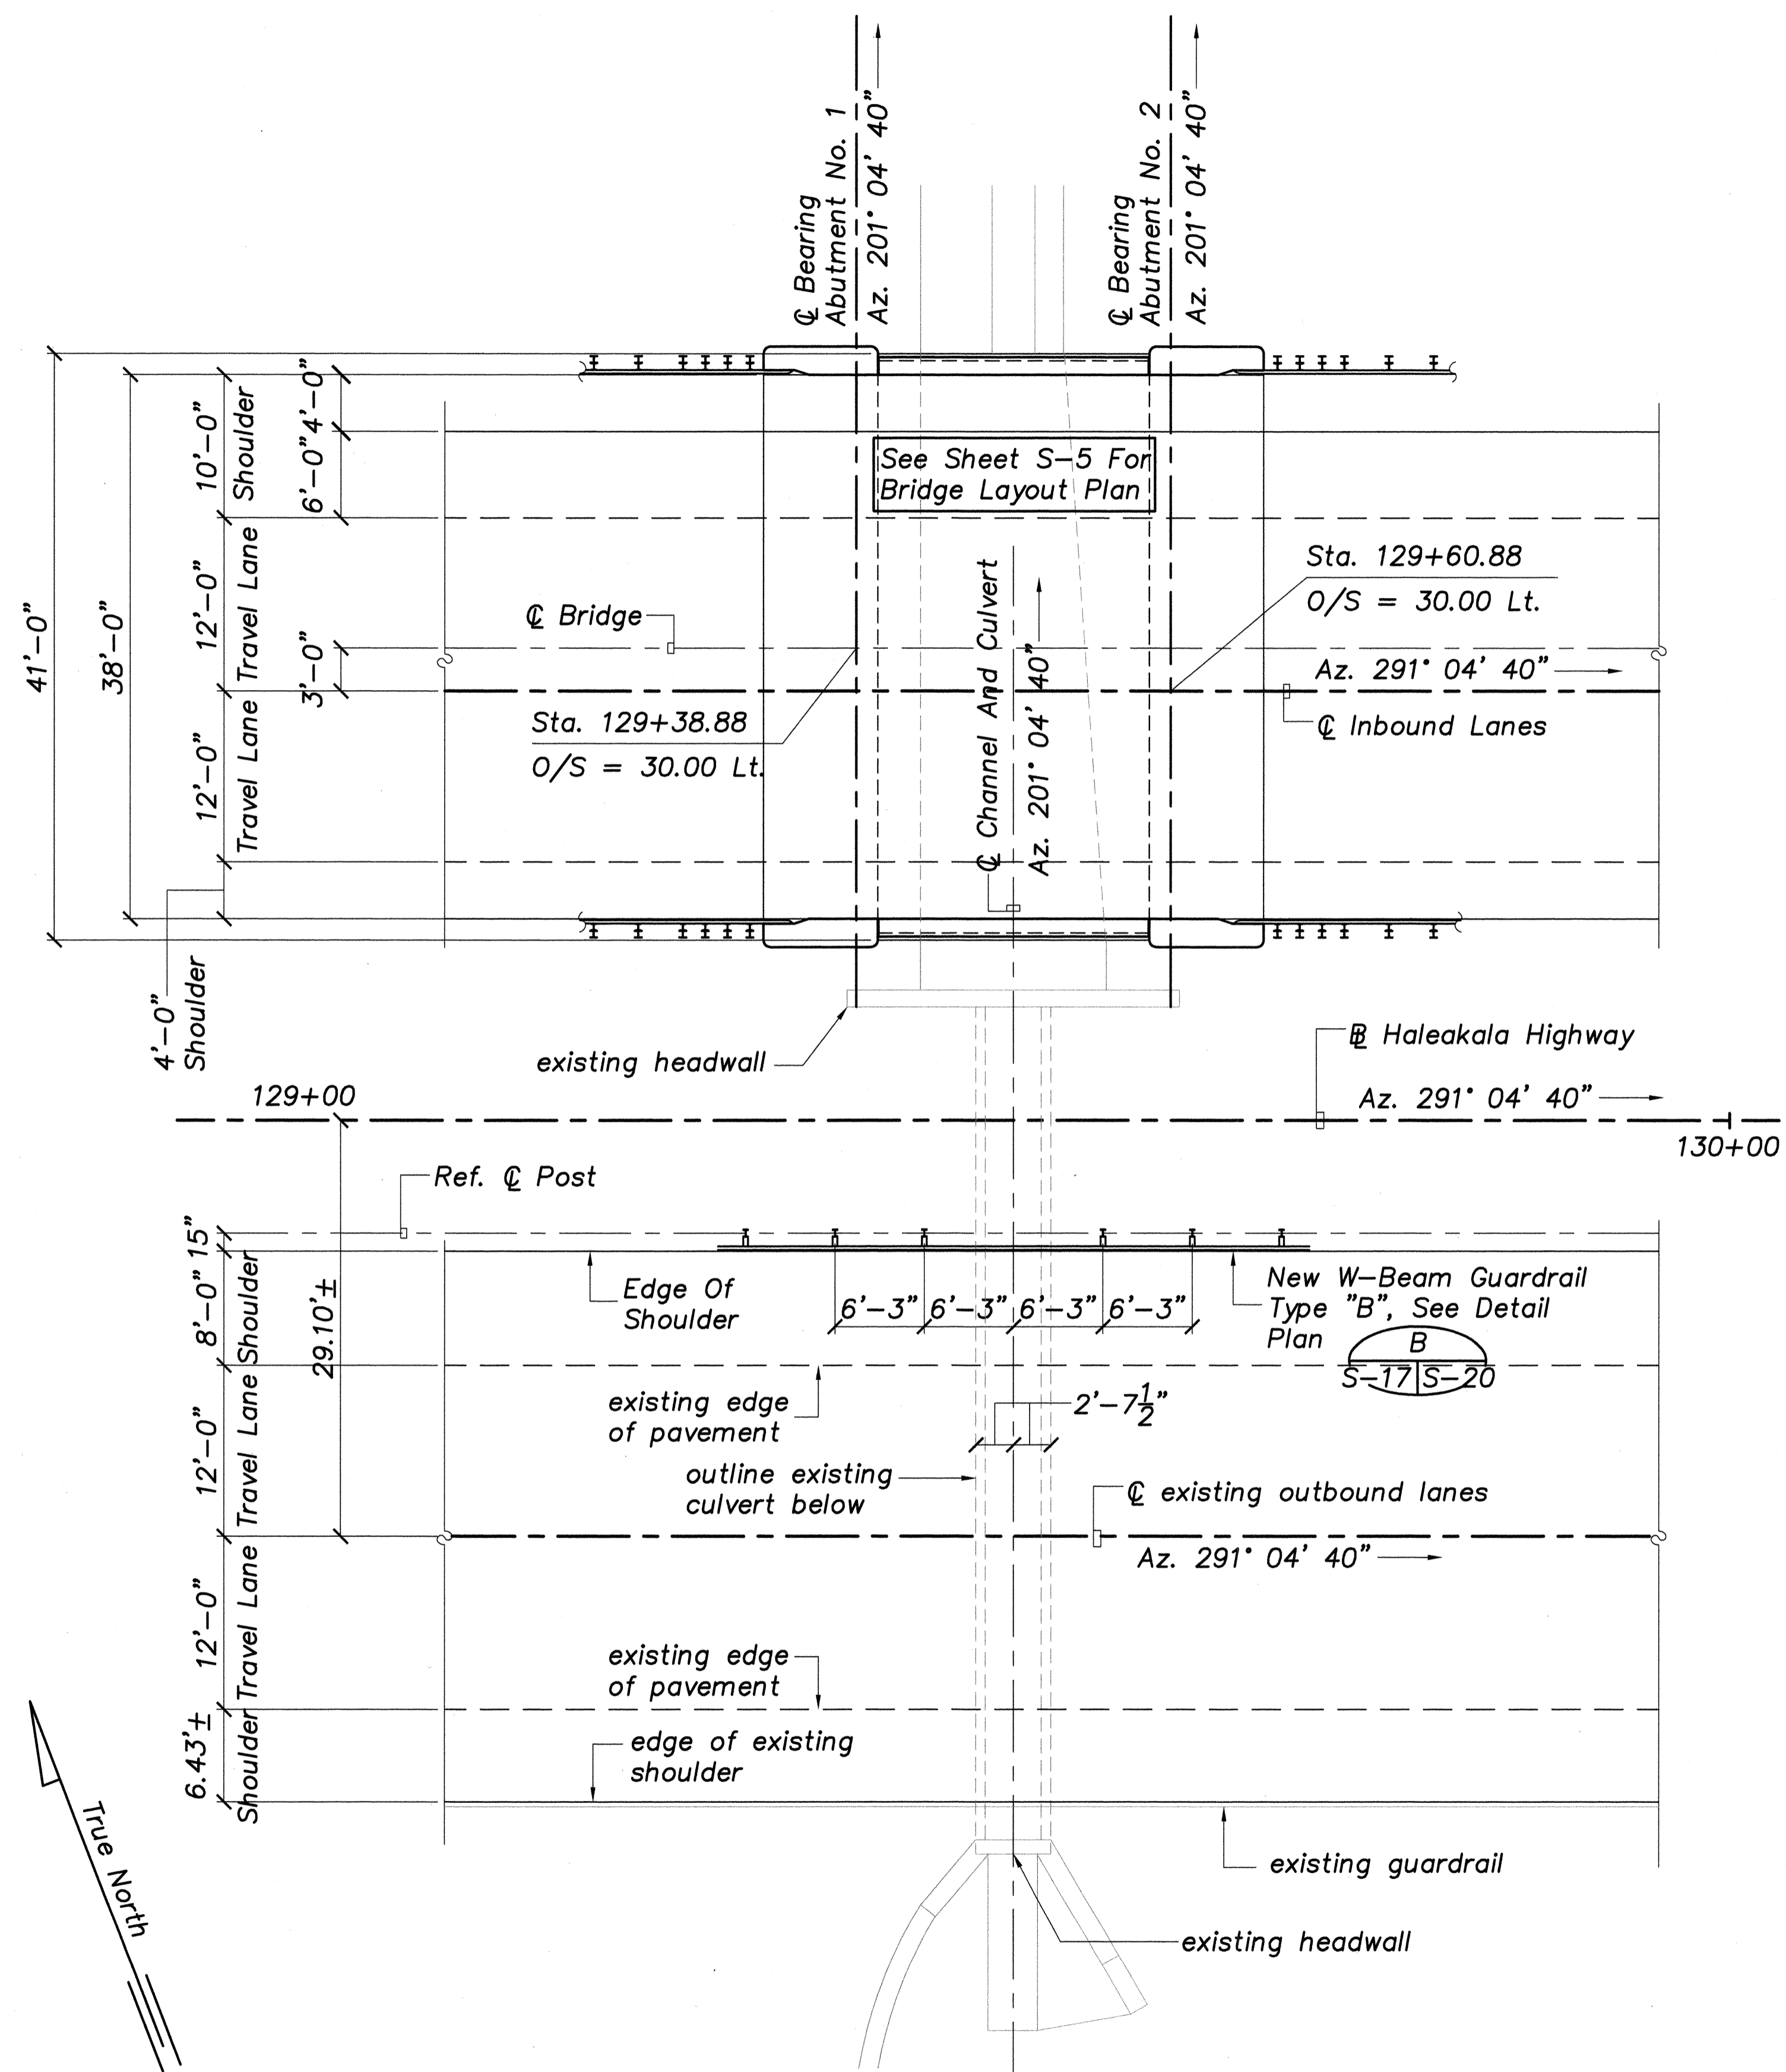

**AT BOX CULVERT CROSSING
EXISTING WATERWAY STRUCTURE NO. 2 LAYOUT PLAN**

Scale: 1/8"=1'-0"

DESIGNED BY	DATE
DRAWN BY	
CHECKED BY	
APPROVED BY	
NO. BOOK	
NO.	

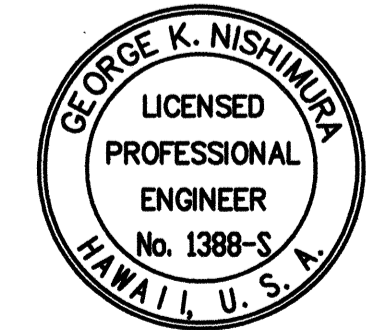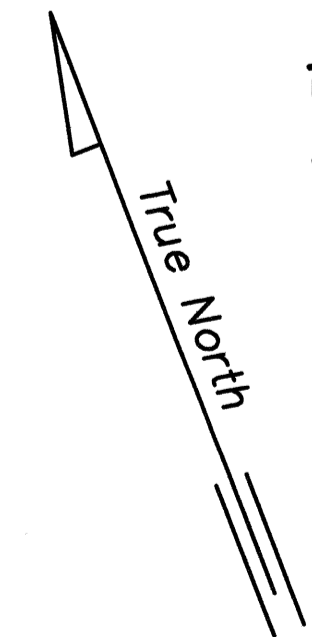

THIS WORK WAS PREPARED BY ME OR UNDER MY SUPERVISION.
 SIGNATURE
 04/30/06
 EXPIRATION DATE OF PROFESSIONAL LICENSE


STATE OF HAWAII
 DEPARTMENT OF TRANSPORTATION
 HIGHWAYS DIVISION
**EXISTING WATERWAY STRUCTURE NO. 2
 LAYOUT PLAN**

*HALEAKALA HIGHWAY WIDENING, PHASE 2
 HANA HIGHWAY TO PUKALANI BYPASS
 FED. AID PROJ. NO. NH-037-1(24)*


SCALE: AS NOTED DATE: MAY 2005

SHEET No. S-17 OF 26 SHEETS


FED. ROAD DIST. NO.	STATE	FED. AID PROJ. NO.	FISCAL YEAR	SHEET NO.	TOTAL SHEETS
HAWAII	HAW.	NH-037-1(24)	2005	C.O. 251	288

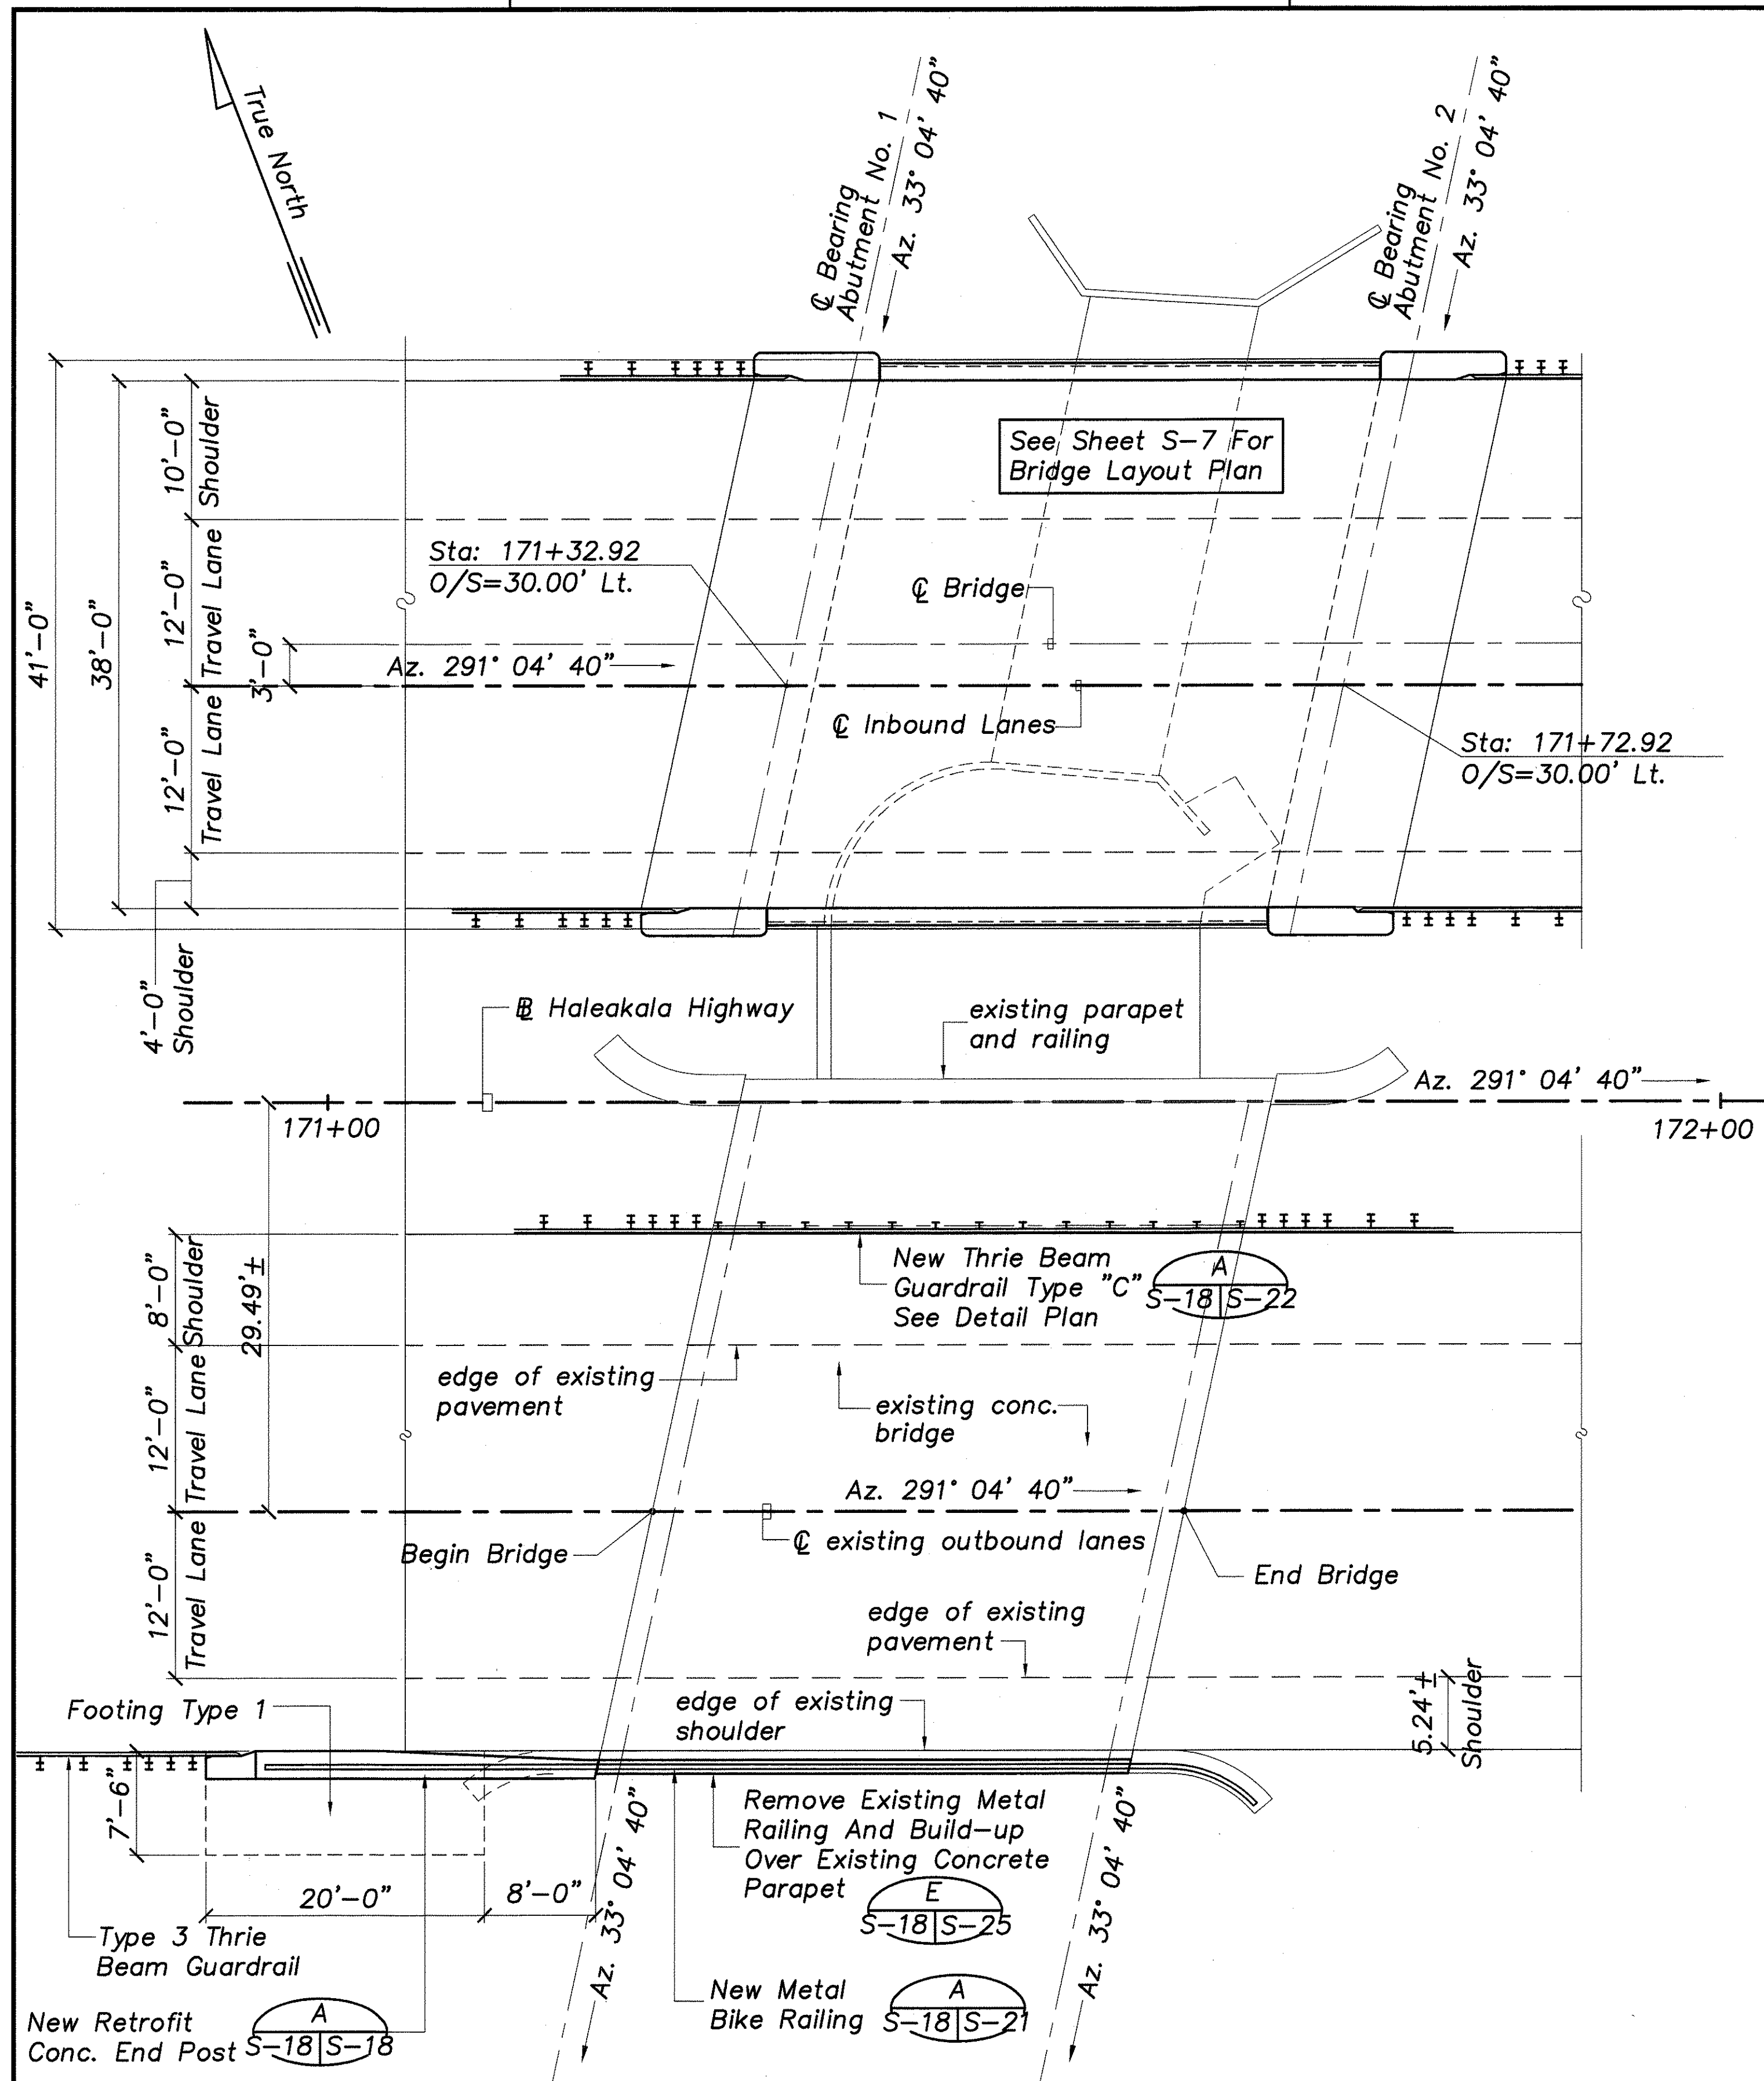

AT LOWRIE DITCH CROSSING
EXISTING WATERWAY STRUCTURE NO. 3 LAYOUT PLAN
 Scale: 1/8"=1'-0"

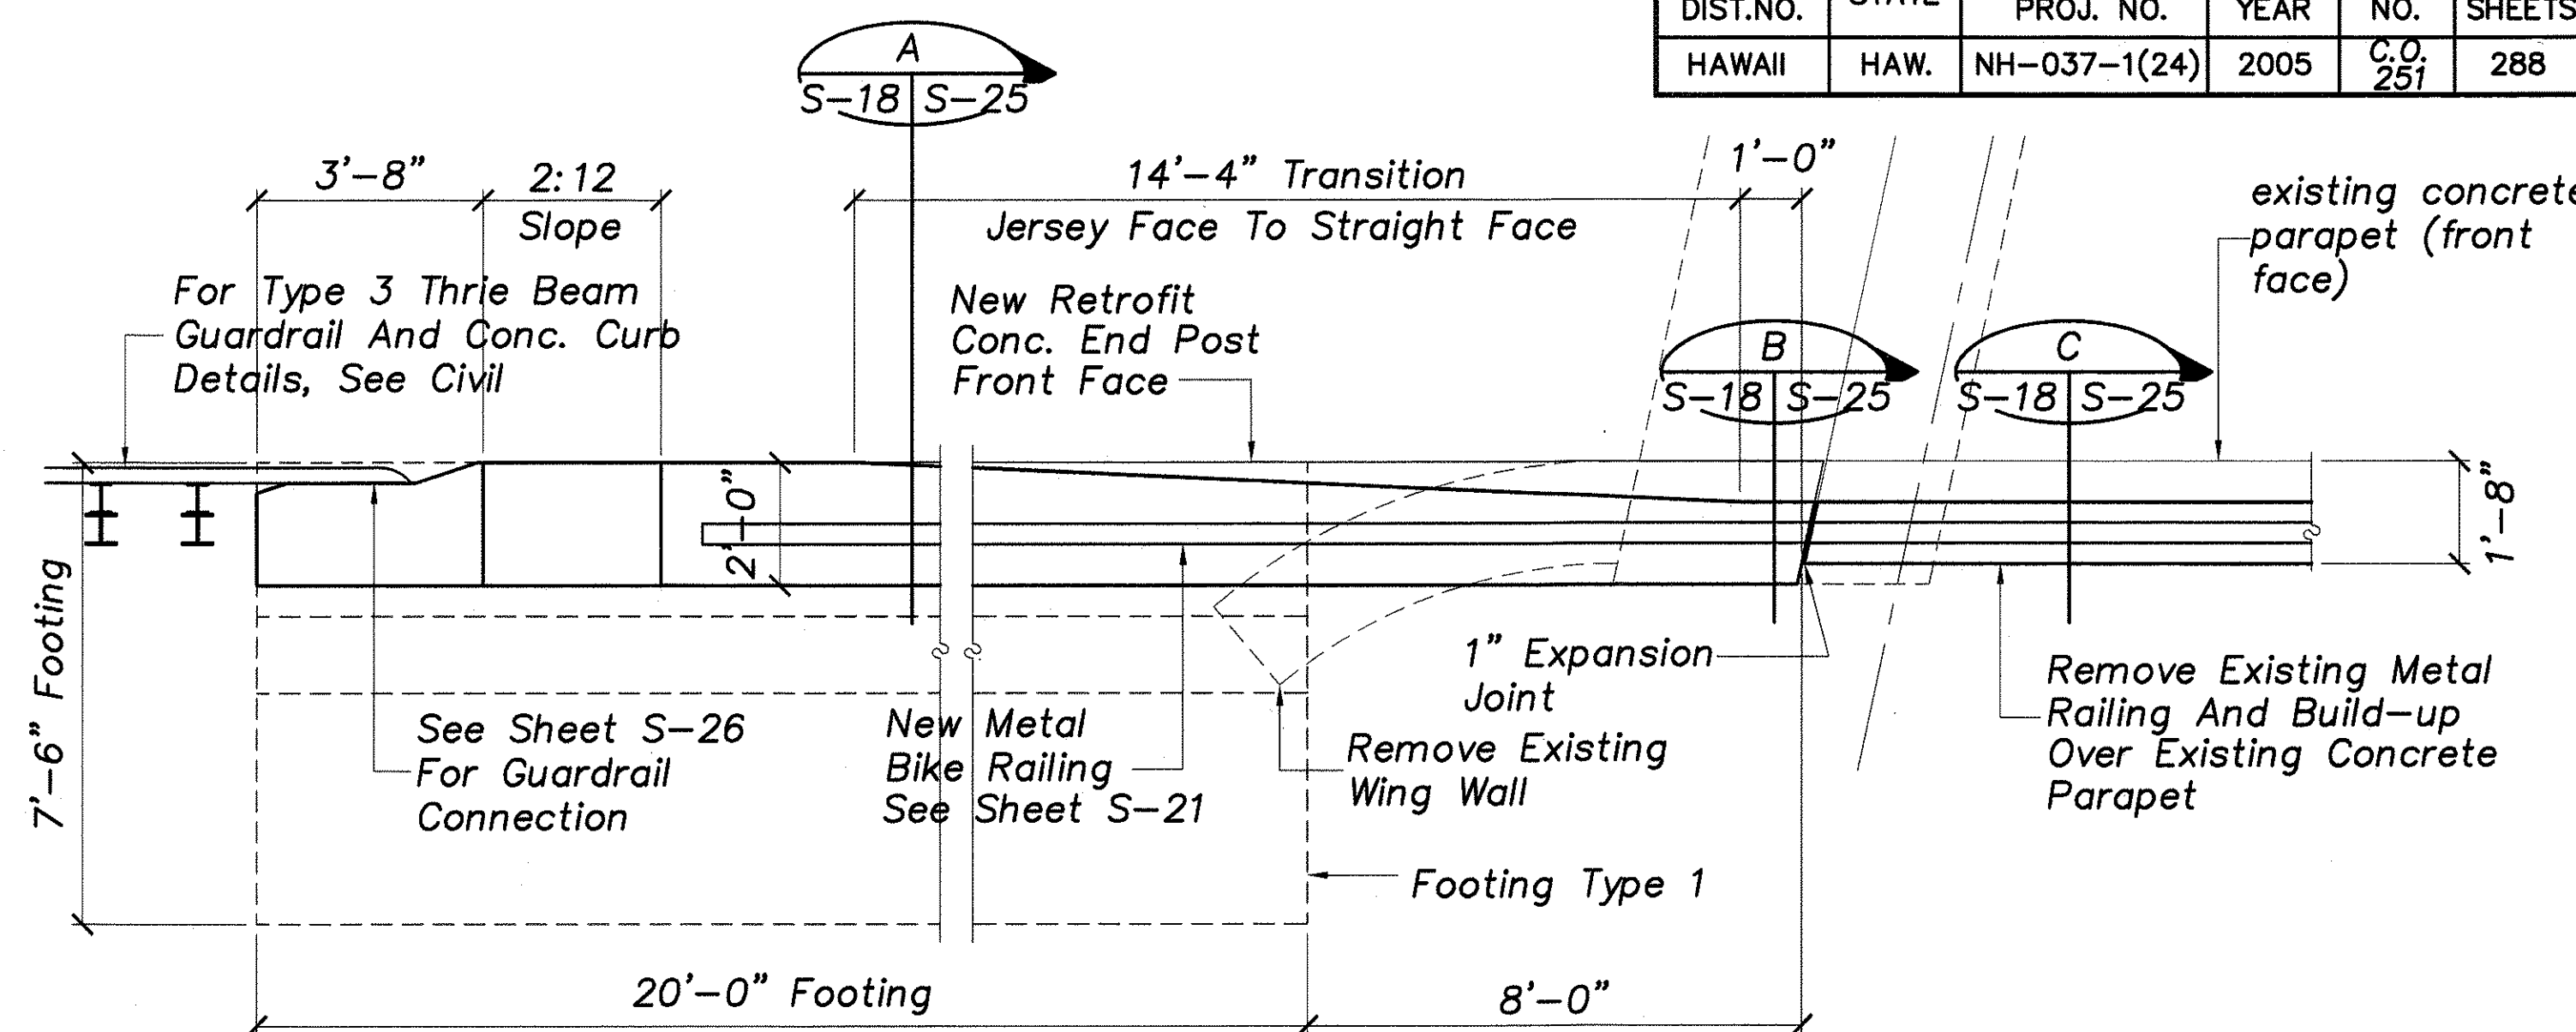


CONCRETE END POST PLAN
 Scale: 3/8"=1'-0"

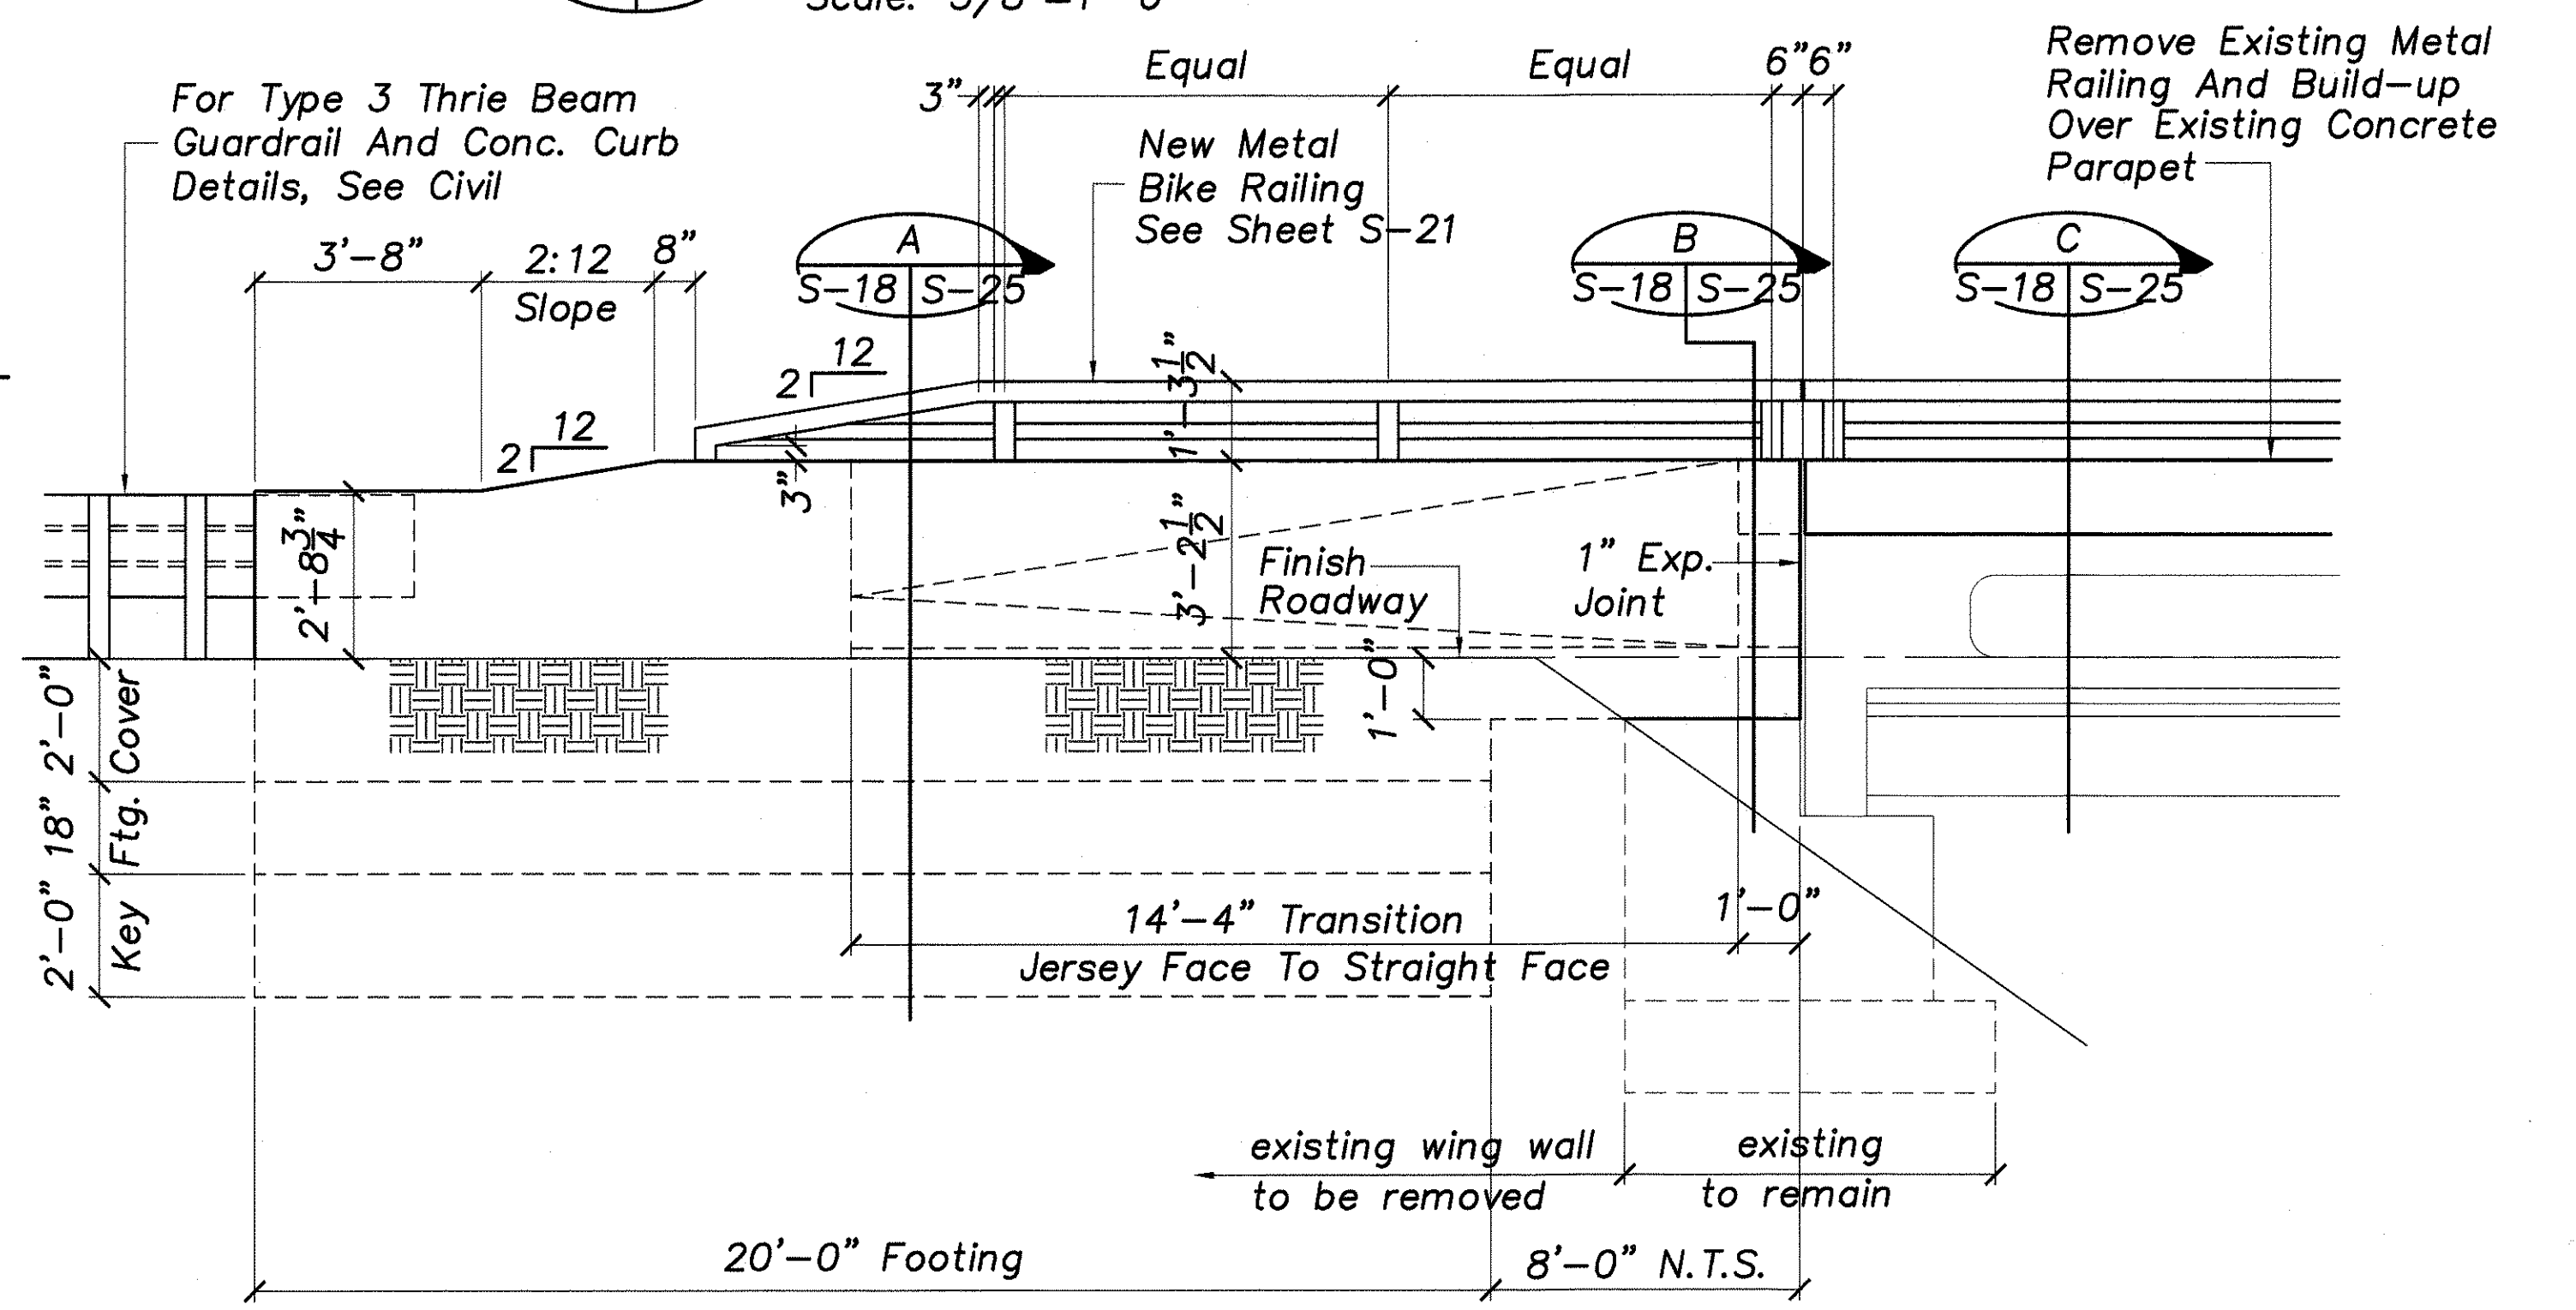

CONCRETE END POST ELEVATION
 Scale: 3/8"=1'-0"

DATE	BY

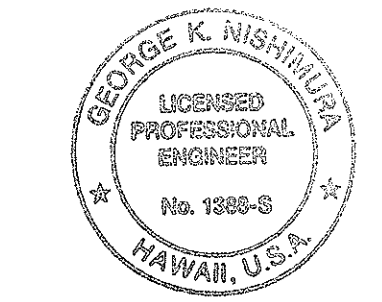


Date	Revision
7/2/07	Revised New Retrofit Concrete End Post

STATE OF HAWAII
 DEPARTMENT OF TRANSPORTATION
 HIGHWAYS DIVISION
EXISTING WATERWAY STRUCTURE NO. 3
LAYOUT PLAN


HALEAKALA HIGHWAY WIDENING, PHASE 2
HANA HIGHWAY TO PUKALANI BYPASS
FED. AID PROJ. NO. NH-037-1(24)

SCALE: AS NOTED DATE: MAY 2005
 SHEET No. S-18 OF 26 SHEETS

FED. ROAD DIST. NO.	STATE	FED. AID PROJ. NO.	FISCAL YEAR	SHEET NO.	TOTAL SHEETS
HAWAII	HAW.	NH-037-1(24)	2005	253	288

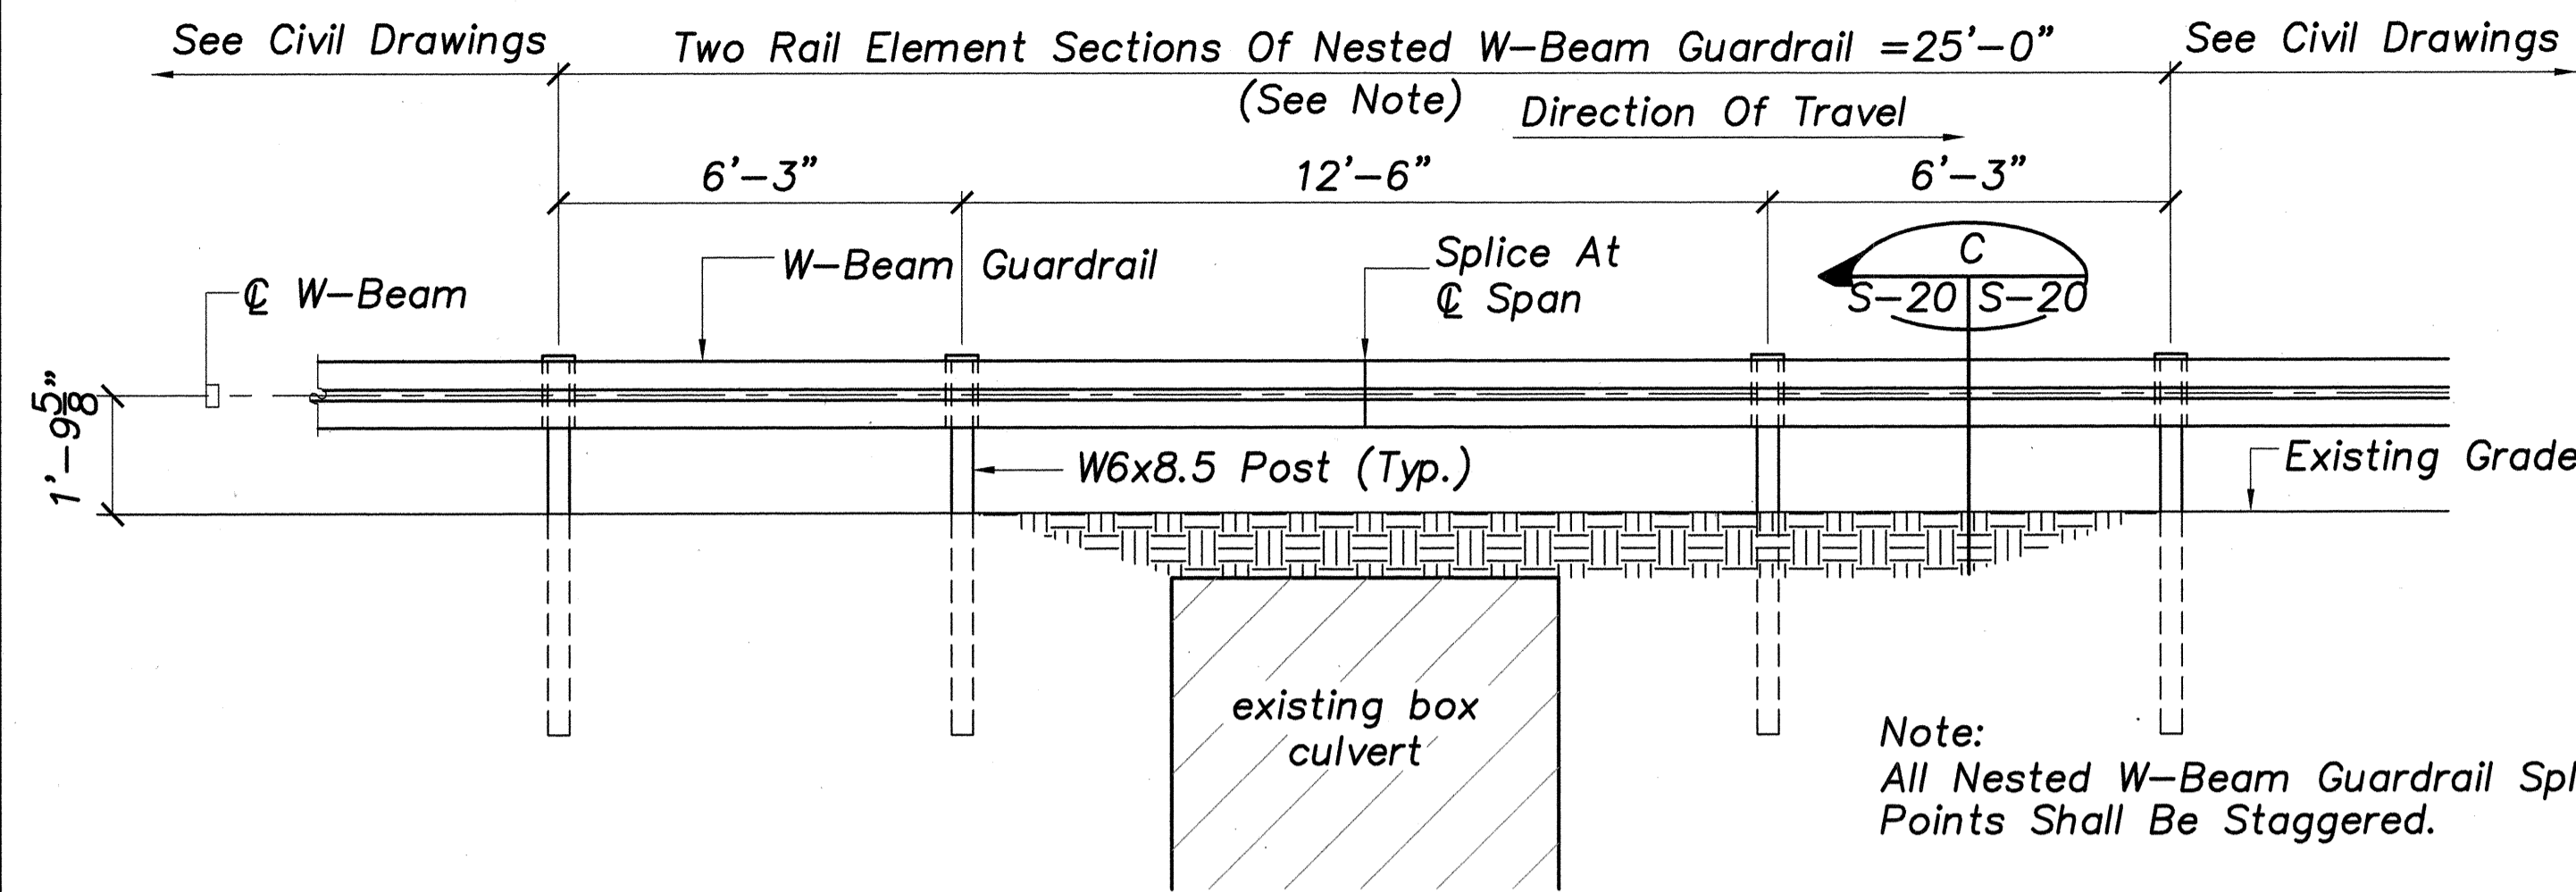


GUARDRAIL TYPE "B" ELEVATION
Scale: 3/8"=1'-0"

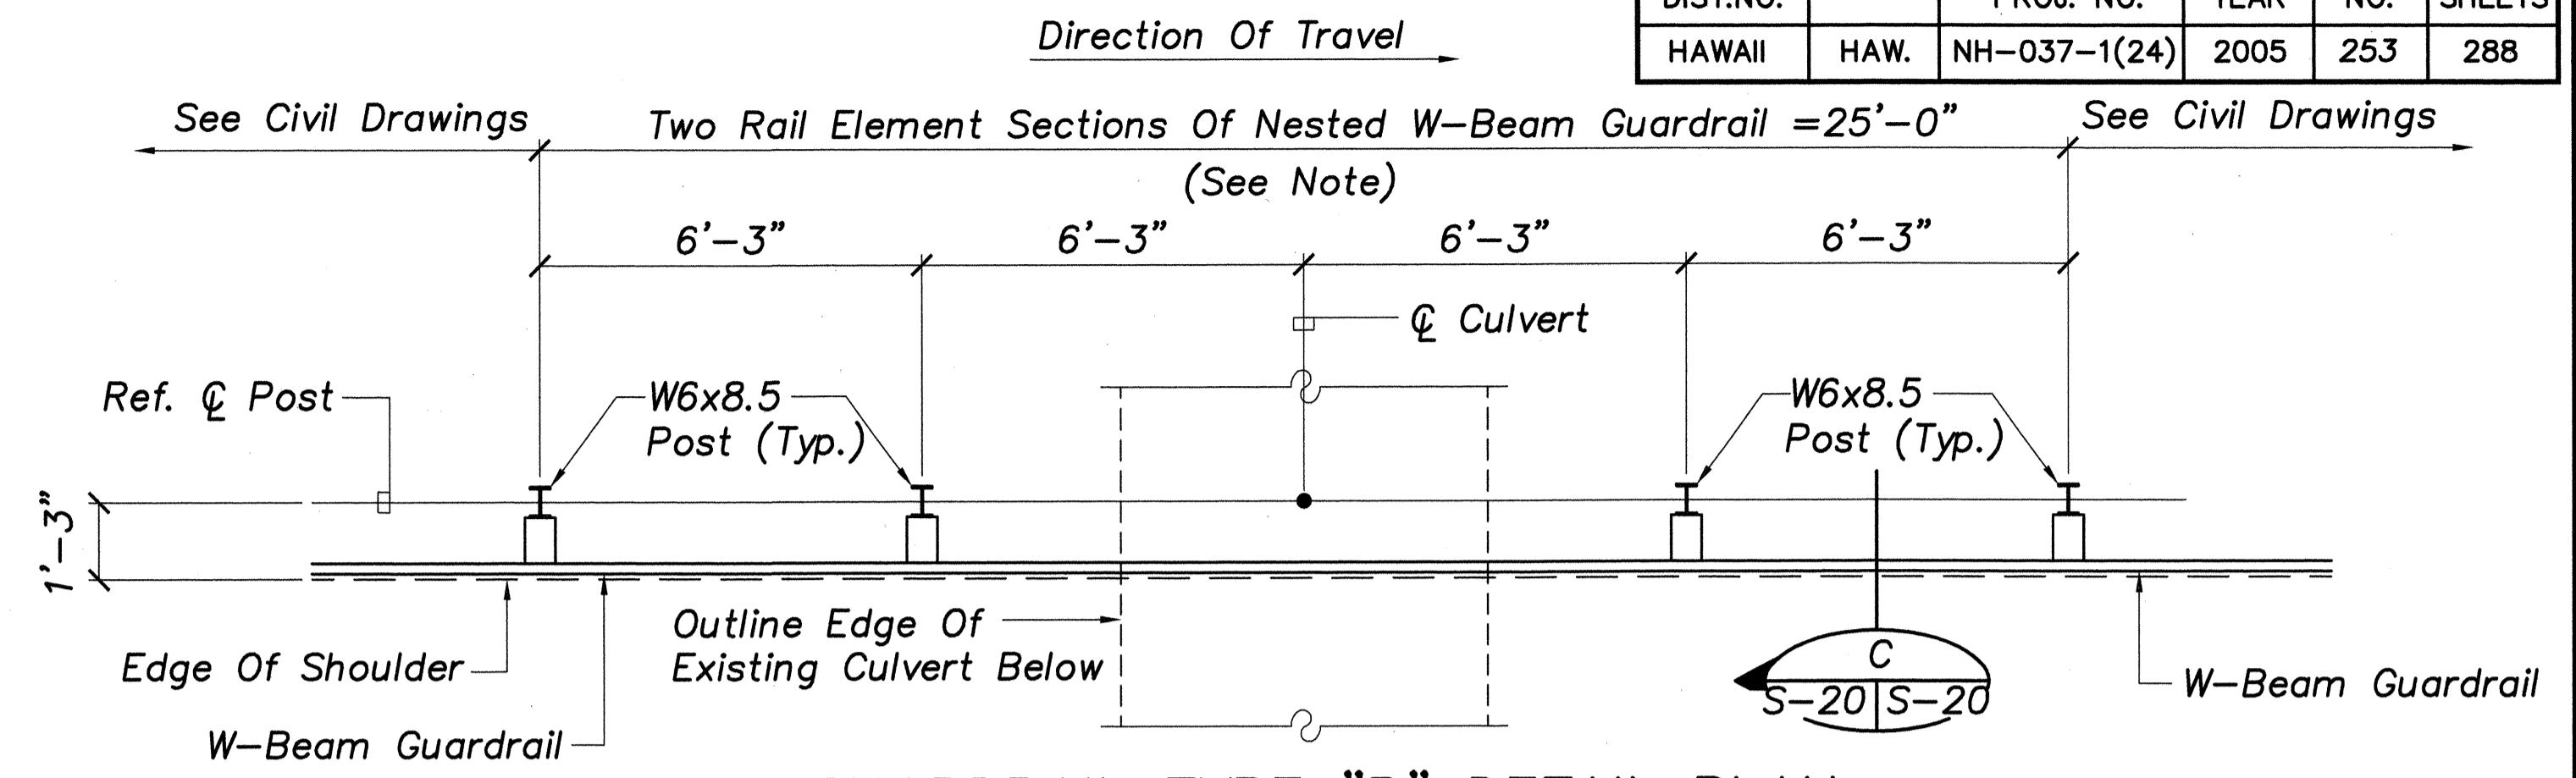


GUARDRAIL TYPE "B" DETAIL PLAN
Scale: 3/8"=1'-0"


GUARDRAIL TYPE "B" DETAIL
Scale As Noted

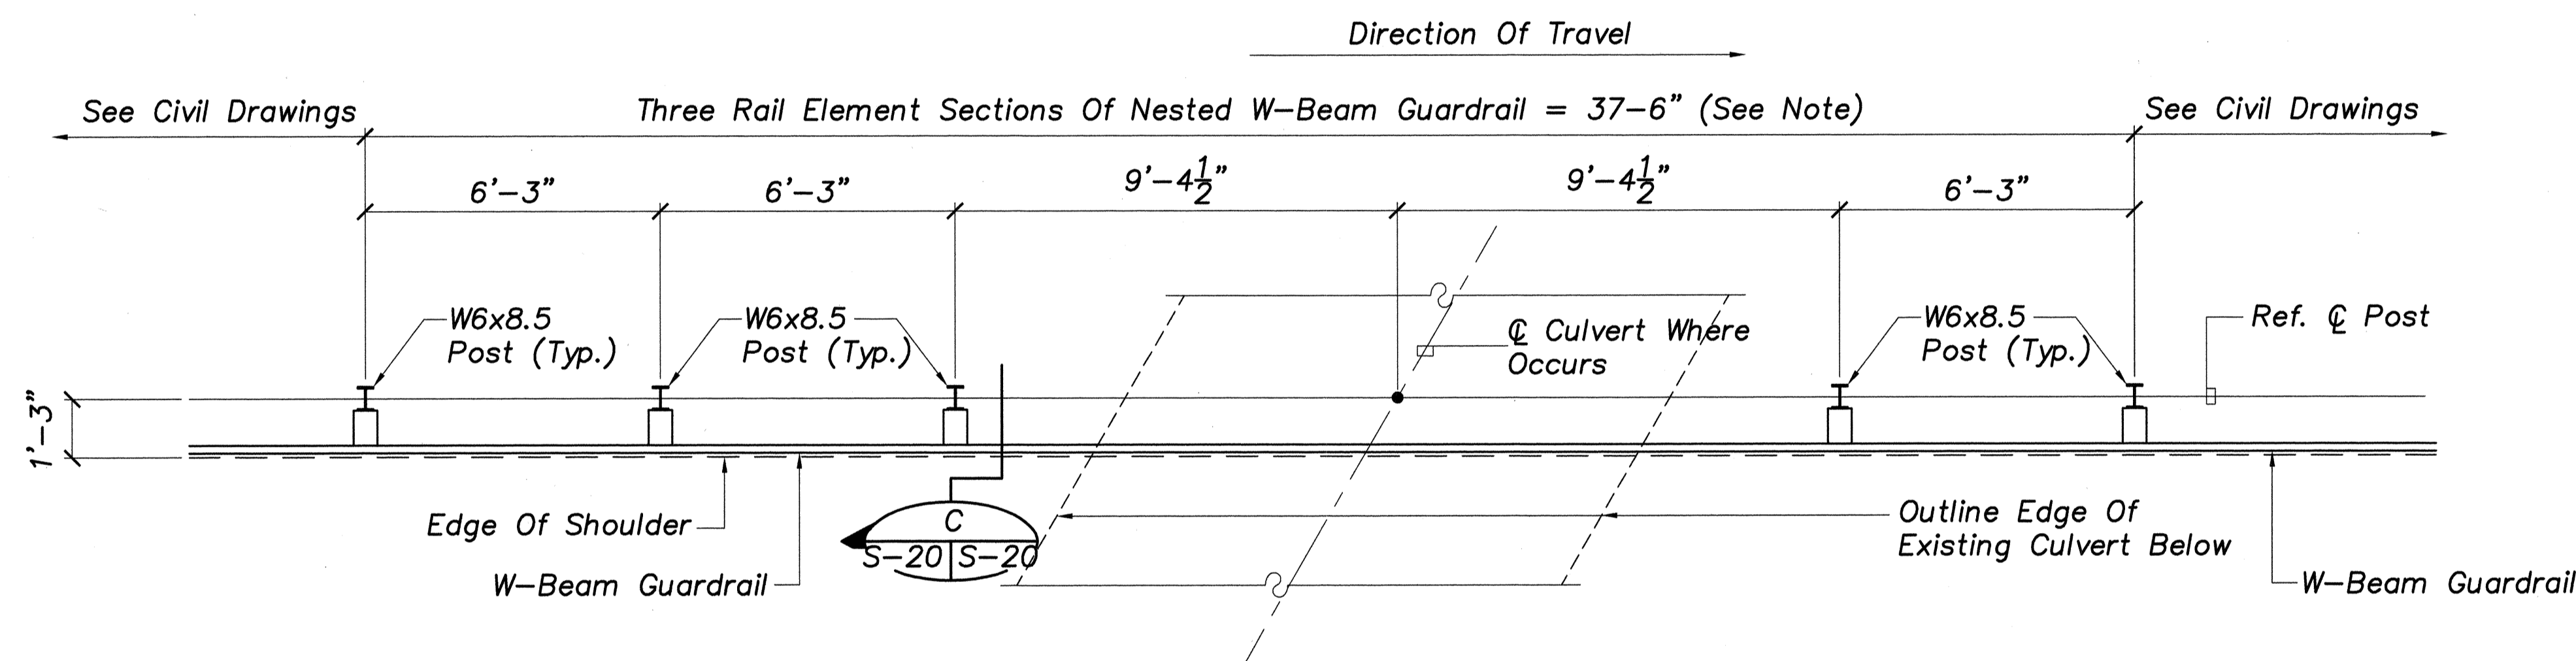

GUARDRAIL TYPE "A" DETAIL PLAN
Scale: 3/8"=1'-0"

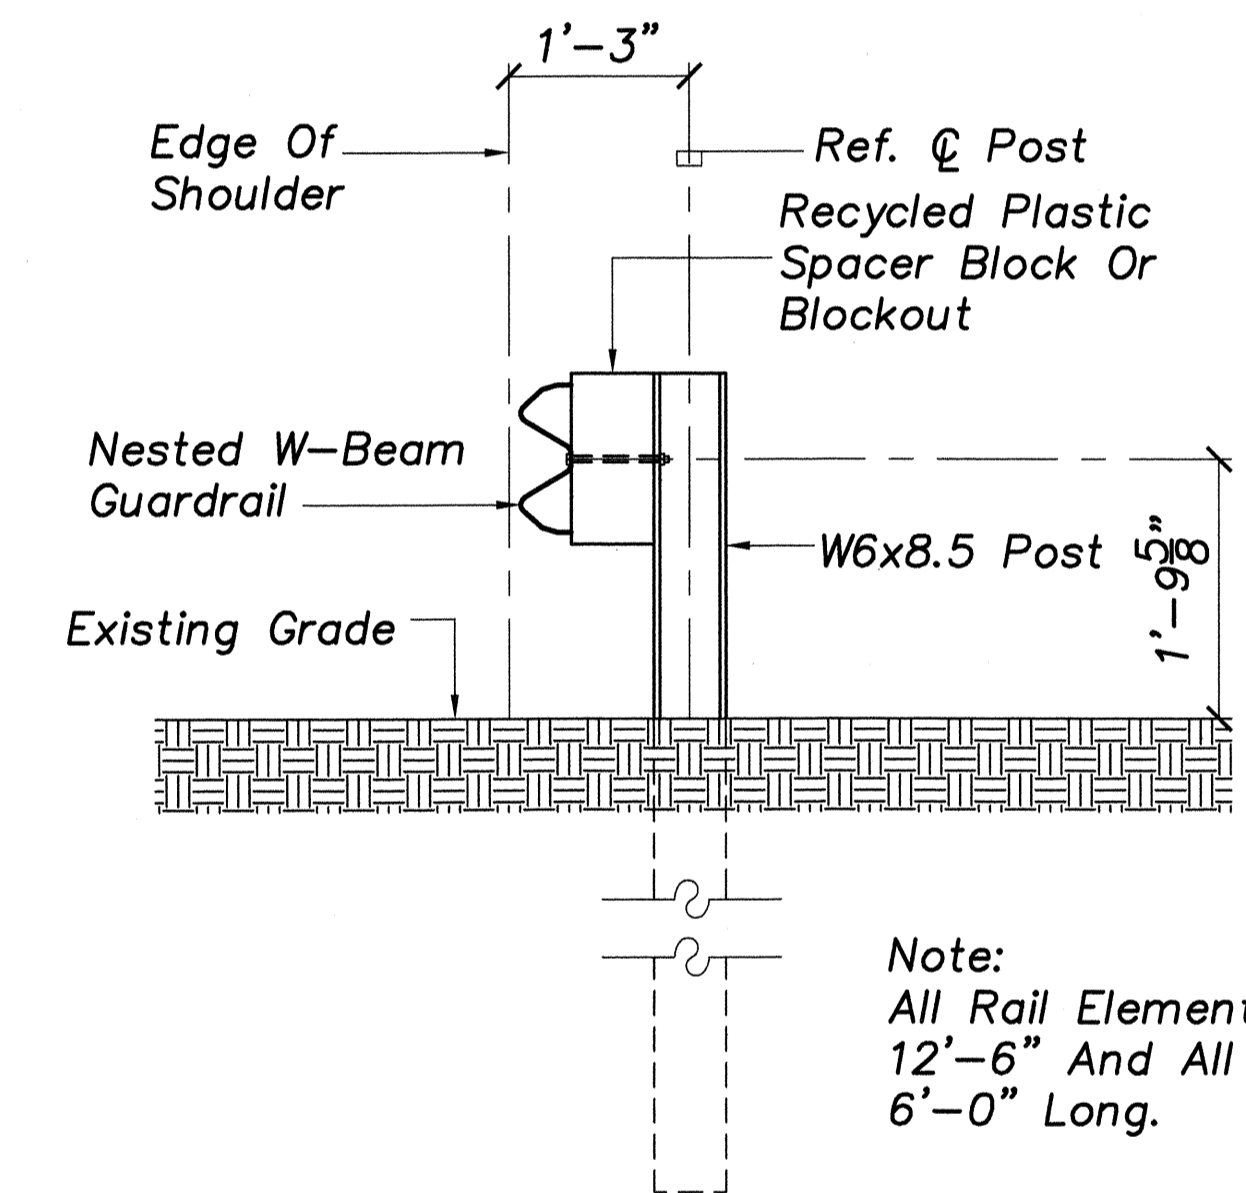


SECTION
Scale: 3/4"=1'-0"

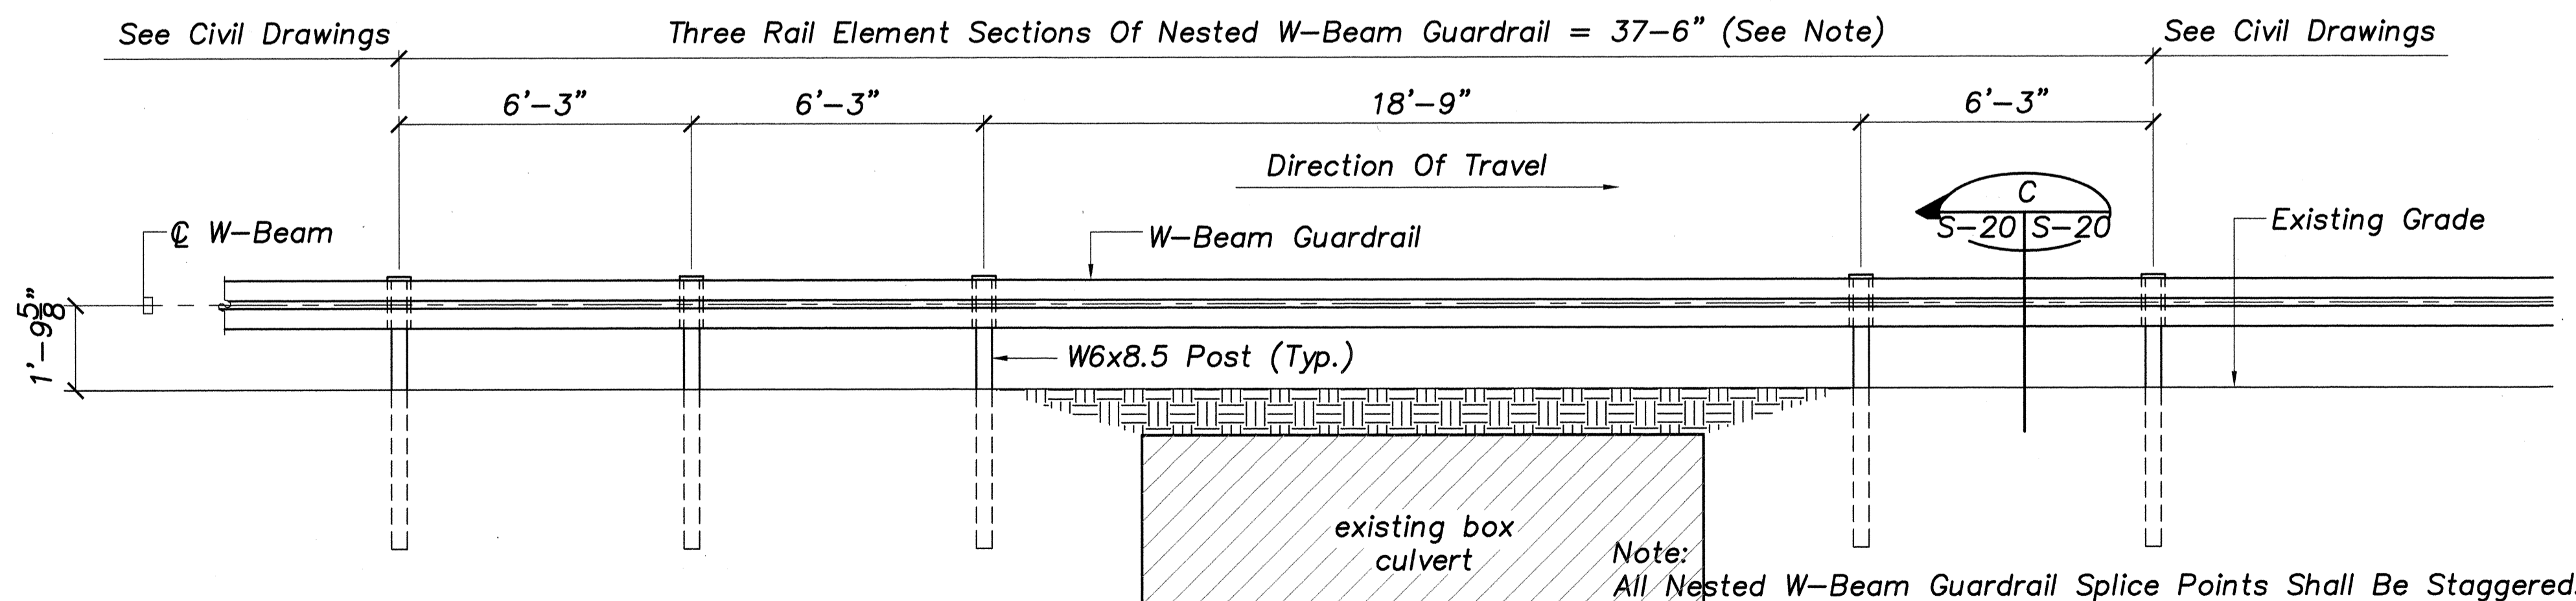

GUARDRAIL TYPE "A" ELEVATION
Scale: 3/8"=1'-0"

GUARDRAIL TYPE "A" DETAIL
Scale As Noted



DATE	_____
DESIGNED BY	_____
CHECKED BY	_____
DRAWN BY	_____
TRACED BY	_____
NOTED BY	_____
ORIGINAL PLAN	_____
NOTE BOOK	_____
No.	_____

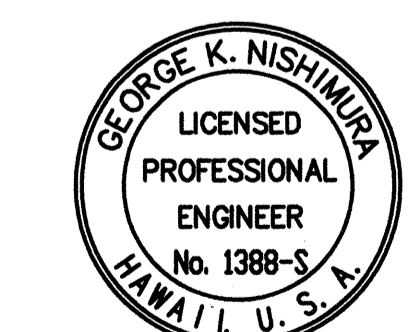



THIS WORK WAS PREPARED BY ME OR UNDER MY SUPERVISION.
SIGNATURE
04/30/06
EXPIRATION DATE OF PROFESSIONAL LICENSE

STATE OF HAWAII
DEPARTMENT OF TRANSPORTATION
HIGHWAYS DIVISION
GUARDRAIL TYPE "A" AND TYPE "B" DETAIL
HALEAKALA HIGHWAY WIDENING, PHASE 2
HANA HIGHWAY TO PUKALANI BYPASS
FED. AID PROJ. NO. NH-037-1(24)
SCALE: AS NOTED DATE: MAY 2005
SHEET No. S-20 OF 26 SHEETS

FED. ROAD DIST. NO.	STATE	FED. AID PROJ. NO.	FISCAL YEAR	SHEET NO.	TOTAL SHEETS
HAWAII	HAW.	NH-037-1(24)	2005	C.O. 254	288

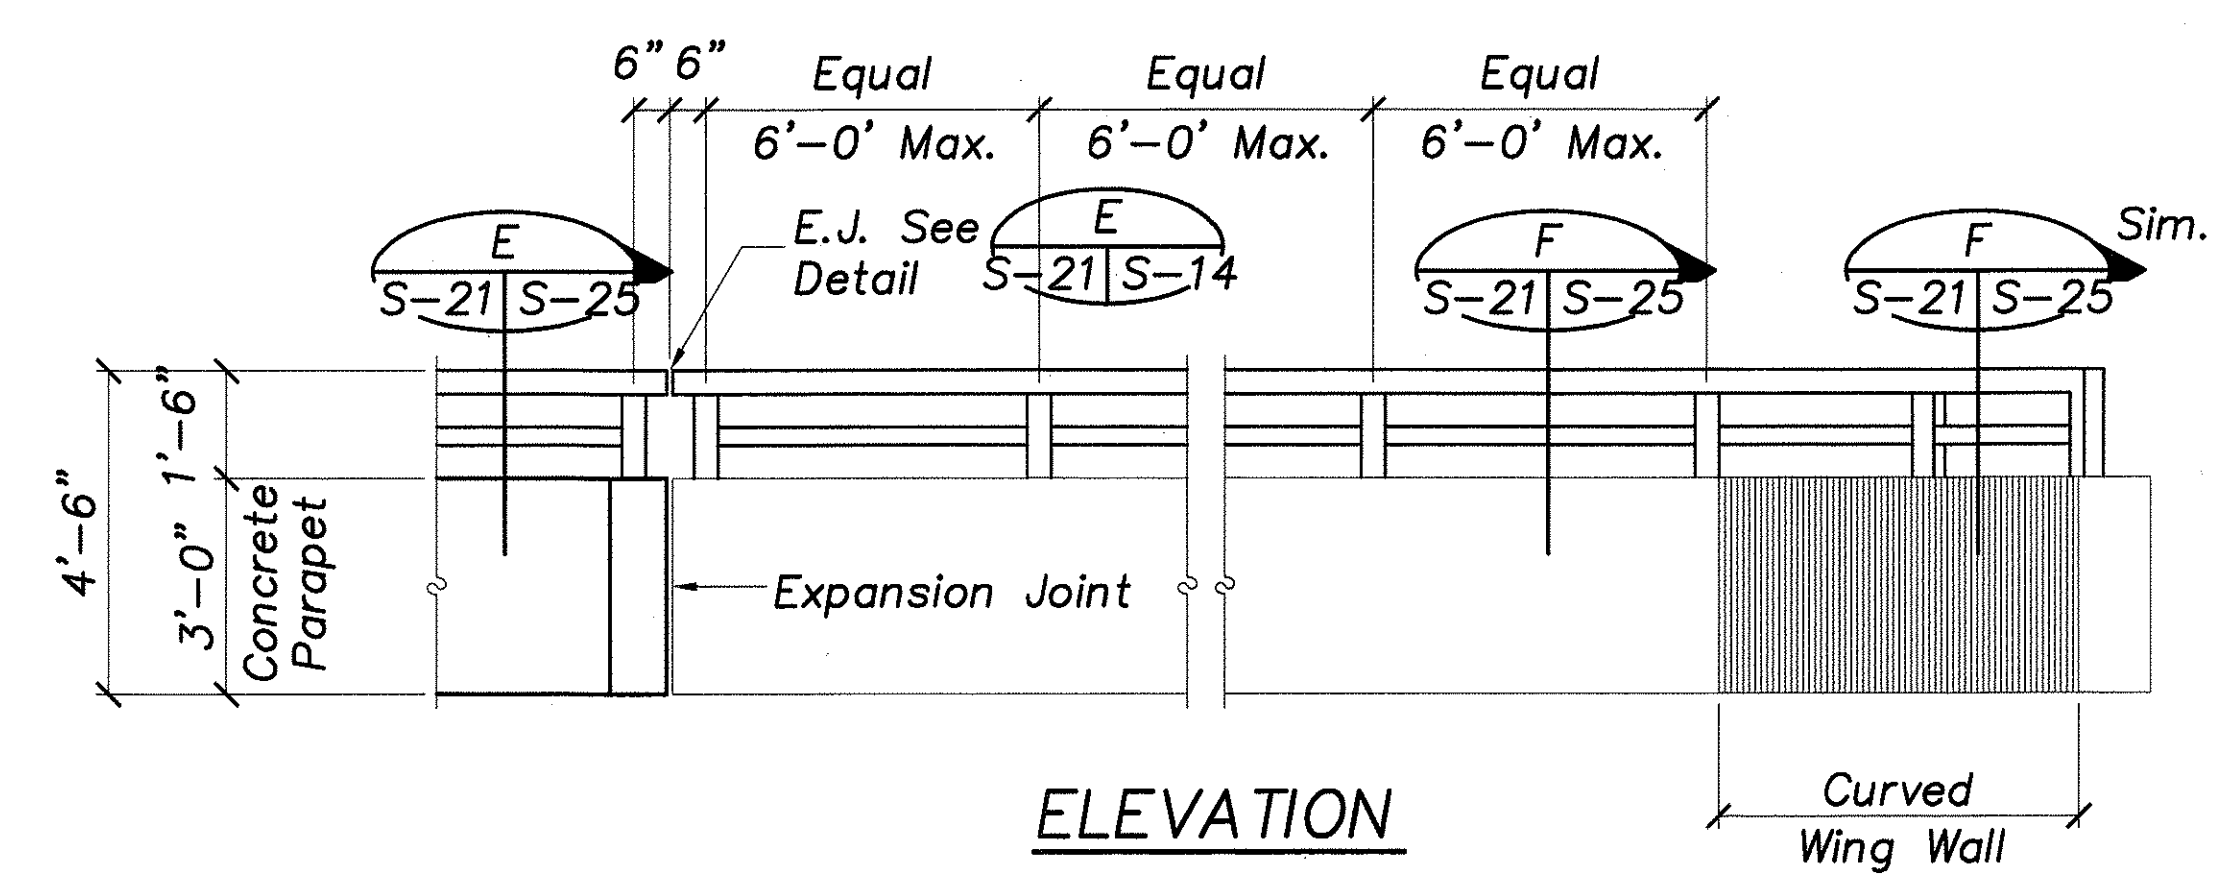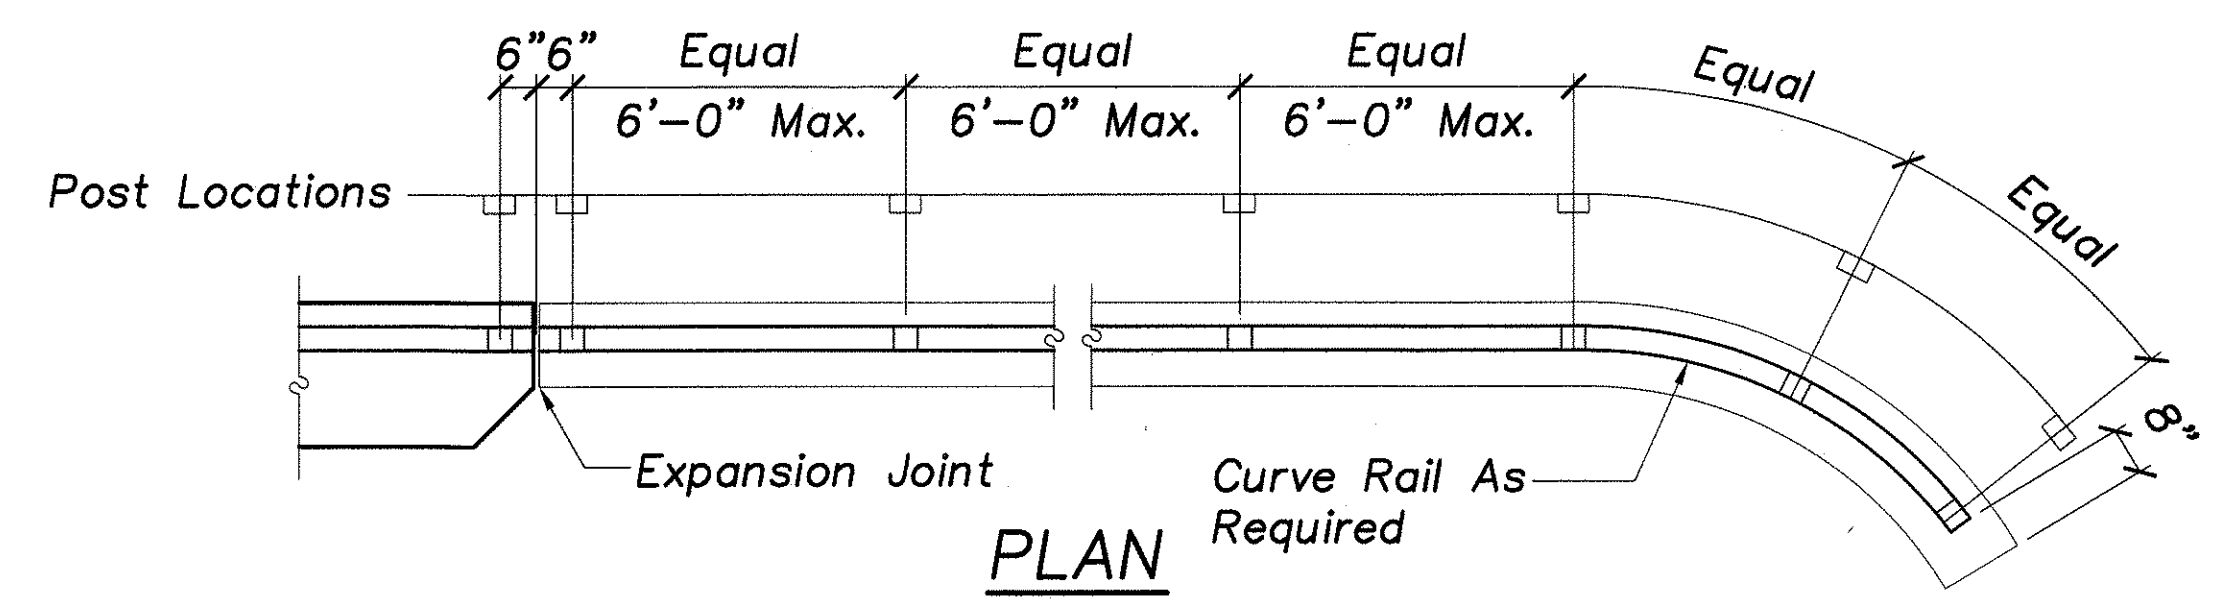


AT WATERWAY STRUCTURES NO. 1 AND 4

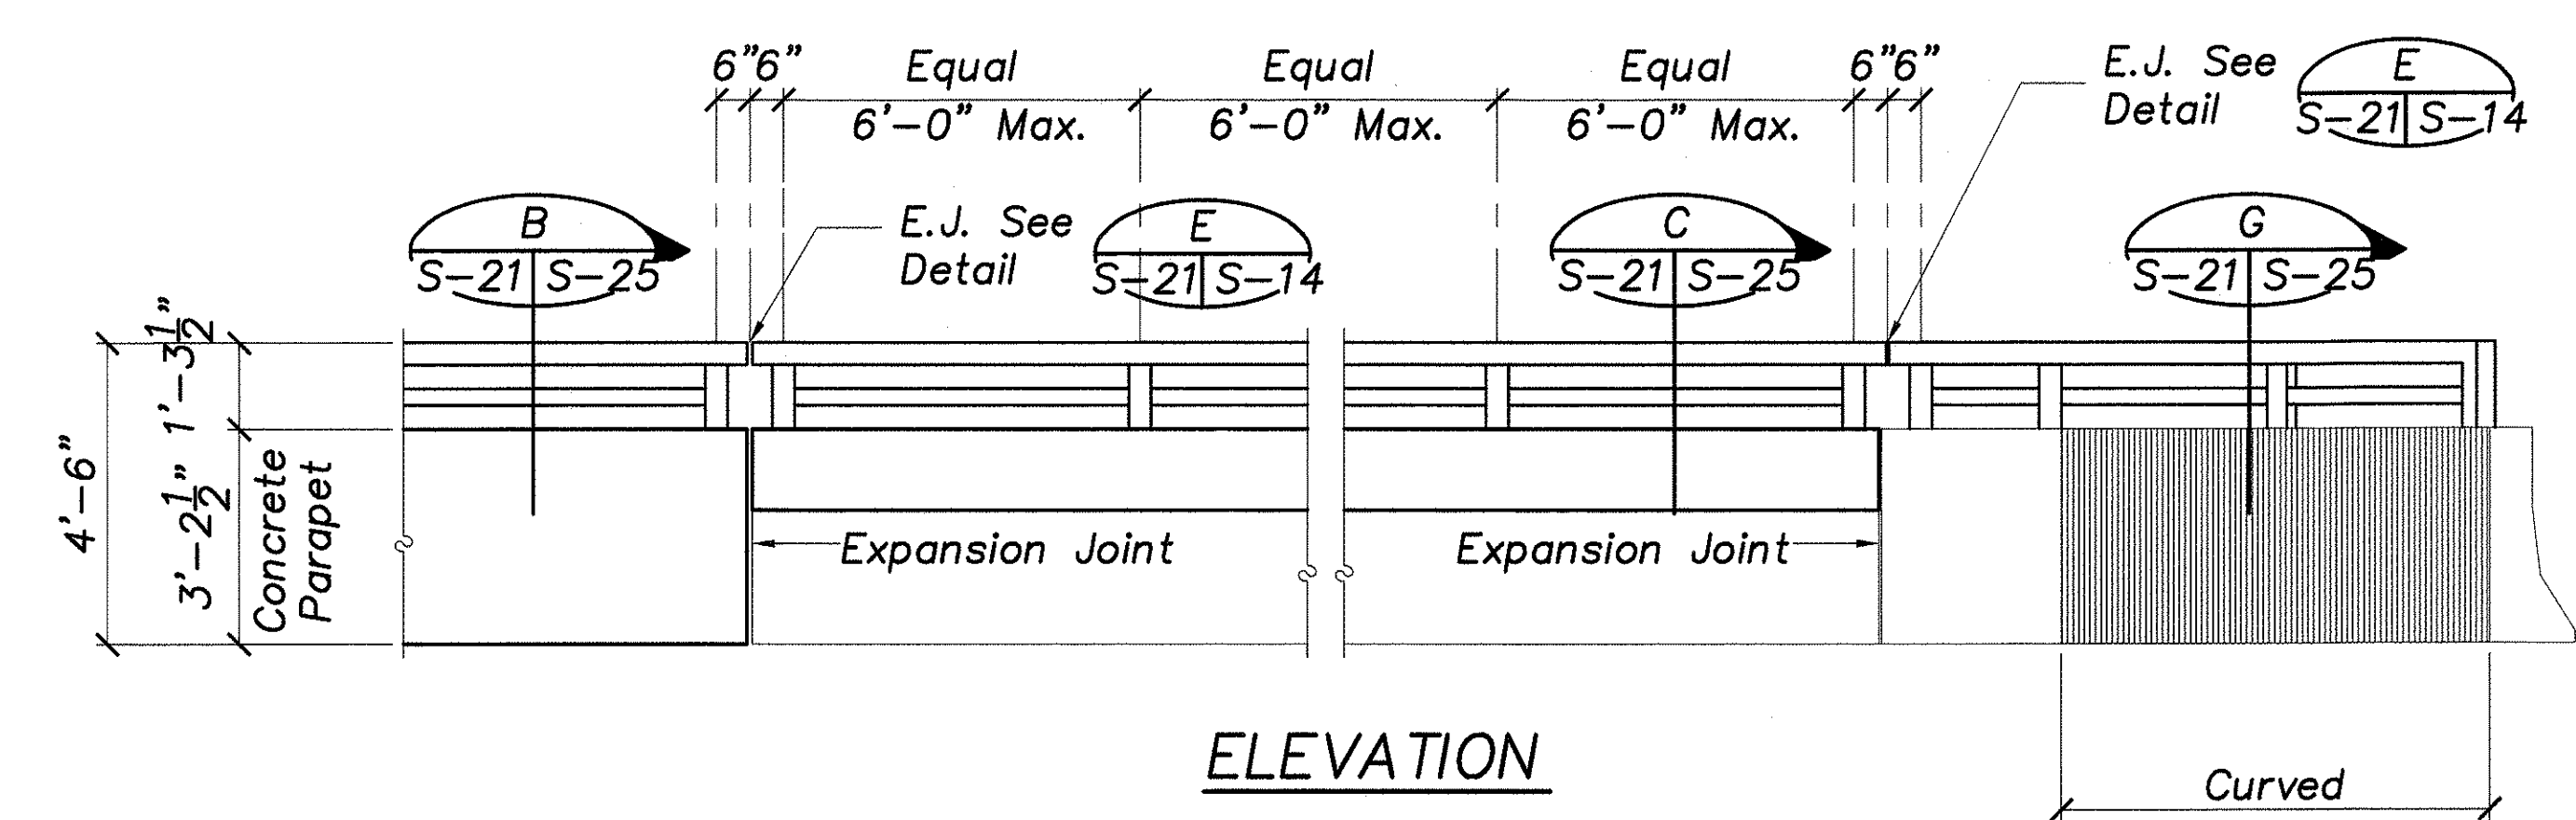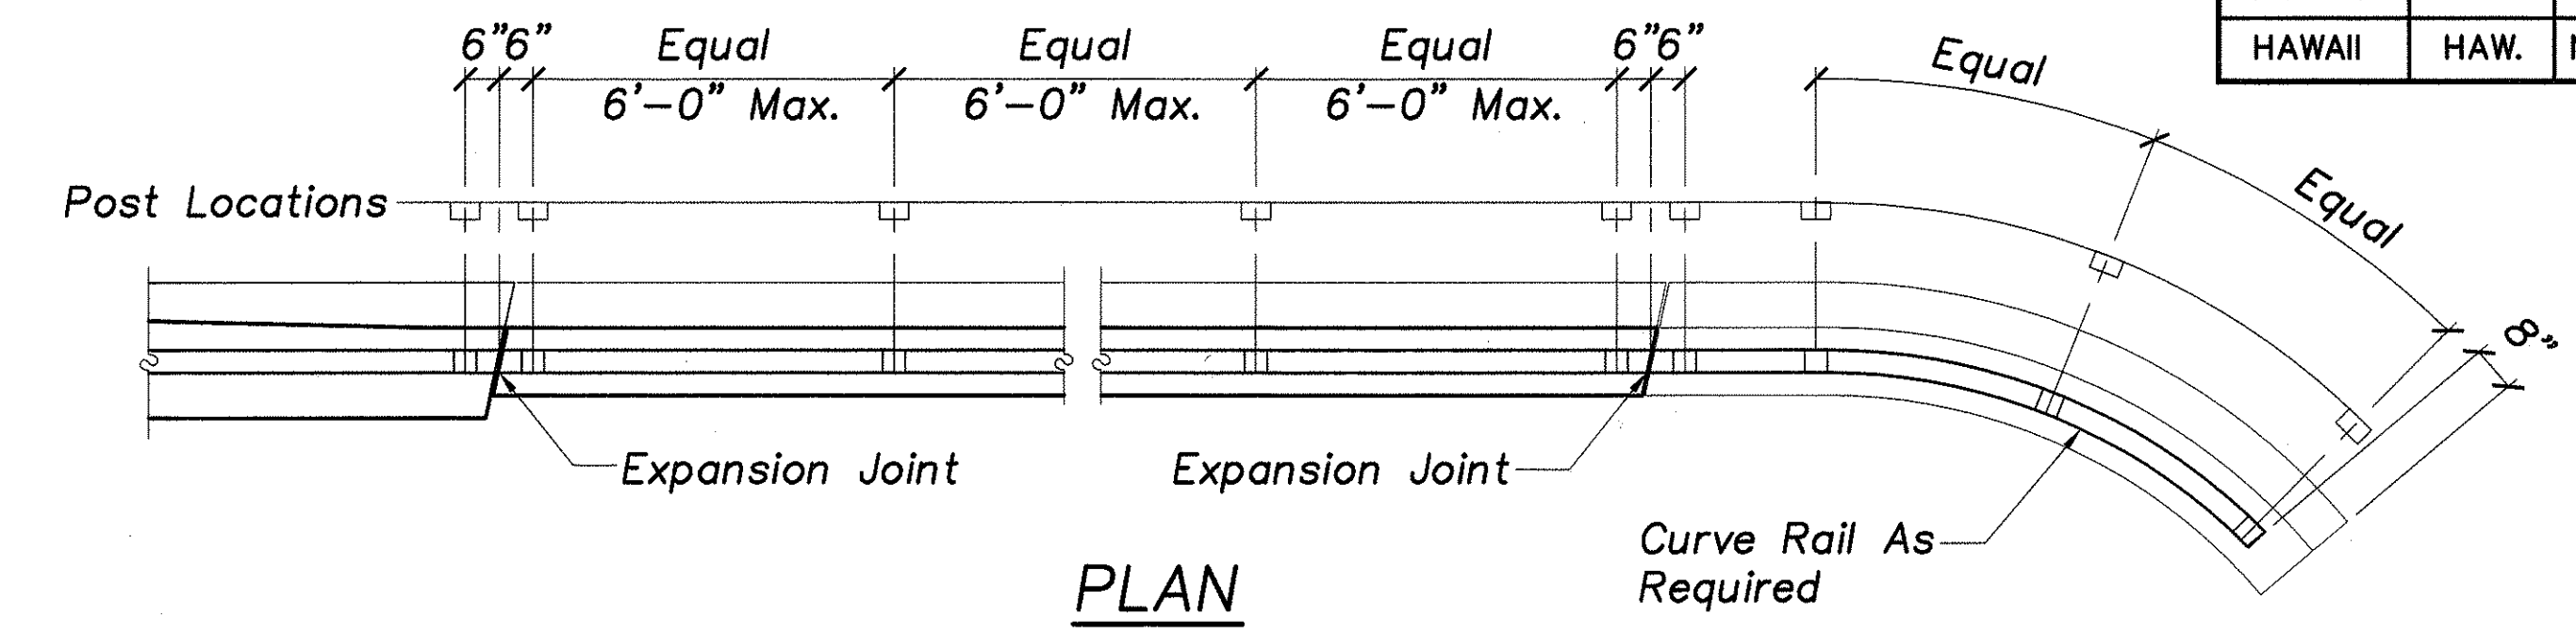

AT WATERWAY STRUCTURE NO. 3

METAL BIKE RAILING DETAIL

S-16, S-18, S-19, S-21 Scale As Noted
S-25

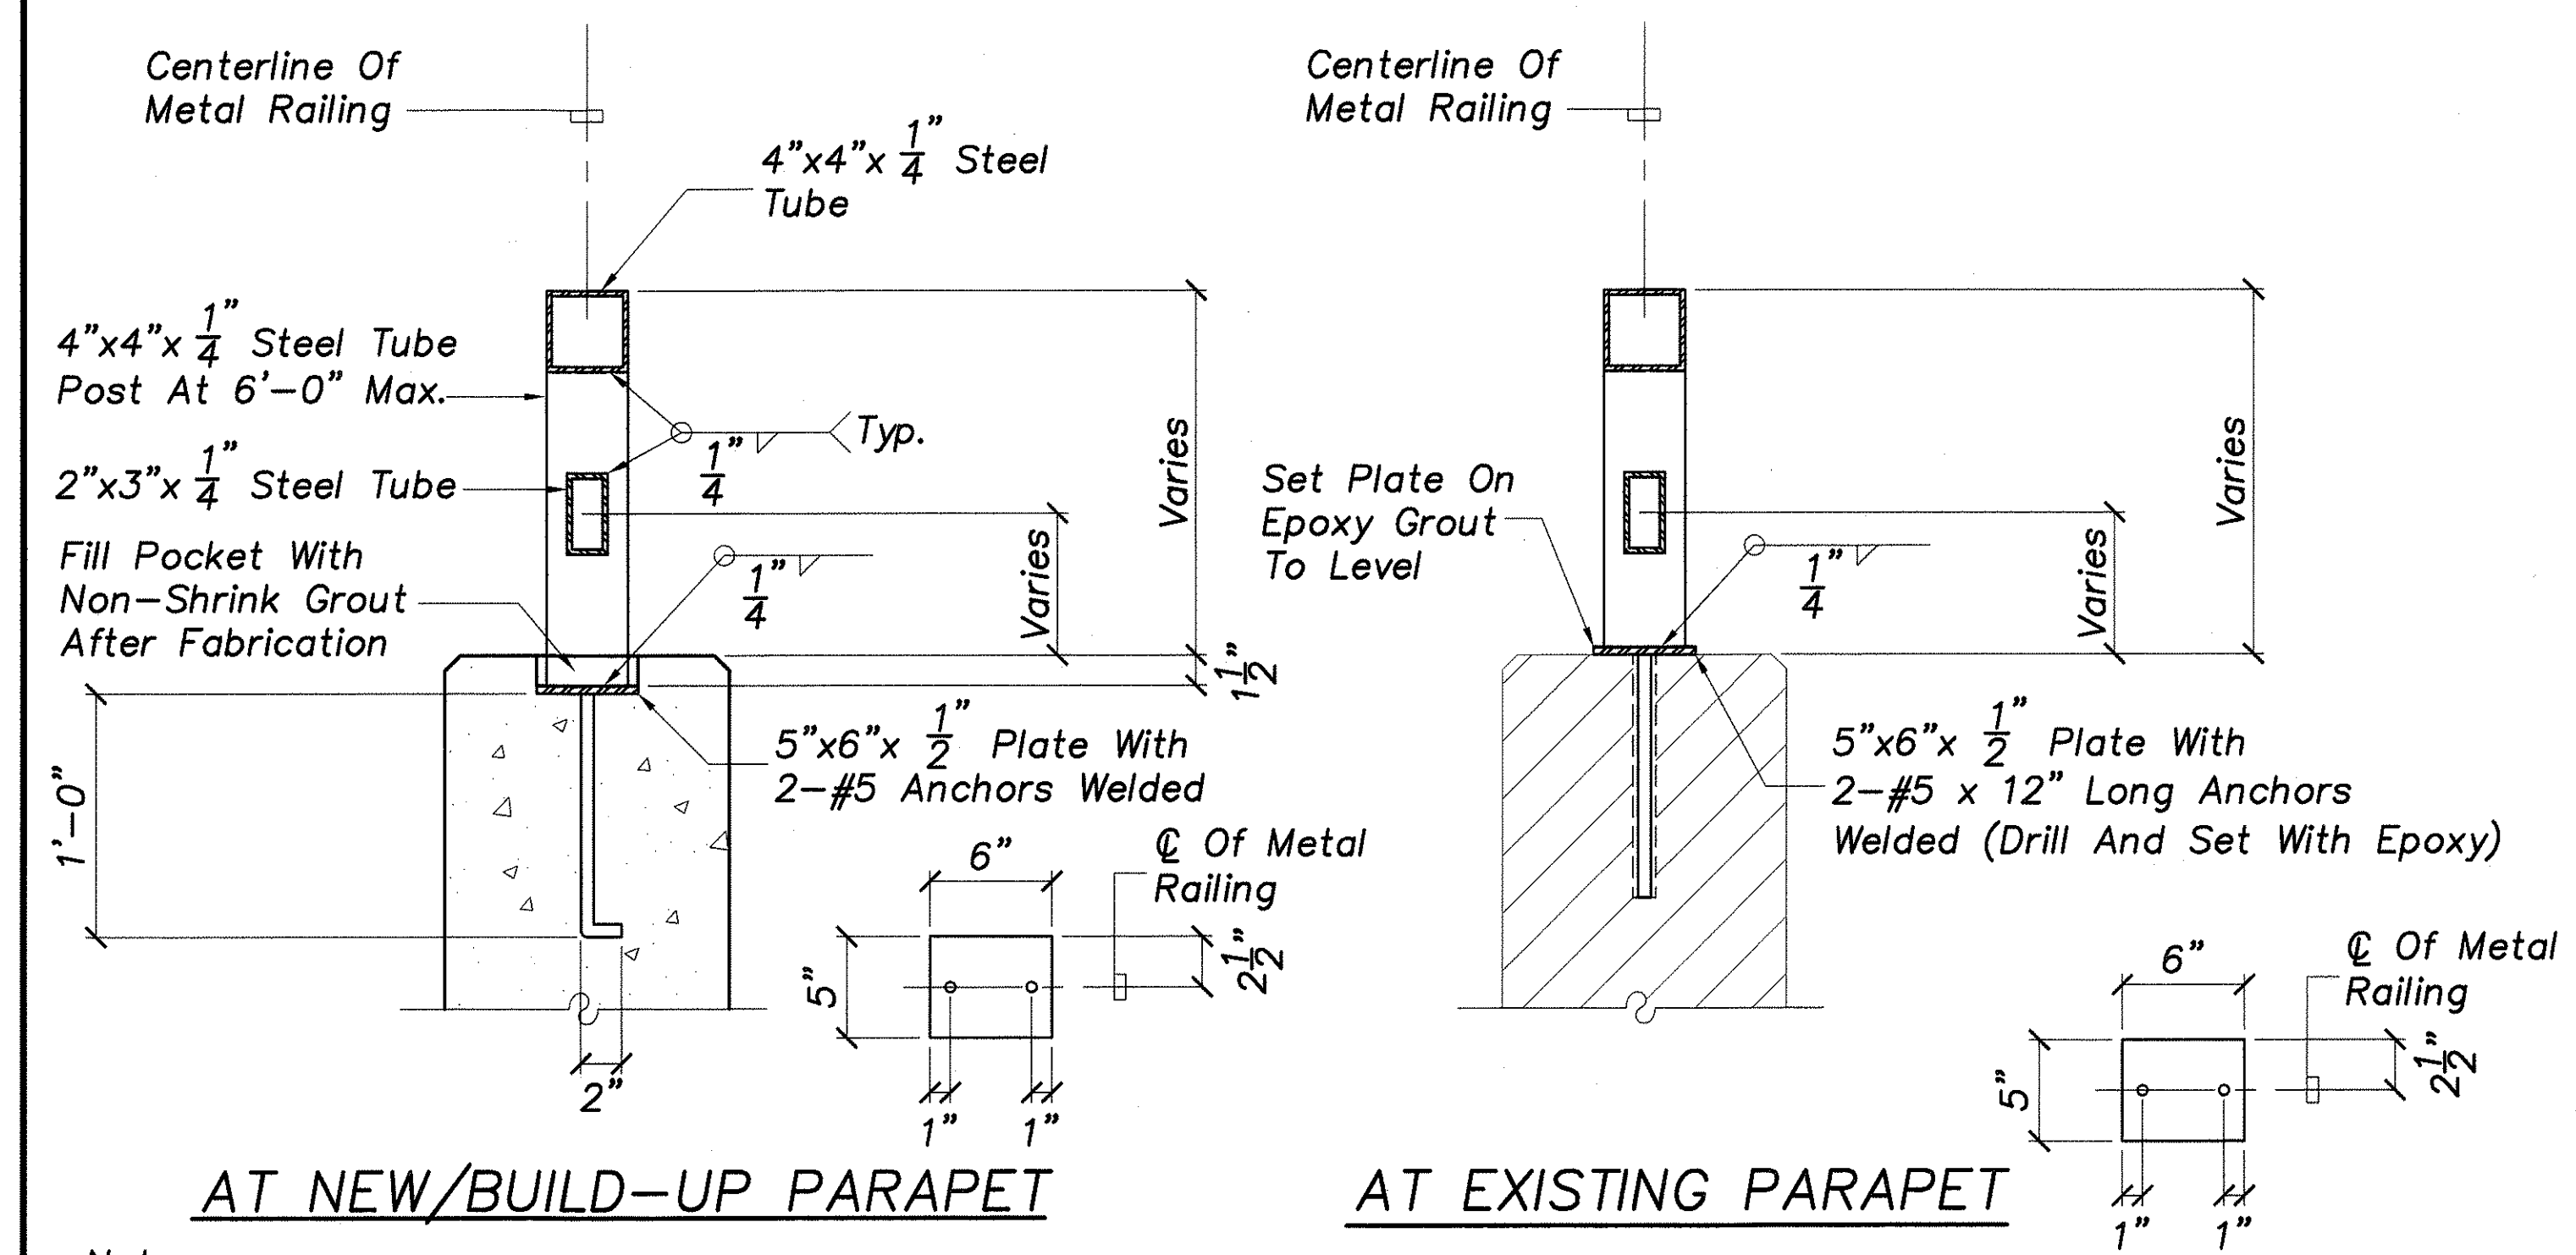


AT NEW/BUILD-UP PARAPET

AT EXISTING PARAPET


- Note:**
- Grind All Exposed Welded Joints On Metal Railing Smooth.
 - Metal Railing Assembly Shall Be Hot Dipped Galvanized After Fabrication.
 - Reinforcing Bars To Be Welded Shall Conform To ASTM A706, Grade 60.

BIKE RAILING SECTION

S-21, S-25 Scale: 1 1/2"=1'-0"

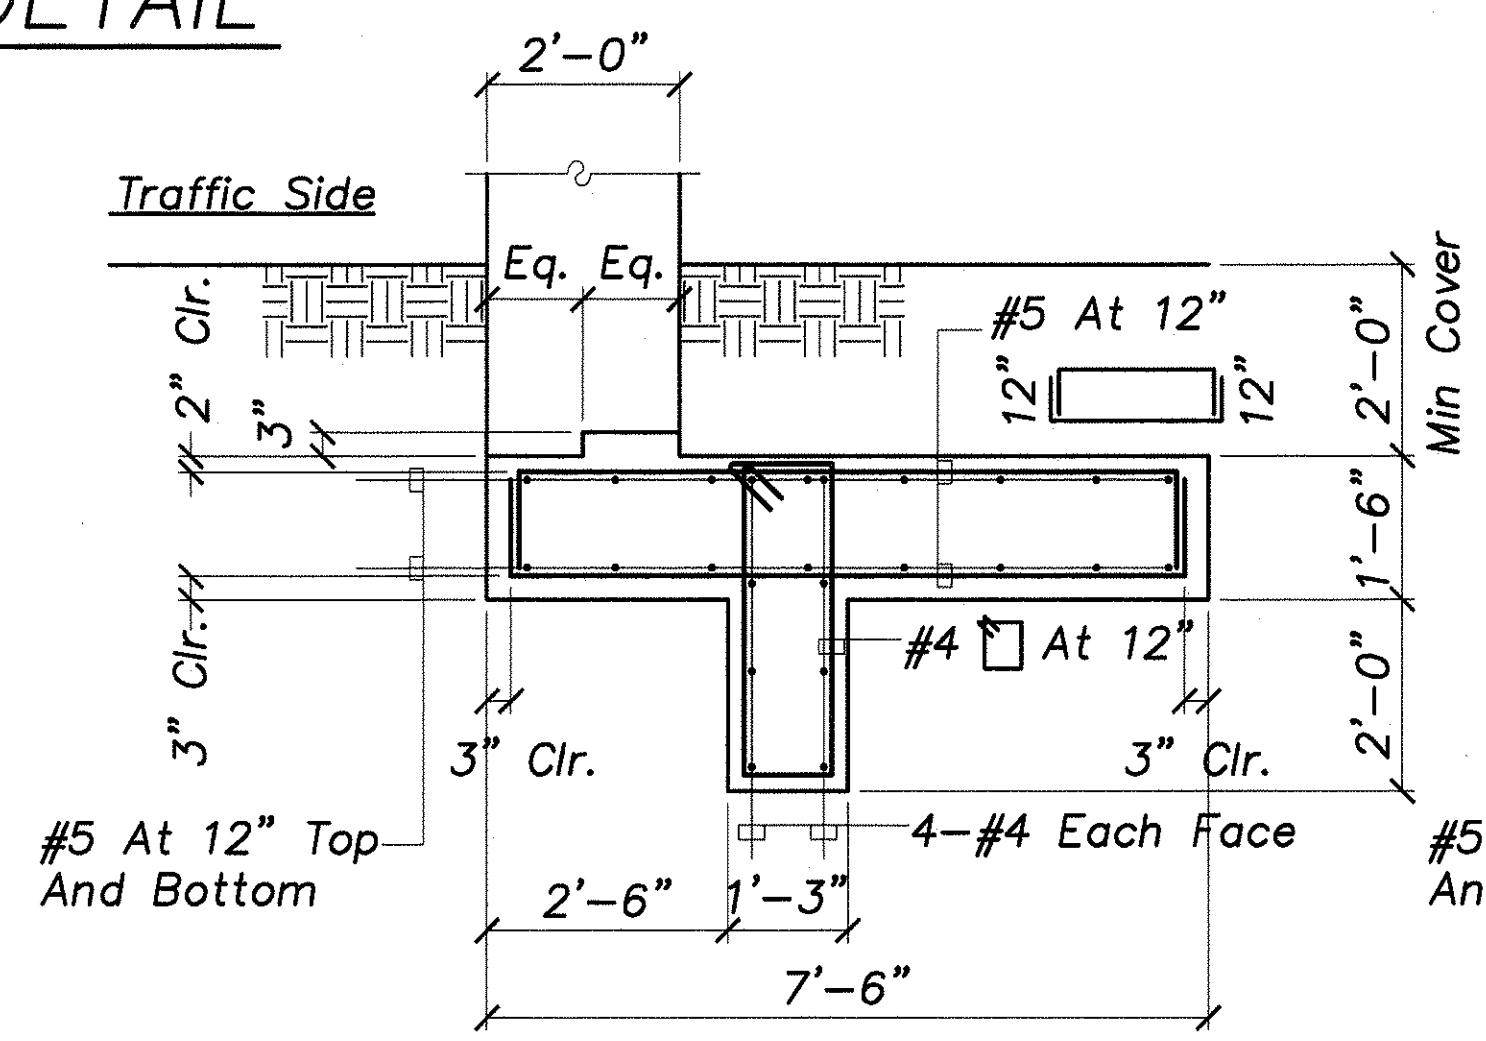


FOOTING TYPE 1
Scale: 1/2"=1'-0"

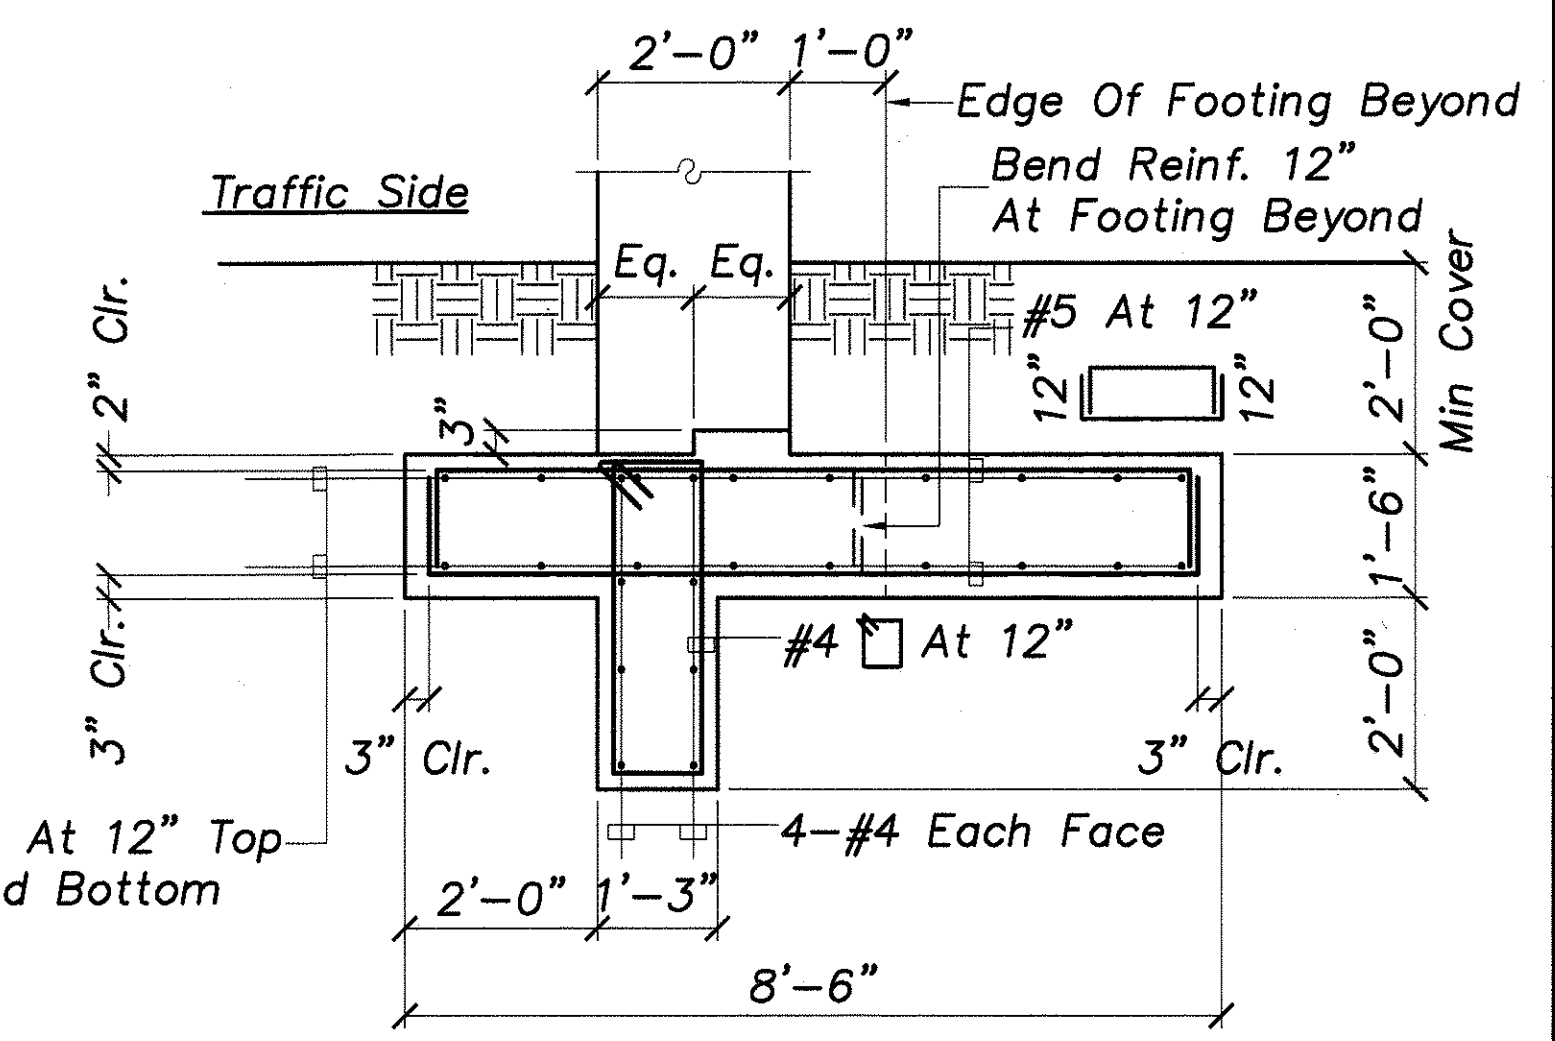

FOOTING TYPE 2
Scale: 1/2"=1'-0"


DATE	
SURVEY PLANNED BY	
DRAWN BY	
DESIGNED BY	
NOTED BY	
CHECKED BY	
NO.	

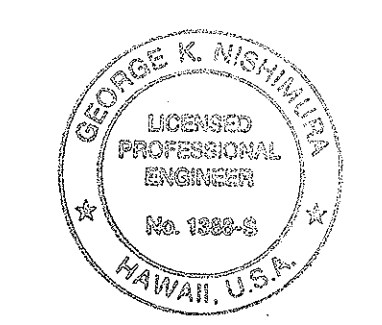

02/30/08
Expiration Date of Professional Engineer


7/2/07	Added Footing Details (Type 1 And Type 2)
Date	Revision
STATE OF HAWAII DEPARTMENT OF TRANSPORTATION HIGHWAYS DIVISION METAL BIKE RAILING DETAIL	
HALEAKALA HIGHWAY WIDENING, PHASE 2 HANA HIGHWAY TO PUKALANI BYPASS FED. AID PROJ. NO. NH-037-1(24)	
SCALE: AS NOTED	DATE: MAY 2005
SHEET No. S-21 OF 26 SHEETS	

FED. ROAD DIST. NO.	STATE	FED. AID PROJ. NO.	FISCAL YEAR	SHEET NO.	TOTAL SHEETS
HAWAII	HAW.	NH-037-1(24)	2005	255	288

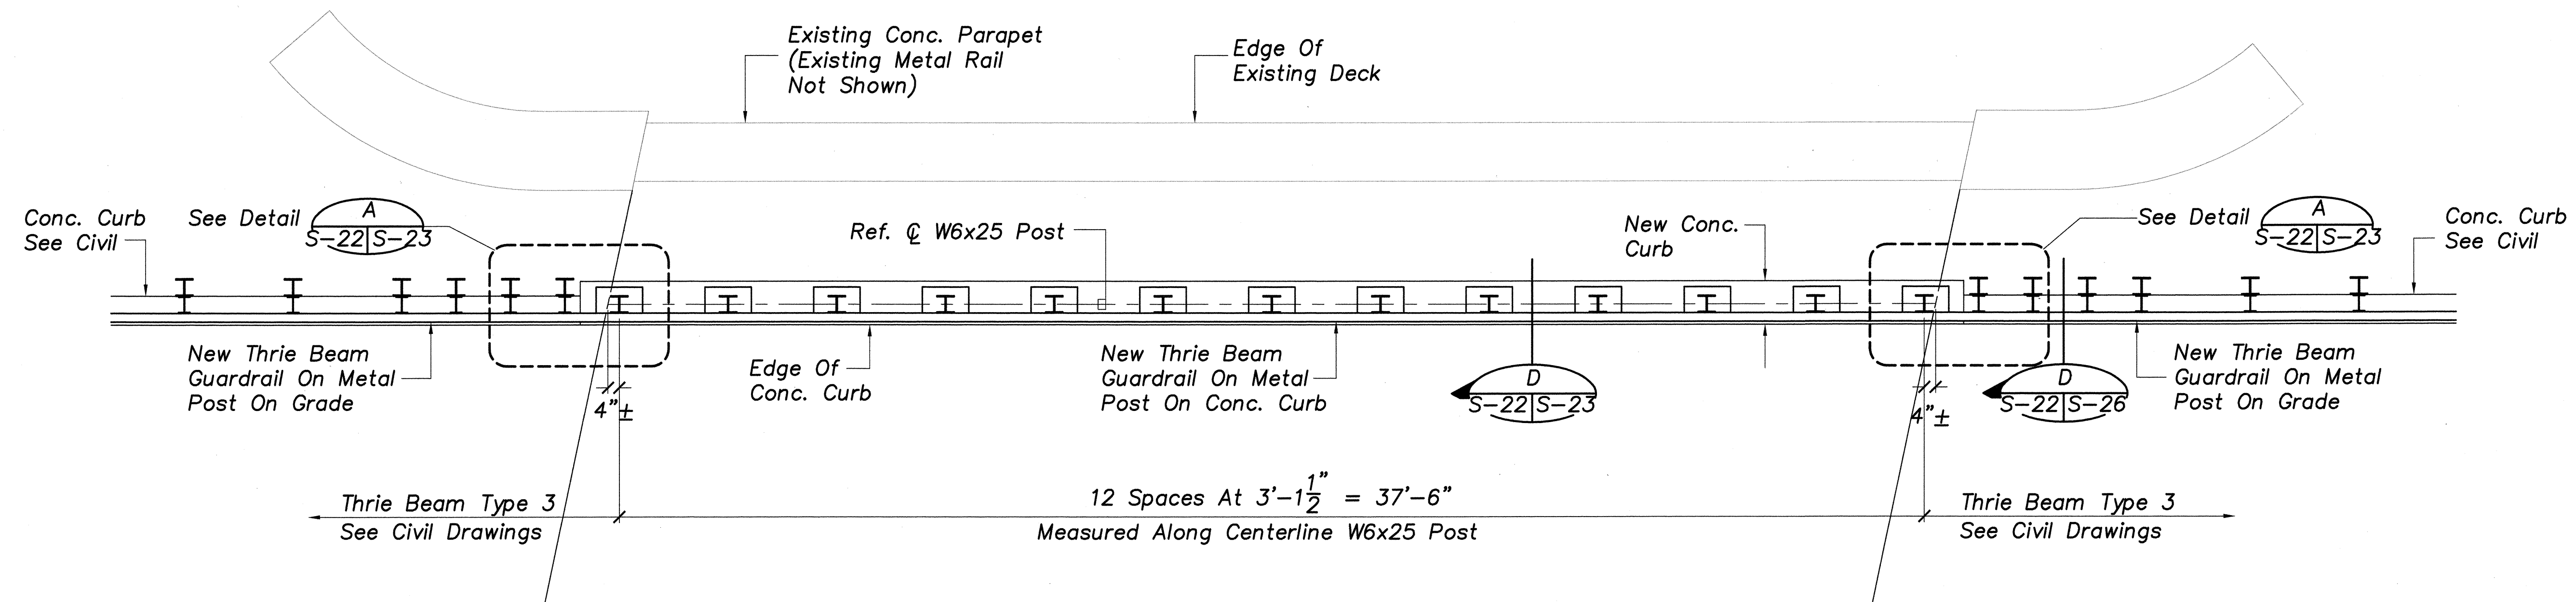

GUARDRAIL TYPE "C" DETAIL PLAN

Scale: 3/8"=1'-0"

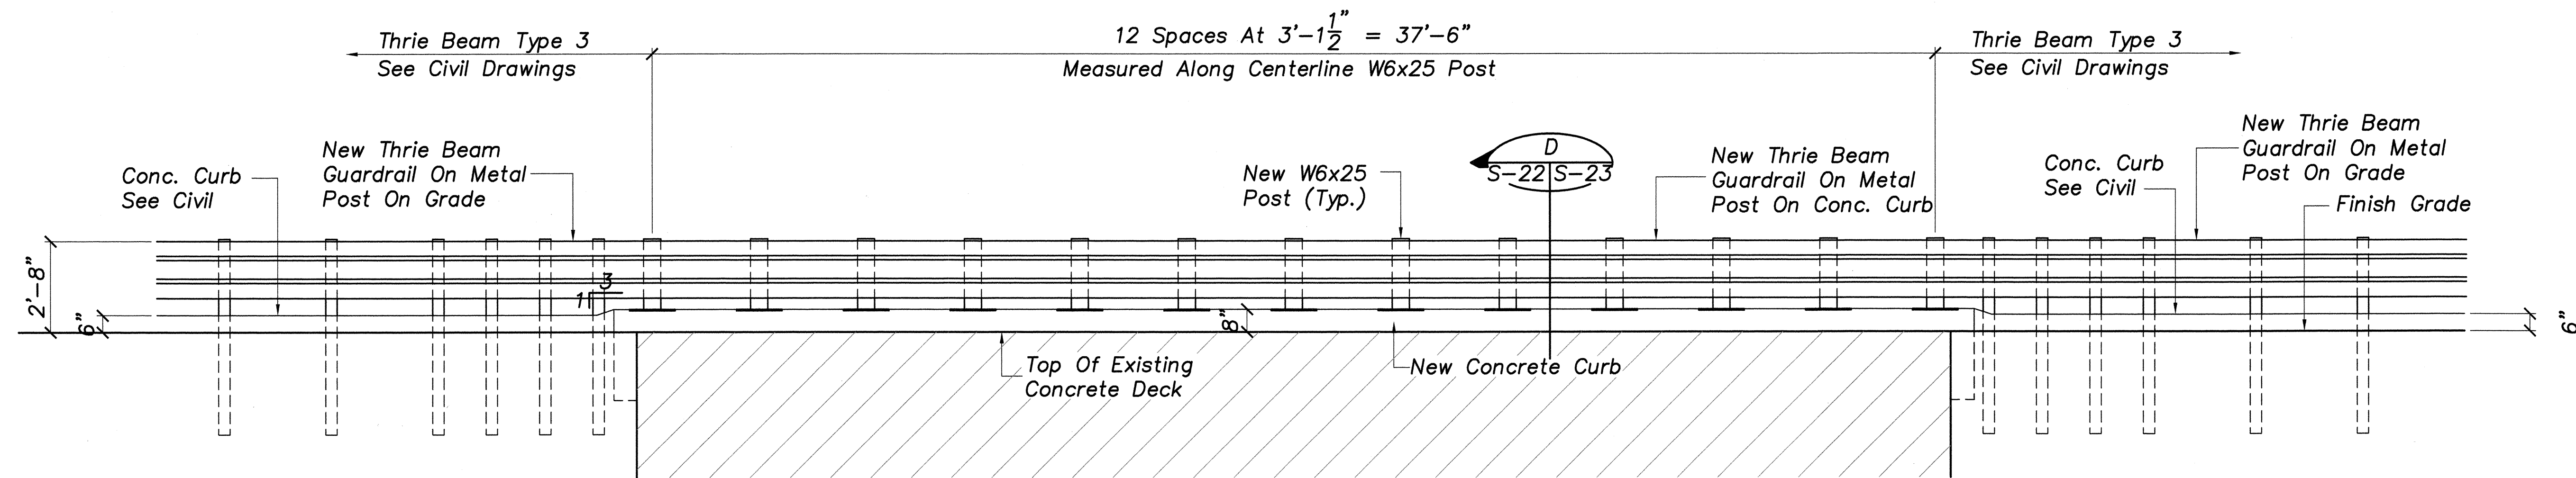


GUARDRAIL TYPE "C" ELEVATION

Scale: 3/8"=1'-0"

GUARDRAIL TYPE "C" DETAILS

Scale As Noted

DESIGNED BY	DATE
DRAWN BY	
CHECKED BY	
APPROVED BY	
NO. _____	

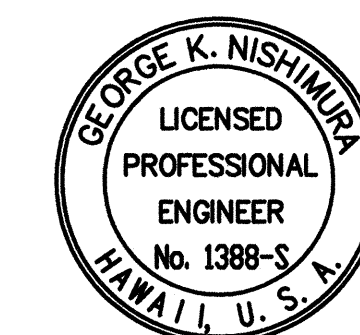

THIS WORK WAS PREPARED BY ME OR UNDER MY SUPERVISION.
 SIGNATURE
 04/30/06
 EXPIRATION DATE OF PROFESSIONAL LICENSE




STATE OF HAWAII
 DEPARTMENT OF TRANSPORTATION
 HIGHWAYS DIVISION
GUARDRAIL TYPE "C" DETAILS

HALEAKALA HIGHWAY WIDENING, PHASE 2
 HANA HIGHWAY TO PUKALANI BYPASS
 FED. AID PROJ. NO. NH-037-1(24)


SCALE: AS NOTED DATE: MAY 2005

SHEET No. S-22OF 26 SHEETS

FED. ROAD DIST. NO.	STATE	FED. AID PROJ. NO.	FISCAL YEAR	SHEET NO.	TOTAL SHEETS
HAWAII	HAW.	NH-037-1(24)	2005	257	288

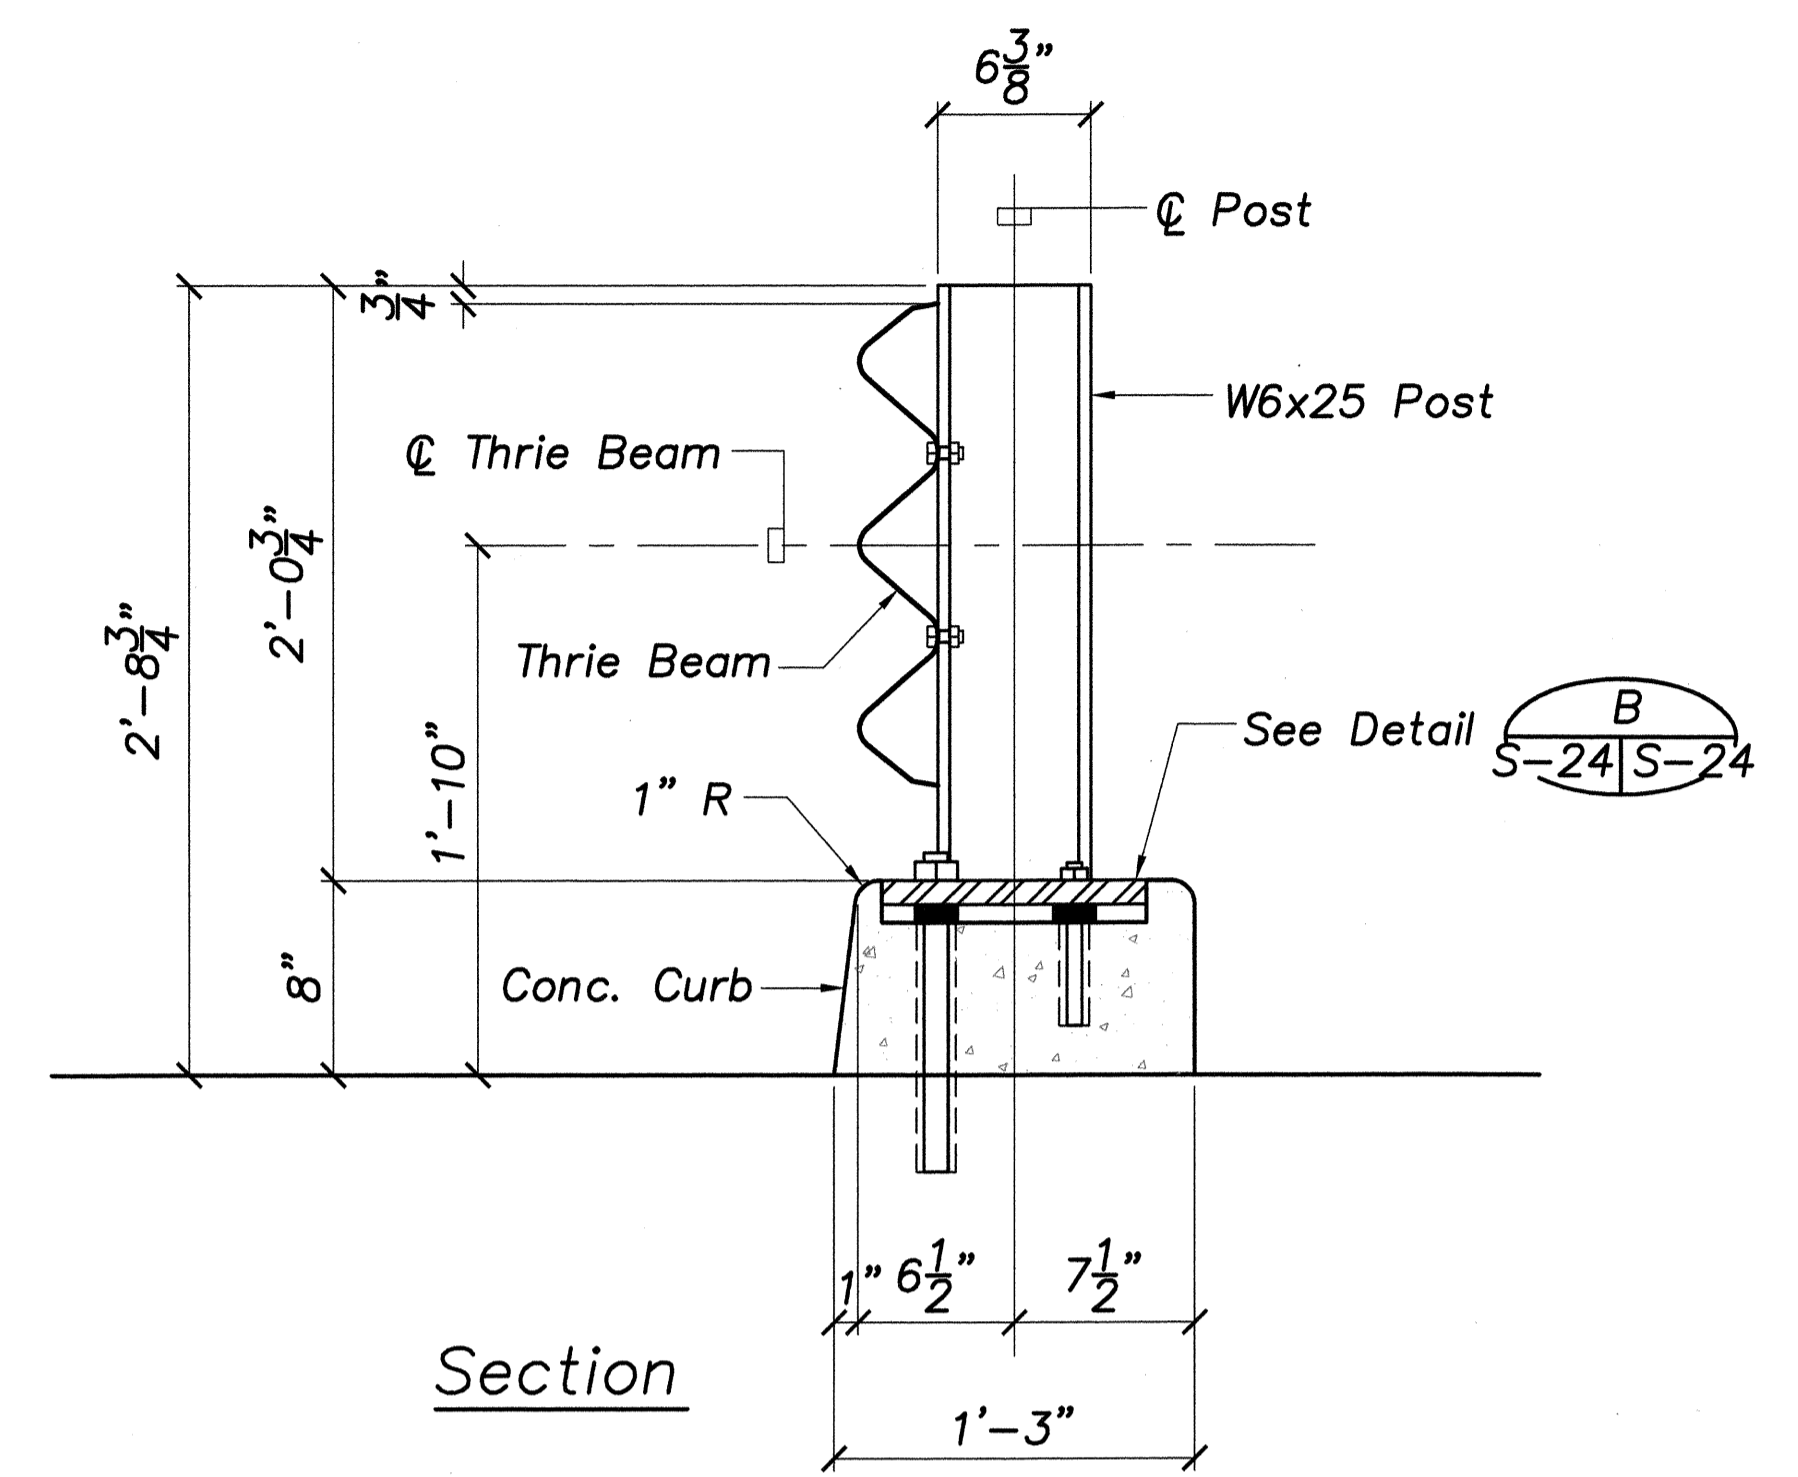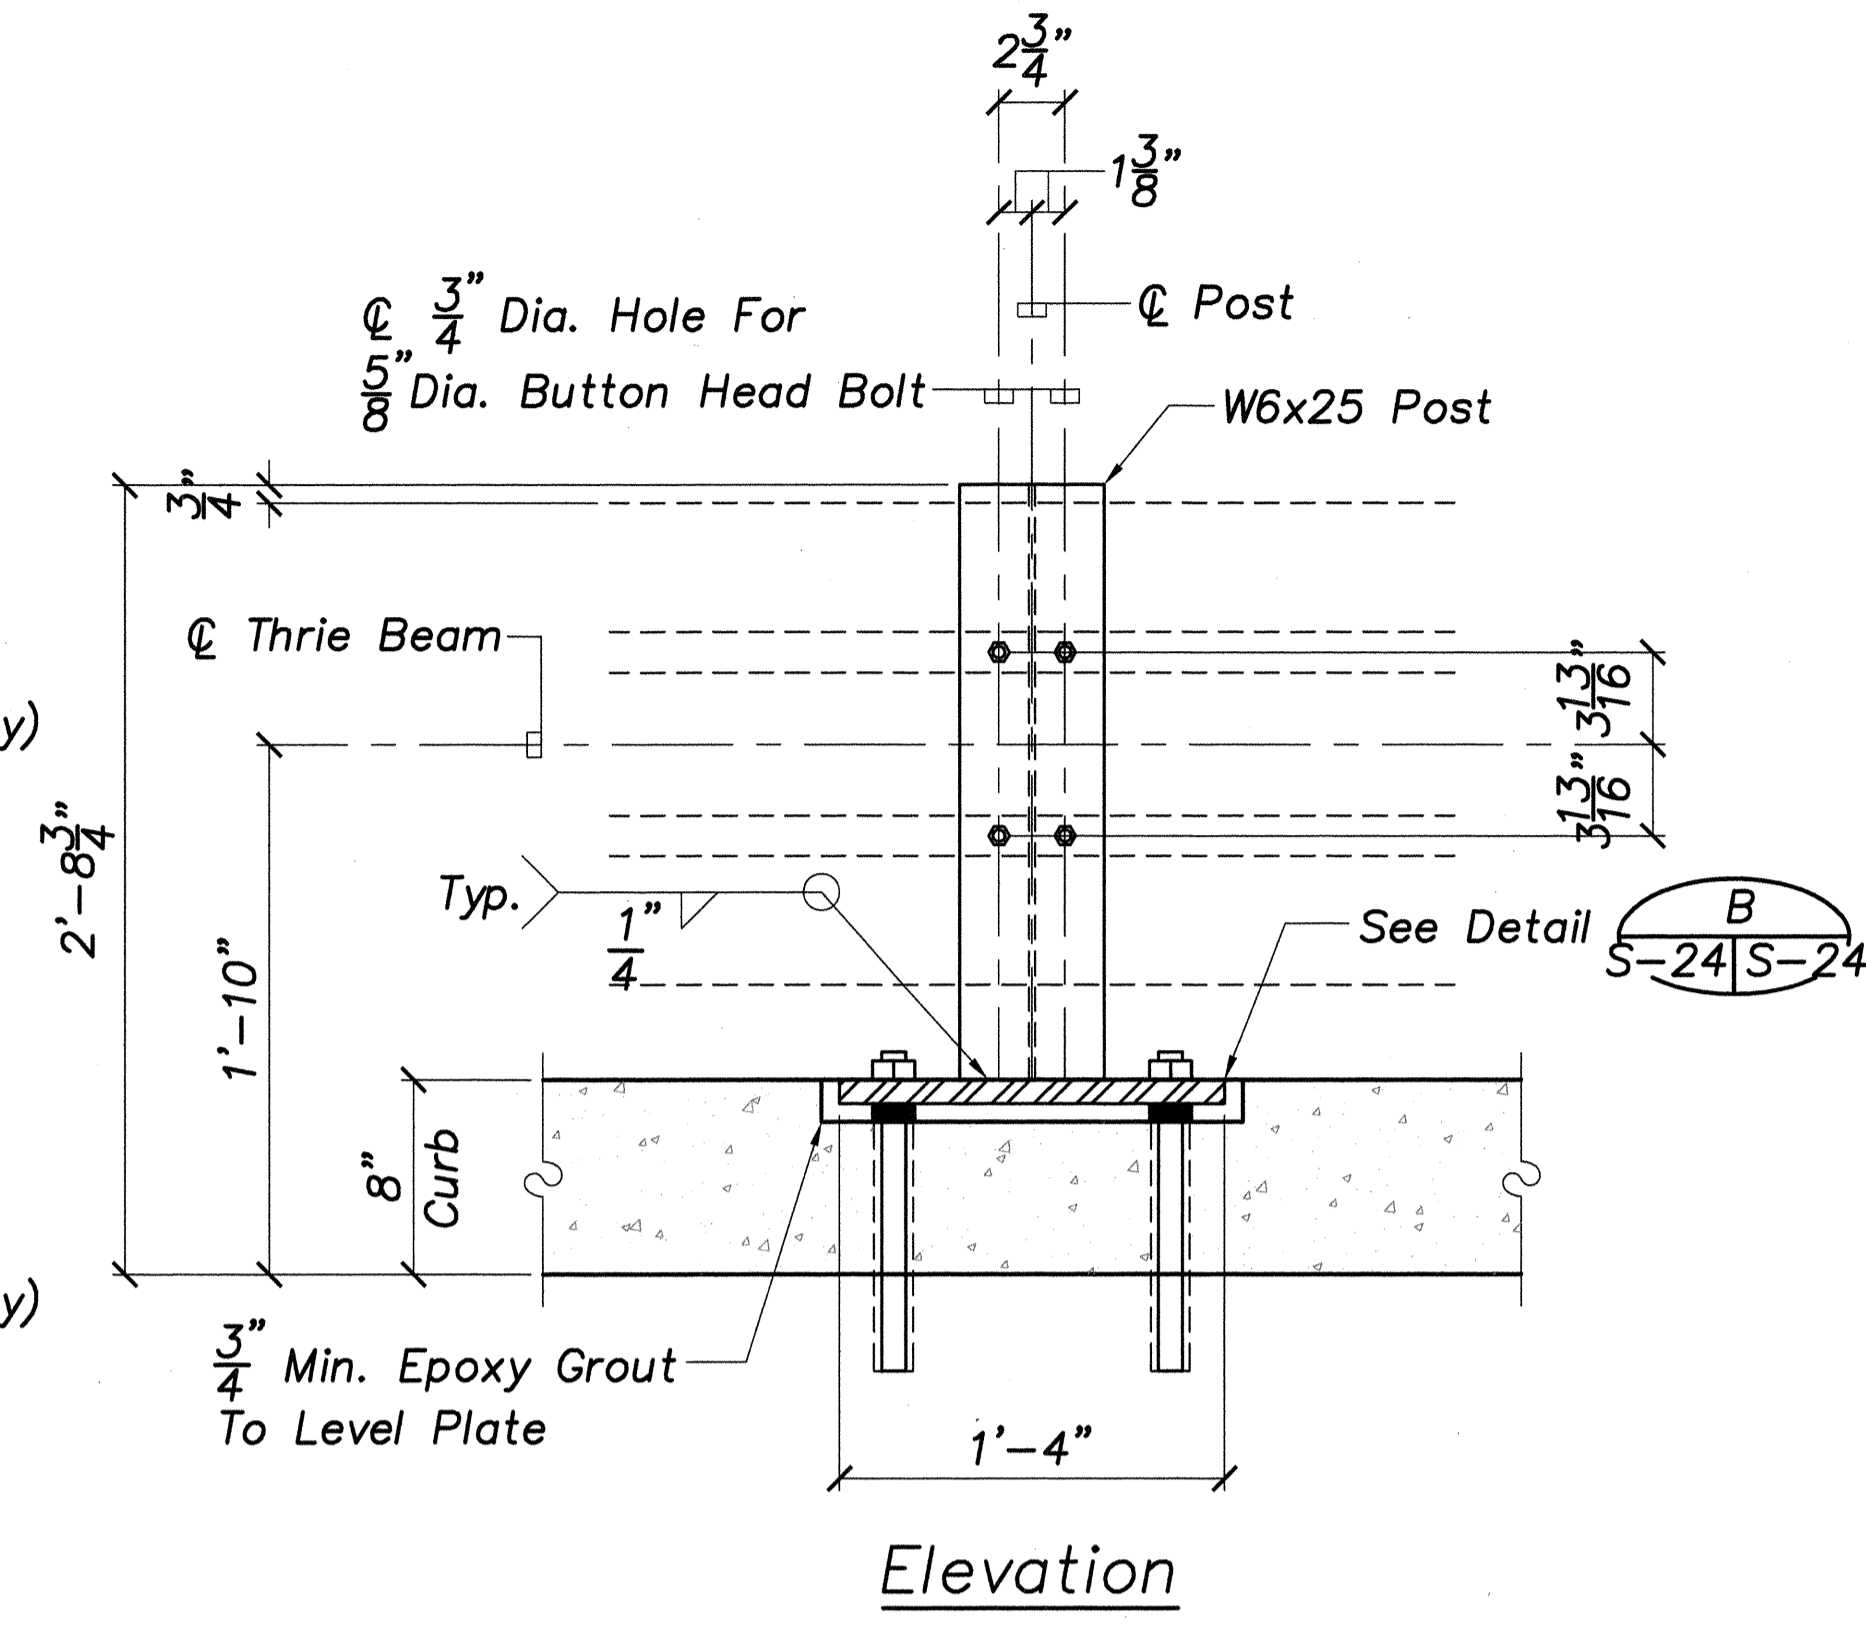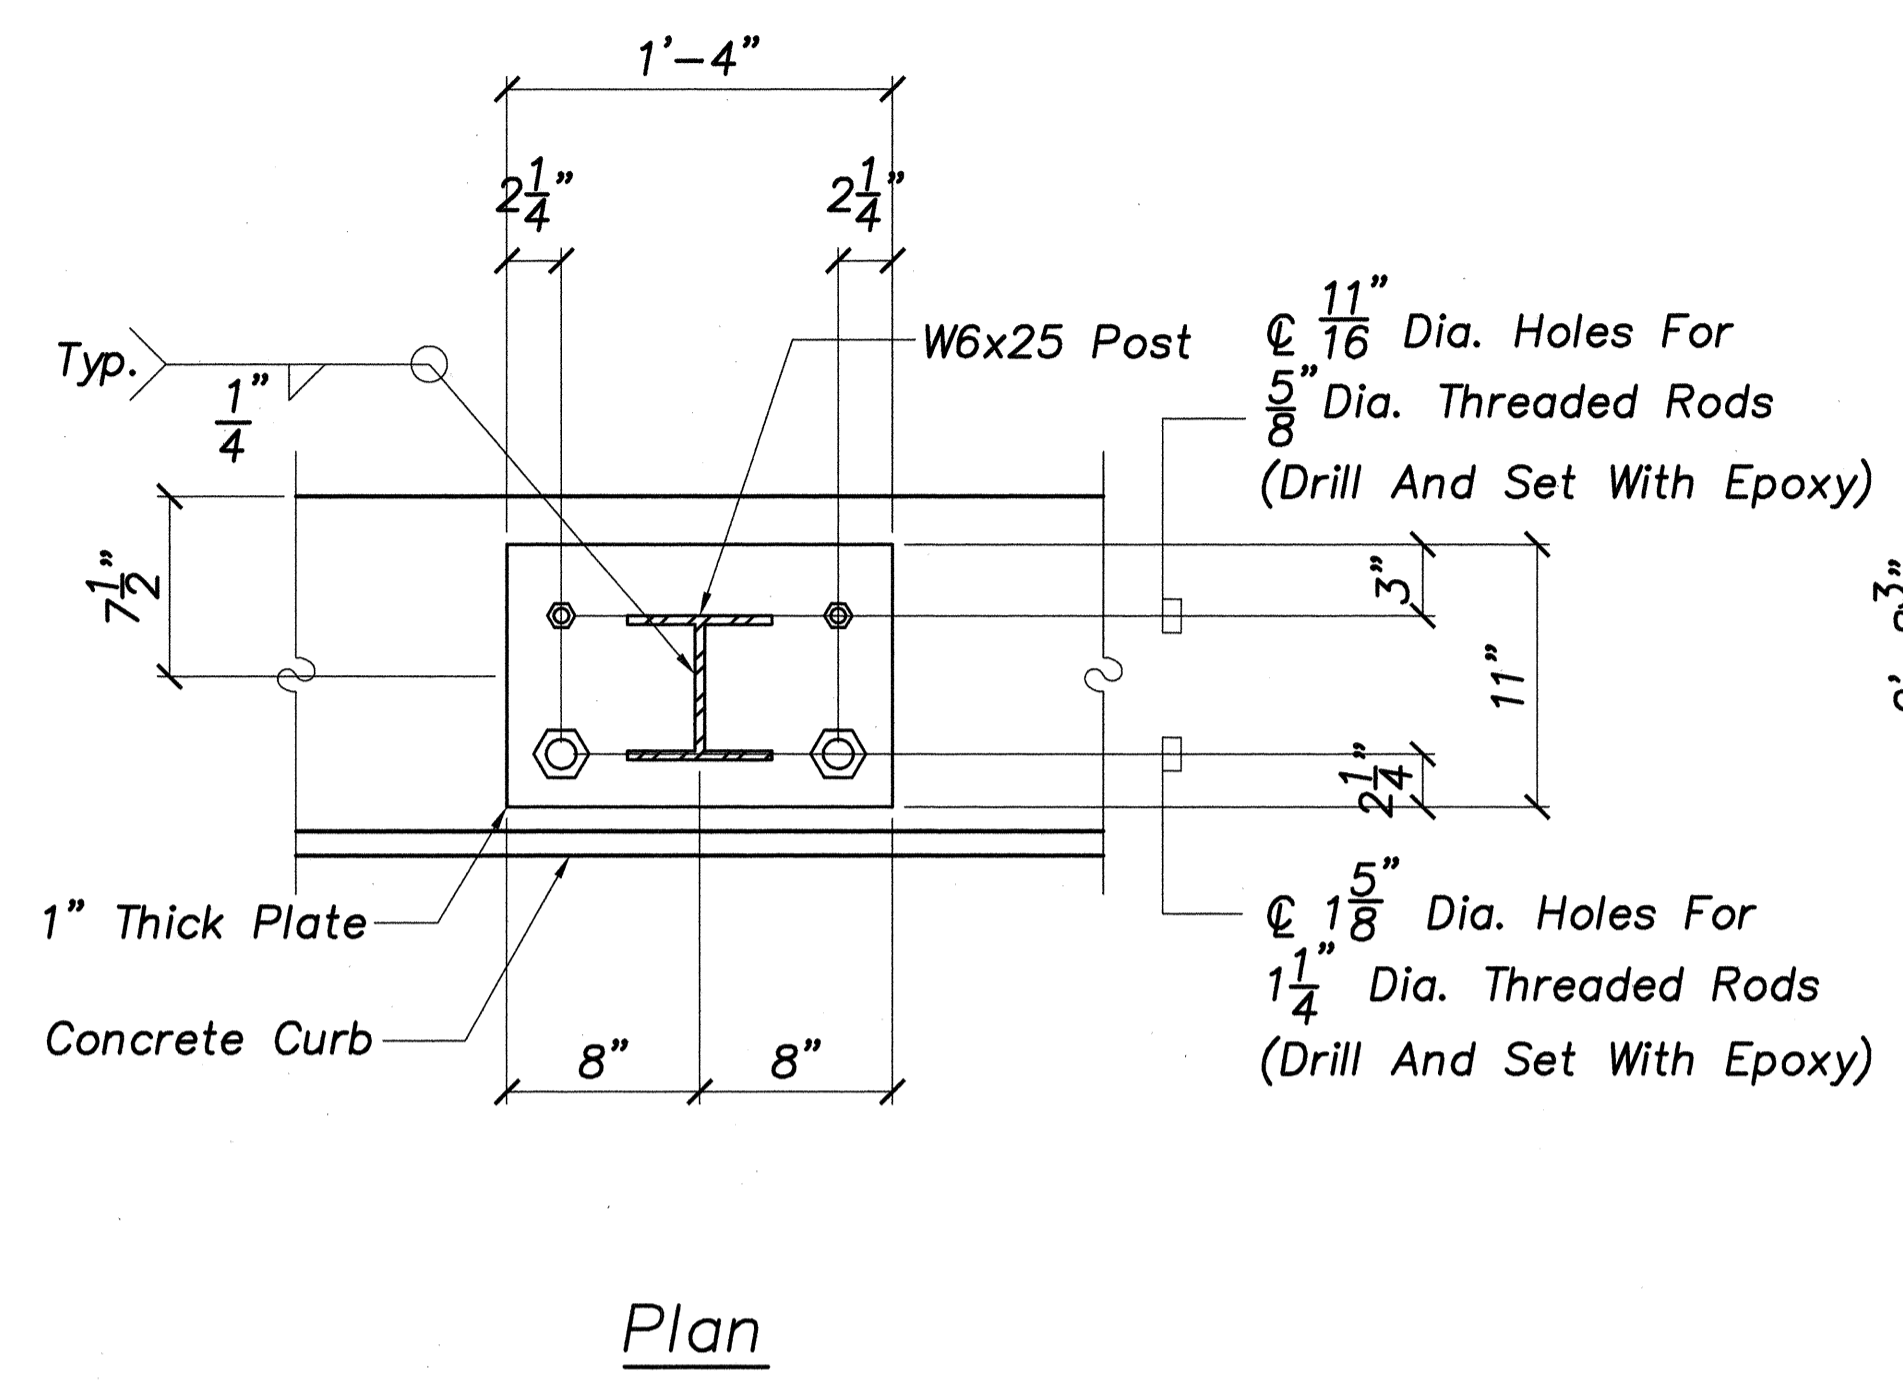


W6x25 POST AND BASE DETAIL
 Scale: 1 1/2" = 1'-0"

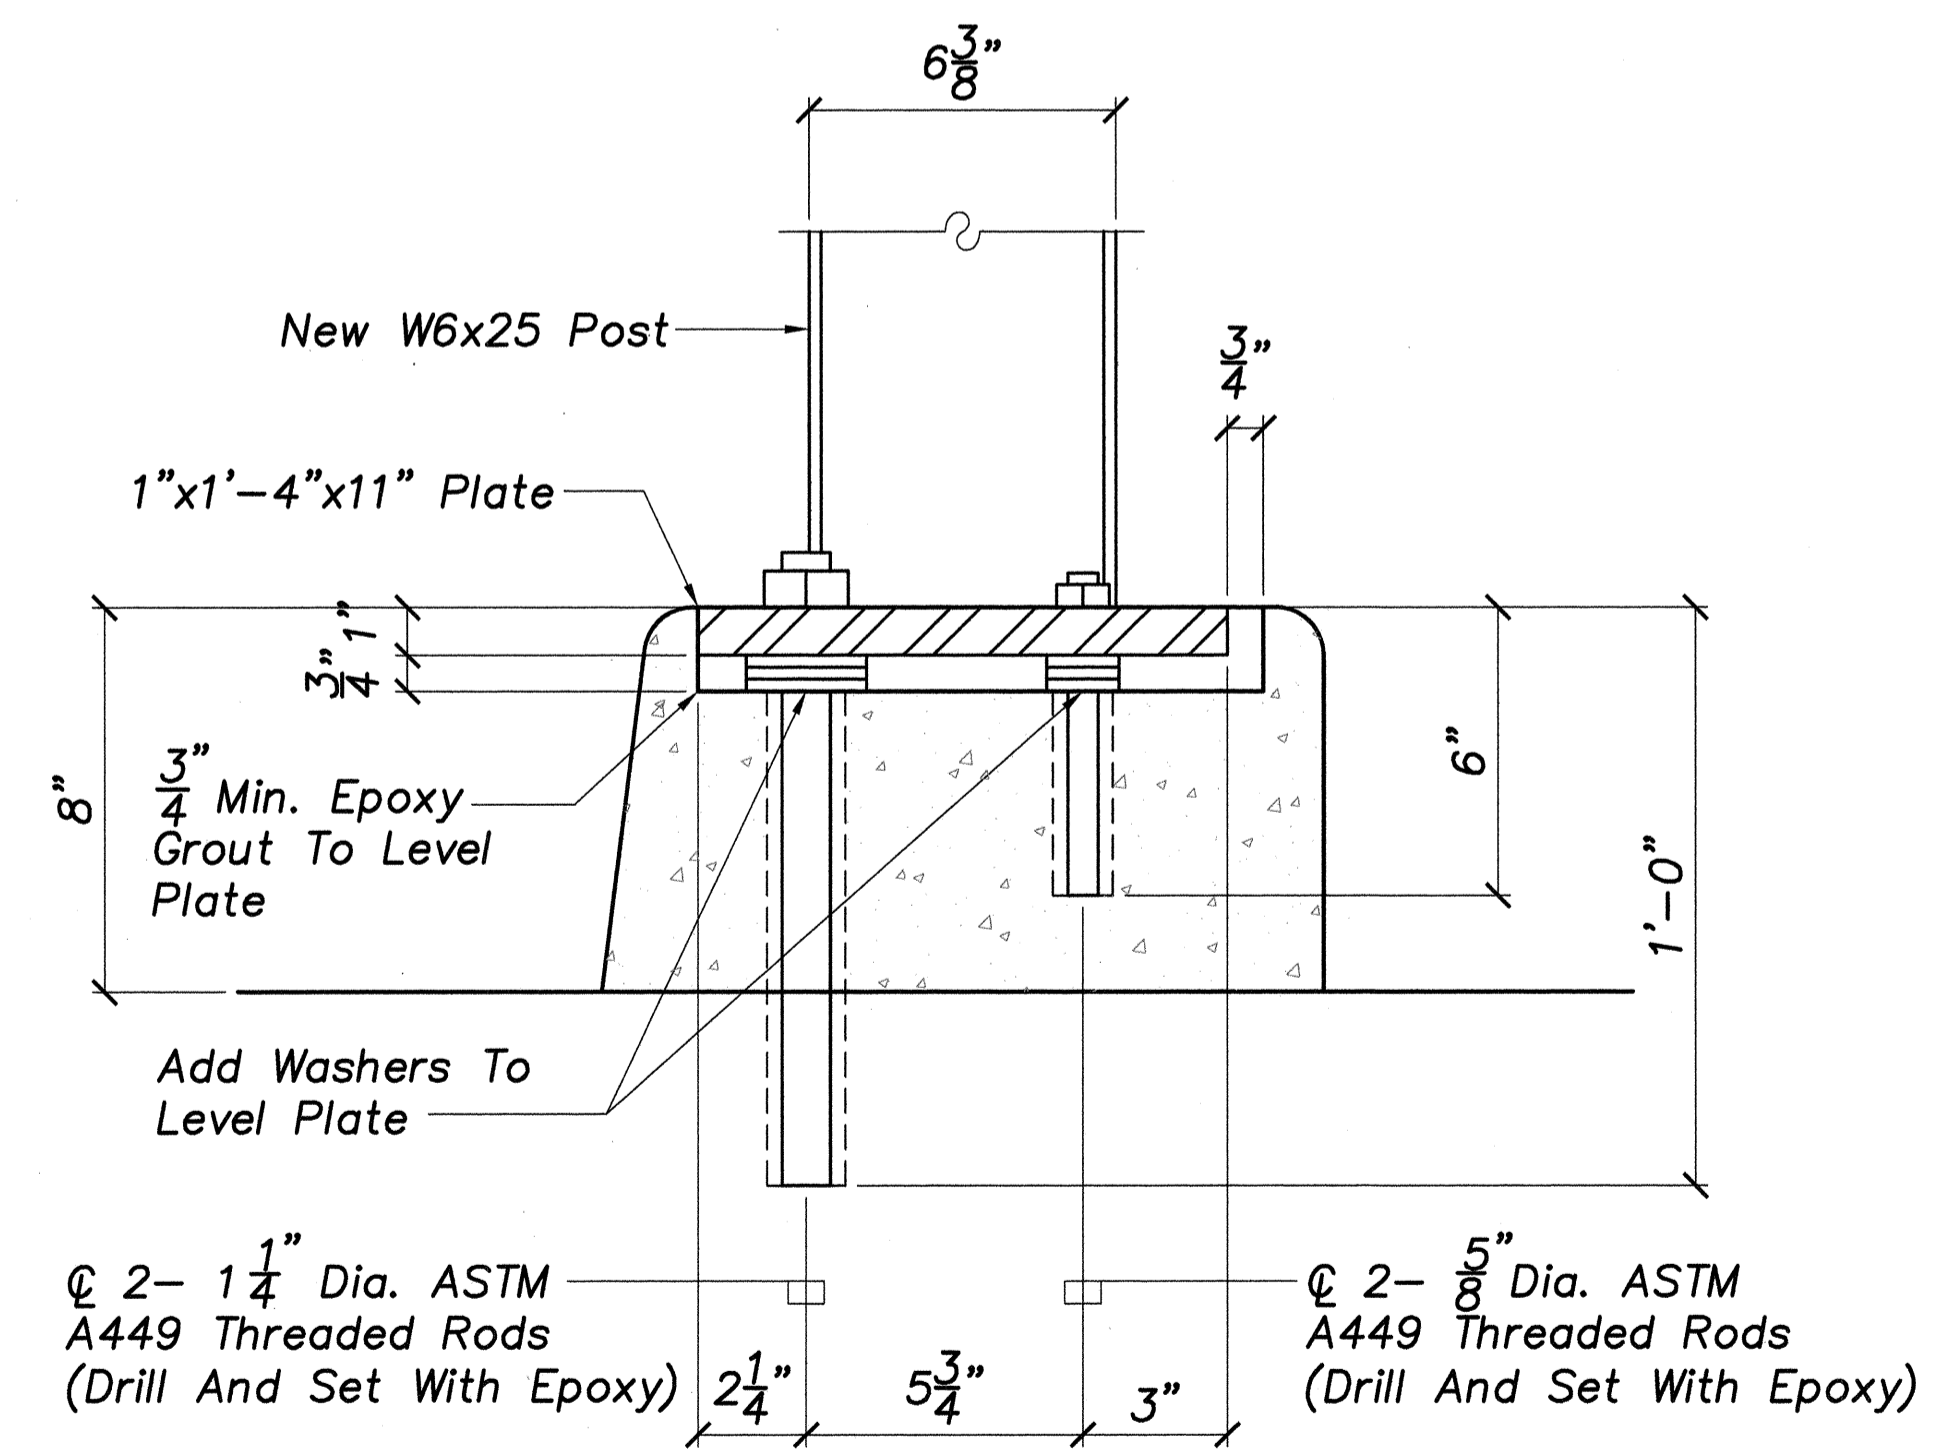

BASE PLATE DETAIL
 Scale: 3" = 1'-0"

DATE	_____
DESIGNED BY	_____
CHECKED BY	_____
NO. _____	_____

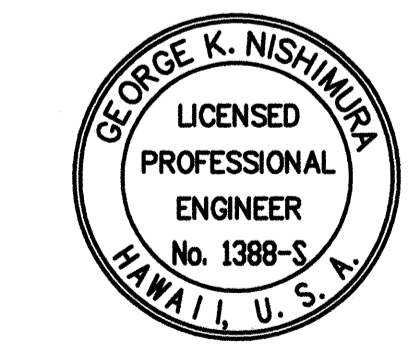








THIS WORK WAS PREPARED BY ME OR UNDER MY SUPERVISION.
 SIGNATURE
 04/30/06
 EXPIRATION DATE OF PROFESSIONAL LICENSE

STATE OF HAWAII
 DEPARTMENT OF TRANSPORTATION
 HIGHWAYS DIVISION
GUARDRAIL DETAILS


HALEAKALA HIGHWAY WIDENING, PHASE 2
 HANA HIGHWAY TO PUKALANI BYPASS
 FED. AID PROJ. NO. NH-037-1(24)

SCALE: AS NOTED DATE: MAY 2005
 SHEET No. S-24 OF 26 SHEETS

FED. ROAD DIST. NO.	STATE	FED. AID PROJ. NO.	FISCAL YEAR	SHEET NO.	TOTAL SHEETS
HAWAII	HAW.	NH-037-1(24)	2005	C.O. 258	288

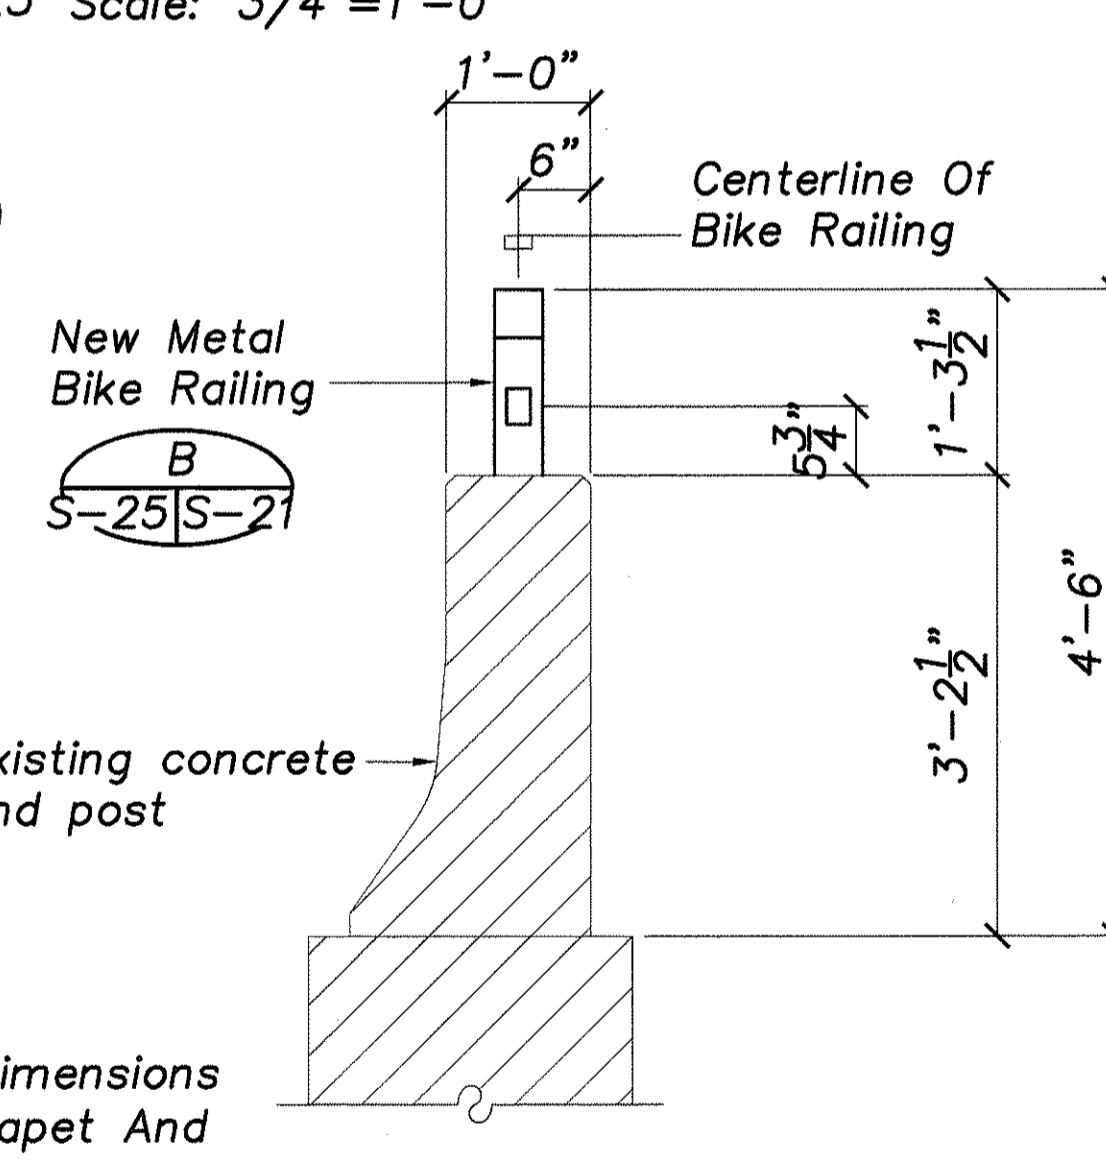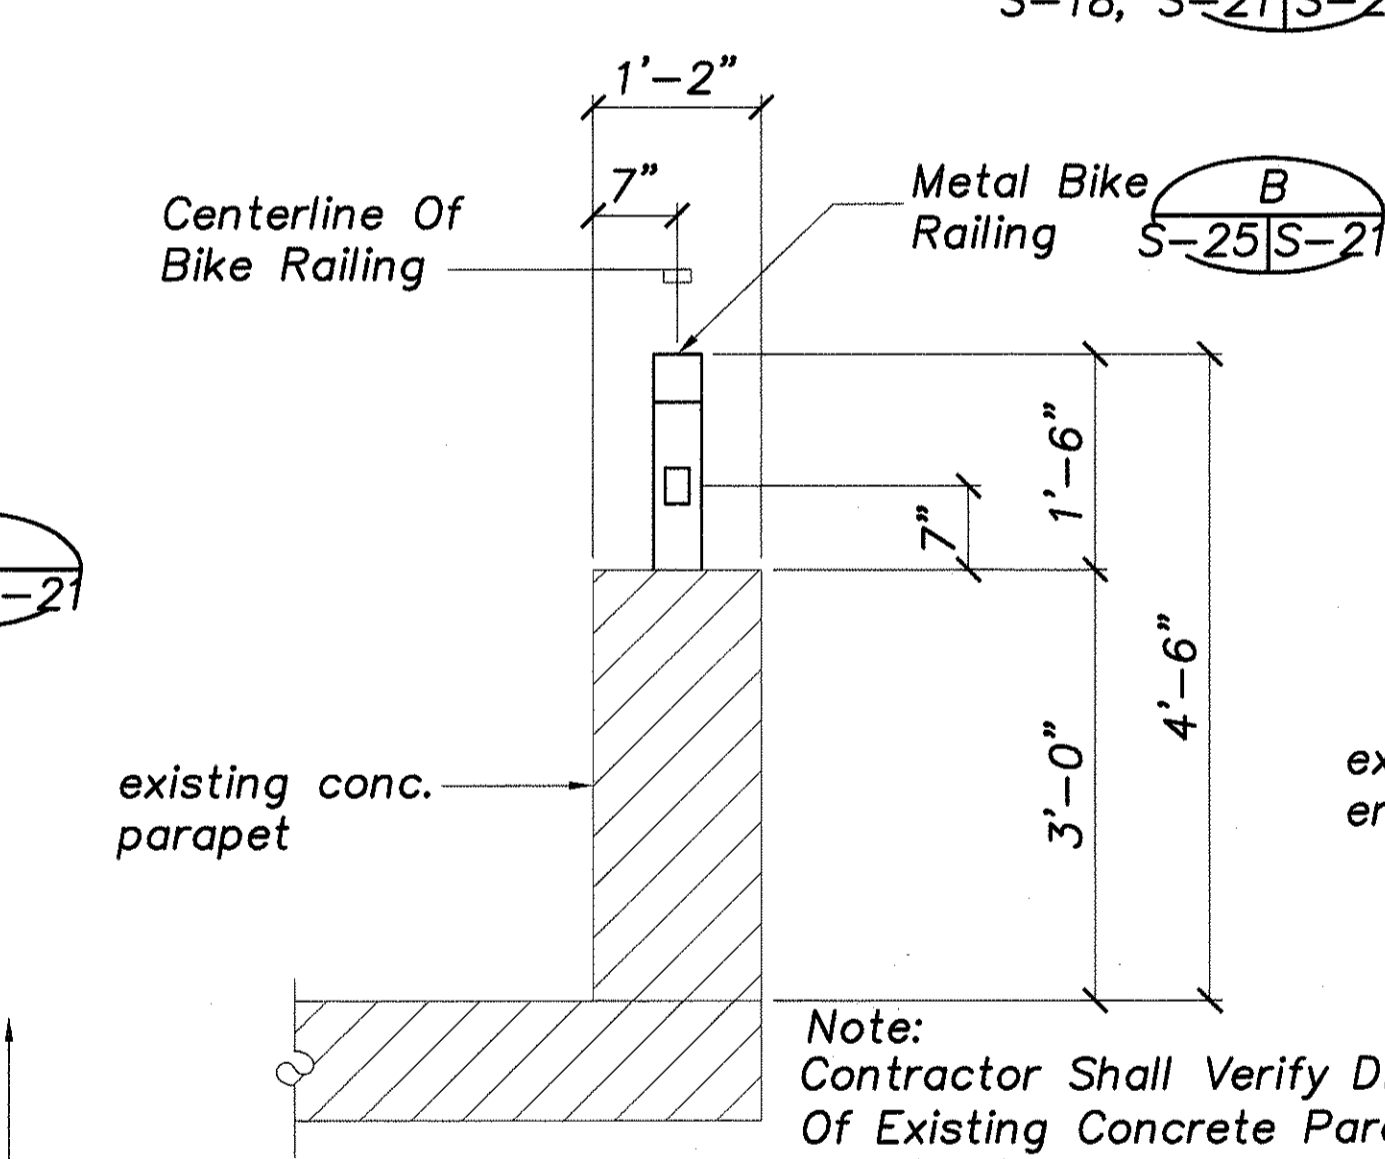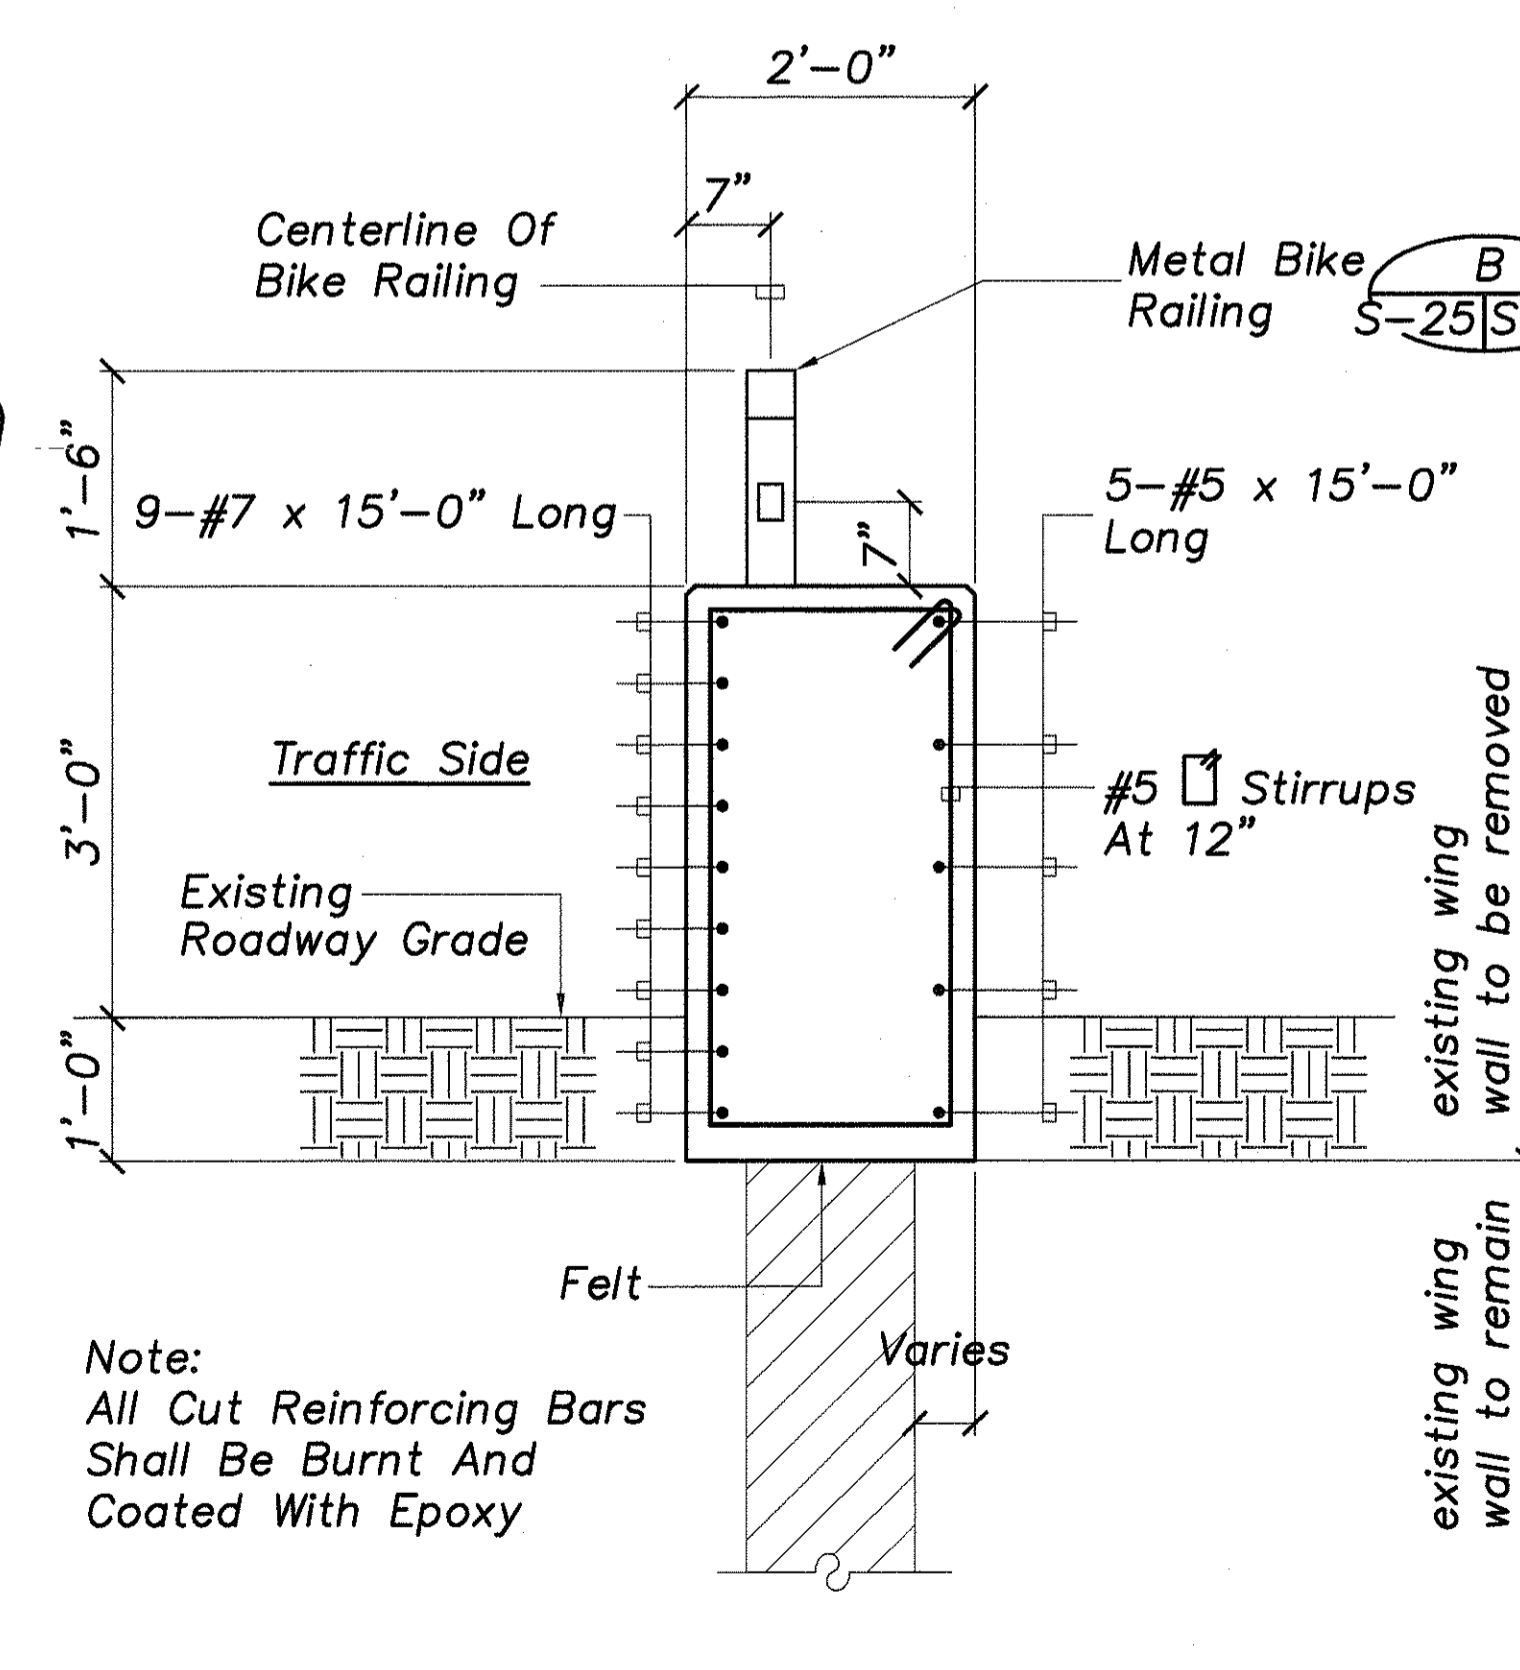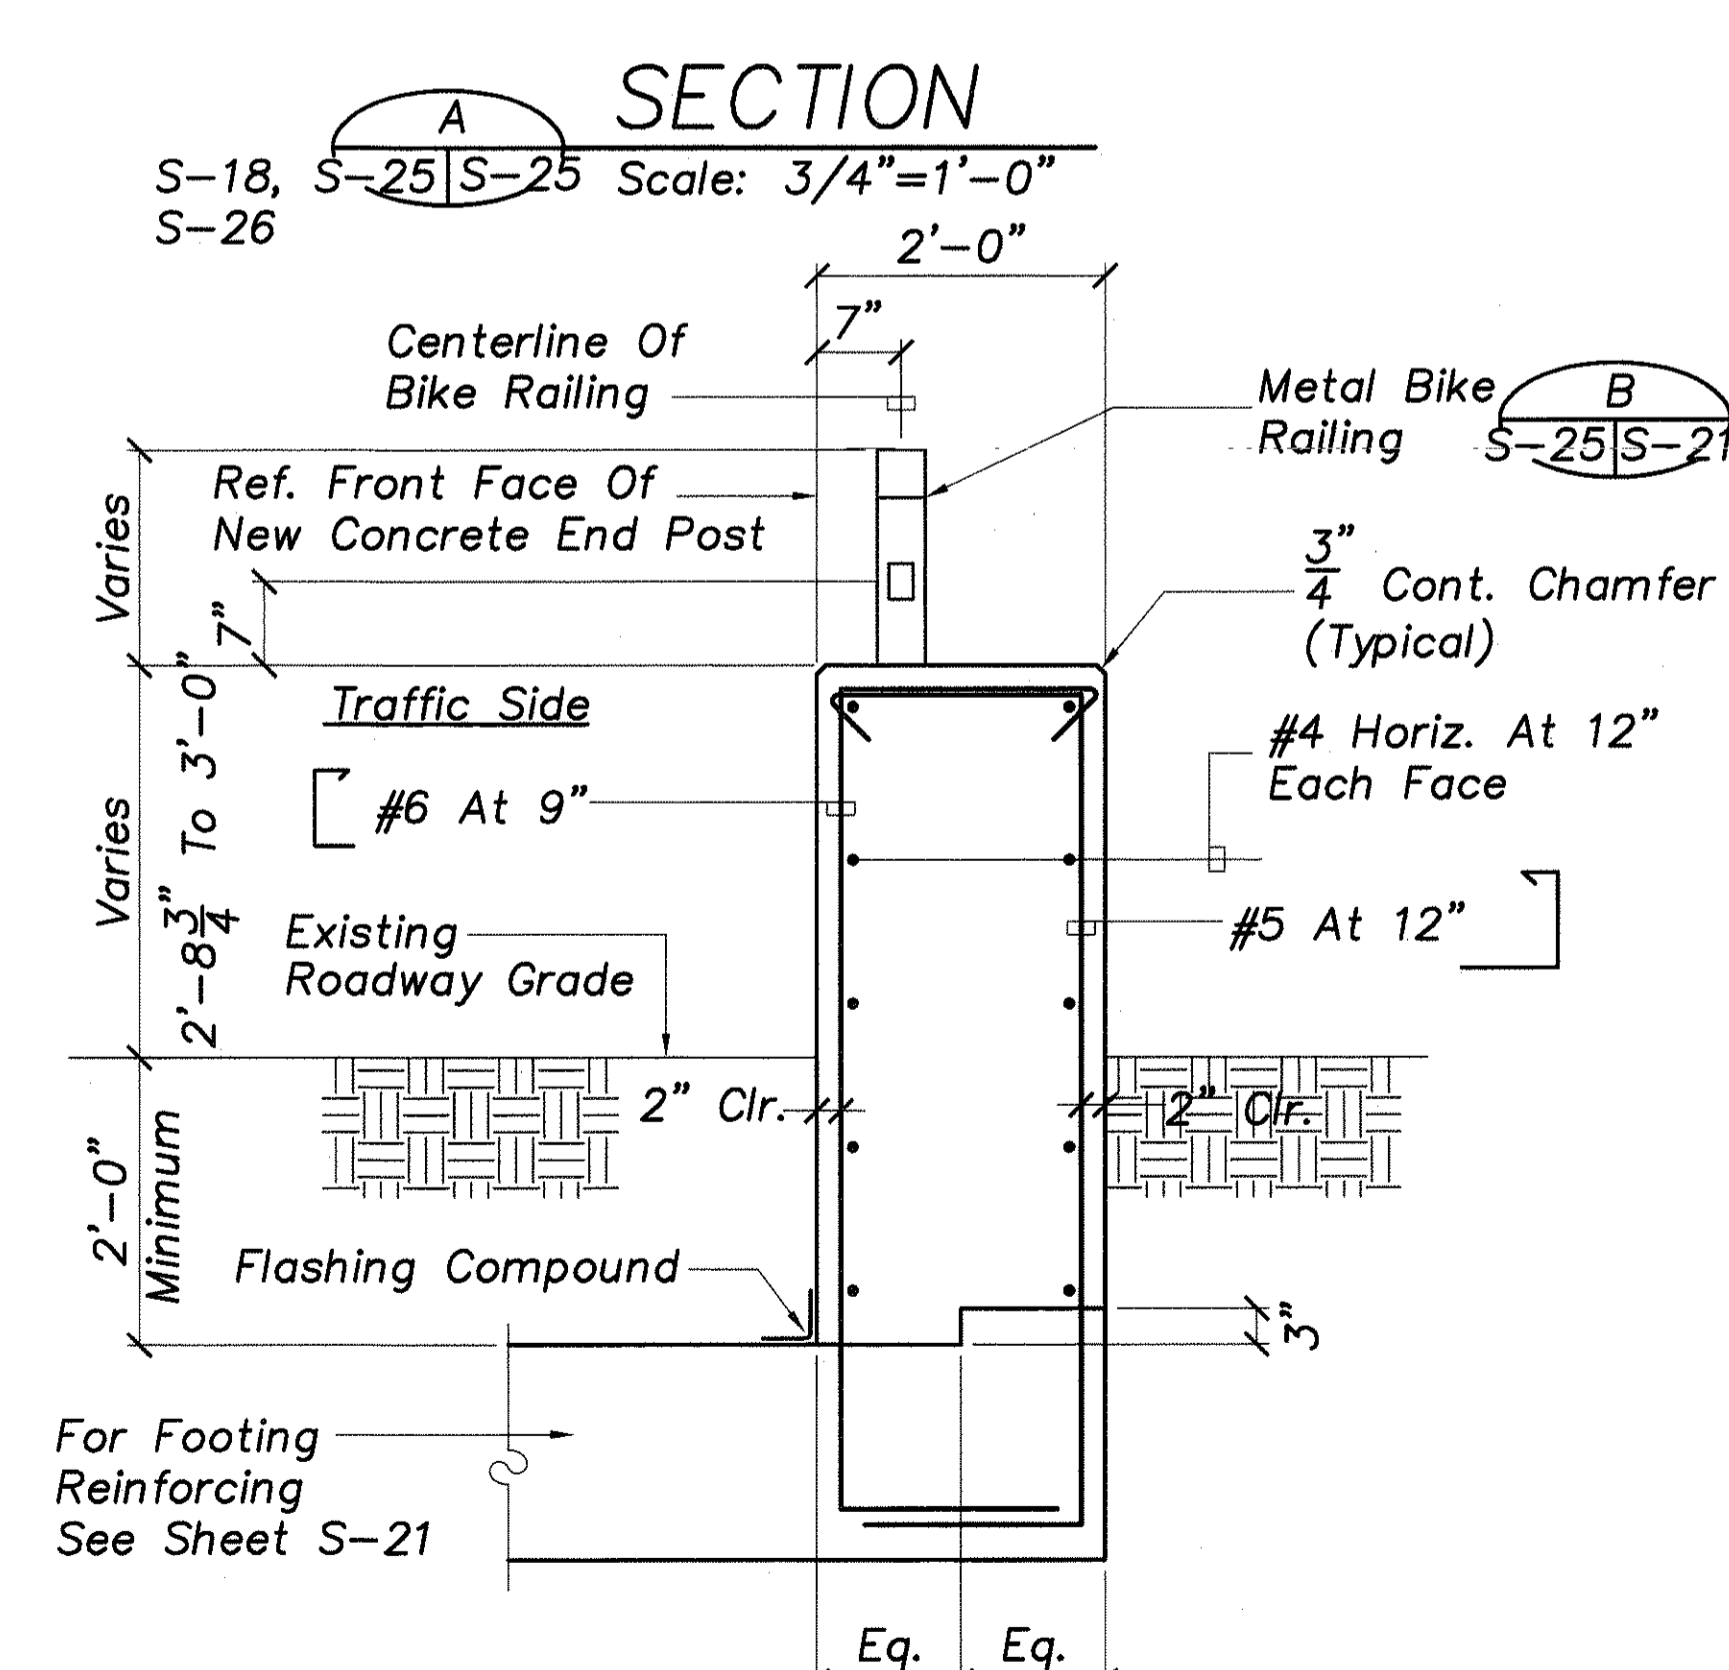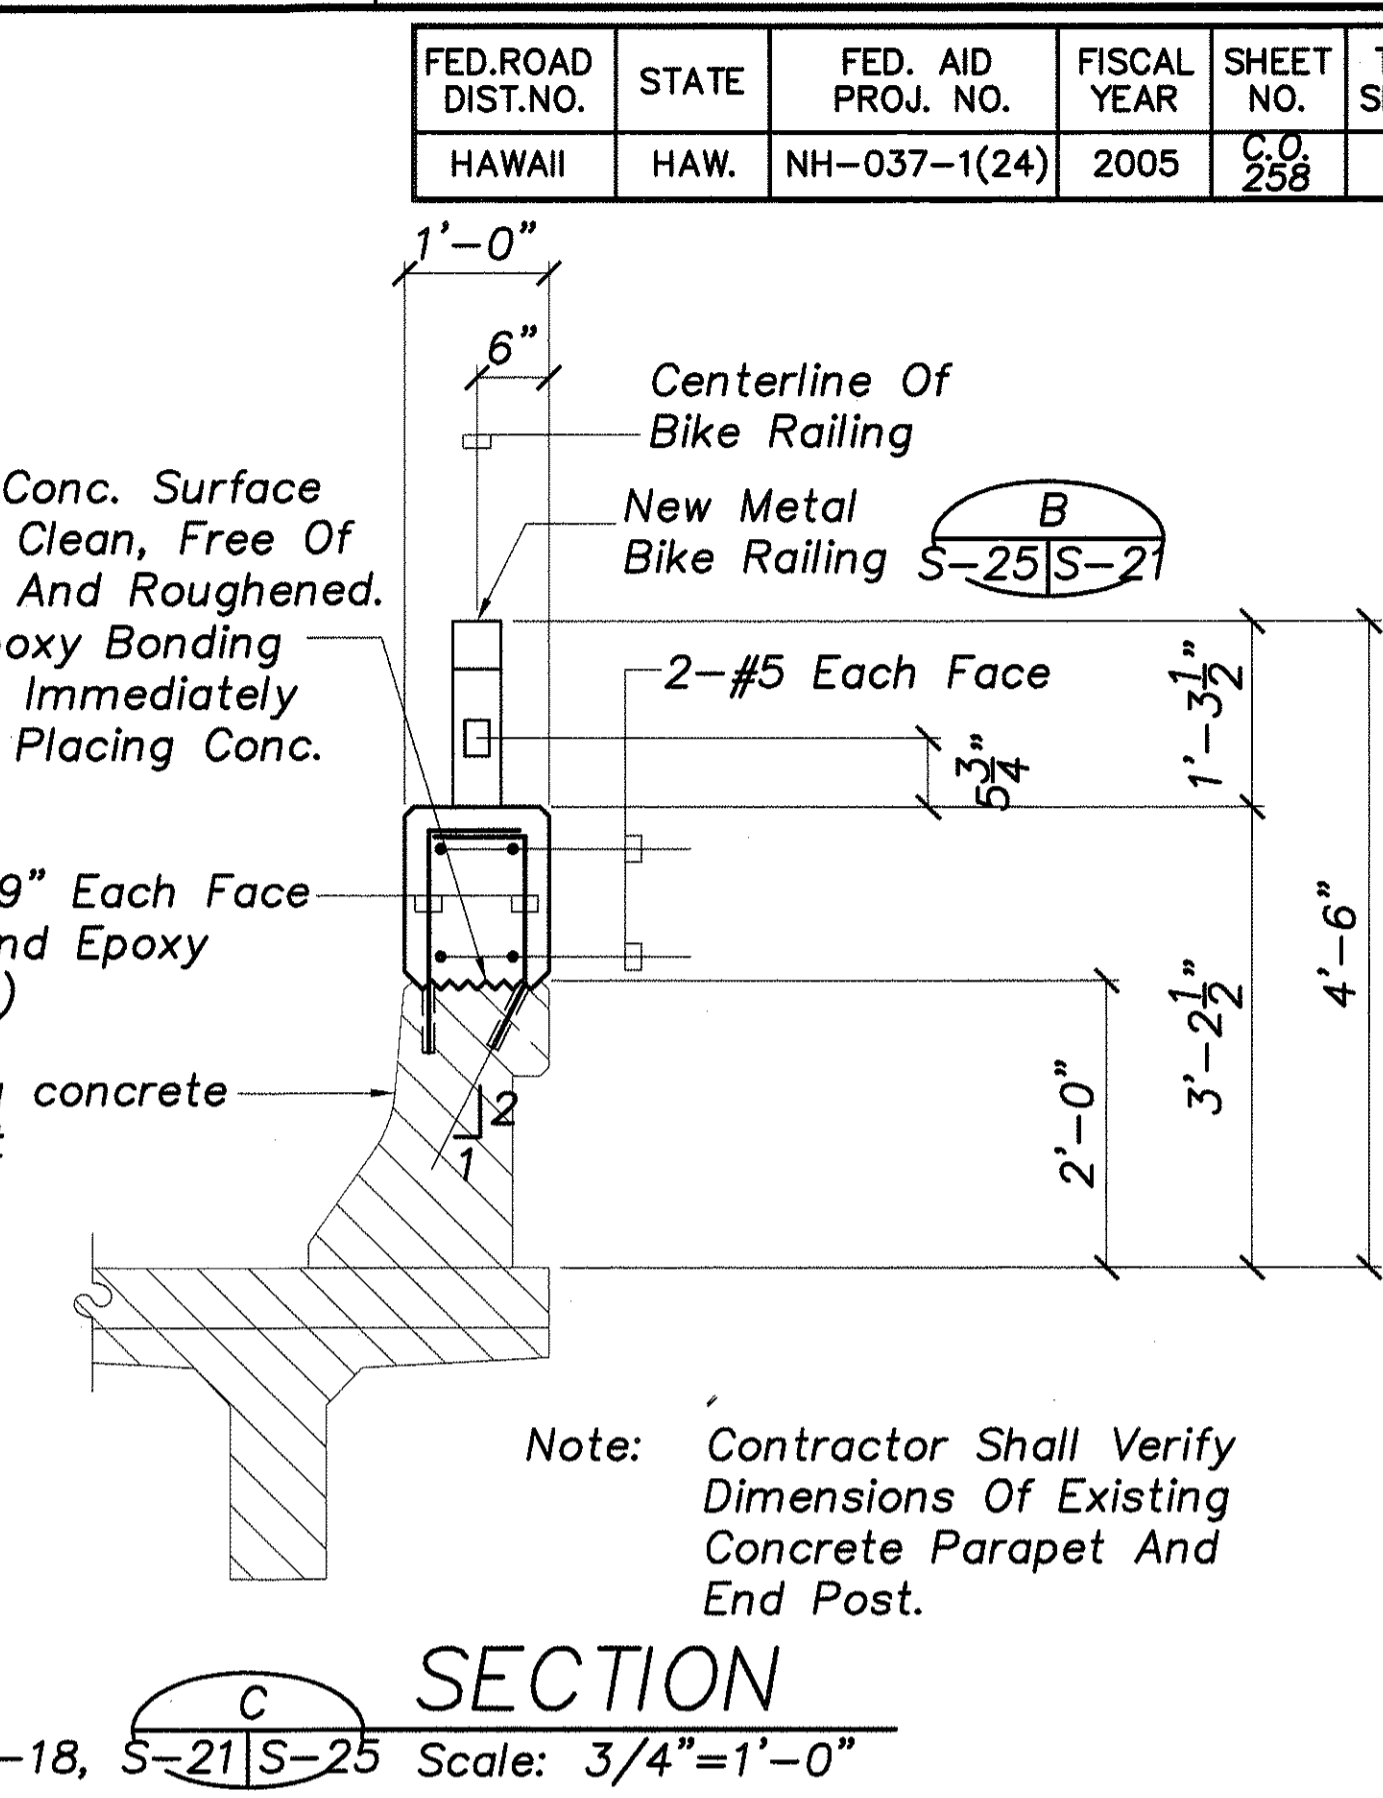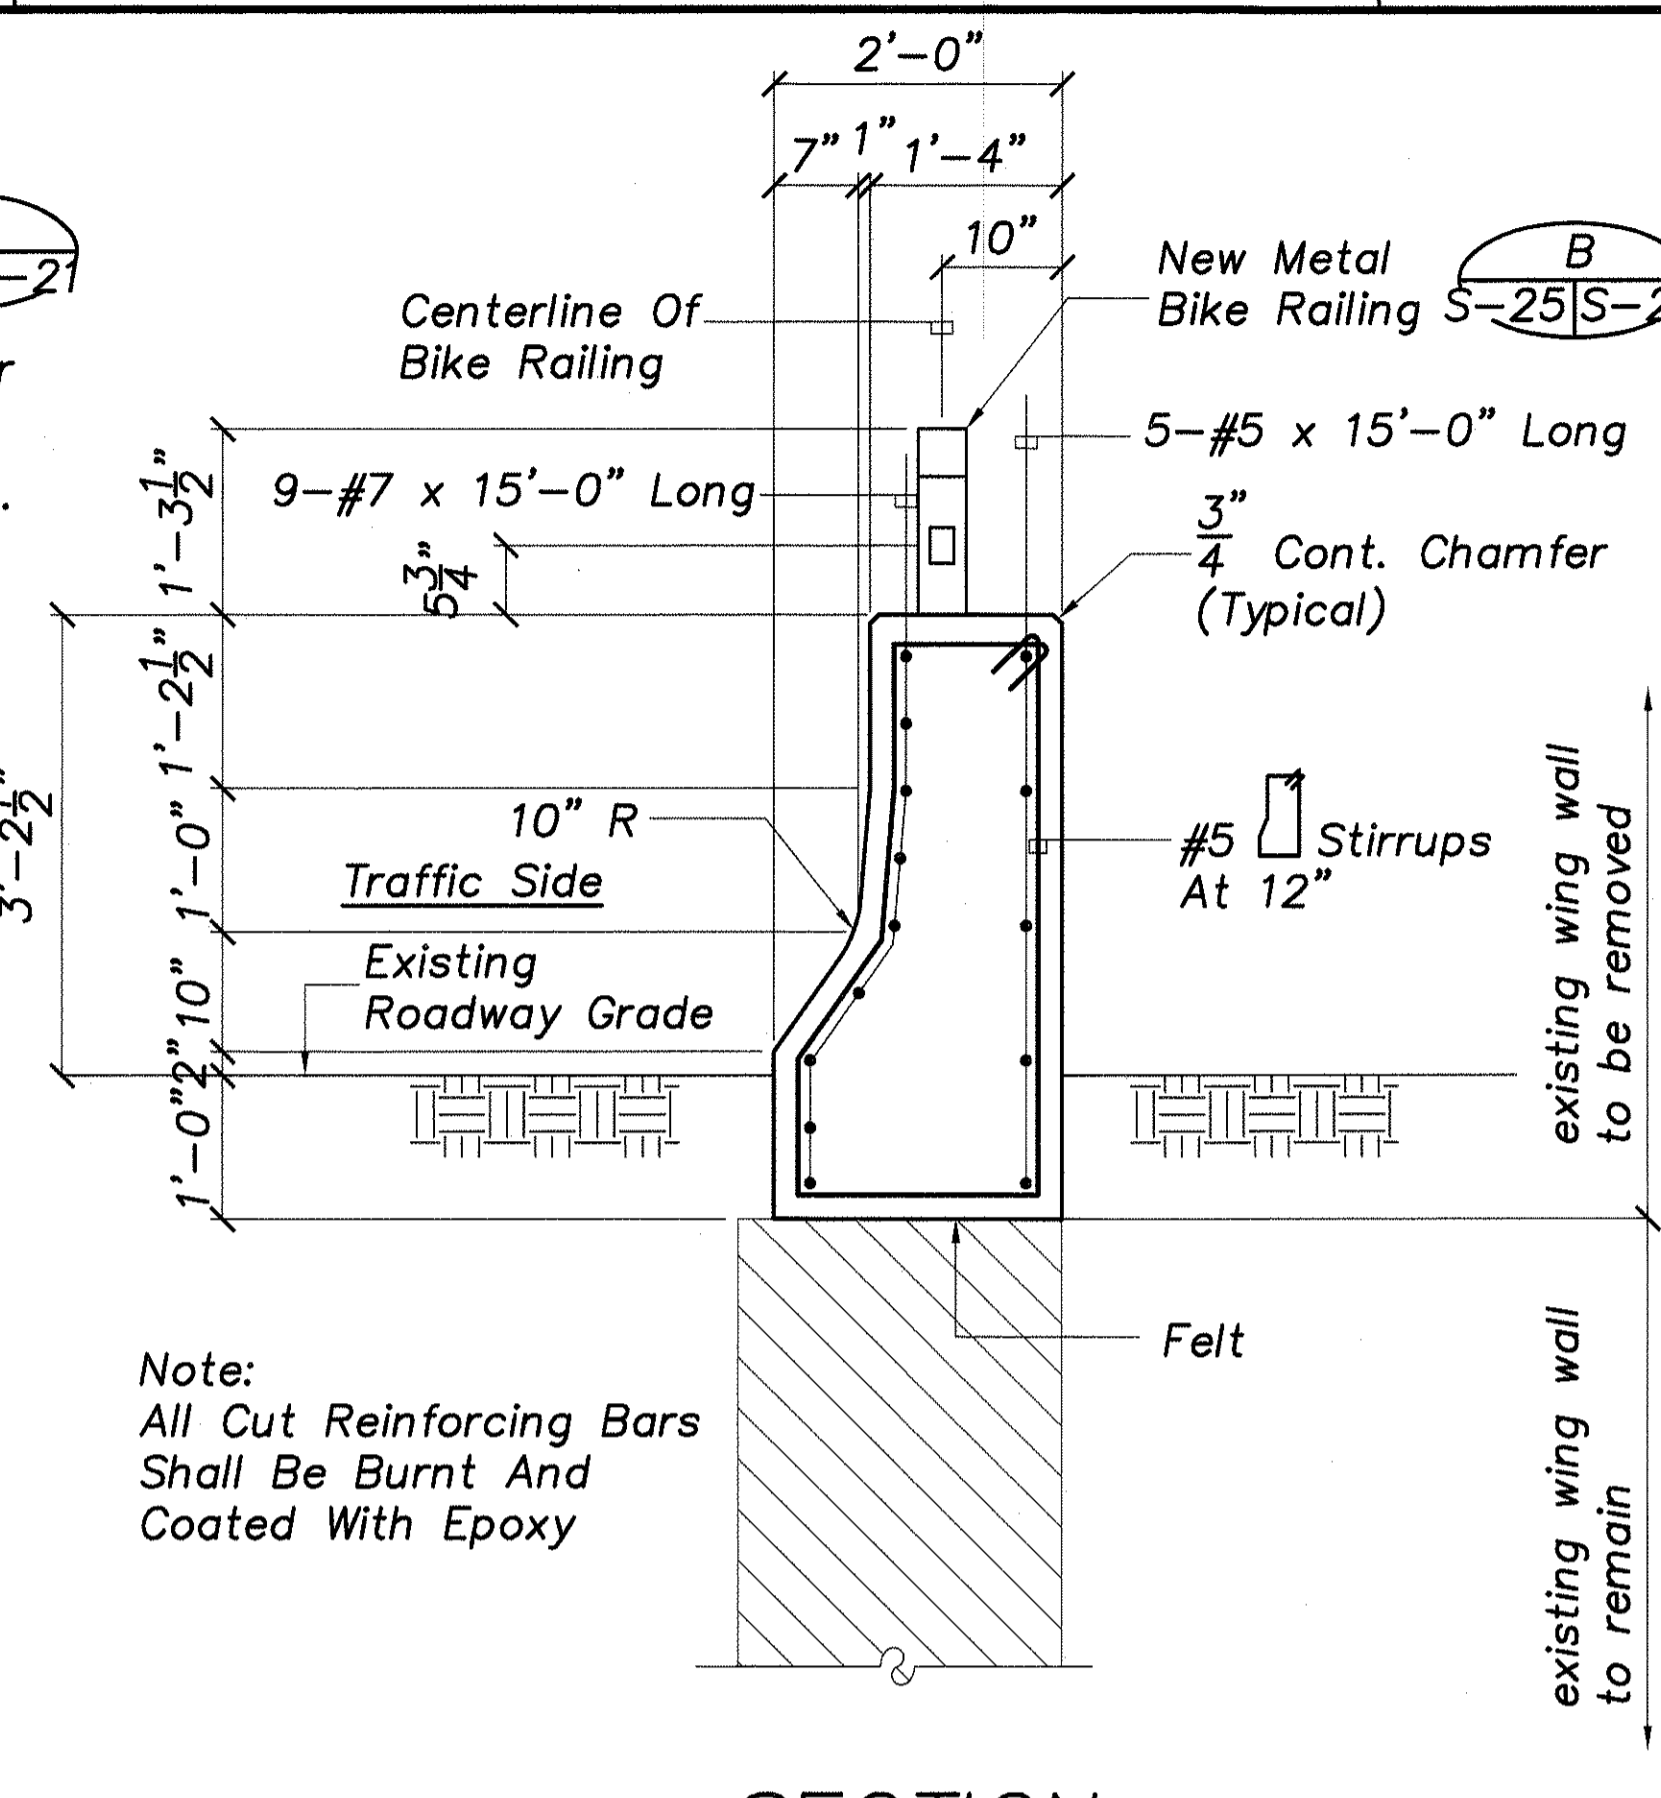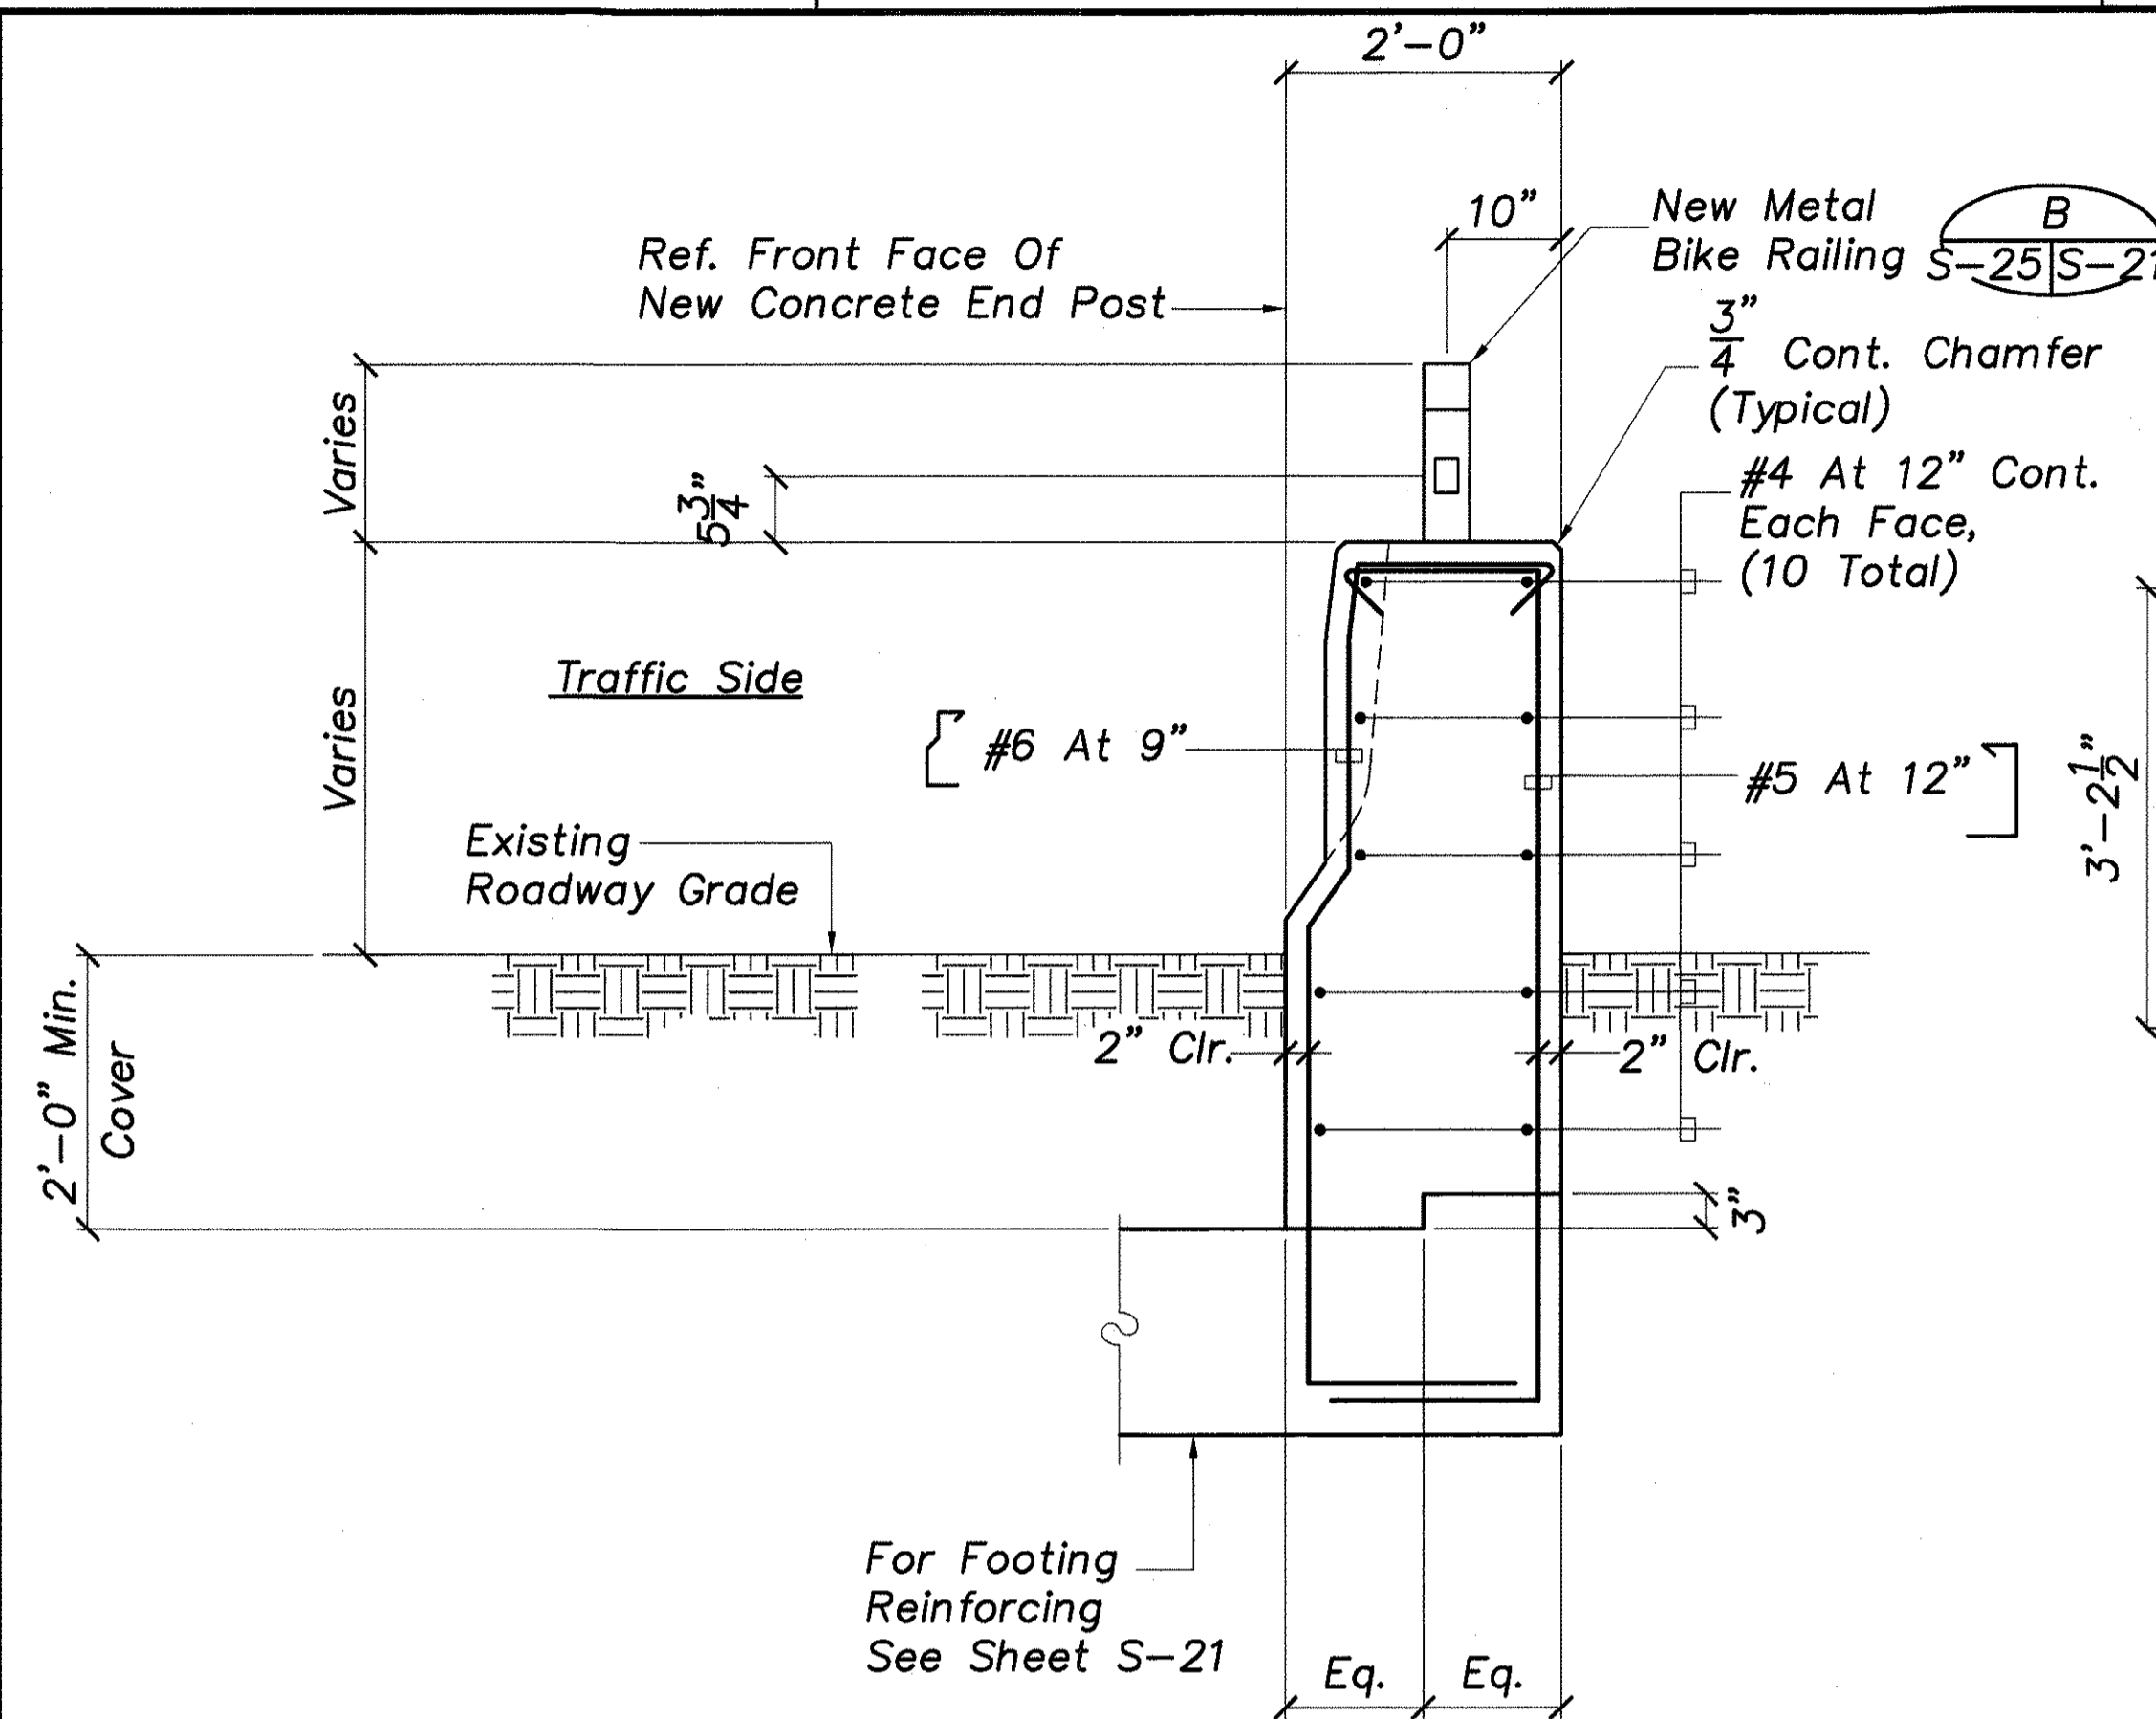

SURVEY PLANNED BY	DATE
DRAWN BY	
DESIGNED BY	
QUANTITIES BY	
CHECKED BY	
ORIGINAL PLAN	
NOTE BOOK	
NO.	

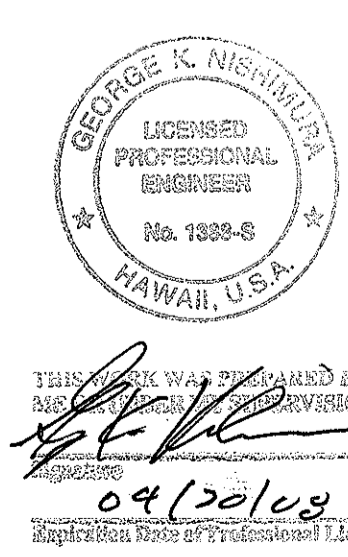

7/2/07	Revised Sections A, B, D, And E
Date	Revision
STATE OF HAWAII DEPARTMENT OF TRANSPORTATION HIGHWAYS DIVISION	
RETROFIT CONCRETE END POST DETAILS	
HALEAKALA HIGHWAY WIDENING, PHASE 2 HANA HIGHWAY TO PUKALANI BYPASS FED. AID PROJ. NO. NH-037-1(24)	
SCALE: AS NOTED	DATE: MAY 2005
SHEET No. S-25 OF 26 SHEETS	

