


FED. ROAD DIST. NO.	STATE	FED. AID PROJ. NO.	FISCAL YEAR	SHEET NO.	TOTAL SHEETS
HAWAII	HAW.	NH-037-1(22)	2002	42	72

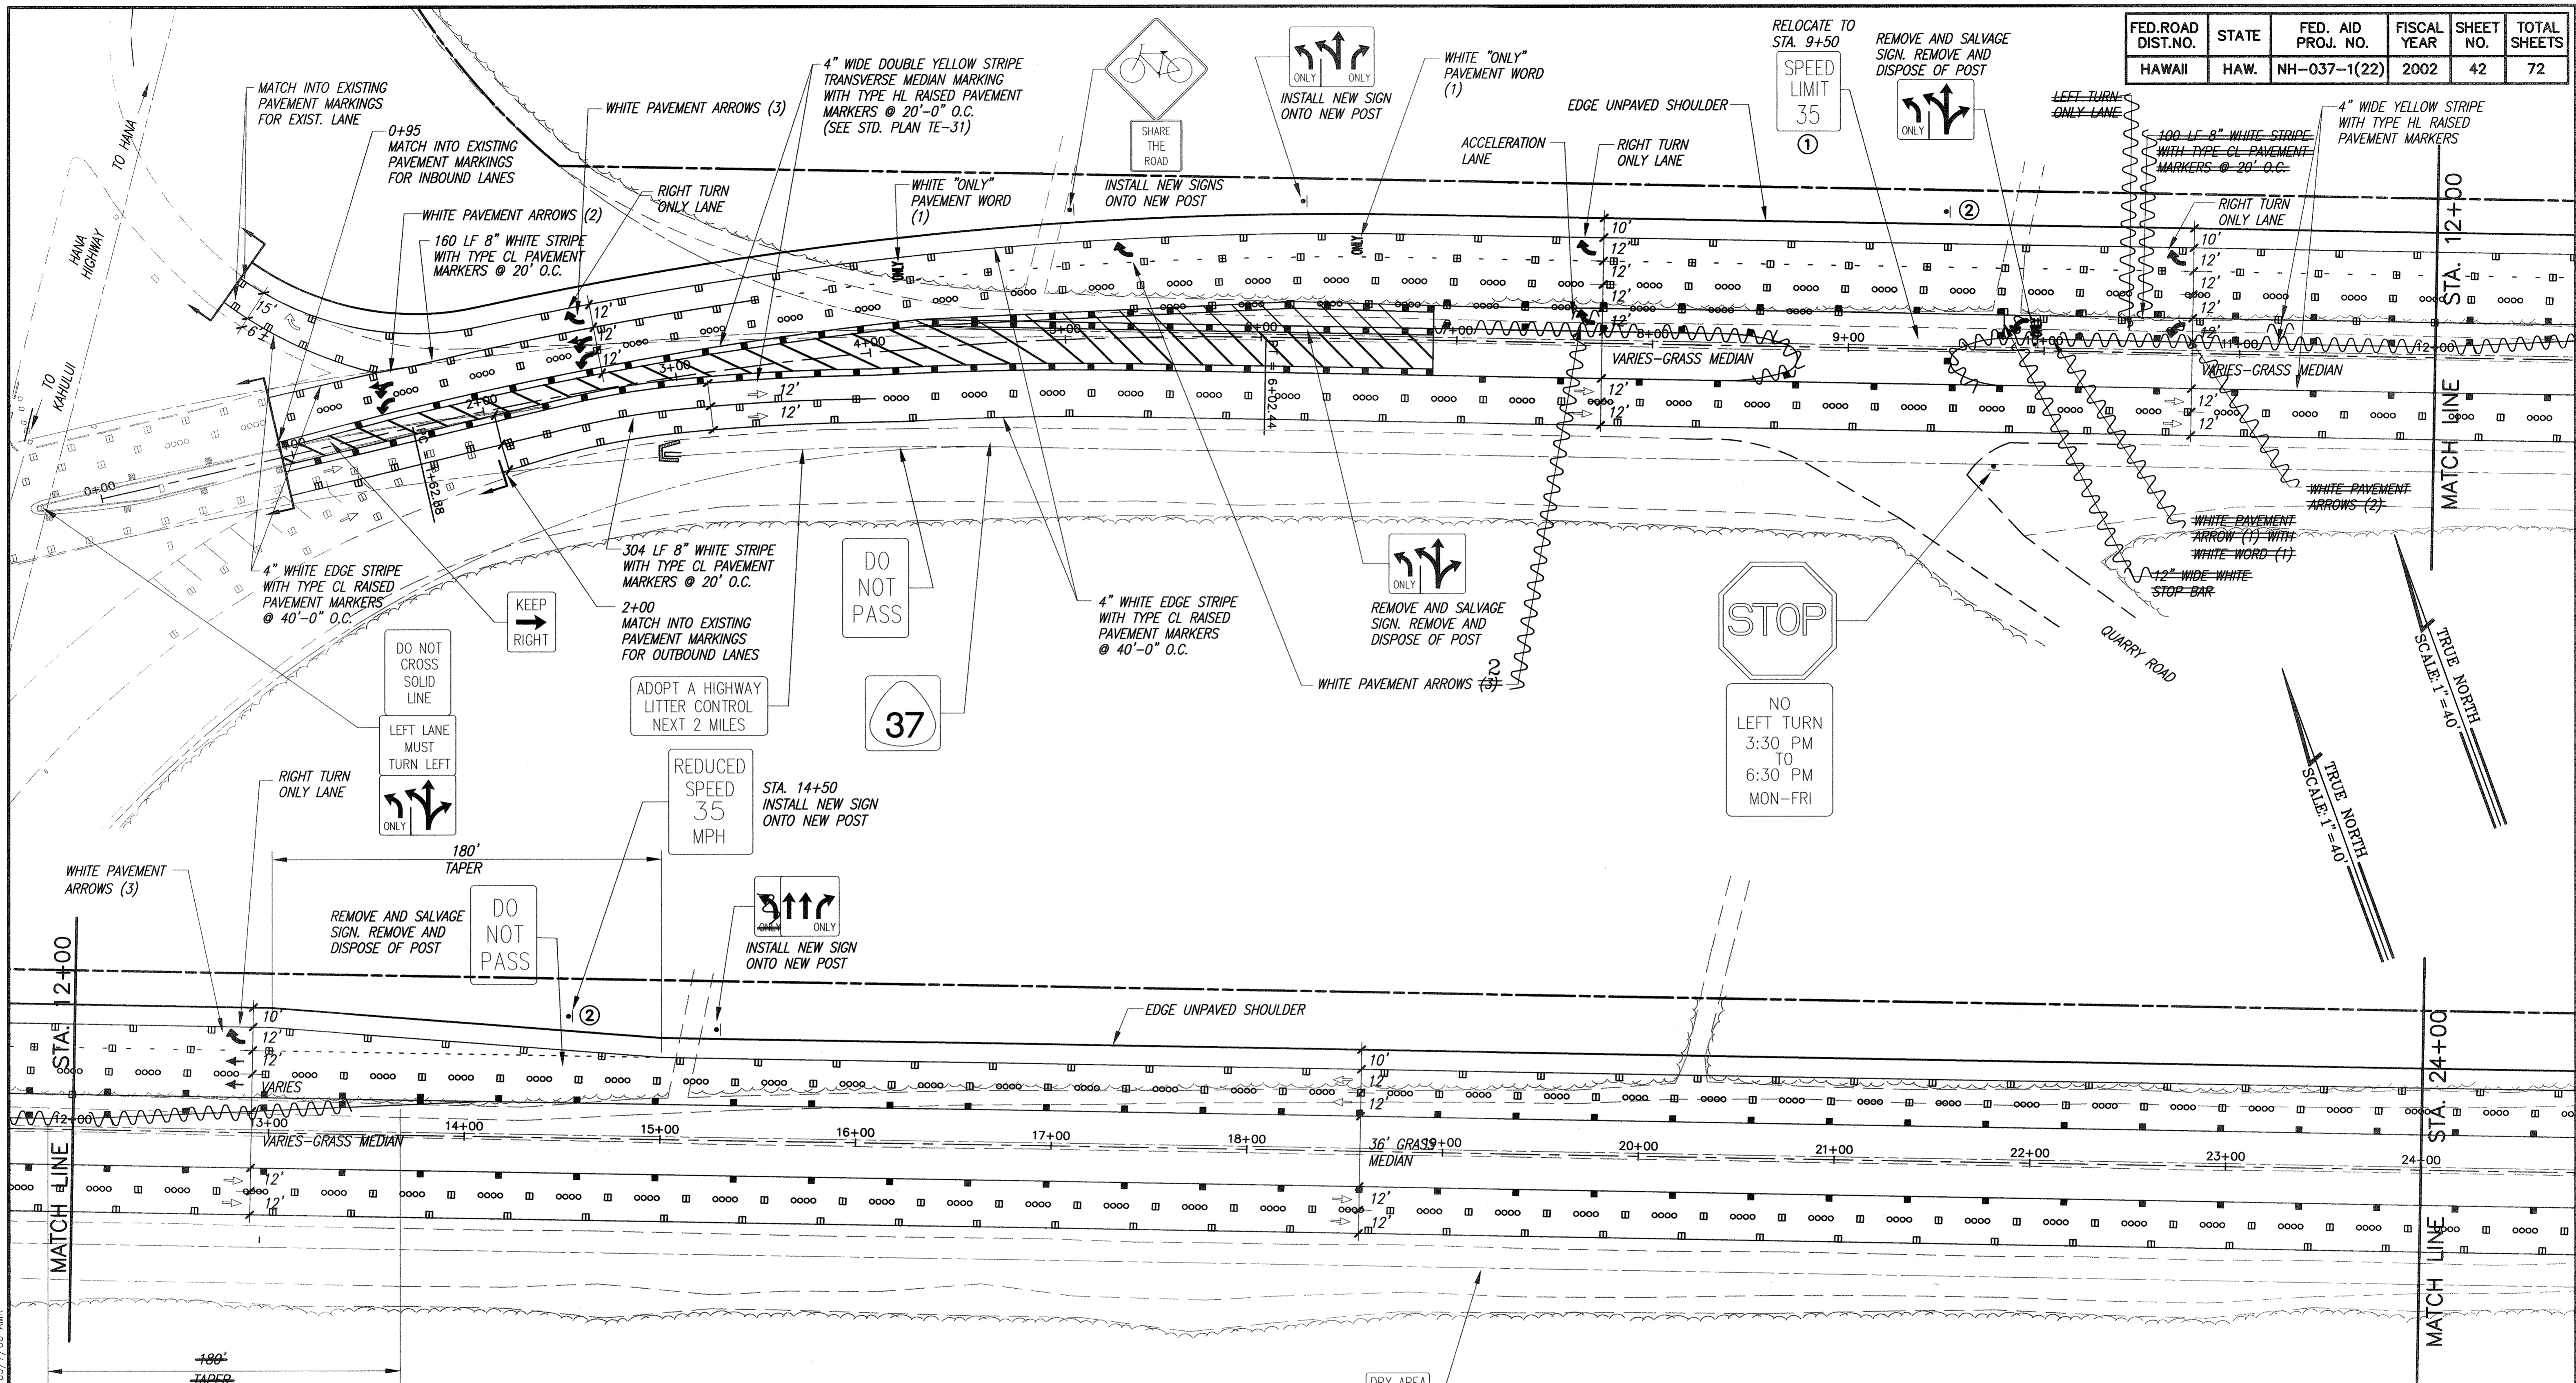

ORIGINAL PLAN	DATE
TRACED BY	
DESIGNED BY	
QUANTITIES BY	
CHECKED BY	
No.	


194-56 f:PH1-S1.dwg, d:PH1(STRIPE)(ESH-1) 1=1 09/17/06 AMR

- KEYNOTES**
- ① RELOCATE SIGN ONTO NEW SIGN POSTS.
 - ② NEW LOCATION FOR RELOCATED SIGN.

- SIGNAGE NOTES**
- 1. RELOCATE EXISTING SIGNS FOR INBOUND LANES ONTO NEW SIGN POSTS, TYPICAL.
 - 2. UNLESS OTHERWISE SPECIFIED, ALL EXISTING SIGNS FOR OUTBOUND LANES SHALL REMAIN IN PLACE, TYPICAL.

LEGEND FOR AS-BUILT POSTINGS

	Squiggly line for as-built deletion
	Double line for as-built deletion
Roadway	Text for as-built posting

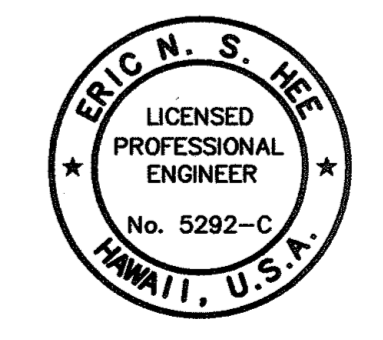

THIS WORK WAS PREPARED BY ME OR UNDER MY SUPERVISION.
Eric N. S. Hee
 ENGINEERS SURVEYORS HAWAII, INC.
 LICENSE EXPIRATION DATE: 4/30/04

STATE OF HAWAII
 DEPARTMENT OF TRANSPORTATION
 HIGHWAYS DIVISION

PAVEMENT MARKING PLAN

**HALEAKALA HIGHWAY WIDENING, PHASE I
 HANA HIGHWAY TO PUKALANI BYPASS
 FED. AID PROJ. NO. NH-037-1(22)**

SCALE: AS NOTED DATE: NOV., 2002

SHEET No. 1 OF 2 SHEETS

AS-BUILT

42

\\esr-1\ESH\Engineering\Projects\194-56\Haleakala Hwy\PHASE 1\FINAL\AS-BUILT\PH1-S1.dwg, Layout1, 3/28/2008 11:08:17 AM, 1:1

