


FED. ROAD DIST. NO.	STATE	FED. AID PROJ. NO.	FISCAL YEAR	SHEET NO.	TOTAL SHEETS
HAWAII	HAW.	STP-037-1(23)R	2005	8	22

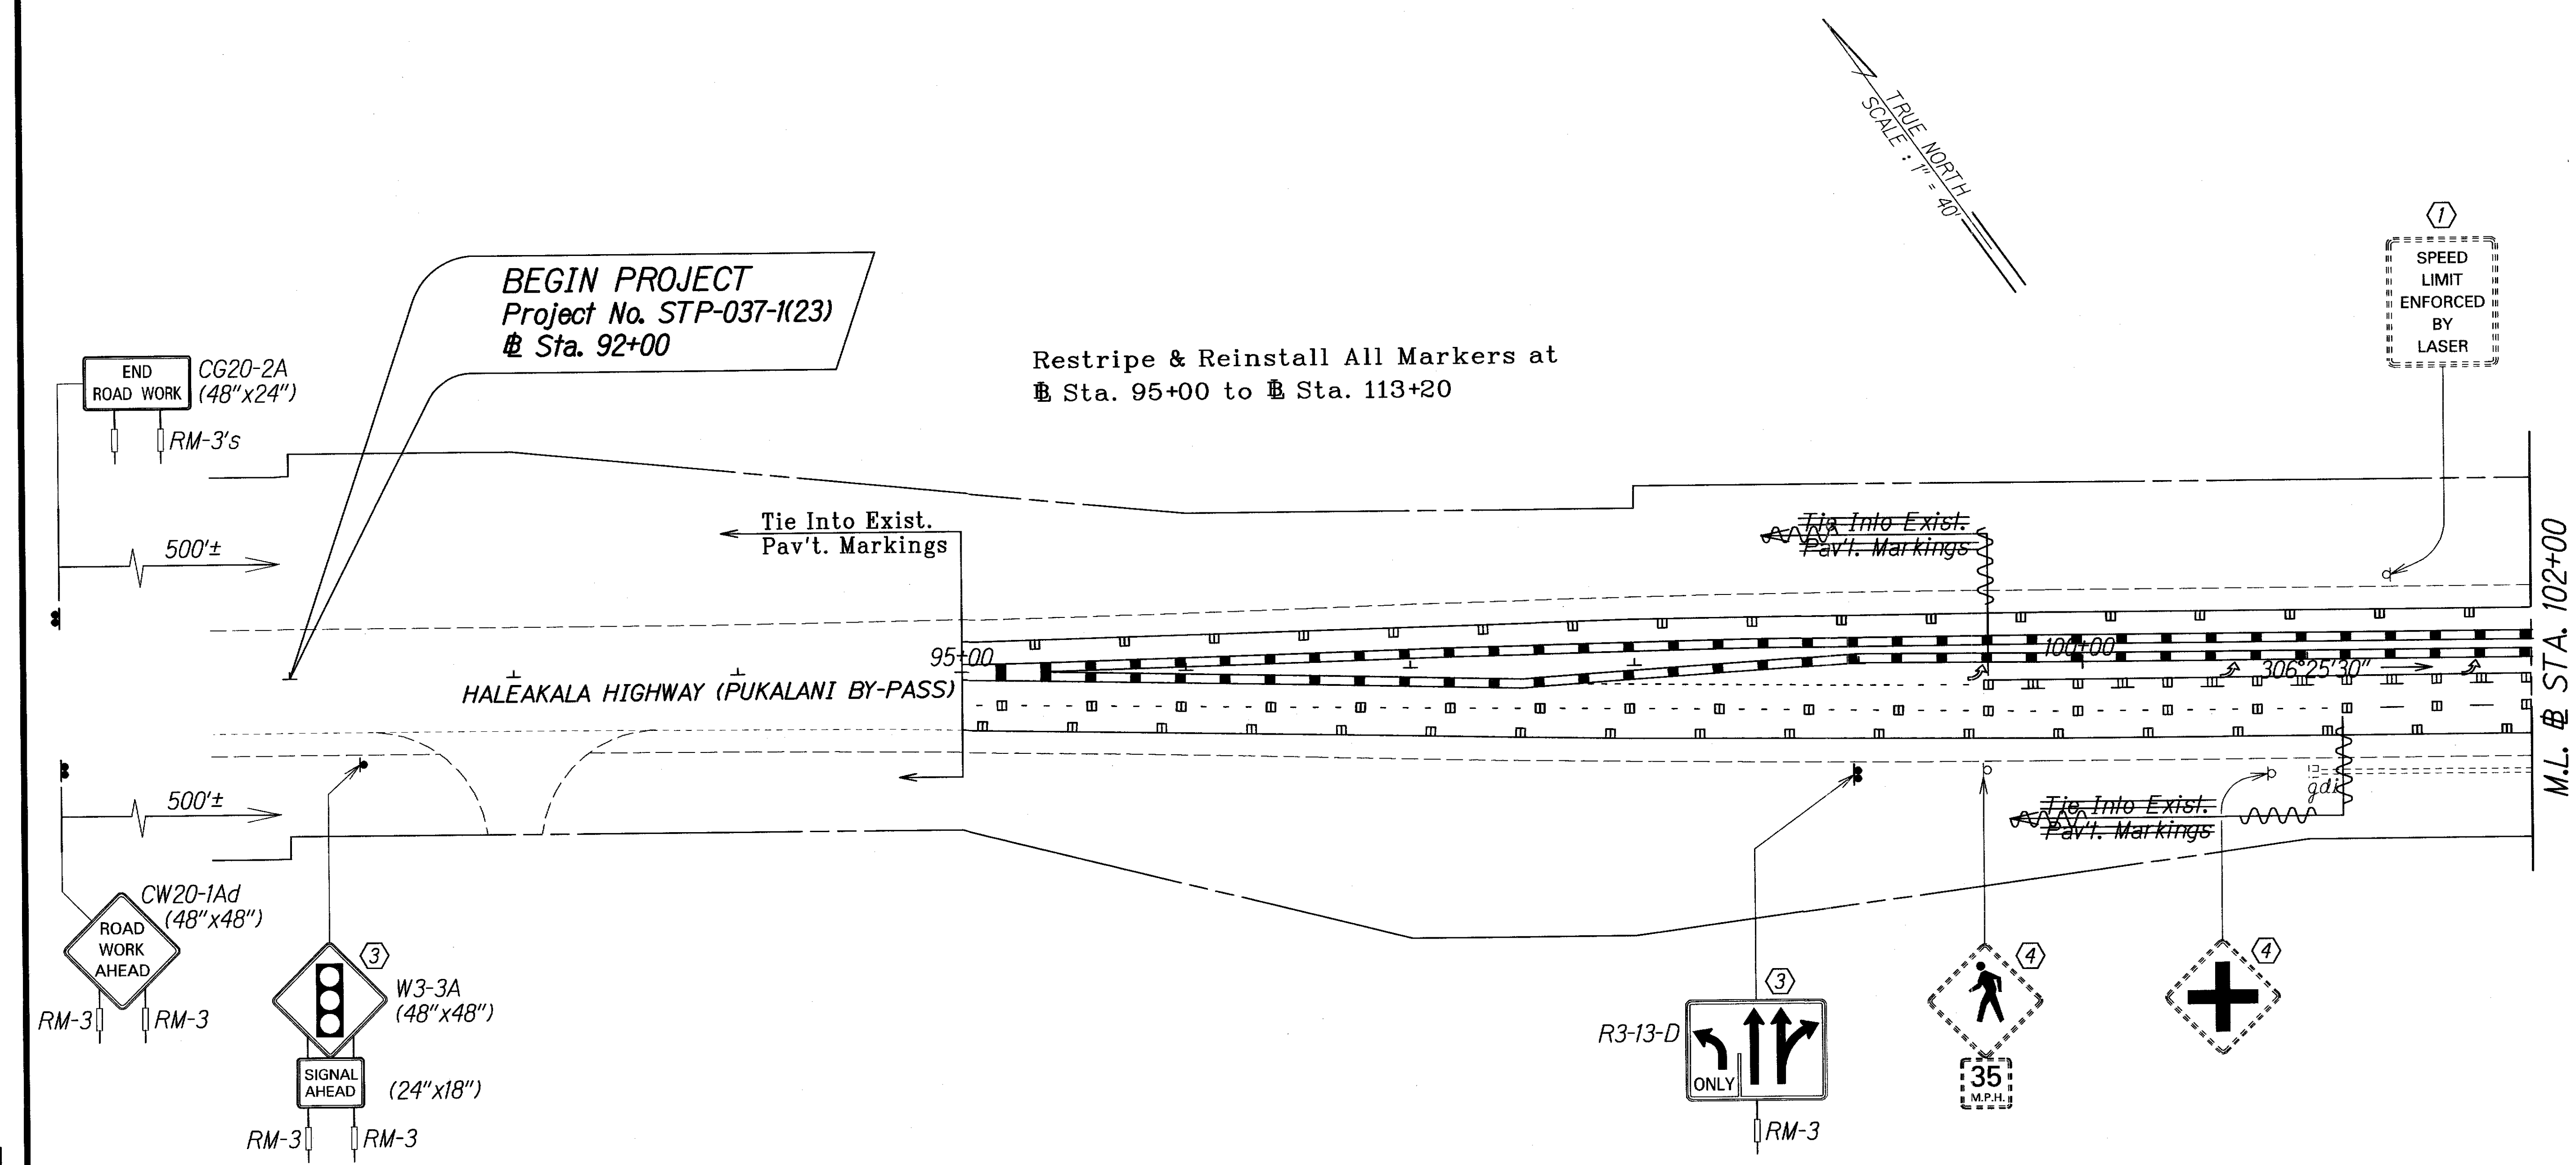

DATE: 3/21/05
SURVEY PLOTTED BY: J. Howells
ORIGINAL PLAN: J. Howells
NOTE BOOK: J. Howells
DESIGNED BY: J. Howells
CHECKED BY: J. Howells
DATE: 3/21/05

- KEY:**
- ① Exist. Sign(s) & Post(s) to Remain
  - ② Remove Exist. Sign(s) w/Post(s) & Install New Sign(s) w/Post(s)
  - ③ Install New Sign(s) w/Post(s)
  - ④ Remove Exist. Sign(s) w/Post(s)

**LEGEND FOR AS-BUILT POSTINGS**

	Squiggly line for as-built deletion
	Double line for as-built deletion
Roadway	Text for as-built posting


STATE OF HAWAII  
DEPARTMENT OF TRANSPORTATION  
HIGHWAYS DIVISION

**PAVEMENT MARKING & SIGNING PLAN**

HALEAKALA HIGHWAY  
Intersection Improvements at Makani Road  
F.A. Project No. STP-037-1(23)R  
Scale: 1" = 40' Date: May 2005  
SHEET No. 72 OF 7 SHEETS

"AS-BUILT"

FED. ROAD DIST. NO.	STATE	FED. AID PROJ. NO.	FISCAL YEAR	SHEET NO.	TOTAL SHEETS
HAWAII	HAW.	STP-037-1(23)R	2005	9	22

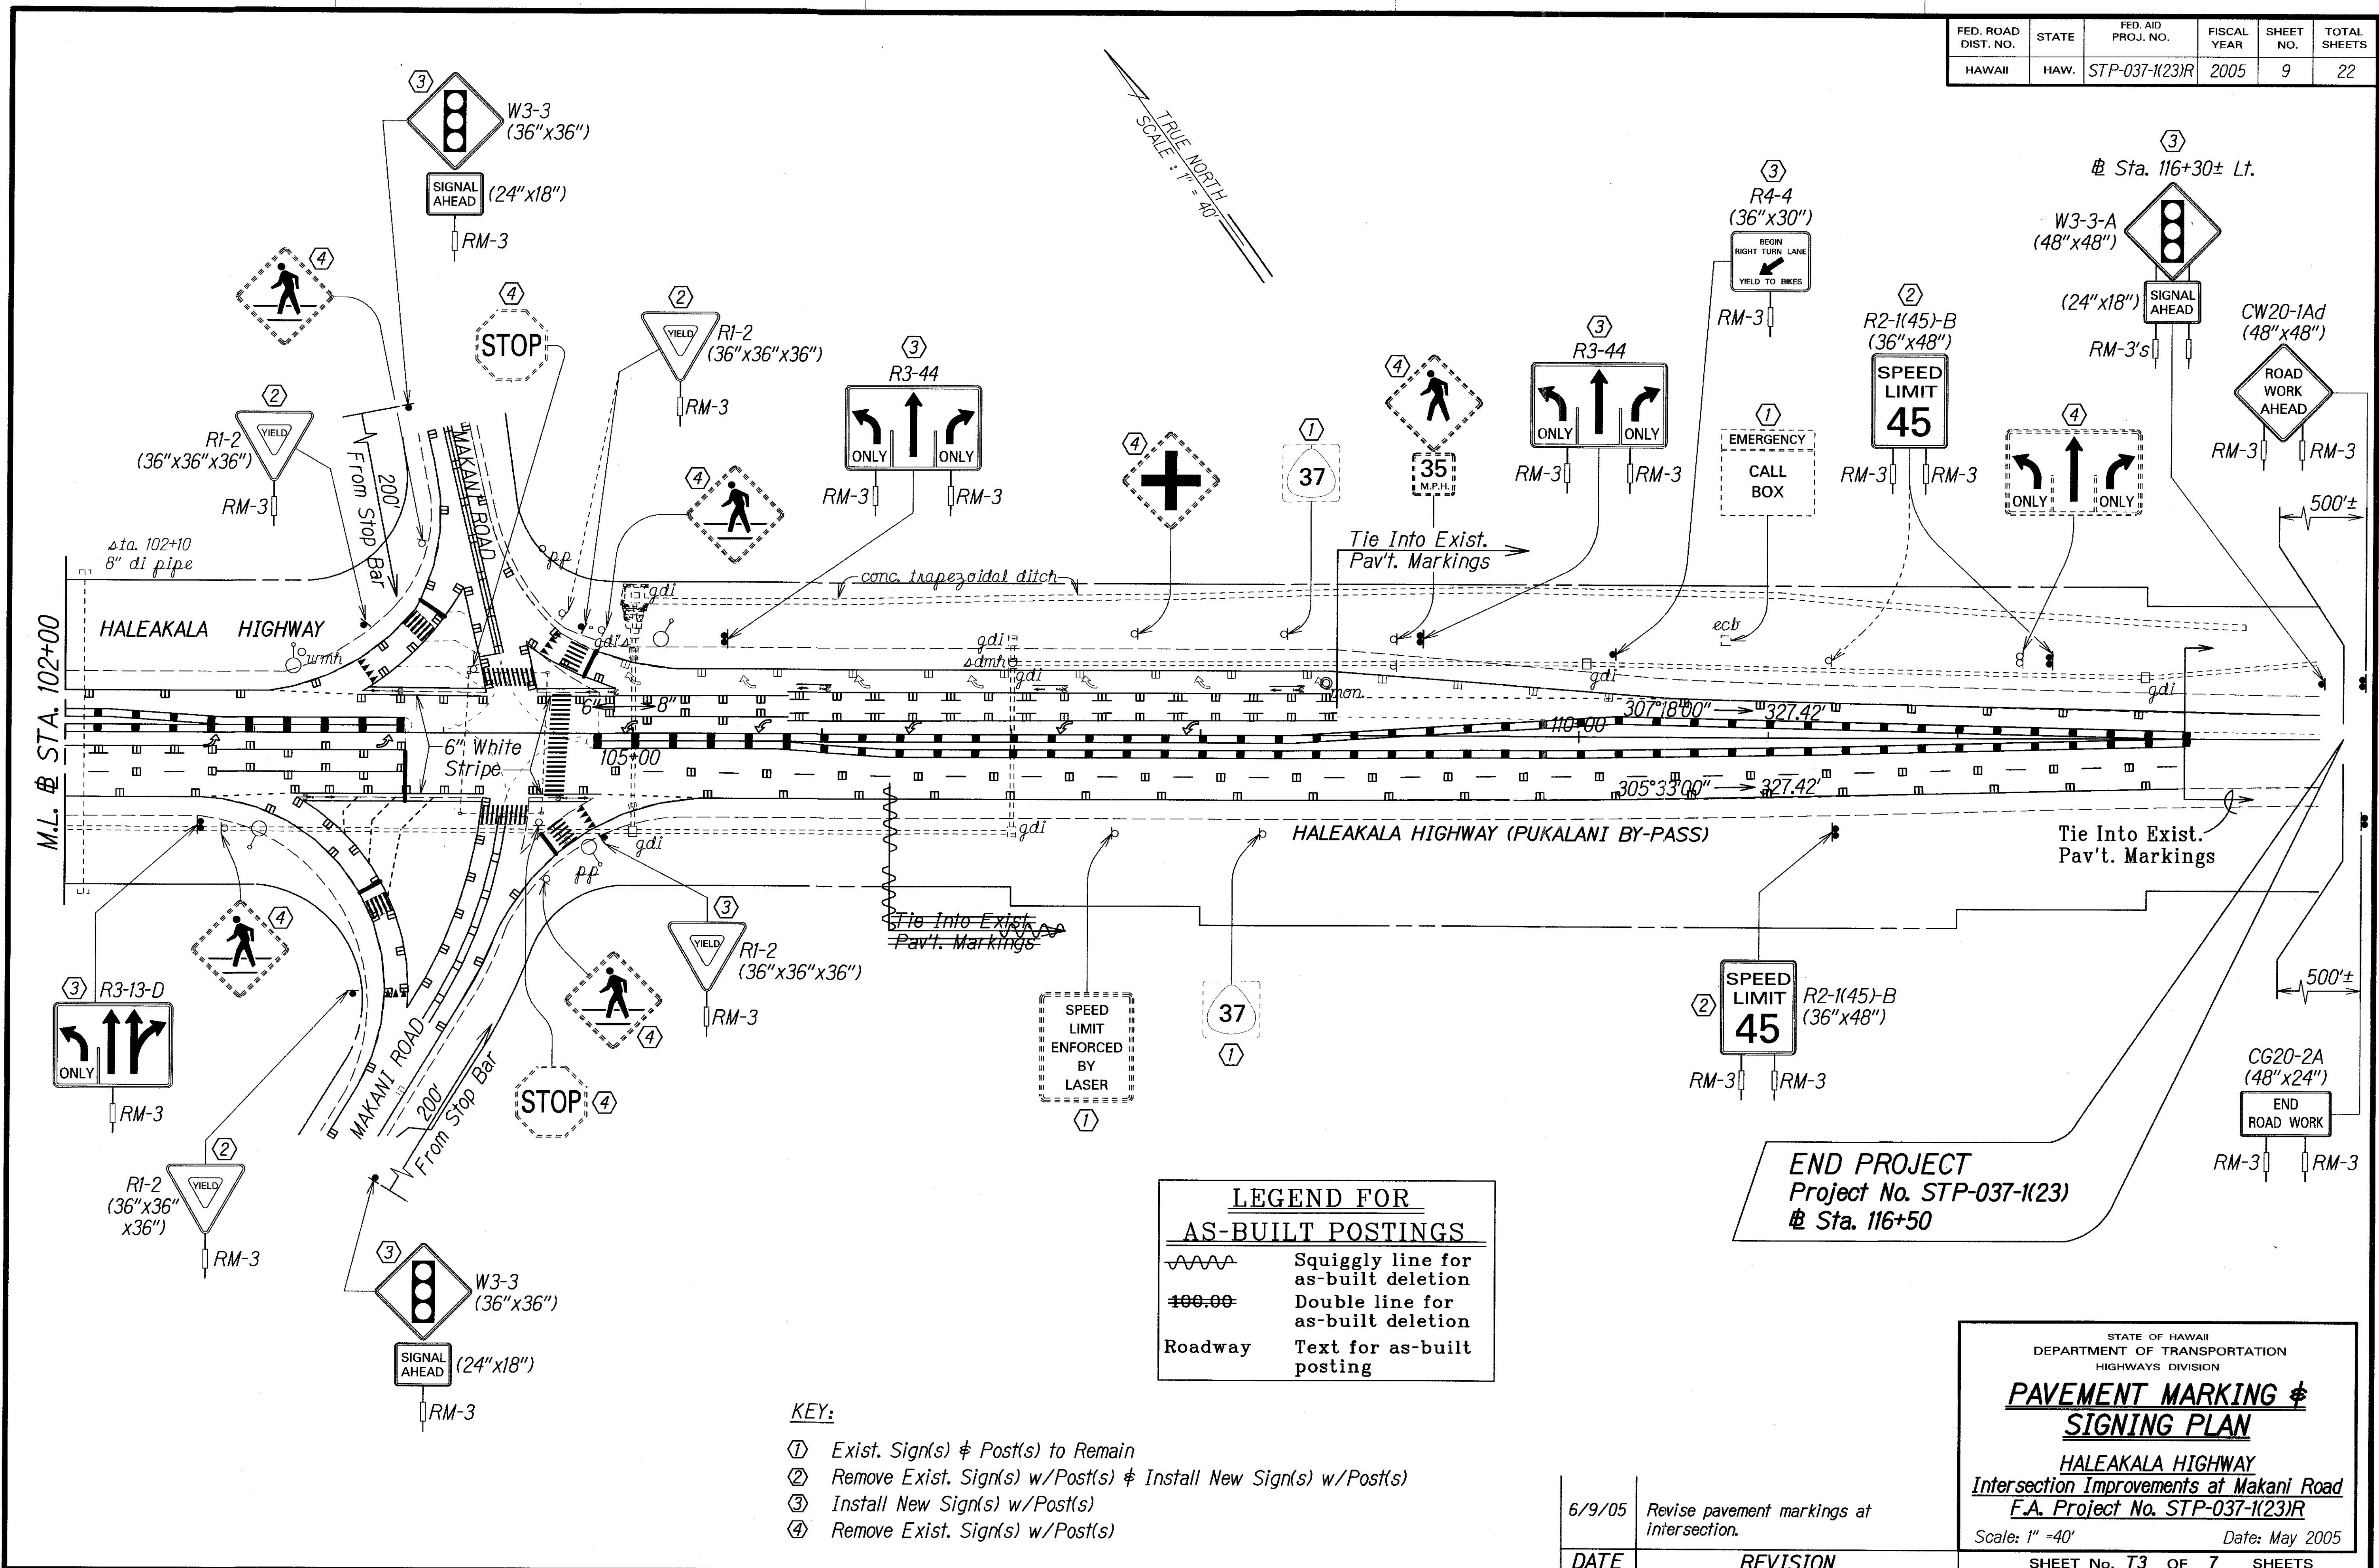

**LEGEND FOR AS-BUILT POSTINGS**

	Squiggly line for as-built deletion
	Double line for as-built deletion
Roadway	Text for as-built posting

- KEY:**
- ① Exist. Sign(s) & Post(s) to Remain
  - ② Remove Exist. Sign(s) w/Post(s) & Install New Sign(s) w/Post(s)
  - ③ Install New Sign(s) w/Post(s)
  - ④ Remove Exist. Sign(s) w/Post(s)

SURVEY PLOTTED BY	DATE
DRAWN BY	
DESIGNED BY	
QUANTITIES BY	
CHECKED BY	
ORIGINAL PLAN	
NOTE BOOK	
TELEPHONE	
CHECKED BY	

6/9/05	Revise pavement markings at intersection.
DATE	REVISION

STATE OF HAWAII  
DEPARTMENT OF TRANSPORTATION  
HIGHWAYS DIVISION

**PAVEMENT MARKING & SIGNING PLAN**

**HALEAKALA HIGHWAY**  
Intersection Improvements at Makani Road  
F.A. Project No. STP-037-1(23)R

Scale: 1" = 40' Date: May 2005

SHEET No. T3 OF 7 SHEETS