


TRAFFIC SIGNAL HEAD SCHEDULE				
Traffic Signal Head Type & Description				
Pole Letter Signal Head Number	A-1 A-2 C-3 C-5 D-3	B-2 B-3 D-2 D-4	A-3 B-1* C-2 D-1*	A-4 B-4 C-1 C-4 D-5 D-6

* With Programmed Visibility

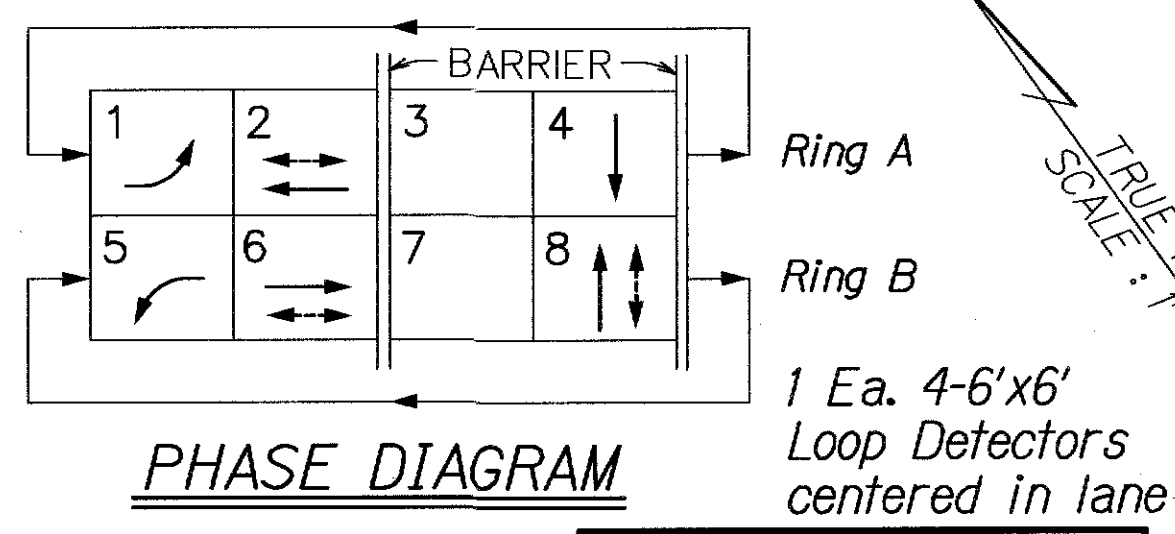

CONDUIT	CABLE
2"	1-2C #14
2"	SPARE
2"	SPARE

CONDUIT	CABLE
2"	1-2C #14


CONDUIT	CABLE
2"	2-EVP CABLE
2"	SPARE

CONDUIT	CABLE
2"	1-2C #14/1-EVP CABLE
2"	1-26C #14
2"	SPARE

CONDUIT	CABLE
2"	2-2C #14

CONDUIT	CABLE
2"	1-2C #14

- NOTE:
1. All Conduits shall be Schedule 80, unless otherwise noted.
 2. All Sidewalks shall provide a minimum clear width of 3'-0" (excluding curb) for pedestrian circulation.
 3. Where necessary, existing pullboxes, handholes, manholes, etc. shall be adjusted to match pavement grade along the pedestrian route. Adjustments shall not be paid for separately but shall be considered incidental to the various traffic signal items unless indicated otherwise.

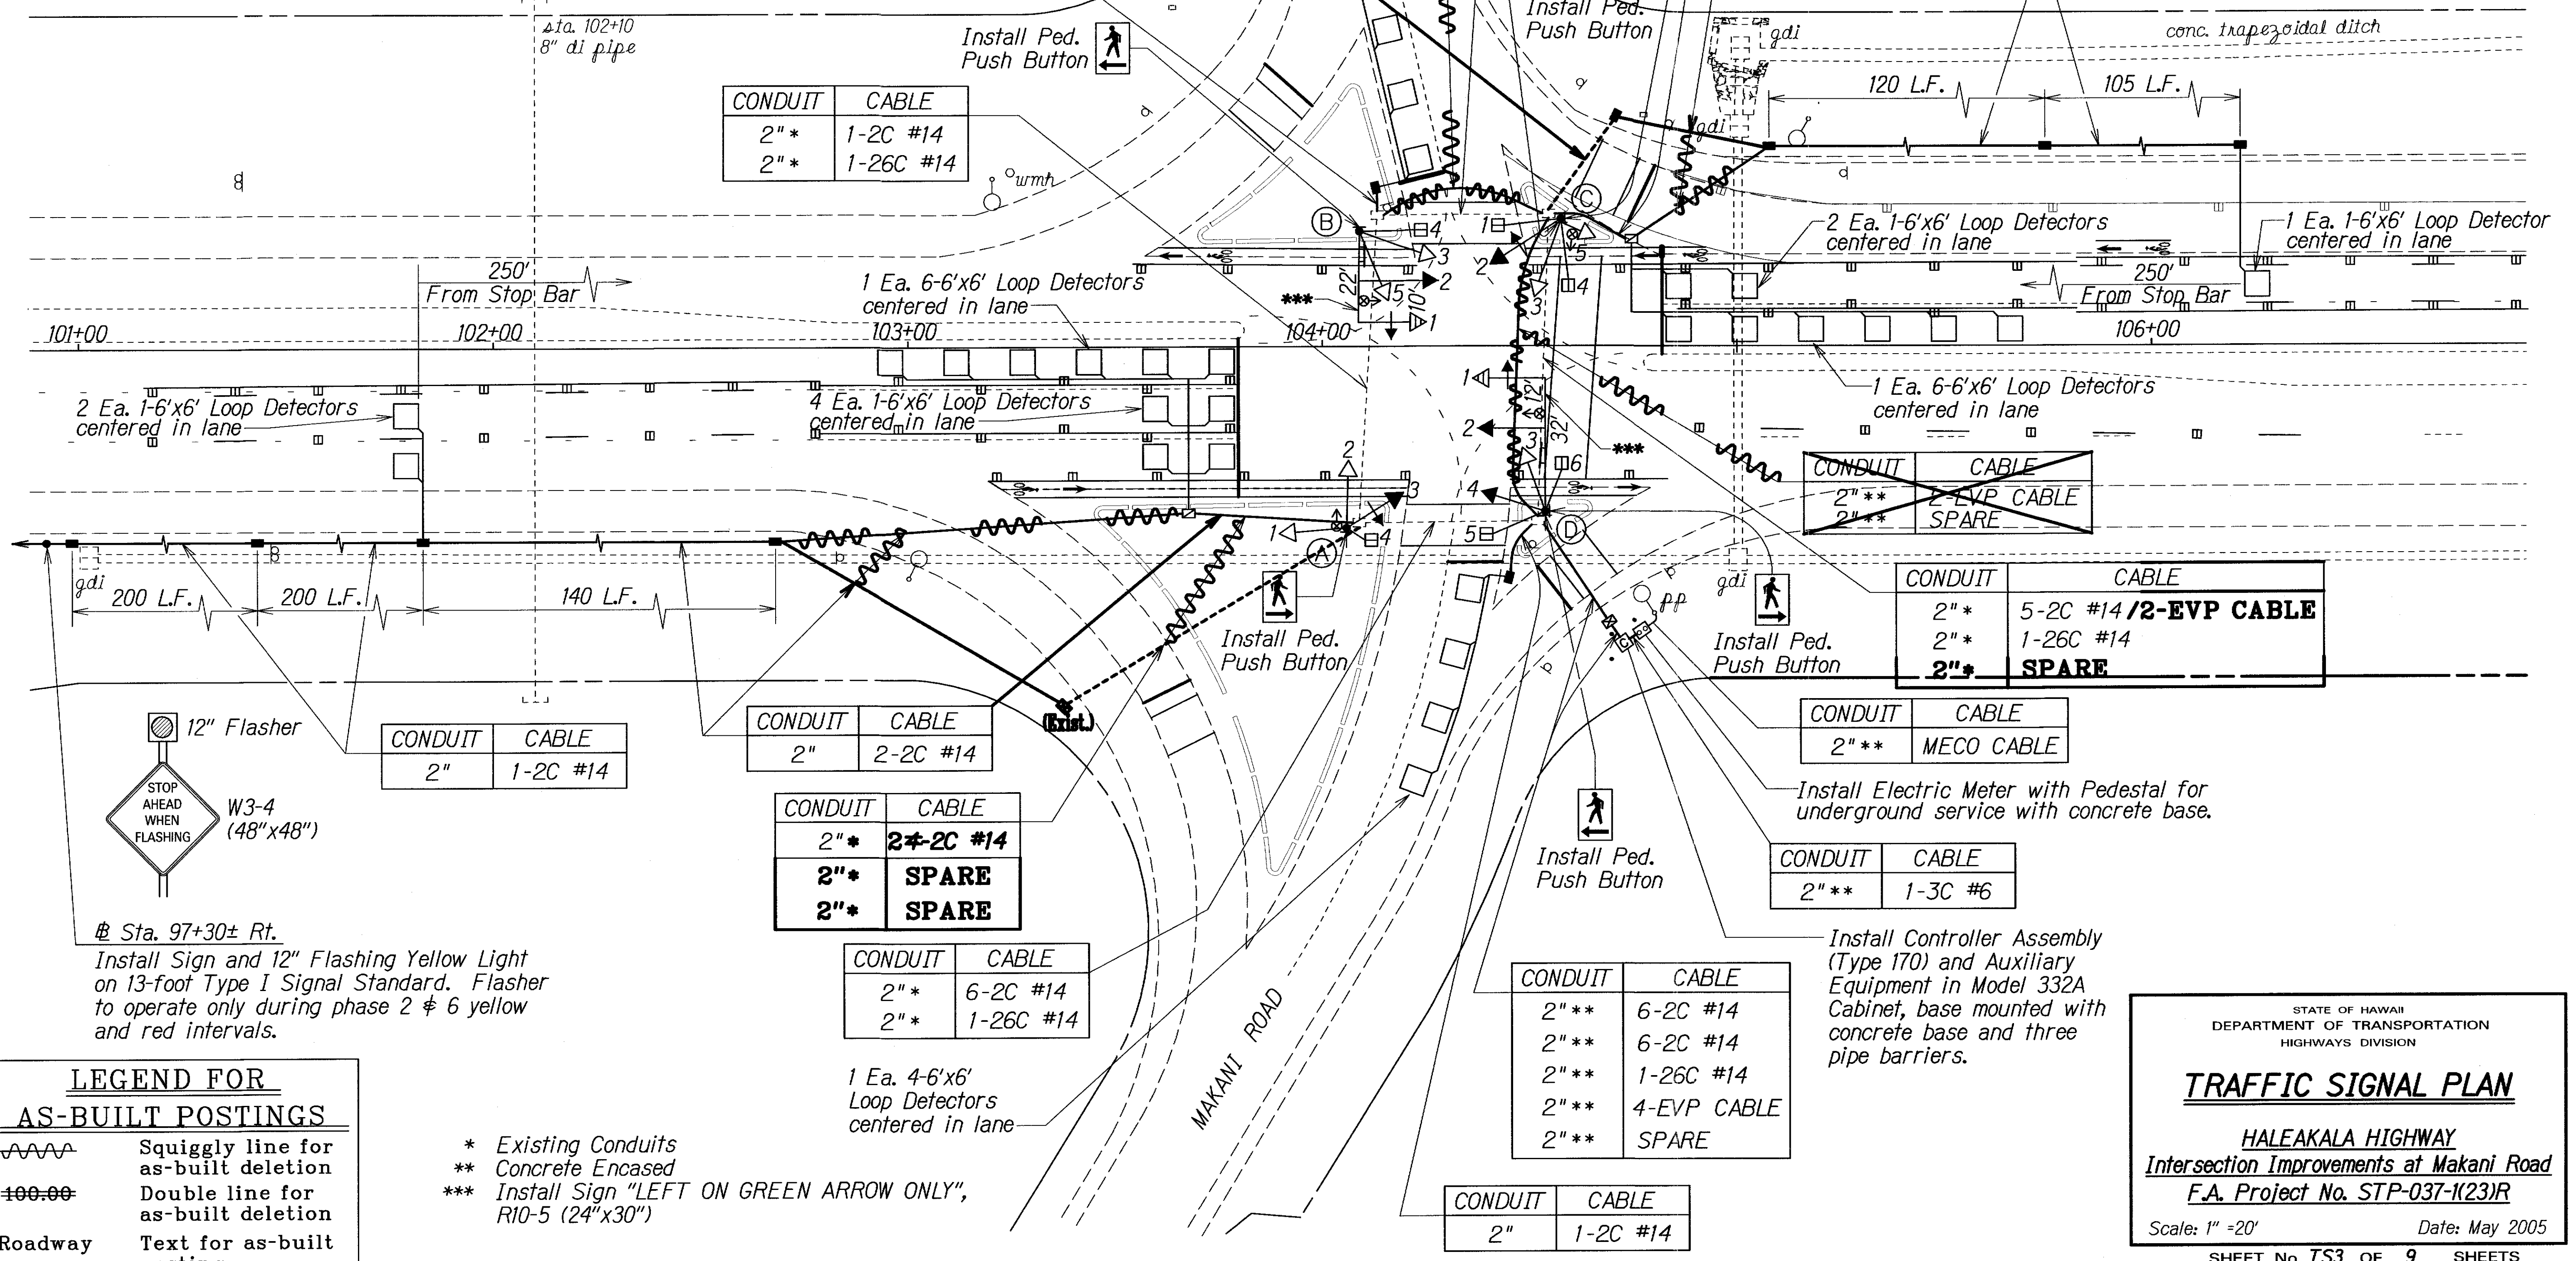

LEGEND FOR AS-BUILT POSTINGS	
	Squiggly line for as-built deletion
	Double line for as-built deletion
	Text for as-built posting

- * Existing Conduits
- ** Concrete Encased
- *** Install Sign "LEFT ON GREEN ARROW ONLY", R10-5 (24"x30")

STATE OF HAWAII
DEPARTMENT OF TRANSPORTATION
HIGHWAYS DIVISION

TRAFFIC SIGNAL PLAN

HALEAKALA HIGHWAY
Intersection Improvements at Makani Road
F.A. Project No. STP-037-1(23)R

Scale: 1" = 20' Date: May 2005

SHEET No. TS3 OF 9 SHEETS