



FED. ROAD DIST. NO.	STATE	PROJ. NO.	FISCAL YEAR	SHEET NO.	TOTAL SHEETS
HAWAII	HAW.	37C-01-07M	2007	6	10

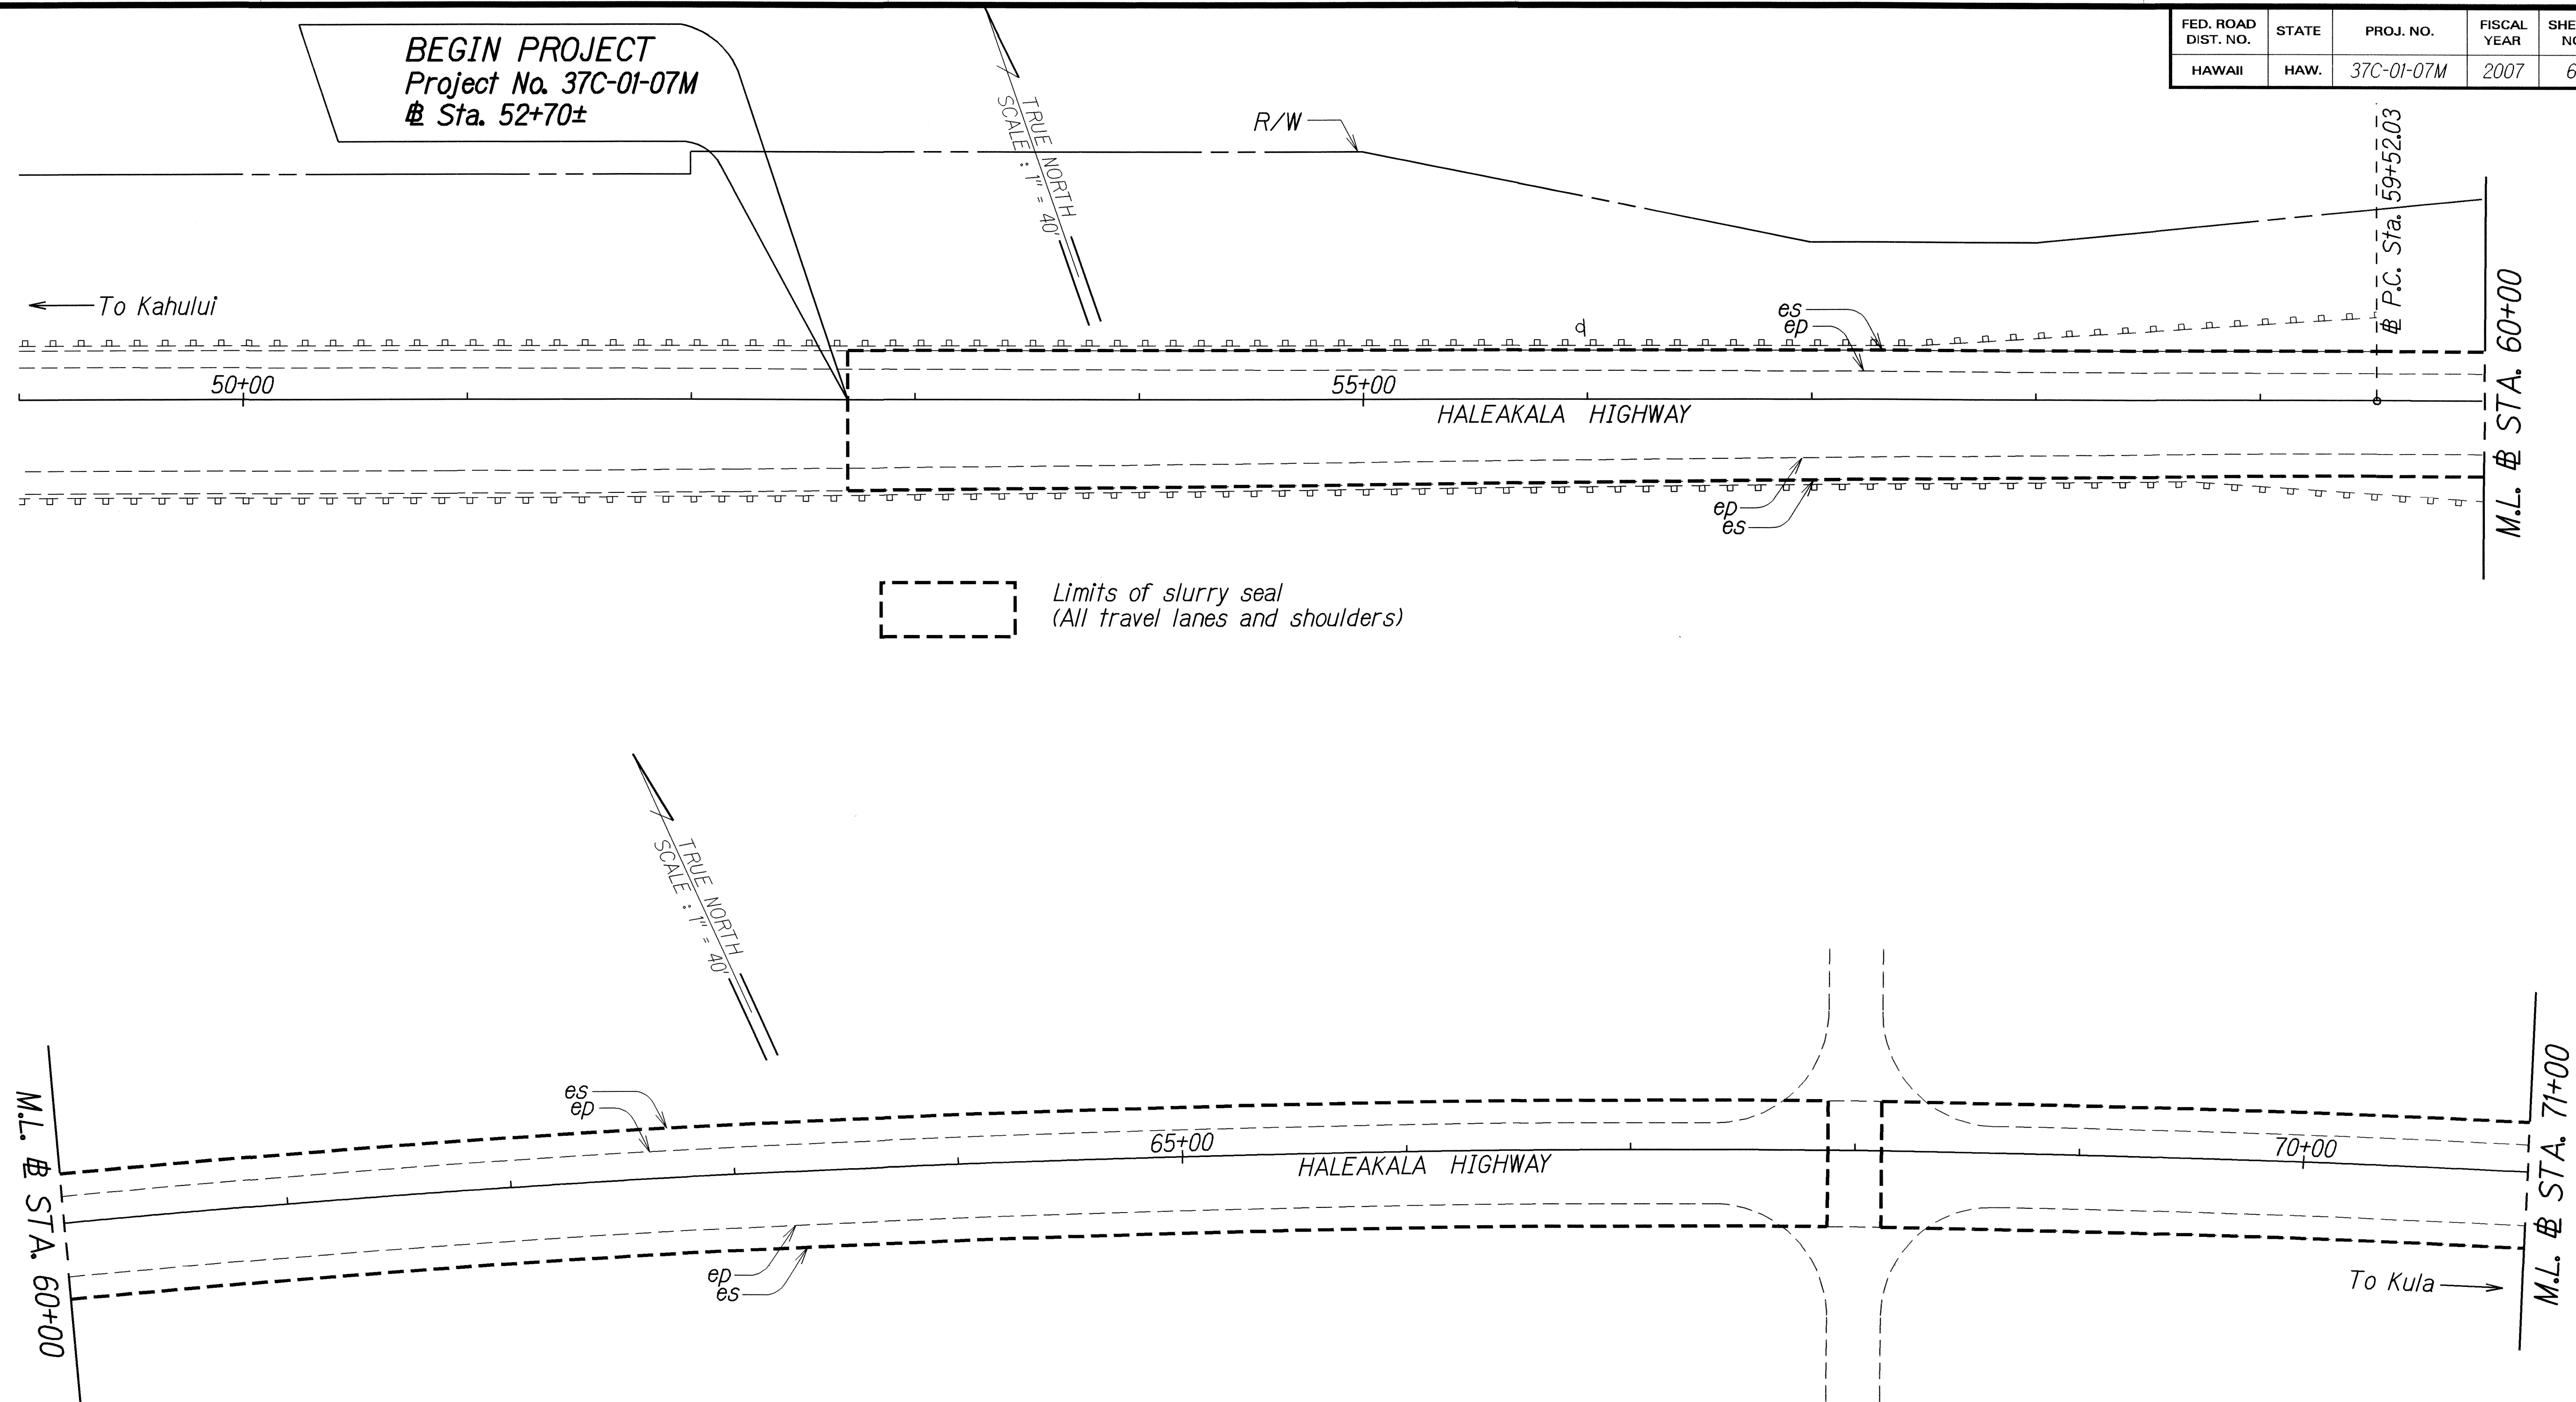

ORIGINAL PLAN	DATE
DESIGNED BY	
TRACED BY	
DESIGNED BY	
QUANTITIES BY	
CHECKED BY	

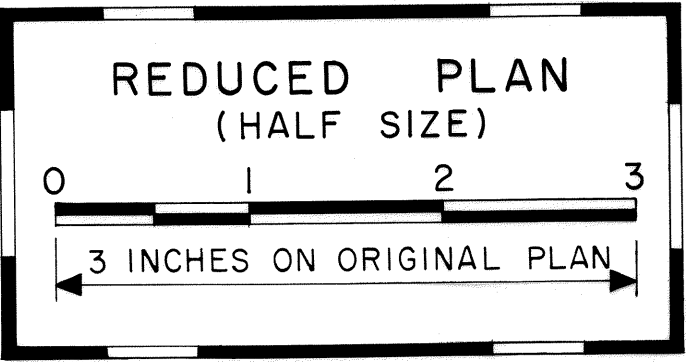

STATE OF HAWAII
DEPARTMENT OF TRANSPORTATION
HIGHWAYS DIVISION



ROADWAY PLAN

**HALEAKALA HIGHWAY PAVEMENT
PREVENTIVE MAINTENANCE**
Vicinity of Pukalani Junction to Five Trees
(M.P. 5.70 to M.P. 7.76)
Project No. 37C-01-07M


Scale: 1" = 40' Date: May, 2007

SHEET No. 1 OF 5 SHEETS

FED. ROAD DIST. NO.	STATE	PROJ. NO.	FISCAL YEAR	SHEET NO.	TOTAL SHEETS
HAWAII	HAW.	37C-01-07M	2007	7	10

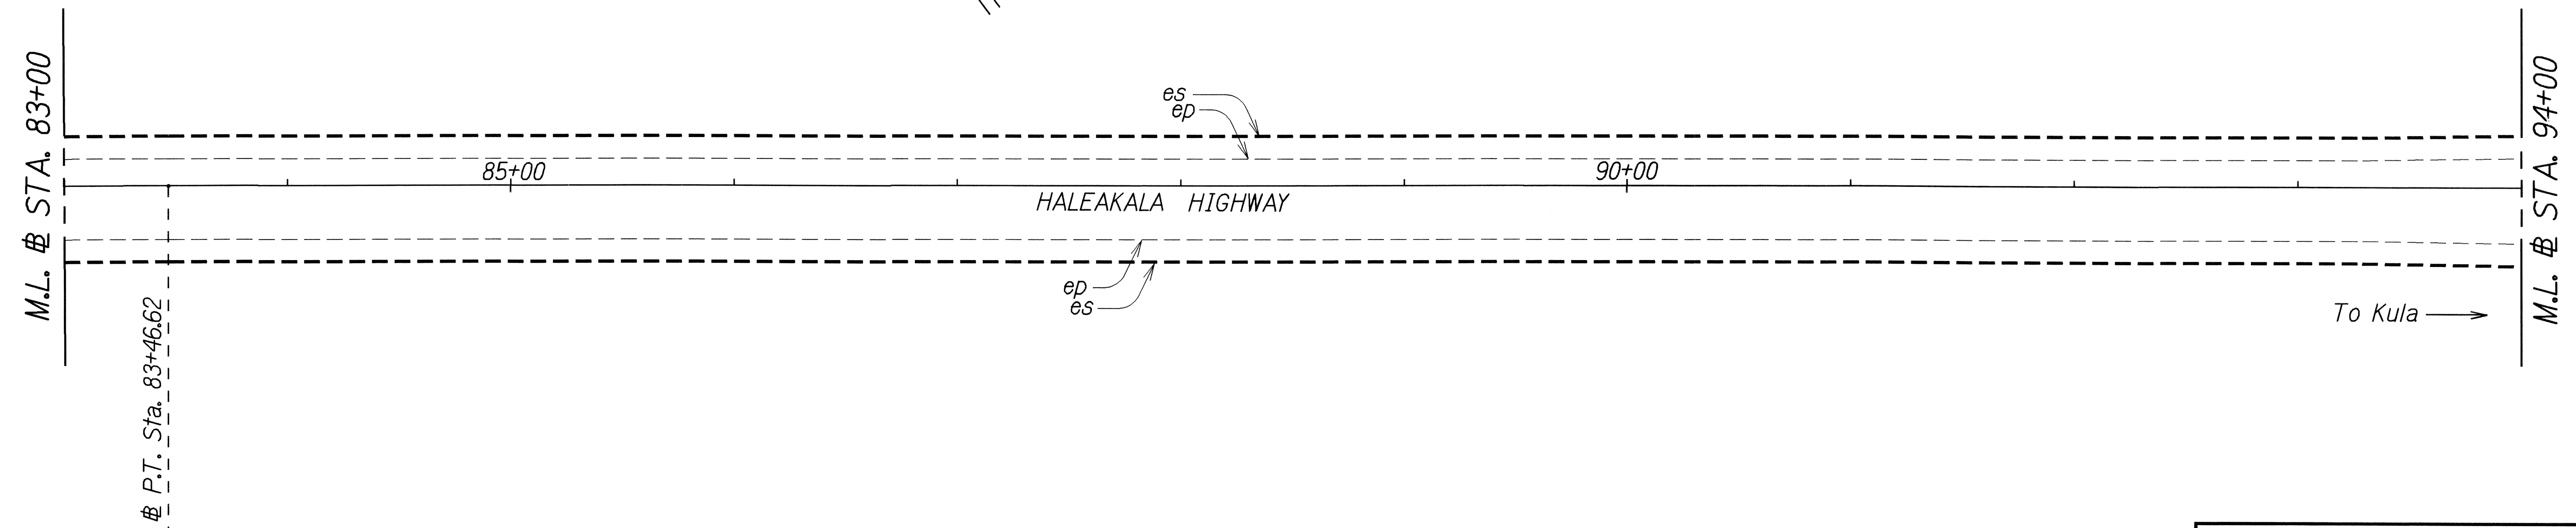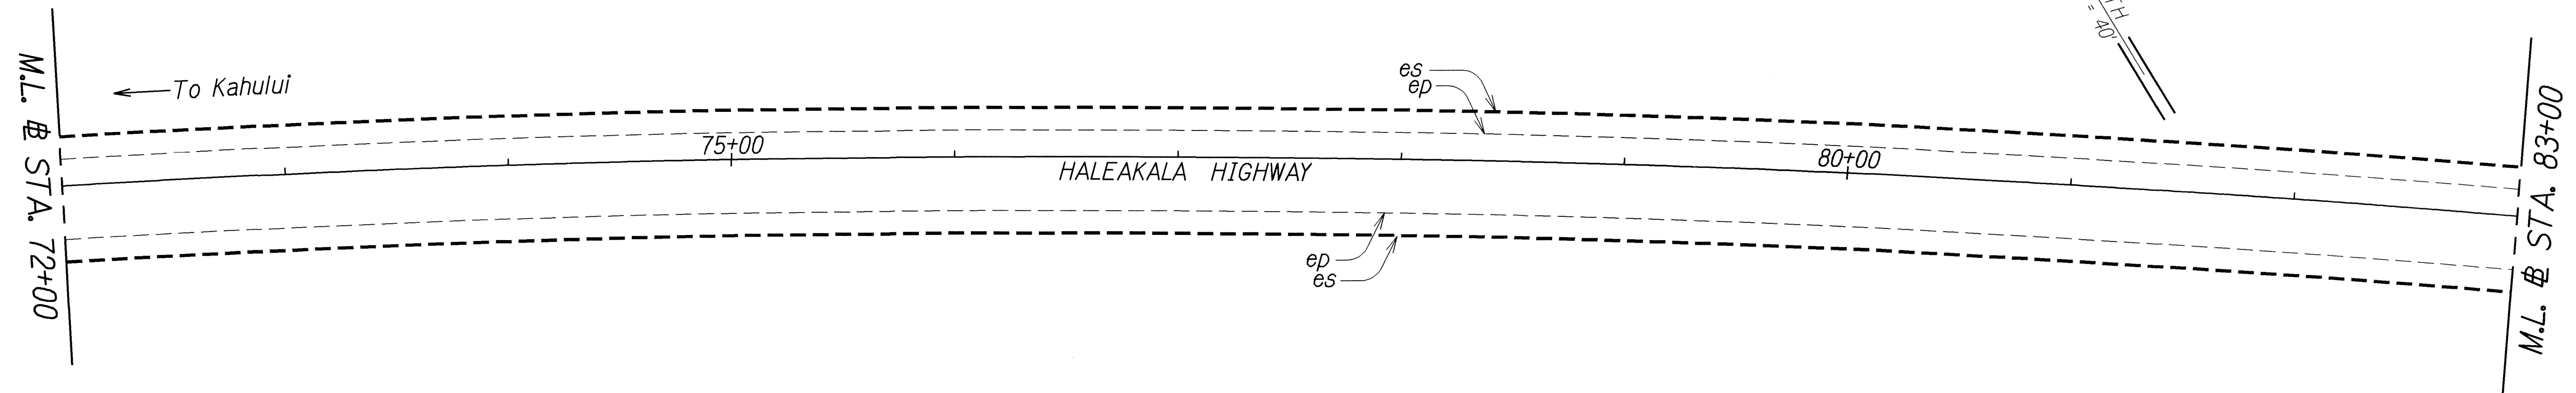


DESIGNED BY	DATE
DRAWN BY	
CHECKED BY	
NOTED BY	
QUANTITIES BY	
DATE	

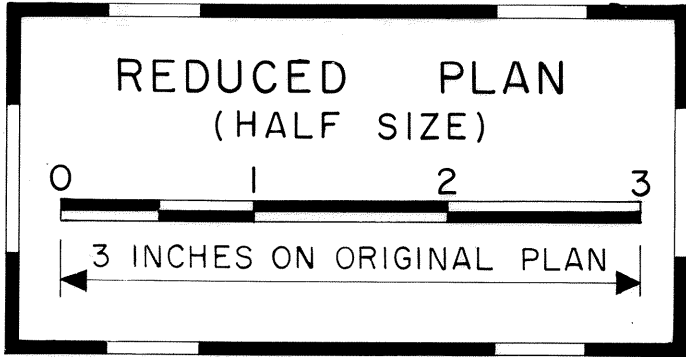


STATE OF HAWAII
DEPARTMENT OF TRANSPORTATION
HIGHWAYS DIVISION
ROADWAY PLAN
HALEAKALA HIGHWAY PAVEMENT
PREVENTIVE MAINTENANCE
Vicinity of Pukalani Junction to Five Trees
(M.P. 5.70 to M.P. 7.76)
Project No. 37C-01-07M
Scale: 1" = 40' Date: May, 2007

FED. ROAD DIST. NO.	STATE	PROJ. NO.	FISCAL YEAR	SHEET NO.	TOTAL SHEETS
HAWAII	HAW.	37C-01-07M	2007	ADD.8	10

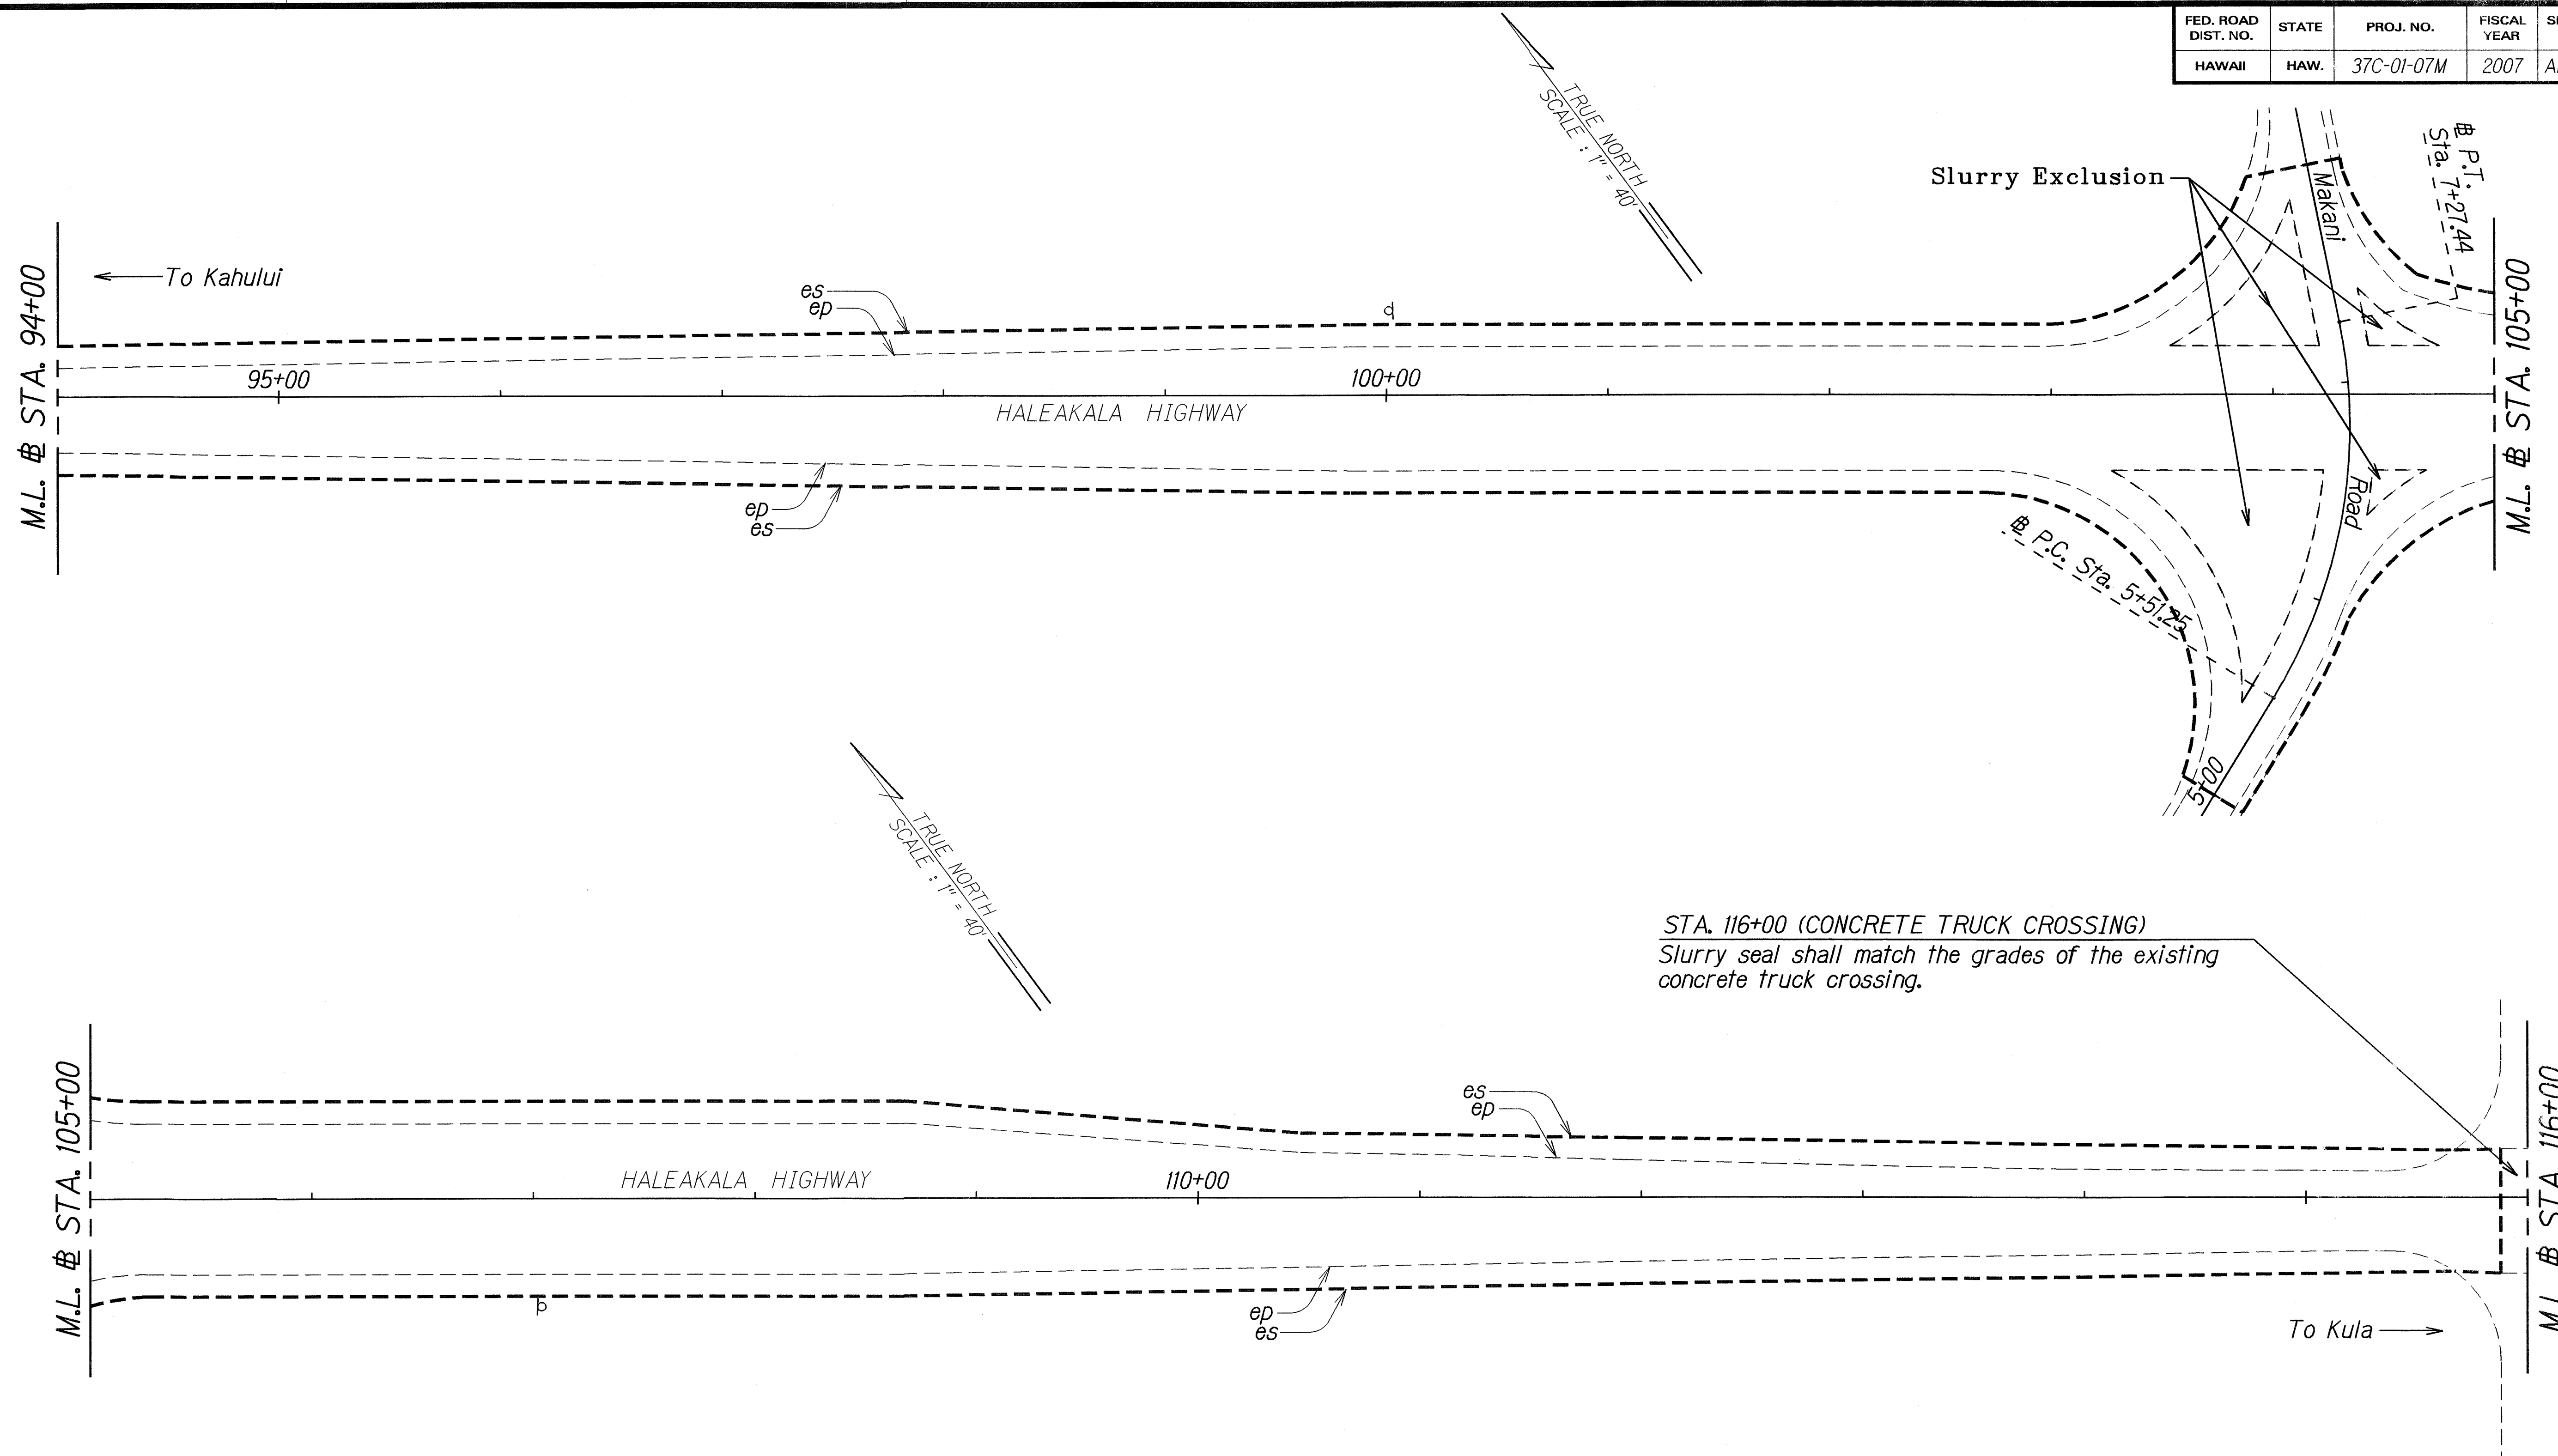

ORIGINAL PLAN	SURVEY PLOTTED BY _____ DATE _____
NOTE BOOK	DRAWN BY <u>X</u> _____
<u>66A.A</u>	TRACED BY _____
<u>56257</u>	DESIGNED BY _____
No. _____	QUANTITIES BY _____
	CHECKED BY _____
 
<u>LEGEND FOR</u> <u>AS-BUILT POSTINGS</u>	
	Squiggly line for as-built deletion
100-00	Double line for as-built deletion
Roadway	Text for as-built posting



6-14-07	Notes on Concrete Truck Crossing.
DATE	REVISION

STATE OF HAWAII
DEPARTMENT OF TRANSPORTATION
HIGHWAYS DIVISION
ROADWAY PLAN
HALEAKALA HIGHWAY PAVEMENT
PREVENTIVE MAINTENANCE
Vicinity of Pukalani Junction to Five Trees
(M.P. 5.70 to M.P. 7.76)
Project No. 37C-01-07M
Scale: 1" = 40' Date: May, 2007
SHEET No. 3 OF 5 SHEETS

"AS-BUILT"

ADD.8

FED. ROAD DIST. NO.	STATE	PROJ. NO.	FISCAL YEAR	SHEET NO.	TOTAL SHEETS
HAWAII	HAW.	37C-01-07M	2007	ADD.9	10

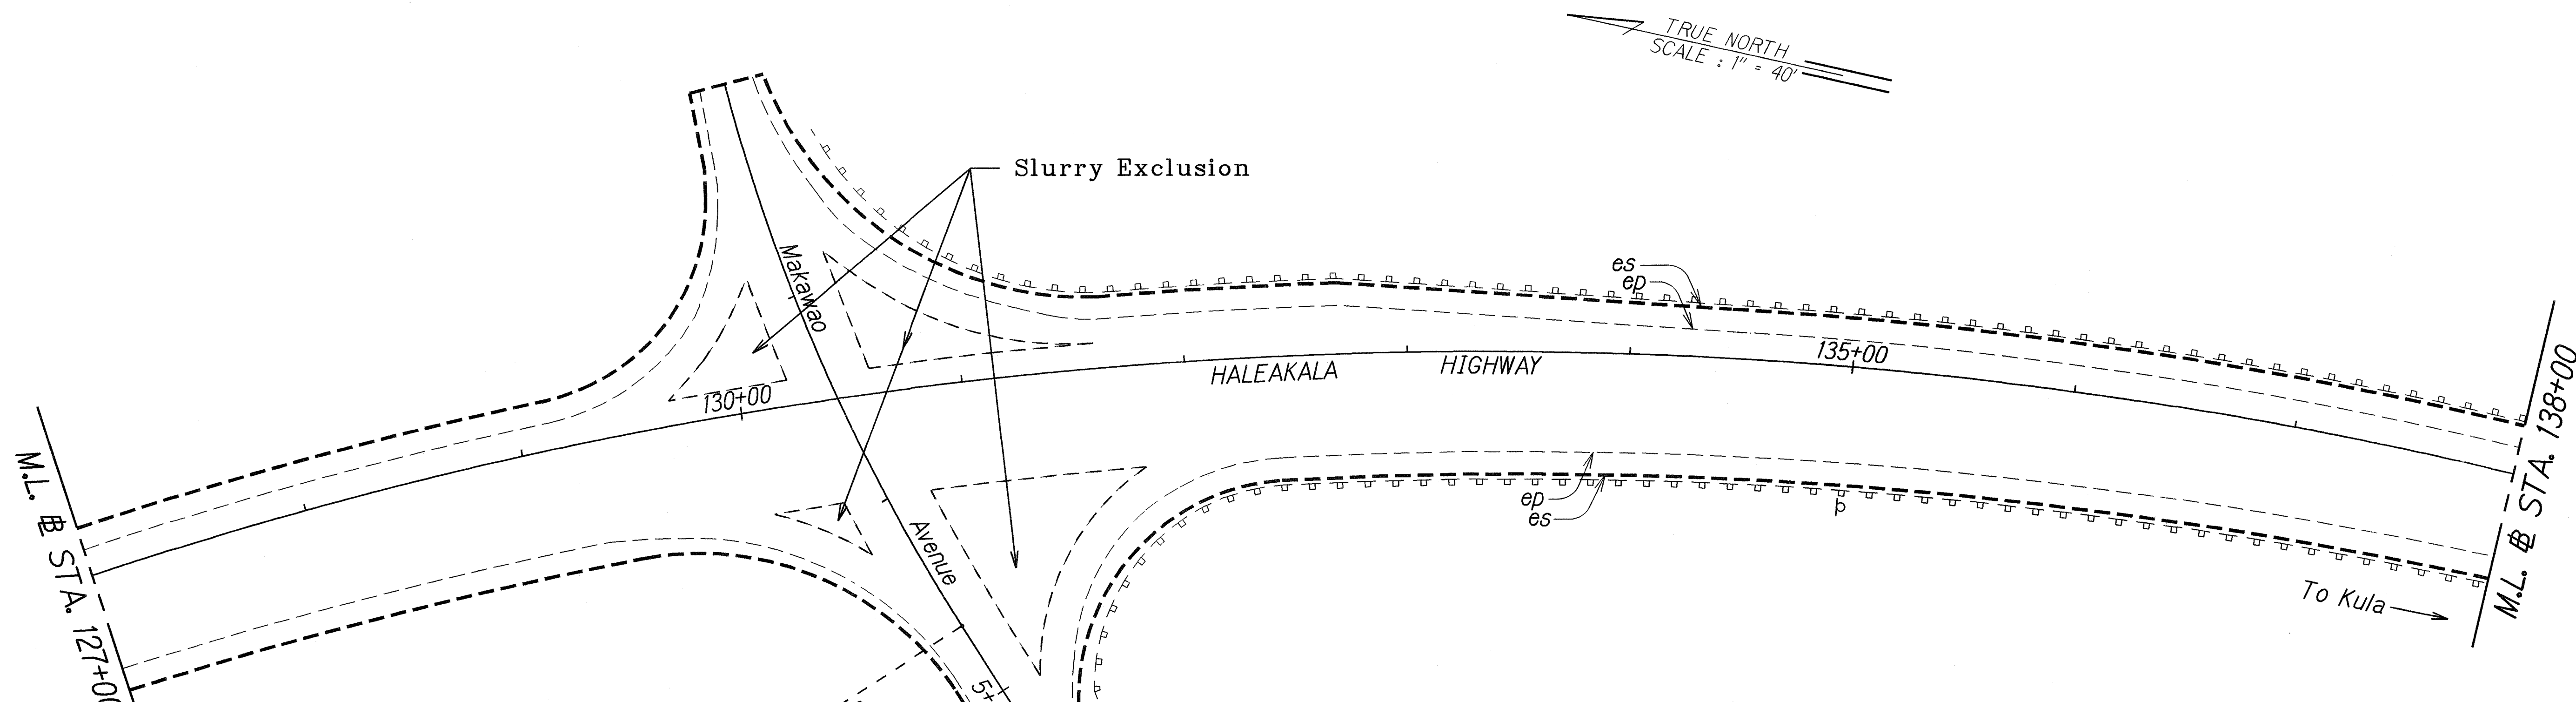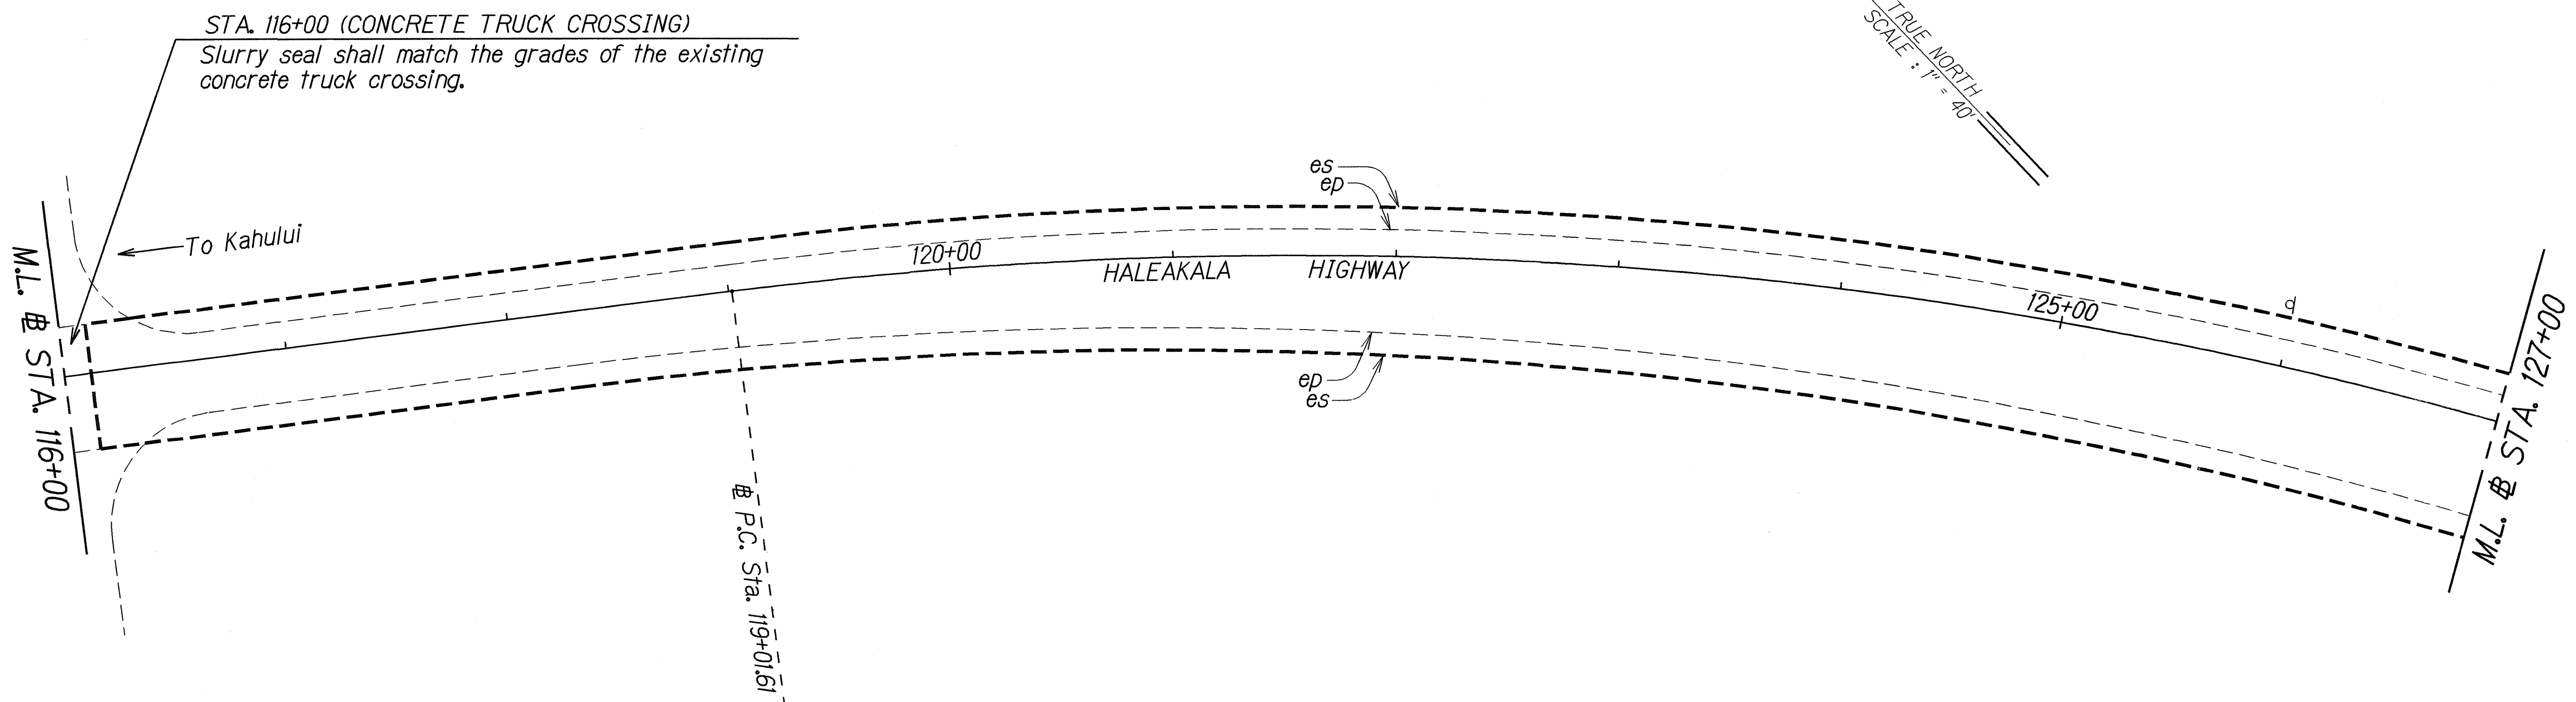

ORIGINAL PLAN	SURVEY PLOTTED BY	DATE
NOTED BY	DRAWN BY	
QUANTITIES BY	TRACED BY	
CHECKED BY	NOTED BY	
	DATE	


LEGEND FOR AS-BUILT POSTINGS	
	Squiggly line for as-built deletion
	Double line for as-built deletion
Roadway	Text for as-built posting

6-14-07	Notes on Concrete Truck Crossing.
---------	-----------------------------------

DATE	REVISION
------	----------

STATE OF HAWAII
DEPARTMENT OF TRANSPORTATION
HIGHWAYS DIVISION
ROADWAY PLAN
HALEAKALA HIGHWAY PAVEMENT PREVENTIVE MAINTENANCE
Vicinity of Pukalani Junction to Five Trees
(M.P. 5.70 to M.P. 7.76)
Project No. 37C-01-07M
Scale: 1" = 40' Date: May, 2007
SHEET No. 4 OF 5 SHEETS


FED. ROAD DIST. NO.	STATE	PROJ. NO.	FISCAL YEAR	SHEET NO.	TOTAL SHEET
HAWAII	HAW.	37C-01-07M	2007	10	10

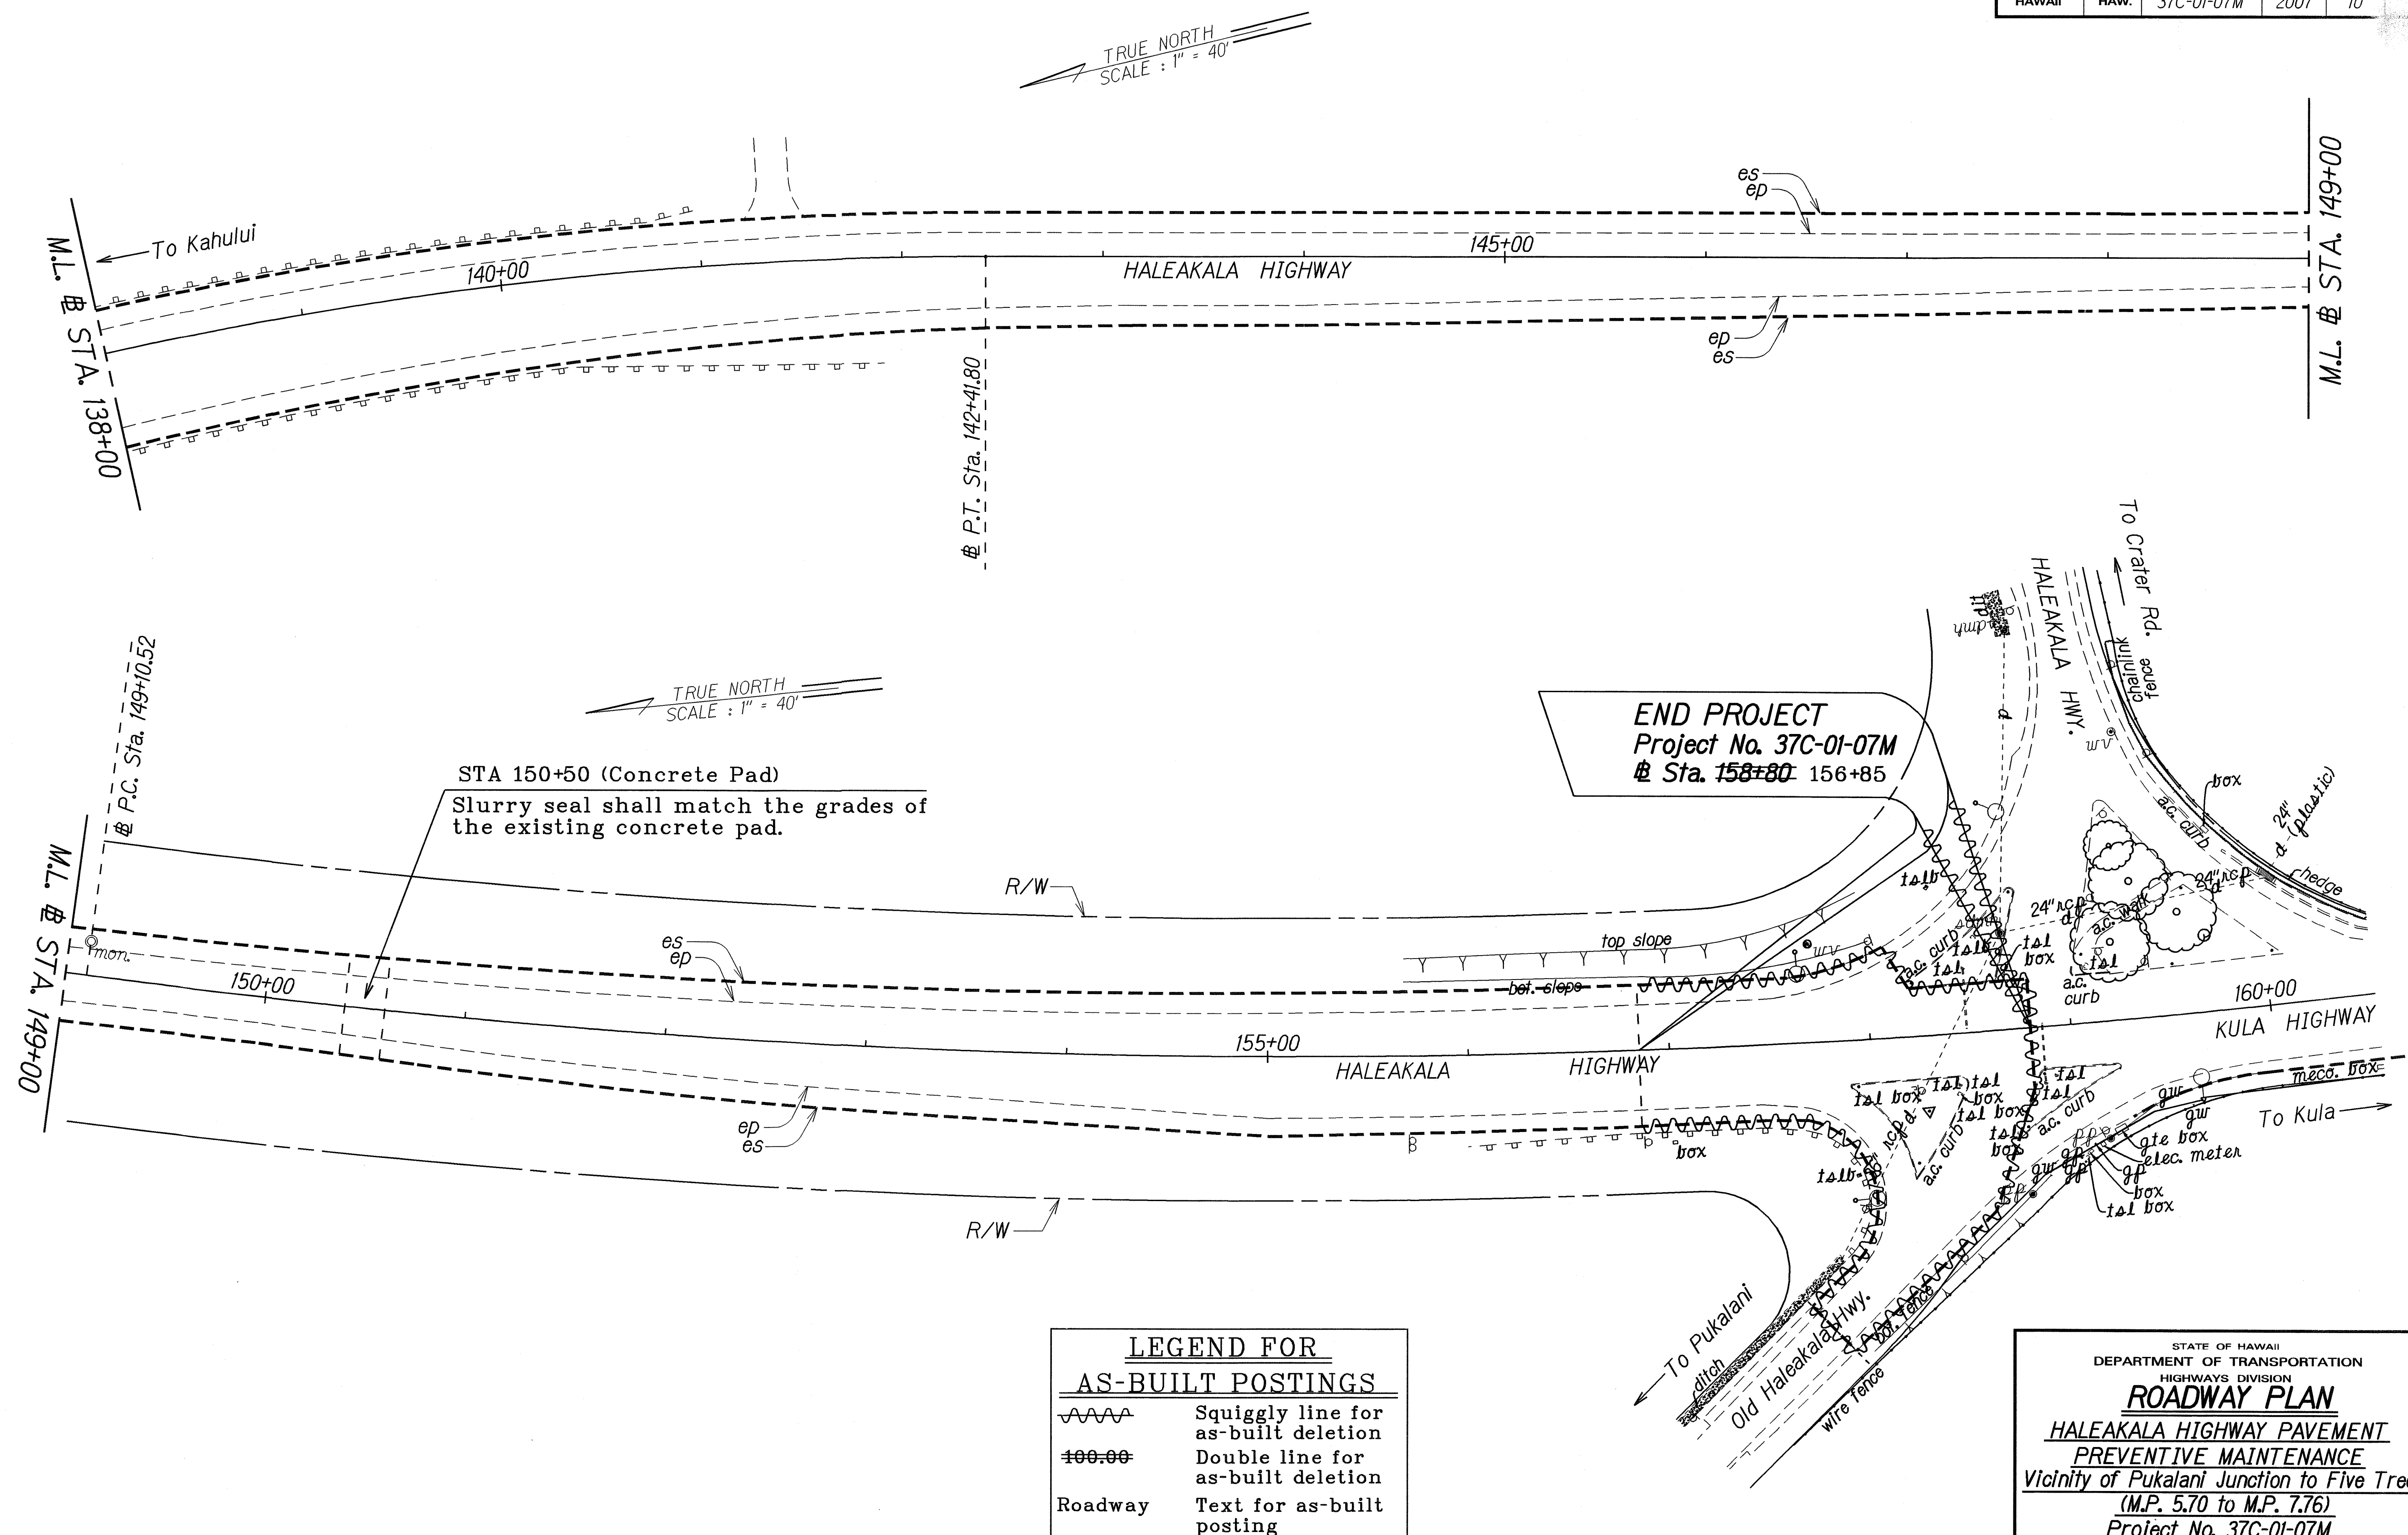

ORIGINAL PLAN	SURVEY PLOTTED BY _____ DATE _____
	DRAWN BY χ _____
	TRACED BY _____
NOTE BOOK	DESIGNED BY χ _____
ad, x	QUANTITIES BY _____
χ, dgn	CHECKED BY _____
No. _____	

"AS-BUILT"

FED. ROAD DIST. NO.	STATE	PROJ. NO.	FISCAL YEAR	SHEET NO.	TOTAL SHEETS
HAWAII	HAW.	37C-01-07M	2007	C.O. 10-S1	2

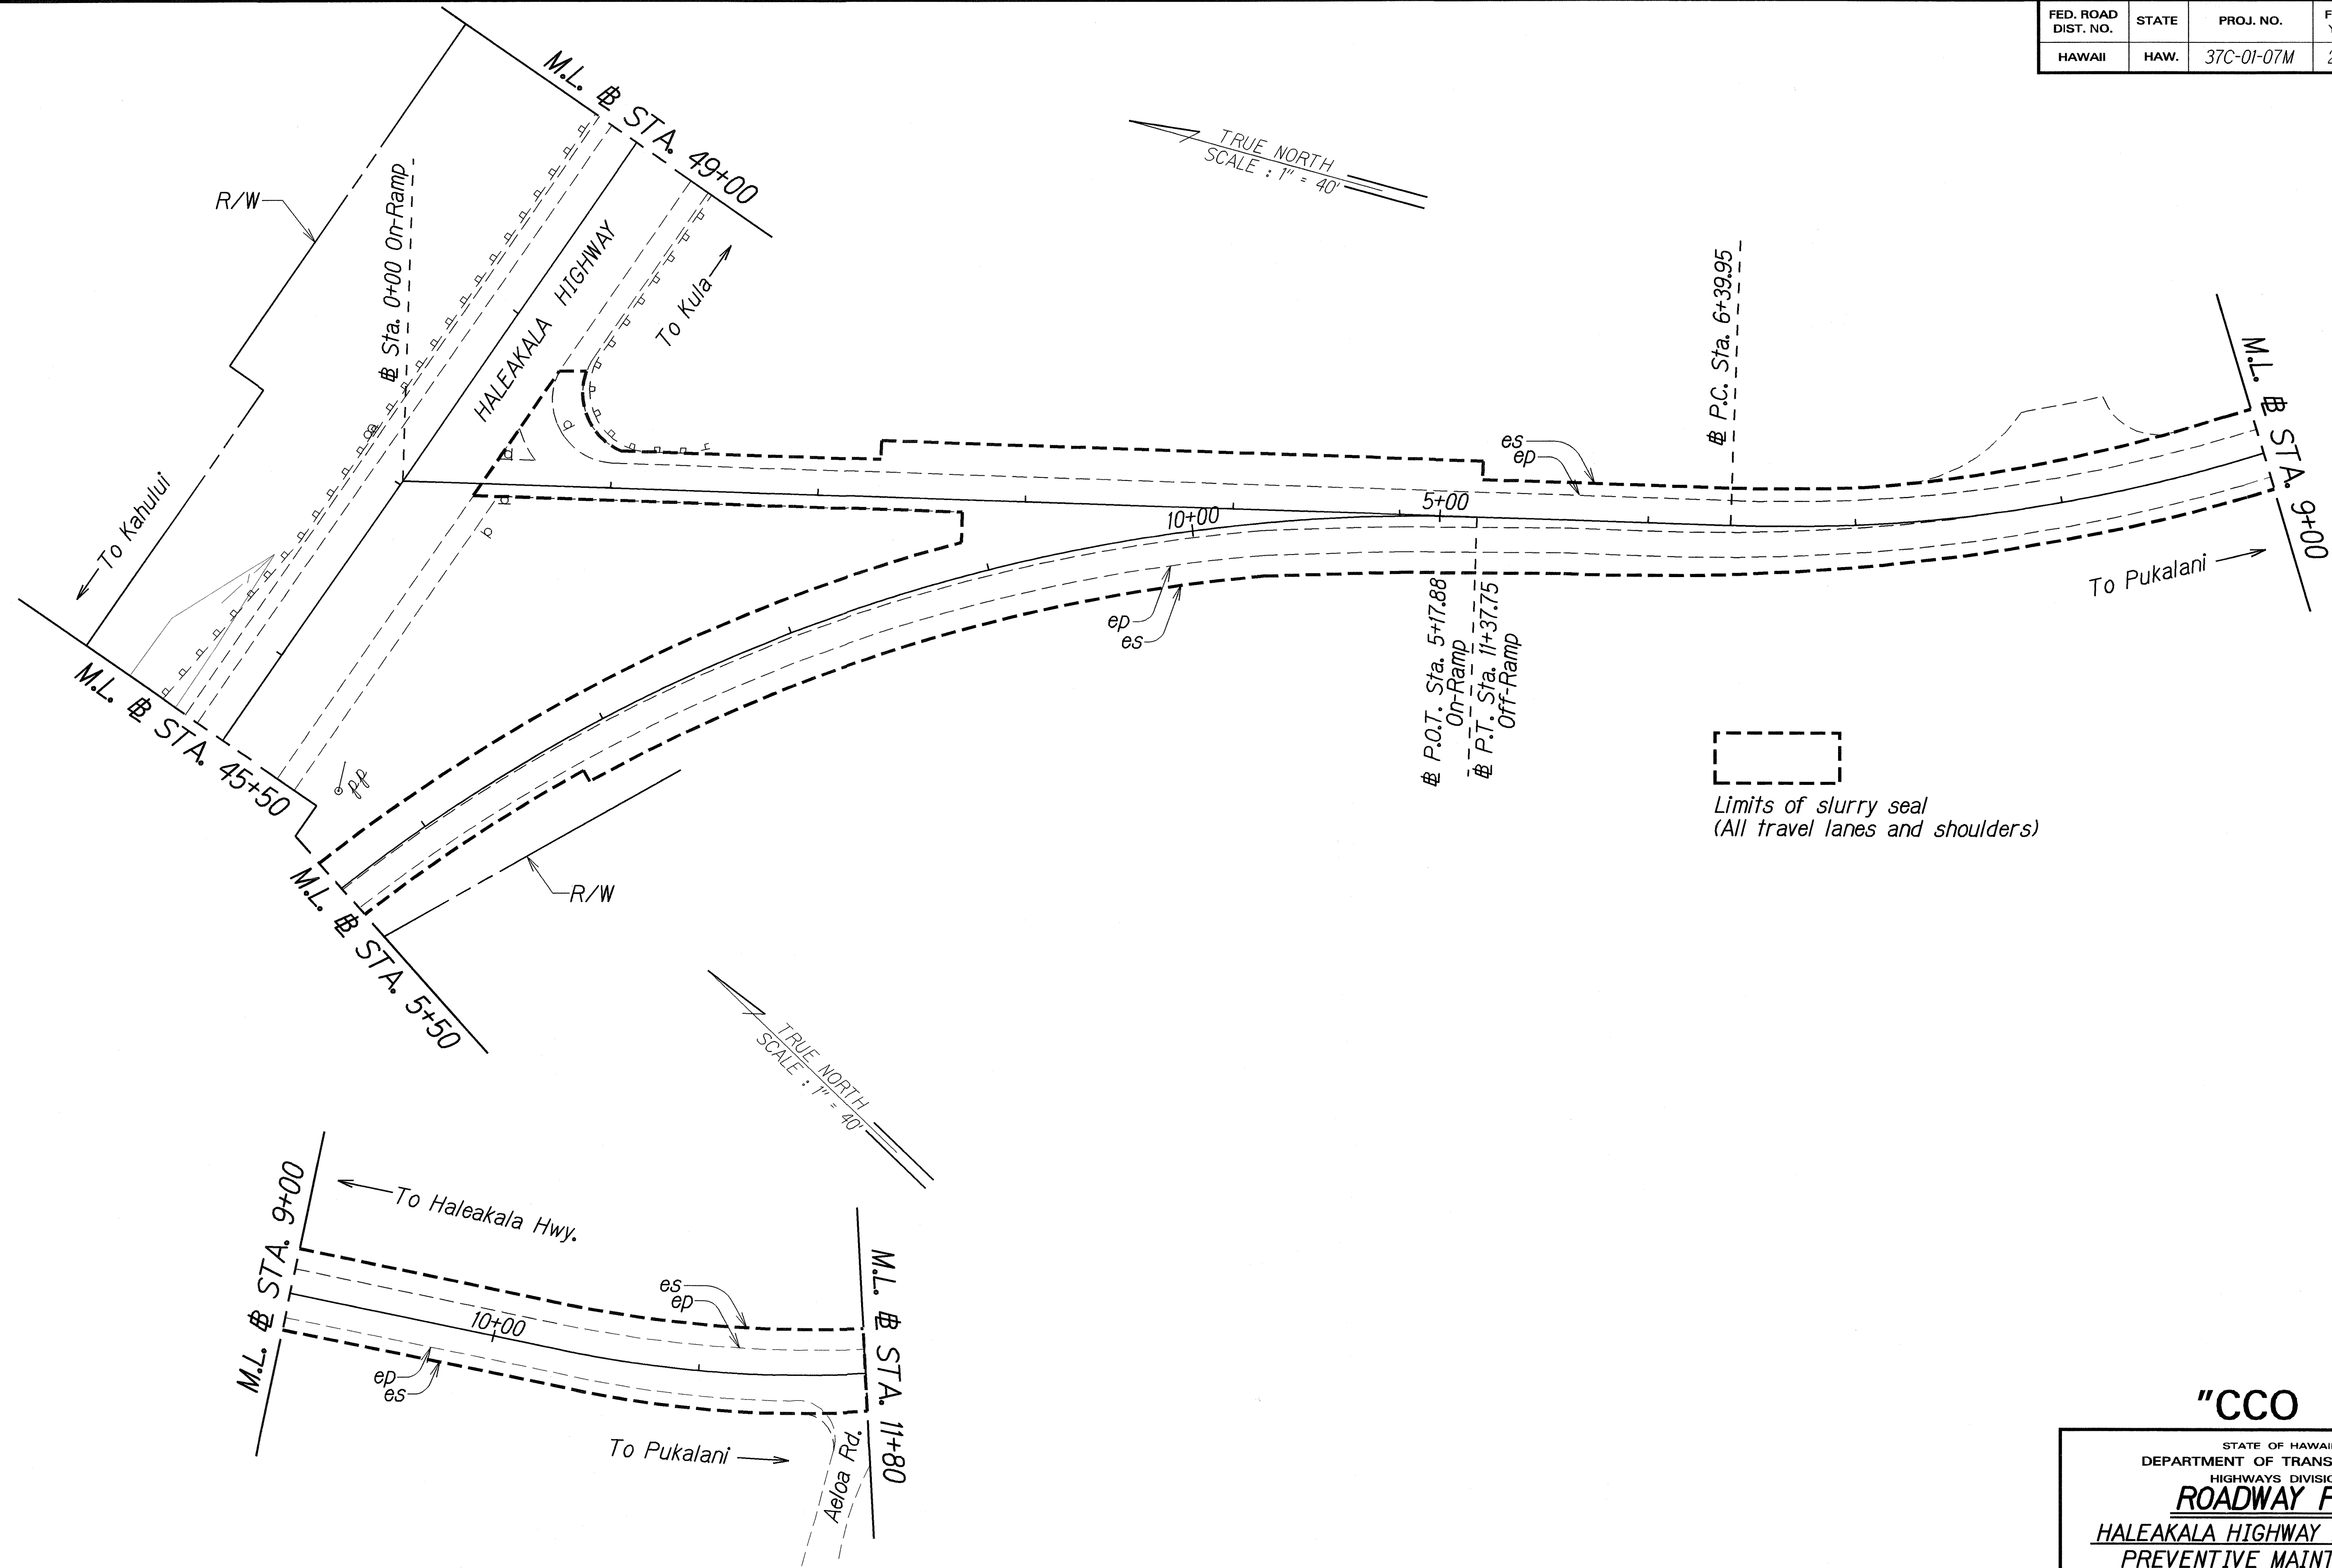

SURVEY PLOTTED BY	DATE
DESIGNED BY	
CHECKED BY	
NOTE BOOK	
CHECKED BY	
N.	

"CCO 1"

STATE OF HAWAII

DEPARTMENT OF TRANSPORTATION

HIGHWAYS DIVISION

ROADWAY PLAN

HALEAKALA HIGHWAY PAVEMENT

PREVENTIVE MAINTENANCE

Vicinity of Pukalani Junction to Five Trees

(M.P. 5.70 to M.P. 7.76)

Project No. 37C-01-07M



Scale: 1" = 40'

Date: March, 2008

SHEET No. 1 OF 1 SHEETS

C.O. 10 S-1

FED. ROAD DIST. NO.	STATE	PROJ. NO.	FISCAL YEAR	SHEET NO.	TOTAL SHEETS
HAWAII	HAW.	37C-01-07M	2007	C.O. 10 S-2	2

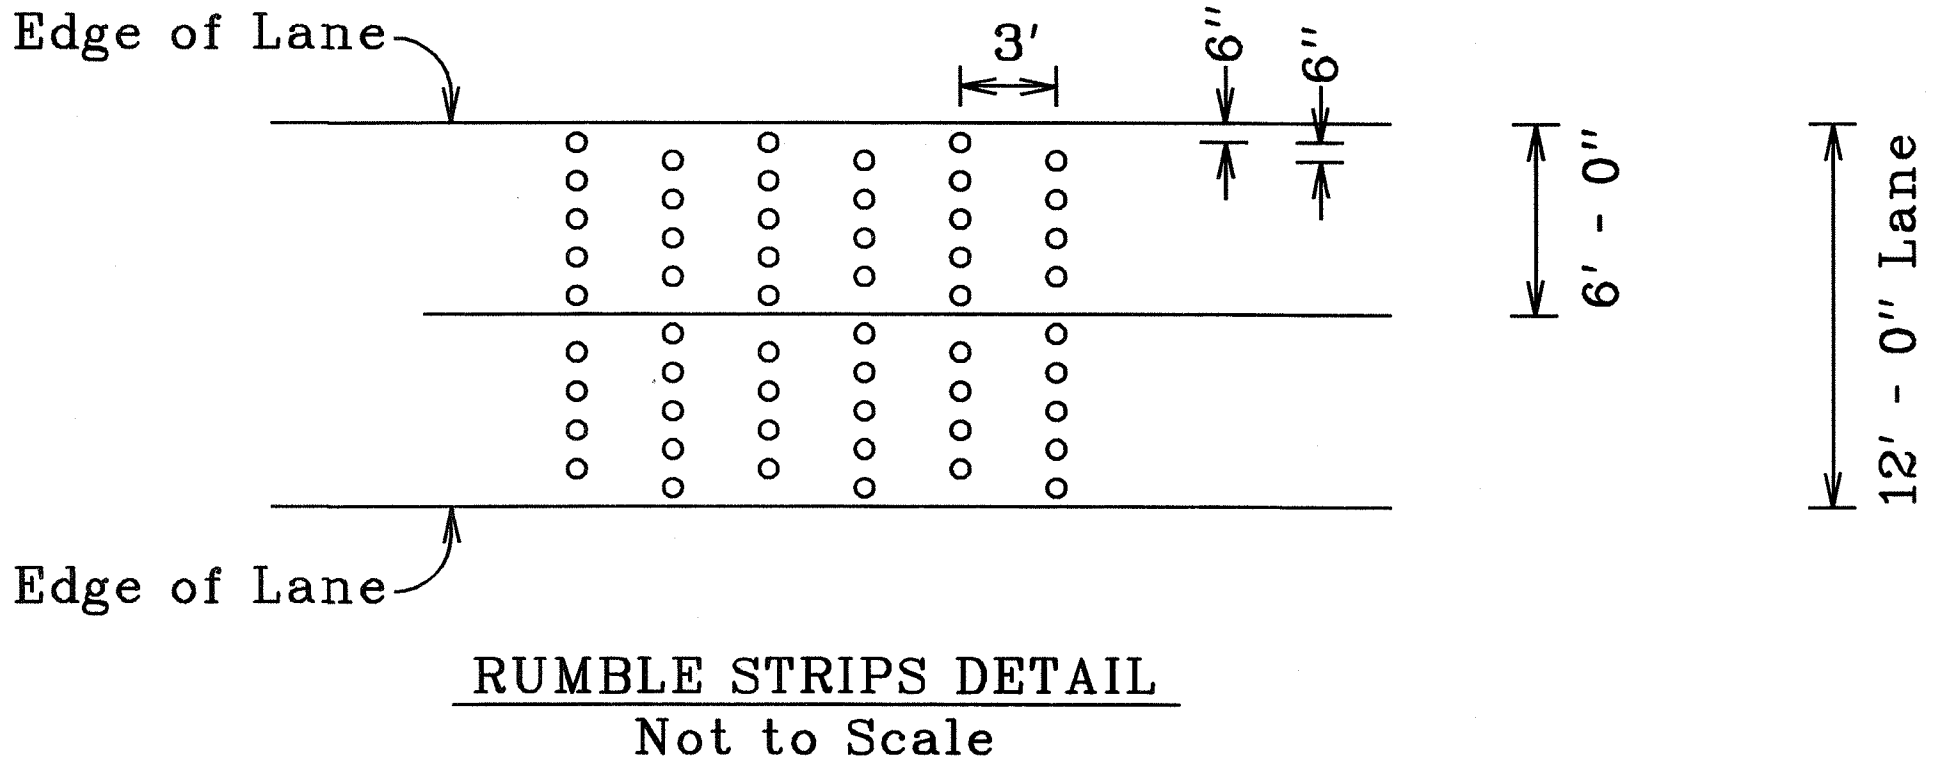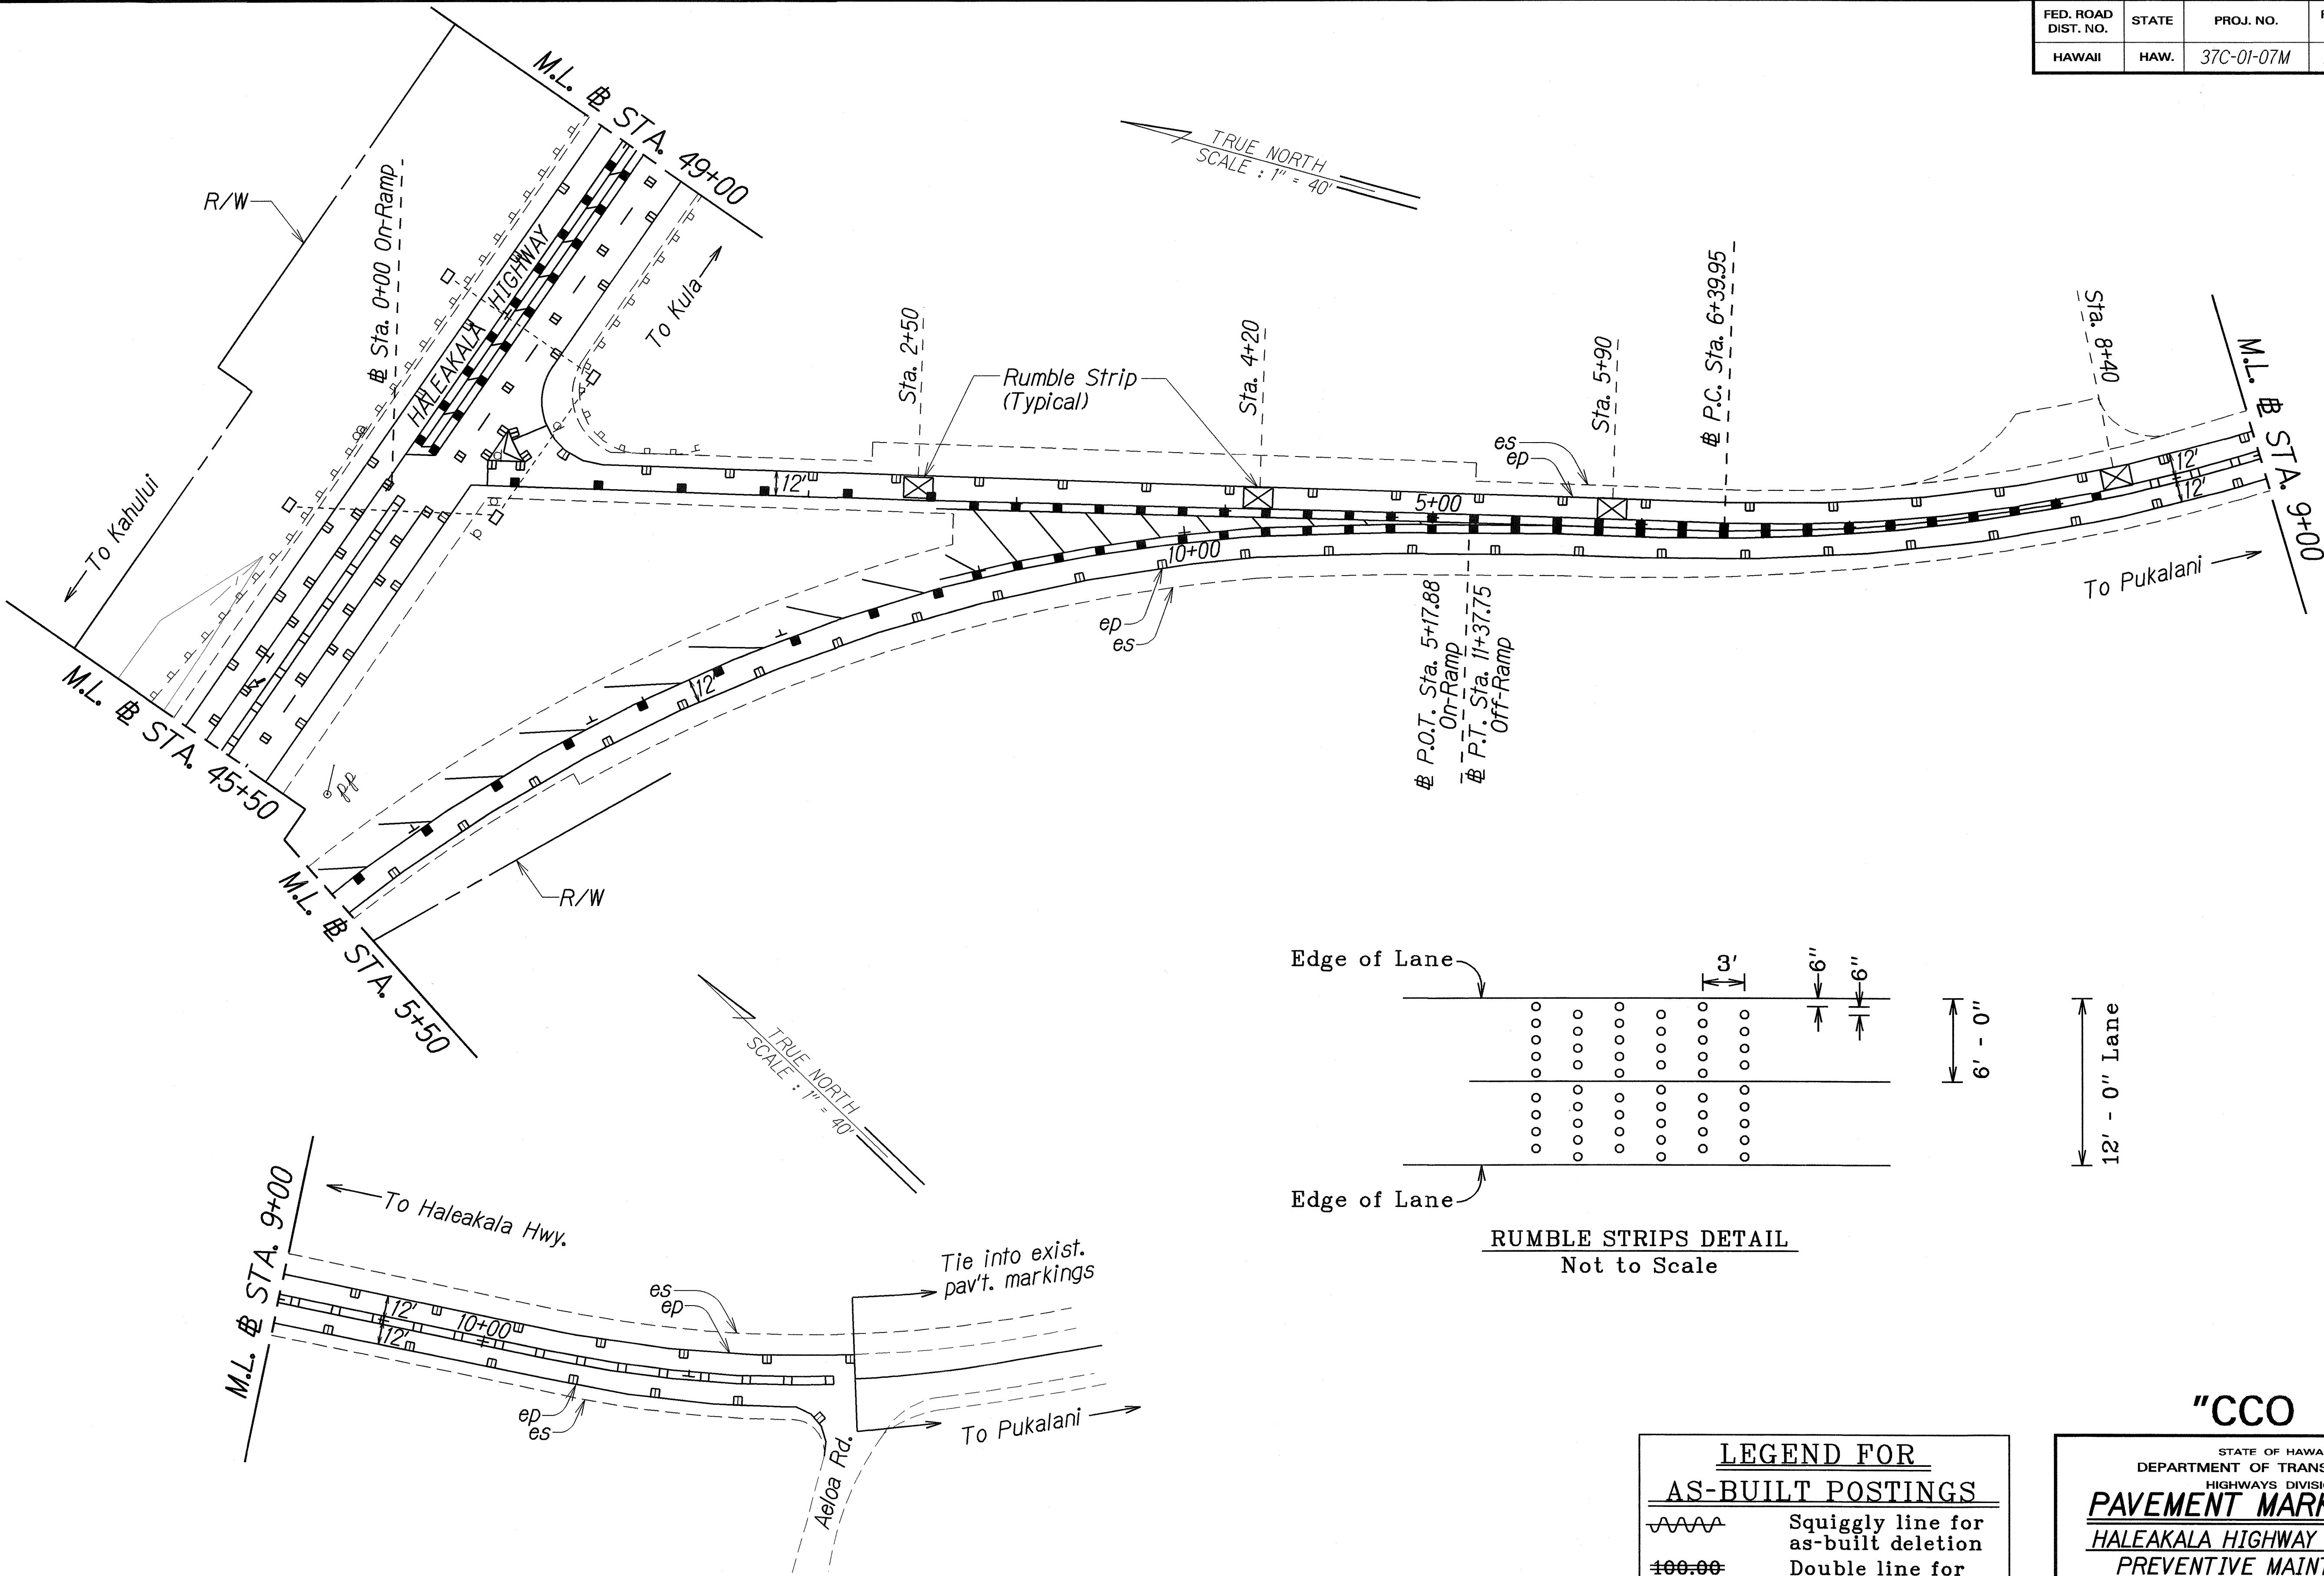

LEGEND FOR AS-BUILT POSTINGS	
	Squiggly line for as-built deletion
	Double line for as-built deletion
Roadway	Text for as-built posting

"CCO 1"

STATE OF HAWAII
DEPARTMENT OF TRANSPORTATION
HIGHWAYS DIVISION

PAVEMENT MARKING PLAN

HALEAKALA HIGHWAY PAVEMENT PREVENTIVE MAINTENANCE

Vicinity of Pukalani Junction to Five Trees
(M.P. 5.70 to M.P. 7.76)
Project No. 37C-01-07M

Scale: 1" = 40' Date: March, 2008

SHEET No. 1 OF 1 SHEETS

SURVEY PLOTTED BY	DATE
DESIGNED BY	
QUANTITIES BY	
CHECKED BY	
ORIGINAL PLAN	
NOTE BOOK	
N.	