

INDEX TO DRAWINGS	
SHEET NO.	DESCRIPTION
1	TITLE SHEET
2	STANDARD PLANS SUMMARY
3	GENERAL NOTES
4 - 5	WATER POLLUTION & EROSION CONTROL NOTES
6 - 10	ROADWAY PLANS
C.O. 10 S-1	ROADWAY PLANS
C.O. 10 S-2	PAVEMENT MARKING PLANS

STATE OF HAWAII

DEPARTMENT OF TRANSPORTATION

HIGHWAYS DIVISION

HONOLULU, HAWAII

"AS-BUILT"

PLANS FOR

HALEAKALA HIGHWAY PAVEMENT PREVENTIVE MAINTENANCE

VICINITY OF PUKALANI JUNCTION TO FIVE TREES



M.P. 5.70 TO M.P. 7.76

PROJECT NO. 37C-01-07M

DISTRICT OF MAKAWAO


ISLAND OF MAUI

FED. ROAD DIST. NO.	STATE	PROJ. NO.	FISCAL YEAR	SHEET NO.	TOTAL SHEETS
HAWAII	HAW.	37C-01-07M	2007	1	10

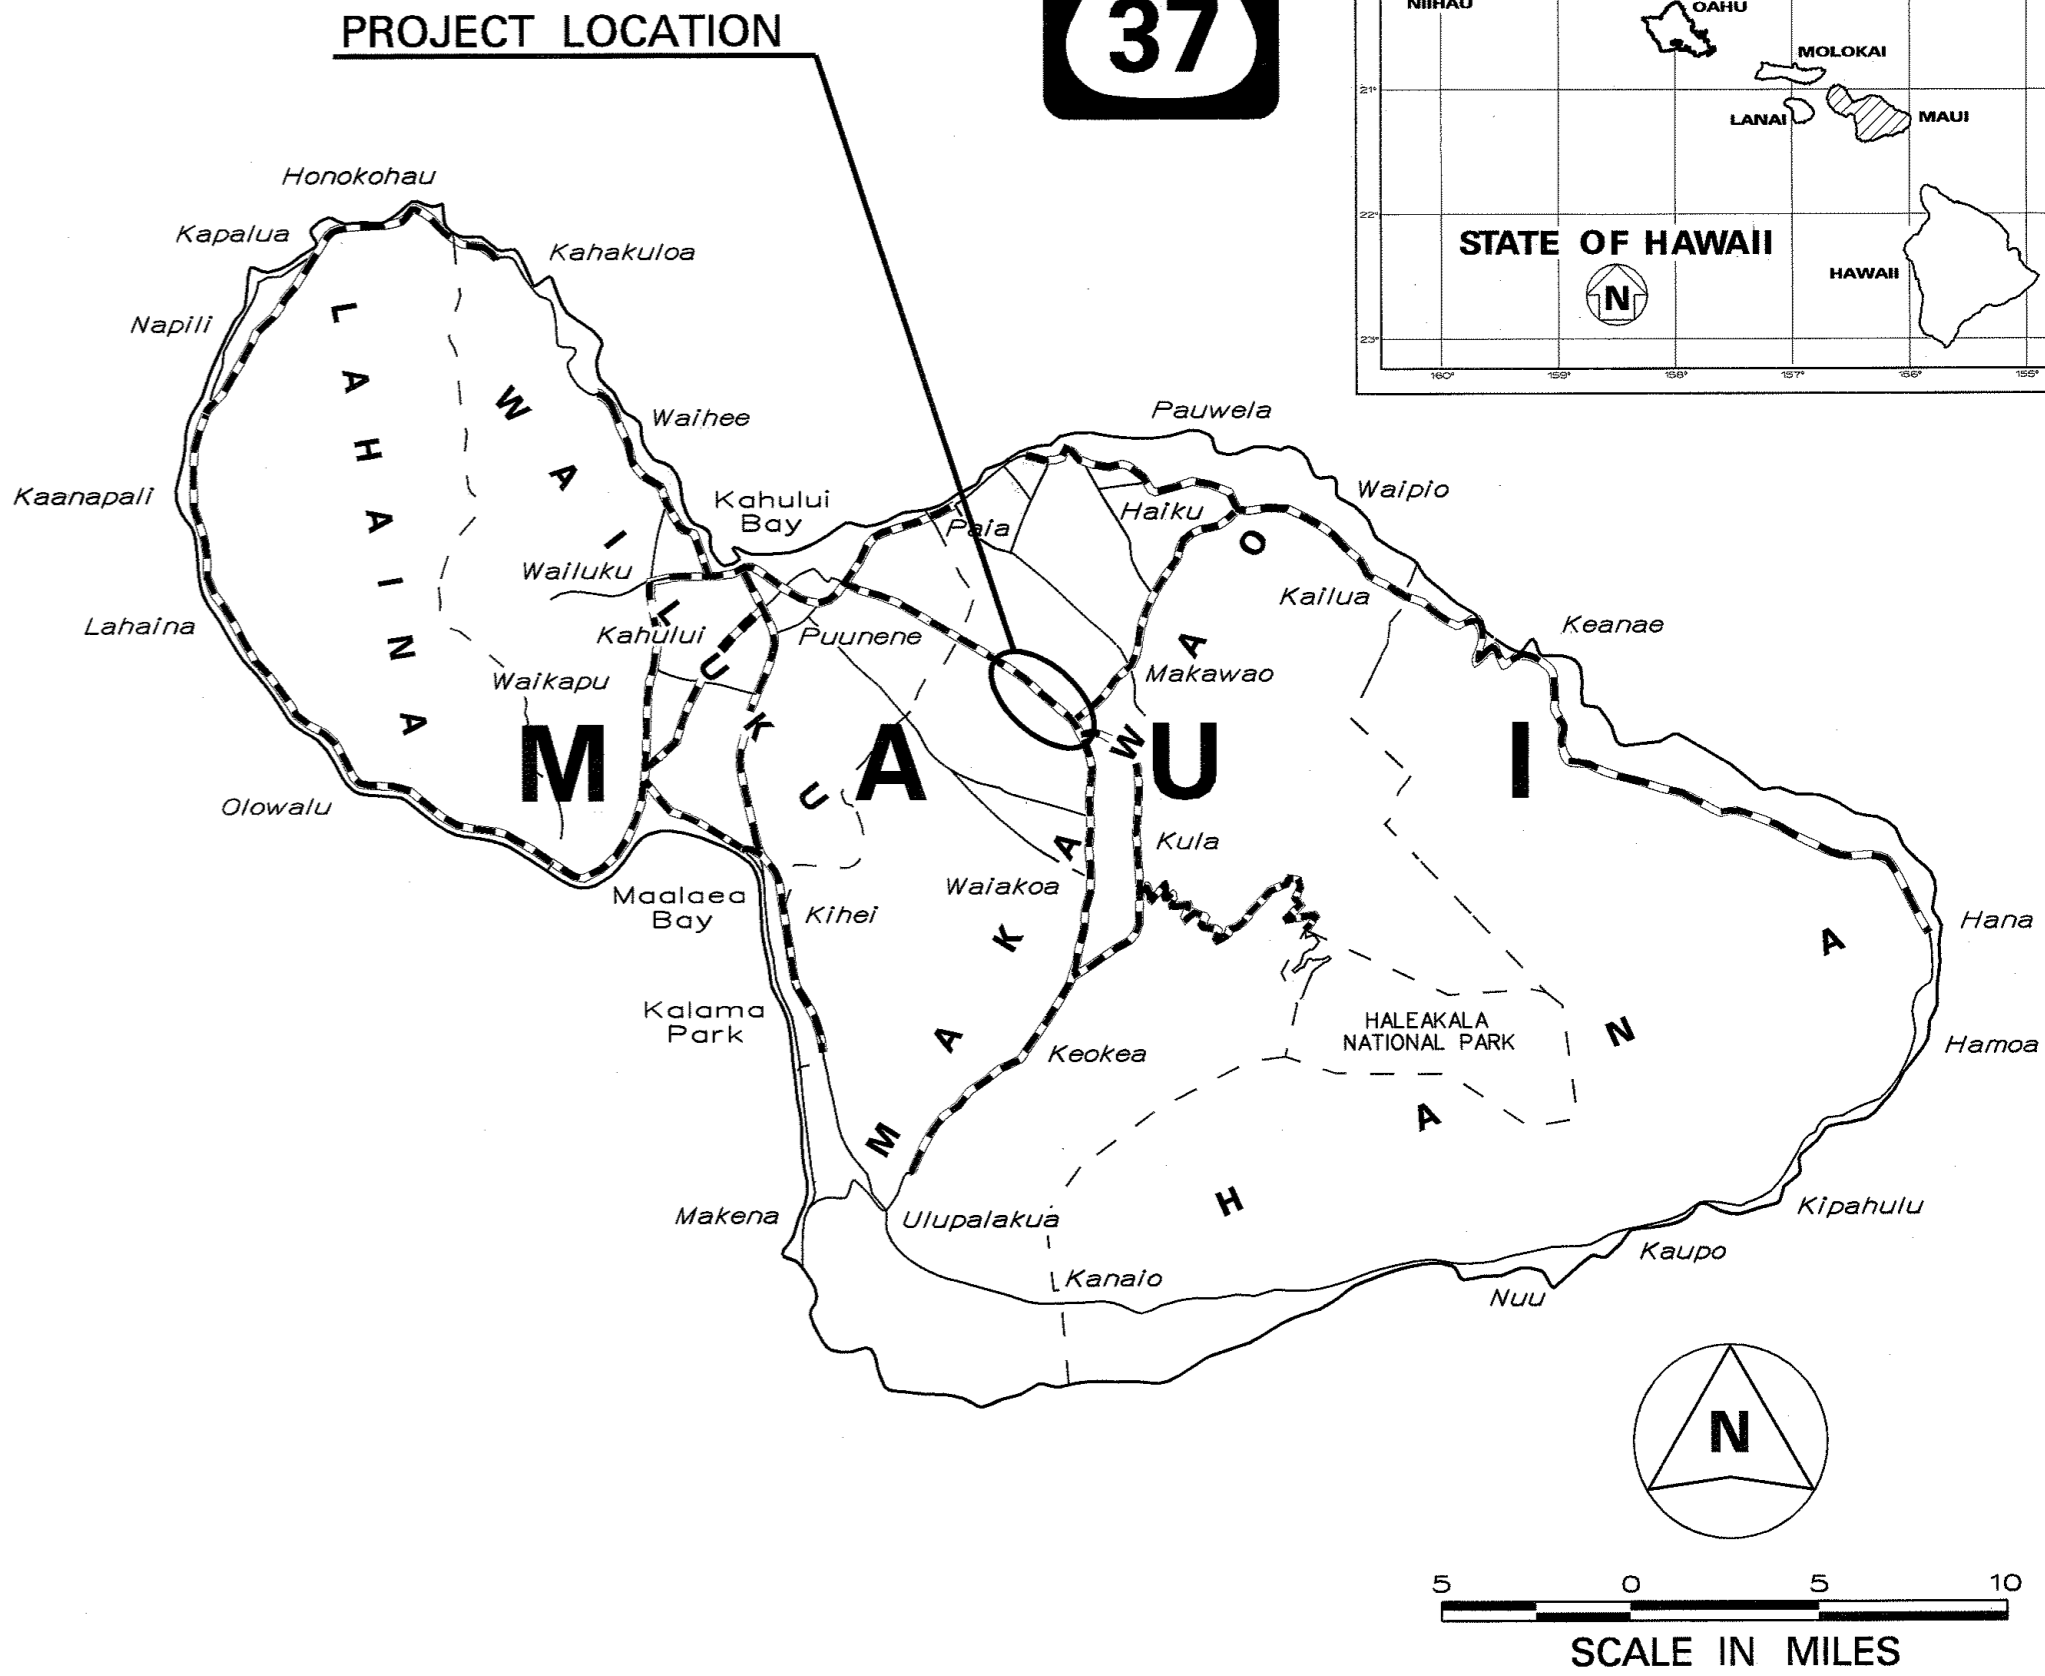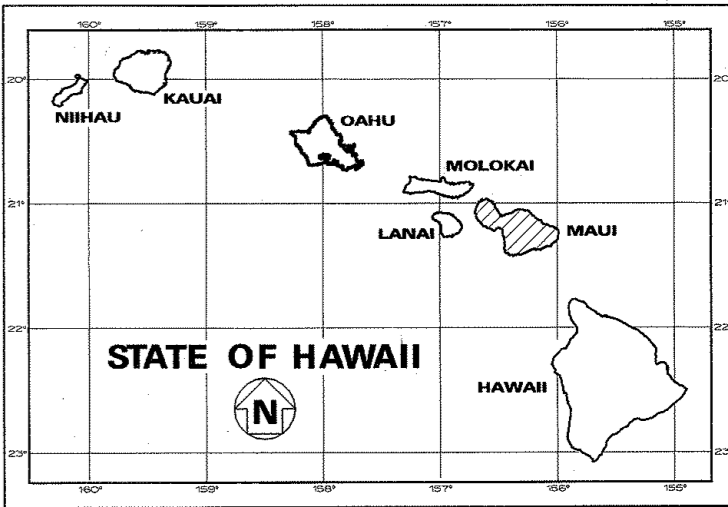

FEDERAL AID PROJECTS PREVIOUSLY CONSTRUCTED OR UNDER CONSTRUCTION

MILE POST 5.70 TO MILE POST 7.76

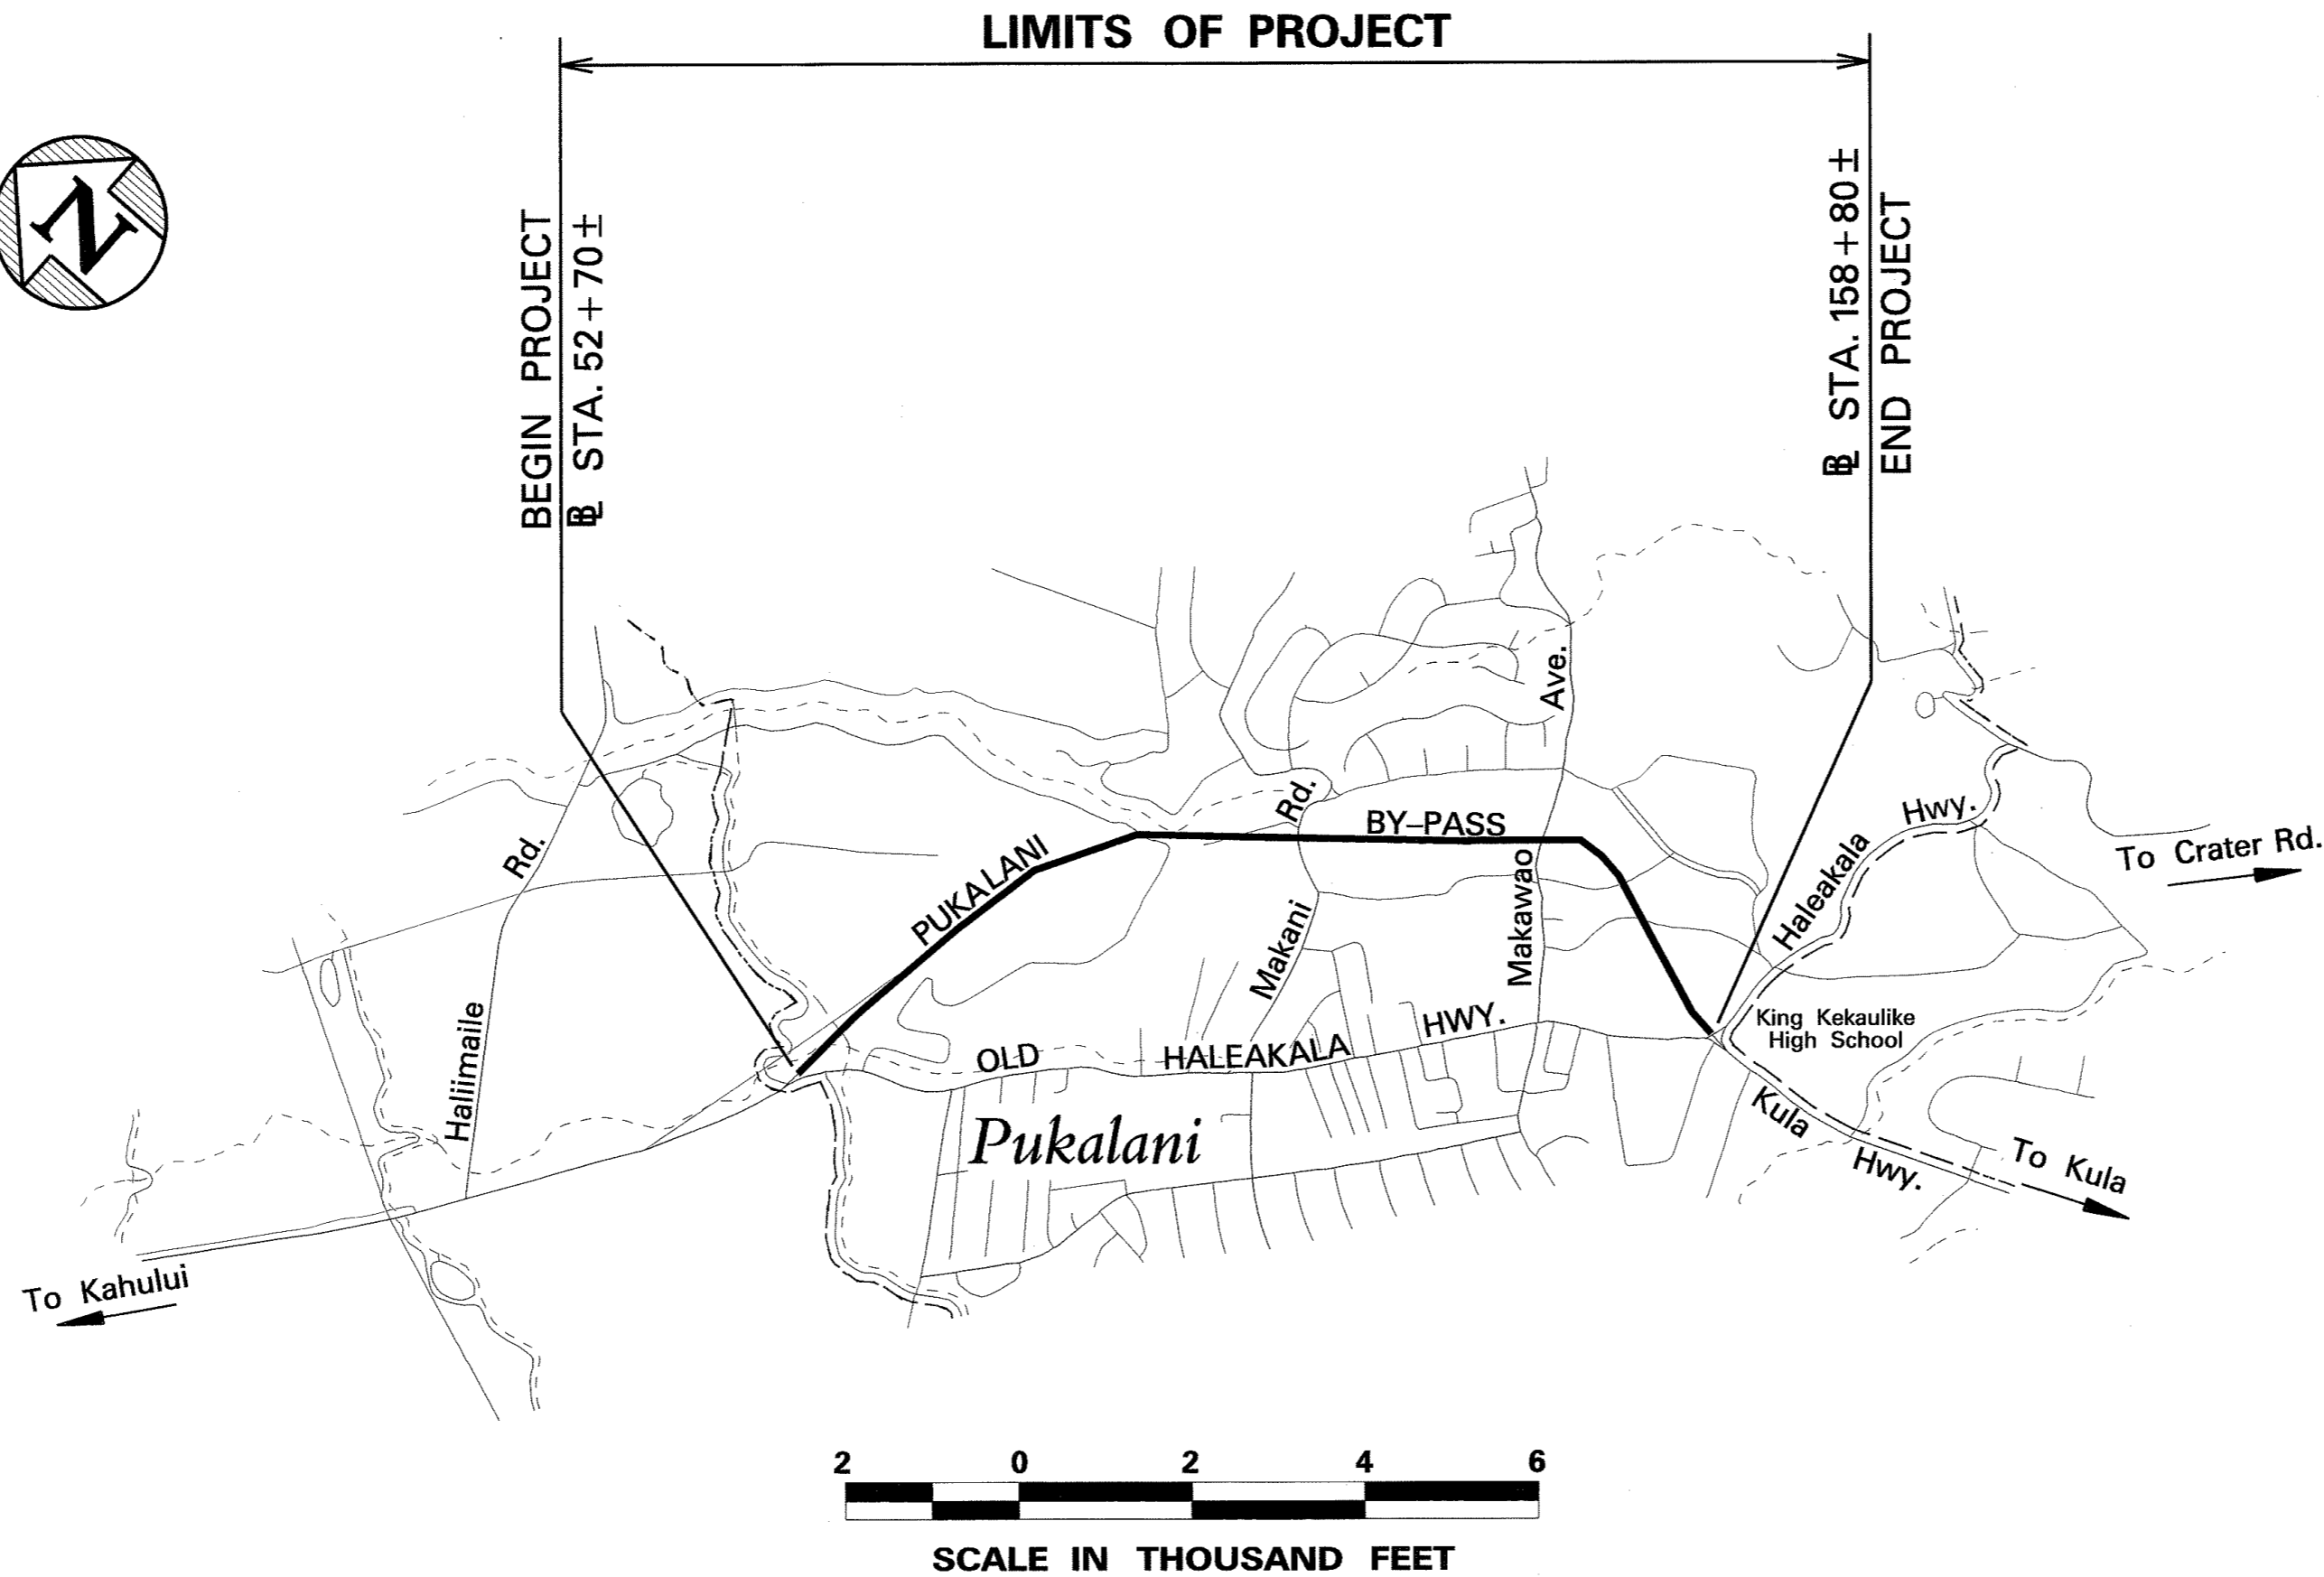

CHANGES MADE DURING CONSTRUCTION HAVE BEEN INCORPORATED ON THESE PLANS EXCEPT CHANGES IN THE ORIGINAL THEORETICAL QUANTITIES. FOR ACTUAL QUANTITIES, REFER TO PROJECT LEDGER AND/OR COMPUTATION BOOK.

RESIDENT ENGINEER

9-4-08

DATE

DEPARTMENT OF TRANSPORTATION STATE OF HAWAII	
APPROVED:	
<i>[Signature]</i>	5-13-07
DIR. OF TRANSPORTATION	DATE

DESIGNED BY

HWY-M

MANAGED BY

HWY-ME

PHONE

873-3535

DATE

MAY 2007