




FED. ROAD DIST. NO.	STATE	PROJ. NO.	FISCAL YEAR	SHEET NO.	TOTAL SHEETS
HAWAII	HAW.	37CDE-01-08M	2008	11	30

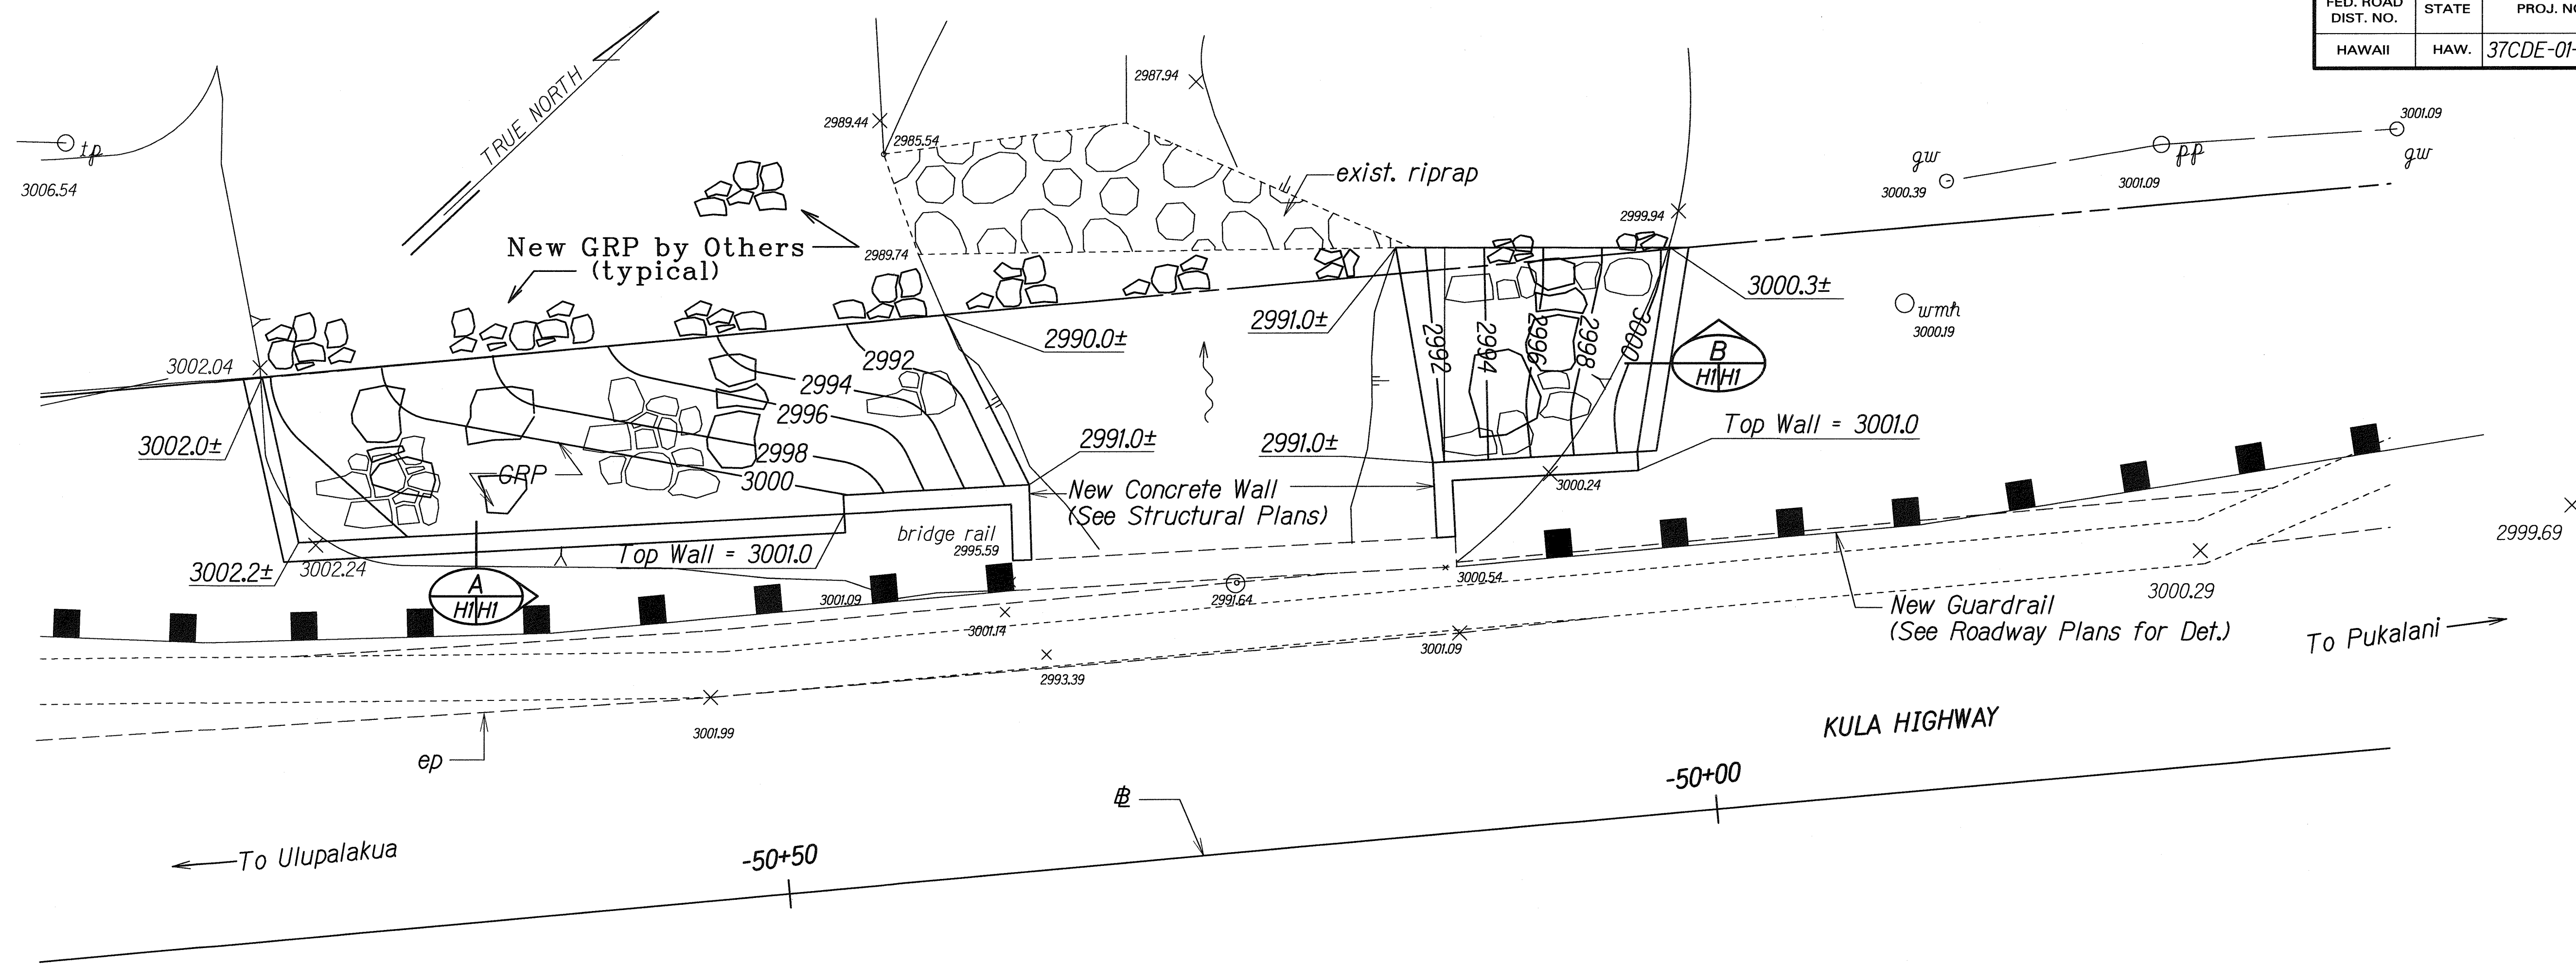

PLAN
Scale: 1"=5'

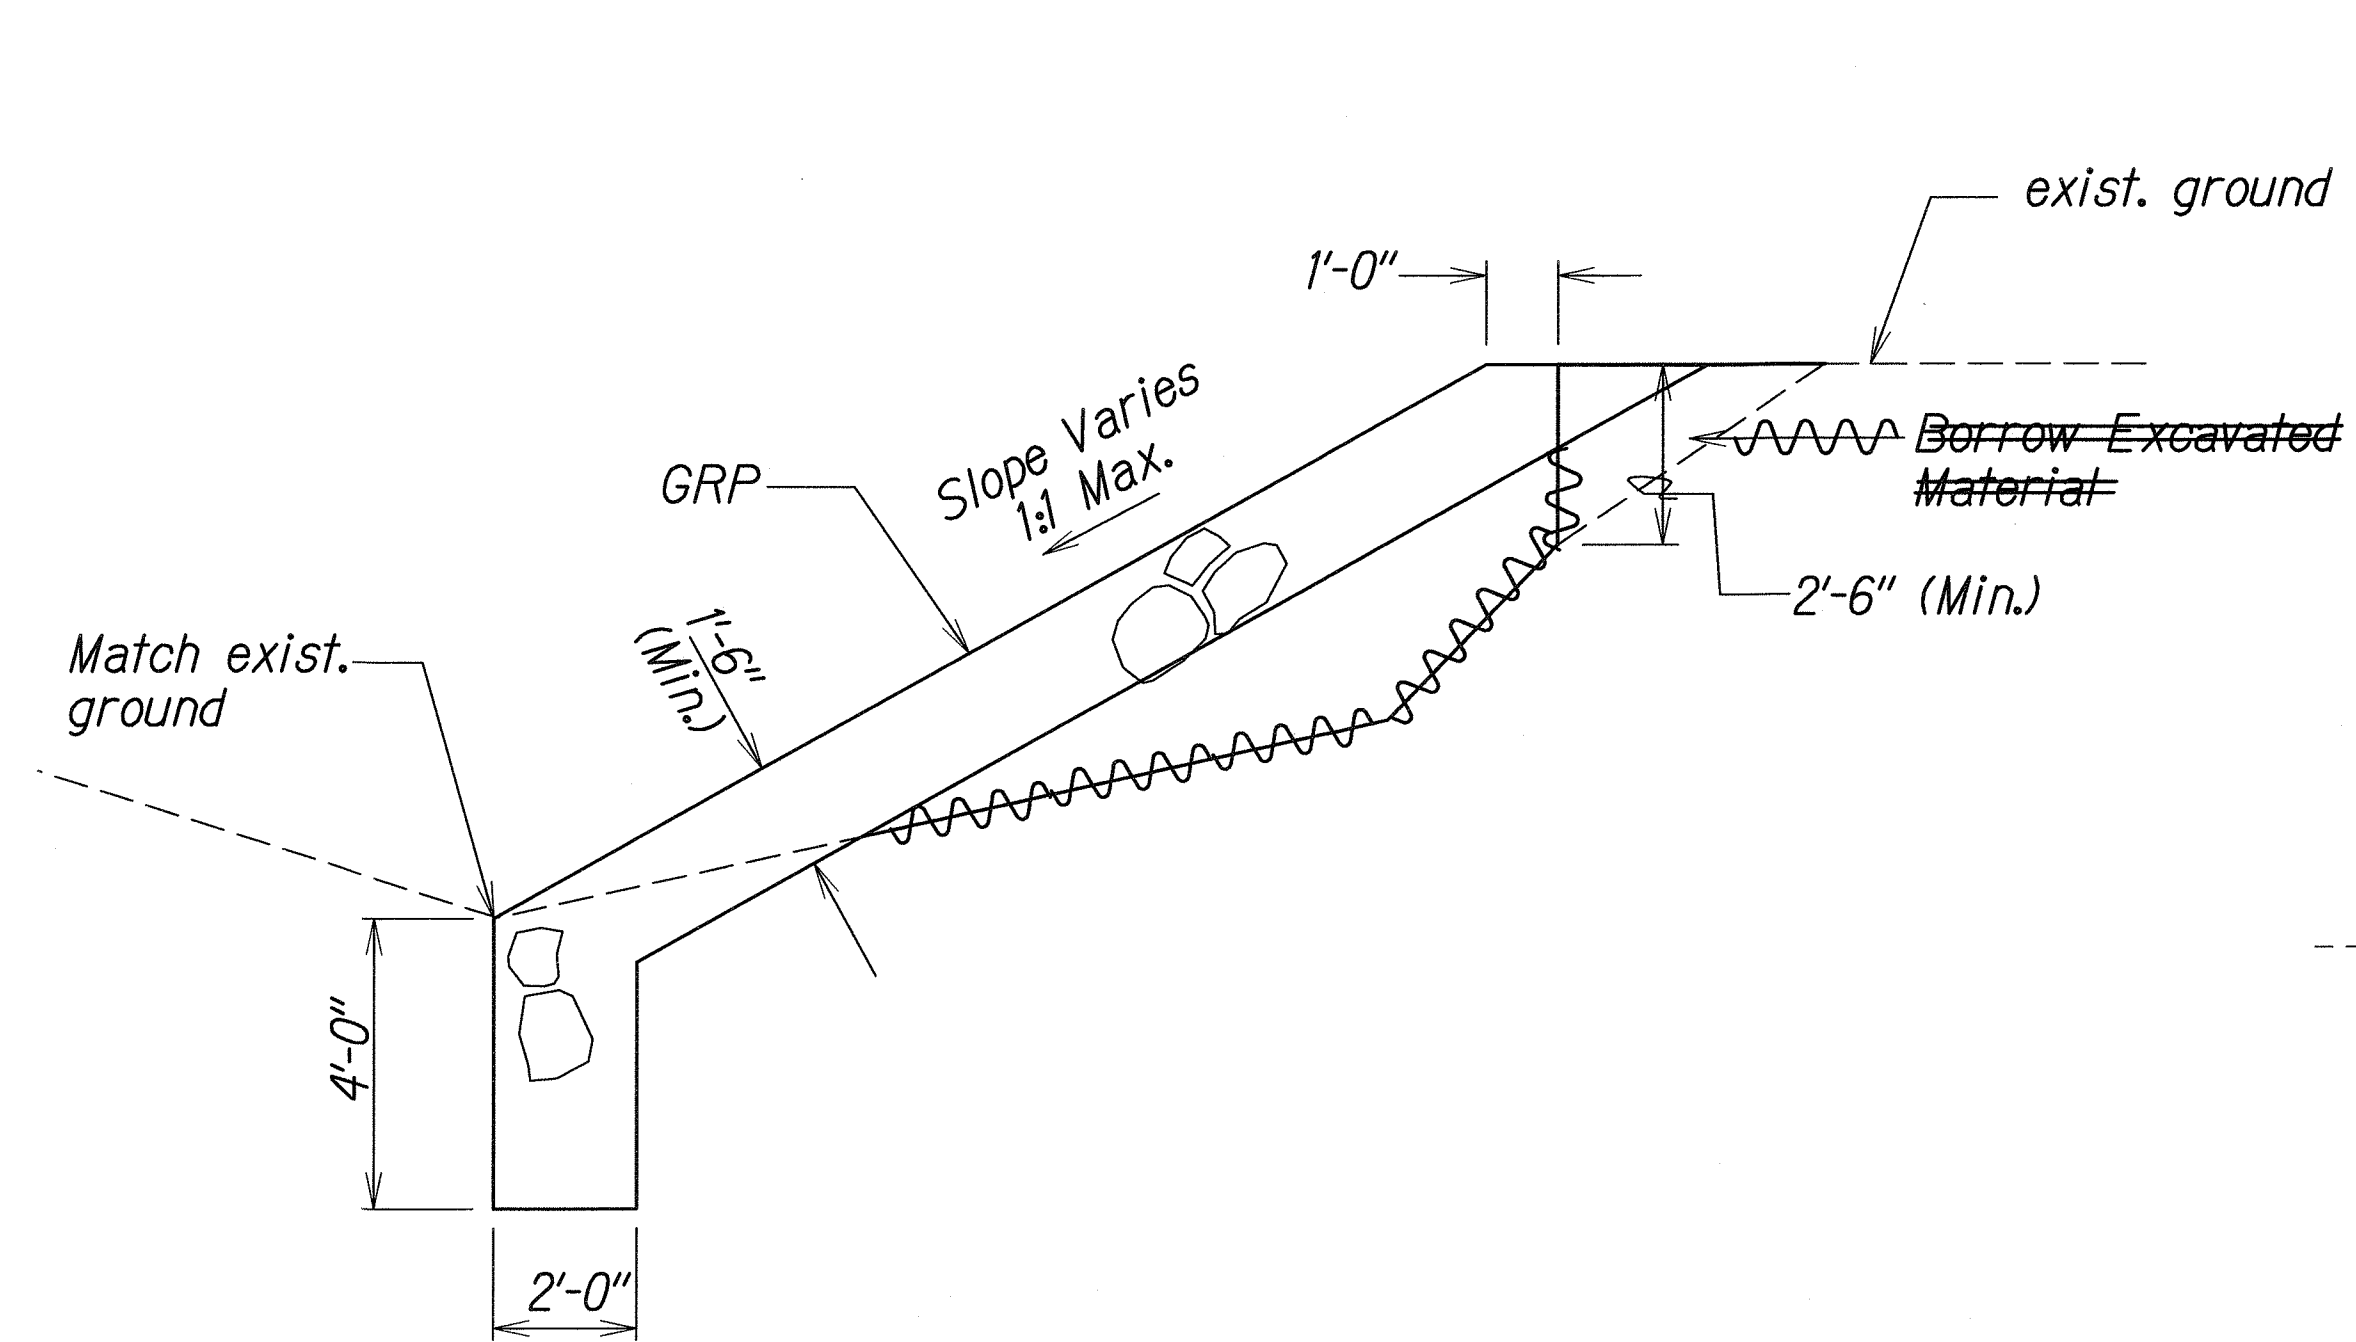

SECTION A
Scale: 3/8"=1'-0"

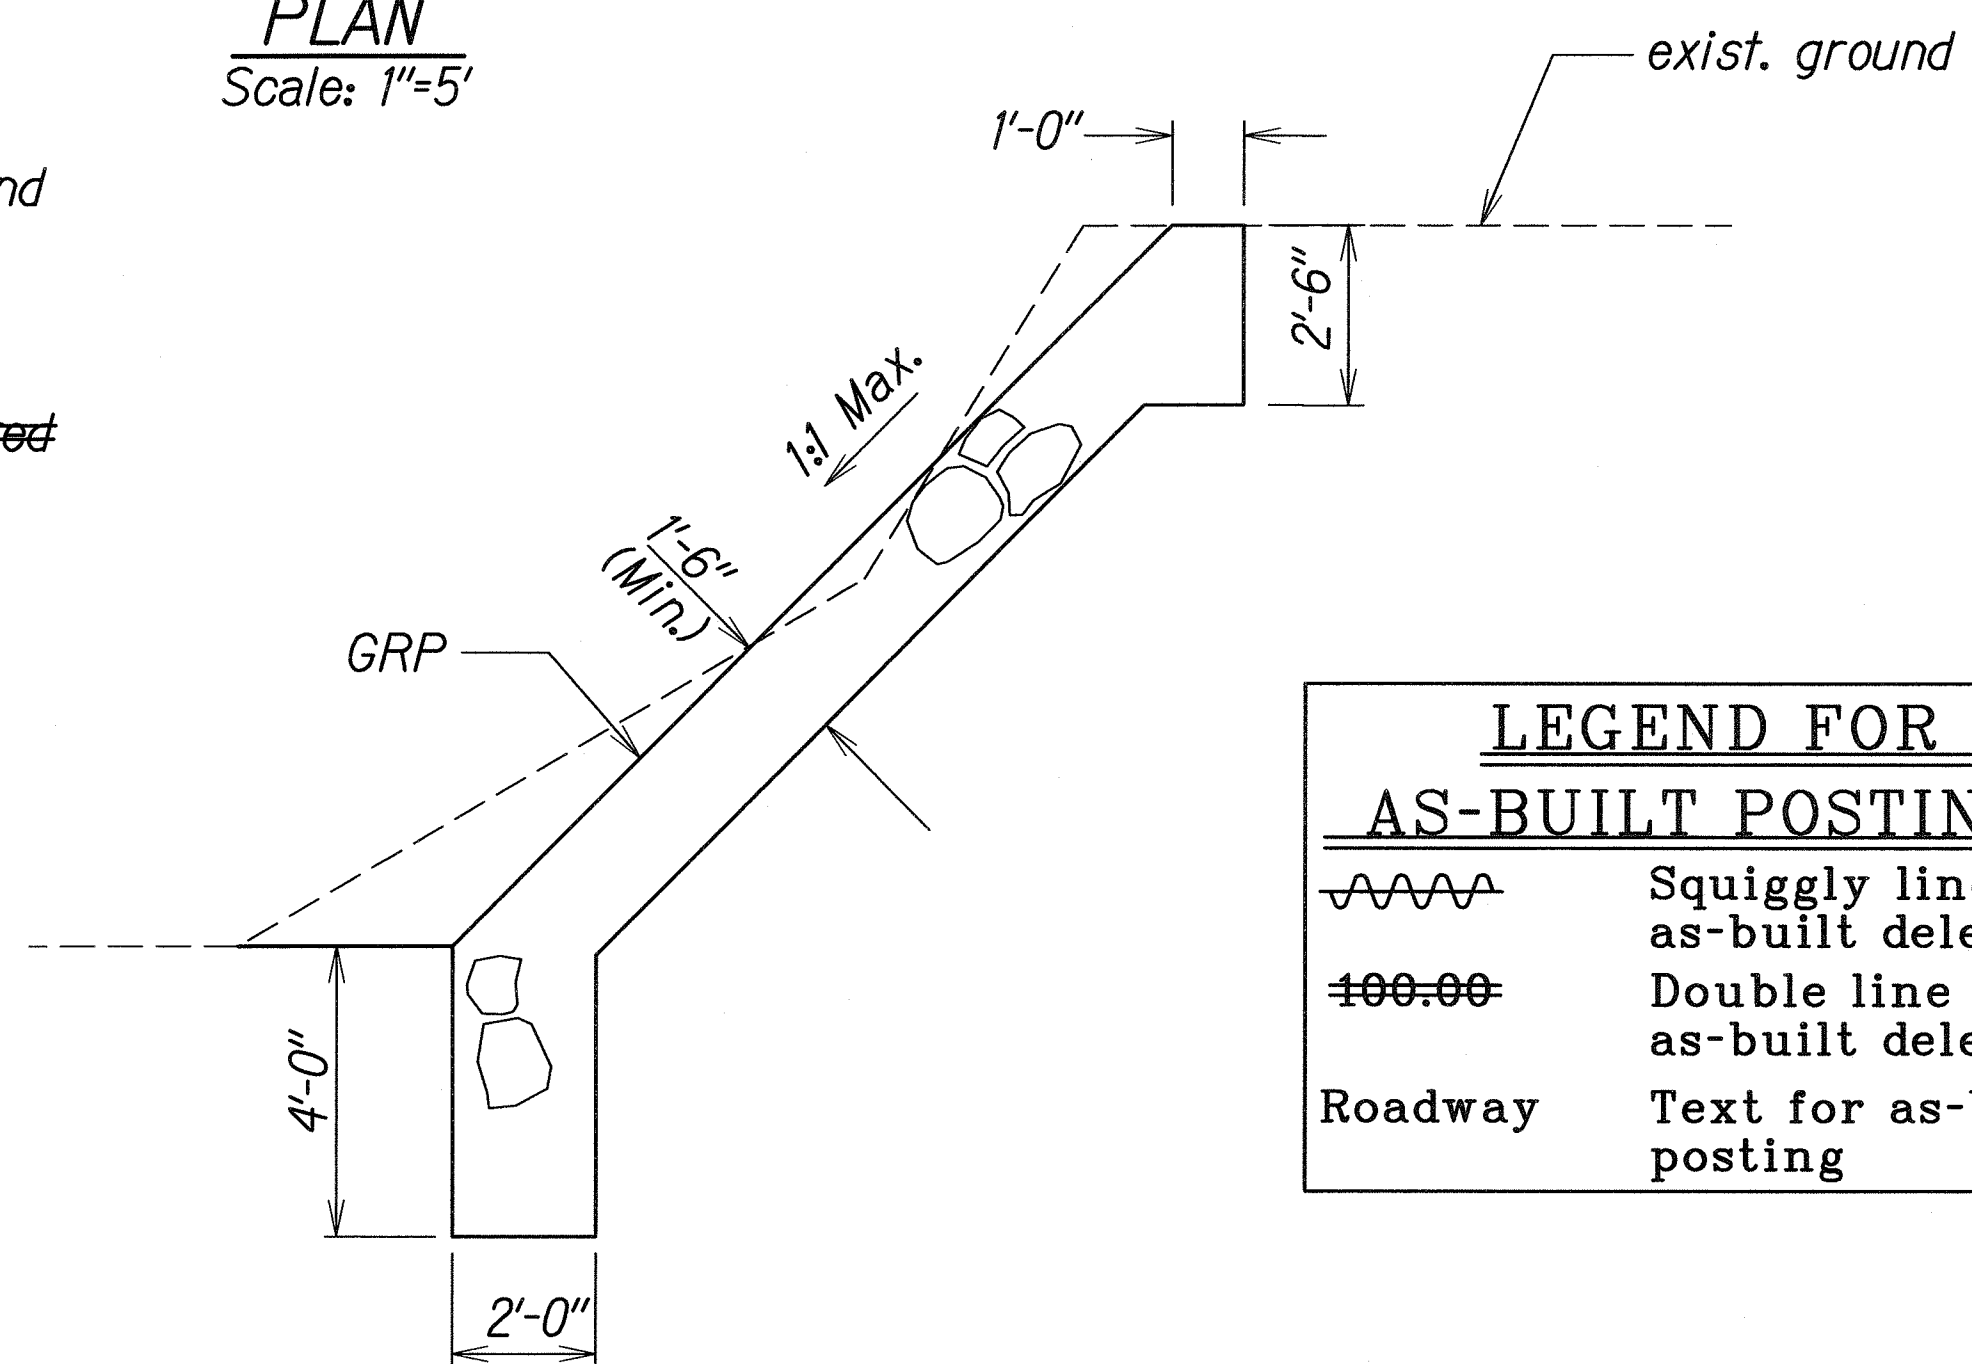

SECTION B
Scale: 3/8"=1'-0"

LEGEND FOR AS-BUILT POSTINGS	
	Squiggly line for as-built deletion
	Double line for as-built deletion
Roadway	Text for as-built posting

ORIGINAL PLAN	SURVEY PLOTTED BY	DATE
NOTE BOOK	DRAWN BY	
CHITKASANO	CHECKED BY	
CHITKASANO	APPROVED BY	

STATE OF HAWAII
DEPARTMENT OF TRANSPORTATION
HIGHWAYS DIVISION

DRAINAGE DETAIL

KULA HIGHWAY FLOOD DAMAGE REPAIRS
AT VARIOUS LOCATIONS
Project No. 37CDE-01-08M

Scale: As Shown Date: April, 2008

SHEET No. 11 OF 1 SHEETS

"AS-BUILT"