

FED. ROAD DIST. NO.	STATE	PROJ. NO.	FISCAL YEAR	SHEET NO.	TOTAL SHEETS
HAWAII	HAW.	37CDE-01-08M	2008	6	30

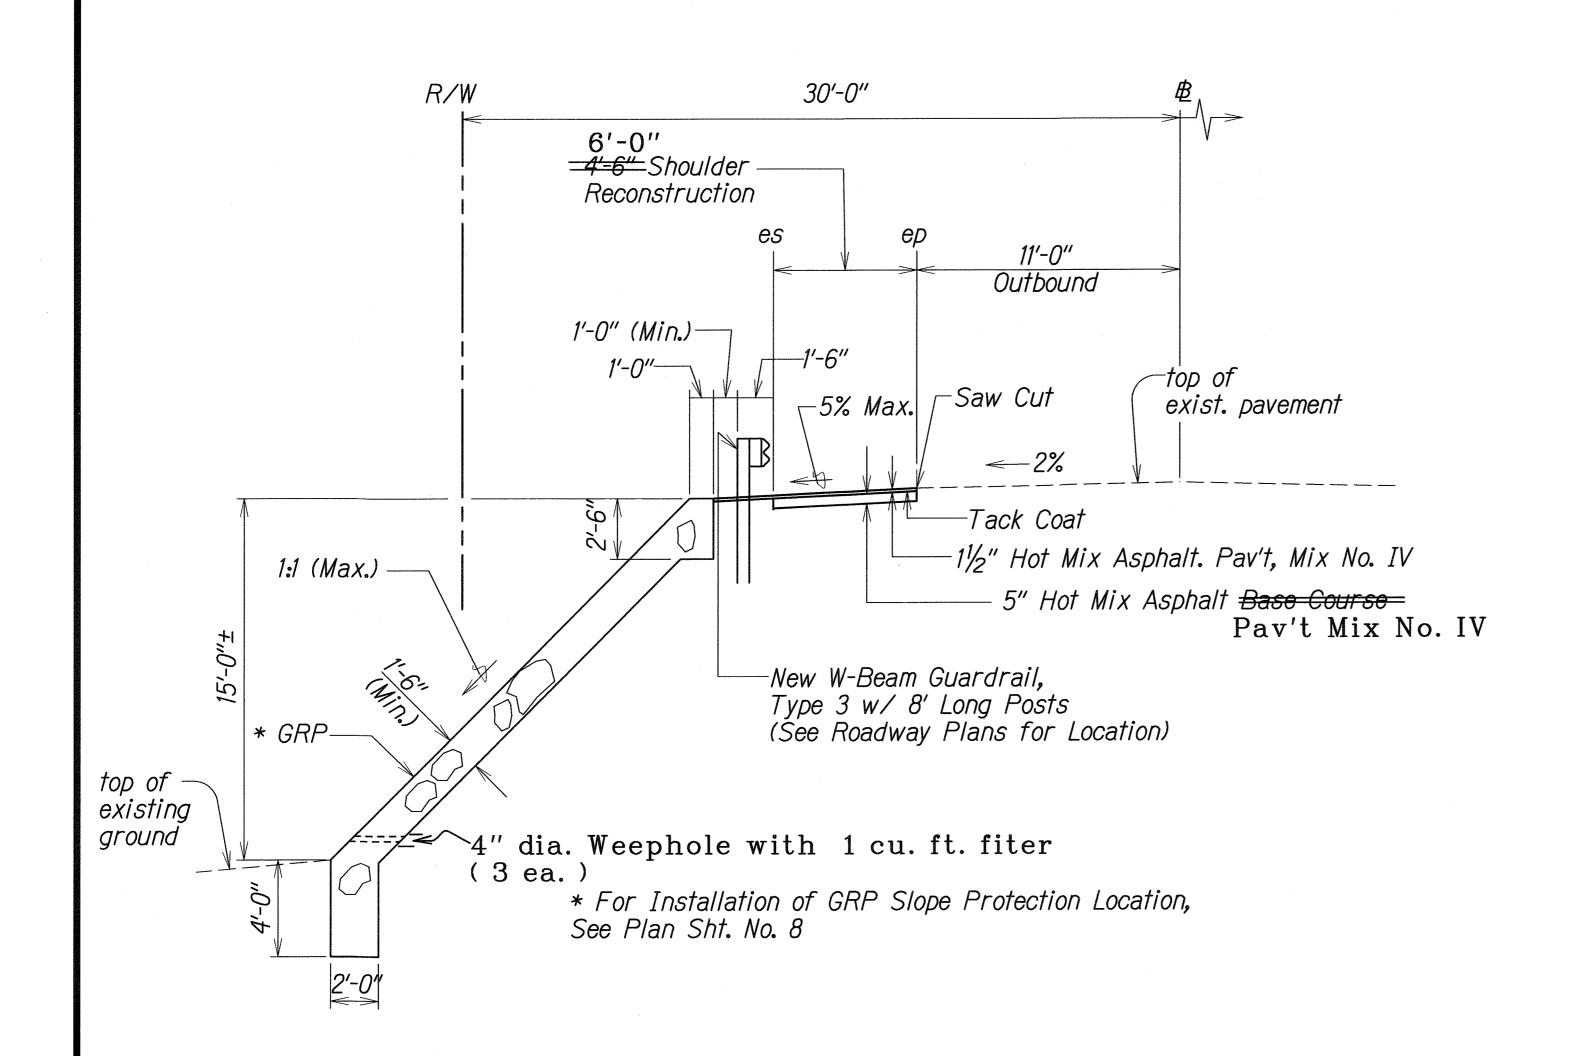

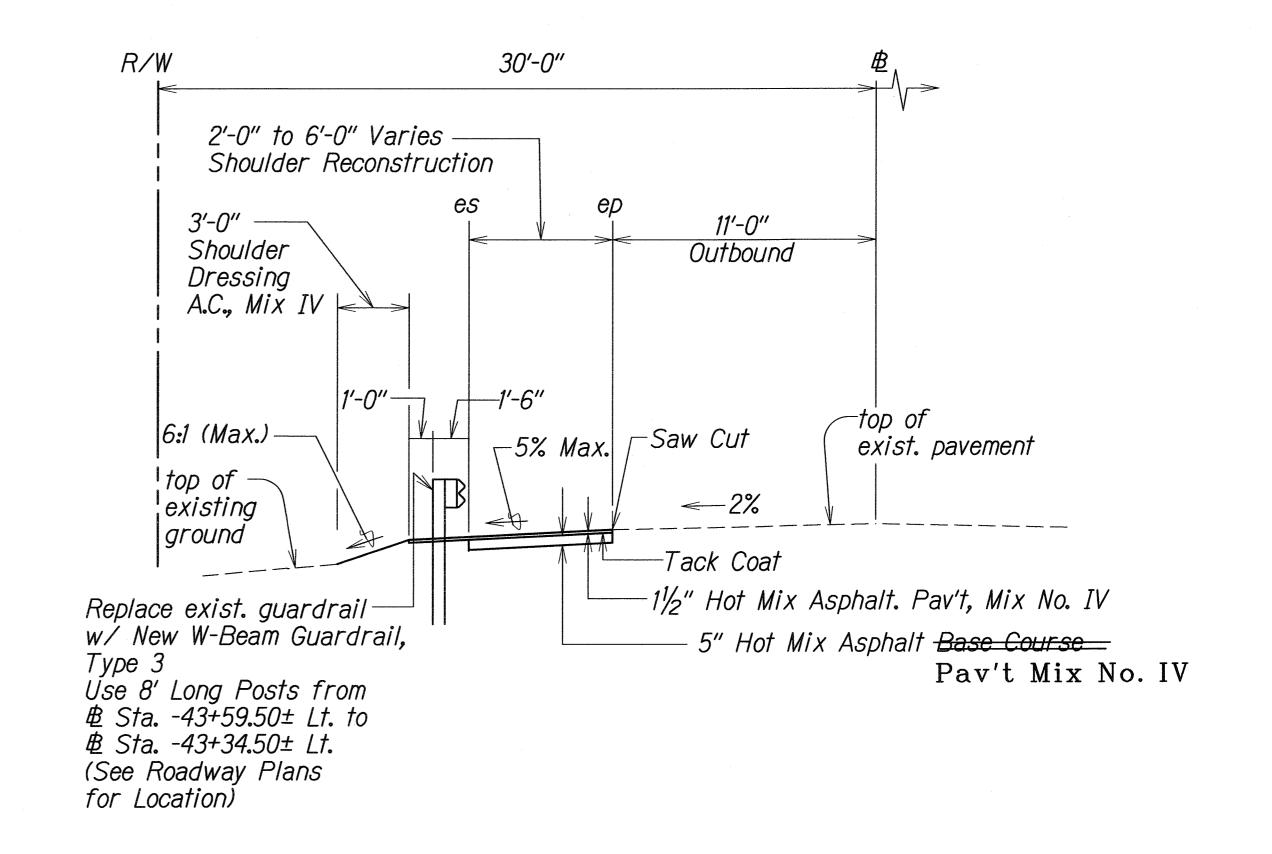


## PARTIAL TYPICAL SECTION £ STA. -44+09.50± LT. TO ₺ STA. -42+09.50± LT. (OUTBOUND)

Scale:1/4"=1'-0"

## PARTIAL TYPICAL SECTION # STA. -48+84.00± LT. TO # STA. -47+58.00± LT. (OUTBOUND)

Scale:1/4"=1'-0"

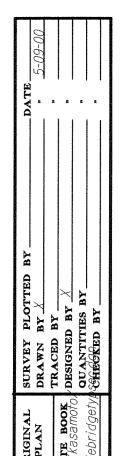

1. Should the Shoulder Reconstruction Drop Off exceed  $6\frac{1}{2}$ " from the top of Finish Pavement, HMA Base Course should be used as Fill Material between the New Pavement and the Shoulder Reconstruction.

2. Dressing of Shoulder should consist of clearing, grubbing, reshaping, and compacting the unpaved shoulders with suitable excavated material as shown on the plans and/or as directed by the Engineer. This work shall be considered incidental to the various contract items.

LEGEND FOR AS-BUILT POSTINGS Squiggly line for as-built deletion  $\overline{}$ <del>100.00</del> Double line for as-built deletion Text for as-built posting Roadway

06/05/08 Added Plan sheet callout for GRP REVISION STATE OF HAWAII DEPARTMENT OF TRANSPORTATION TYPICAL SECTION


KULA HIGHWAY FLOOD DAMAGE REPAIRS AT VARIOUS LOCATIONS Project No. 37CDE-01-08M

Scale: As shown

Date: April, 2008 SHEET No. 1 OF 2 SHEETS

"AS-BUILT"

ADD 6

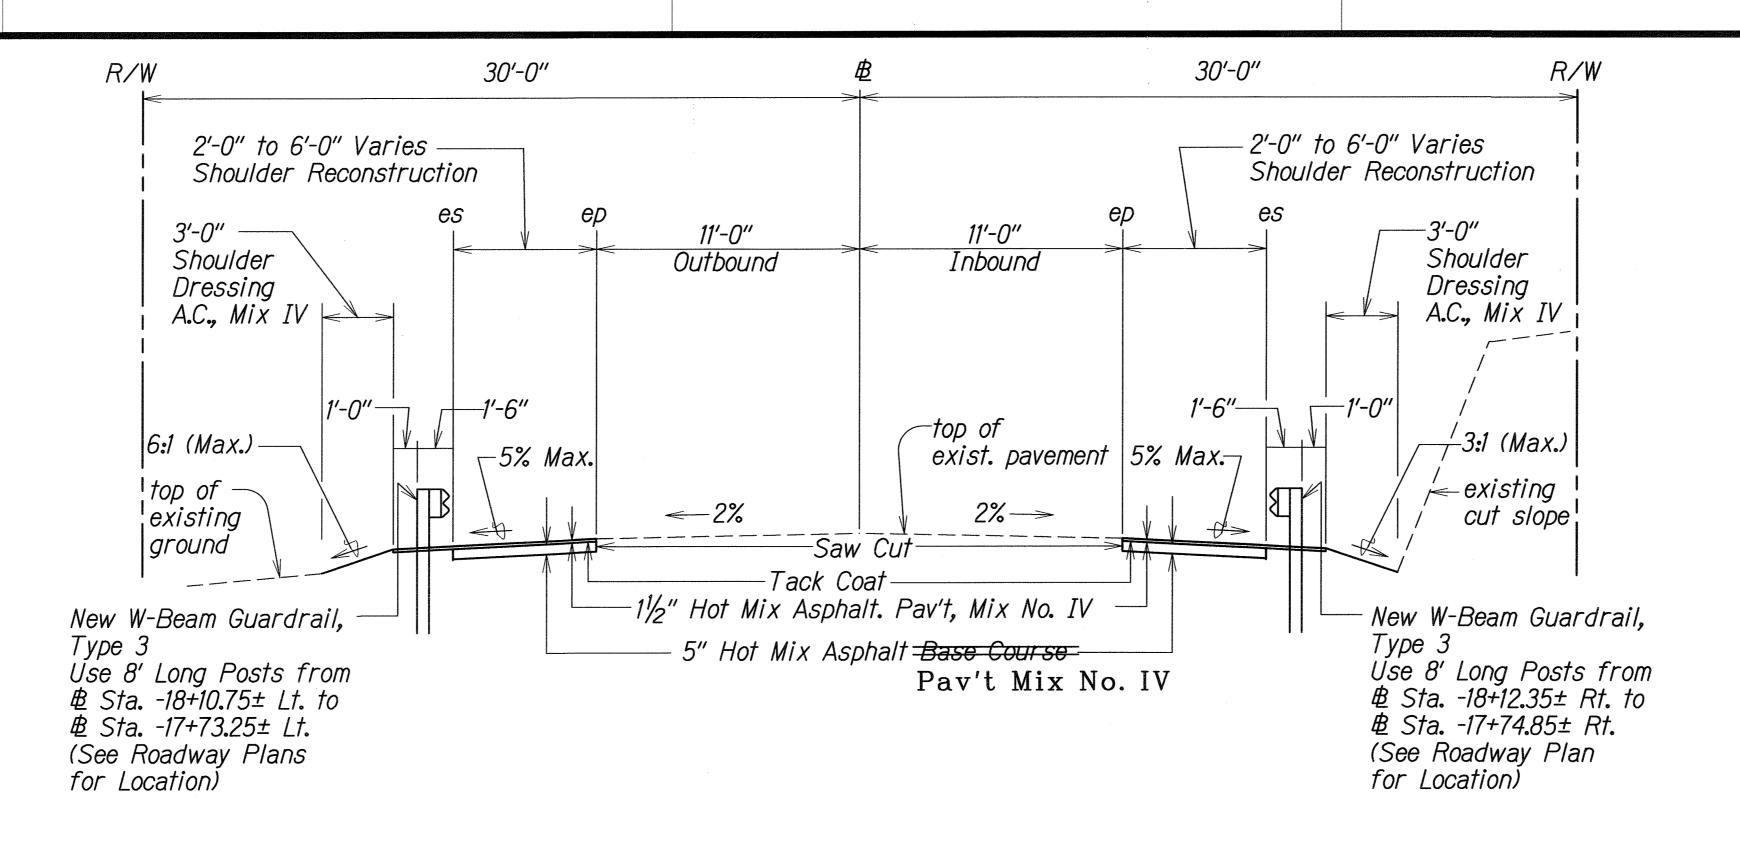

TYPICAL SECTION

型 STA. -51+24.75± LT. TO 型 STA. -49+12.50± LT. (OUTBOUND)
型 STA. -51+00.00± RT. TO 型 STA. -49+44.50± RT. (INBOUND)
型 STA. -18+73.25± LT. TO 型 STA. -16+65.00± LT. (OUTBOUND)
型 STA. -18+57.00± RT. TO 型 STA. -17+34.00± RT. (INBOUND)

Scale:1/4"=1'-0"

Note

1. Should the Shoulder Reconstruction Drop Off exceed  $6\frac{1}{2}$ " from the top of Finish Pavement, HMA Base Course should be used as Fill Material between the New Pavement and the Shoulder Reconstruction.

2. Dressing of Shoulder should consist of clearing, grubbing, reshaping, and compacting the unpaved shoulders with suitable excavated material as shown on the plans and/or as directed by the Engineer. This work shall be considered incidental to the various contract items.

LEGEND FOR AS-BUILT POSTINGS

Squiggly line for as-built deletion

Squiggly line for as-built deletion

Double line for as-built deletion

Roadway Text for as-built posting

06/05/08 Revised Location of Typical Section

DATE REVISION

FED. ROAD DIST. NO.

HAW. 37CDE-01-08M

FISCAL SHEET YEAR NO.

2008

STATE OF HAWAII
DEPARTMENT OF TRANSPORTATION
HIGHWAYS DIVISION

TYPICAL SECTION

KULA HIGHWAY FLOOD DAMAGE REPAIRS

AT VARIOUS LOCATIONS

Project No. 37CDE-01-08M

Scale: As shown

Date: April, 2008

SHEET No. 2 OF 2 SHEETS

AS-BUILT''

ADD 7