




FED. ROAD DIST. NO.	STATE	PROJ. NO.	FISCAL YEAR	SHEET NO.	TOTAL SHEETS
HAWAII	HAW.	37E-01-12M	2012	ADD.7	18

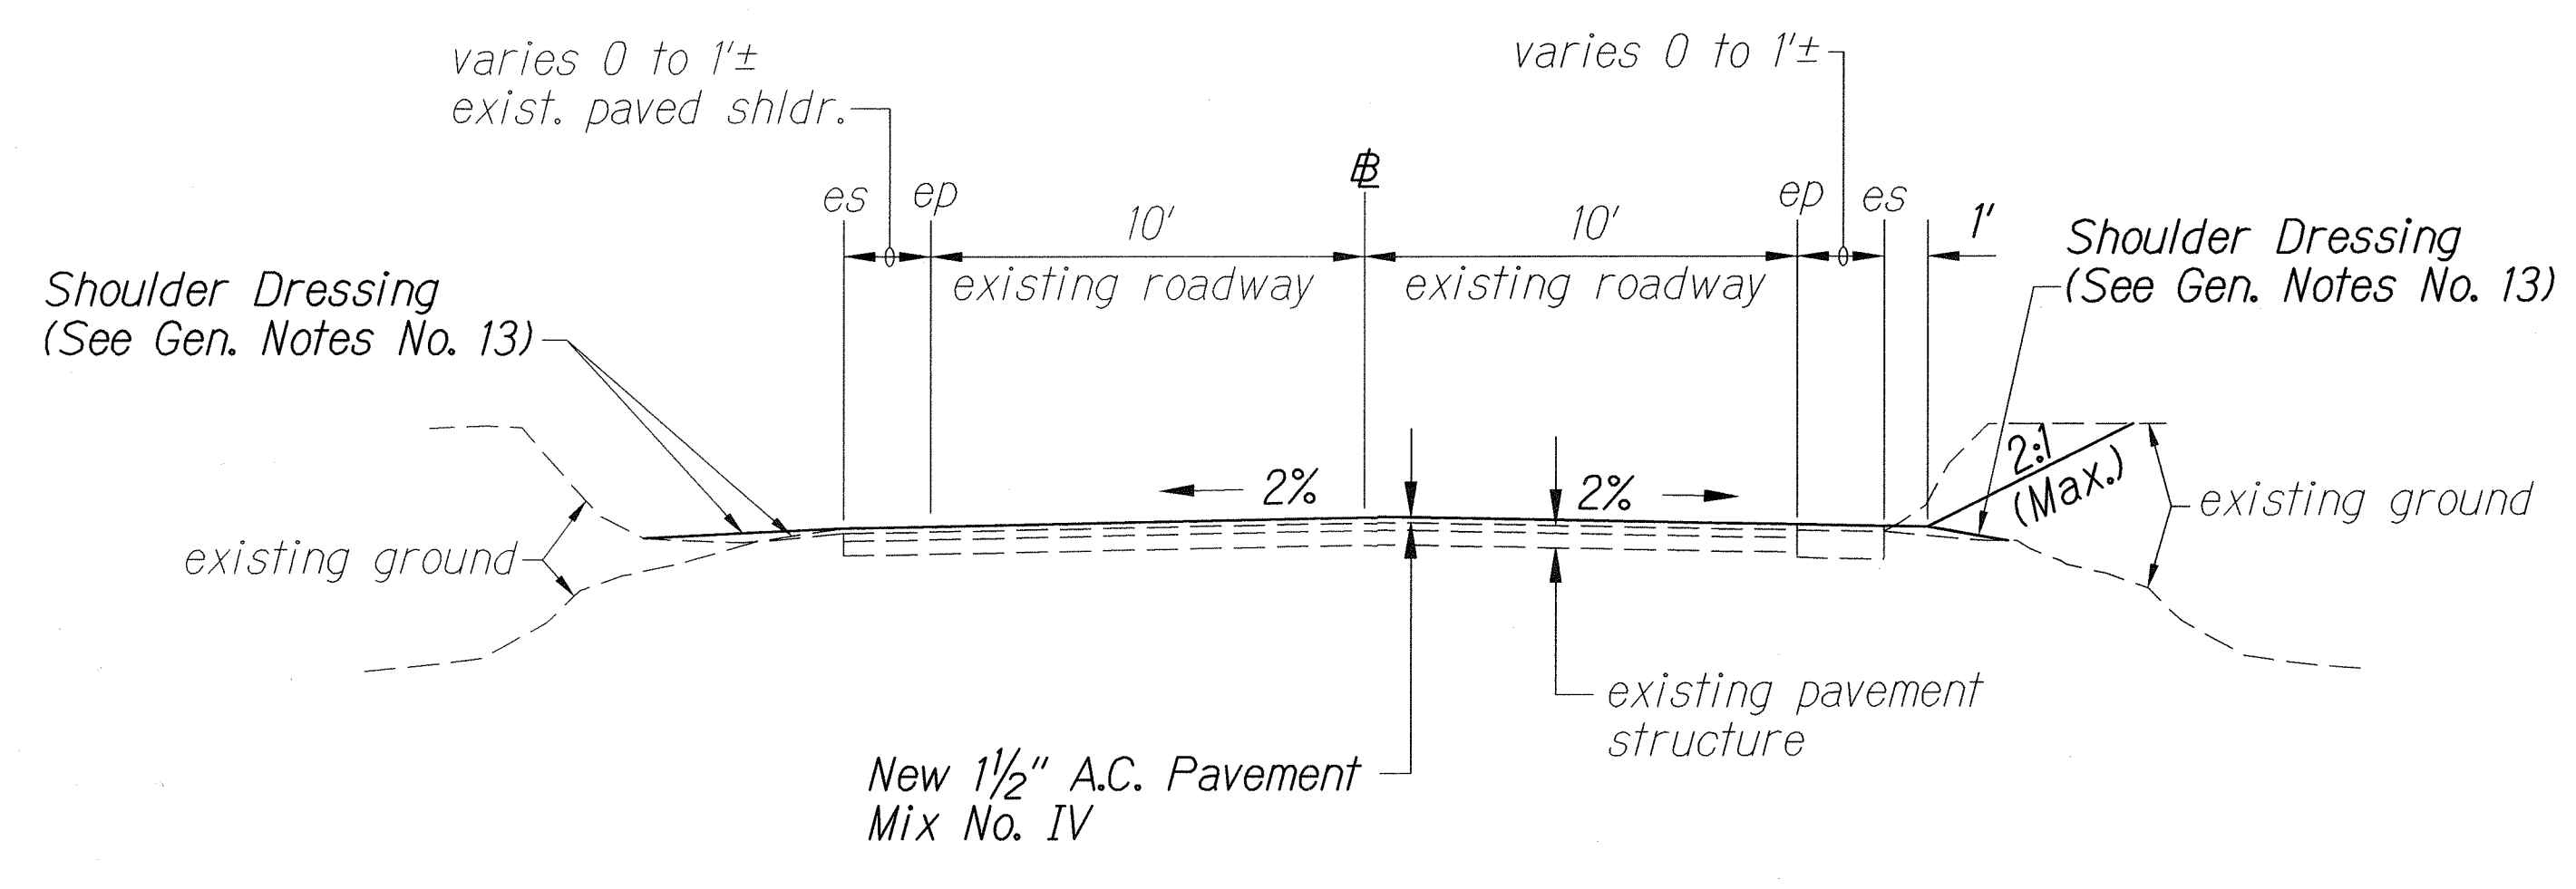


TYPICAL SECTION ON TANGENTS
 STA. -225+98± TO STA. 0+00±
 Scale: 1/4" = 1'-0"

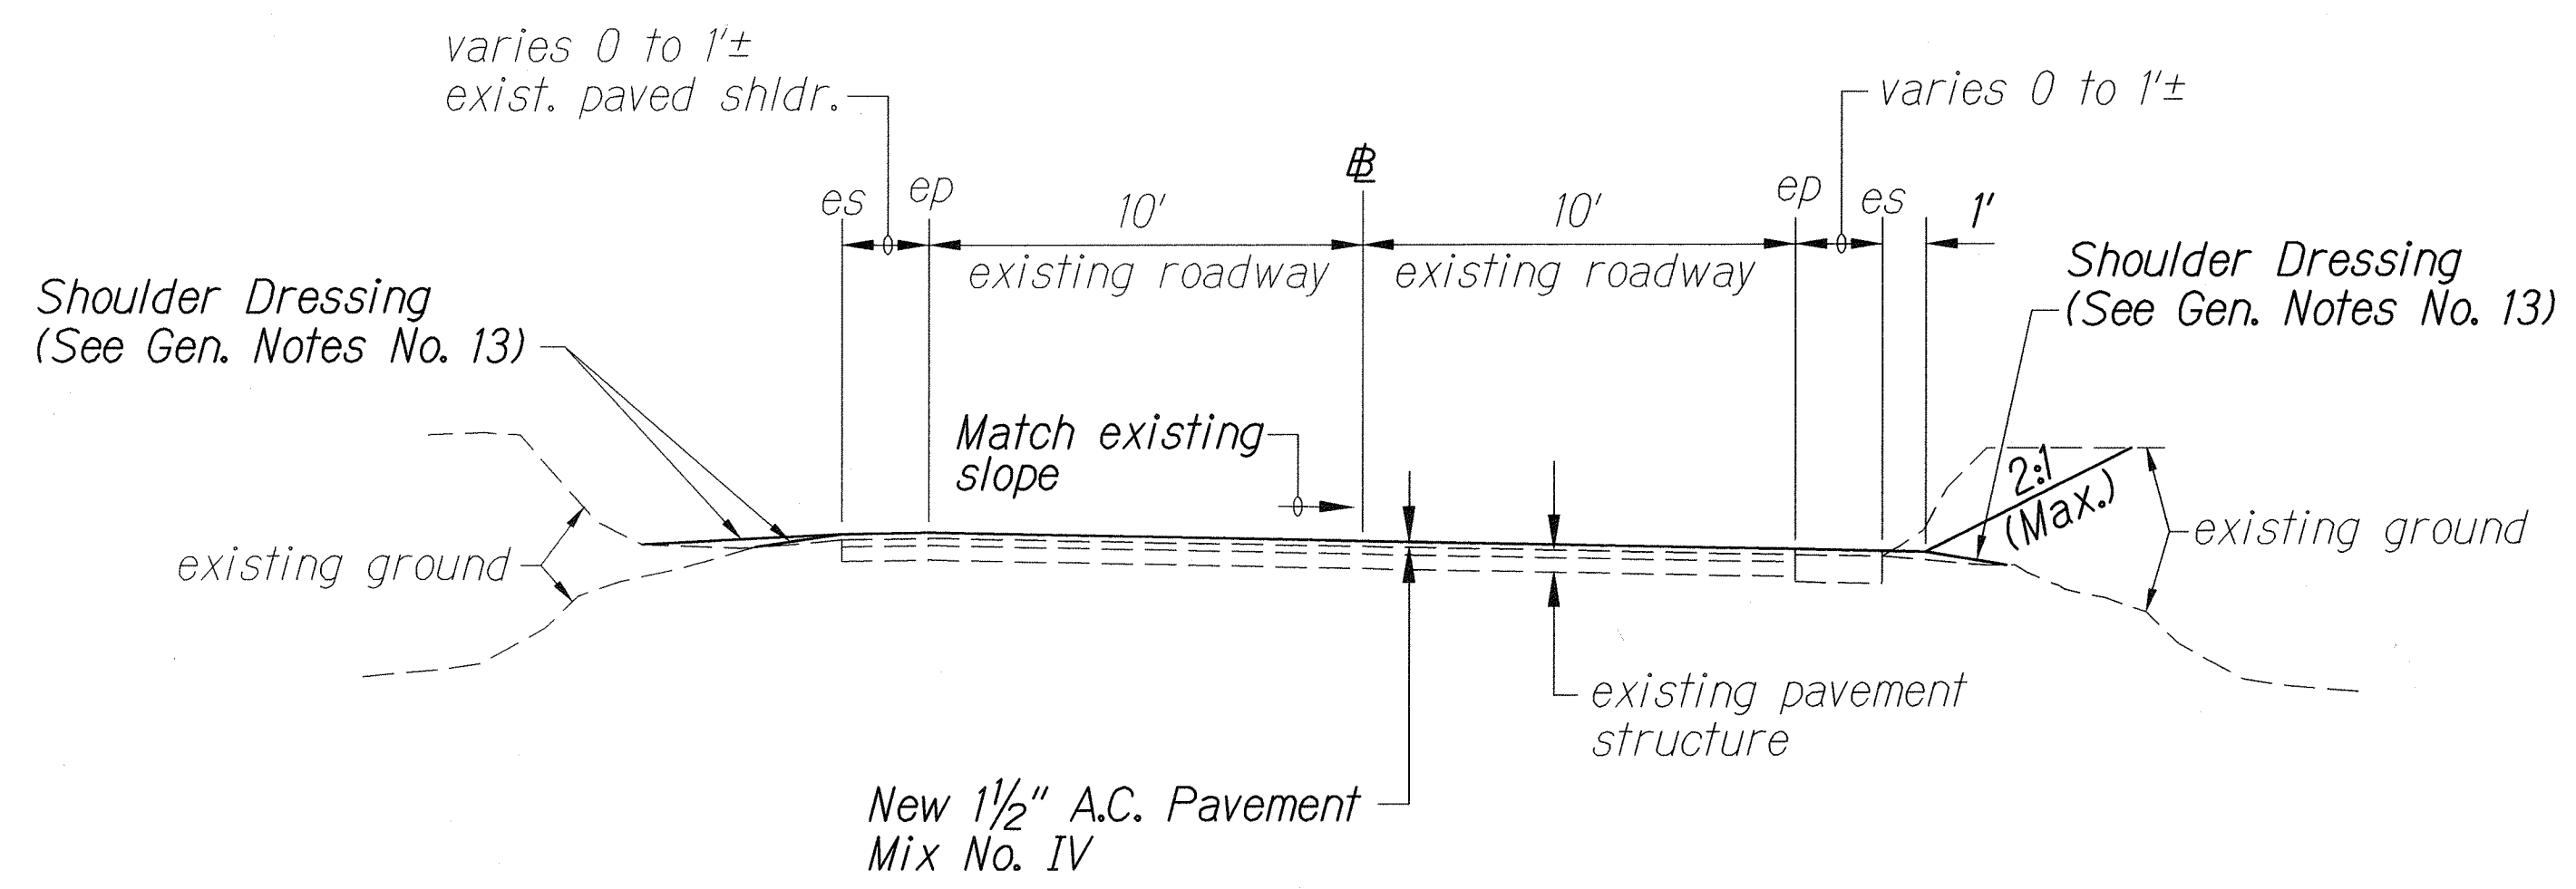

TYPICAL SECTION ON CURVES
 STA. -225+98± TO STA. 0+00±
 Scale: 1/4" = 1'-0"

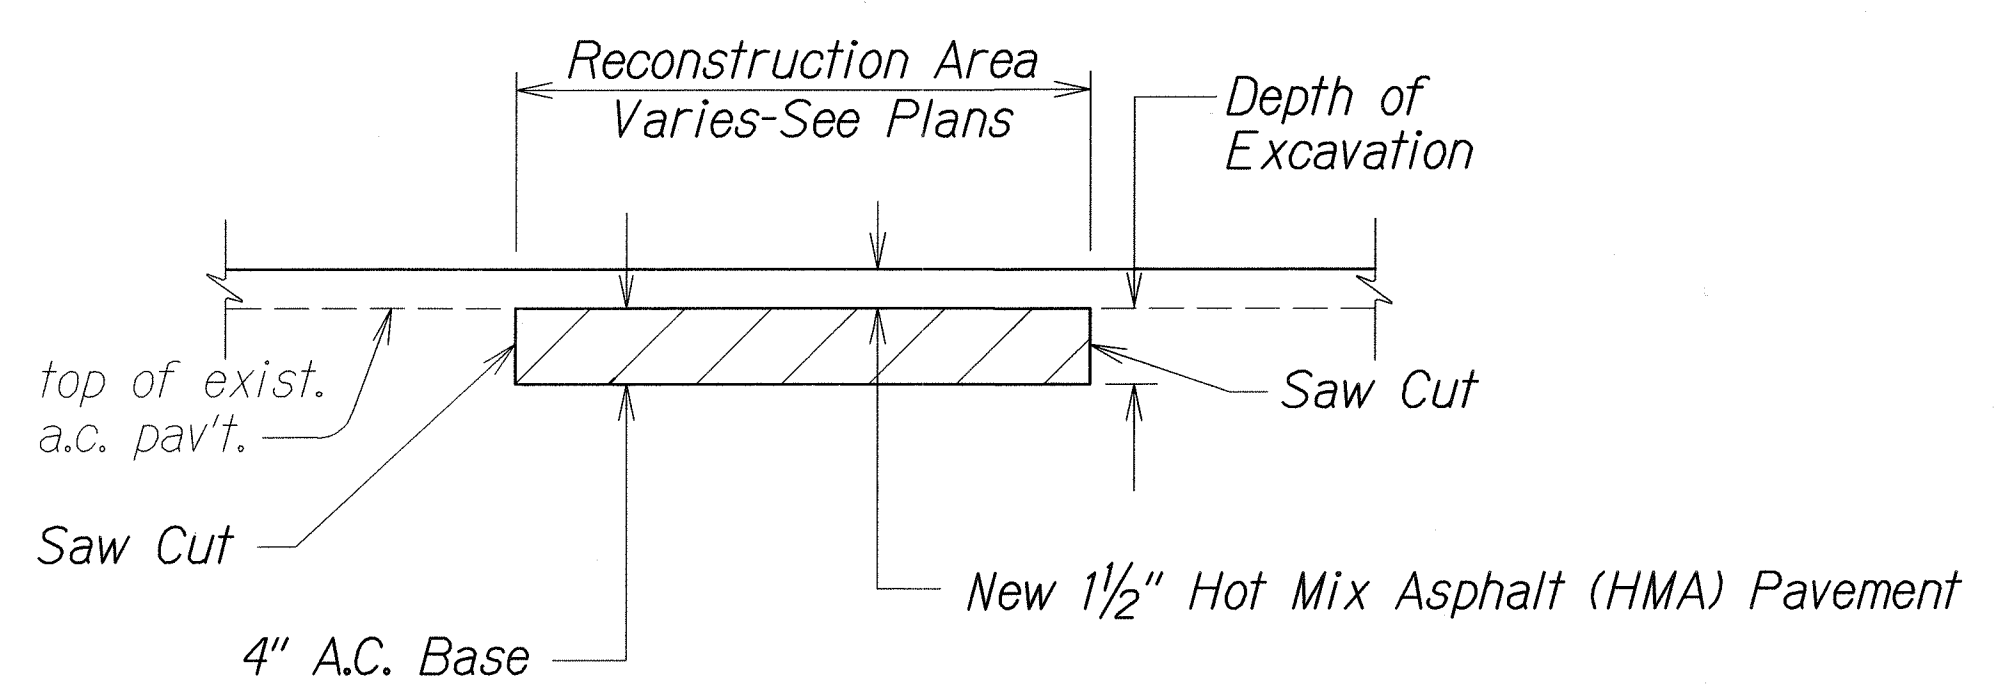


A.C. PAVEMENT RECONSTRUCTION DETAIL
 Not To Scale

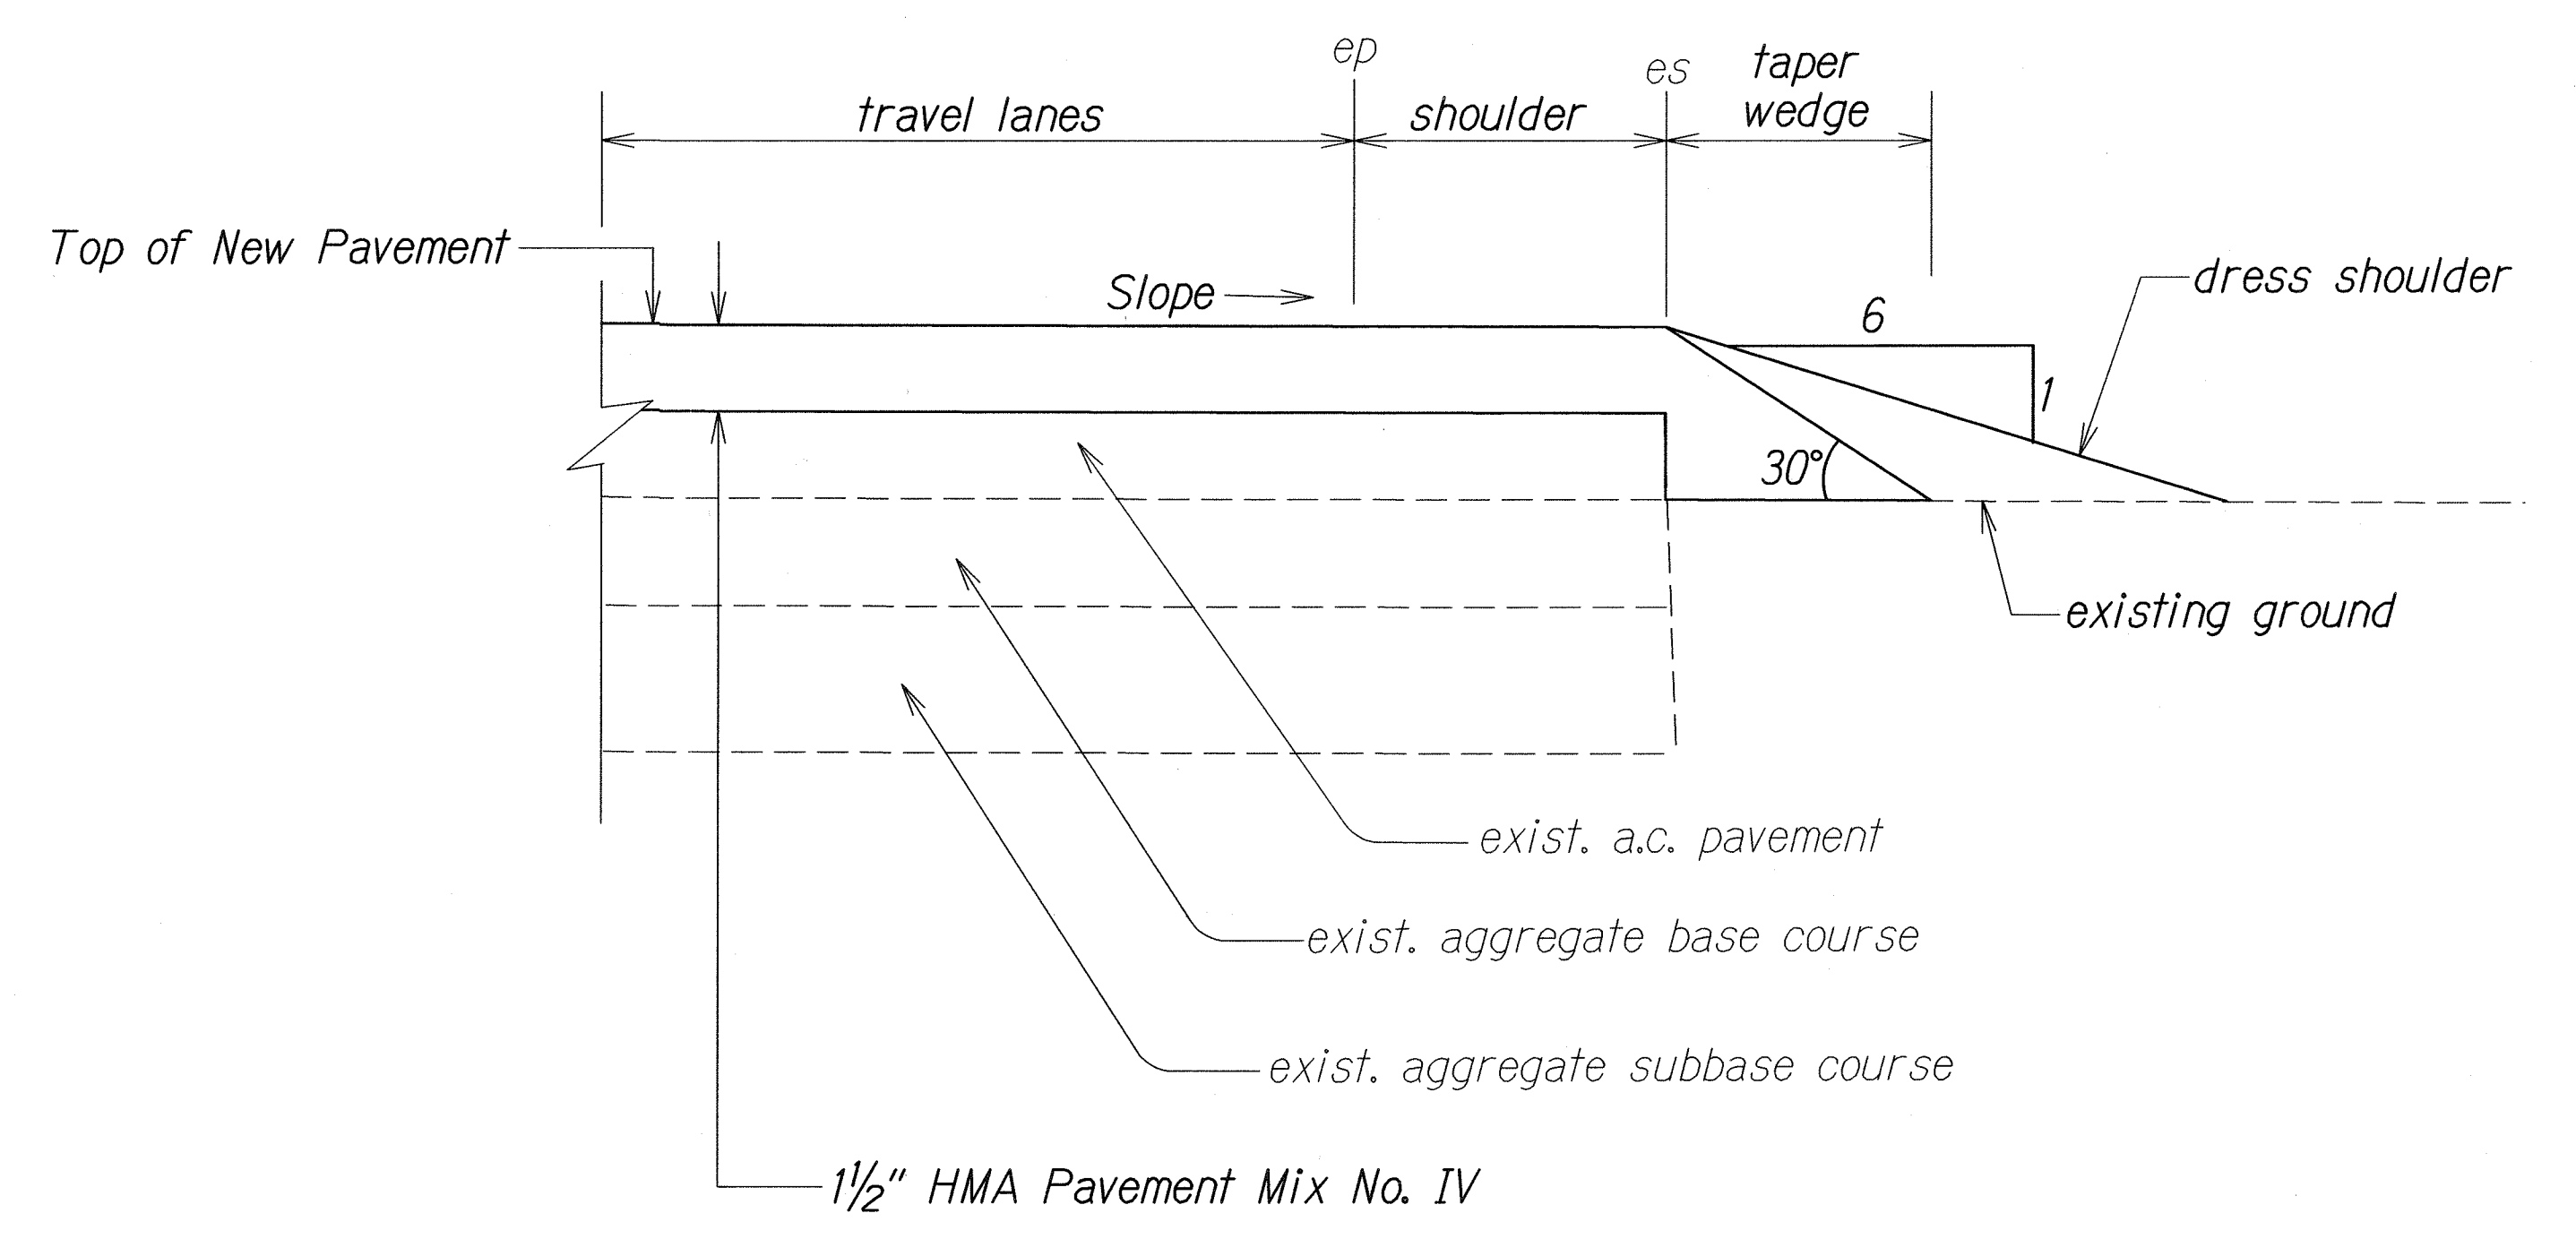

Note: Contractor shall mount a device directly on the paver screed extension to provide a 30° beveled shoulder edge.

TYPICAL PAVEMENT EDGE DETAIL
 (FOR OVERLAYING PROJECT)
 Not To Scale

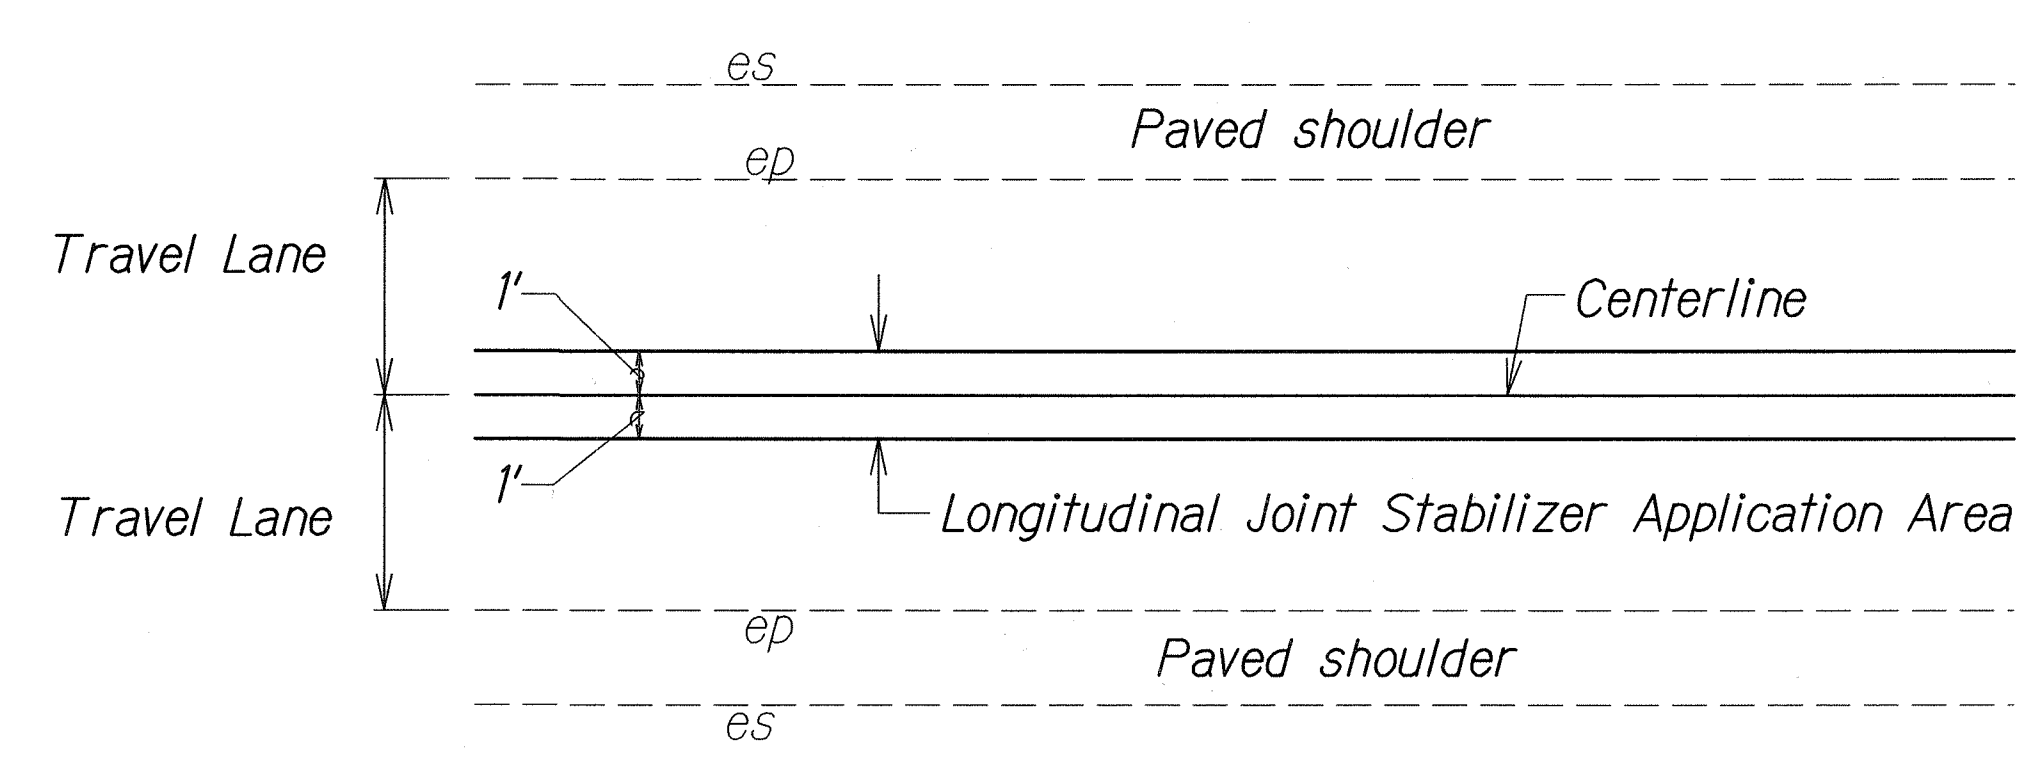

TYPICAL SECTION FOR LONGITUDINAL JOINT STABILIZER
 Not To Scale

3-12-12	Add Typical Section for Longitudinal Joint Stabilizer.
DATE	REVISION

STATE OF HAWAII
DEPARTMENT OF TRANSPORTATION
HIGHWAYS DIVISION

TYPICAL SECTIONS & DETAILS
KULA HIGHWAY PAVEMENT
PREVENTIVE MAINTENANCE
Thompson Road Towards Ulupalakua
Project No. 37E-01-12M
Scale: As Shown Date: December, 2011
SHEET No. 2 OF 2 SHEETS

SURVEY PLOTTED BY	DATE
DESIGNED BY	
TRACED BY	
NOTE BOOK	
QUANTITIES BY	
CHECKED BY	