- 100	INDEX TO DRAWINGS
SHEET NO.	DESCRIPTION
1	TITLE SHEET
2	STANDARD PLANS SUMMARY
3	GENERAL NOTES AND LEGEND
4 – 5	WATER POLLUTION & EROSION CONTROL NOTES
6 – 7	TYPICAL SECTIONS AND DETAILS
8	PAVEMENT MARKING LEGEND, DETAILS AND NOTES
9 – 18	ROADWAY & PAVEMENT MARKING PLANS
	i vi
•	
·	
	·

STATE OF HAWAII

DEPARTMENT OF TRANSPORTATION


DIVISION HIGHWAYS HONOLULU, HAWAII "AS-BUILT"

PLANS FOR

KULA HIGHWAY PAVEMENT PREVENTIVE MAINTENANCE

THOMPSON ROAD TOWARDS ULUPALAKUA **PROJECT NO. 37E-01-12M**

> DISTRICT OF MAKAWAO ISLAND OF MAUI

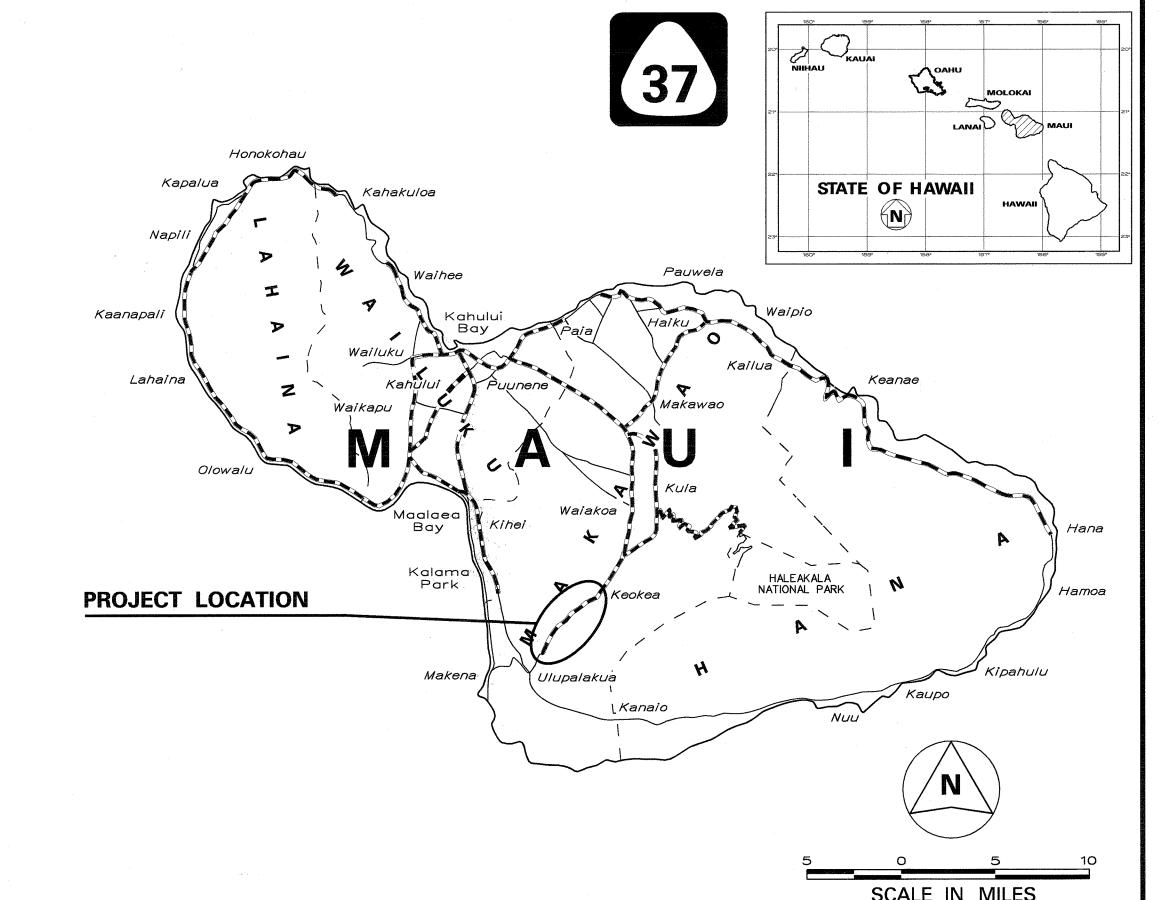


FED. ROAD DIST. NO.

PROJ. NO.

37E-01-12M



MILE POST 17.03 TO MILE POST 21.13

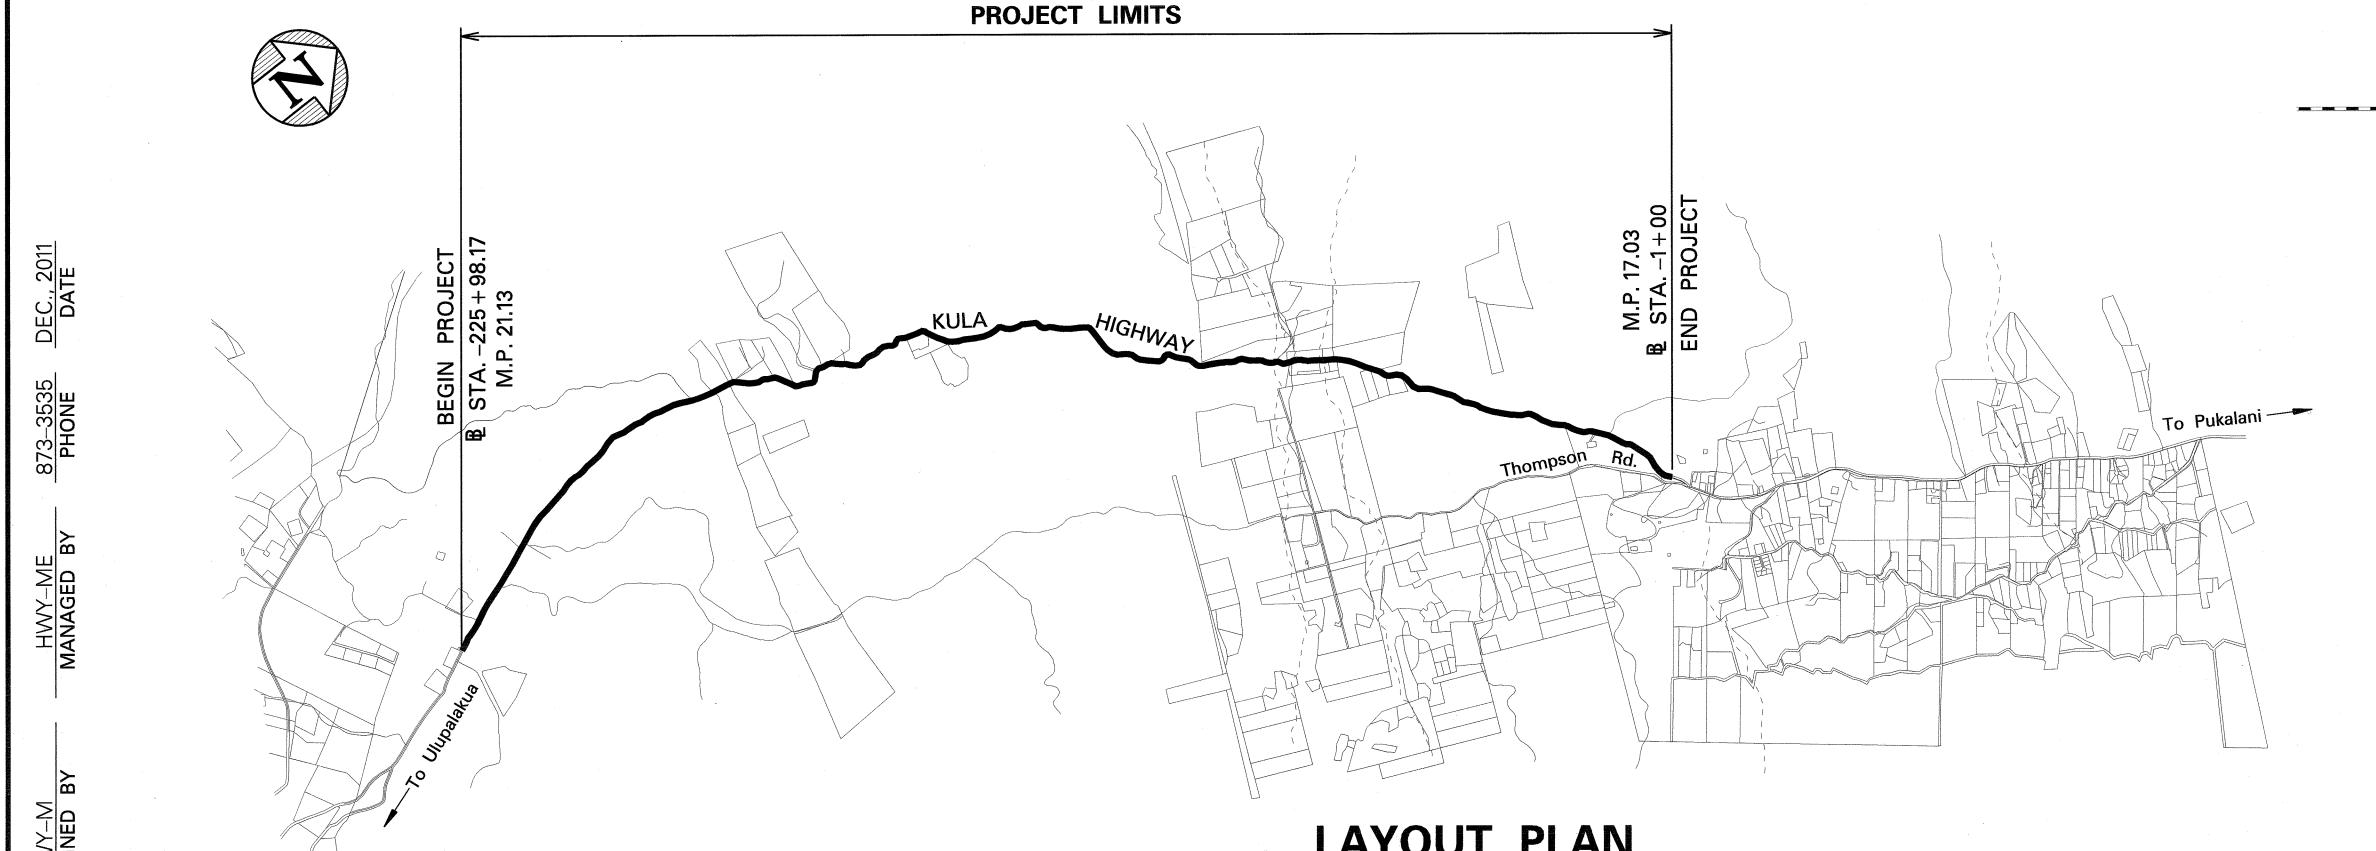

SCALE IN THOUSAND FEET

CHANGES MADE DURING CONSTRUCTION HAVE BEEN INCORPORATED ON THESE PLANS EXCEPT CHANGES IN THE ORIGINAL THEORETICAL QUANTITIES. FOR ACTUAL QUANTITIES, REFER TO PROJECT LEDGER AND/OR COMPUTATION-BOOK.

DEPARTMENT OF TRANSPORTATION STATE OF HAWAII

APPROVED: almi A. Jalusti 2/07/12 FO DIR. OF TRANSPORTATION

LAYOUT PLAN

GROSS LENGTH OF PROJECT.....4.10 MILES NET LENGTH OF PROJECT..... 4.10 MILES