




FED. ROAD DIST. NO.	STATE	PROJ. NO.	FISCAL YEAR	SHEET NO.	TOTAL SHEETS
HAWAII	HAW.	37E-01-12M	2012	6	18

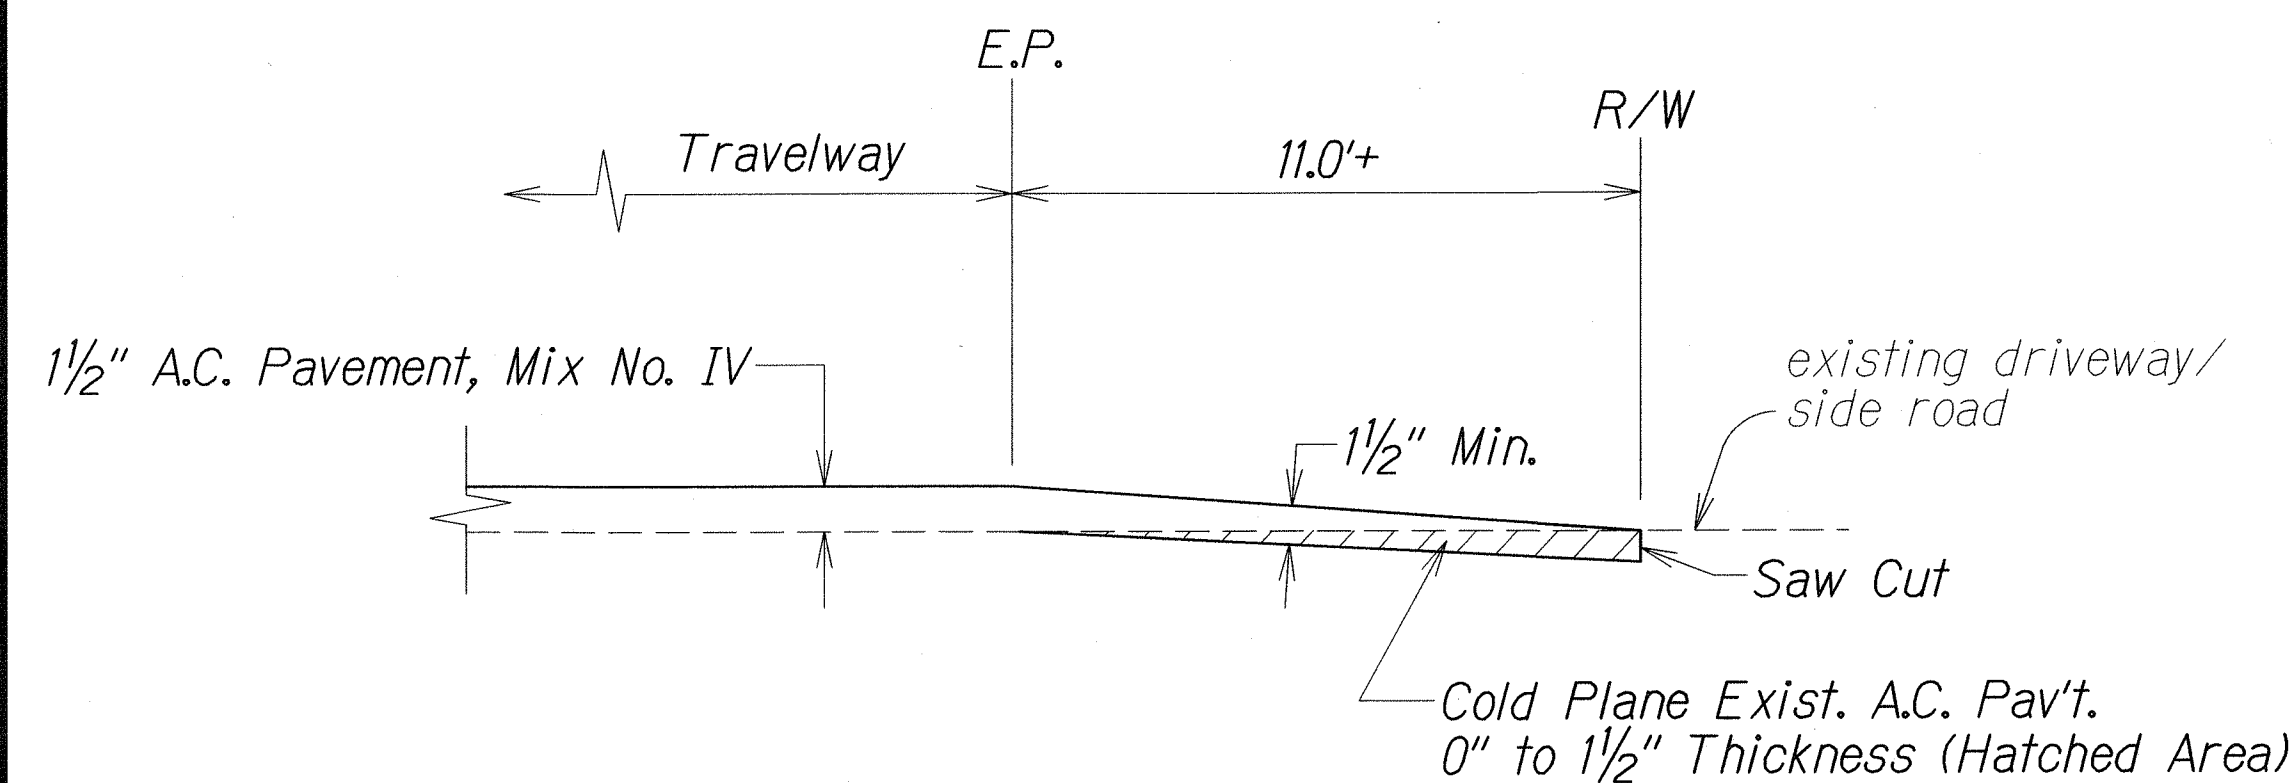


SIDE ROAD/DRIVEWAY PAVING TRANSITION DETAIL
Not To Scale

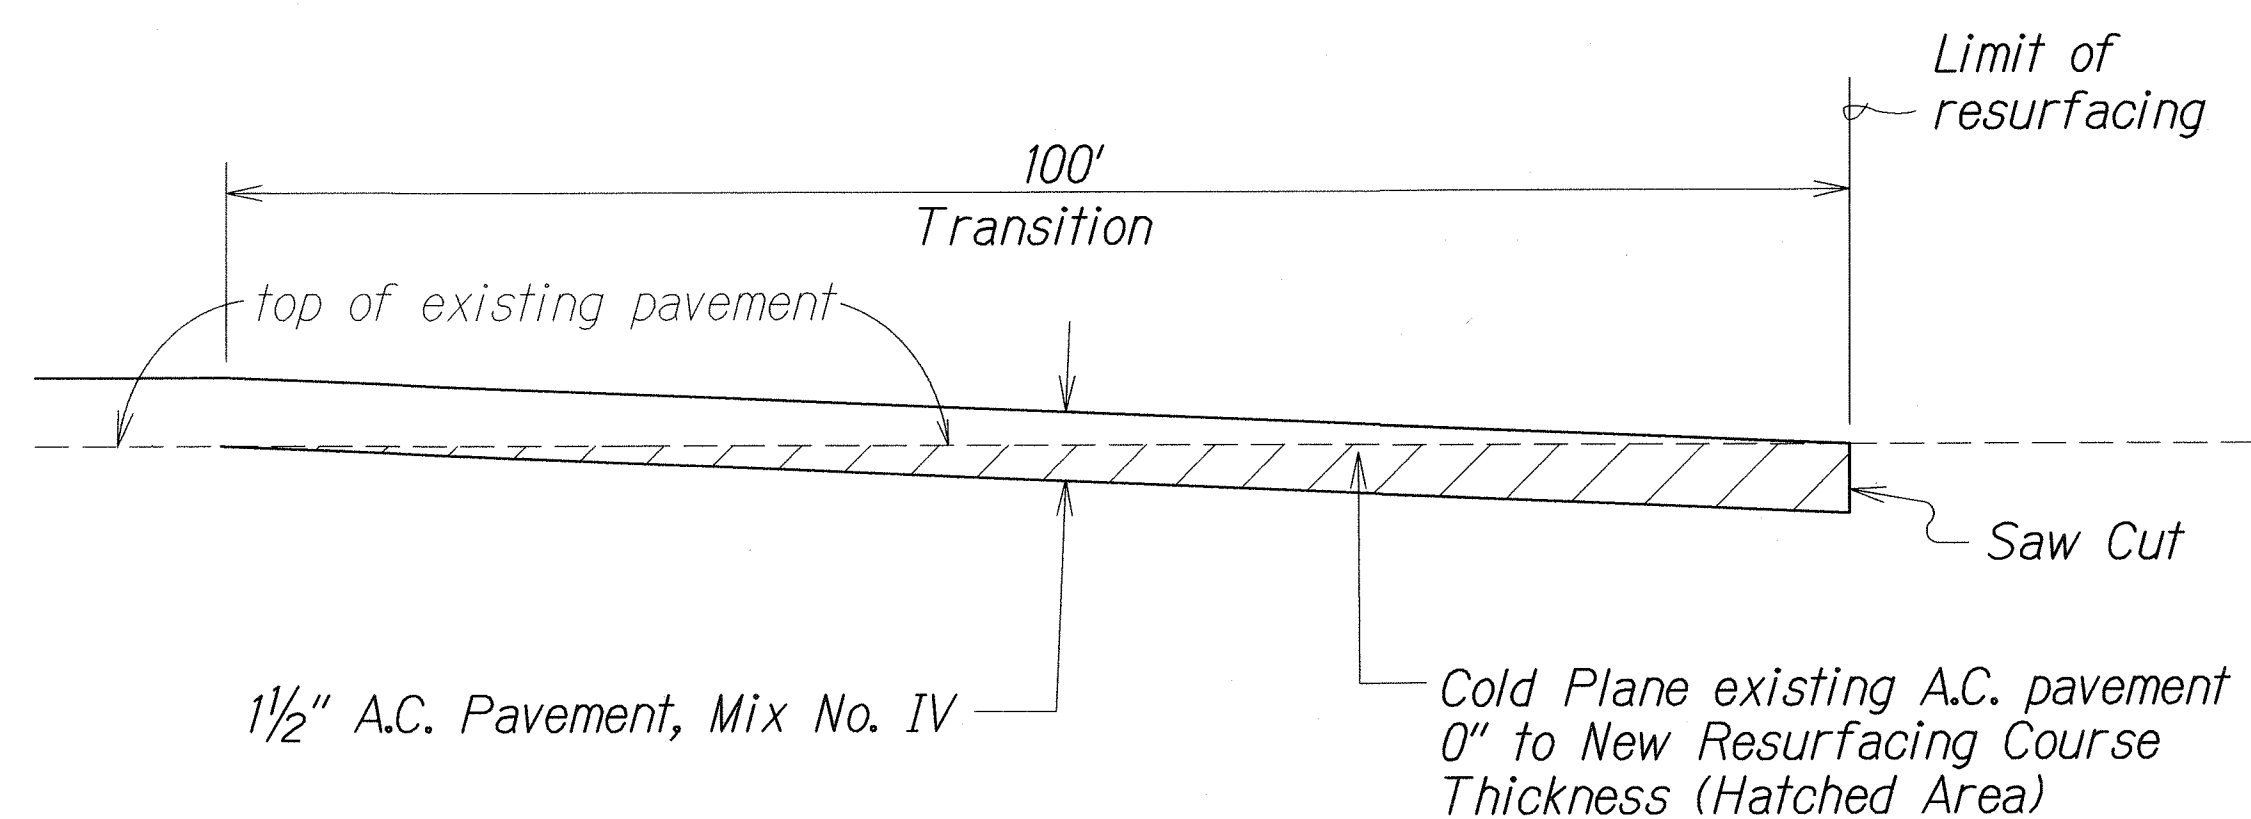

COLD PLANED TRANSITION DETAIL
BEGIN AND END OF PROJECT
Not To Scale

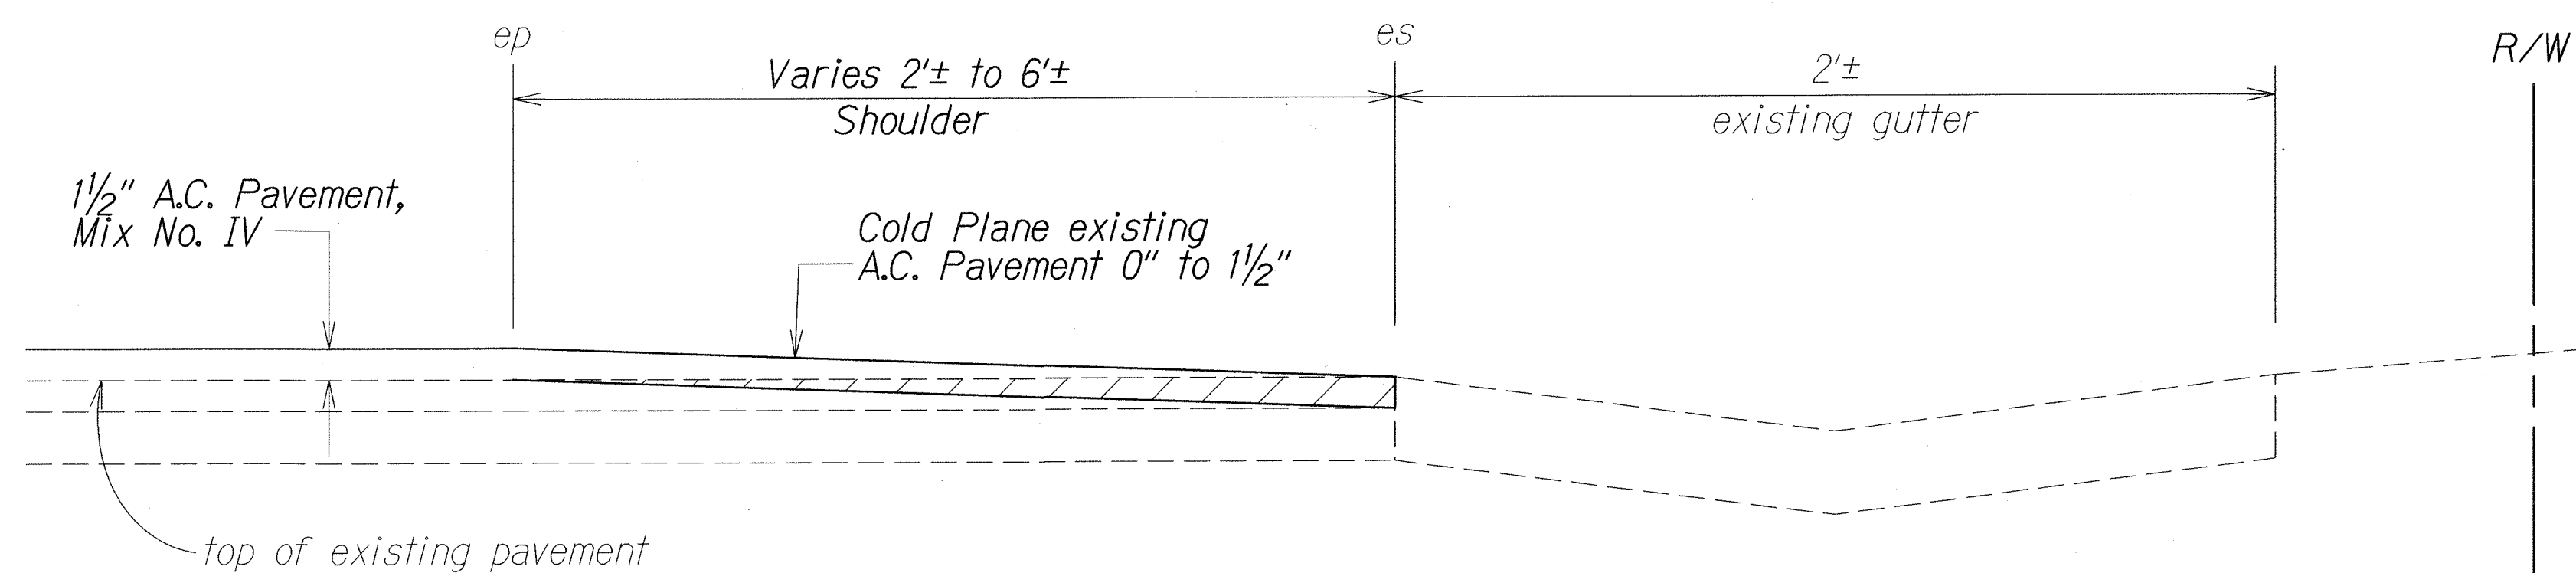


TYPICAL TRANSITION AT
EXISTING BITUMINOUS GUTTER DETAIL
Not To Scale

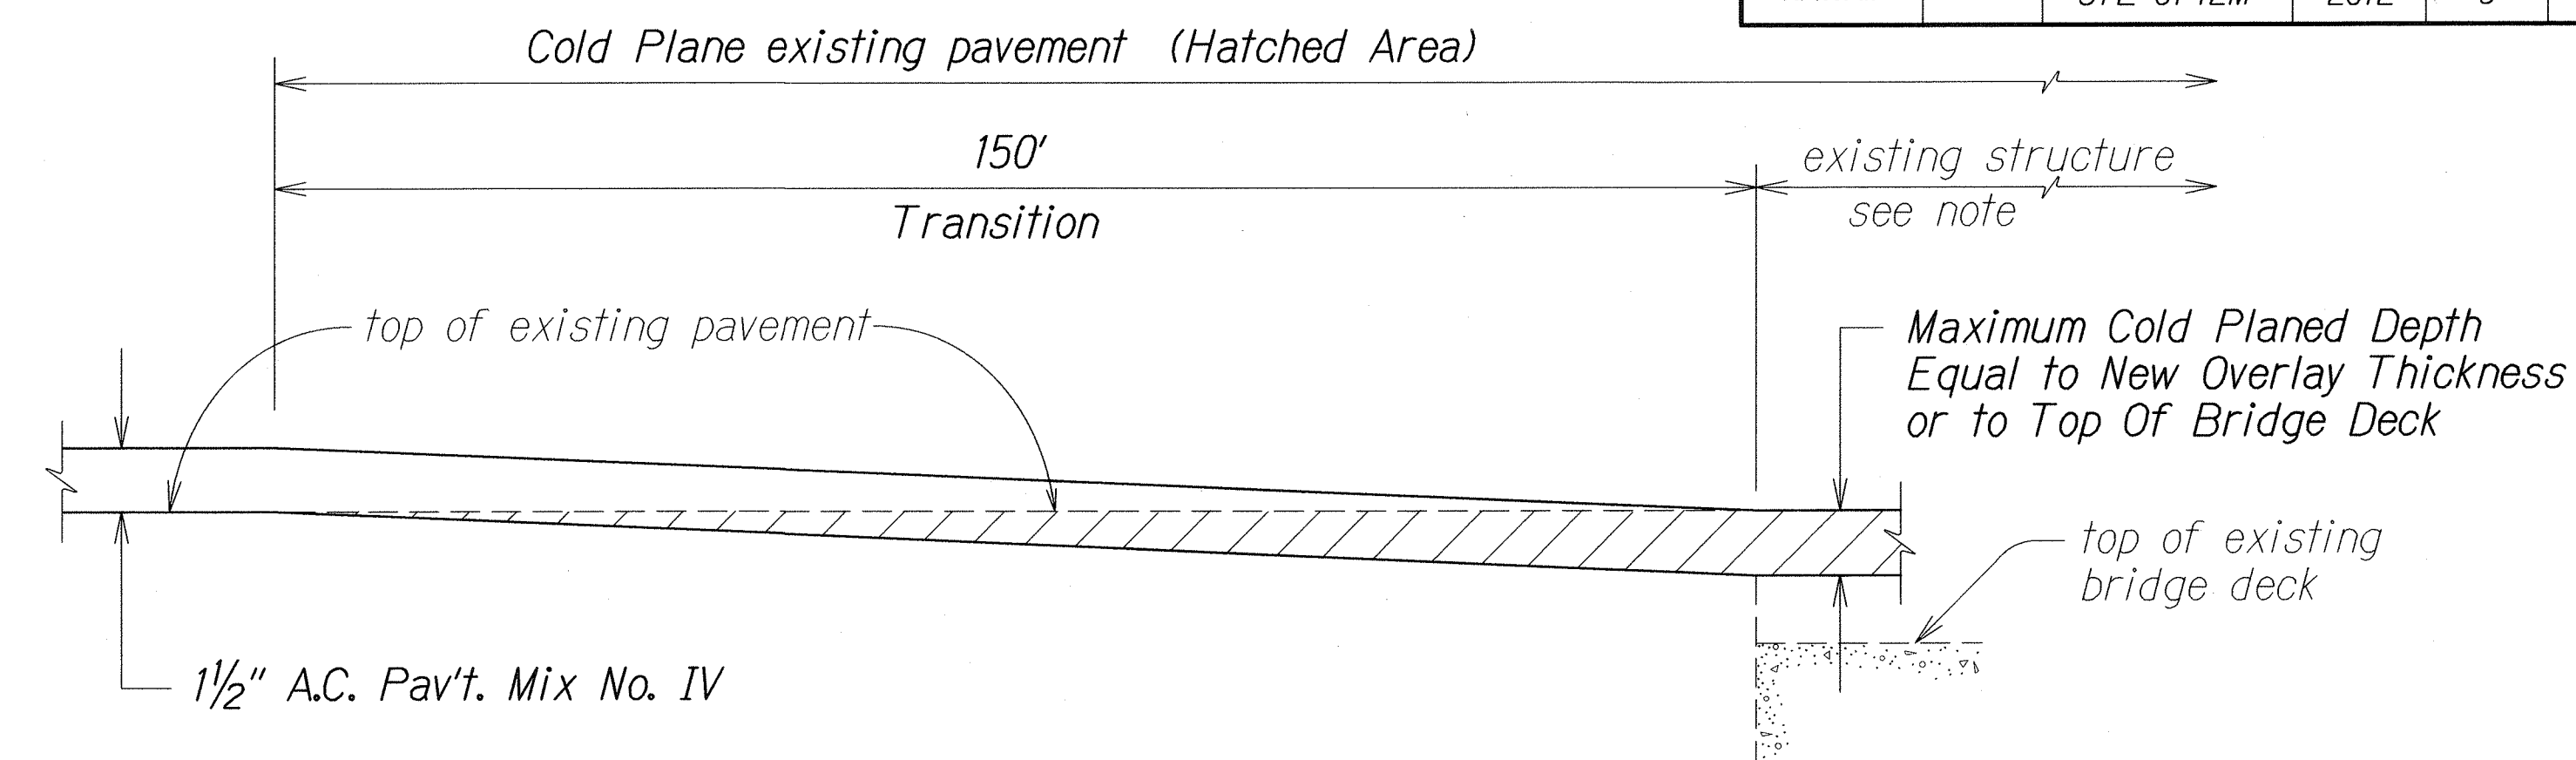

Note: In cold planing the pavement over the structure, the Contractor shall exercise care not to damage any portion of the structure, especially the slab, joints, drainage pipes or reinforcement. Any damage to the structure during the cold planing operations shall be repaired by the Contractor at his expense. Repair work shall be directed by the Engineer. The Contractor shall verify the thickness of the pavement by taking several measurements throughout the structure.

COLD PLANED TRANSITION AND RESURFACING
OVER EXISTING STRUCTURE
Not to Scale

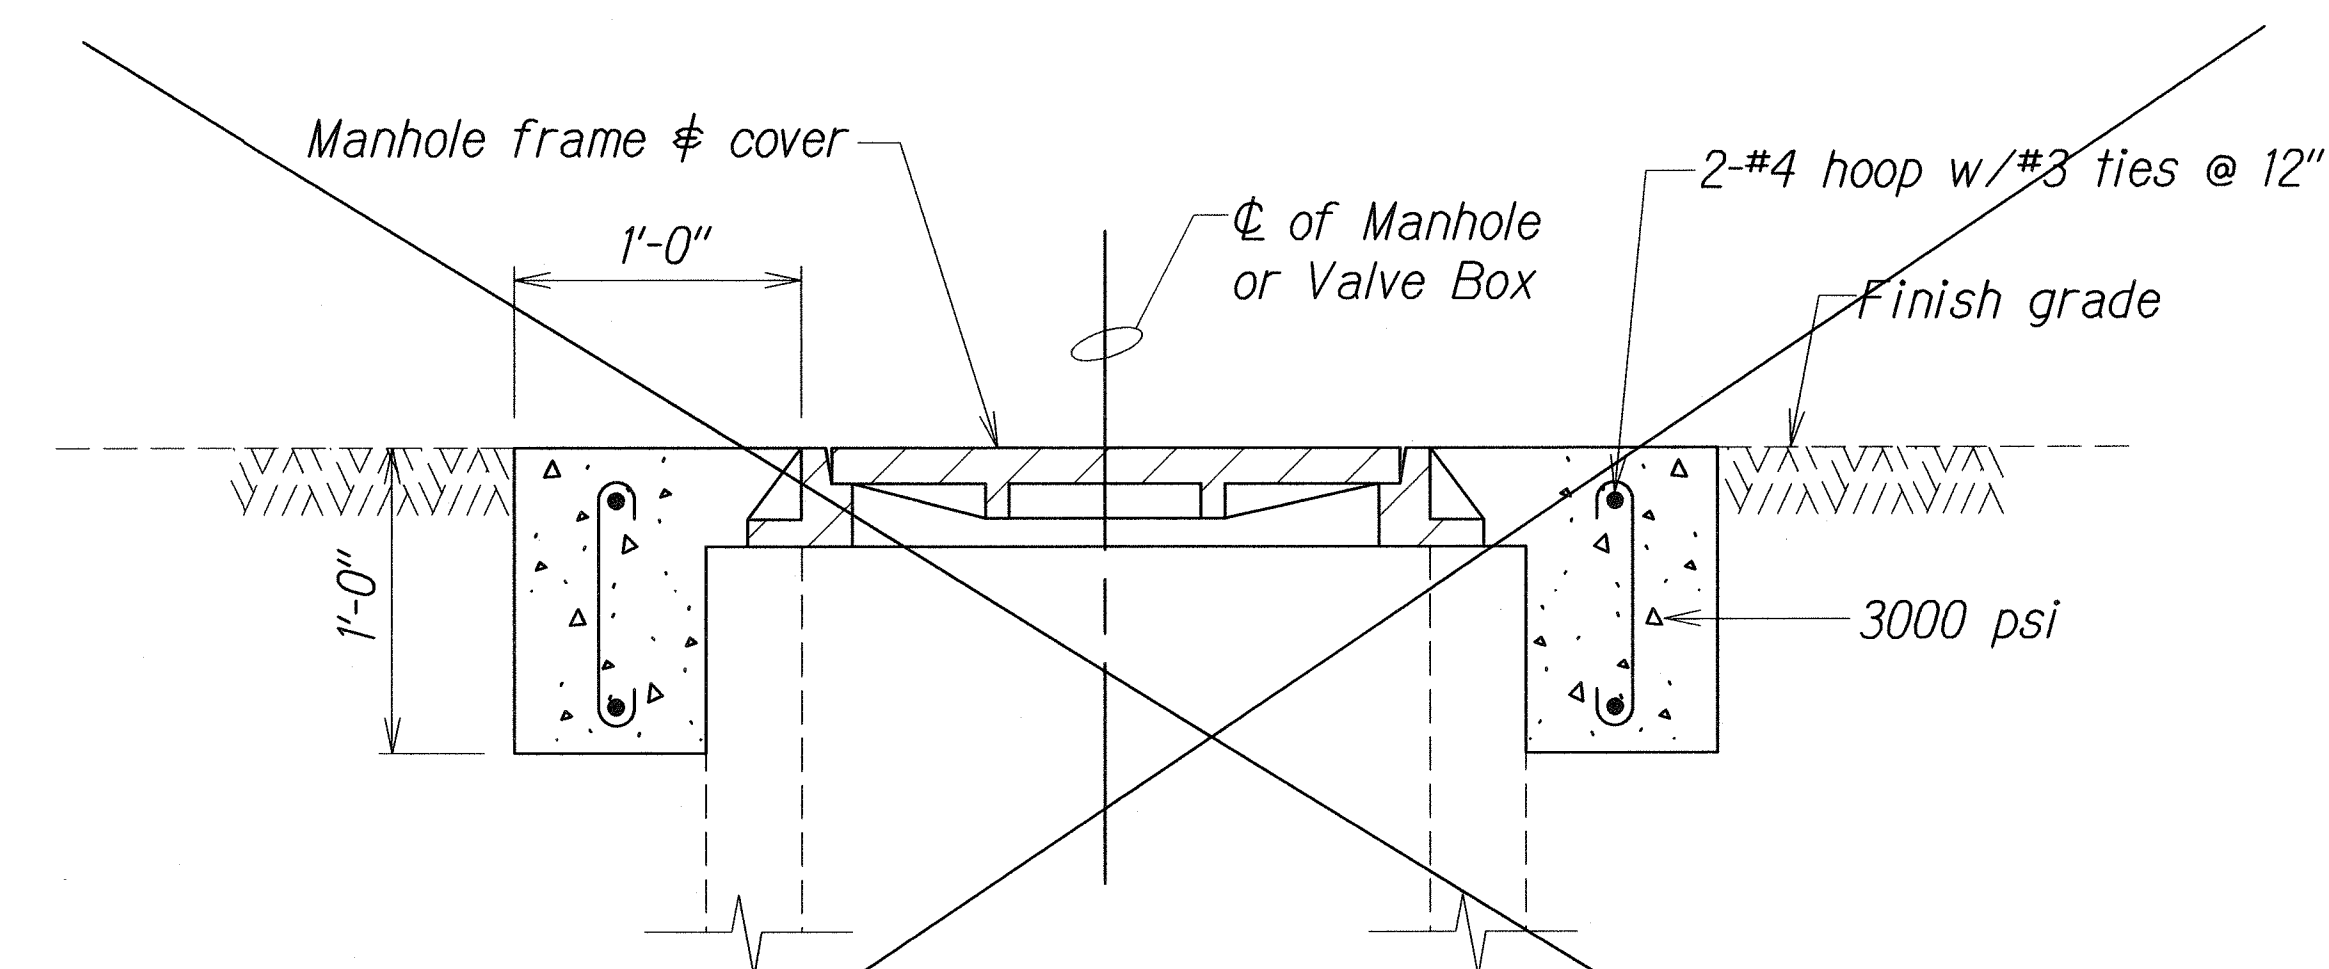


DETAIL - CONCRETE COLLAR FOR
ADJUSTMENTS OF MANHOLES AND VALVE BOX
Not To Scale

LEGEND FOR AS-BUILT POSTINGS	
	Squiggly line for as-built deletion
	Double line for as-built deletion
Roadway	Text for as-built posting


STATE OF HAWAII DEPARTMENT OF TRANSPORTATION HIGHWAYS DIVISION	
TYPICAL SECTIONS & DETAILS	
KULA HIGHWAY PAVEMENT PREVENTIVE MAINTENANCE Thompson Road Towards Ulupalakua Project No. 37E-01-12M	
Scale: As Shown	Date: December, 2011
SHEET No. 1 OF 2 SHEETS	

SURVEY PLOTTED BY	DATE
DRAWN BY	
DESIGNED BY	
CHECKED BY	
ORIGINAL PLAN	
NOTE BOOK	
NO.	


FED. ROAD DIST. NO.	STATE	PROJ. NO.	FISCAL YEAR	SHEET NO.	TOTAL SHEETS
HAWAII	HAW.	37E-01-12M	2012	ADD.7	18

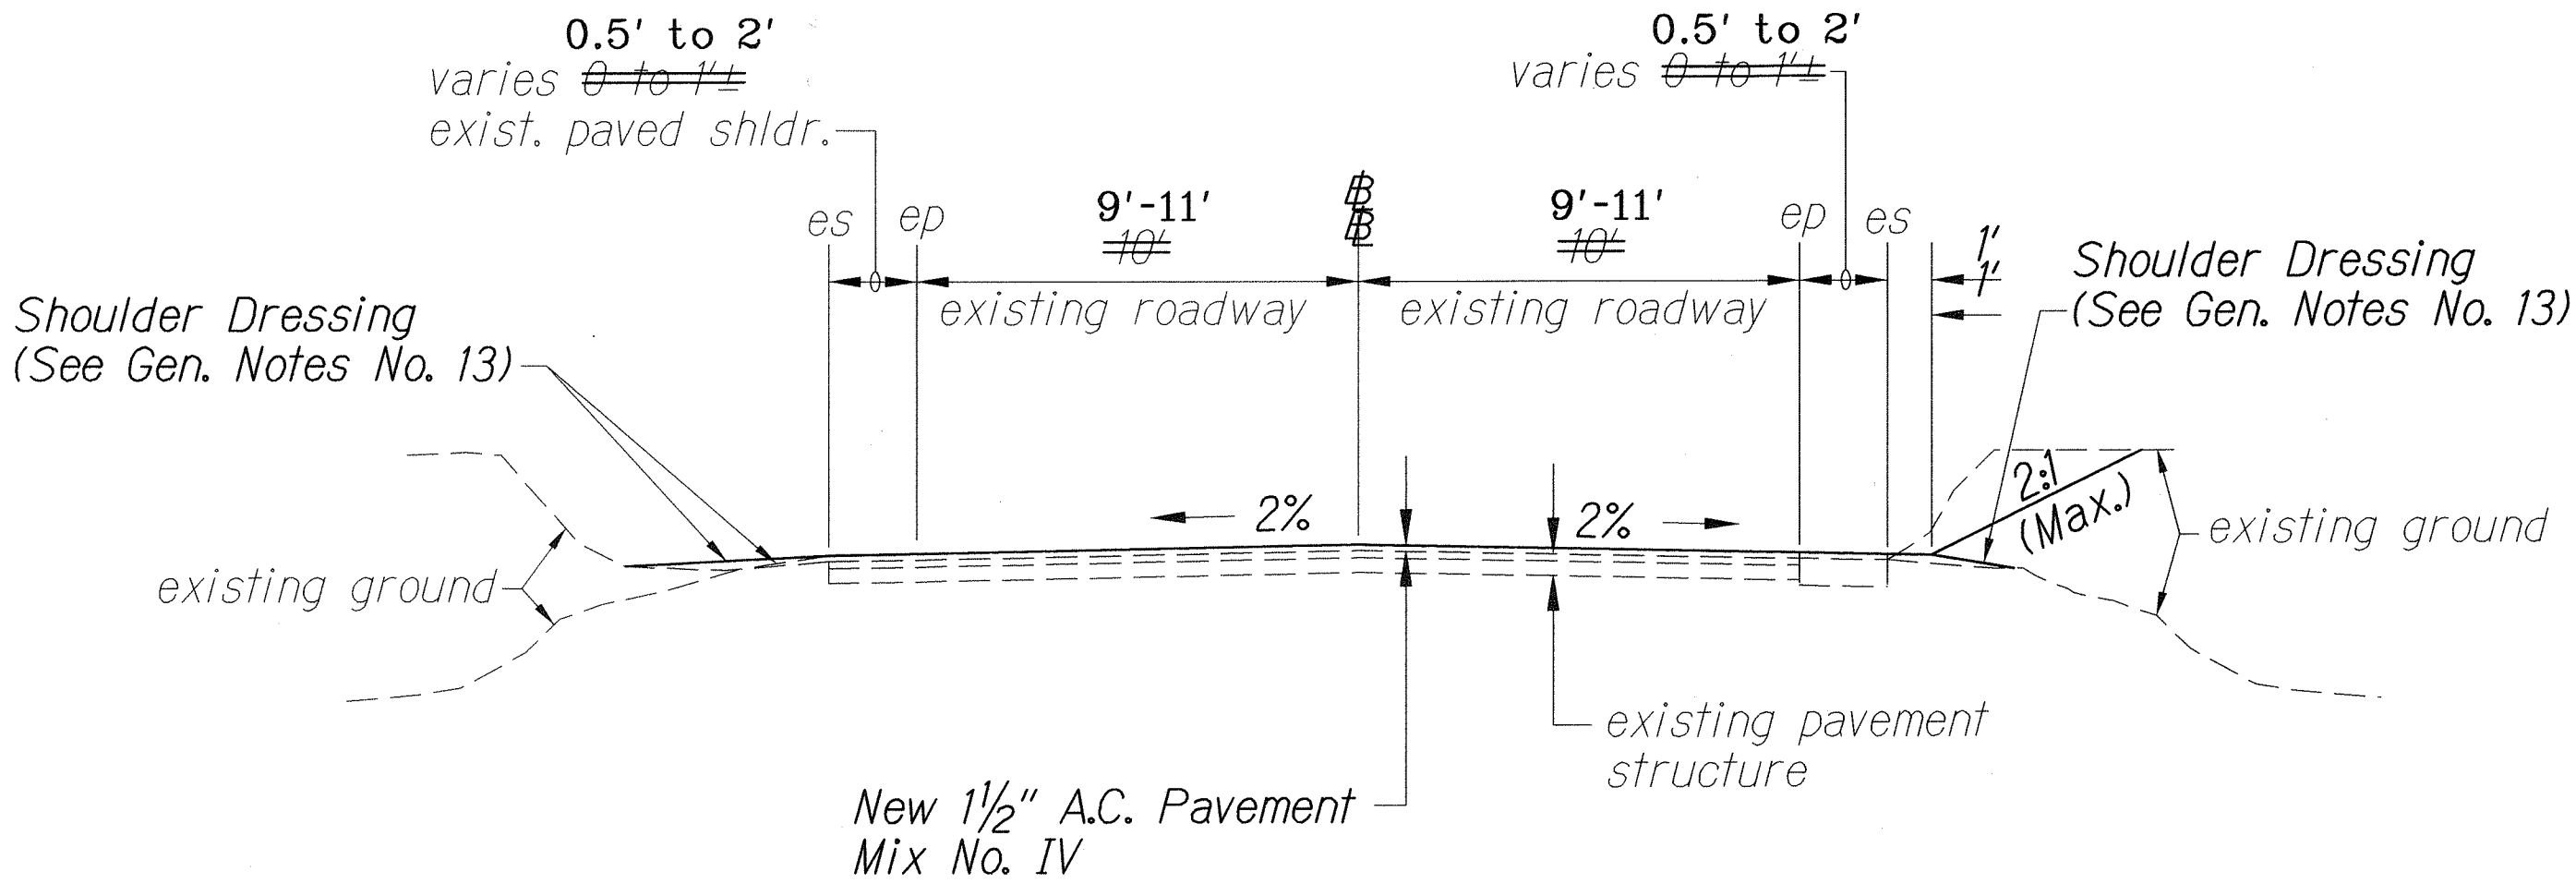


TYPICAL SECTION ON TANGENTS
 ± STA. -225+98± TO ± STA. 0+00±
 Scale: 1/4"= 1'-0"

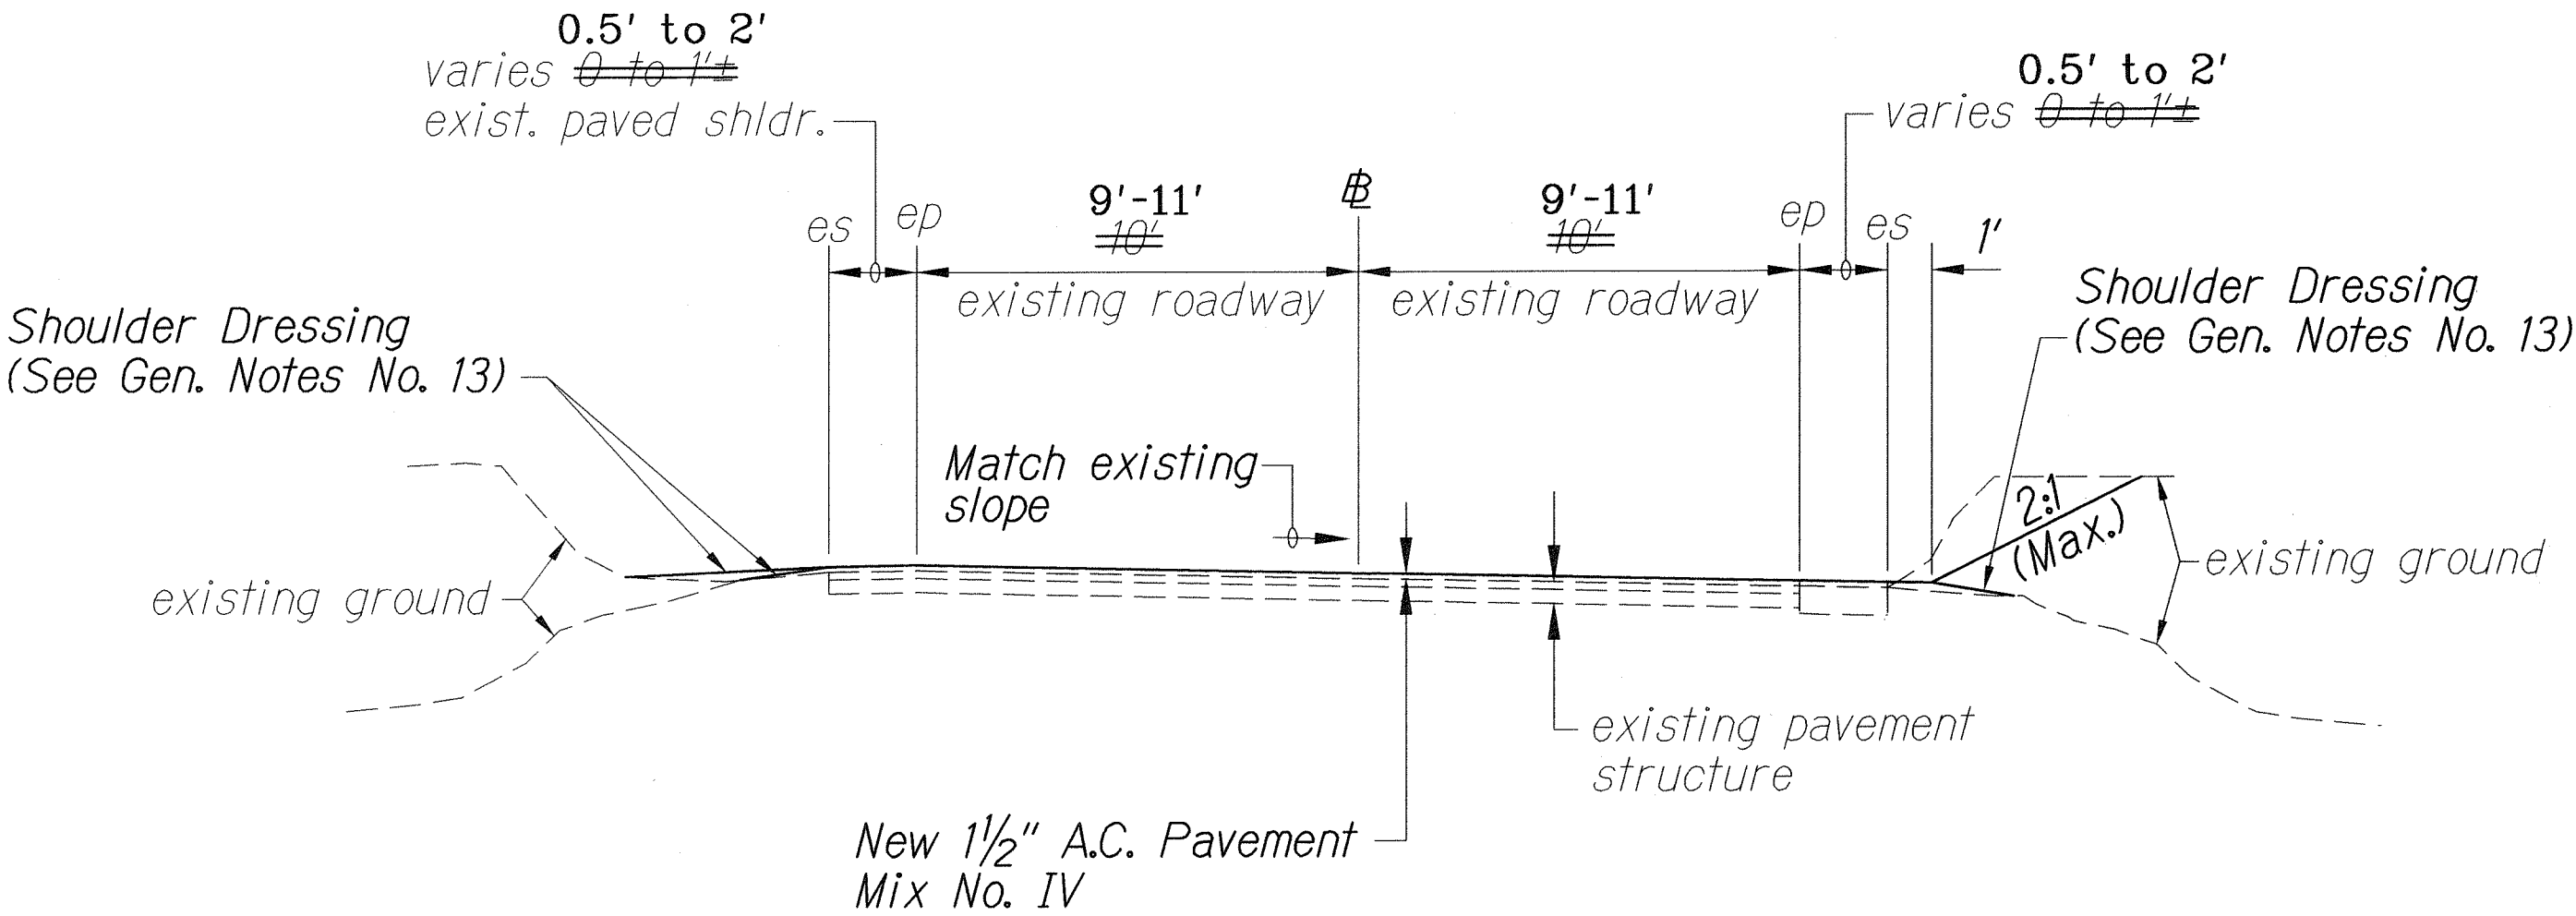

TYPICAL SECTION ON CURVES
 ± STA. -225+98± TO ± STA. 0+00±
 Scale: 1/4"= 1'-0"

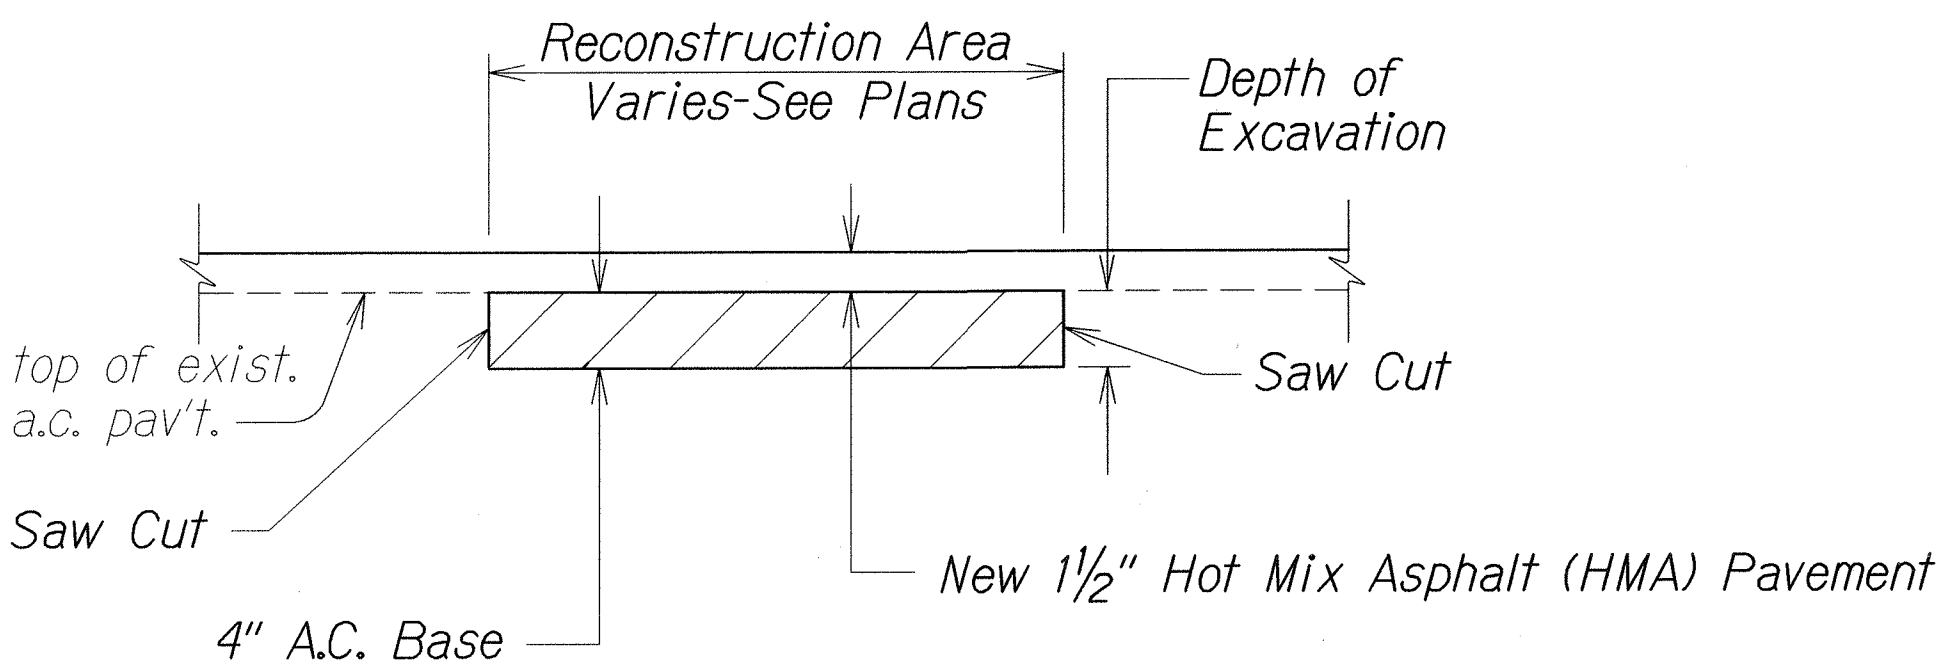


A.C. PAVEMENT RECONSTRUCTION DETAIL
 Not To Scale

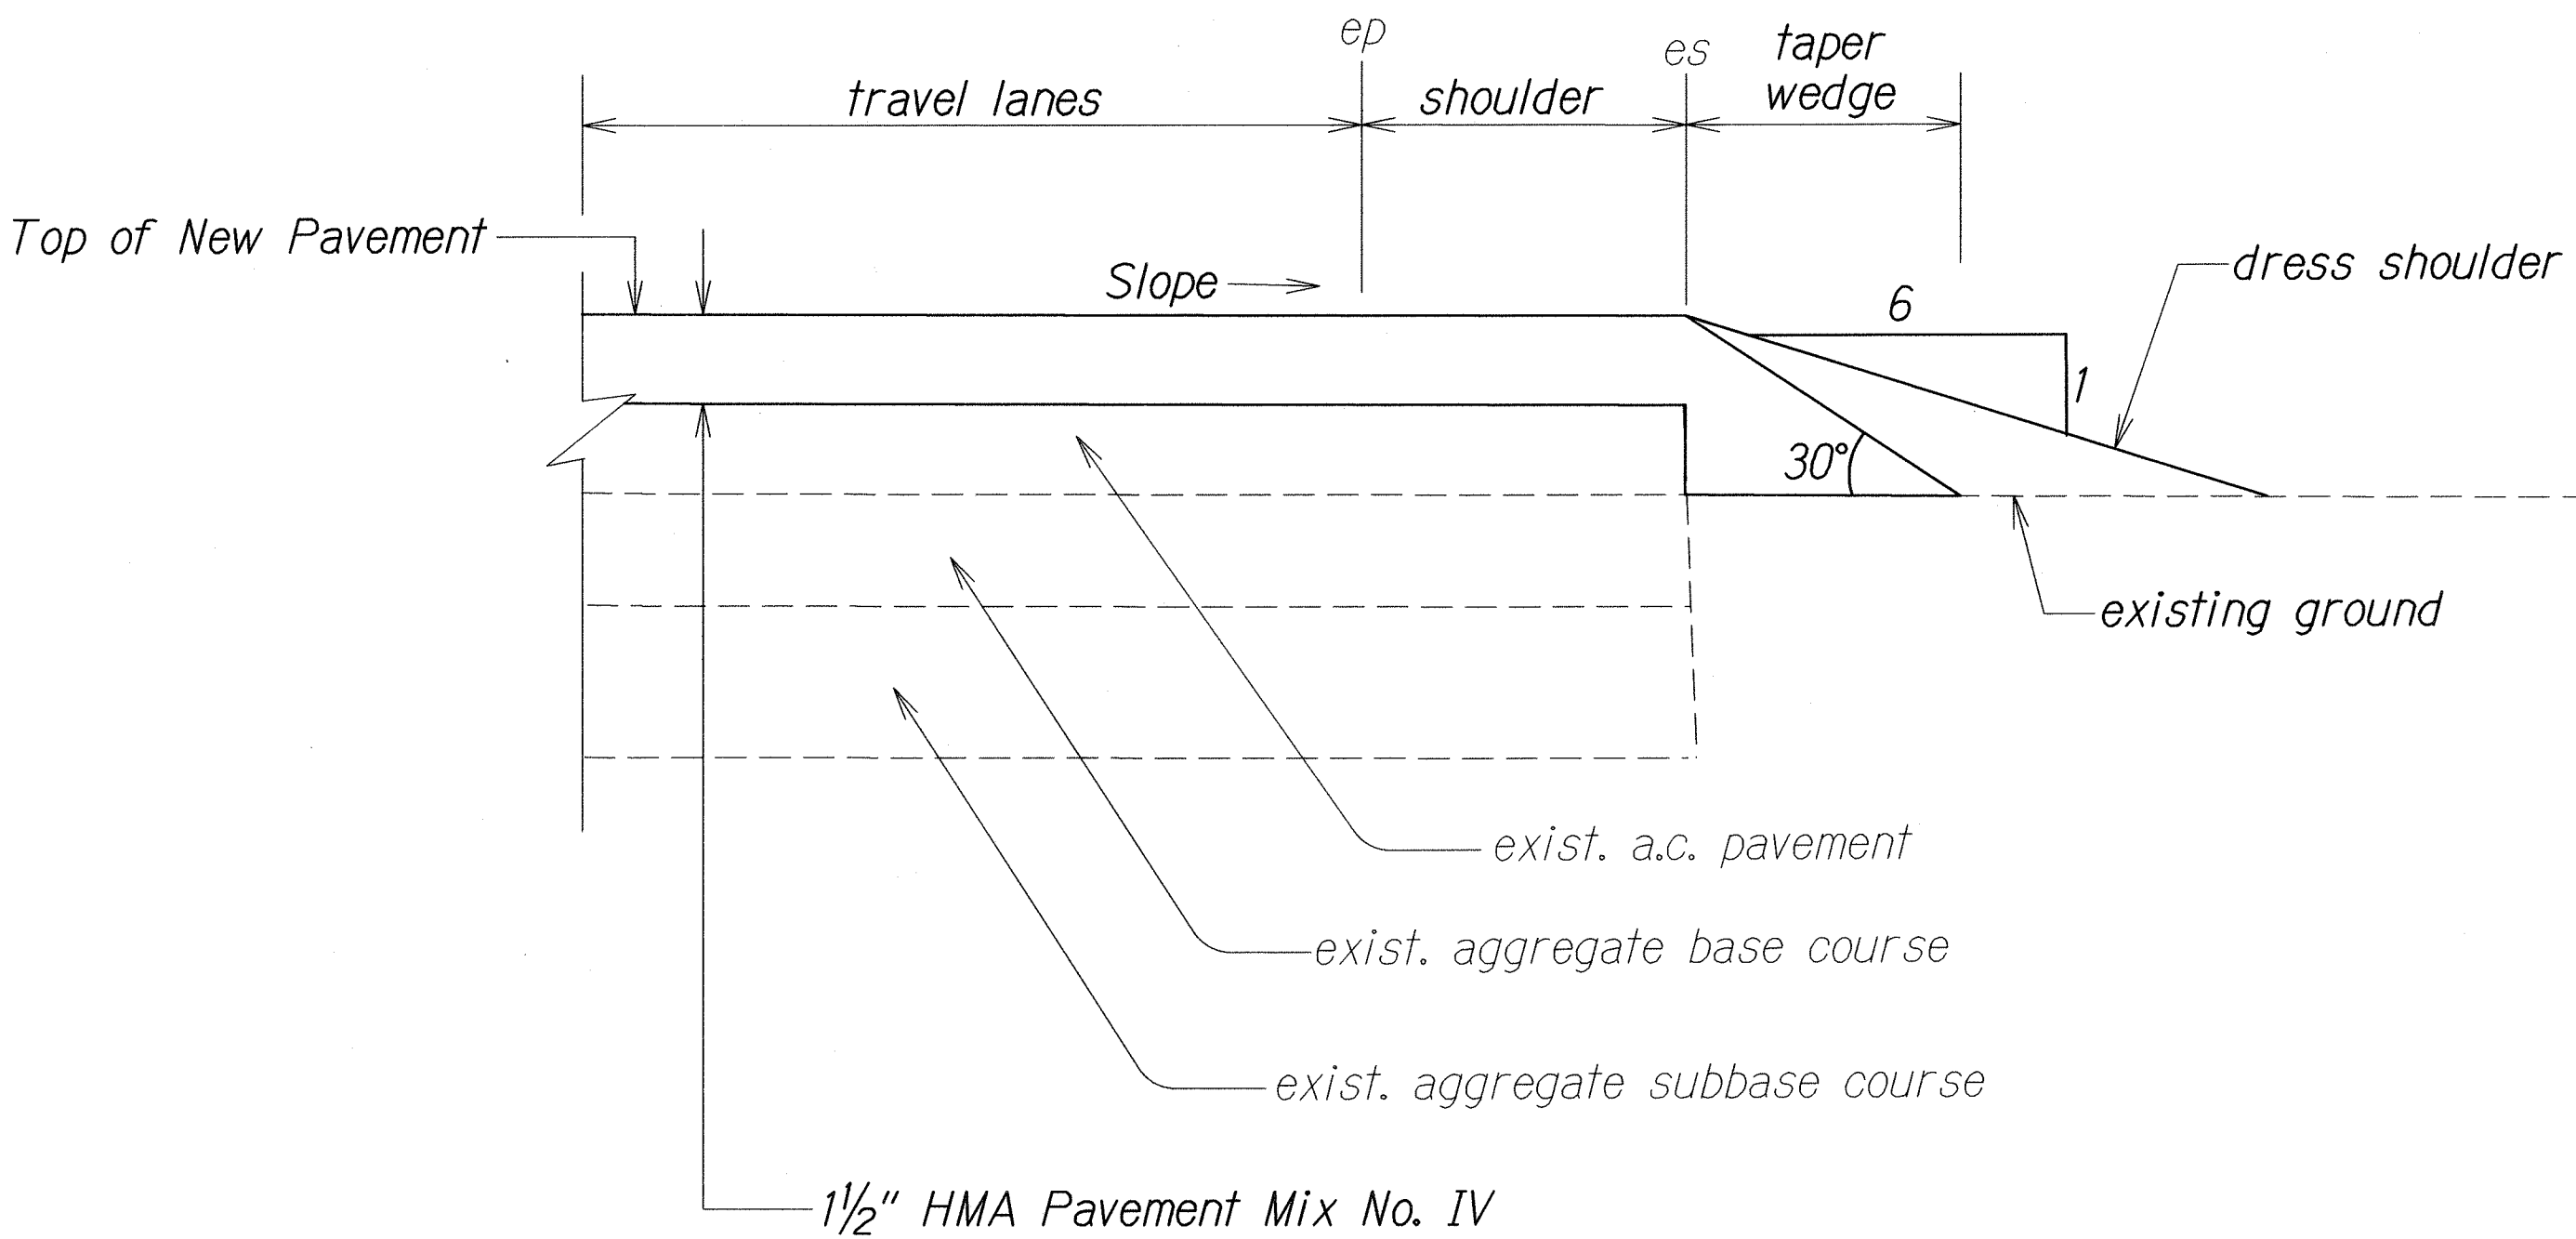

Note: Contractor shall mount a device directly on the paver screed extension to provide a 30° beveled shoulder edge.

TYPICAL PAVEMENT EDGE DETAIL
(FOR OVERLAYING PROJECT)
 Not To Scale

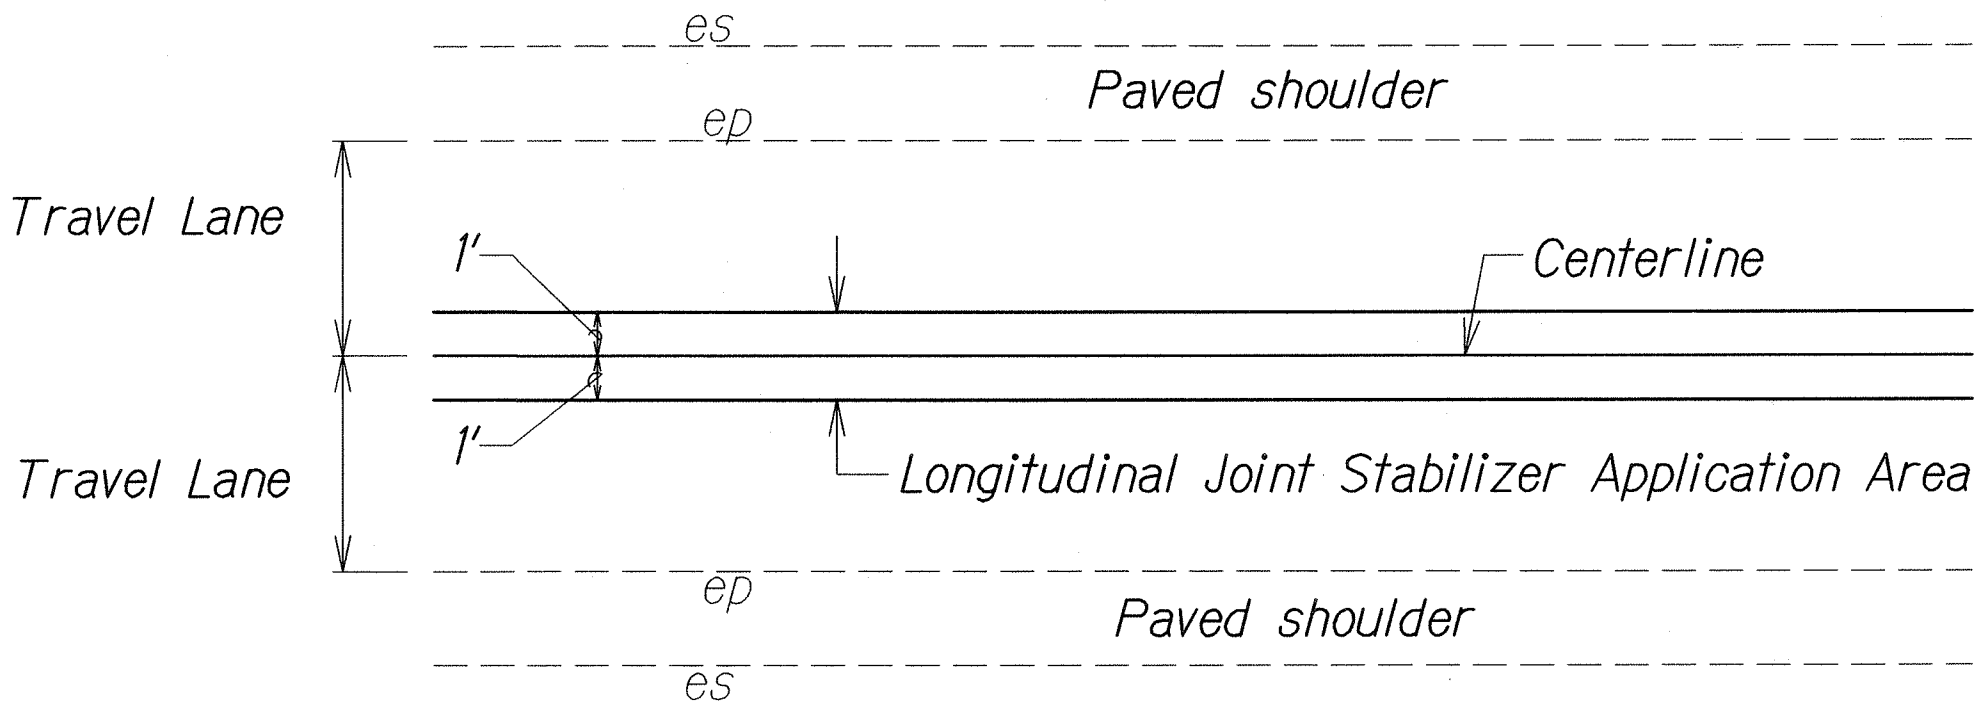

△ TYPICAL SECTION FOR LONGITUDINAL JOINT STABILIZER
 Not To Scale

LEGEND FOR AS-BUILT POSTINGS	
	Squiggly line for as-built deletion
	Double line for as-built deletion
	Text for as-built posting

△	3-12-12	Add Typical Section for Longitudinal Joint Stabilizer.
DATE	REVISION	

STATE OF HAWAII DEPARTMENT OF TRANSPORTATION HIGHWAYS DIVISION	
TYPICAL SECTIONS & DETAILS	
KULA HIGHWAY PAVEMENT PREVENTIVE MAINTENANCE Thompson Road Towards Ulupalakua Project No. 37E-01-12M	
Scale: As Shown	Date: December, 2011
SHEET No. 2 OF 2 SHEETS	

SURVEY PLOTTED BY	DATE
DRAWN BY	
TRACED BY	
DESIGNED BY	
CHECKED BY	
NOTED BY	
ORIGINAL PLAN	

"AS-BUILT"

ADD.7