

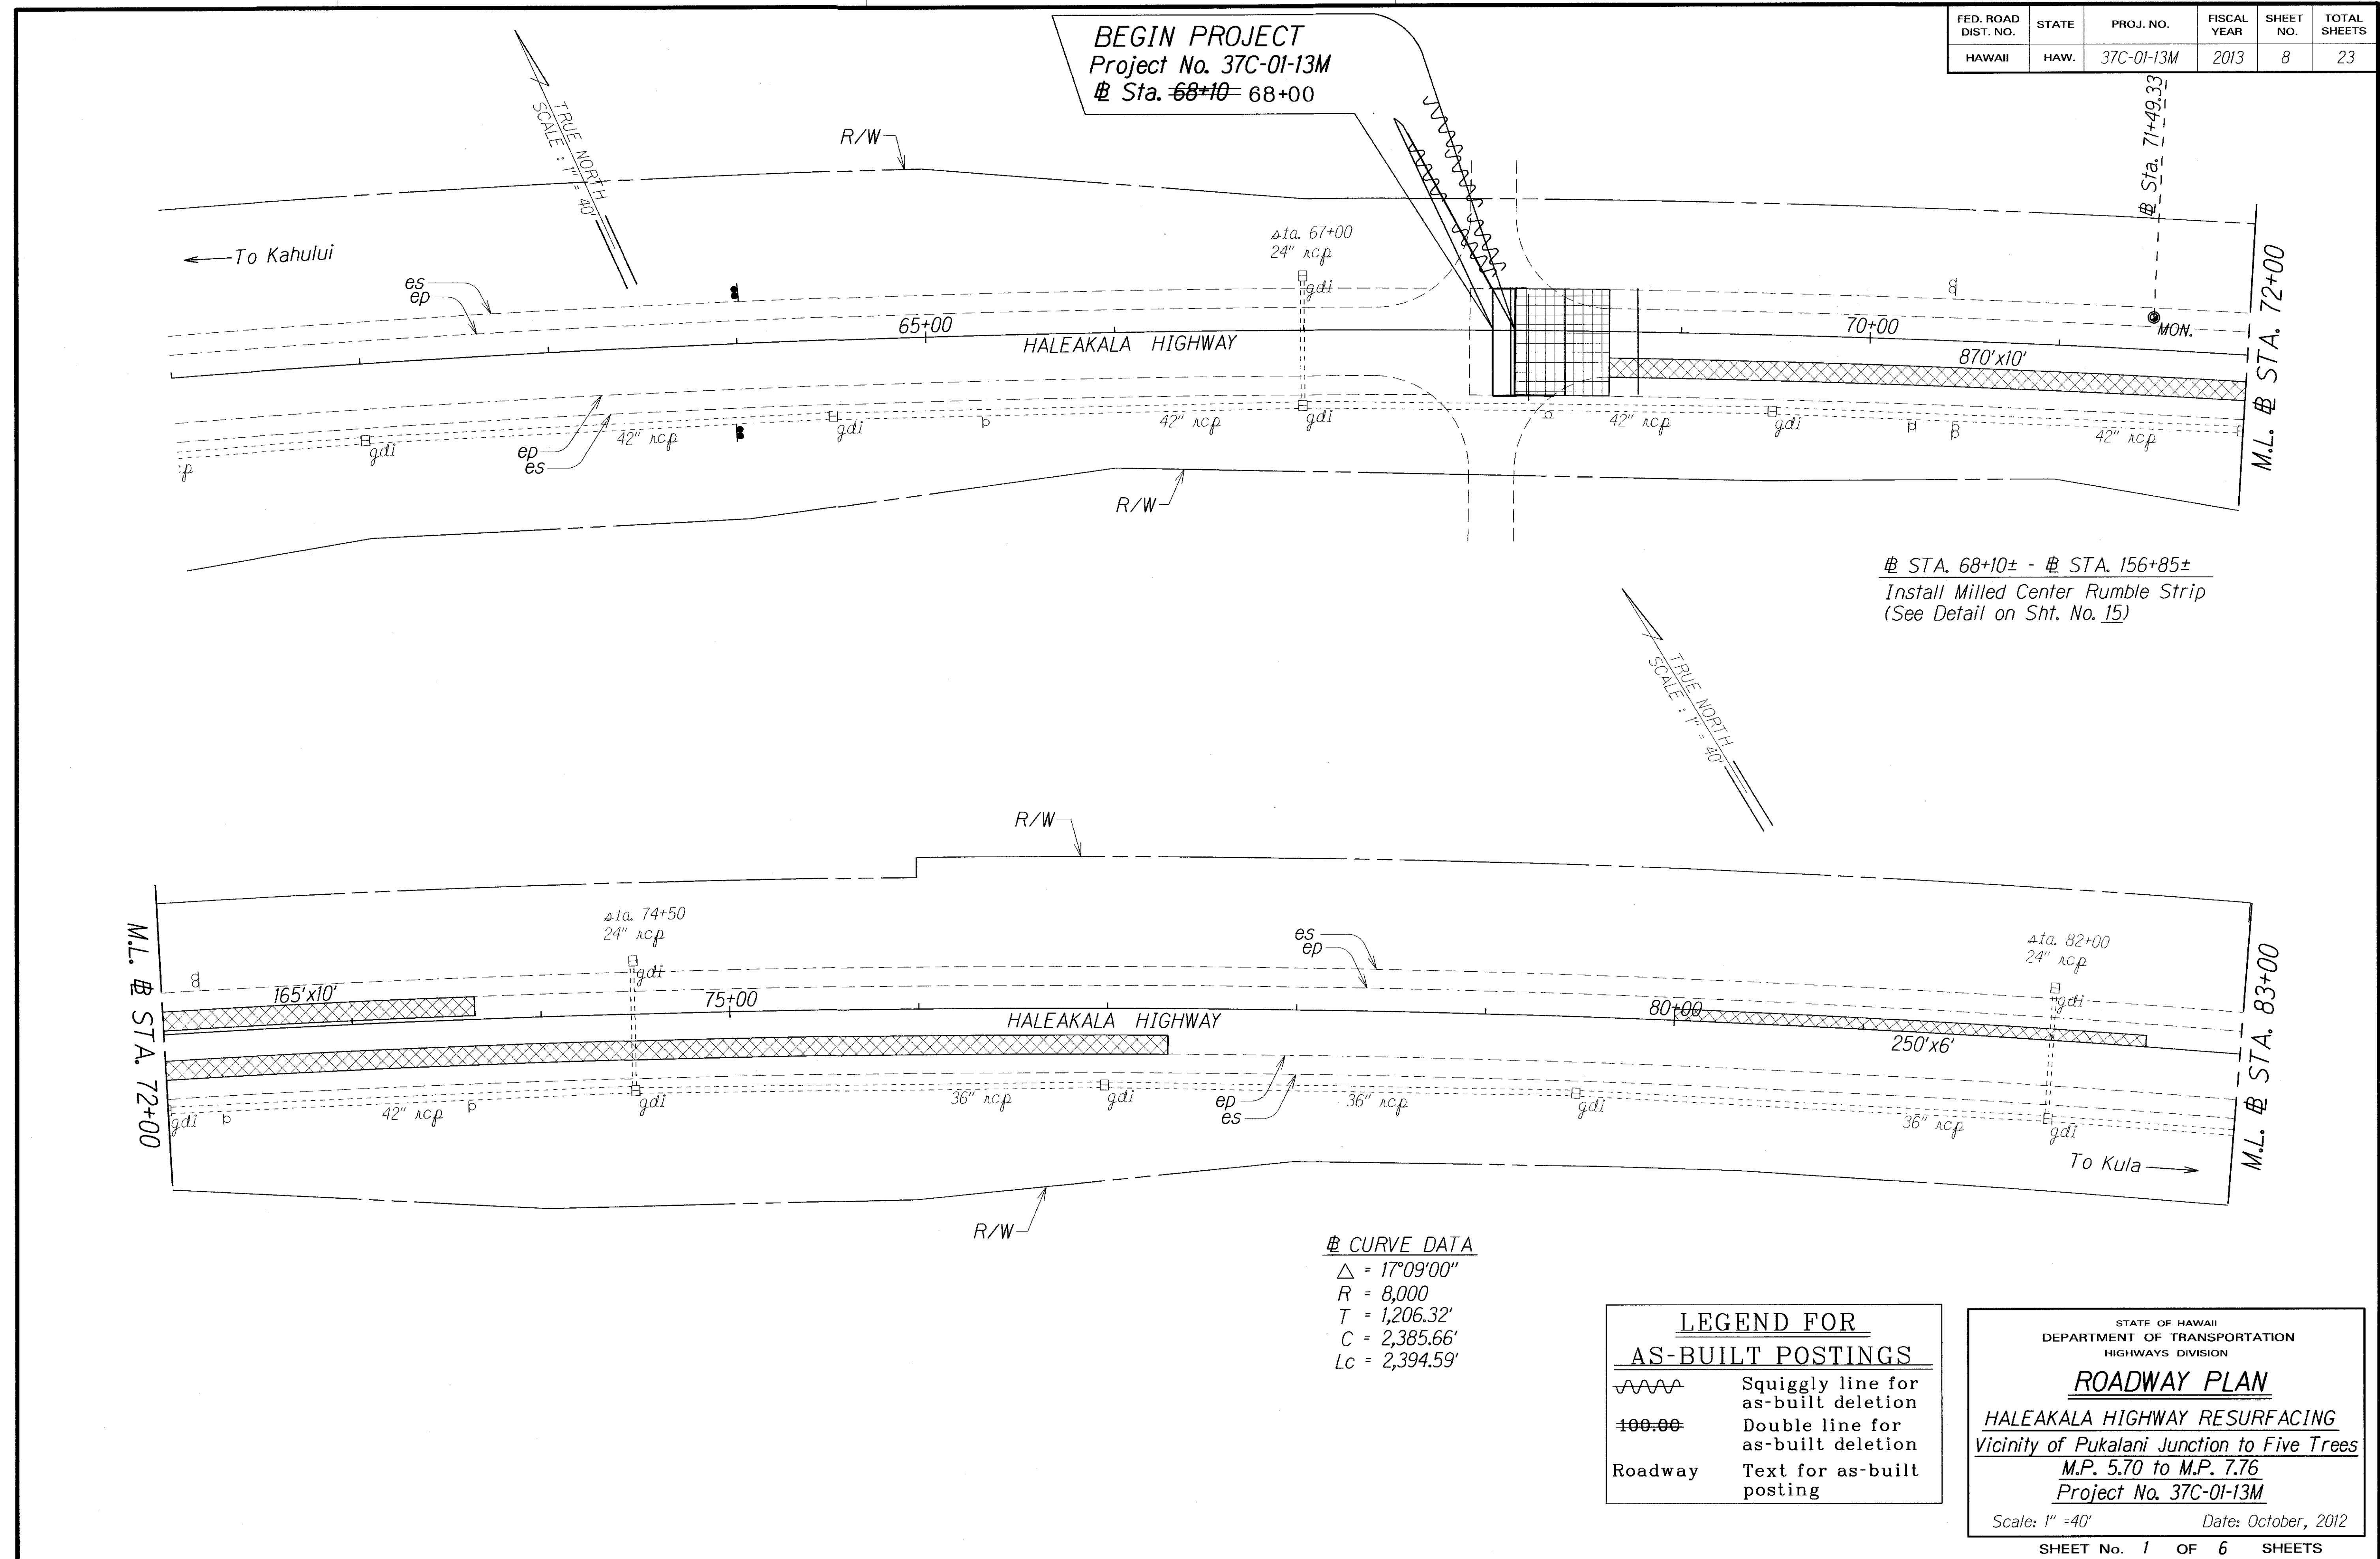


FED. ROAD DIST. NO.	STATE	PROJ. NO.	FISCAL YEAR	SHEET NO.	TOTAL SHEETS
HAWAII	HAW.	37C-01-13M	2013	8	23

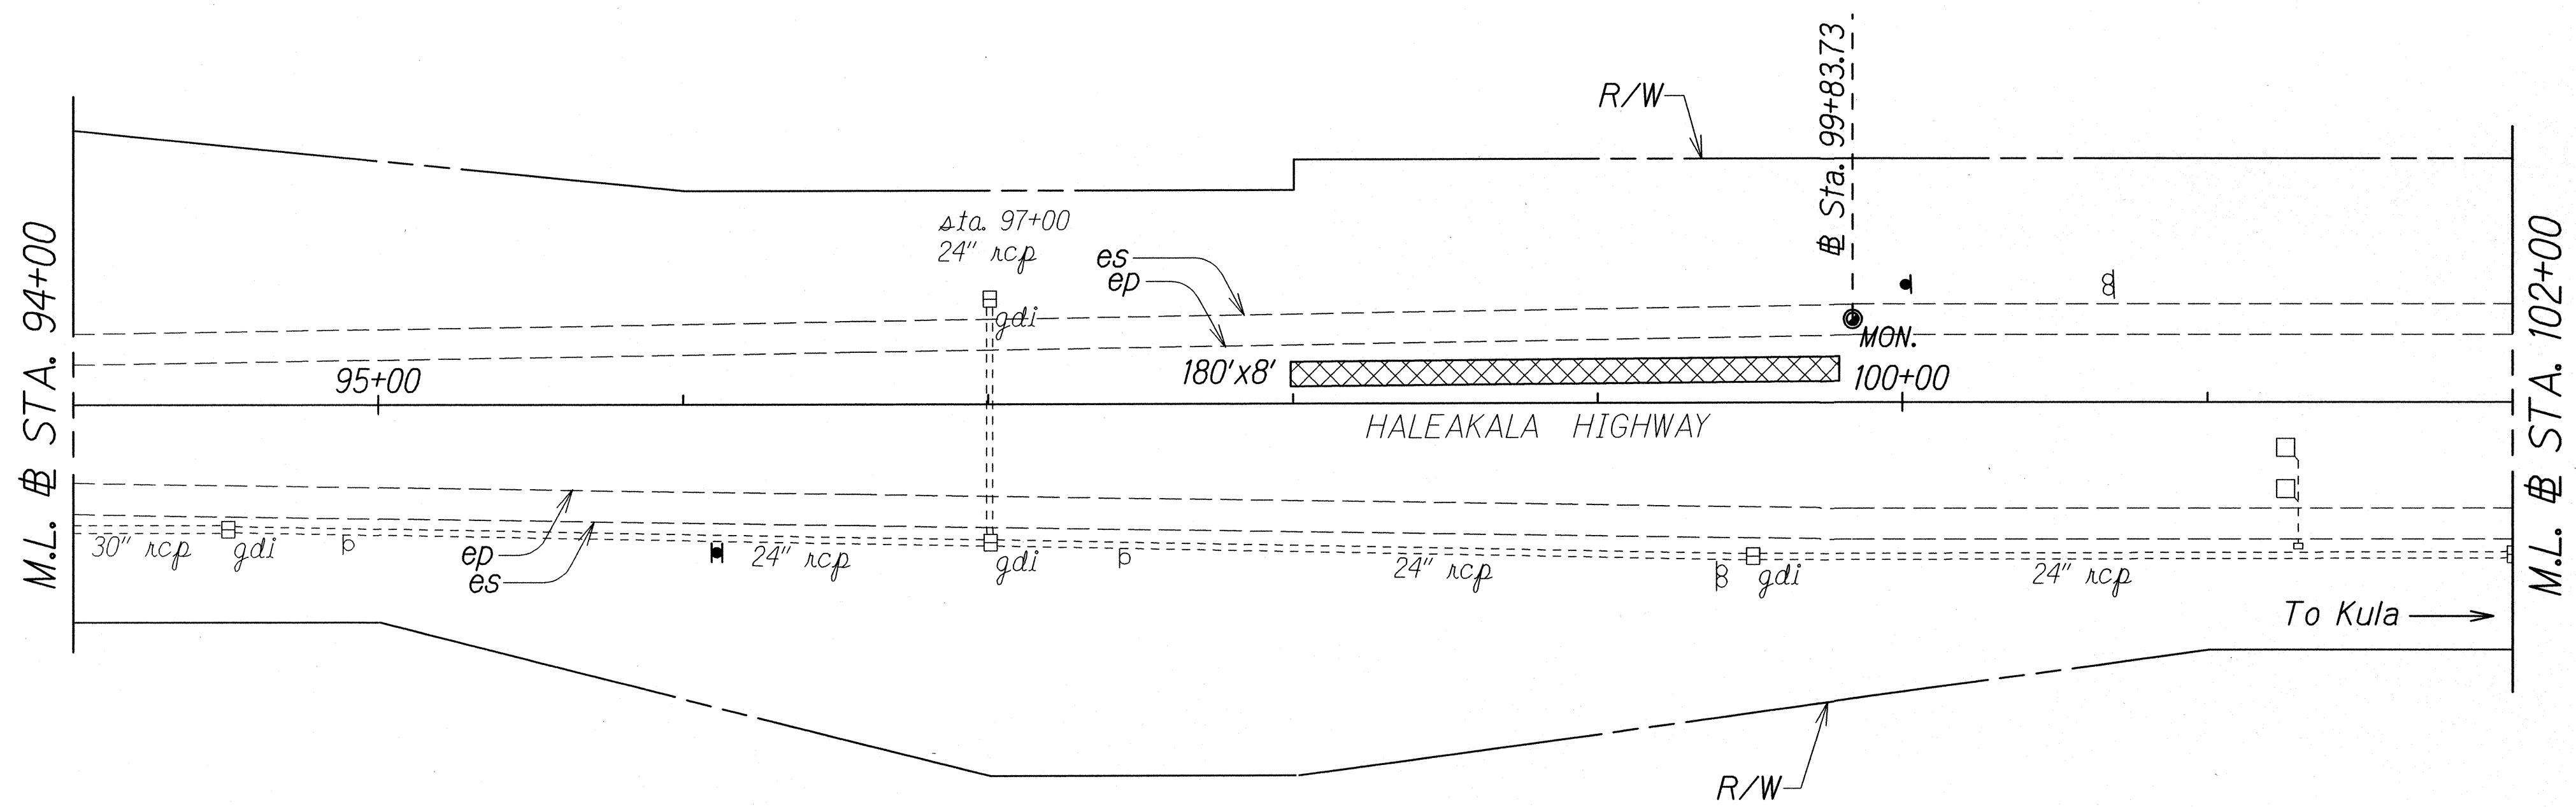

"AS-BUILT"

FED. ROAD DIST. NO.	STATE	PROJ. NO.	FISCAL YEAR	SHEET NO.	TOTAL SHEETS
HAWAII	HAW.	37C-01-13M	2013	9	23

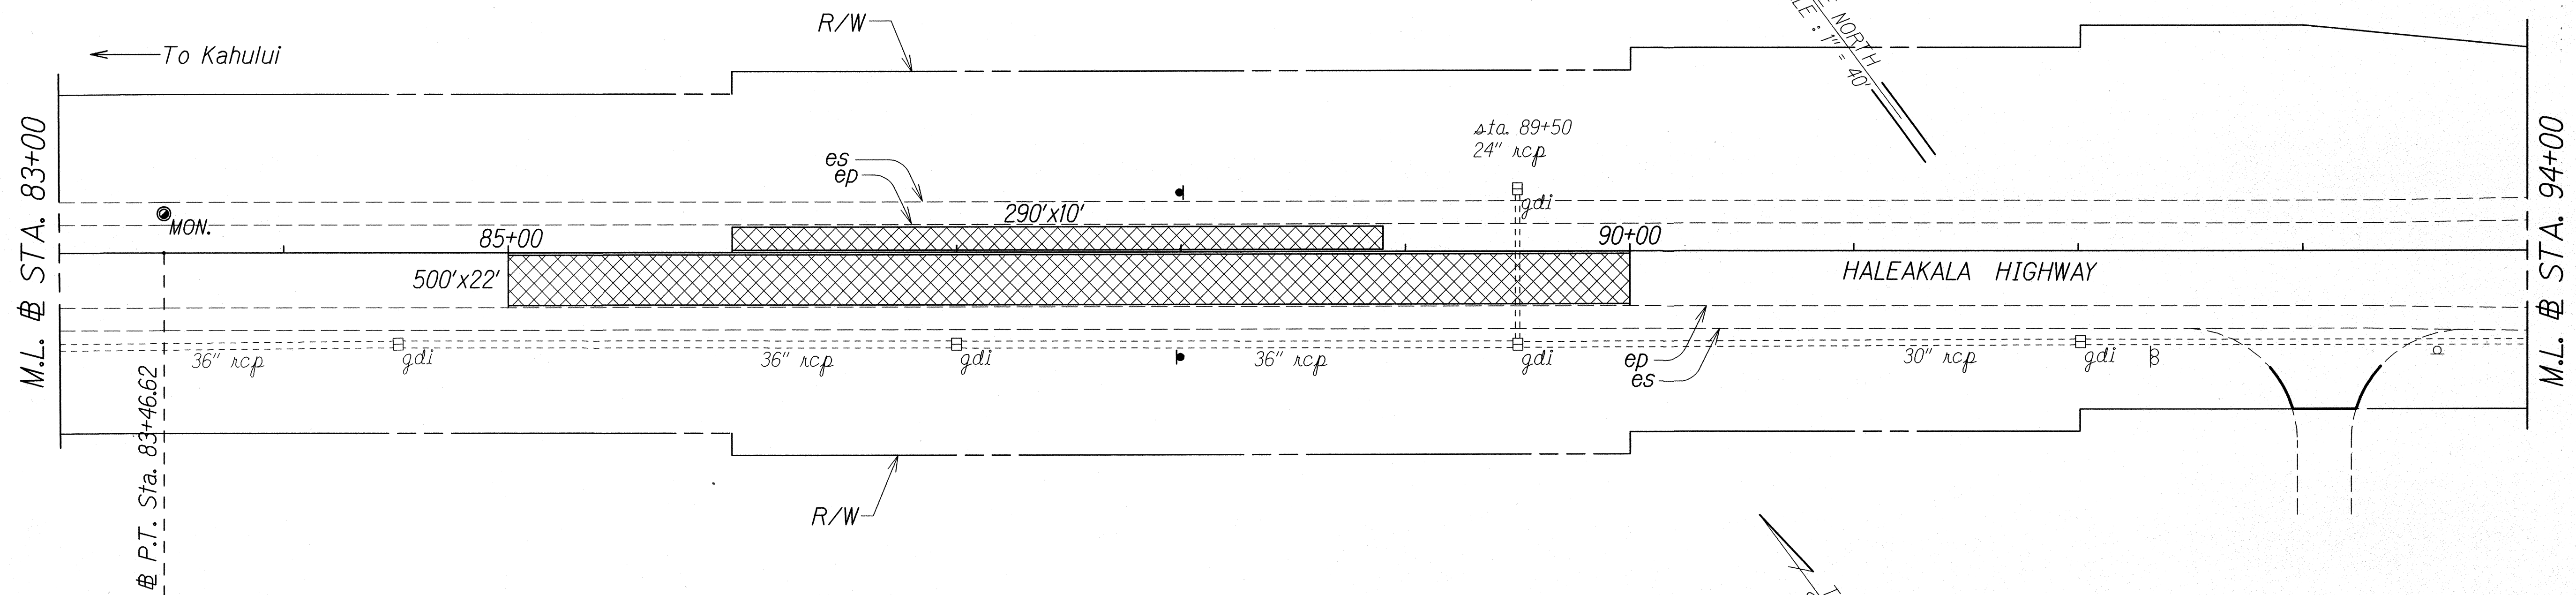

ORIGINAL PLAN	SURVEY PLOTTED BY	DATE
NOTE BOOK	DRAWN BY	
	DESIGNED BY	
	CHECKED BY	


STATE OF HAWAII
DEPARTMENT OF TRANSPORTATION
HIGHWAYS DIVISION

ROADWAY PLAN

HALEAKALA HIGHWAY RESURFACING
Vicinity of Pukalani Junction to Five Trees
M.P. 5.70 to M.P. 7.76
Project No. 37C-01-13M

Scale: 1" = 40' Date: October, 2012

FED. ROAD DIST. NO.	STATE	PROJ. NO.	FISCAL YEAR	SHEET NO.	TOTAL SHEETS
HAWAII	HAW.	37C-01-13M	2013	11	23

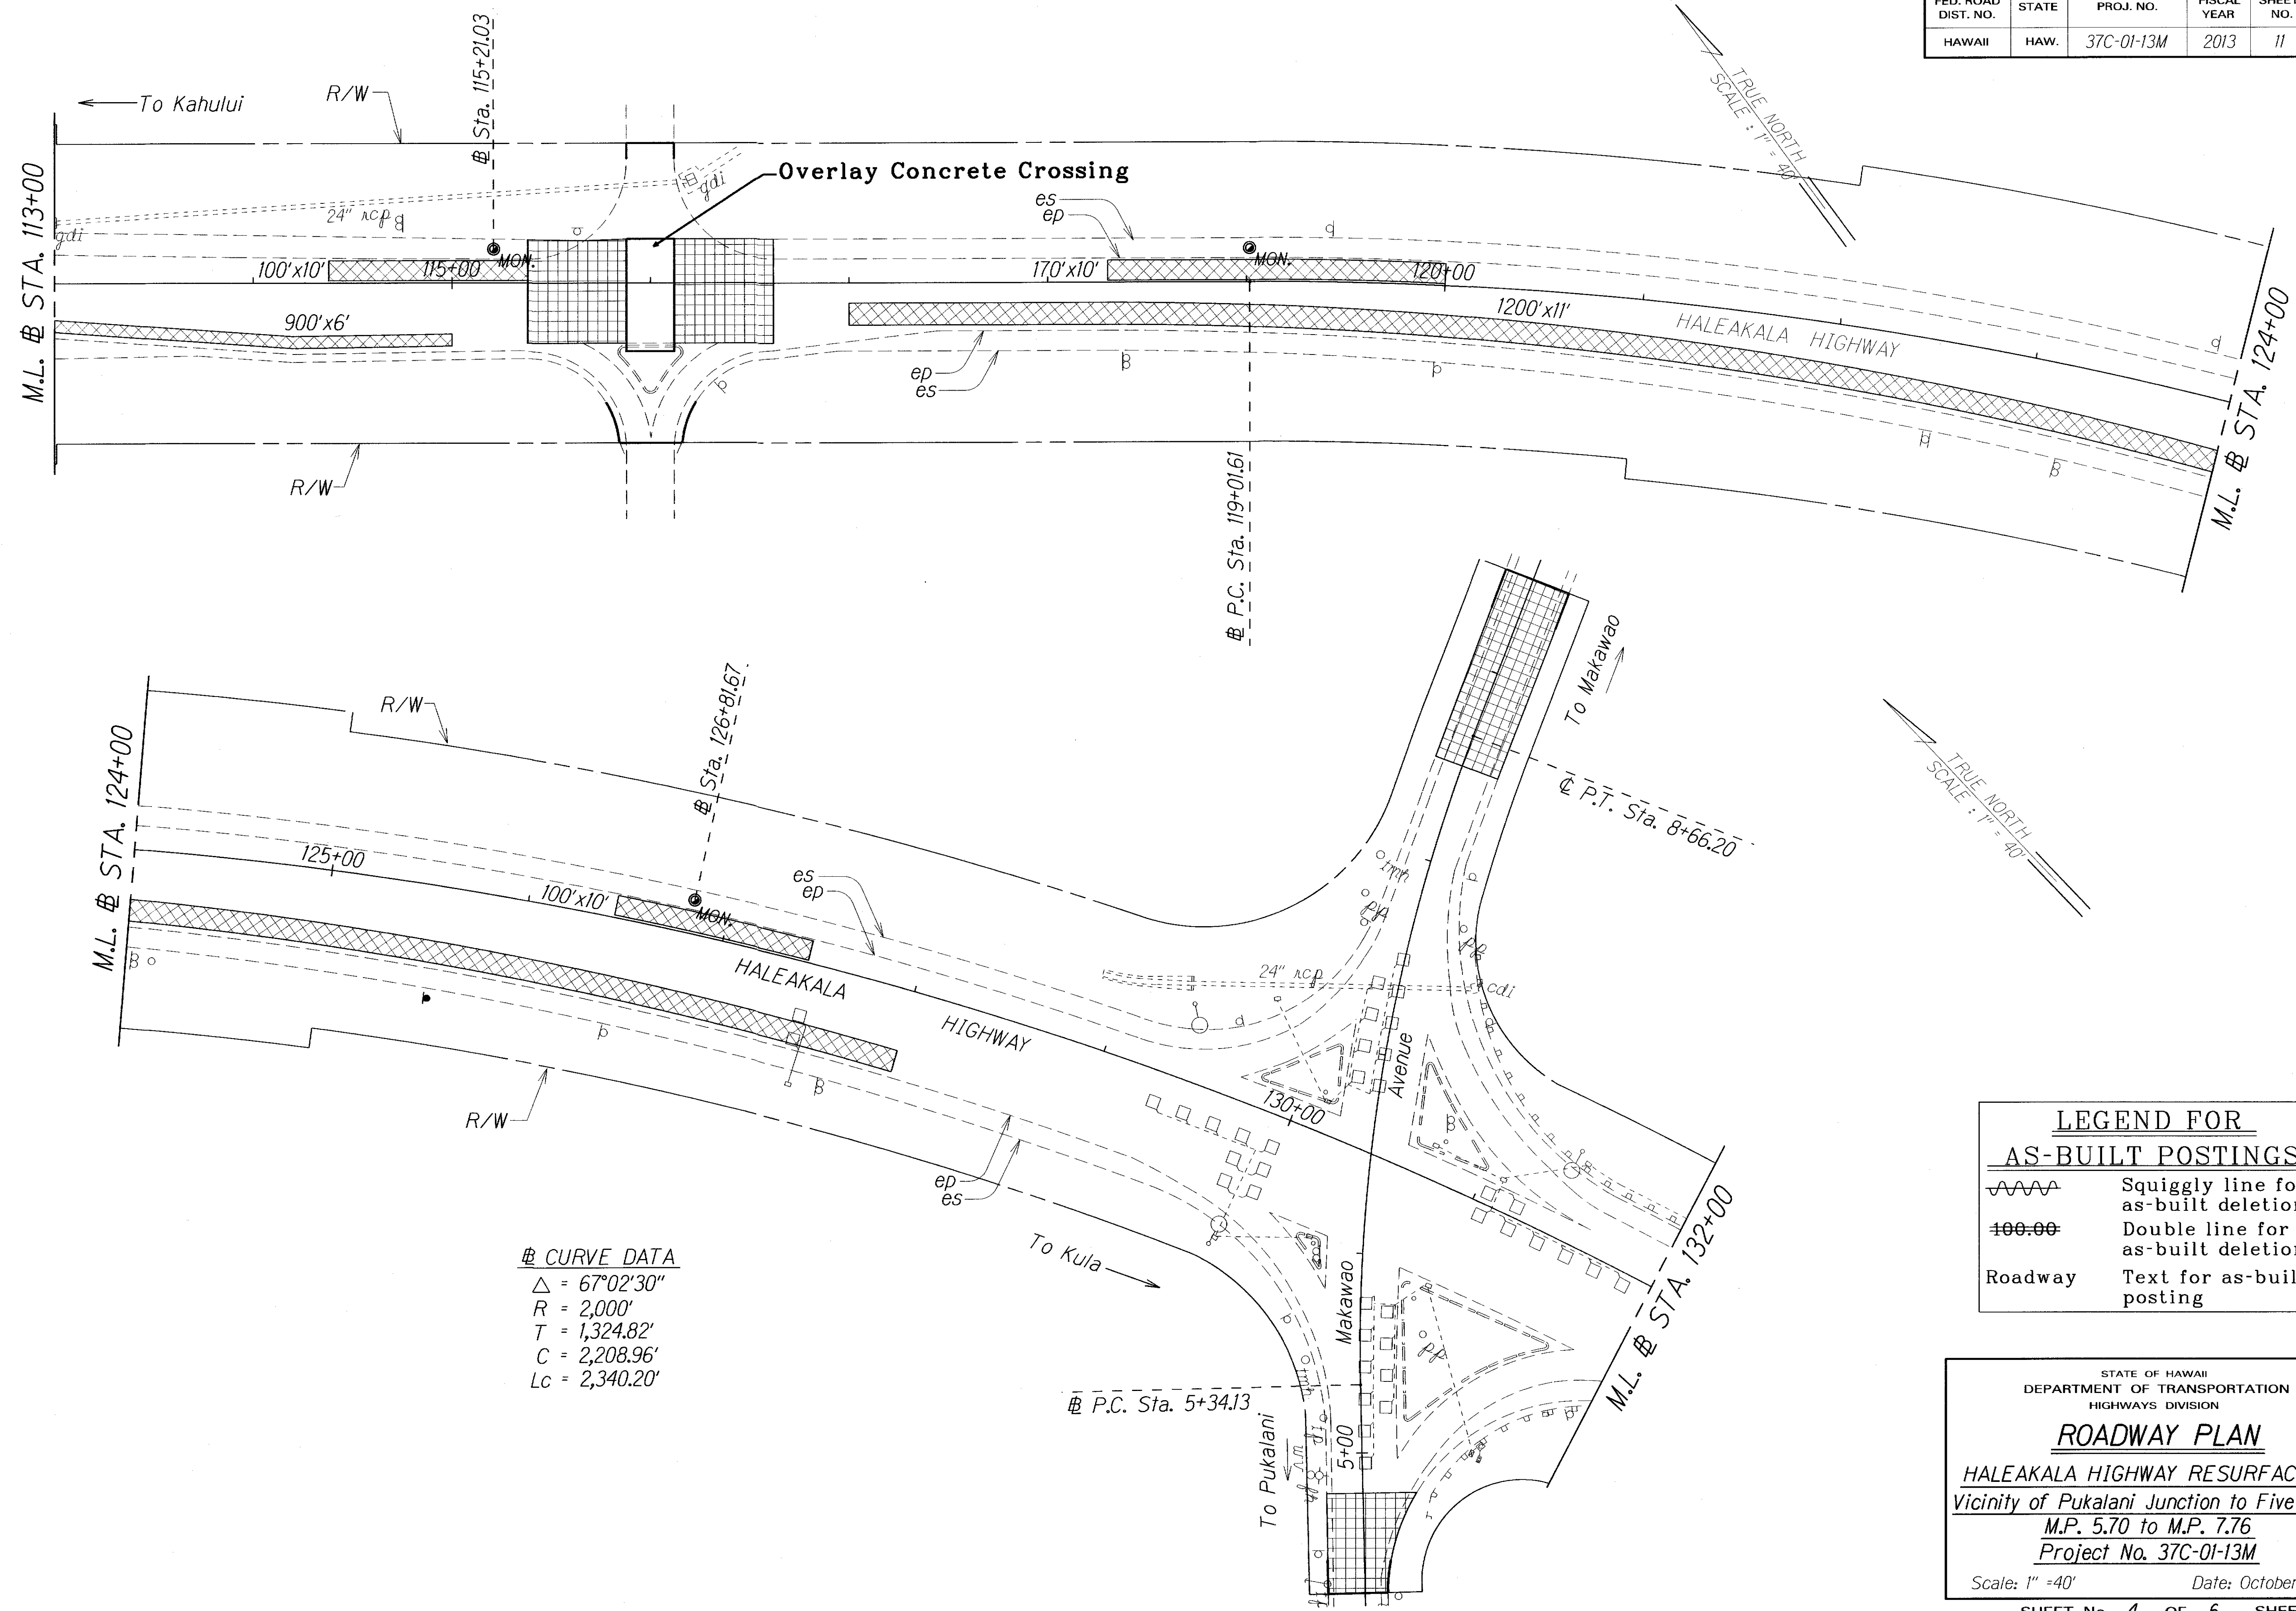

CURVE DATA
 $\Delta = 67^{\circ}02'30''$
 $R = 2,000'$
 $T = 1,324.82'$
 $C = 2,208.96'$
 $LC = 2,340.20'$

LEGEND FOR AS-BUILT POSTINGS	
	Squiggly line for as-built deletion
	Double line for as-built deletion
Roadway	Text for as-built posting

STATE OF HAWAII
DEPARTMENT OF TRANSPORTATION
HIGHWAYS DIVISION

ROADWAY PLAN


HALEAKALA HIGHWAY RESURFACING
Vicinity of Pukalani Junction to Five Trees
M.P. 5.70 to M.P. 7.76
Project No. 37C-01-13M

Scale: 1" = 40' Date: October, 2012

ORIGINAL PLAN	SURVEY PLOTTED BY	DATE
TRACED BY		
NOTE BOOK		
DESIGNED BY		
CHECKED BY		
N ^o .		

"AS-BUILT"

FED. ROAD DIST. NO.	STATE	PROJ. NO.	FISCAL YEAR	SHEET NO.	TOTAL SHEETS
HAWAII	HAW.	37C-01-13M	2013	12	23

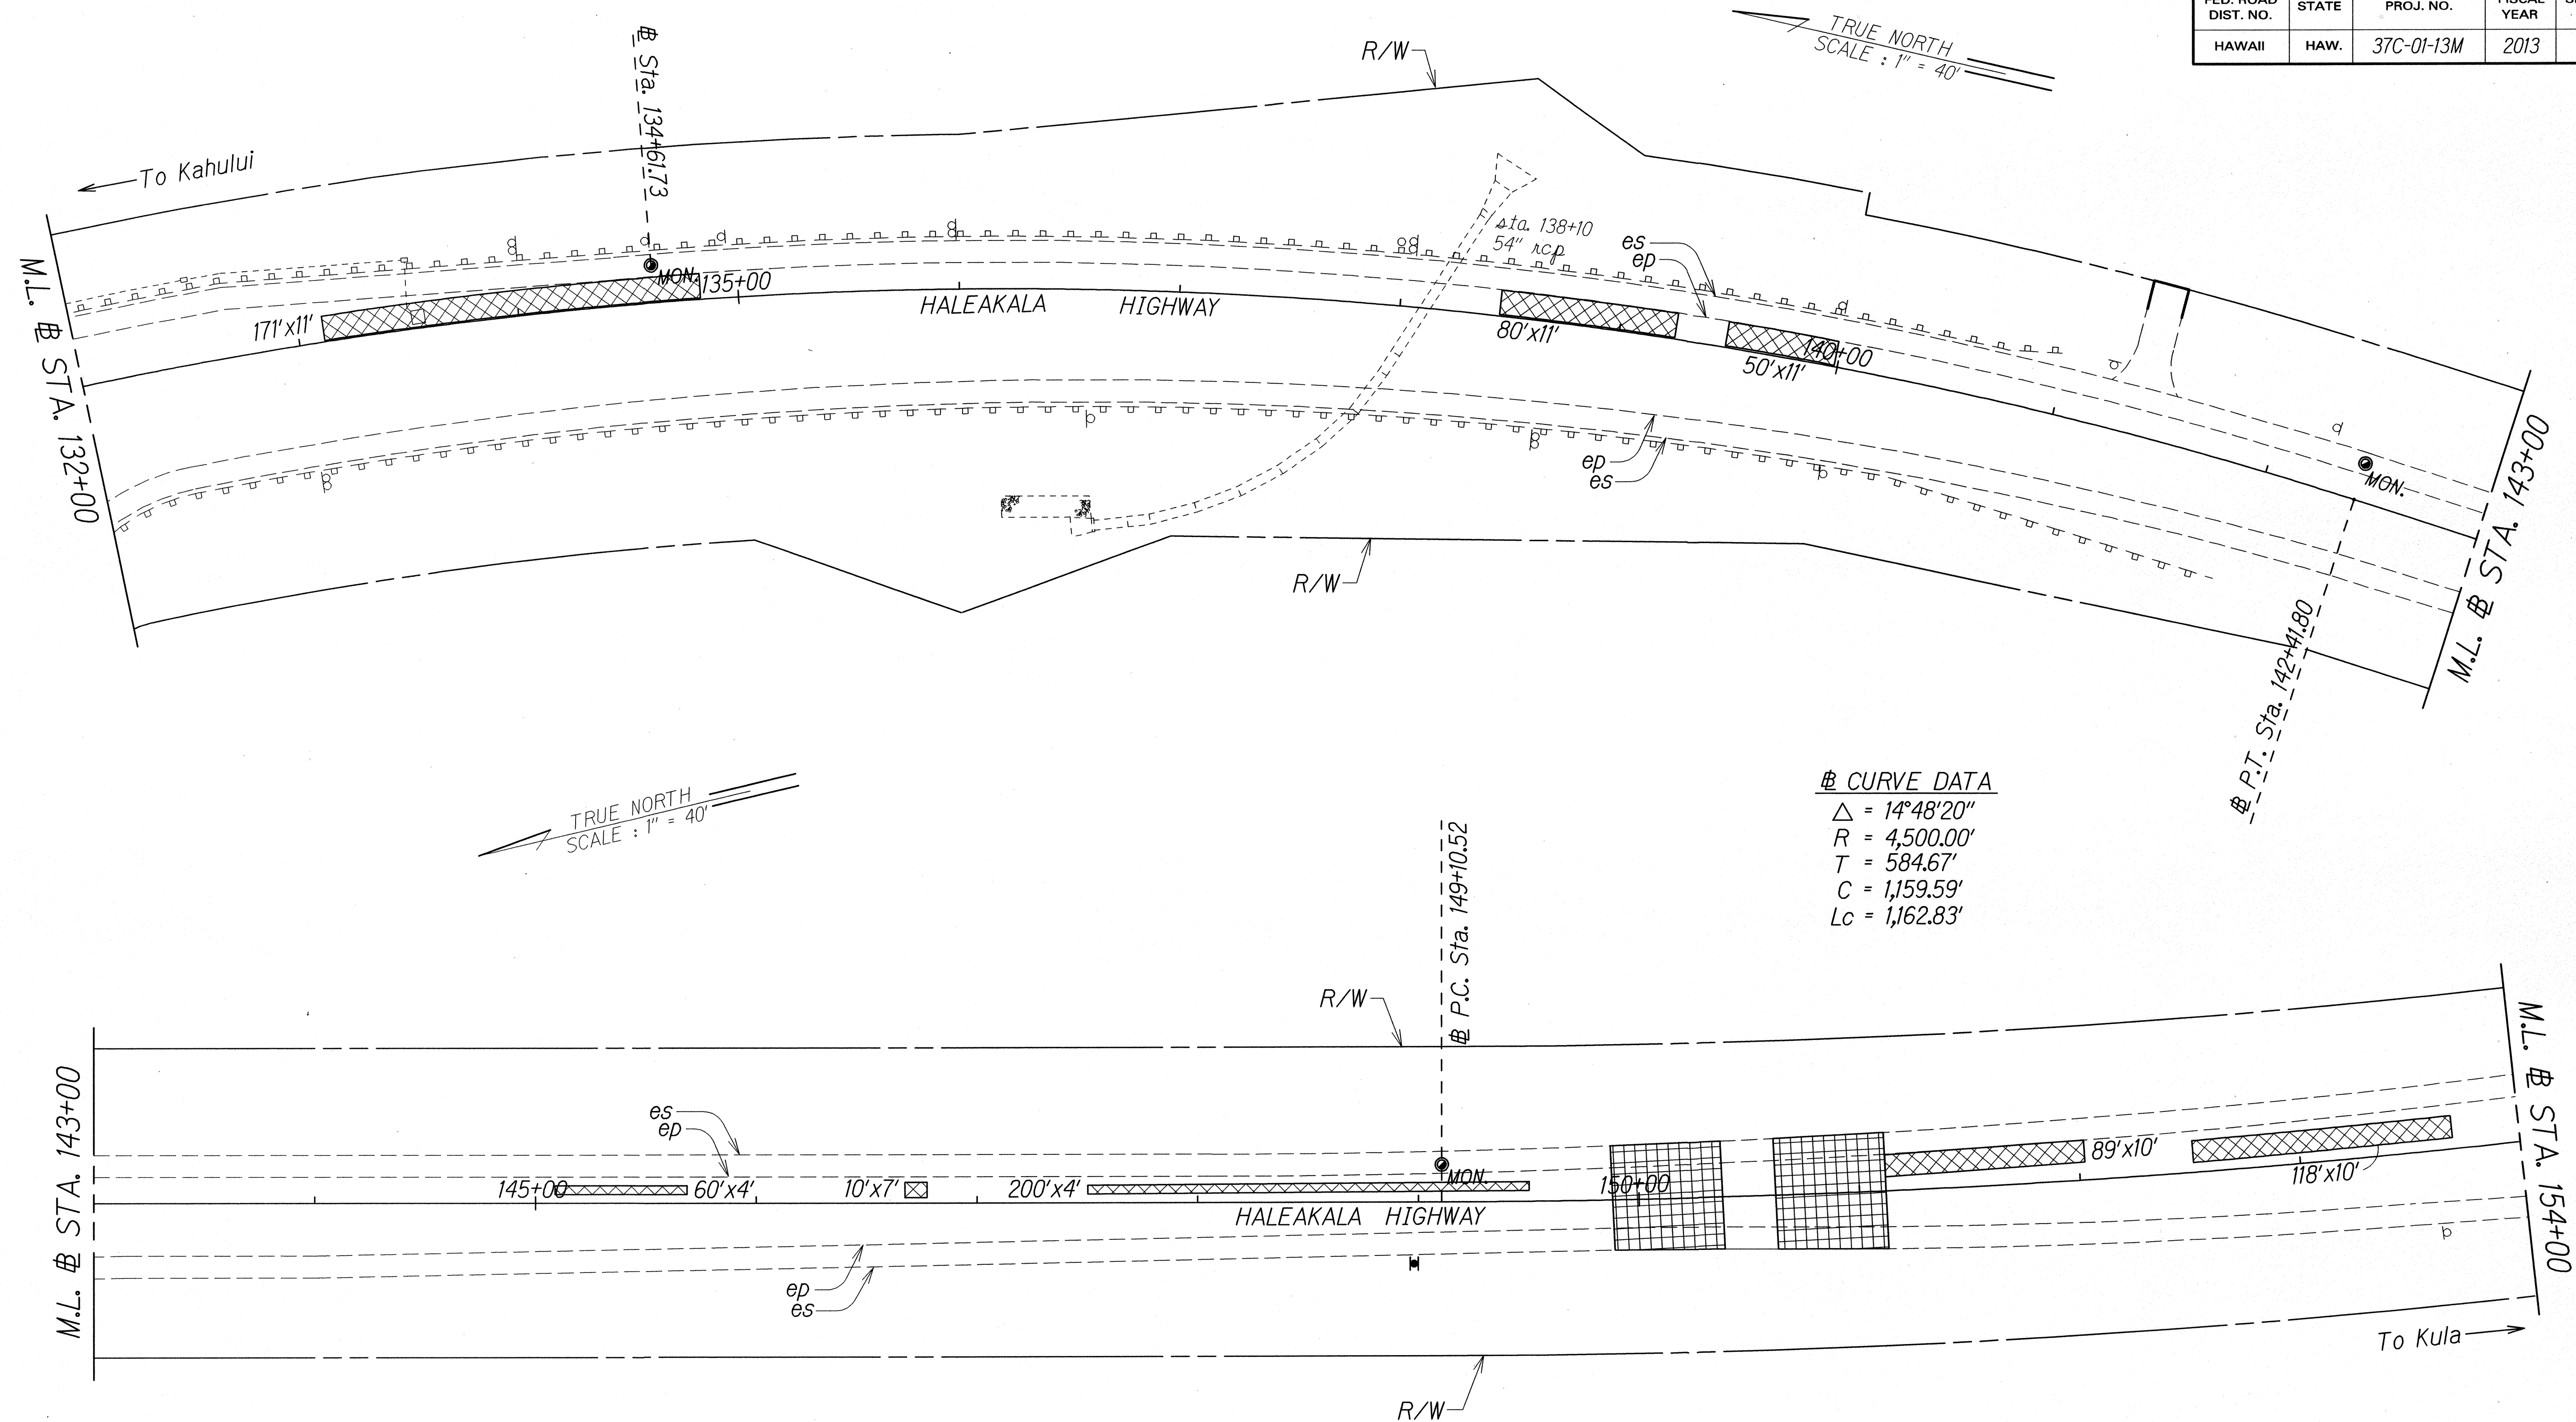

ORIGINAL PLAN	SURVEY PLOTTED BY _____ DATE _____
NOTE BOOK	DRAWN BY _____ *
	TRACED BY _____ *
	DESIGNED BY _____ *
	QUANTITIES BY _____ *
No. _____	CHECKED BY _____ *

STATE OF HAWAII
DEPARTMENT OF TRANSPORTATION
HIGHWAYS DIVISION

ROADWAY PLAN

HALEAKALA HIGHWAY RESURFACING
Vicinity of Pukalani Junction to Five Trees
M.P. 5.70 to M.P. 7.76
Project No. 37C-01-13M

Scale: 1" = 40' *Date: October, 2012*

SHEET No. 5 OF 6 SHEETS

