


FED. ROAD DIST. NO.	STATE	PROJ. NO.	FISCAL YEAR	SHEET NO.	TOTAL SHEETS
HAWAII	HAW.	37C-01-14	2014	ADD.16	30

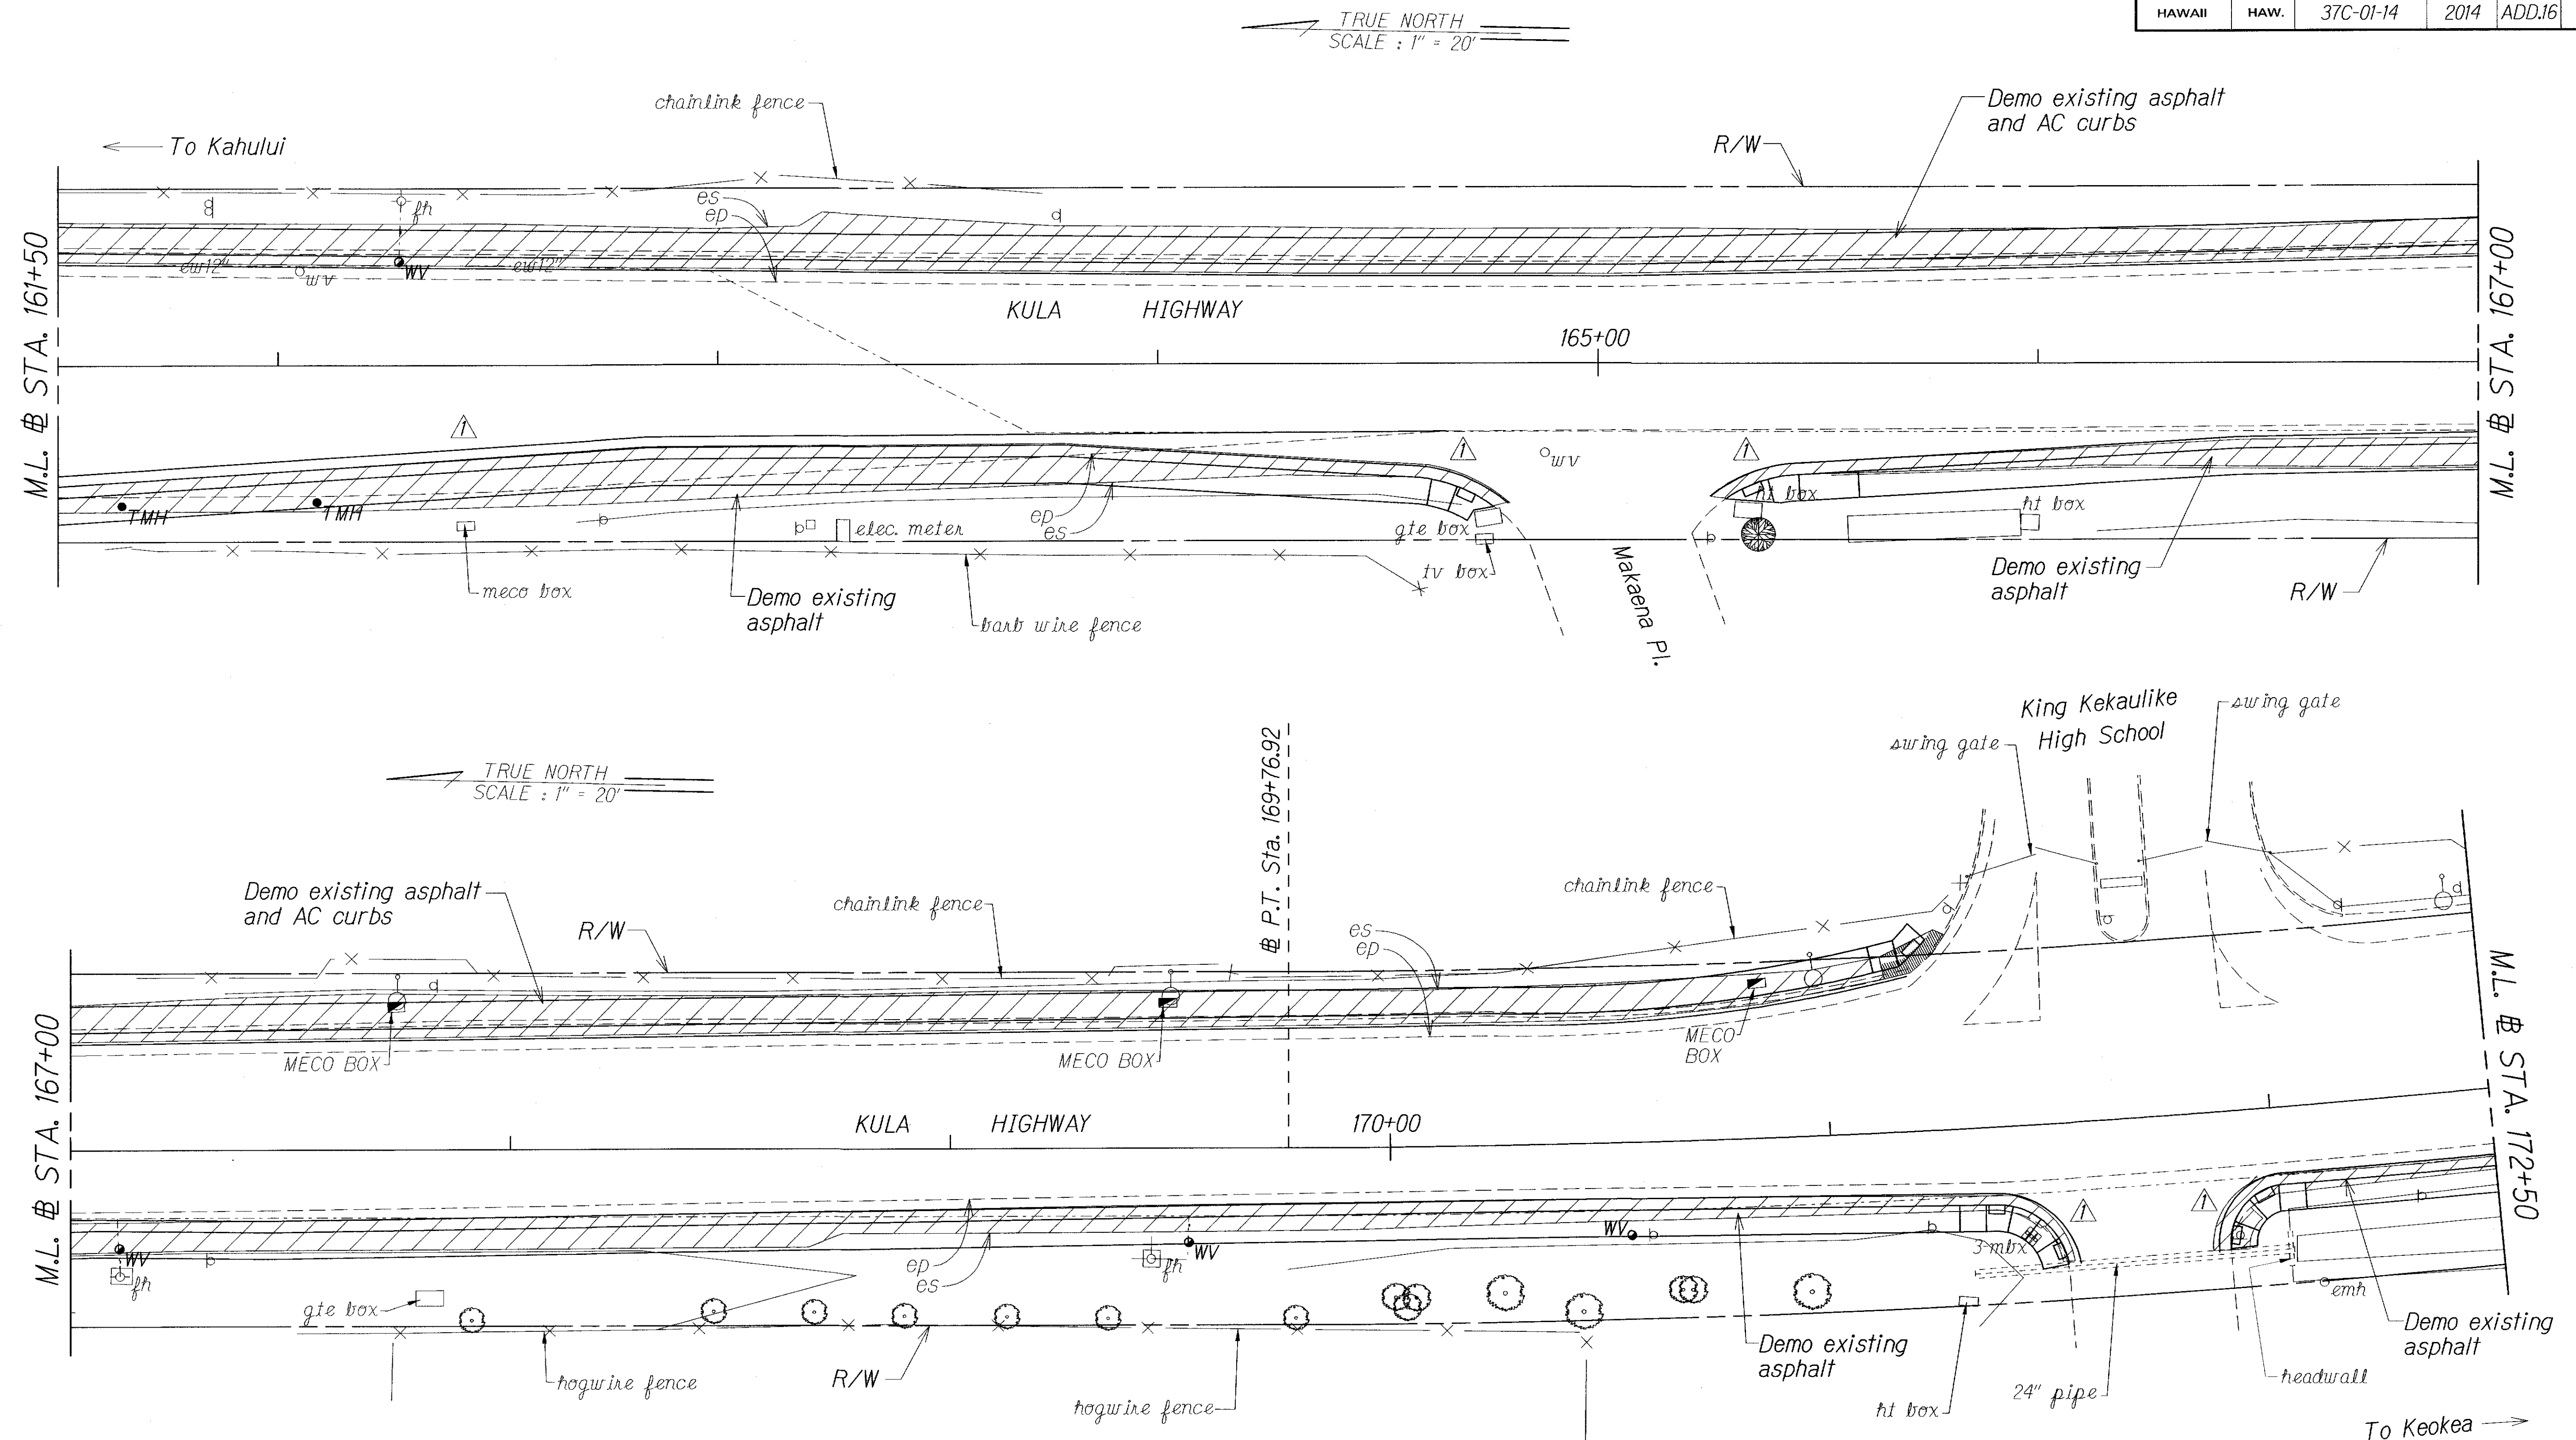

ORIGINAL PLAN	DATE
SURVEY PLOTTED BY	
DRAWN BY	
DESIGNED BY	
QUANTITIES BY	
CHECKED BY	

6-25-14	Revised demoltion area.
DATE	REVISION

NOTE:
Unless otherwise noted, existing utility boxes and water valves will remain in place and adjusted to new finish grade.

STATE OF HAWAII
DEPARTMENT OF TRANSPORTATION
HIGHWAYS DIVISION


DEMOLITION PLAN

HALEAKALA HIGHWAY INTERSECTION IMPROVEMENTS AT KULA HIGHWAY
Project No. 37C-01-14

Scale: 1" = 20' Date: April, 2014

SHEET No. 2 OF 3 SHEETS

FED. ROAD DIST. NO.	STATE	PROJ. NO.	FISCAL YEAR	SHEET NO.	TOTAL SHEETS
HAWAII	HAW.	37C-01-14	2014	ADD.17	30

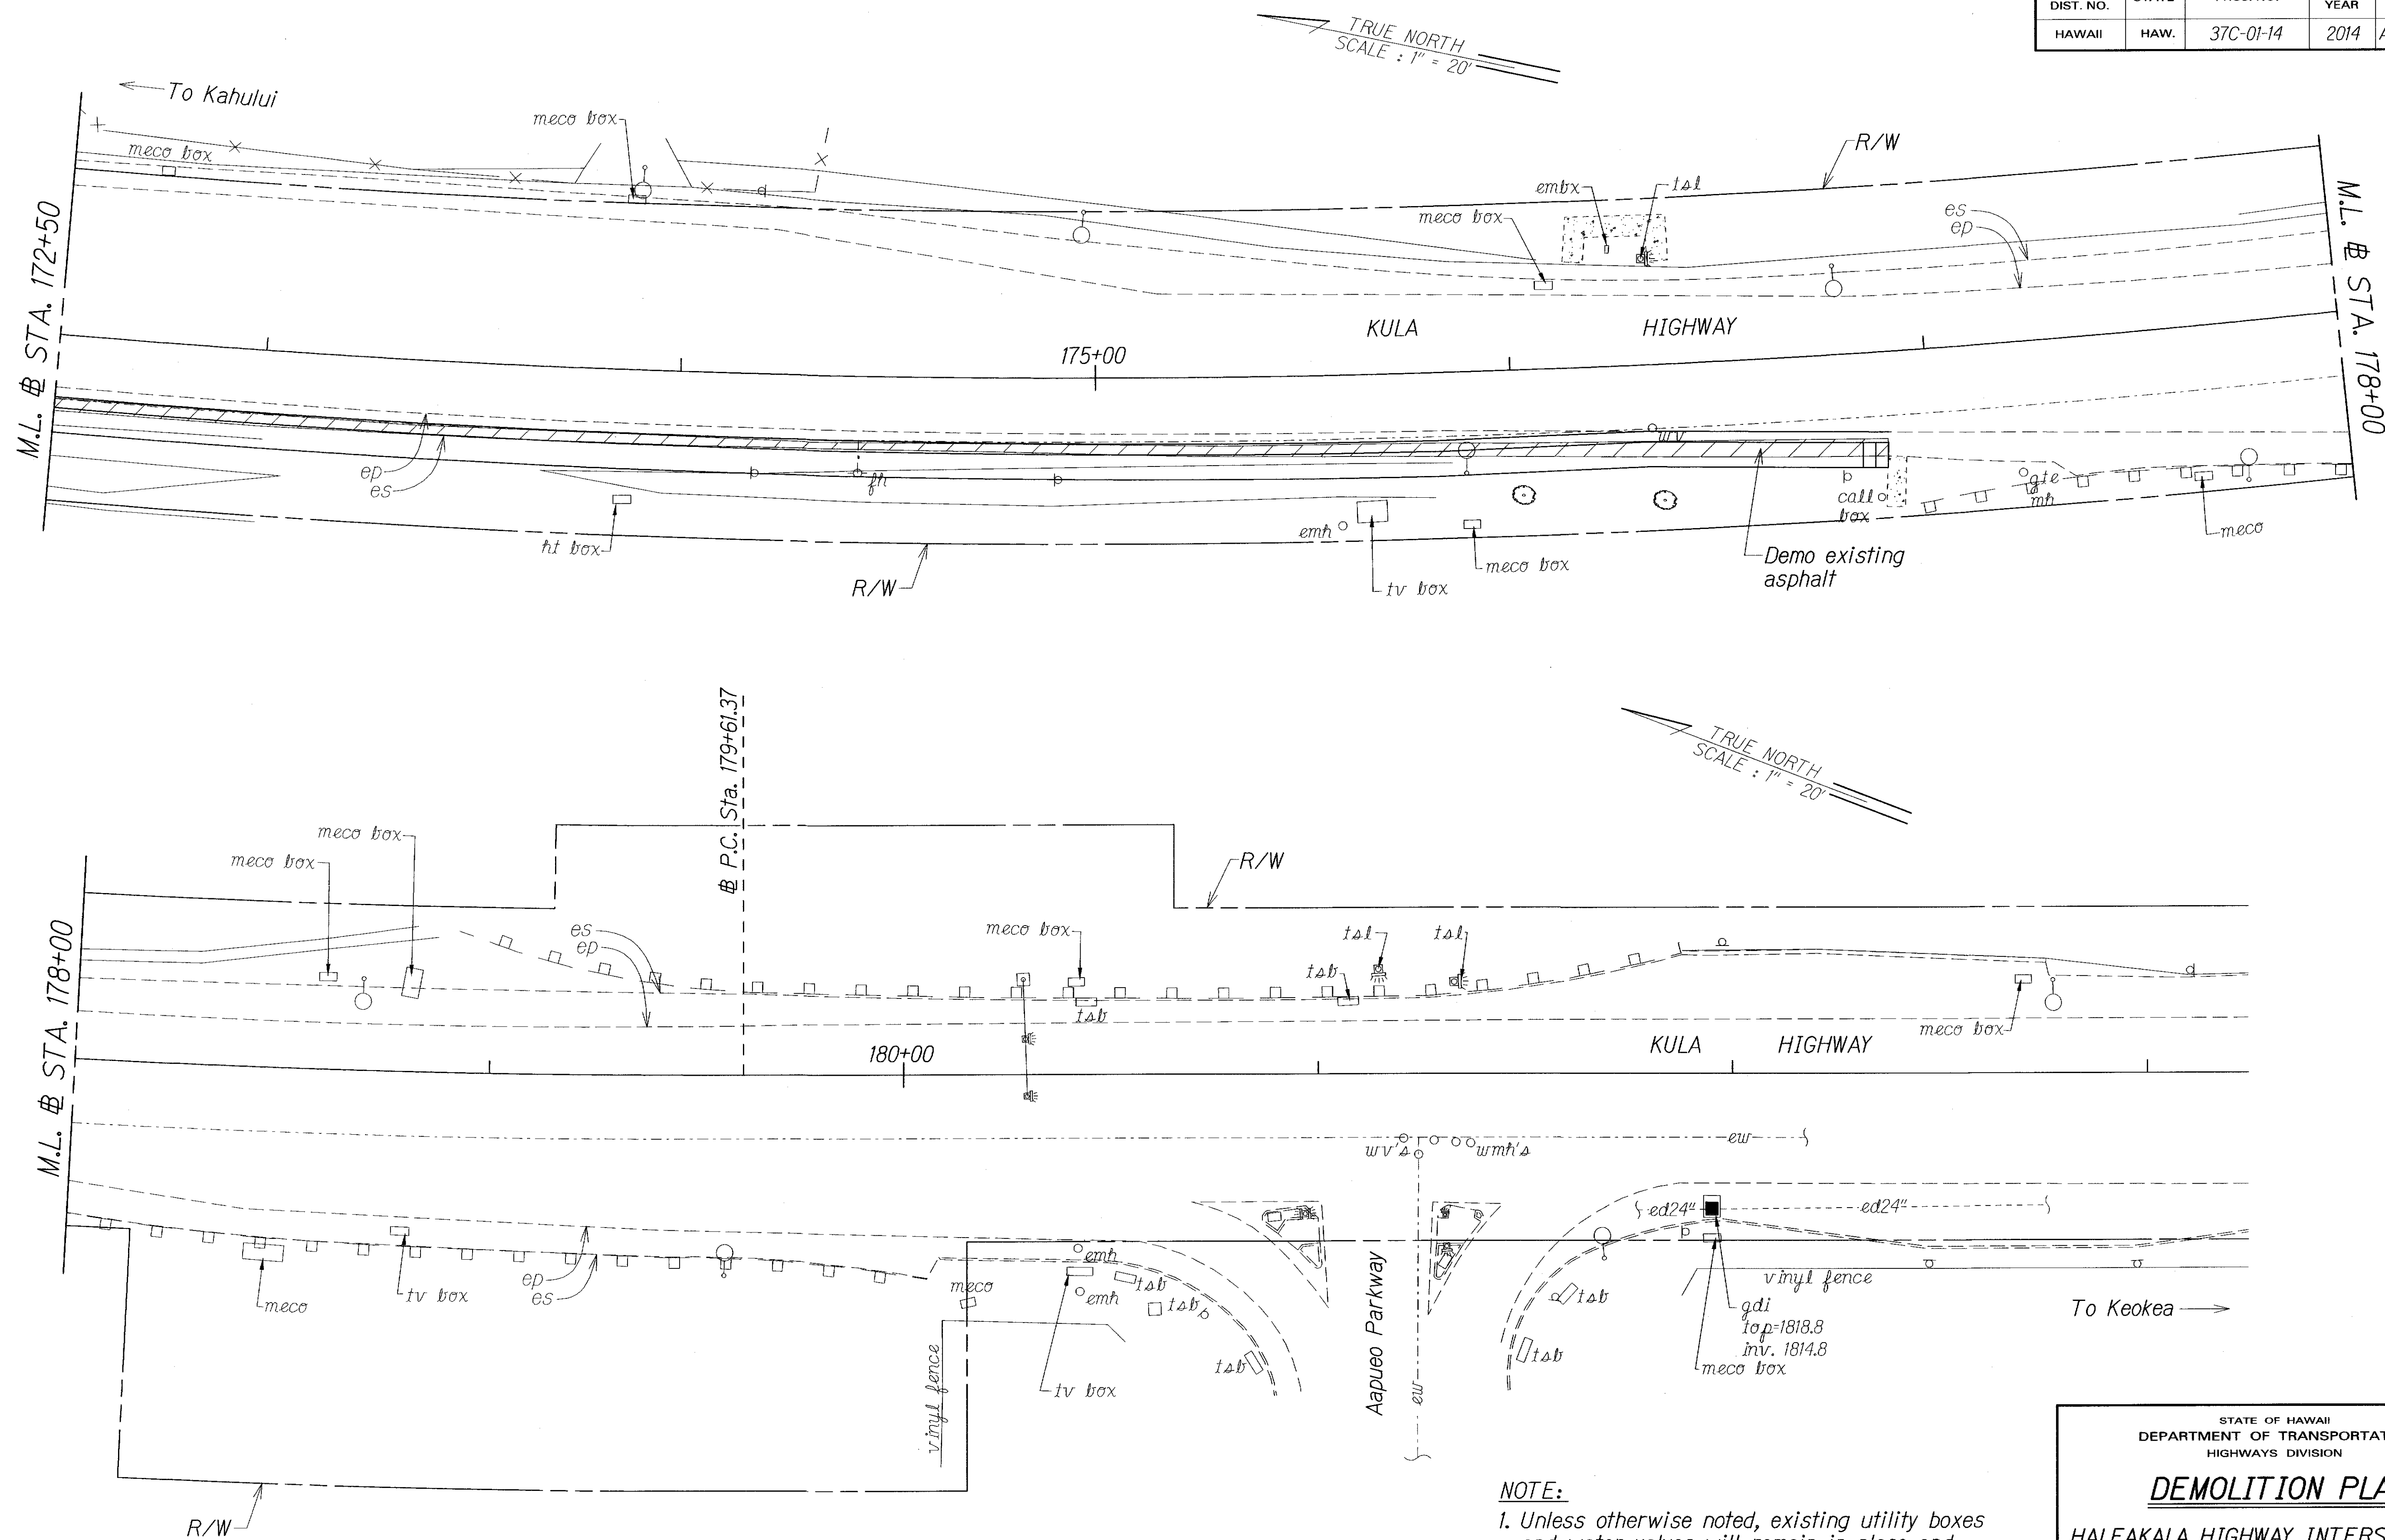

ORIGINAL PLAN	SURVEY PLOTTED BY	DATE
NOTE BOOK	DRAWN BY	
10/14	TRACED BY	
10/14	DESIGNED BY	
10/14	CHECKED BY	

6-25-14 Revised notes.

DATE REVISION

NOTE:

1. Unless otherwise noted, existing utility boxes and water valves will remain in place and adjusted to new finish grade.
2. Remove all markings and markers that conflict with the new markings and markers shown on the Signing and Pavement Marking Plans.

STATE OF HAWAII
DEPARTMENT OF TRANSPORTATION
HIGHWAYS DIVISION

DEMOLITION PLAN

**HALEAKALA HIGHWAY INTERSECTION
IMPROVEMENTS AT KULA HIGHWAY**

Project No. 37C-01-14

Scale: 1" = 20' Date: April, 2014

SHEET No. 3 OF 3 SHEETS