


Only install this Detectable Warning
if not installed by the County of Maui

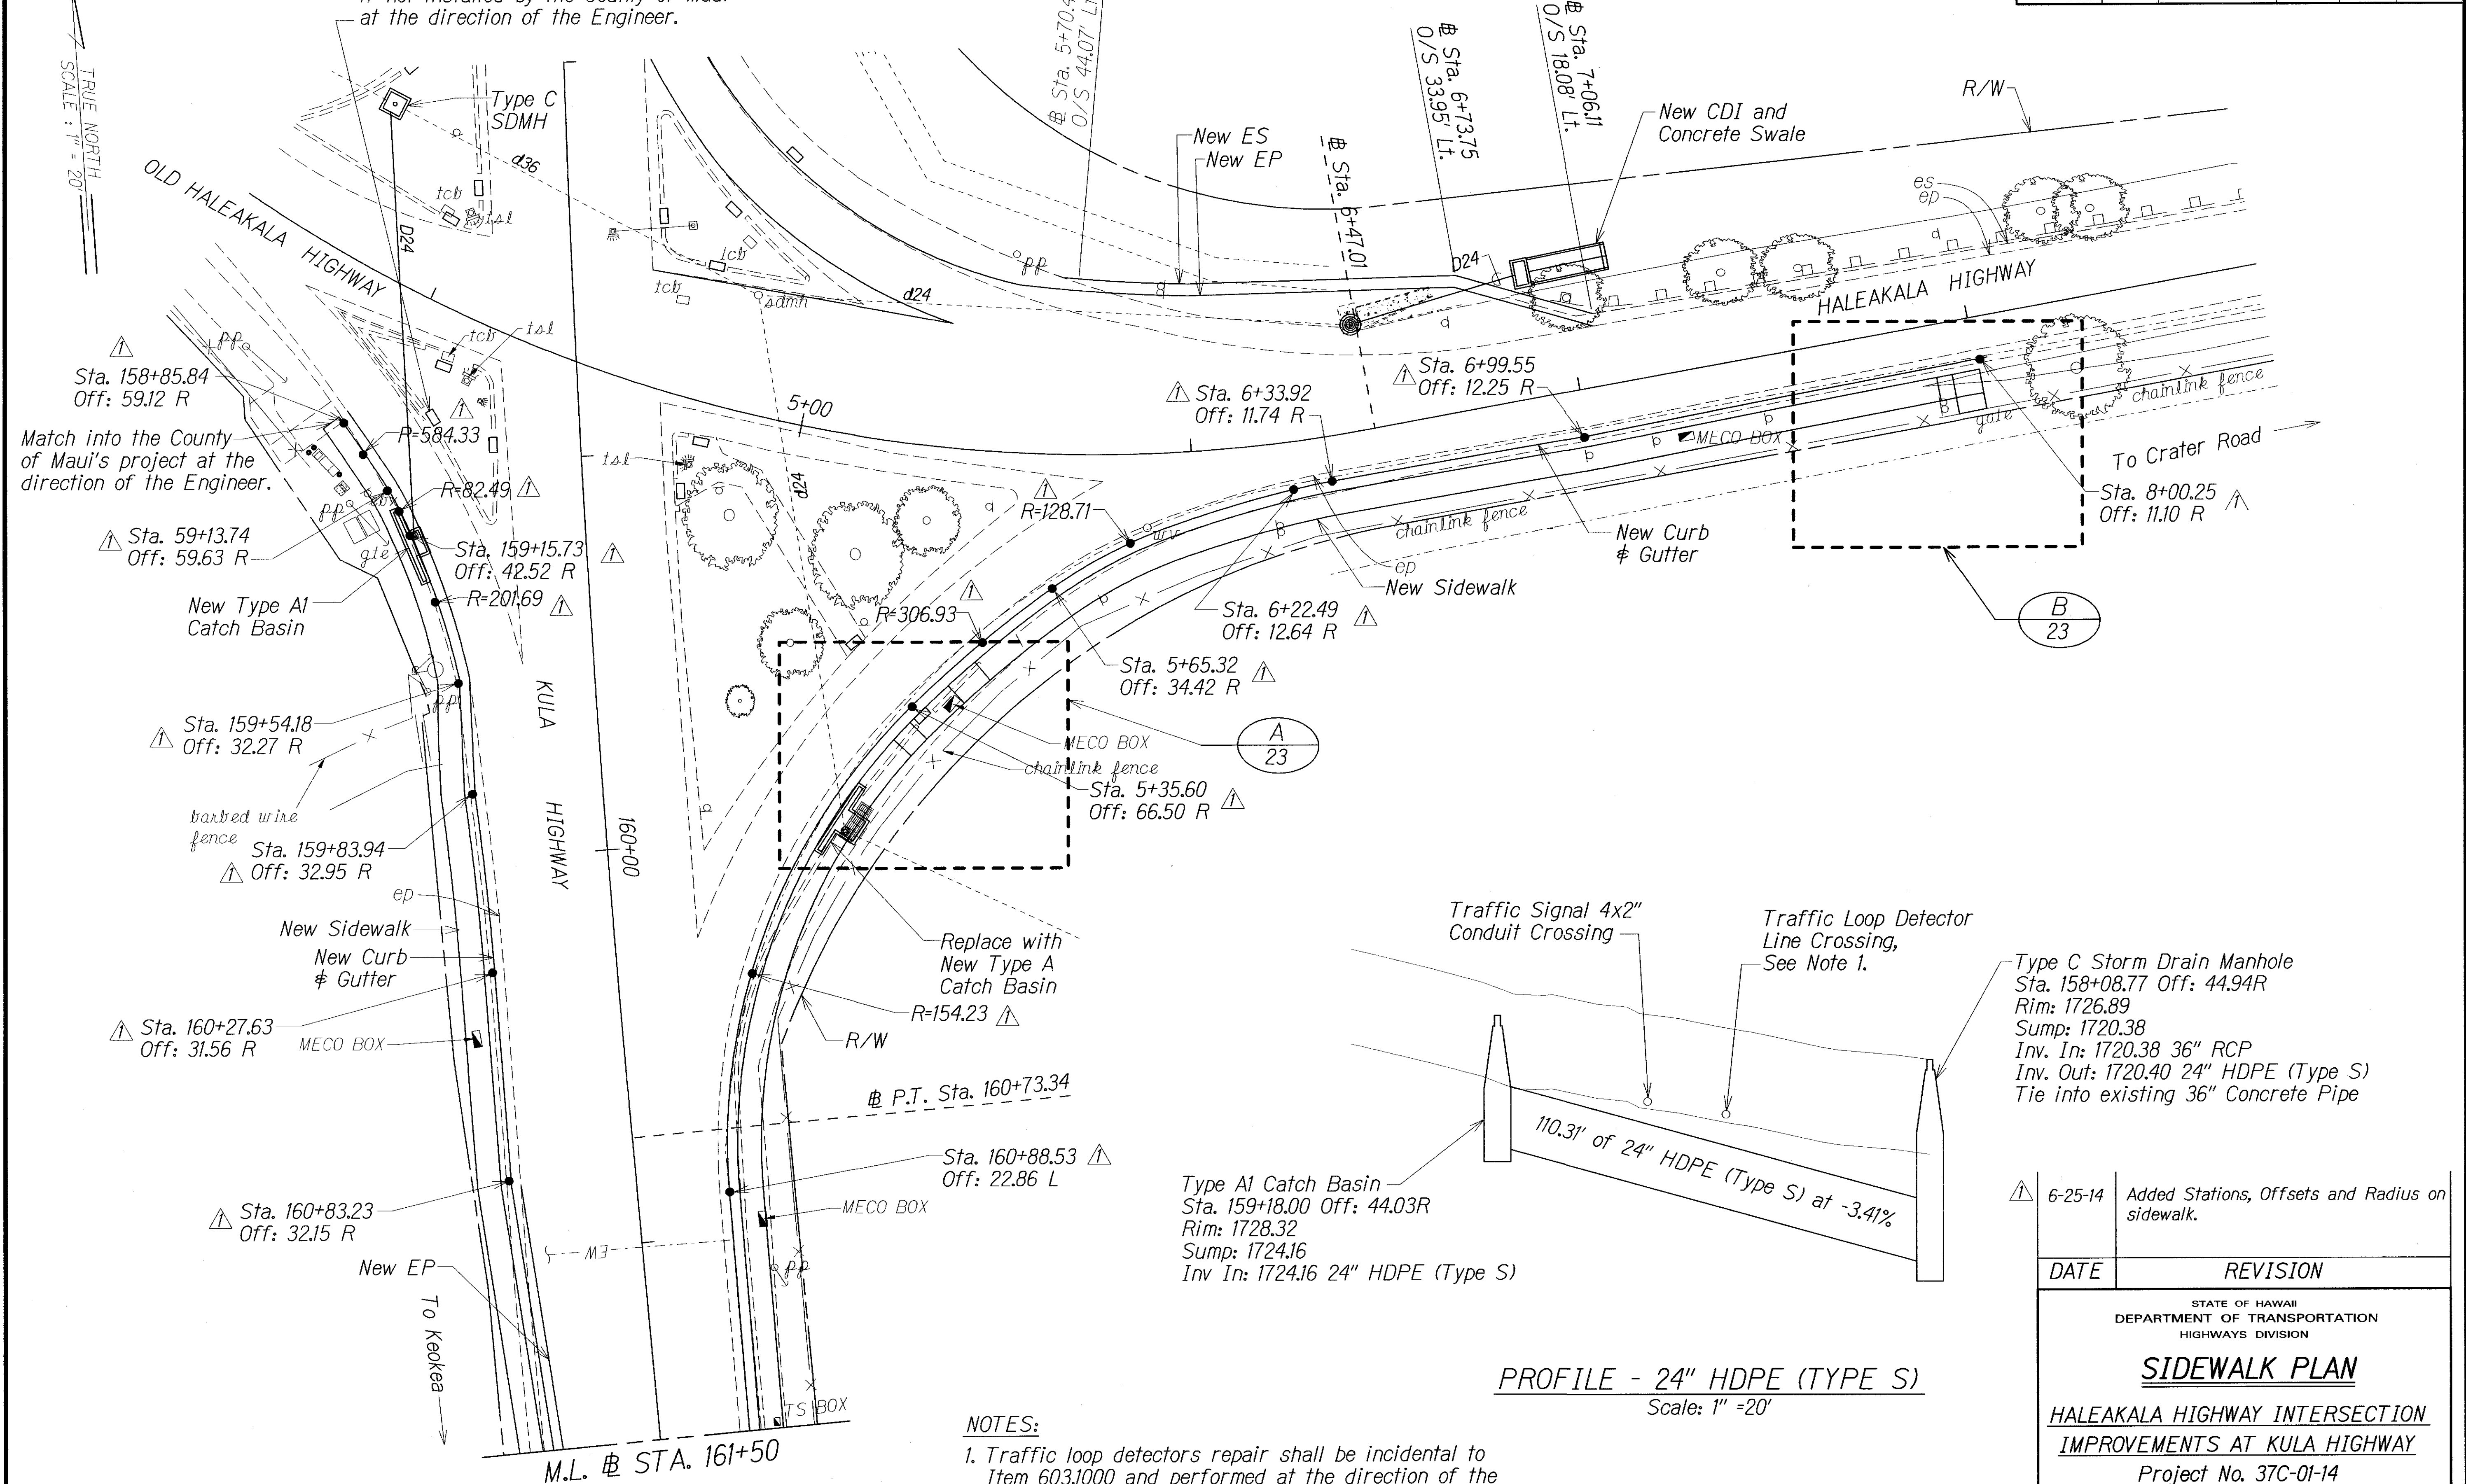

The profile view shows a cross-section of the roadway at STA. 160+83.23. The existing roadway is shown as a solid line, and the proposed roadway is shown as a dashed line. Key features include:

- Sta. 160+83.23**: Stationing point.
- Off: 32.15 R**: Offset from the centerline to the right side of the roadway.
- New EP**: New Edge Profile.
- To Keokea**: Directional arrow pointing towards the Keokea area.
- M.E.**: Median Edge.
- MECO BOX**: Median Edge Catchment Basin.
- TS BOX**: Traffic Signal Box.
- M.L. # STA. 161+50**: Milepost location at STA. 161+50.


Notes:

- Traffic loop detectors repair shall be incidental to Item 603.1000 and performed at the direction of the Engineer.

Type A1 Catch Basin
Sta. 159+18.00 Off: 44.03R
Rim: 1728.32
Sump: 1724.16
Inv In: 1724.16 24" HDPE (Type S)

PROFILE - 24" HDPE (TYPE S)
Scale: 1" = 20'

FED. ROAD DIST. NO.	STATE	PROJ. NO.	FISCAL YEAR	SHEET NO.	TOTAL SHEETS
HAWAII	HAW.	37C-01-14	2014	ADD.21	30

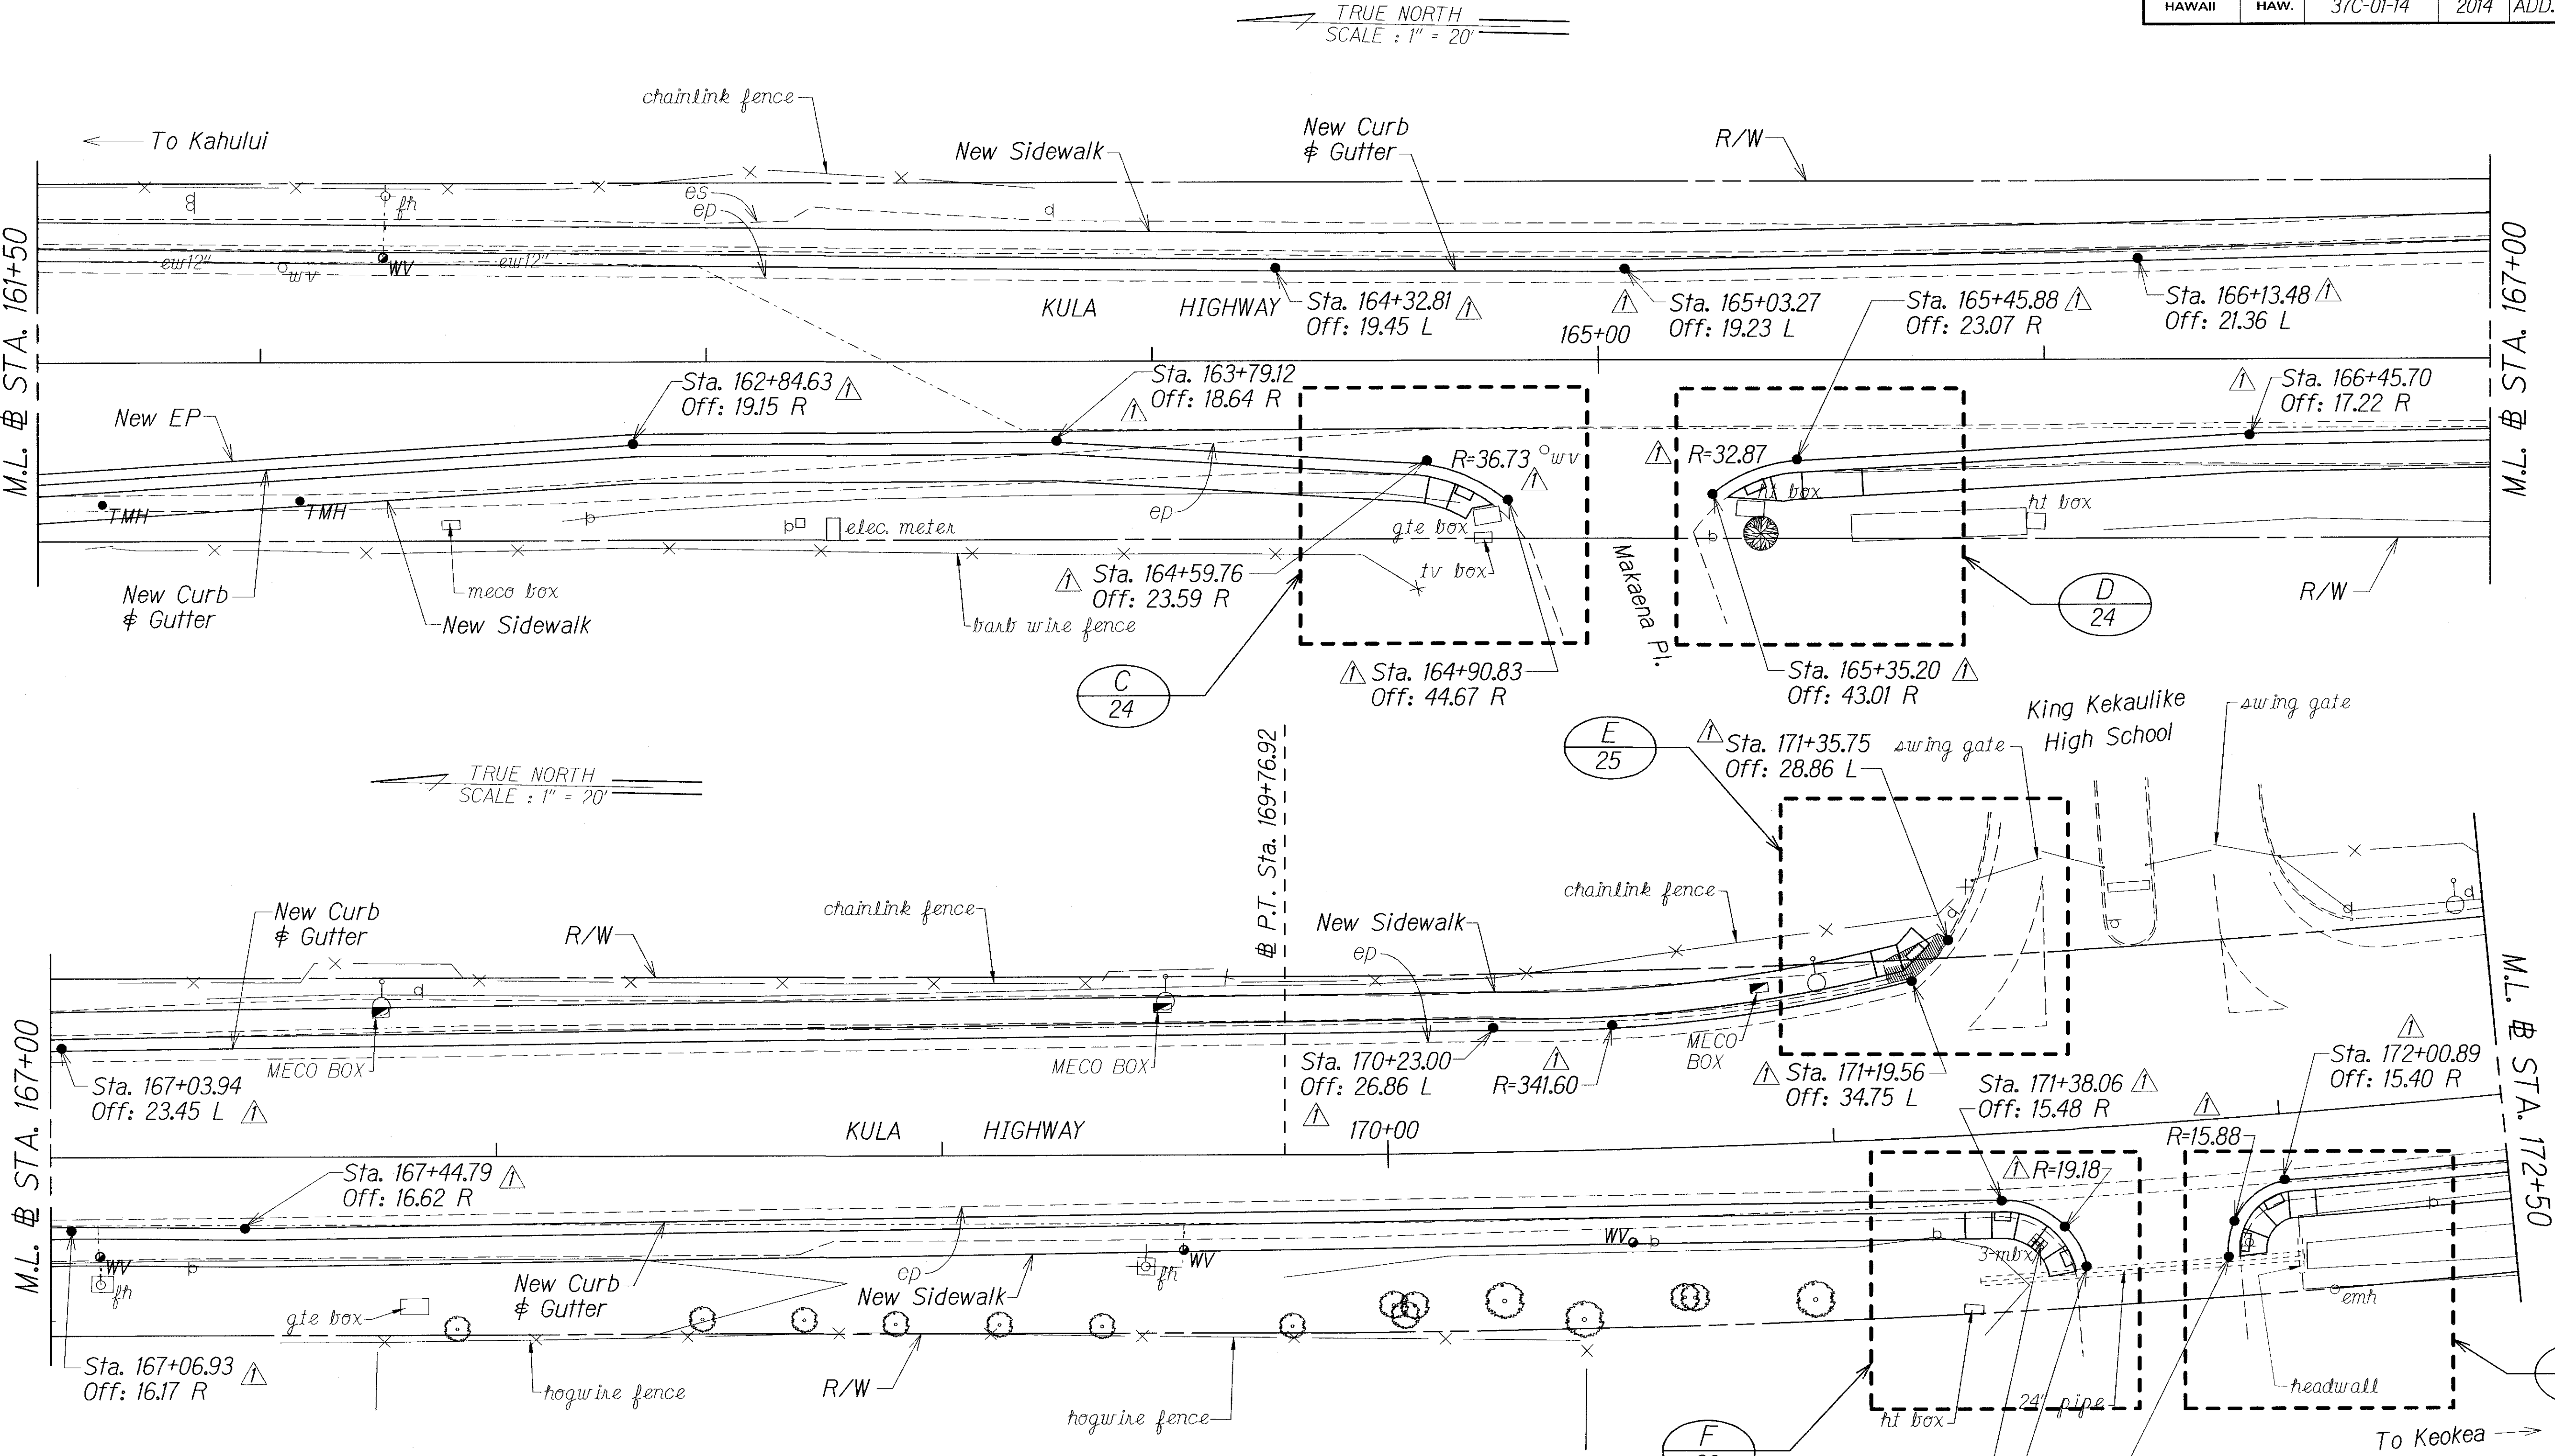

NOTES:

1. Relocation of mailboxes shall be incidental to Item 650.1100 and performed at the direction of the Engineer.

DATE	6-25-14	Added Stations, Offsets and Radius of sidewalk.
DATE		REVISION

STATE OF HAWAII
DEPARTMENT OF TRANSPORTATION
HIGHWAYS DIVISION

SIDEWALK PLAN


HALEAKALA HIGHWAY INTERSECTION
IMPROVEMENTS AT KULA HIGHWAY
Project No. 37C-01-14

Scale: 1" = 20' Date: April, 2014

SHEET No. 2 OF 3 SHEETS

SURVEY PLOTTED BY	DATE
DESIGNED BY	
DESIGNED BY	
QUANTITIES BY	
CHECKED BY	
ORIGINAL PLAN	
NOTE BOOK	
00000	
00000	

FED. ROAD DIST. NO.	STATE	PROJ. NO.	FISCAL YEAR	SHEET NO.	TOTAL SHEETS
HAWAII	HAW.	37C-01-14	2014	ADD.22	30

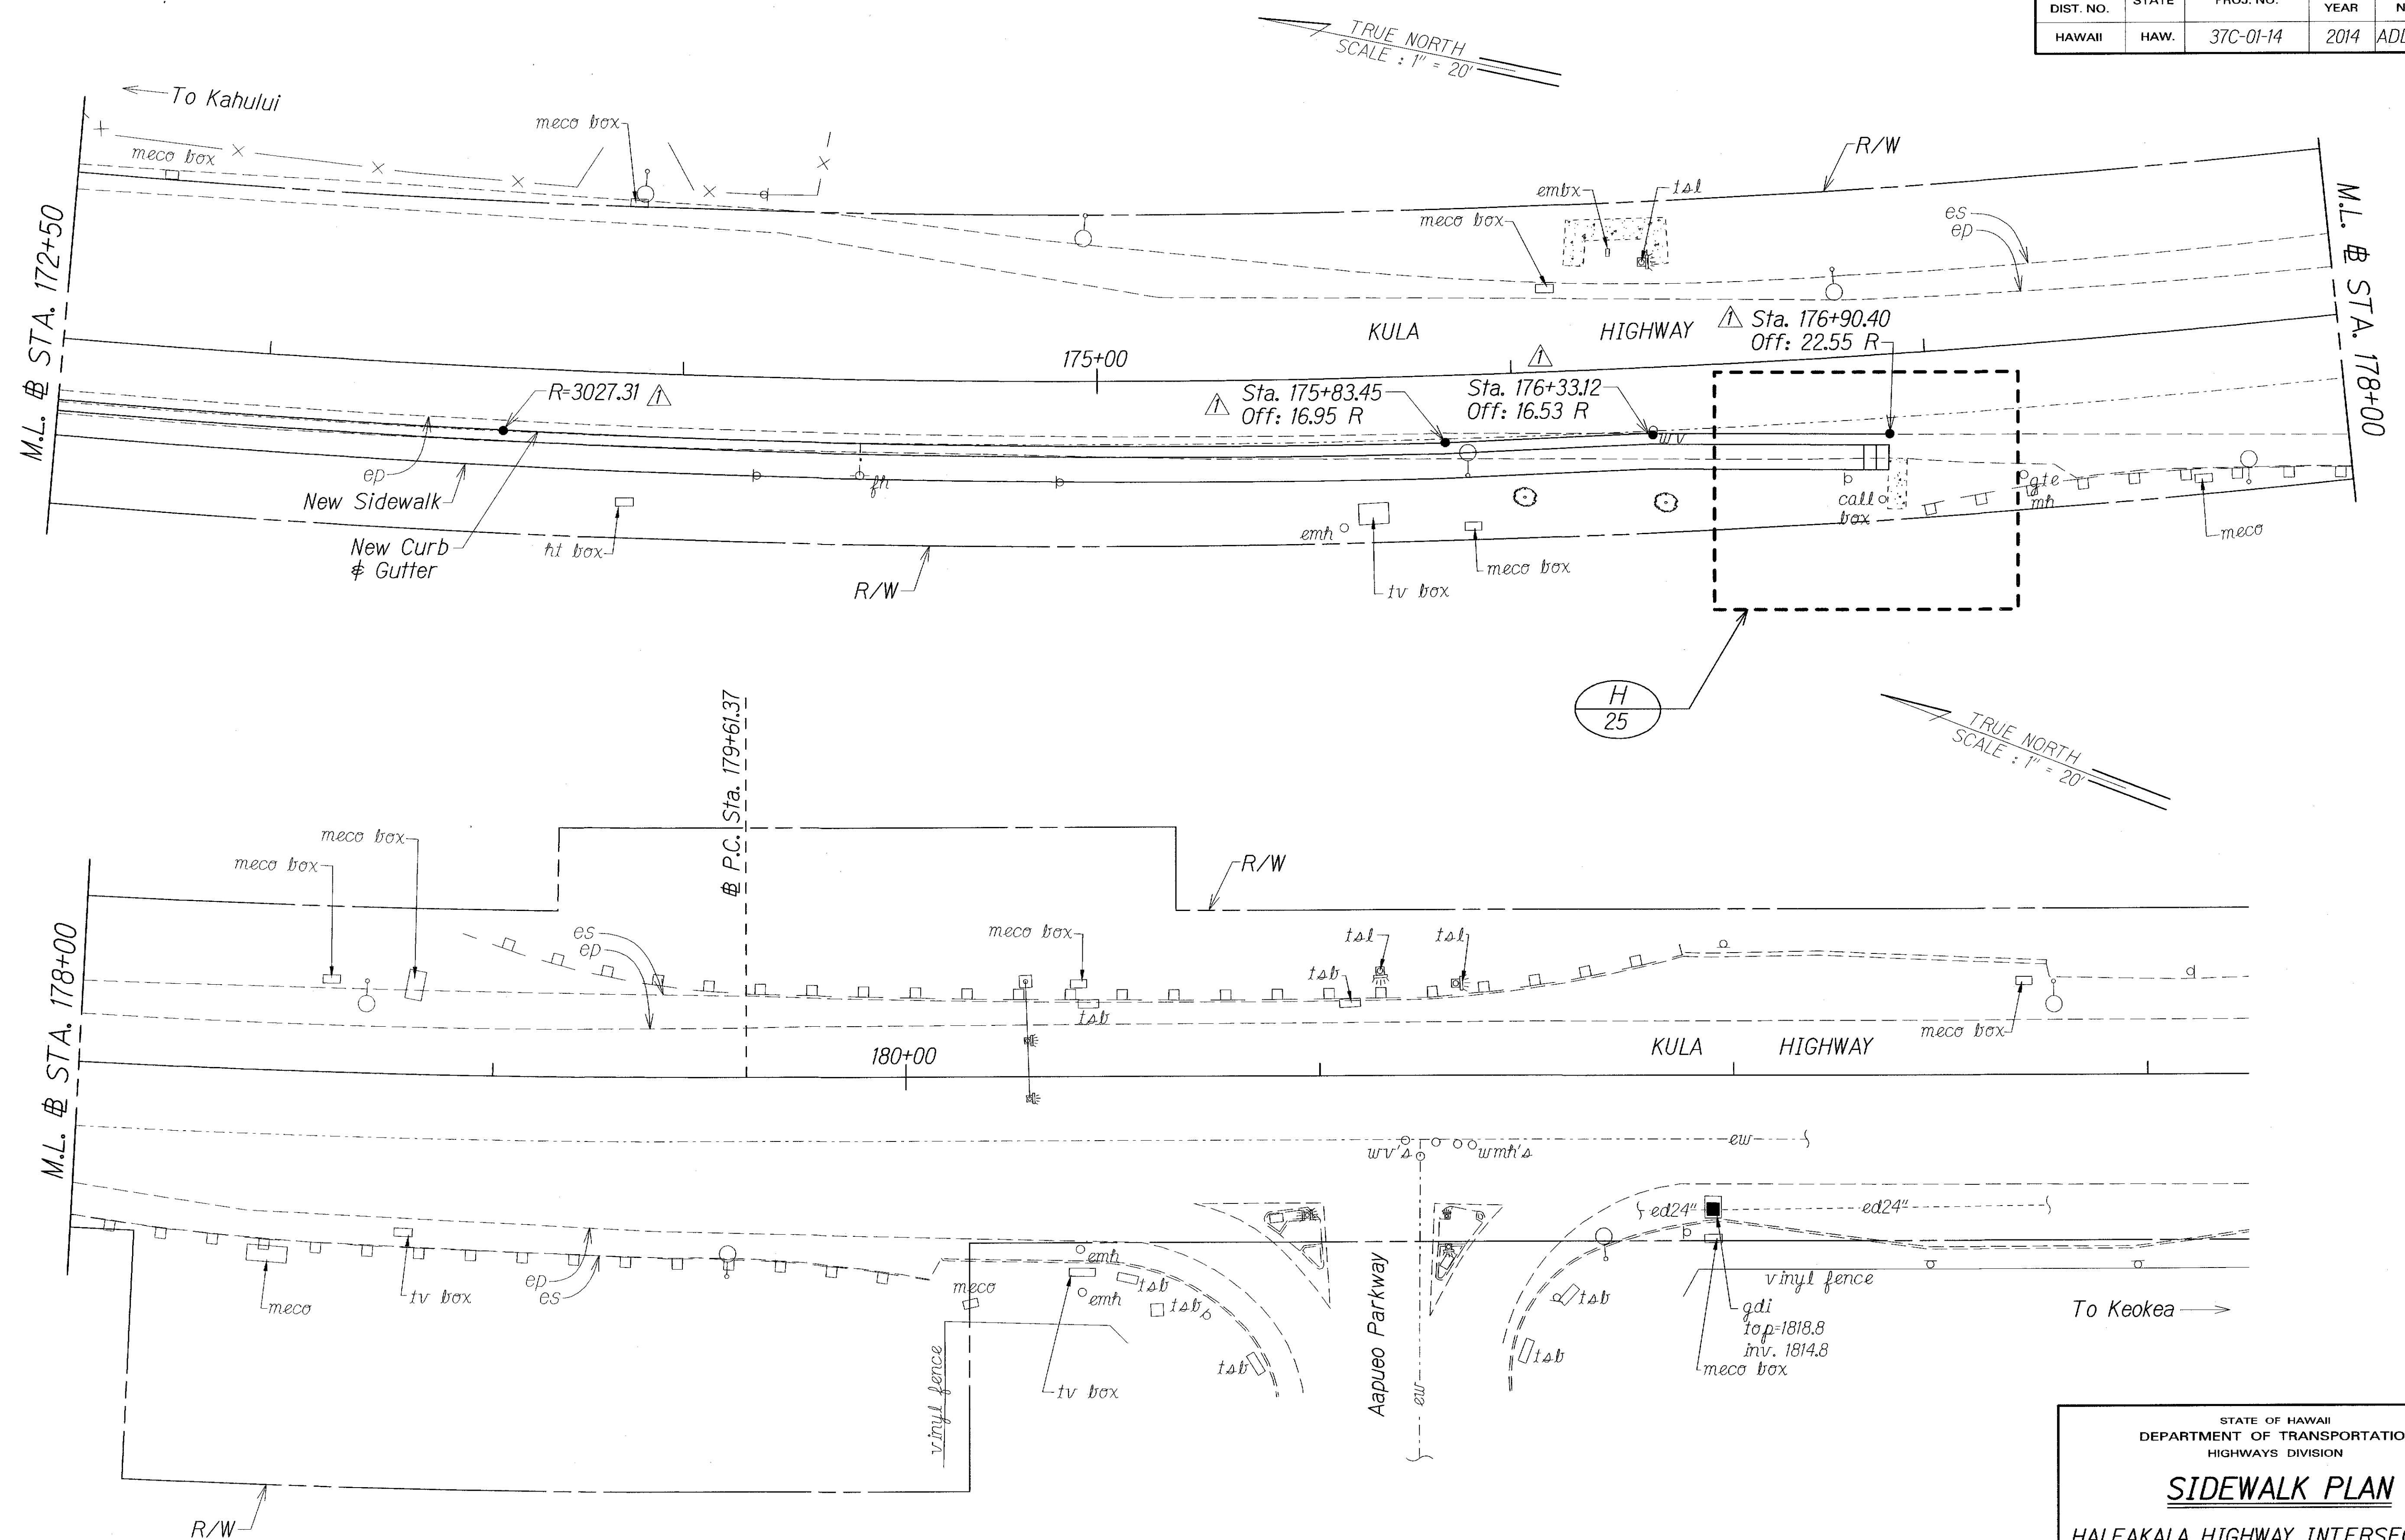

ORIGINAL PLAN	SURVEY PLOTTED BY	DATE
NOT BOOK	DRAWN BY	
DESIGNED BY		
CHECKED BY		
NO. 1000		

6-25-14	Added Stations, Offsets and Radius on sidewalk.
DATE	REVISION

STATE OF HAWAII DEPARTMENT OF TRANSPORTATION HIGHWAYS DIVISION
SIDEWALK PLAN
HALEAKALA HIGHWAY INTERSECTION IMPROVEMENTS AT KULA HIGHWAY
Project No. 37C-01-14
Scale: 1" = 20' Date: April, 2014
SHEET No. 3 OF 3 SHEETS

ADD. 22