	INDEX TO DRAWINGS
SHEET NO.	DESCRIPTION
1	TITLE SHEET
2	STANDARD PLANS SUMMARY
3	GENERAL NOTES AND LEGEND
4 – 5	WATER POLLUTION & EROSION CONTROL NOTES
6 – 8	TYPICAL SECTIONS AND DETAILS
9 – 13	CURB RAMP DETAILS
14	DRAINAGE DETAILS
15 – 17	DEMOLITION PLANS
18 – 19	ROADWAY PLANS
20 – 22	SIDEWALK PLANS
23 – 26	CURB RAMP PLANS
27	PAVEMENT MARKING LEGEND, DETAILS, NOTES & SIGN PANEL LAYOUT
28	WORK ZONE SIGNING PLAN, NOTES & DETAILS
29 – 30	SIGNING AND PAVEMENT MARKING PLANS

STATE OF HAWAII

## DEPARTMENT OF TRANSPORTATION


DIVISION HIGHWAYS HONOLULU, HAWAII


**PLANS FOR** 

## HALEAKALA HIGHWAY INTERSECTION IMPROVEMENTS AT KULA HIGHWAY

PROJECT NO. 37C-01-14

DISTRICT OF MAKAWAO ISLAND OF MAUI

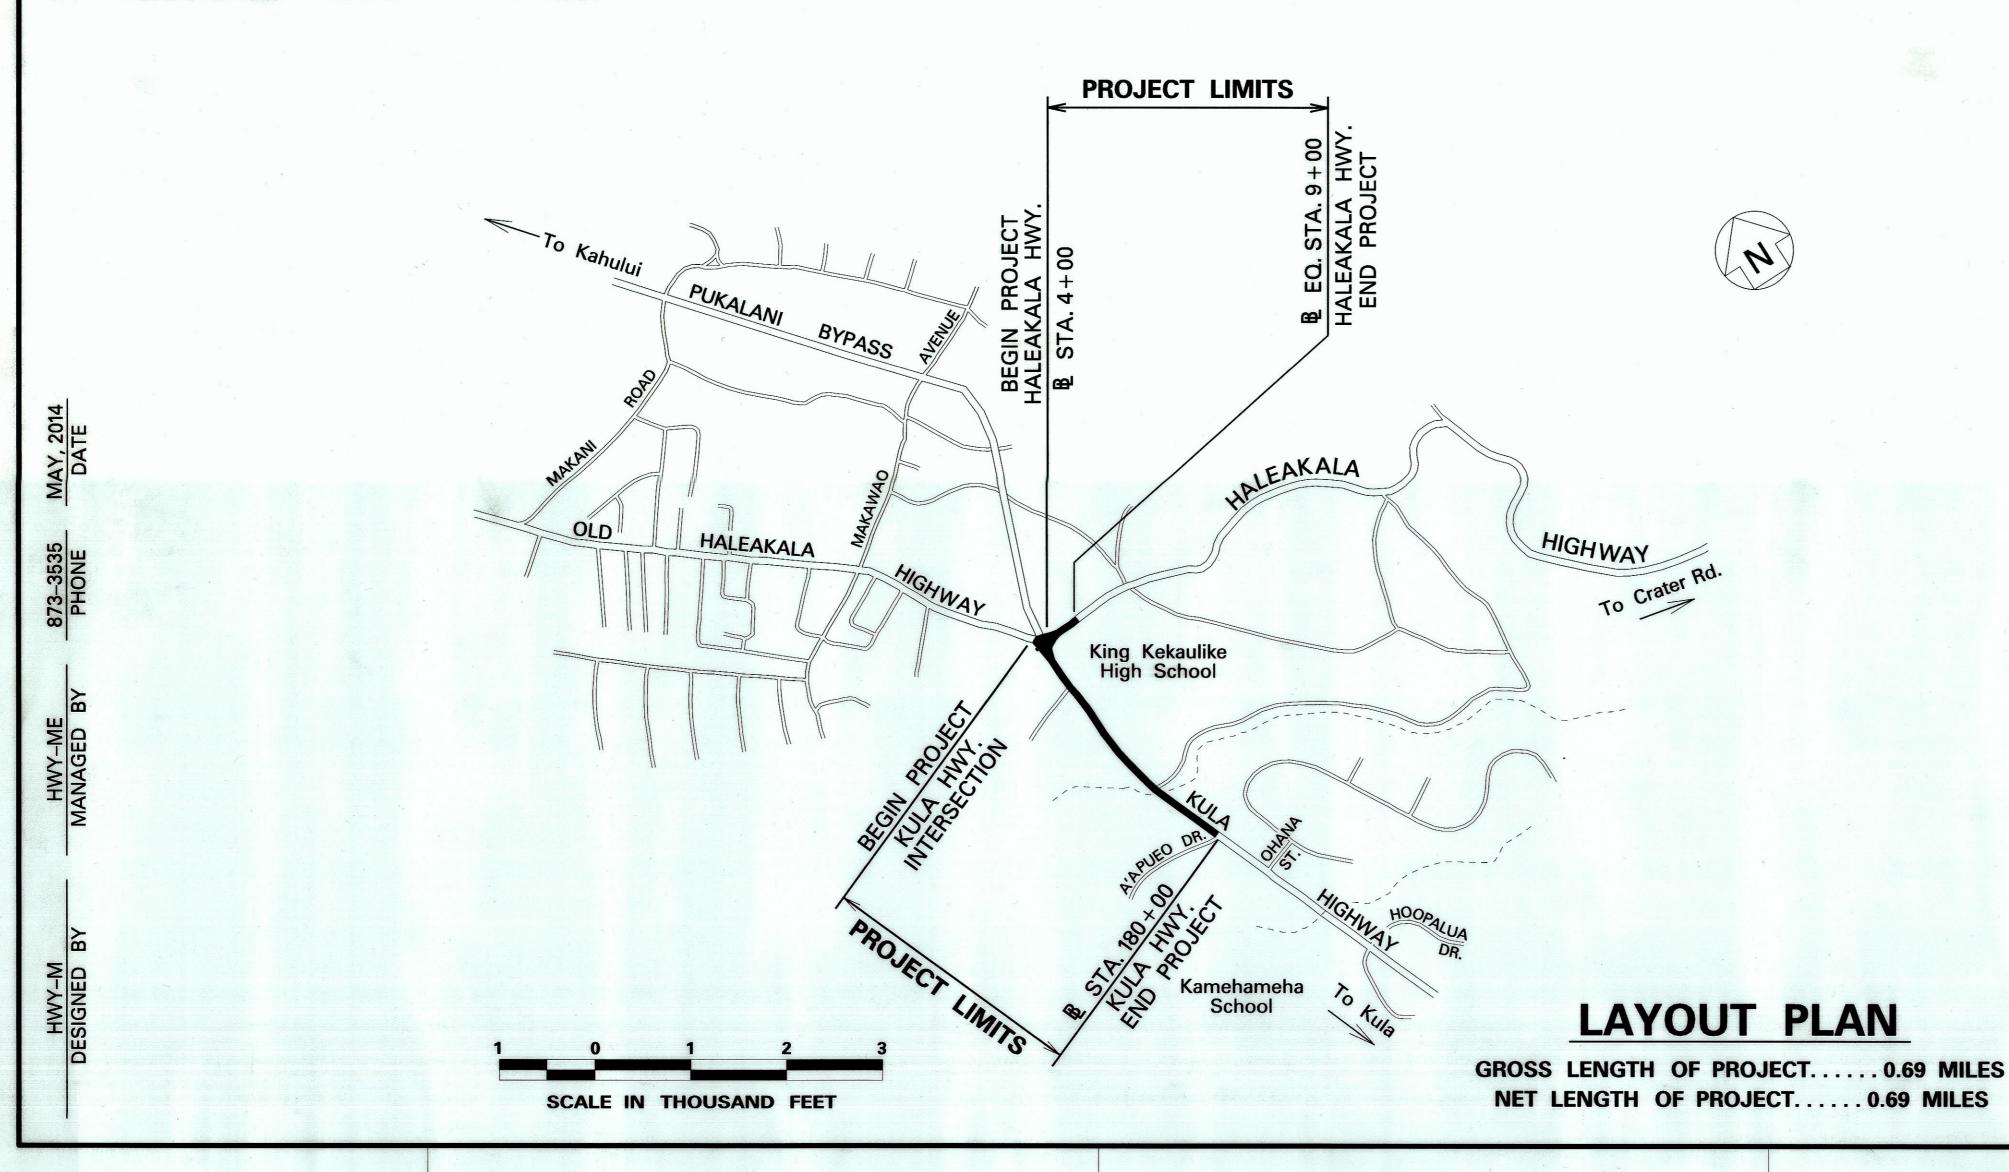

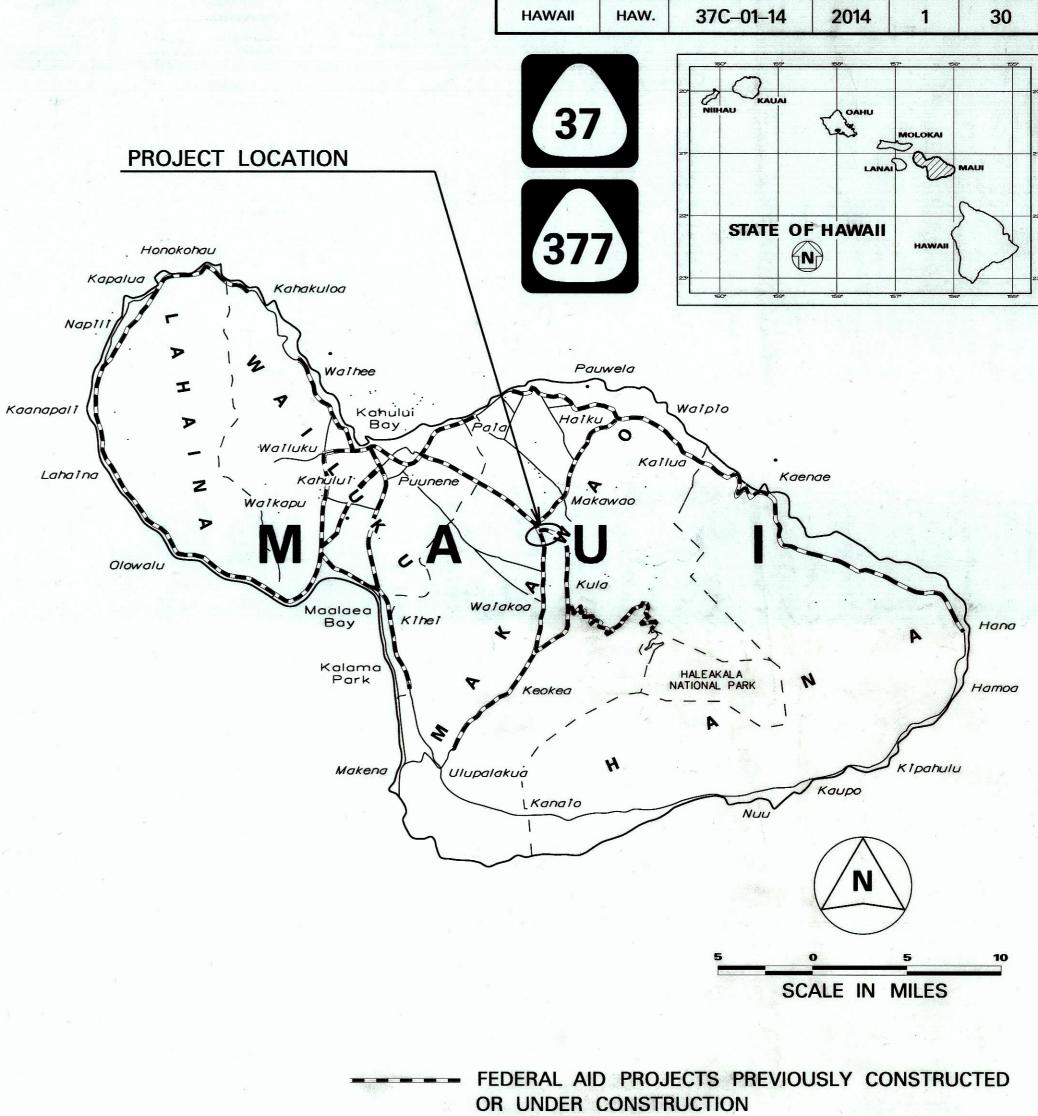

HALEAKALA HWY. MILE POST 0.00 TO MILE POST 0.27 KULA HWY. MILE POST 7.76 TO MILE POST 8.18

SPhilales 7/1/2022

DEPARTMENT OF TRANSPORTATION STATE OF HAWAII

APPROVED:

aven a. Yalusti 5/05/14 for DIR. OF TRANSPORTATION DATE