

Attachment A-5: Site Specific Best Management Practices Plan


SSBMP Notes:

1. Access to properties shall be maintained at all times. BMPs may be removed for access and immediately replaced thereafter.
2. BMPs shall be placed at least 150' downslope from work areas and no less than 1 week in advance of projected construction activities.
3. BMPs shall only be removed upon approval from HDOT.
4. Concrete slurry shall not be discharged to adjacent sites and shall be considered solid waste.

FED. ROAD DIST. NO.	STATE	FED. AID PROJ. NO.	FISCAL YEAR	SHEET NO.	TOTAL SHEETS
HAWAII	HAW.	NH-037-1(028)	2022	0	0

BEGIN PROJECT
Fed.Aid Proj. No. NH-037-1(028)
@ Sta. 47+00

TRUE NORTH
SCALE: 1" = 40'

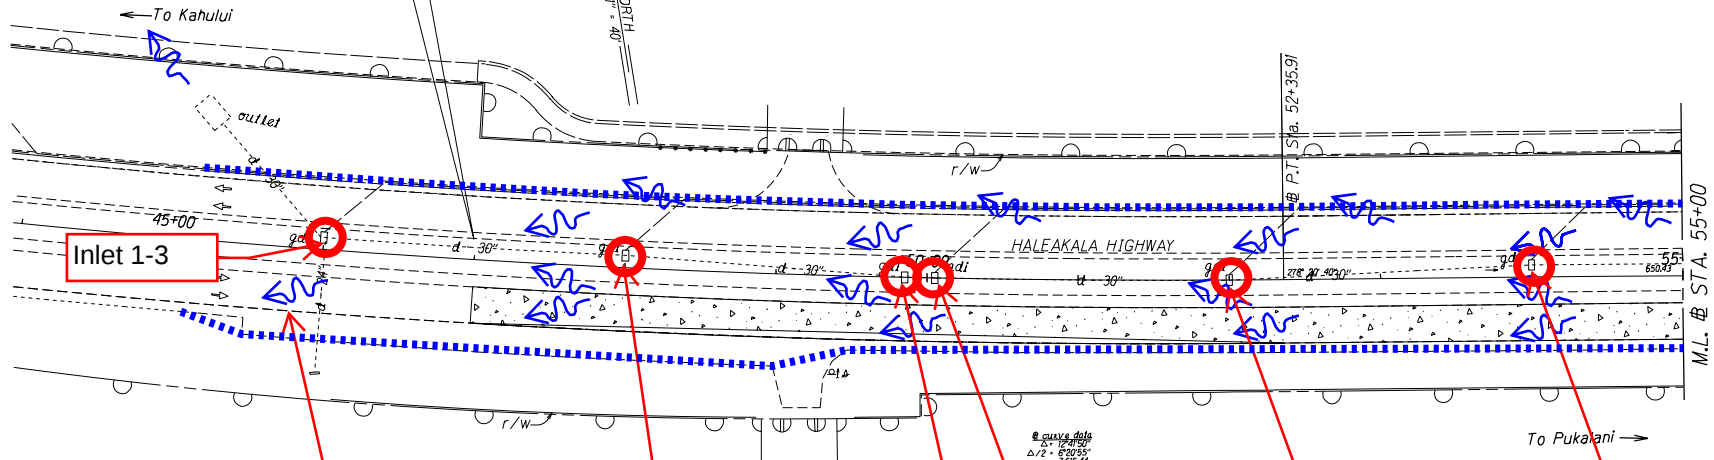

Inlet 1-3

To Inlet 1-1

Inlet 1-4

Inlet 1-5

Inlet 1-6

Inlet 1-7

Inlet 1-8

Legend

- Flow Direction (Surface)
- Inlet Protection
- Perimeter Control

Attachment A-5

Site-Specific BMP Plan

Haleakala Highway Reconstruction


North Firebreak Road to

Old Haleakala Highway

Federal Aid Project No. NH-037-1(028)

DESIGNED BY	DATE
DRAWN BY	
CHECKED BY	
APPROVED BY	
DATE	5/16

FED. ROAD DIST. NO.	STATE	FED. AID PROJ. NO.	FISCAL YEAR	SHEET NO.	TOTAL SHEETS
HAWAII	HAW.	NH-037-1(028)	2022	0	0

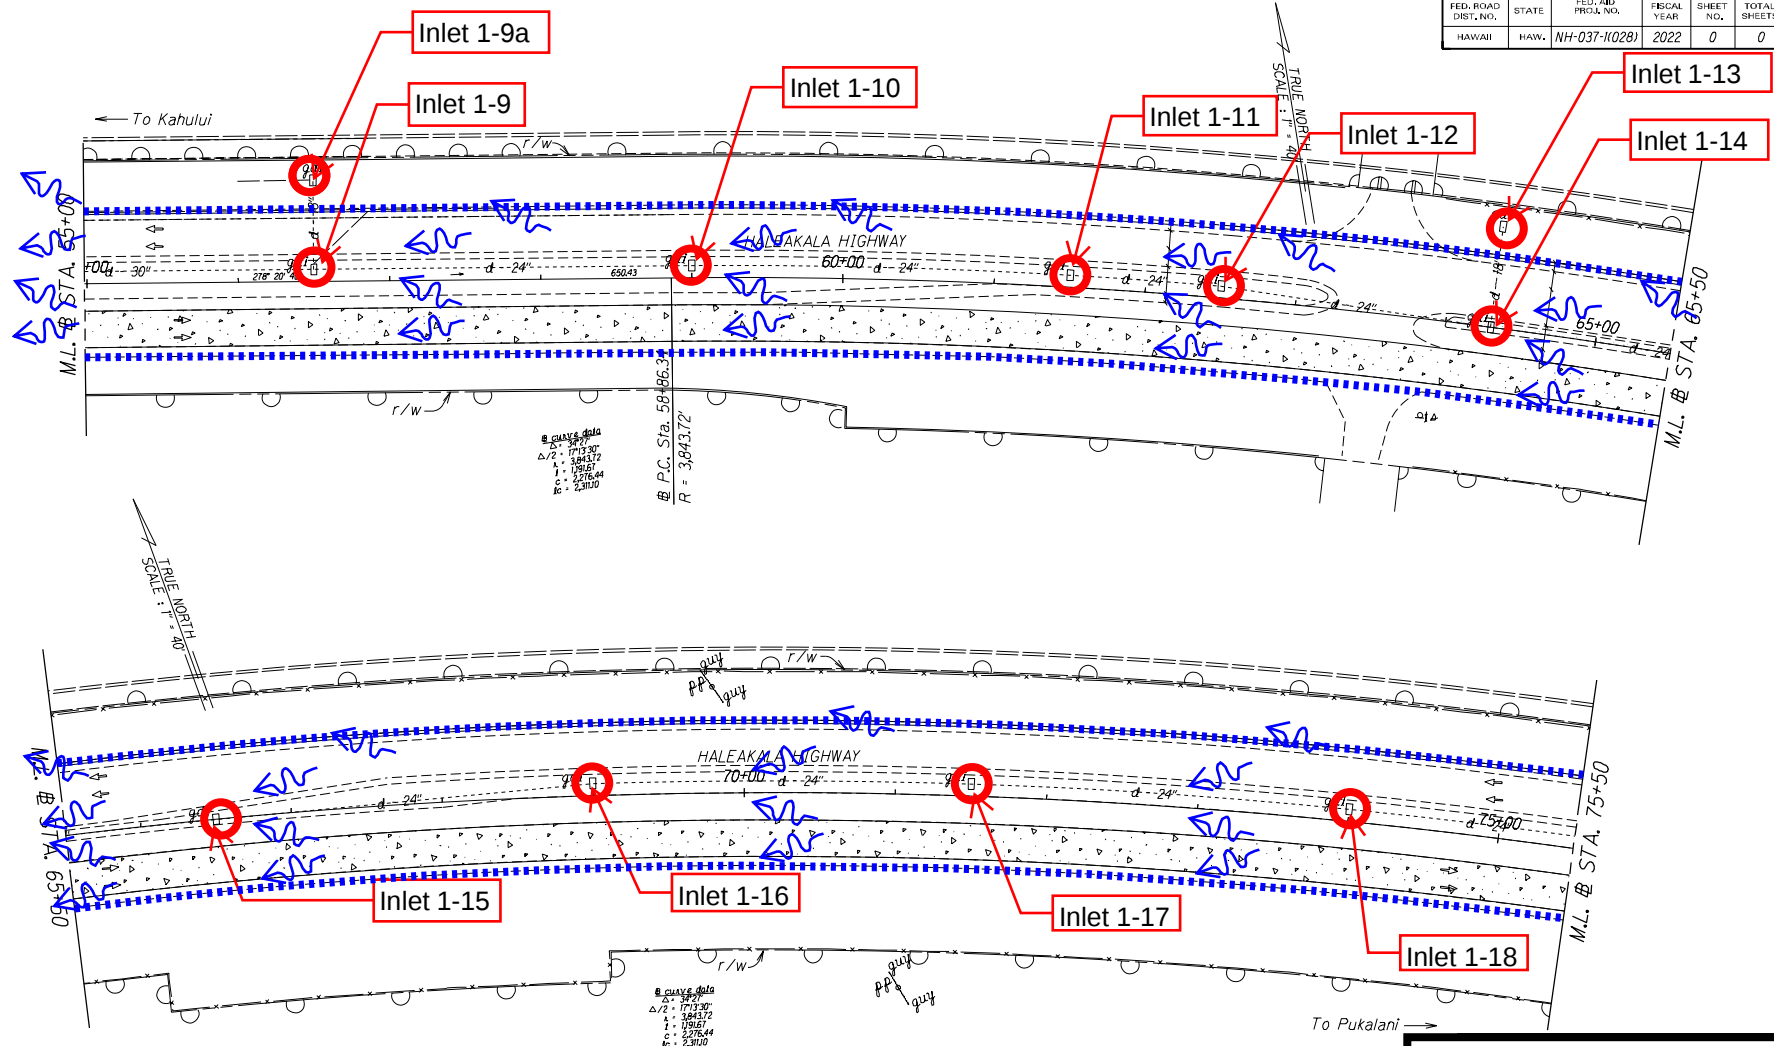


Legend

- Flow Direction (Surface)
- Inlet Protection
- Perimeter Control

Attachment A-5
Site-Specific BMP Plan
Haleakala Highway Reconstruction
North Firebreak Road to
Old Haleakala Highway
Federal Aid Project No. NH-037-1(028)

FED. ROAD DIST. NO.	STATE	FED. AID PROJ. NO.	FISCAL YEAR	SHEET NO.	TOTAL SHEETS
HAWAII	HAW.	NH-037-1(028)	2022	0	0

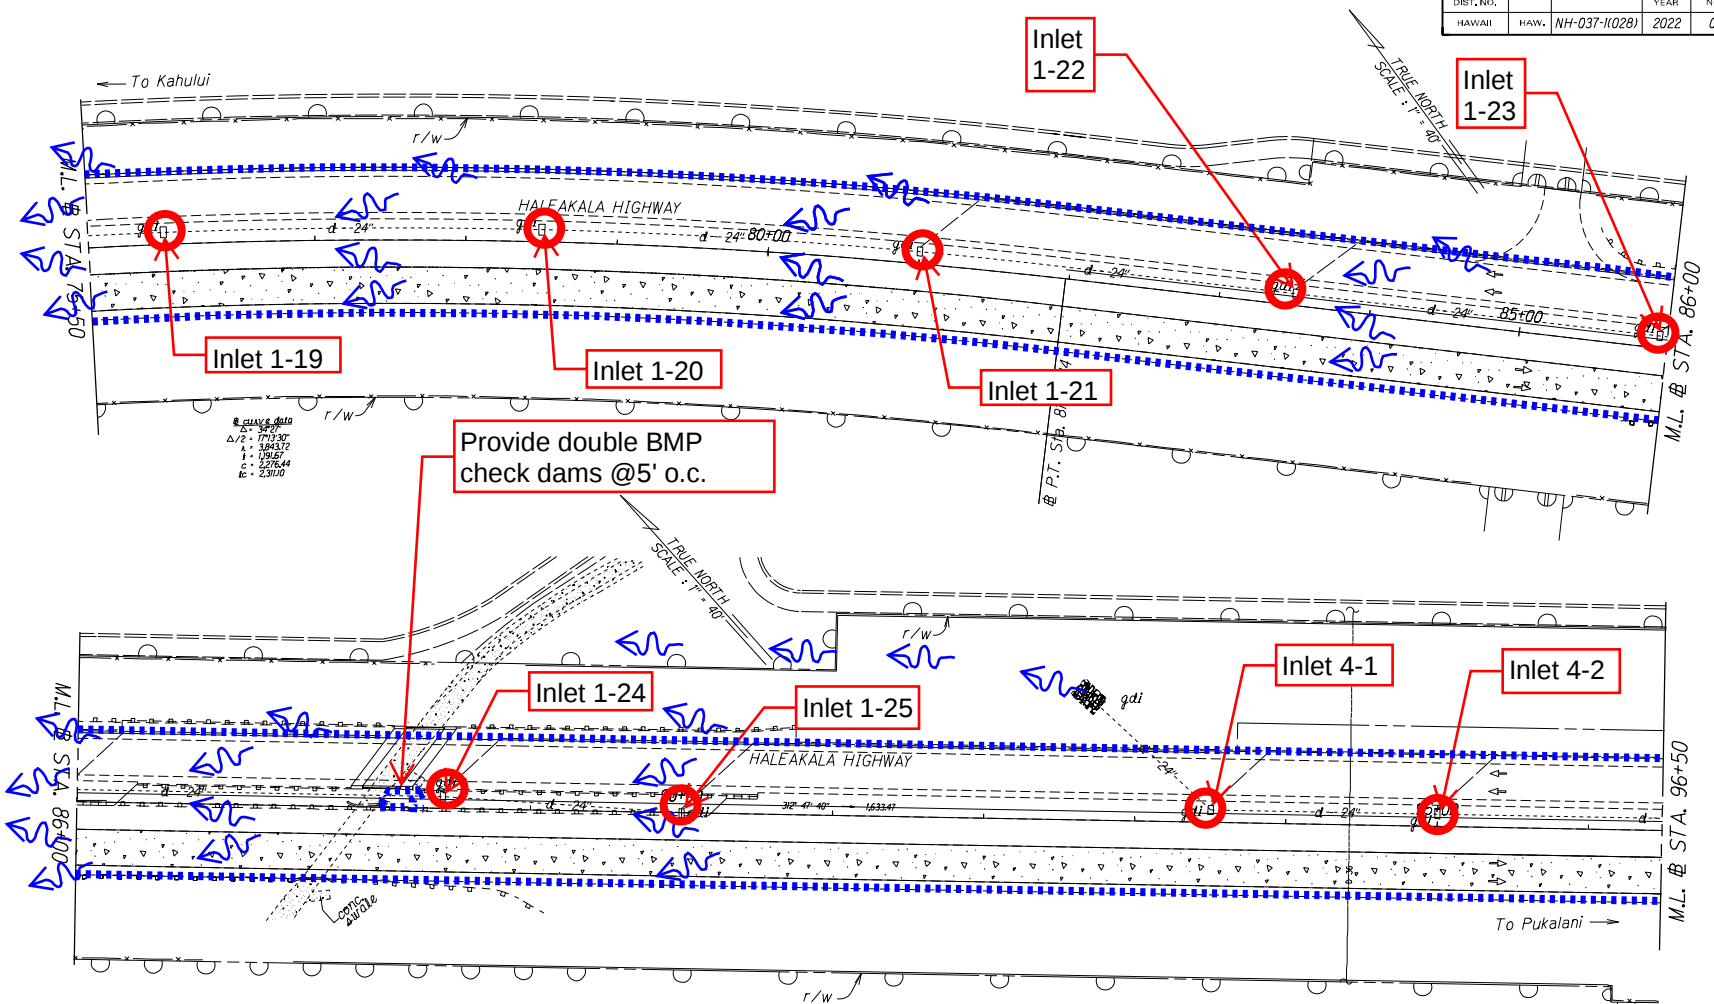


Legend

- Flow Direction (Surface)
- Inlet Protection
- Perimeter Control

Attachment A-5
Site-Specific BMP Plan
Haleakala Highway Reconstruction
North Firebreak Road to
Old Haleakala Highway
Federal Aid Project No. NH-037-1(028)

DESIGNED BY	DATE
DRAWN BY	
CHECKED BY	
APPROVED BY	
DATE	

FED. ROAD DIST. NO.	STATE	FED. AID PROJ. NO.	FISCAL YEAR	SHEET NO.	TOTAL SHEETS
HAWAII	HAW.	NH-037-1(028)	2022	0	0

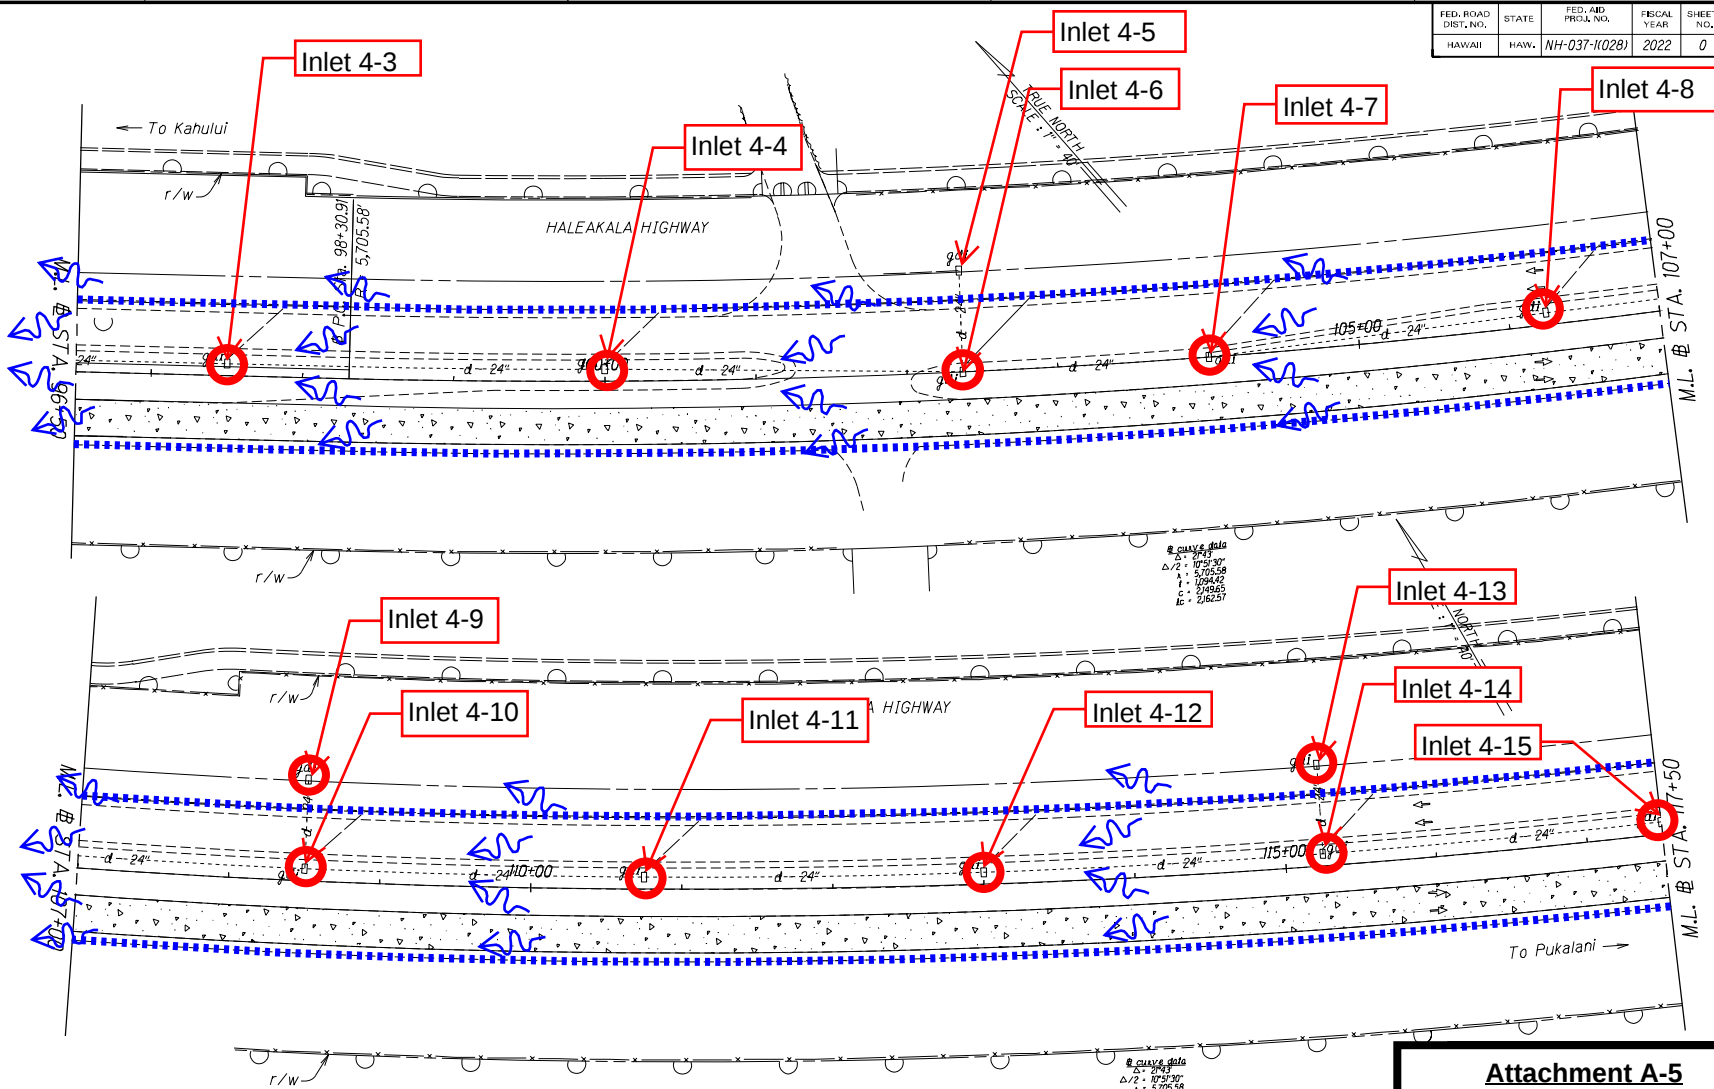


Legend

- Flow Direction (Surface)
- Inlet Protection
- Perimeter Control

Attachment A-5
Site-Specific BMP Plan
Haleakala Highway Reconstruction
North Firebreak Road to
Old Haleakala Highway
Federal Aid Project No. NH-037-1(028)

FED. ROAD DIST. NO.	STATE	FED. AID PROJ. NO.	FISCAL YEAR	SHEET NO.	TOTAL SHEETS
HAWAII	HAW.	NH-037-1(028)	2022	0	0

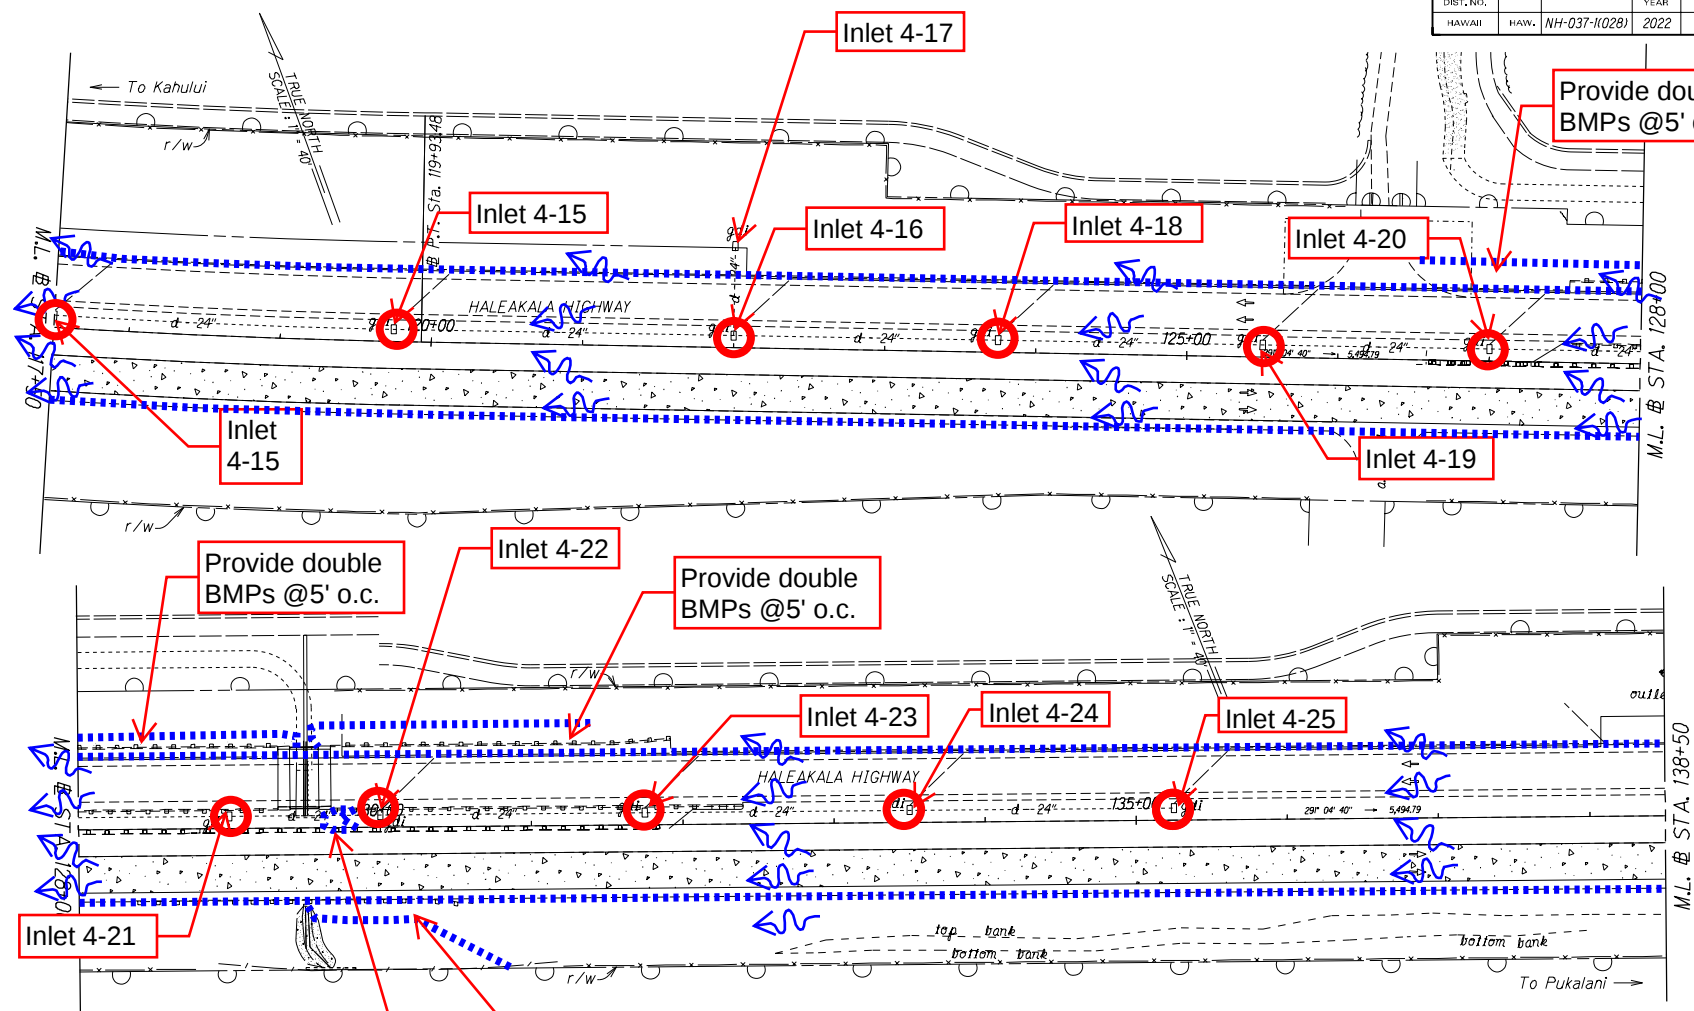

Legend


- Flow Direction (Surface)
- Inlet Protection
- Perimeter Control

Provide double BMPs @5' o.c.

Provide double BMP check dams @5' o.c.

Attachment A-5
Site-Specific BMP Plan
Haleakala Highway Reconstruction
North Firebreak Road to
Old Haleakala Highway
Federal Aid Project No. NH-037-1(028)

FED. ROAD DIST. NO.	STATE	FED. AID PROJ. NO.	FISCAL YEAR	SHEET NO.	TOTAL SHEETS
HAWAII	HAW.	NH-037-1(028)	2022	0	0

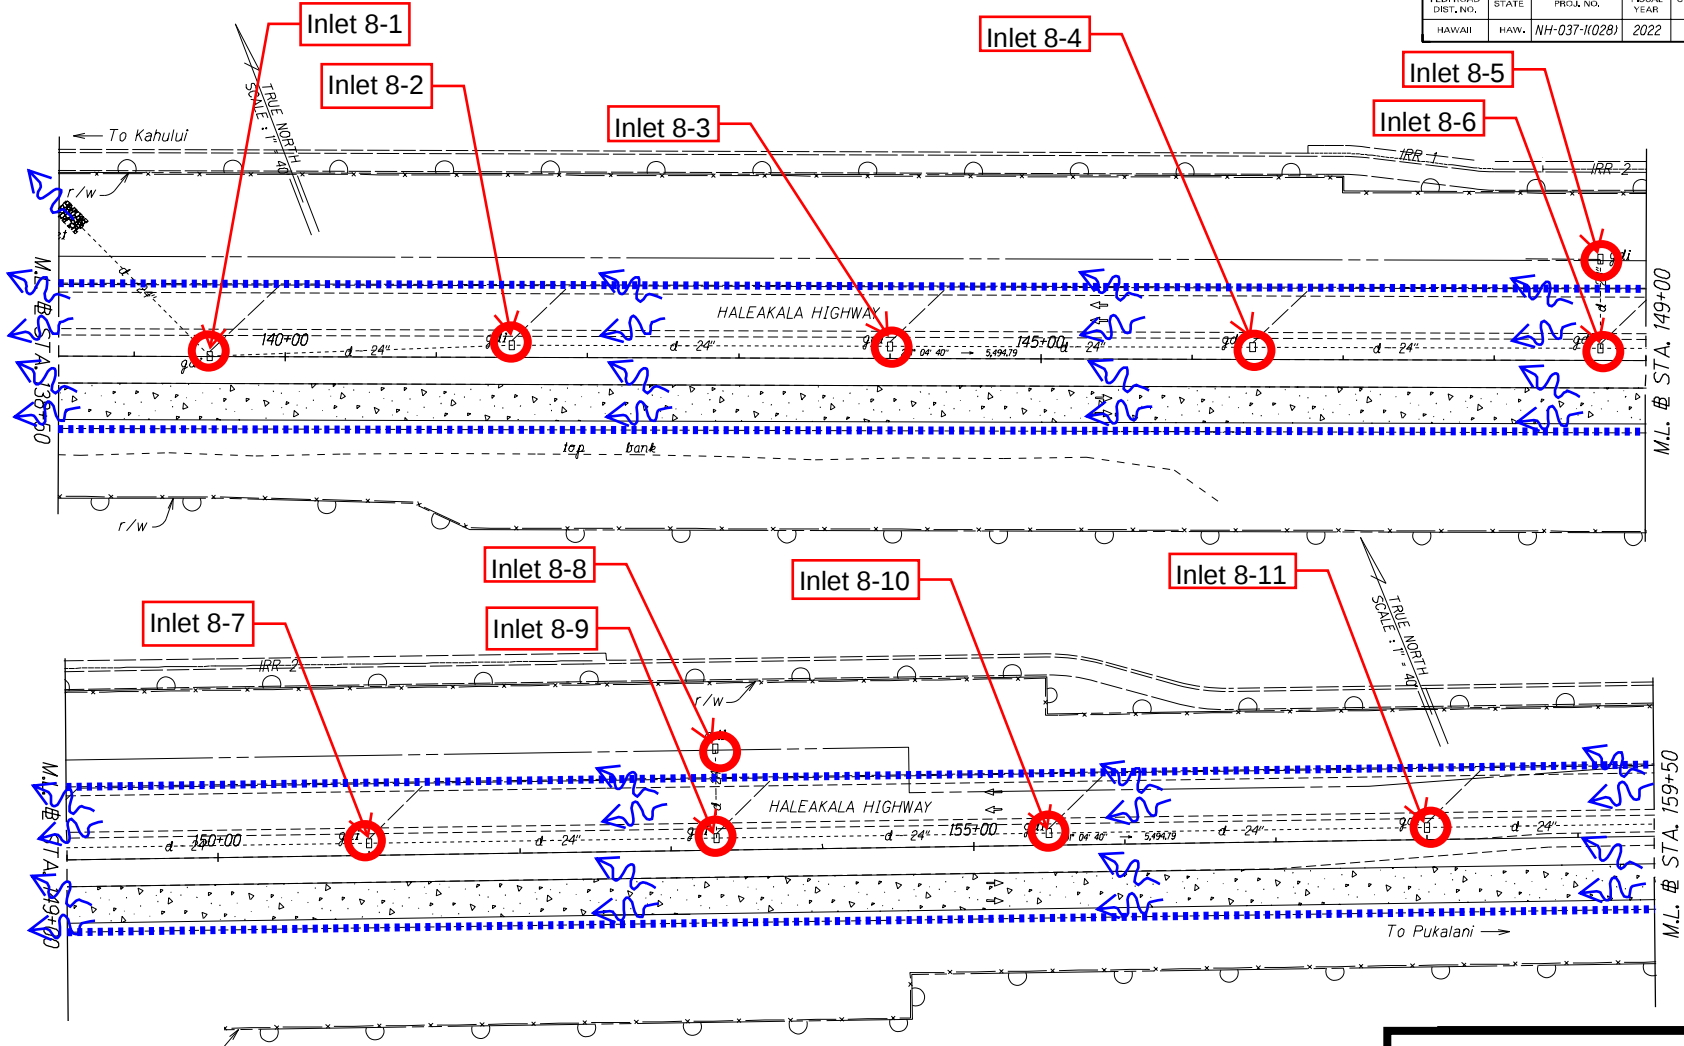


Legend

- Flow Direction (Surface)
- Inlet Protection
- Perimeter Control


Attachment A-5
Site-Specific BMP Plan
Haleakala Highway Reconstruction
North Firebreak Road to
Old Haleakala Highway
Federal Aid Project No. NH-037-1(028)

FED. ROAD DIST. NO.	STATE	FED. AID PROJ. NO.	FISCAL YEAR	SHEET NO.	TOTAL SHEETS
HAWAII	HAW.	NH-037-1(028)	2022	0	0

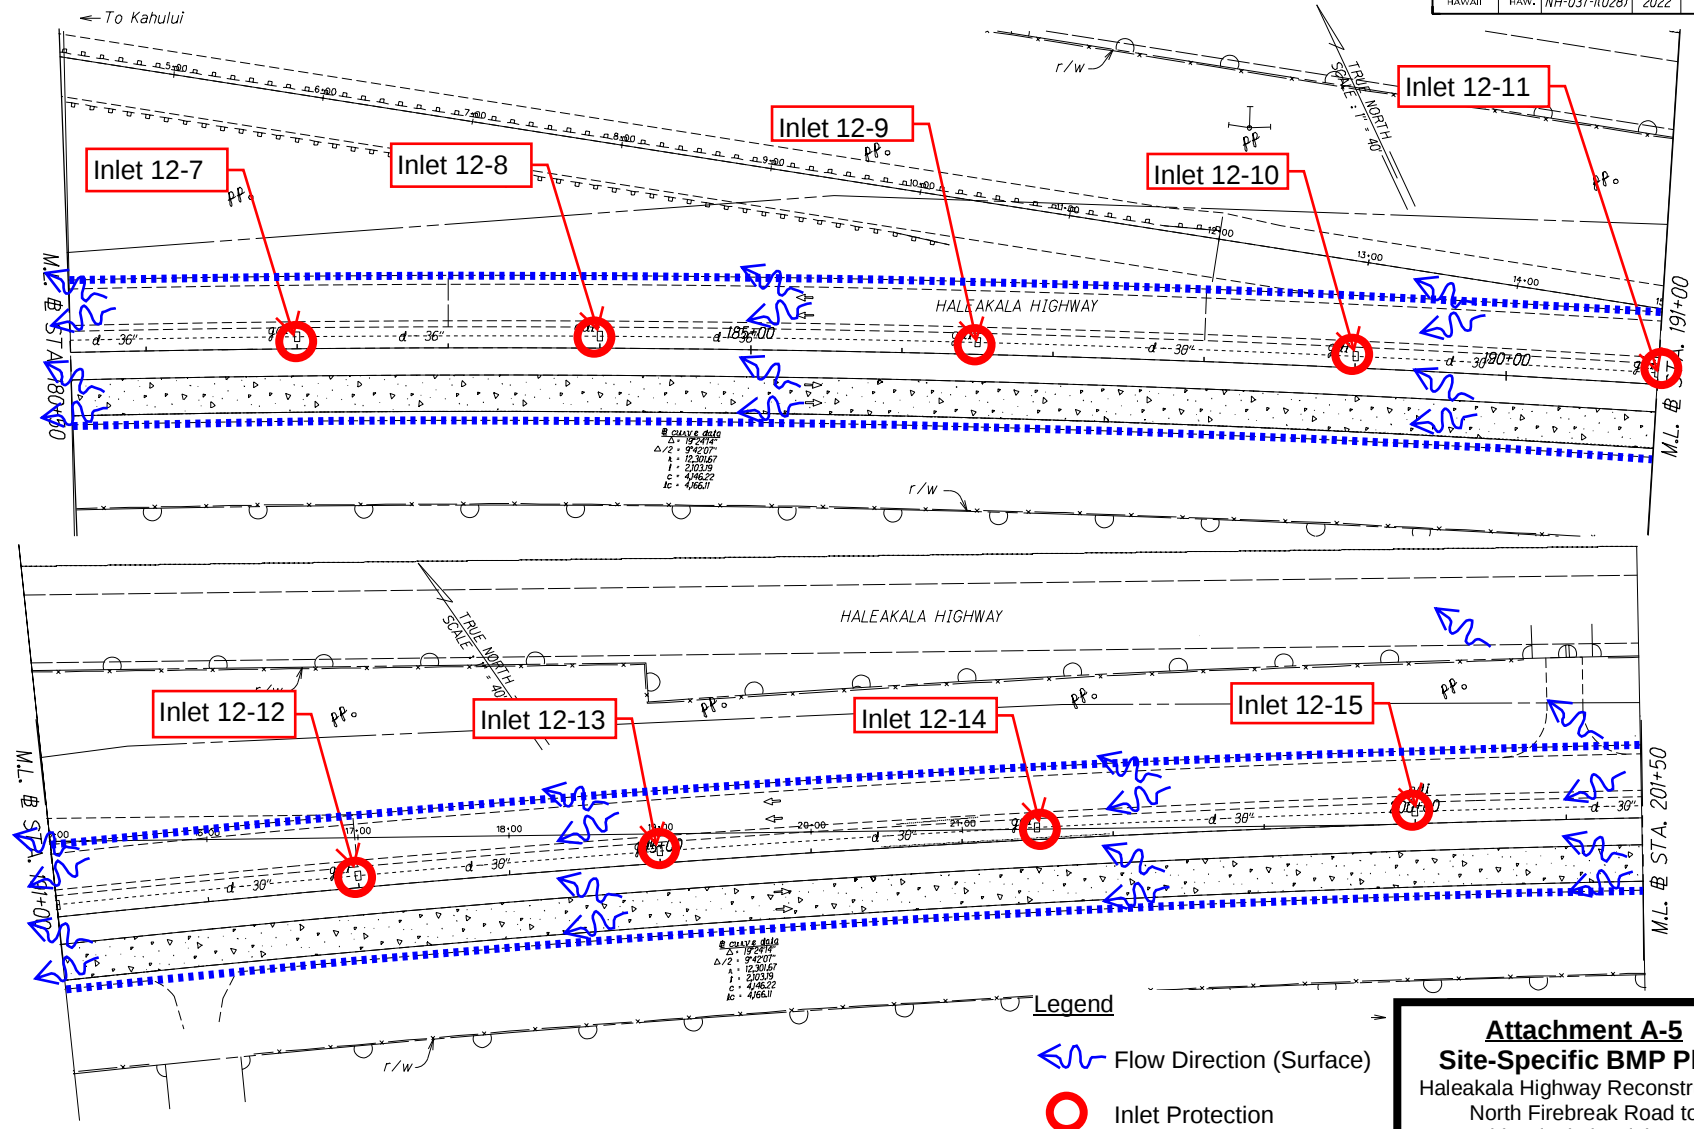


Attachment A-5
Site-Specific BMP Plan
 Haleakala Highway Reconstruction
 North Firebreak Road to
 Old Haleakala Highway
 Federal Aid Project No. NH-037-1(028)


FED. ROAD DIST. NO.	STATE	FED. AID PROJ. NO.	FISCAL YEAR	SHEET NO.	TOTAL SHEETS
HAWAII	HAW.	NH-037-1(028)	2022	0	0

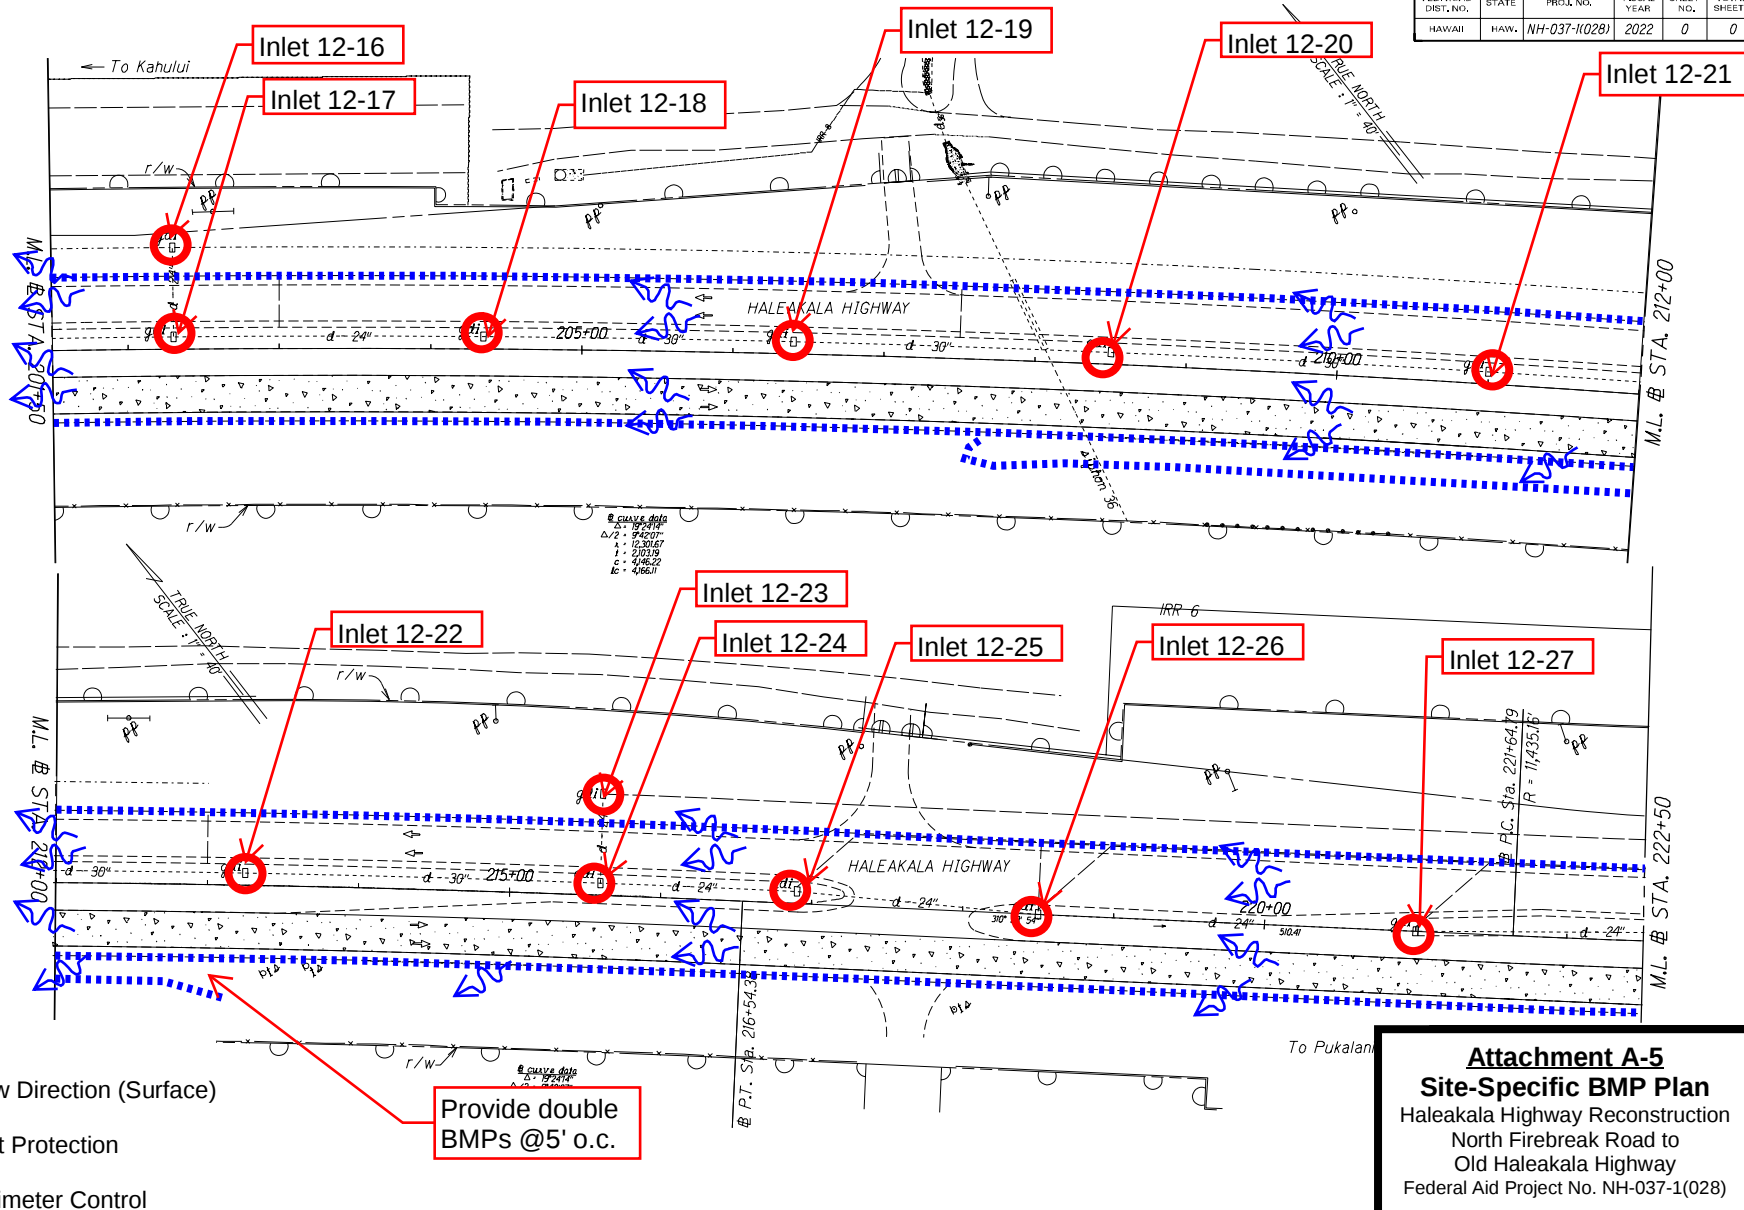

FED. ROAD DIST. NO.	STATE	FED. AID PROJ. NO.	FISCAL YEAR	SHEET NO.	TOTAL SHEETS
HAWAII	HAW.	NH-037-1(028)	2022	0	0

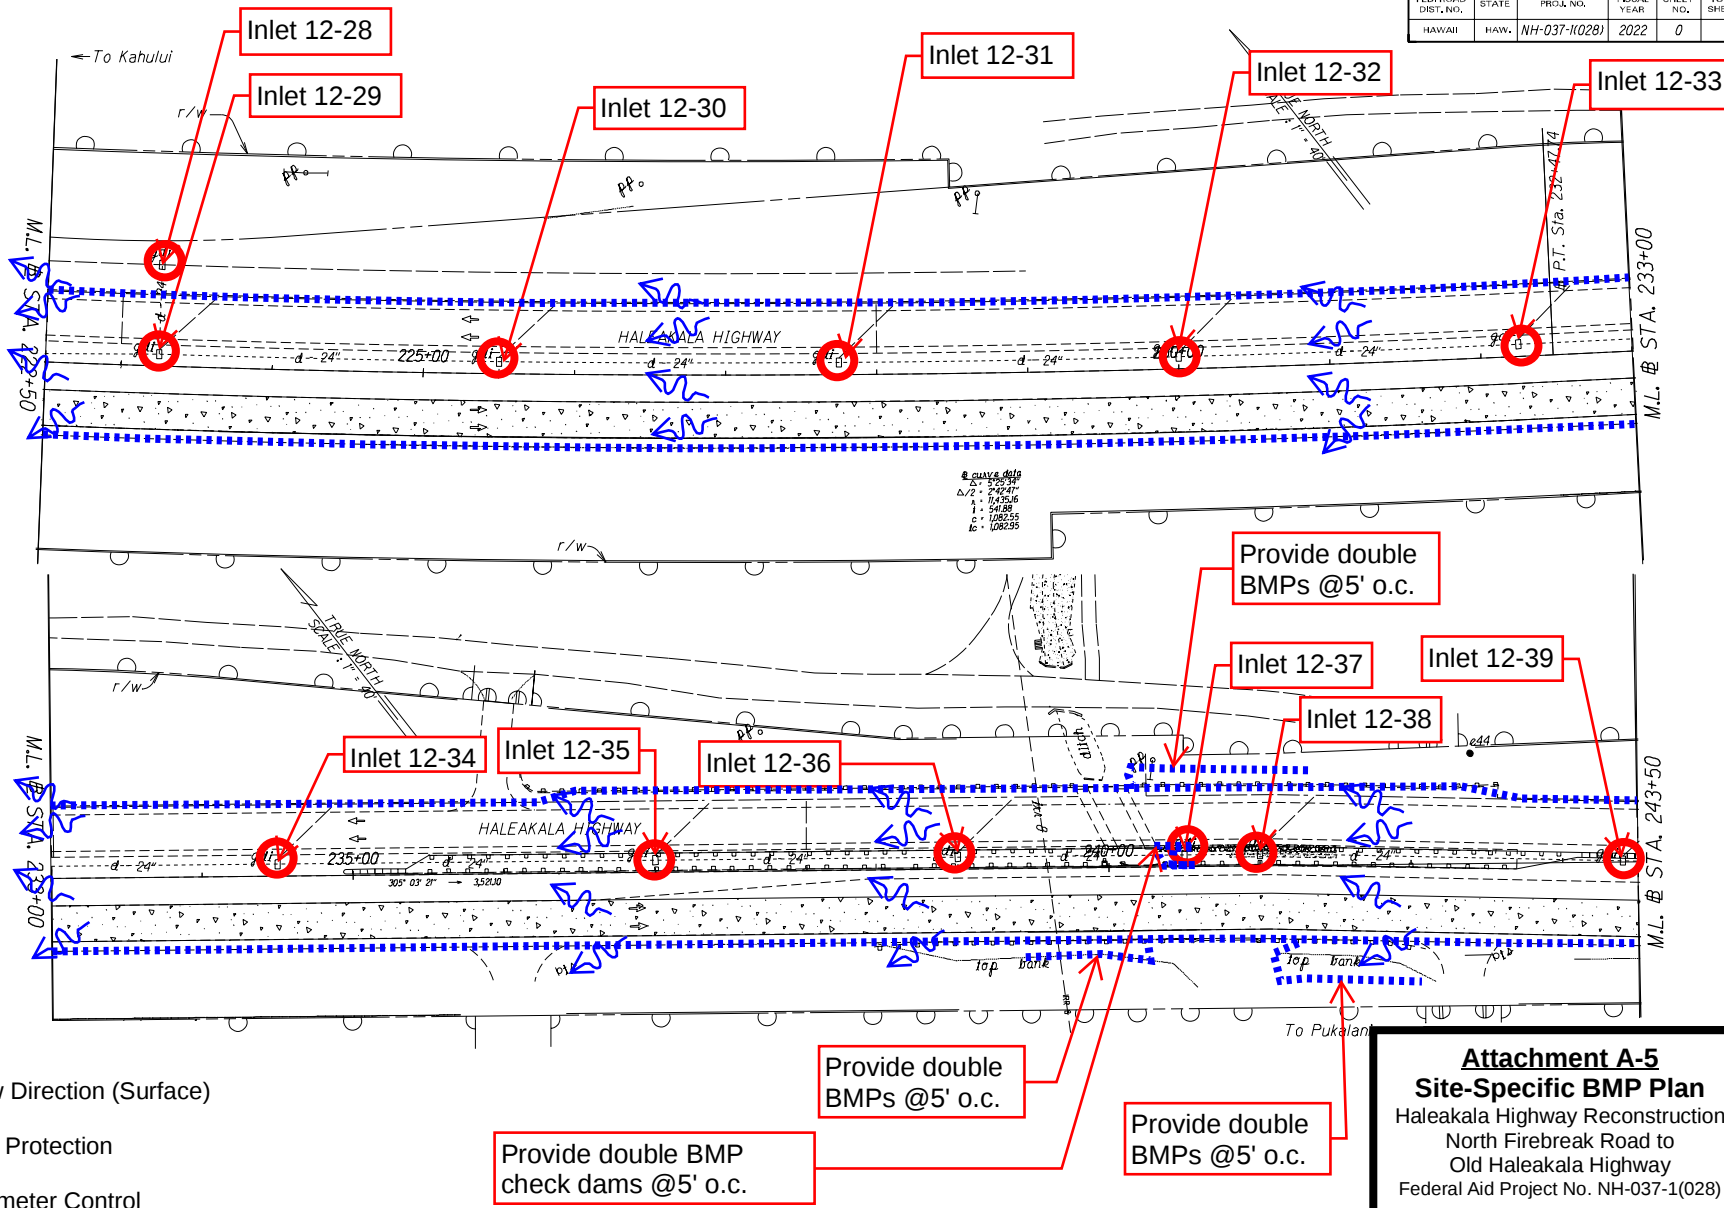

FED. ROAD DIST. NO.	STATE	FED. AID PROJ. NO.	FISCAL YEAR	SHEET NO.	TOTAL SHEETS
HAWAII	HAW.	NH-037-1(028)	2022	0	0

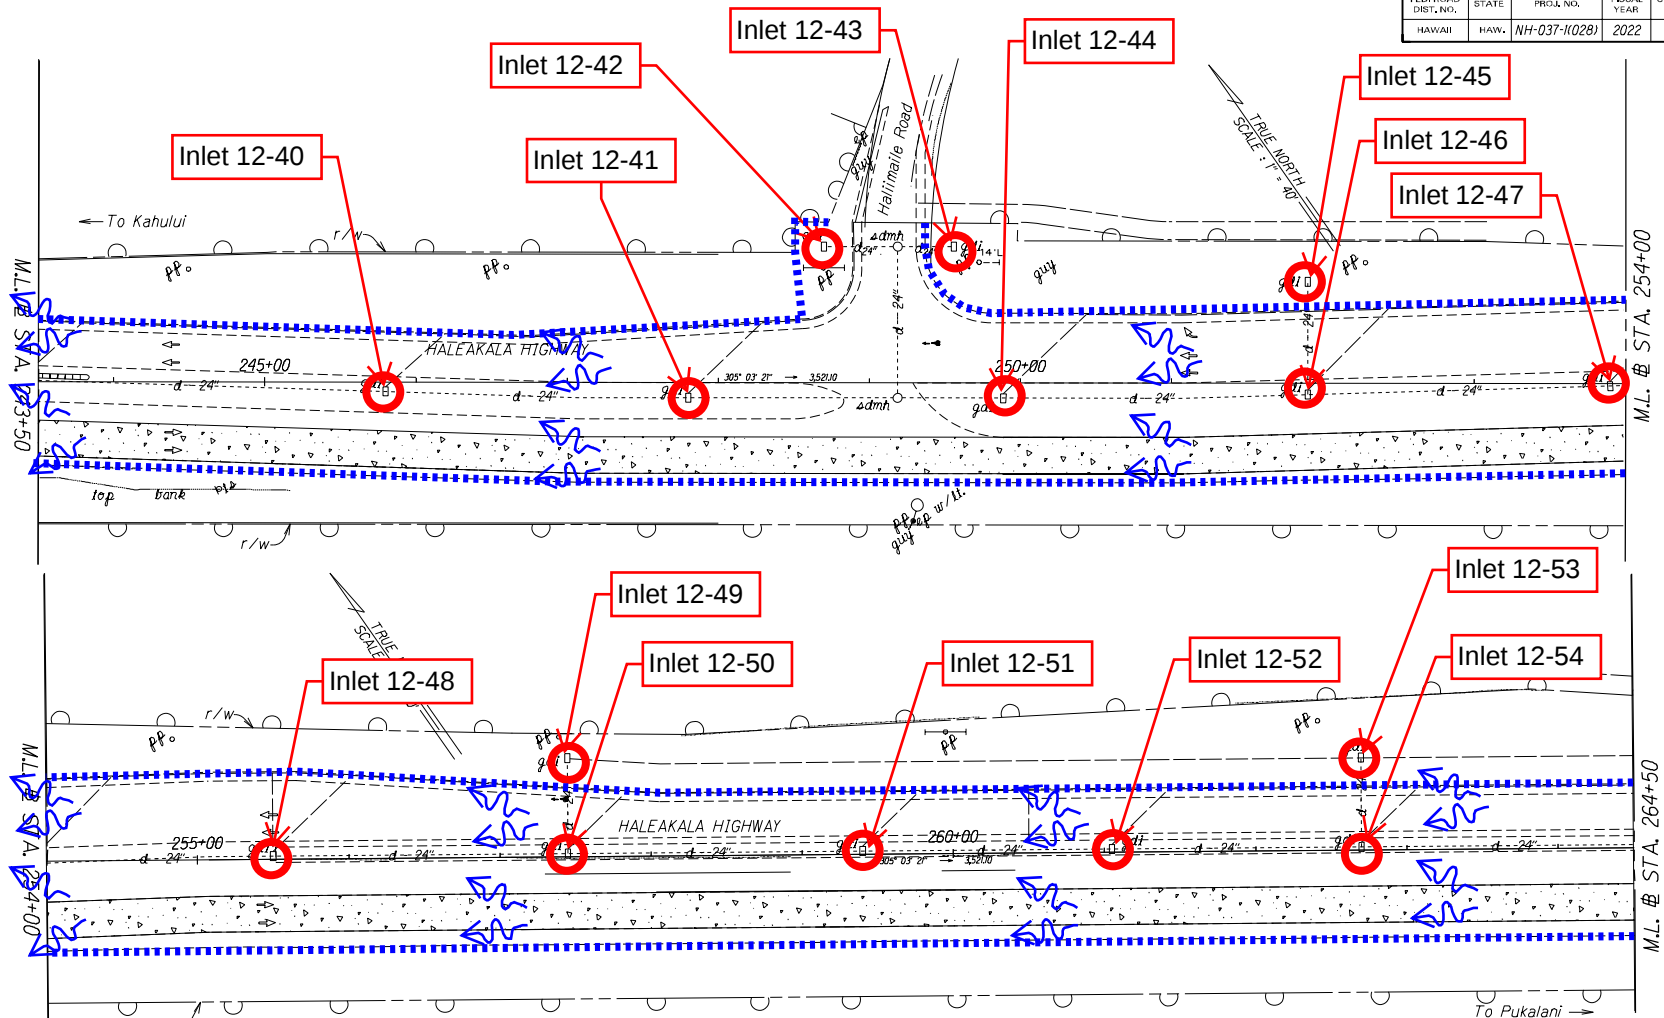


Legend

-  Flow Direction (Surface)
-  Inlet Protection
-  Perimeter Control

Attachment A-5
Site-Specific BMP Plan
 Haleakala Highway Reconstruction
 North Firebreak Road to
 Old Haleakala Highway
 Federal Aid Project No. NH-037-1(028)

DESIGNED BY	DATE
DRAWN BY	
CHECKED BY	
APPROVED BY	
DATE	

FED. ROAD DIST. NO.	STATE	FED. AID PROJ. NO.	FISCAL YEAR	SHEET NO.	TOTAL SHEETS
HAWAII	HAW.	NH-037-1(028)	2022	0	0

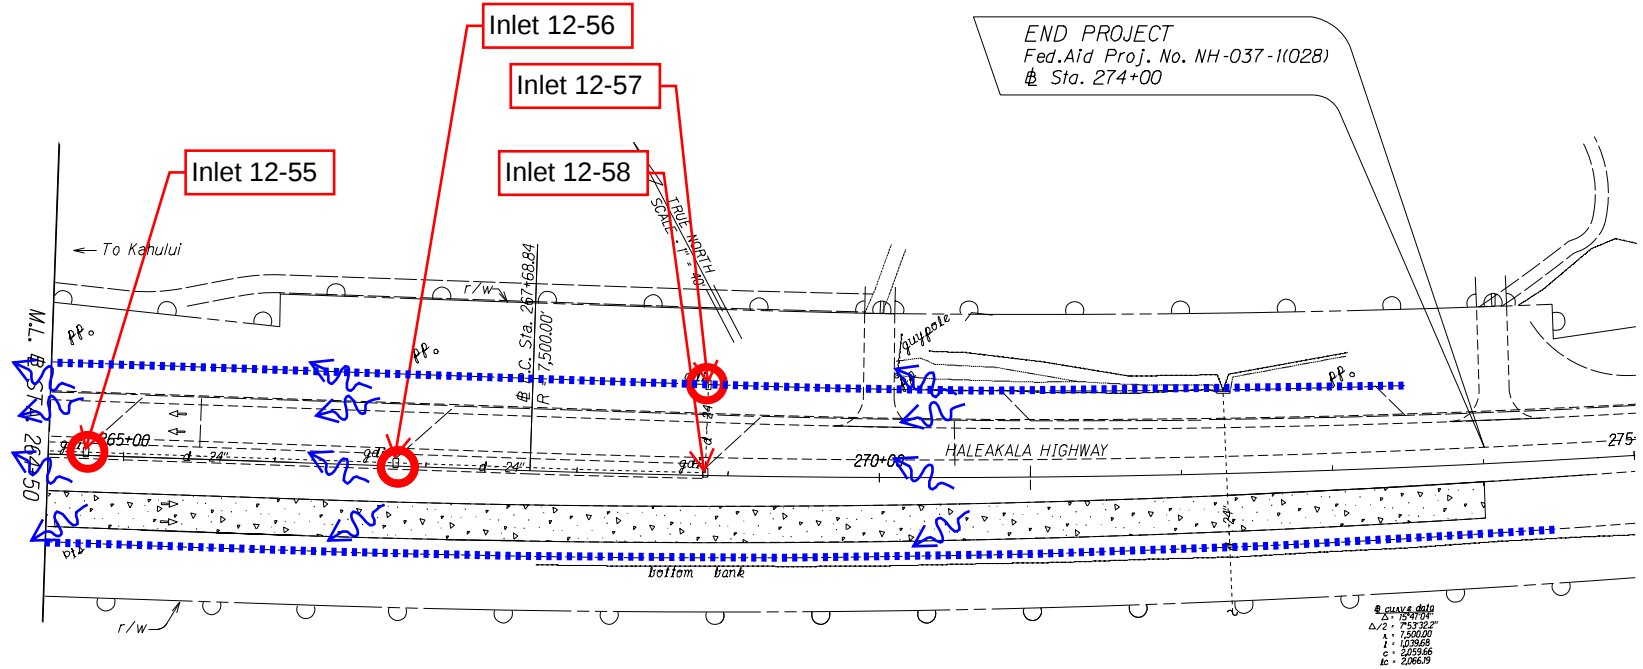

- Legend**
- Flow Direction (Surface)
 - Inlet Protection
 - Perimeter Control

Attachment A-5
Site-Specific BMP Plan
Haleakala Highway Reconstruction
North Firebreak Road to
Old Haleakala Highway
Federal Aid Project No. NH-037-1(028)