


DATE	BY	FINAL SURVEY PLOTTED	NOTE BOOK NO.

Revised sections in accordance with Work Order No. 1, Oct. 23, 33 BK; A.L.B.

DATE	BY	ORIGINAL SURVEY PLOTTED	NOTE BOOK NO.

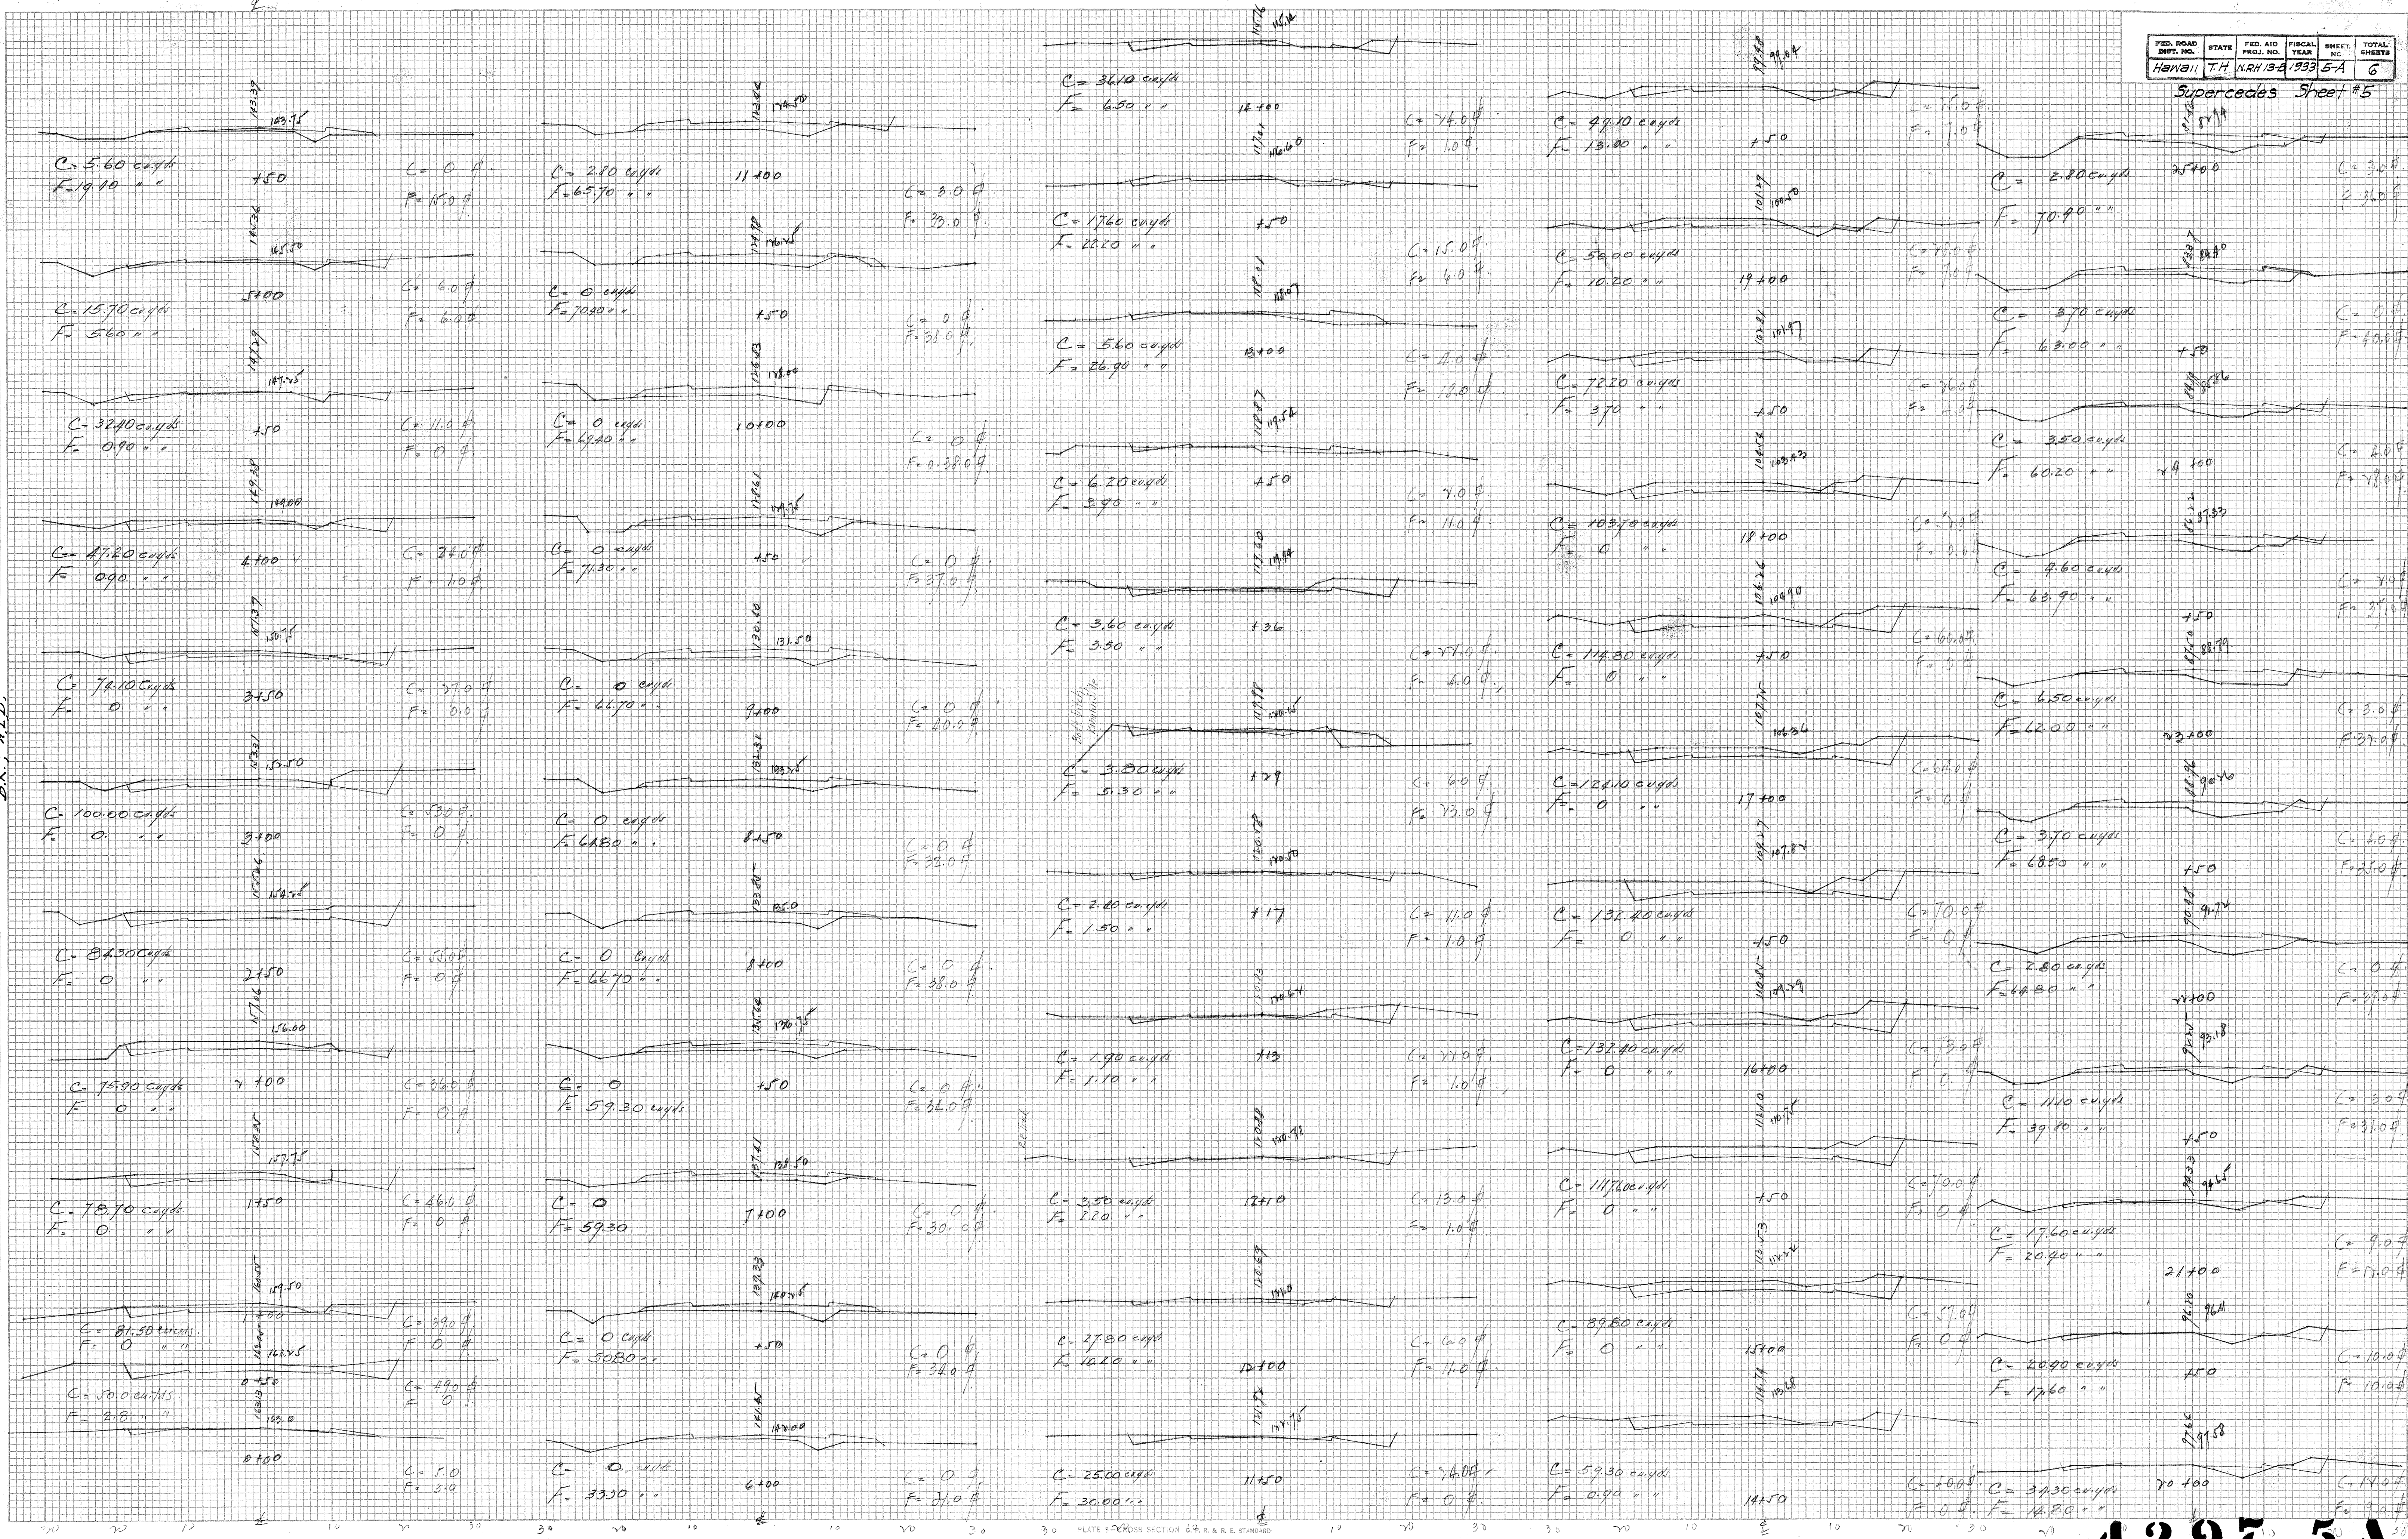

4297.5 A

4297.5 A

Revised sections, in accordance with Work Order No. 1, Oct. 23, '33


DK., A.L.B.

DATE	BY	SURVEYED	NOTED	AREAS CHECKED
10/23/33	A.L.B.	10/23/33	10/23/33	10/23/33
NO.	NO.	NO.	NO.	NO.

DATE	BY	SURVEYED	NOTED	AREAS CHECKED
10/23/33	A.L.B.	10/23/33	10/23/33	10/23/33
NO.	NO.	NO.	NO.	NO.

FED. ROAD DIST. NO.	STATE	FED. AID PROJ. NO.	FISCAL YEAR	SHEET NO.	TOTAL SHEETS
HAWAII	T.H.	NRH13-B	1933	6-A	6

Supercedes Sheet #6

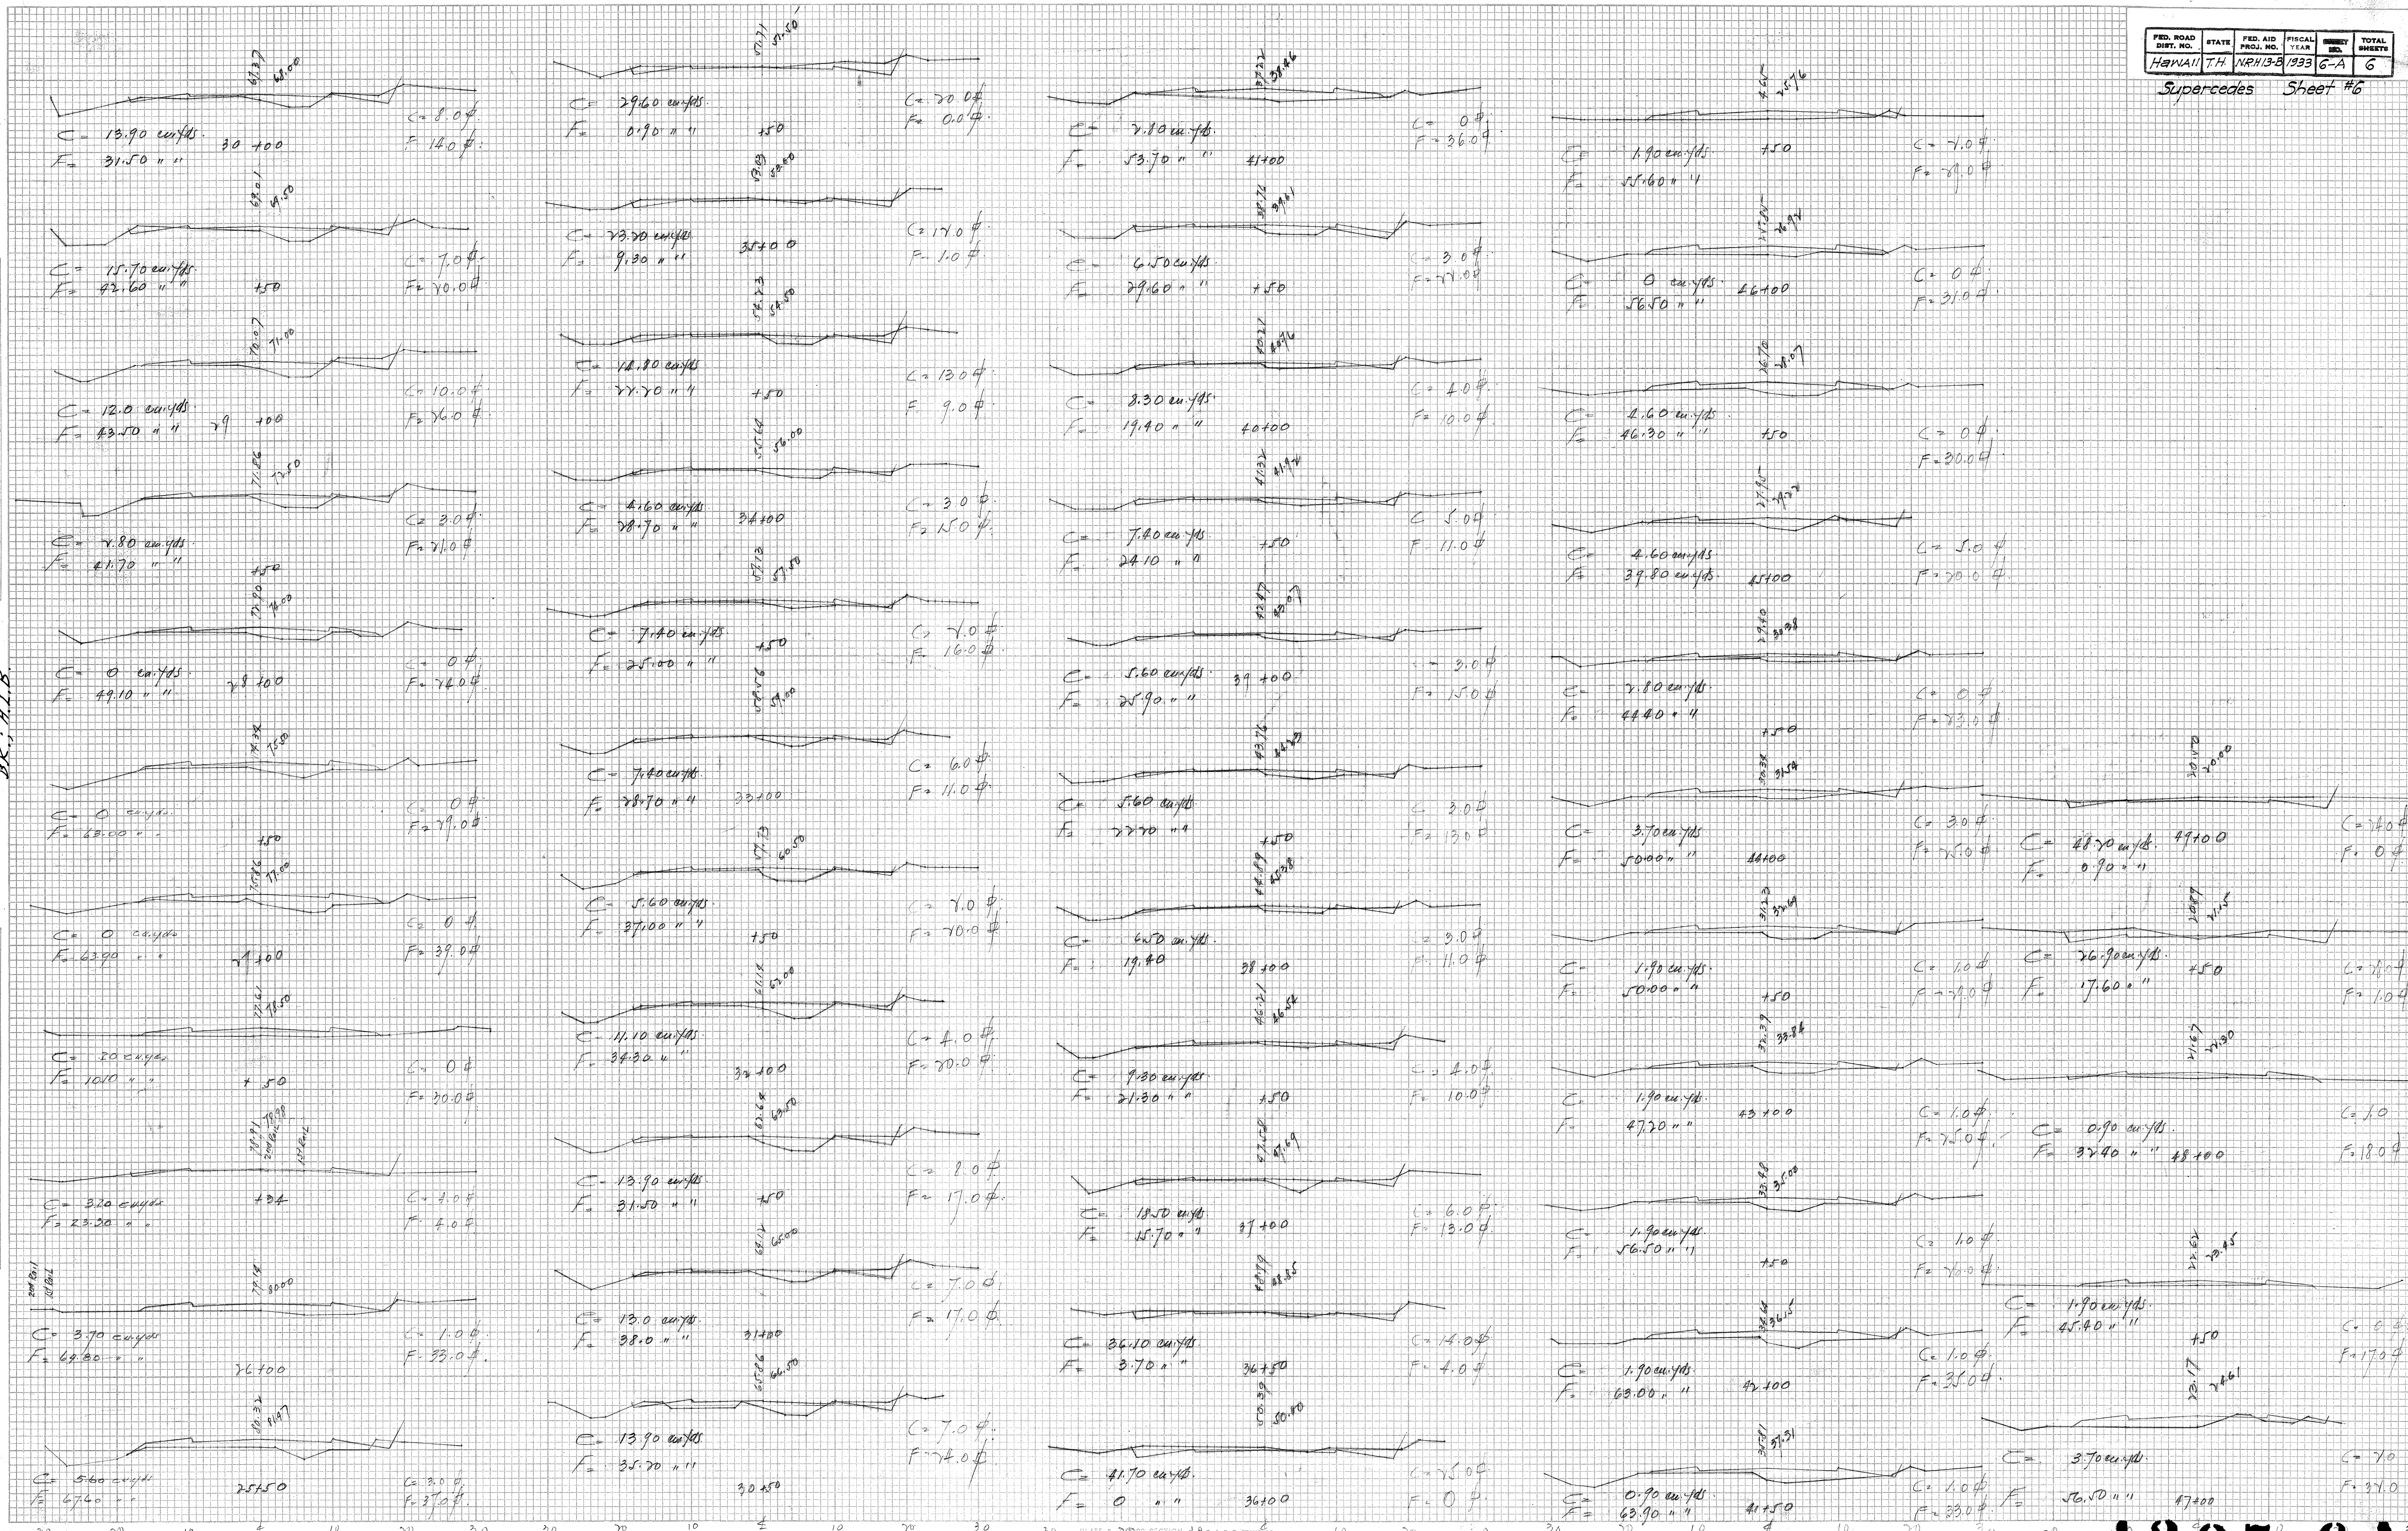

4297.6 A

ORIGINAL SURVEY PLOTTED
 DATE: _____
 BY: _____
 CHECKED: _____
 DATE: _____
 BY: _____
 CHECKED: _____

ORIGINAL SURVEY PLOTTED
 DATE: _____
 BY: _____
 CHECKED: _____
 DATE: _____
 BY: _____
 CHECKED: _____

