





DETAIL OF JUNCTION STA. 0+00
Scale 1"=30'

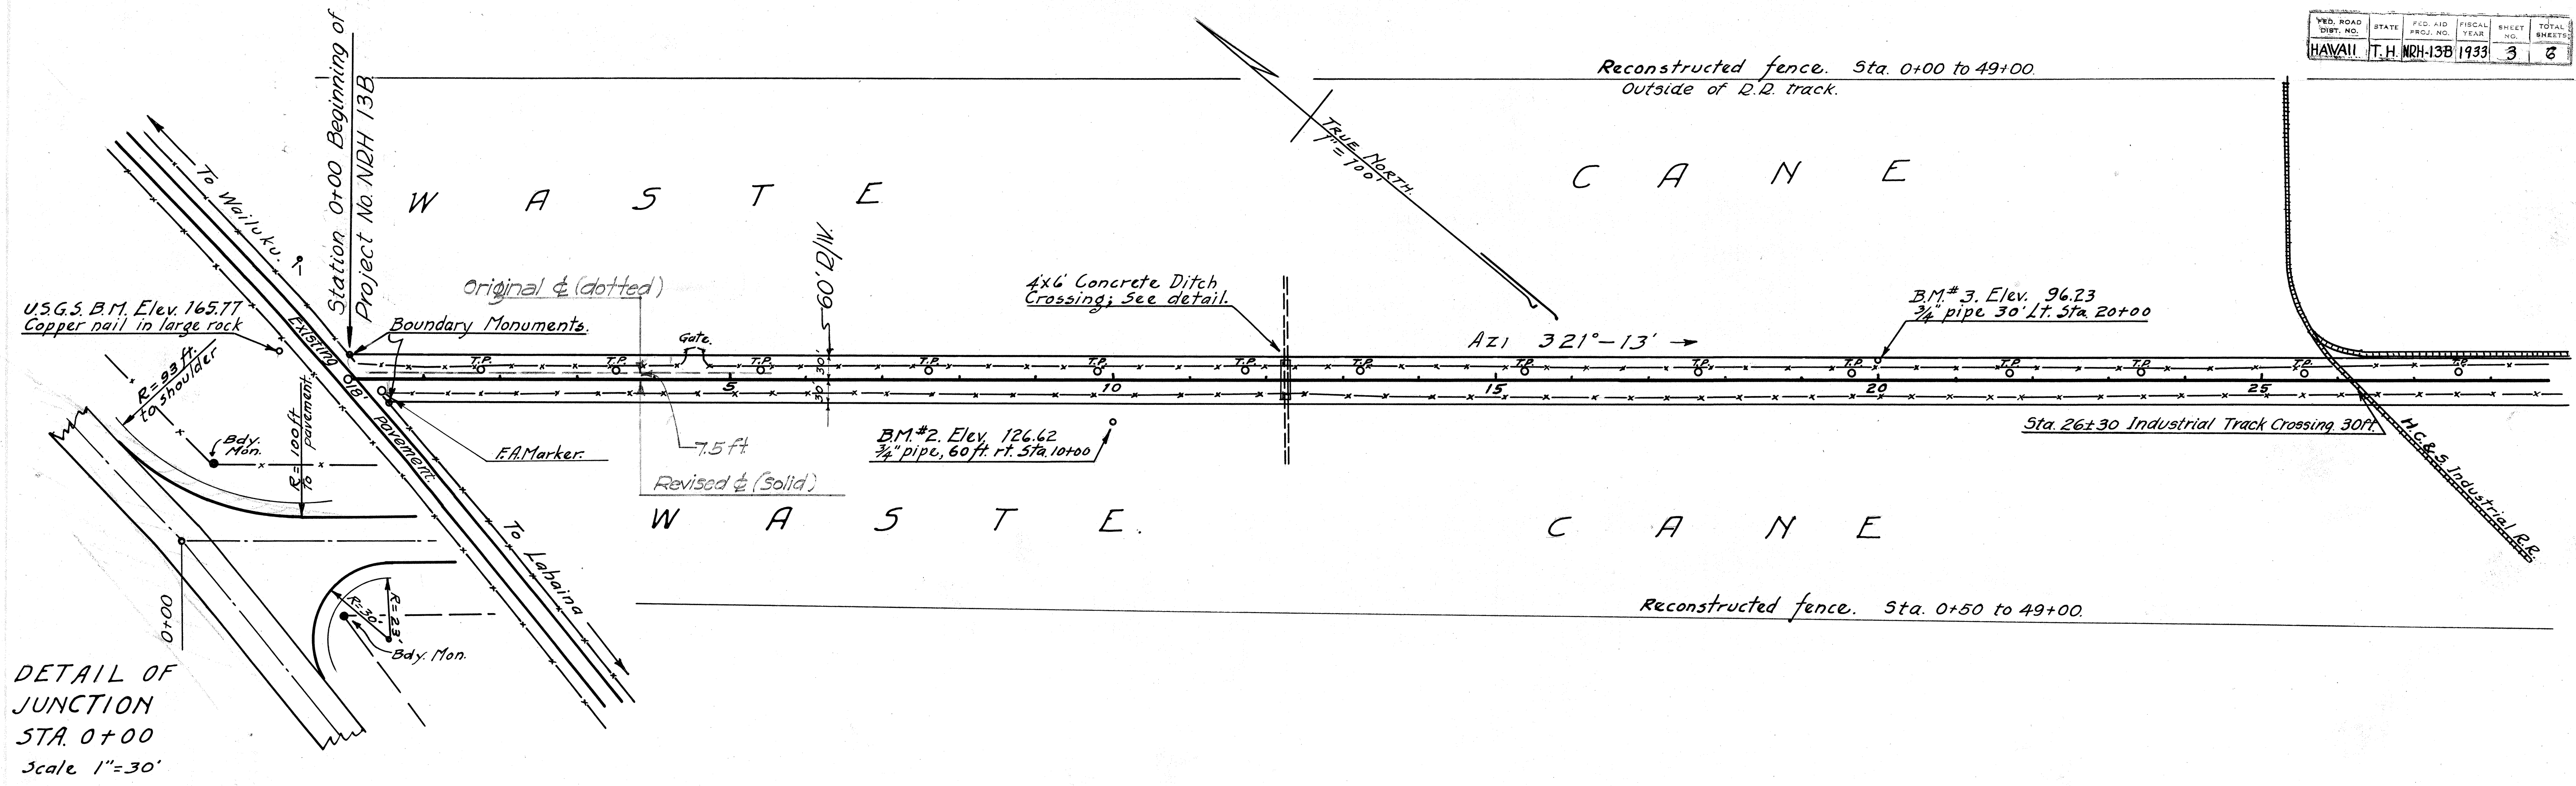

Revised 10-23-33
shifting centerline and
changing grades

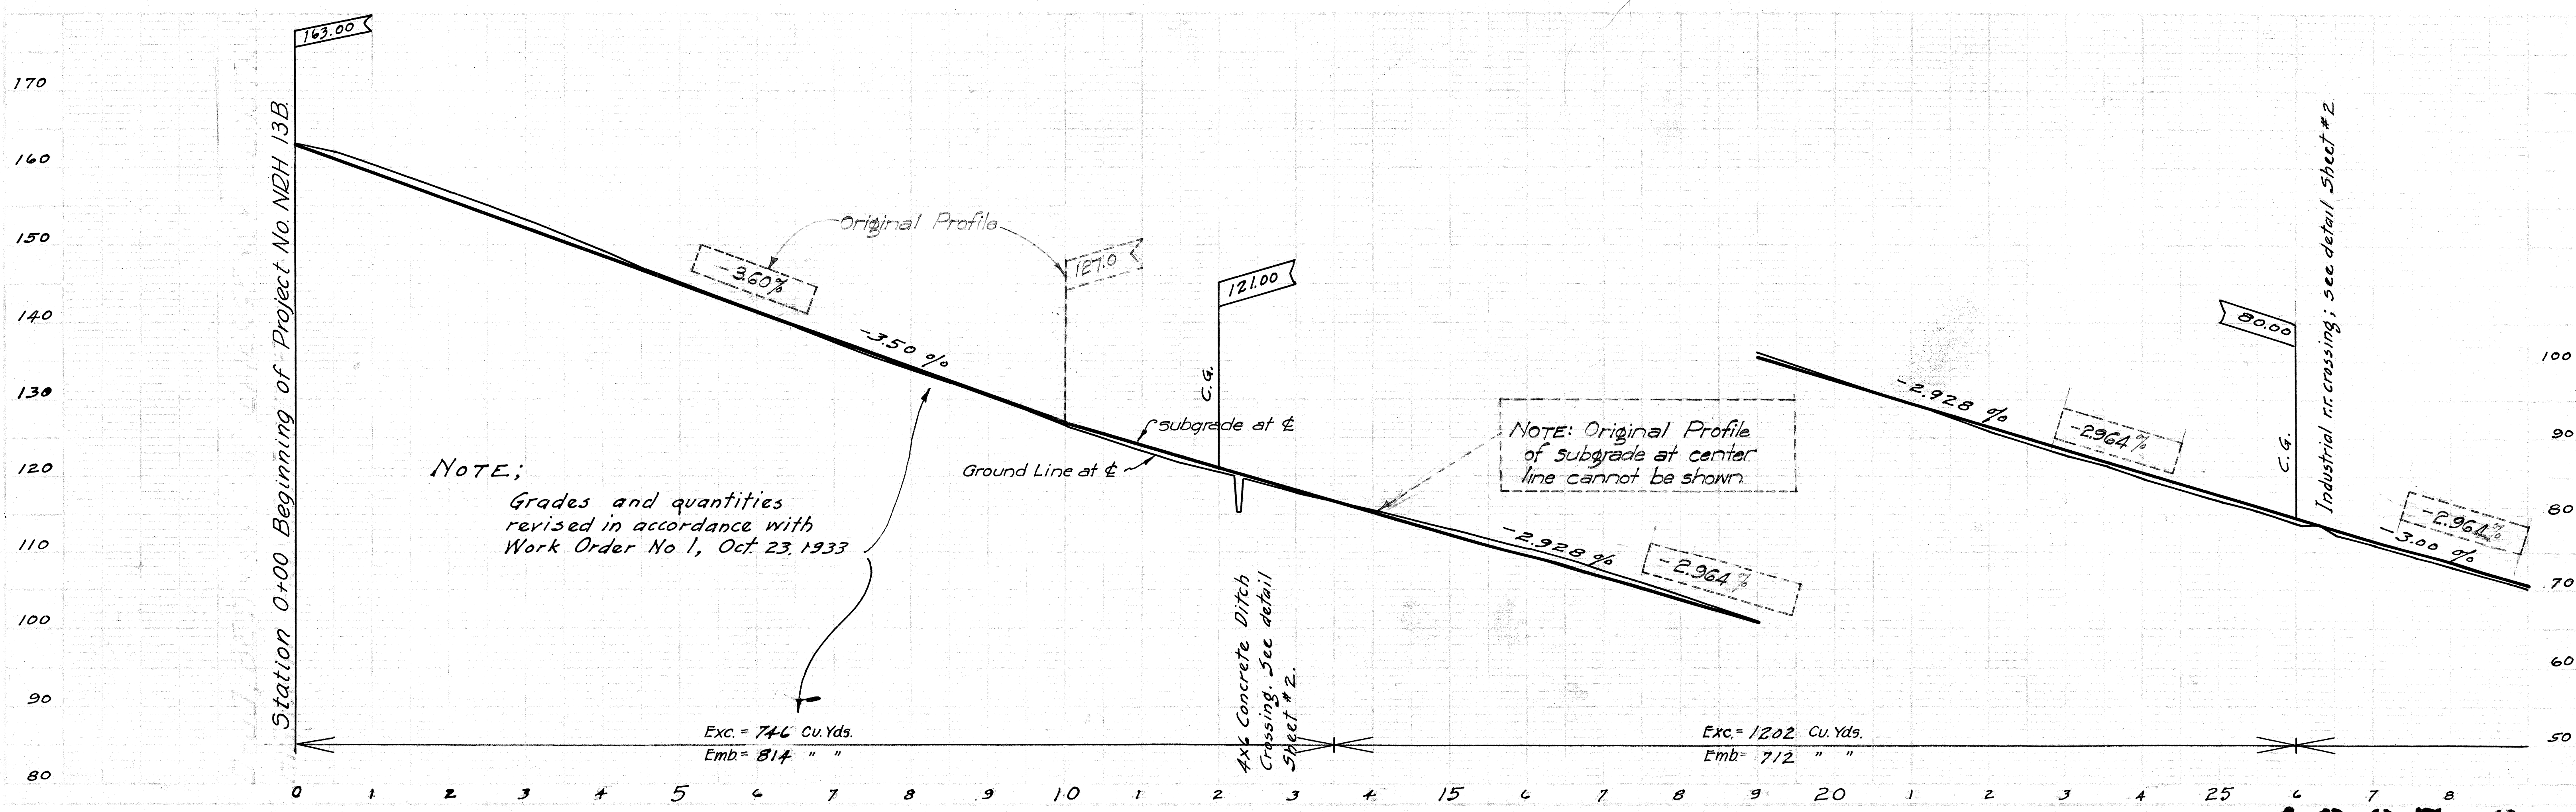