


FED. ROAD DIST. NO.	STATE	FED. AID PROJ. NO.	FISCAL YEAR	SHEET NO.	TOTAL SHEETS
HAWAII	HAW.	STP-0310(4)	2007	16	24

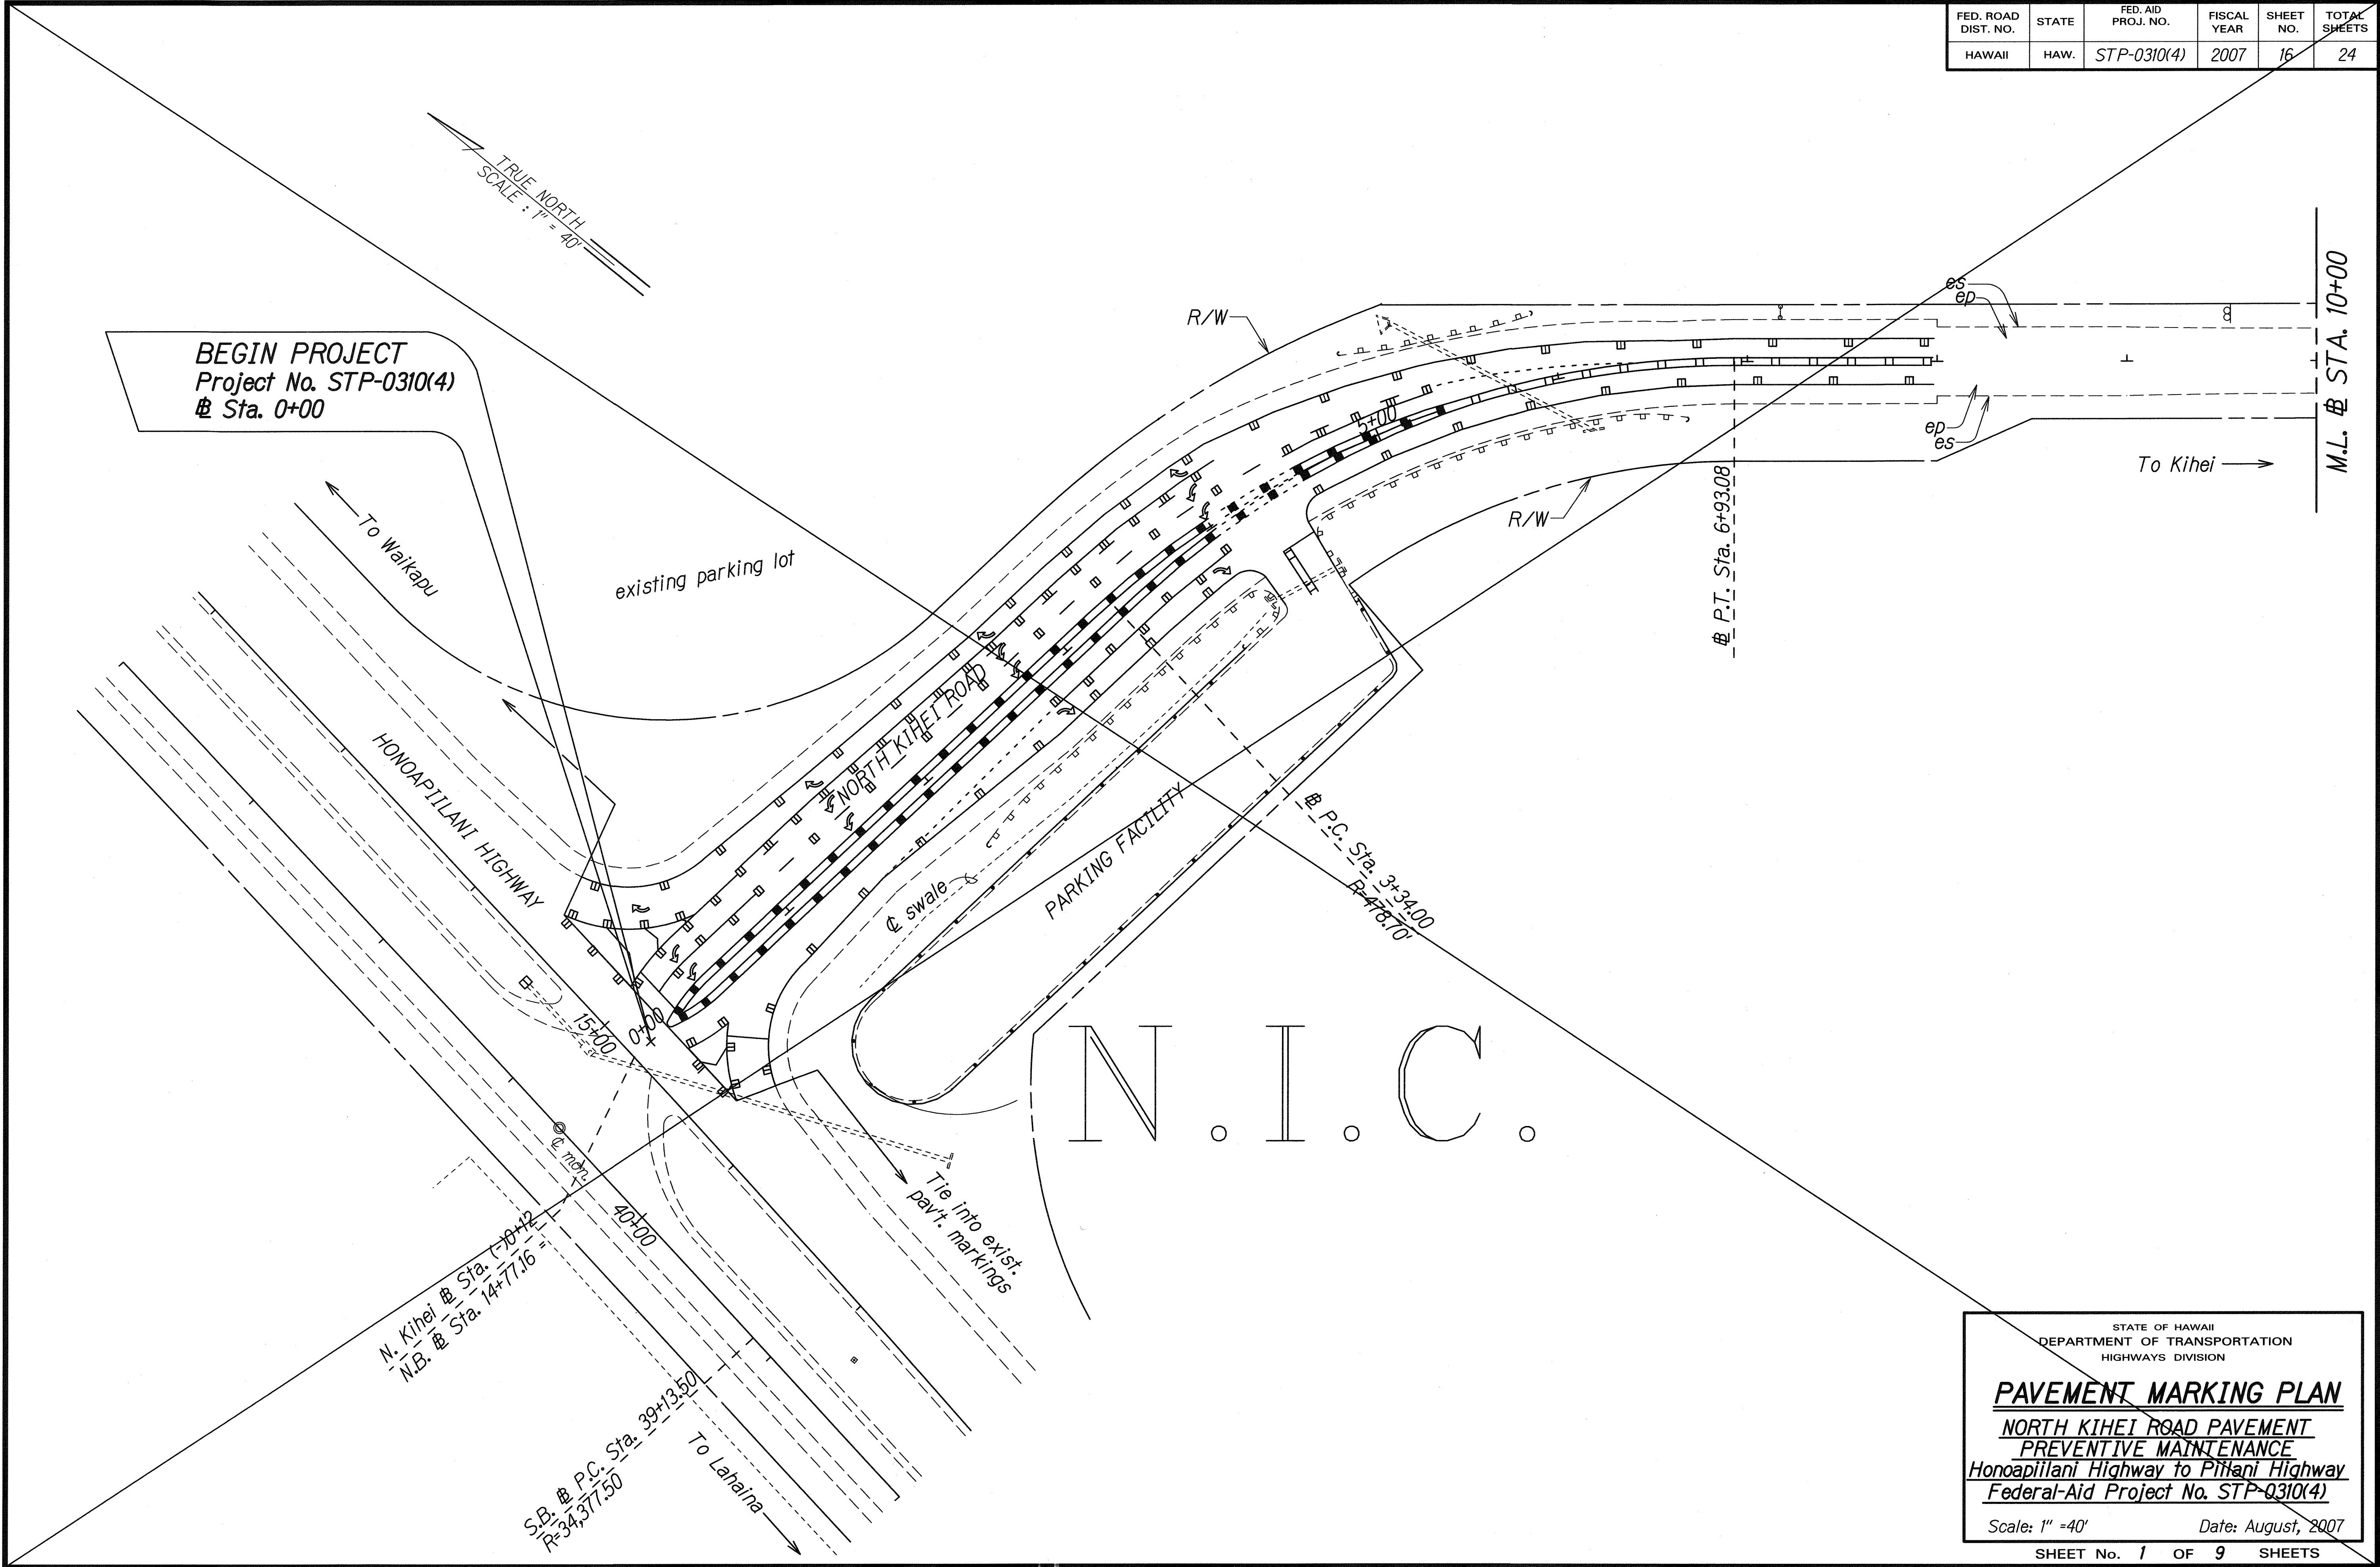


ORIGINAL PLAN	SURVEY PLOTTED BY	DATE
NOTED WORK	DRAWN BY	2007.07
DESIGNED BY	TRACED BY	
CHECKED BY	DESIGNED BY	
	CHECKED BY	

STATE OF HAWAII
DEPARTMENT OF TRANSPORTATION
HIGHWAYS DIVISION

PAVEMENT MARKING PLAN
NORTH KIEHI ROAD PAVEMENT PREVENTIVE MAINTENANCE
Honoapiilani Highway to Piilani Highway
Federal-Aid Project No. STP-0310(4)
Scale: 1" = 40'
Date: August, 2007

"AS-BUILT"

FED. ROAD DIST. NO.	STATE	FED. AID PROJ. NO.	FISCAL YEAR	SHEET NO.	TOTAL SHEETS
HAWAII	HAW.	STP-0310(4)	2007	17	24

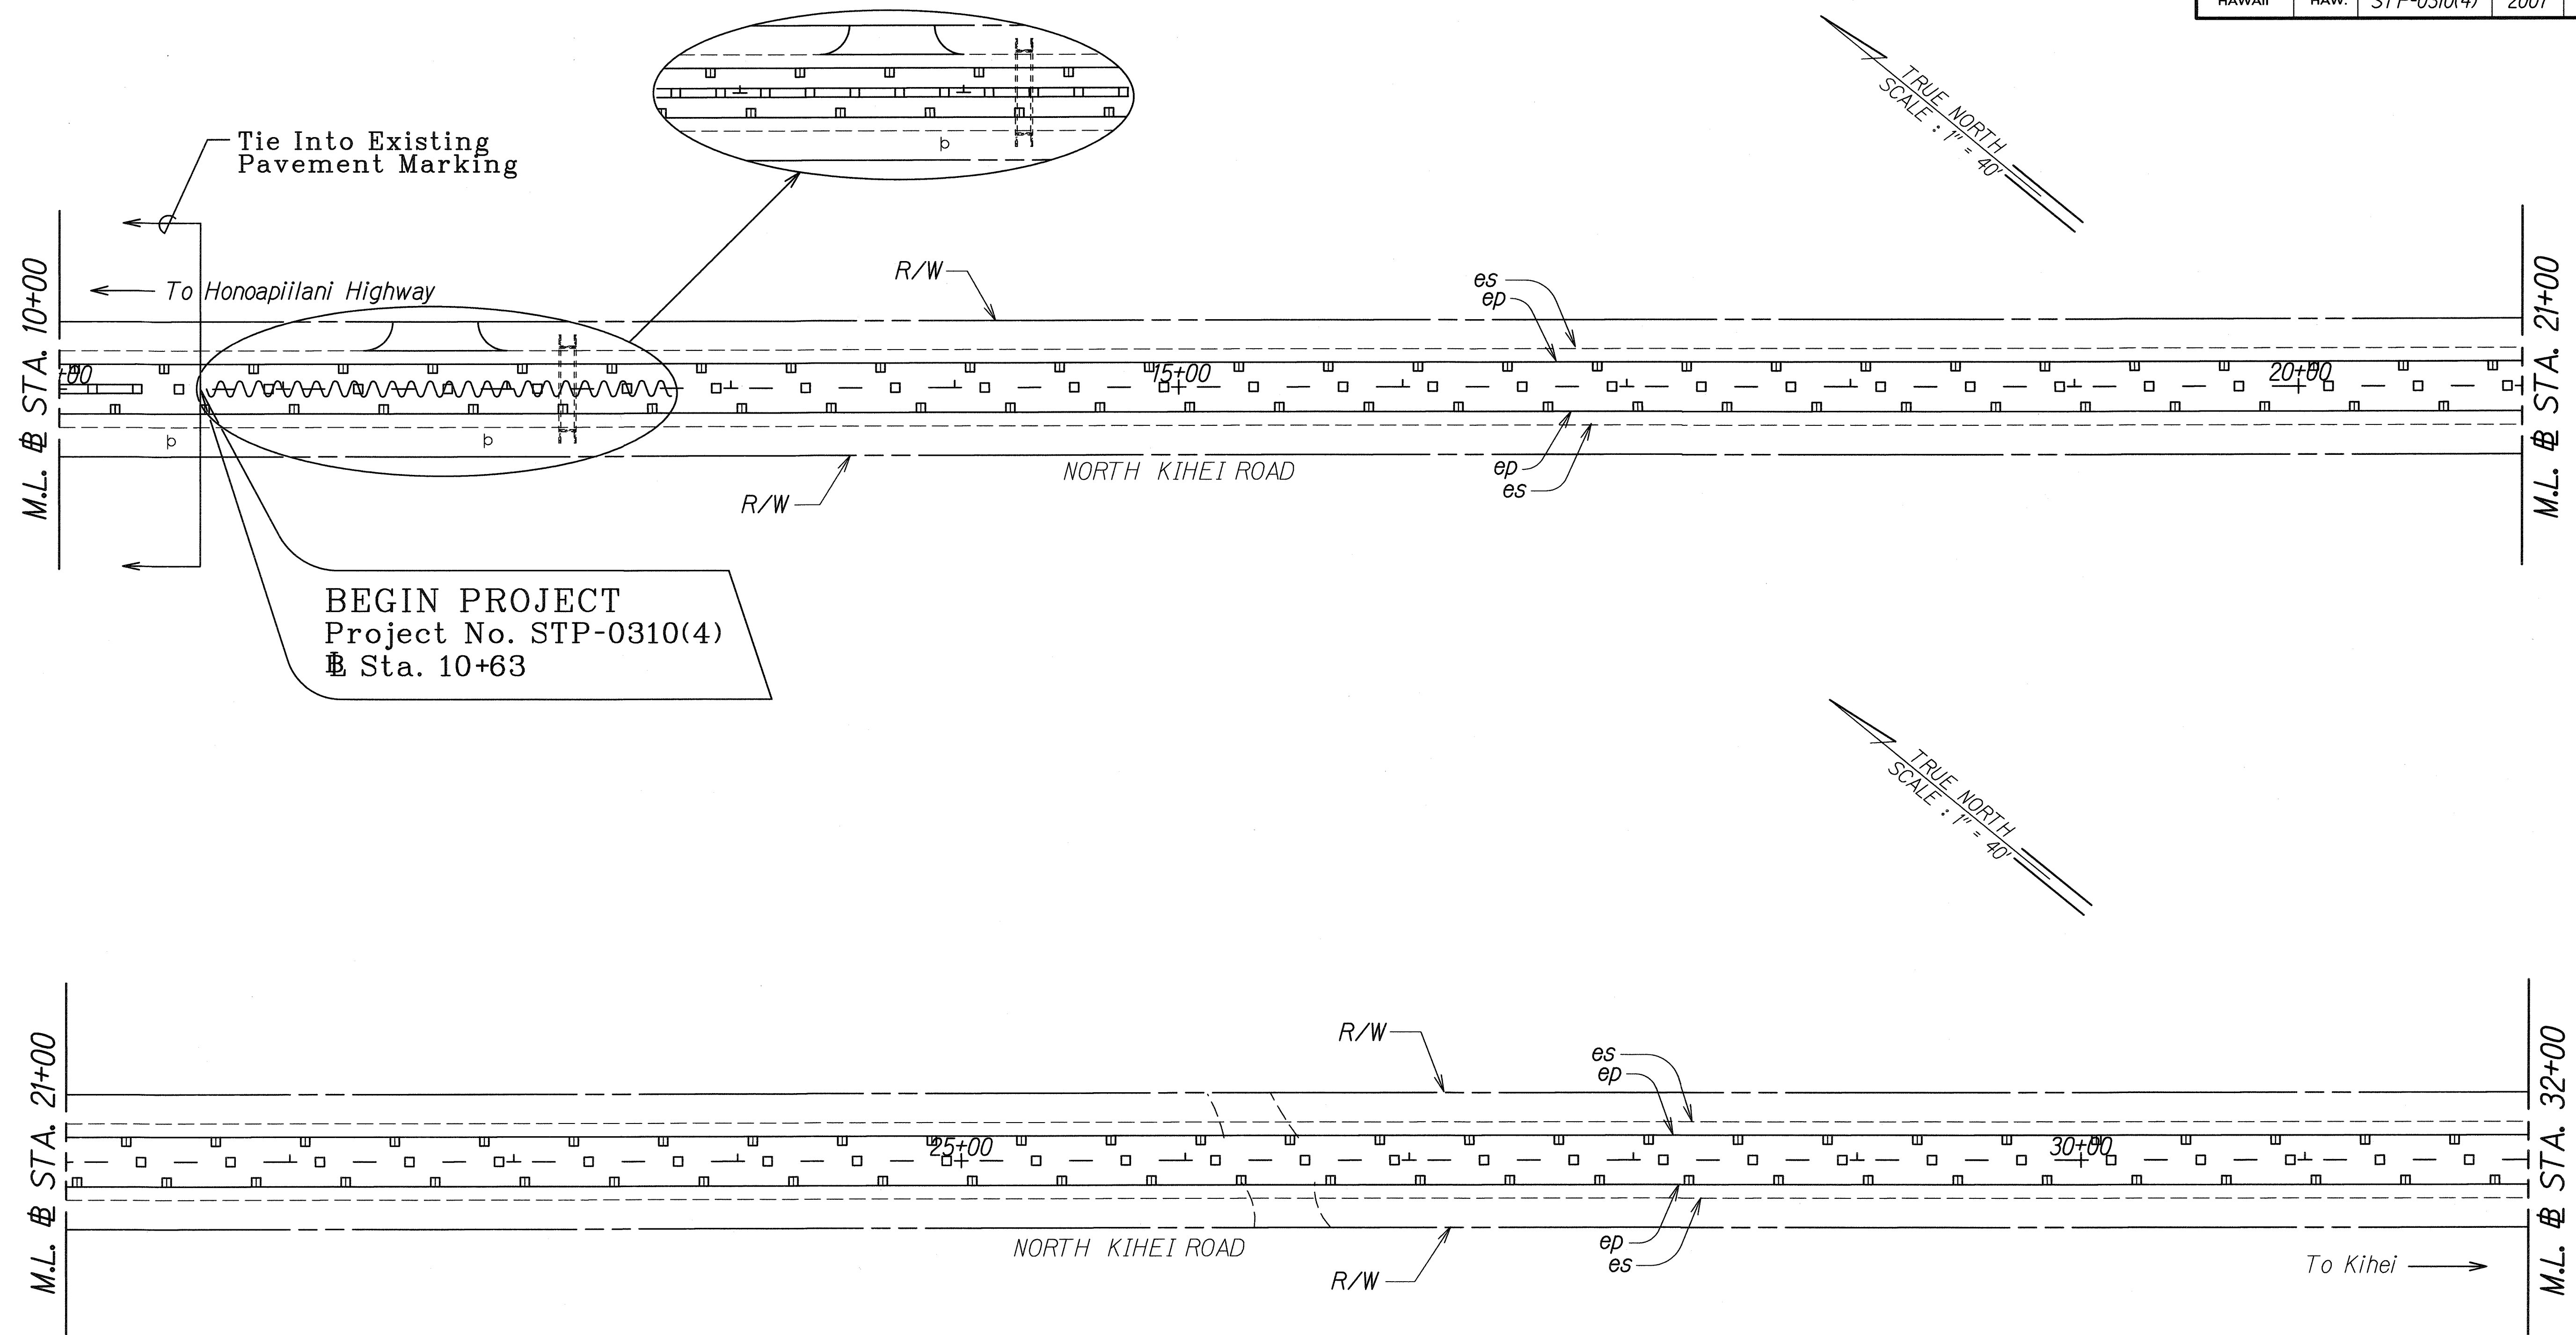

ORIGINAL PLAN	SURVEY PLOTTED BY	DATE
NOTE BOOK	DRAWN BY	Aug. 07
DESIGNED BY	TRACED BY	
QUANTITIES BY		
CHECKED BY		

LEGEND FOR AS-BUILT POSTINGS	
	Squiggly line for as-built deletion
	Double line for as-built deletion
Roadway	Text for as-built posting

STATE OF HAWAII
DEPARTMENT OF TRANSPORTATION
HIGHWAYS DIVISION


PAVEMENT MARKING PLAN

NORTH KIHAI ROAD PAVEMENT PREVENTIVE MAINTENANCE

Honoapiilani Highway to Piilani Highway
Federal-Aid Project No. STP-0310(4)

Scale: 1" = 40' Date: August, 2007

FED. ROAD DIST. NO.	STATE	FED. AID PROJ. NO.	FISCAL YEAR	SHEET NO.	TOTAL SHEETS
HAWAII	HAW.	STP-0310(4)	2007	18	24

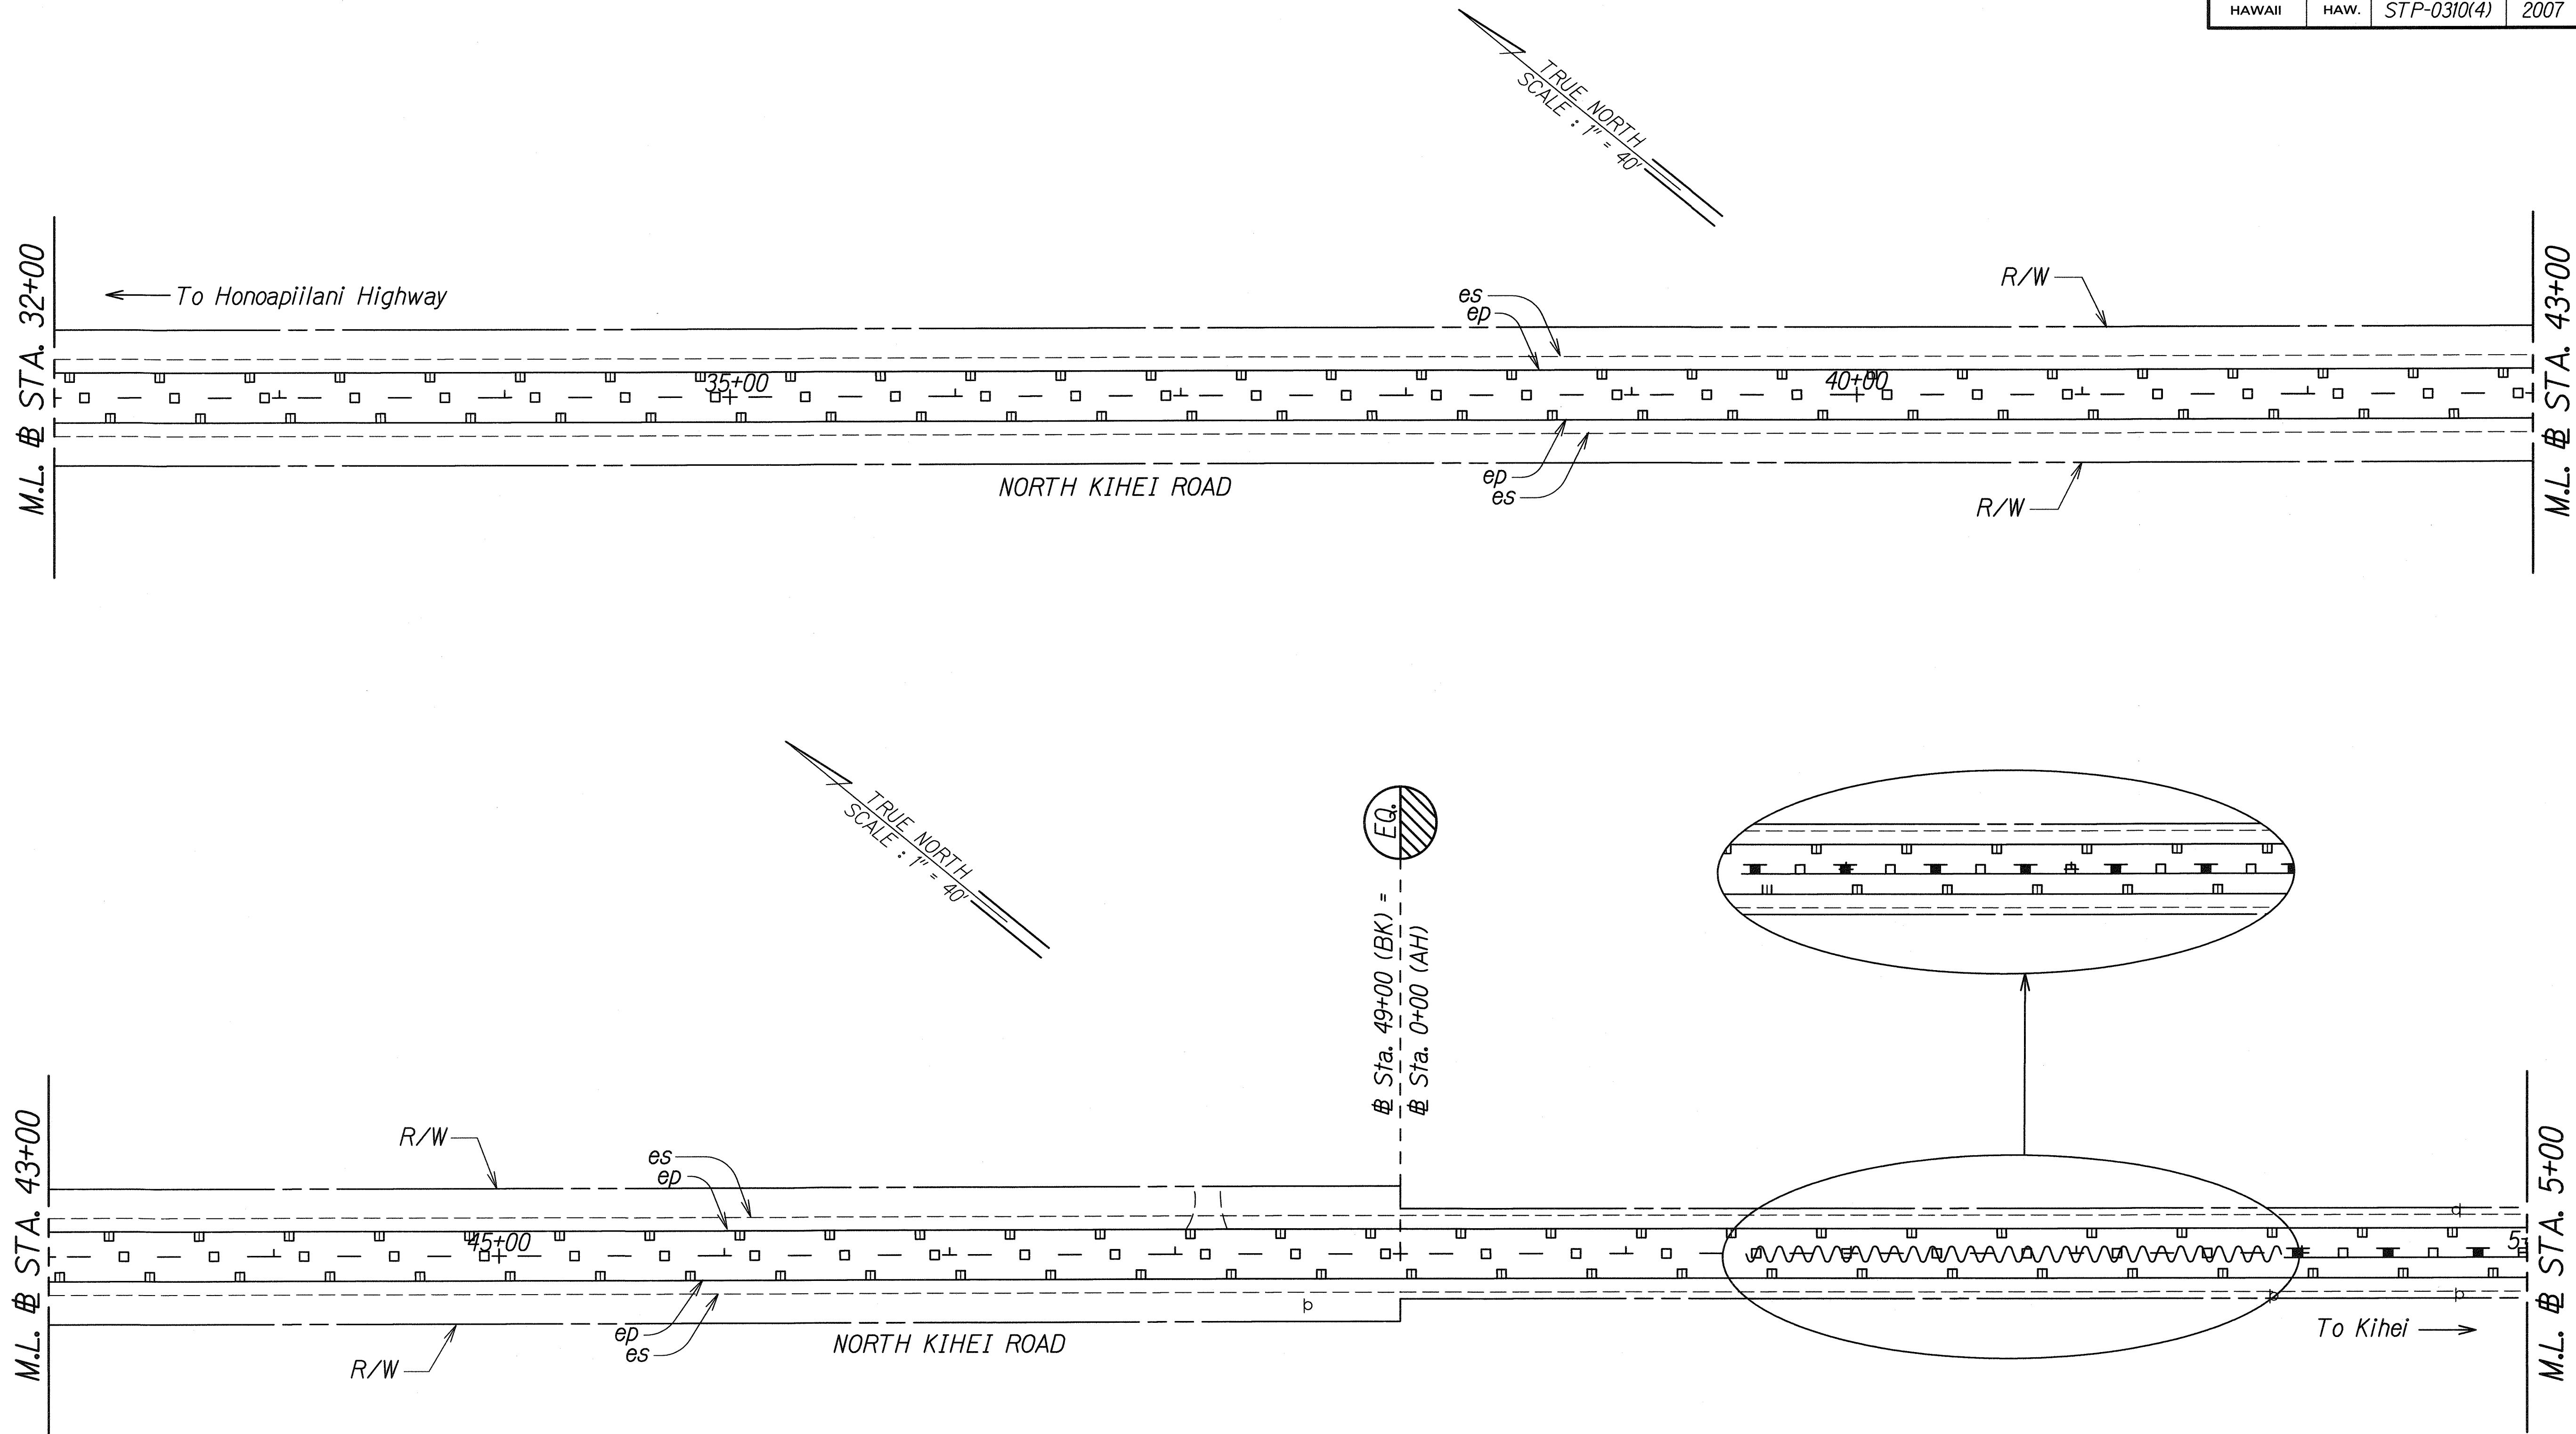

ORIGINAL PLAN	DATE
NOTED	DESIGNED BY
DESIGNED BY	CHECKED BY
CHECKED BY	DATE


LEGEND FOR AS-BUILT POSTINGS	
	Squiggly line for as-built deletion
	Double line for as-built deletion
Roadway	Text for as-built posting

STATE OF HAWAII
DEPARTMENT OF TRANSPORTATION
HIGHWAYS DIVISION

PAVEMENT MARKING PLAN
NORTH KIHAI ROAD PAVEMENT PREVENTIVE MAINTENANCE
Honoapiilani Highway to Pillani Highway
Federal-Aid Project No. STP-0310(4)
Scale: 1" = 40' Date: August, 2007

"AS-BUILT"

FED. ROAD DIST. NO.	STATE	FED. AID PROJ. NO.	FISCAL YEAR	SHEET NO.	TOTAL SHEETS
HAWAII	HAW.	STP-0310(4)	2007	19	24

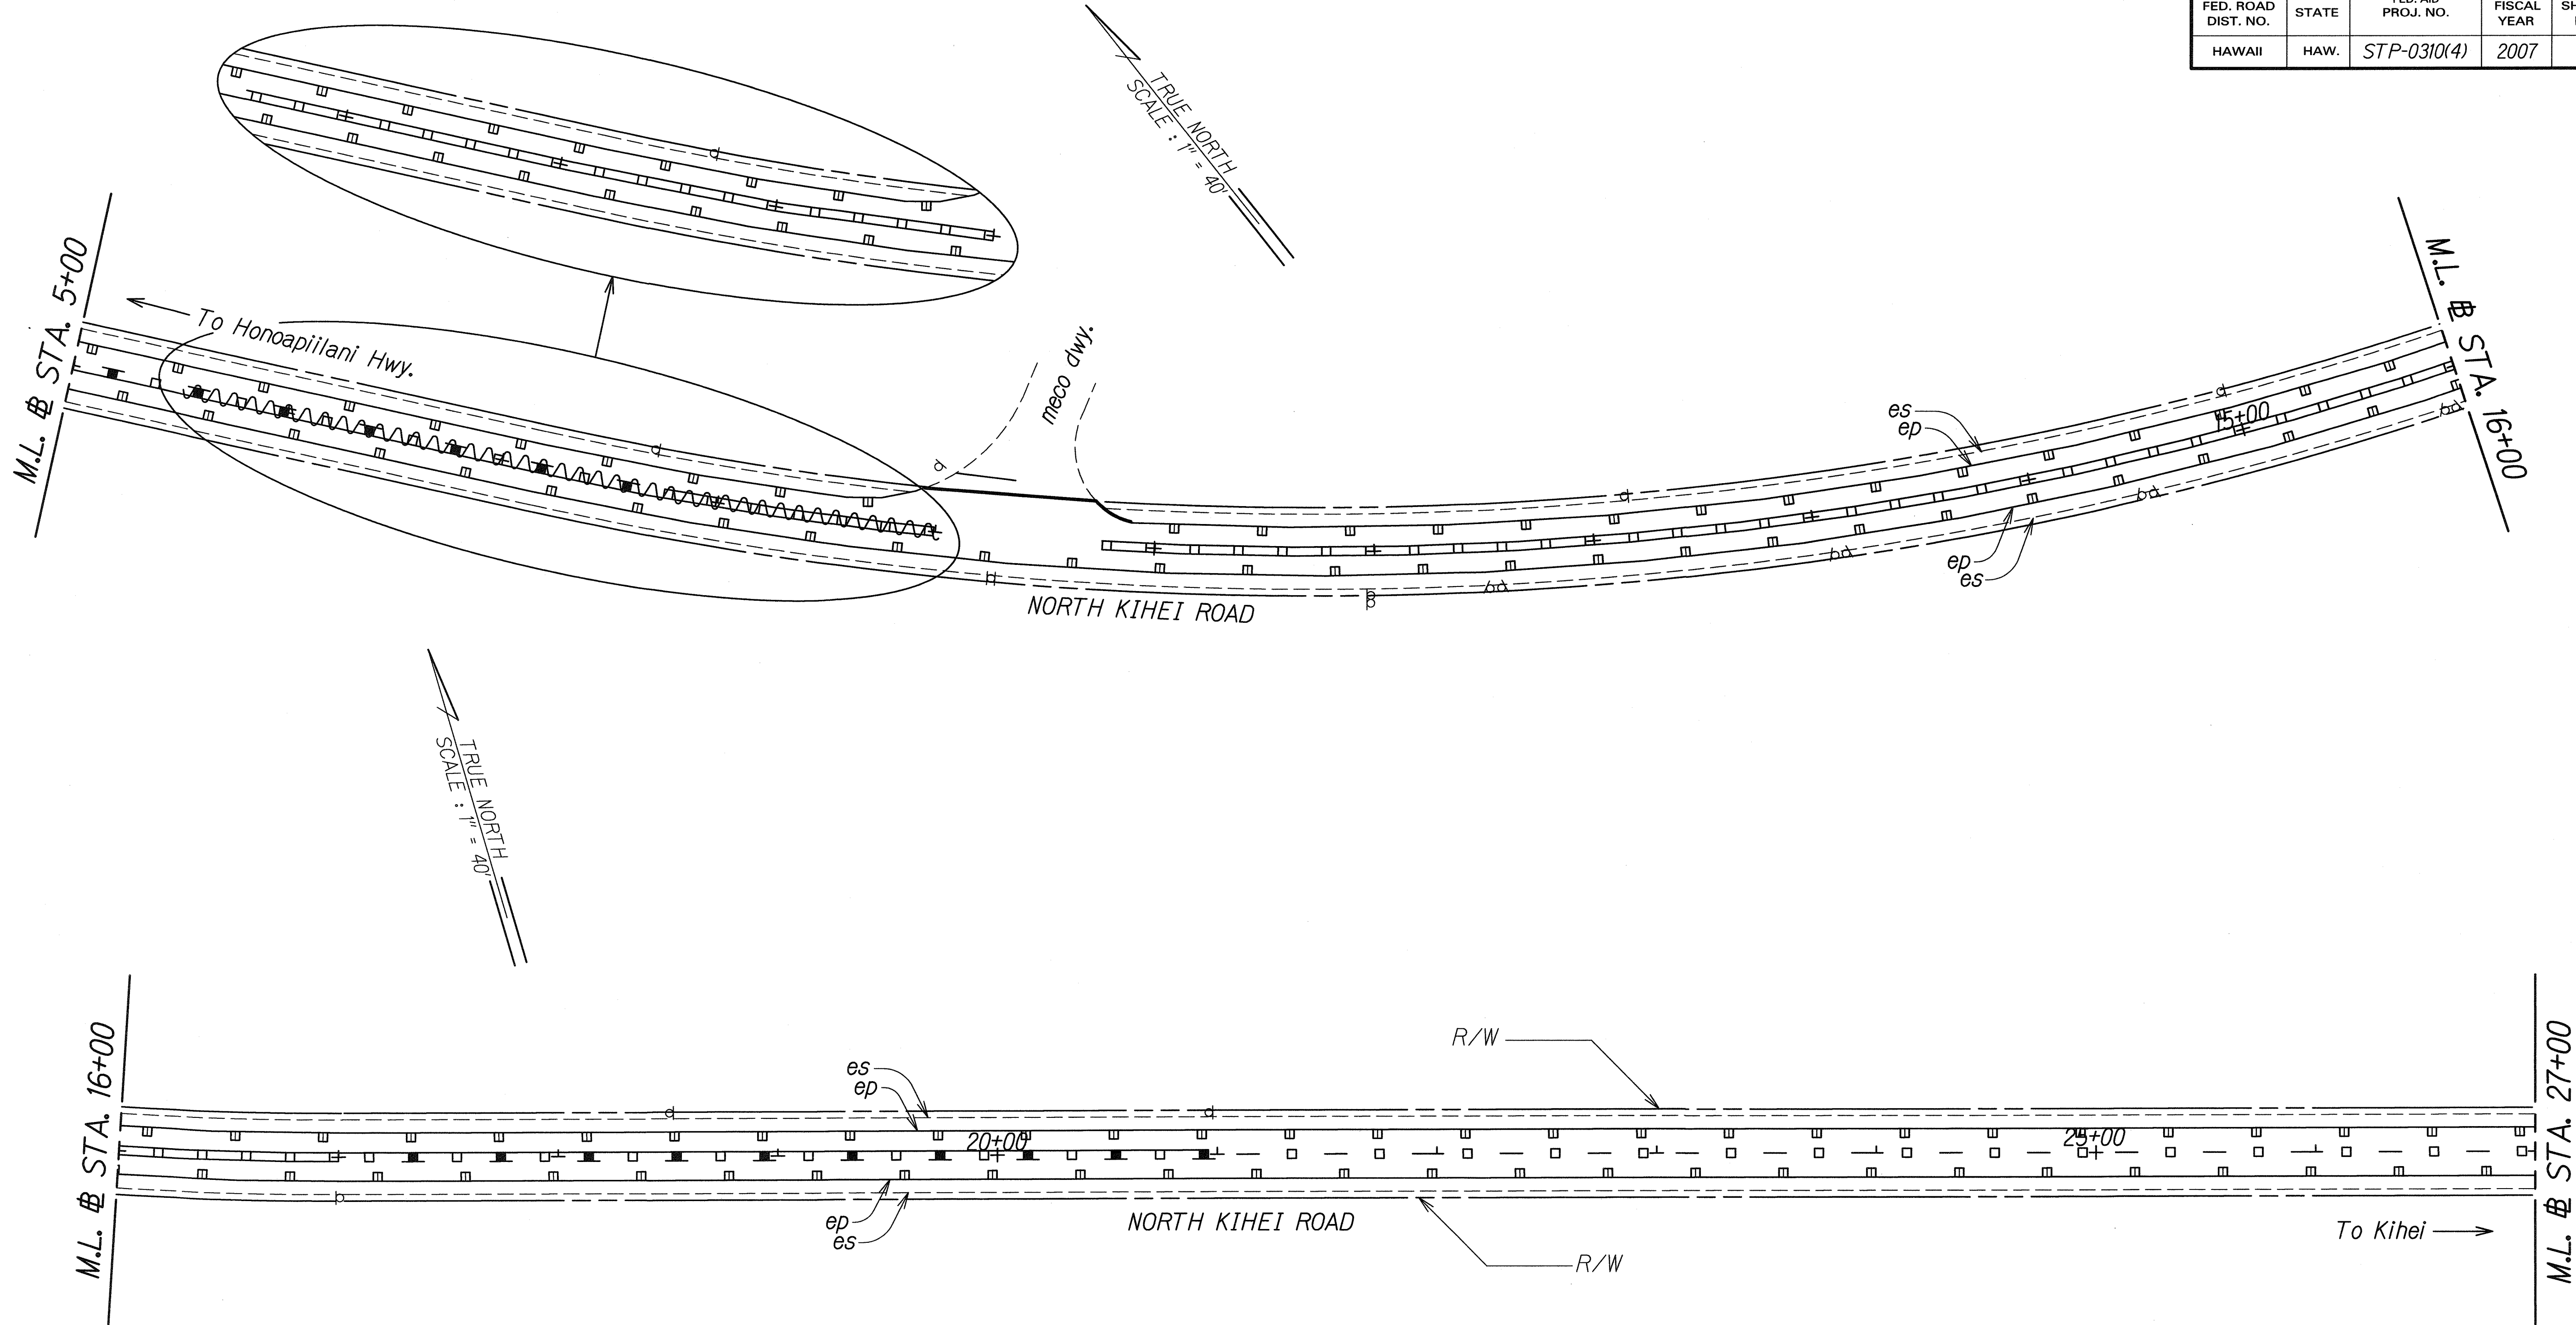


ORIGINAL PLAN	SURVEY PLOTTED BY	DATE
NOTE BOOK	DRAWN BY	AUG. 07
DESIGNED BY	TRACED BY	
CHECKED BY		

LEGEND FOR AS-BUILT POSTINGS	
	Squiggly line for as-built deletion
	Double line for as-built deletion
Roadway	Text for as-built posting

STATE OF HAWAII
DEPARTMENT OF TRANSPORTATION
HIGHWAYS DIVISION

PAVEMENT MARKING PLAN
NORTH KIHAI ROAD PAVEMENT PREVENTIVE MAINTENANCE
Honoapiilani Highway to Piilani Highway
Federal-Aid Project No. STP-0310(4)
Scale: 1" = 40' Date: August, 2007

FED. ROAD DIST. NO.	STATE	FED. AID PROJ. NO.	FISCAL YEAR	SHEET NO.	TOTAL SHEETS
HAWAII	HAW.	STP-0310(4)	2007	20	24

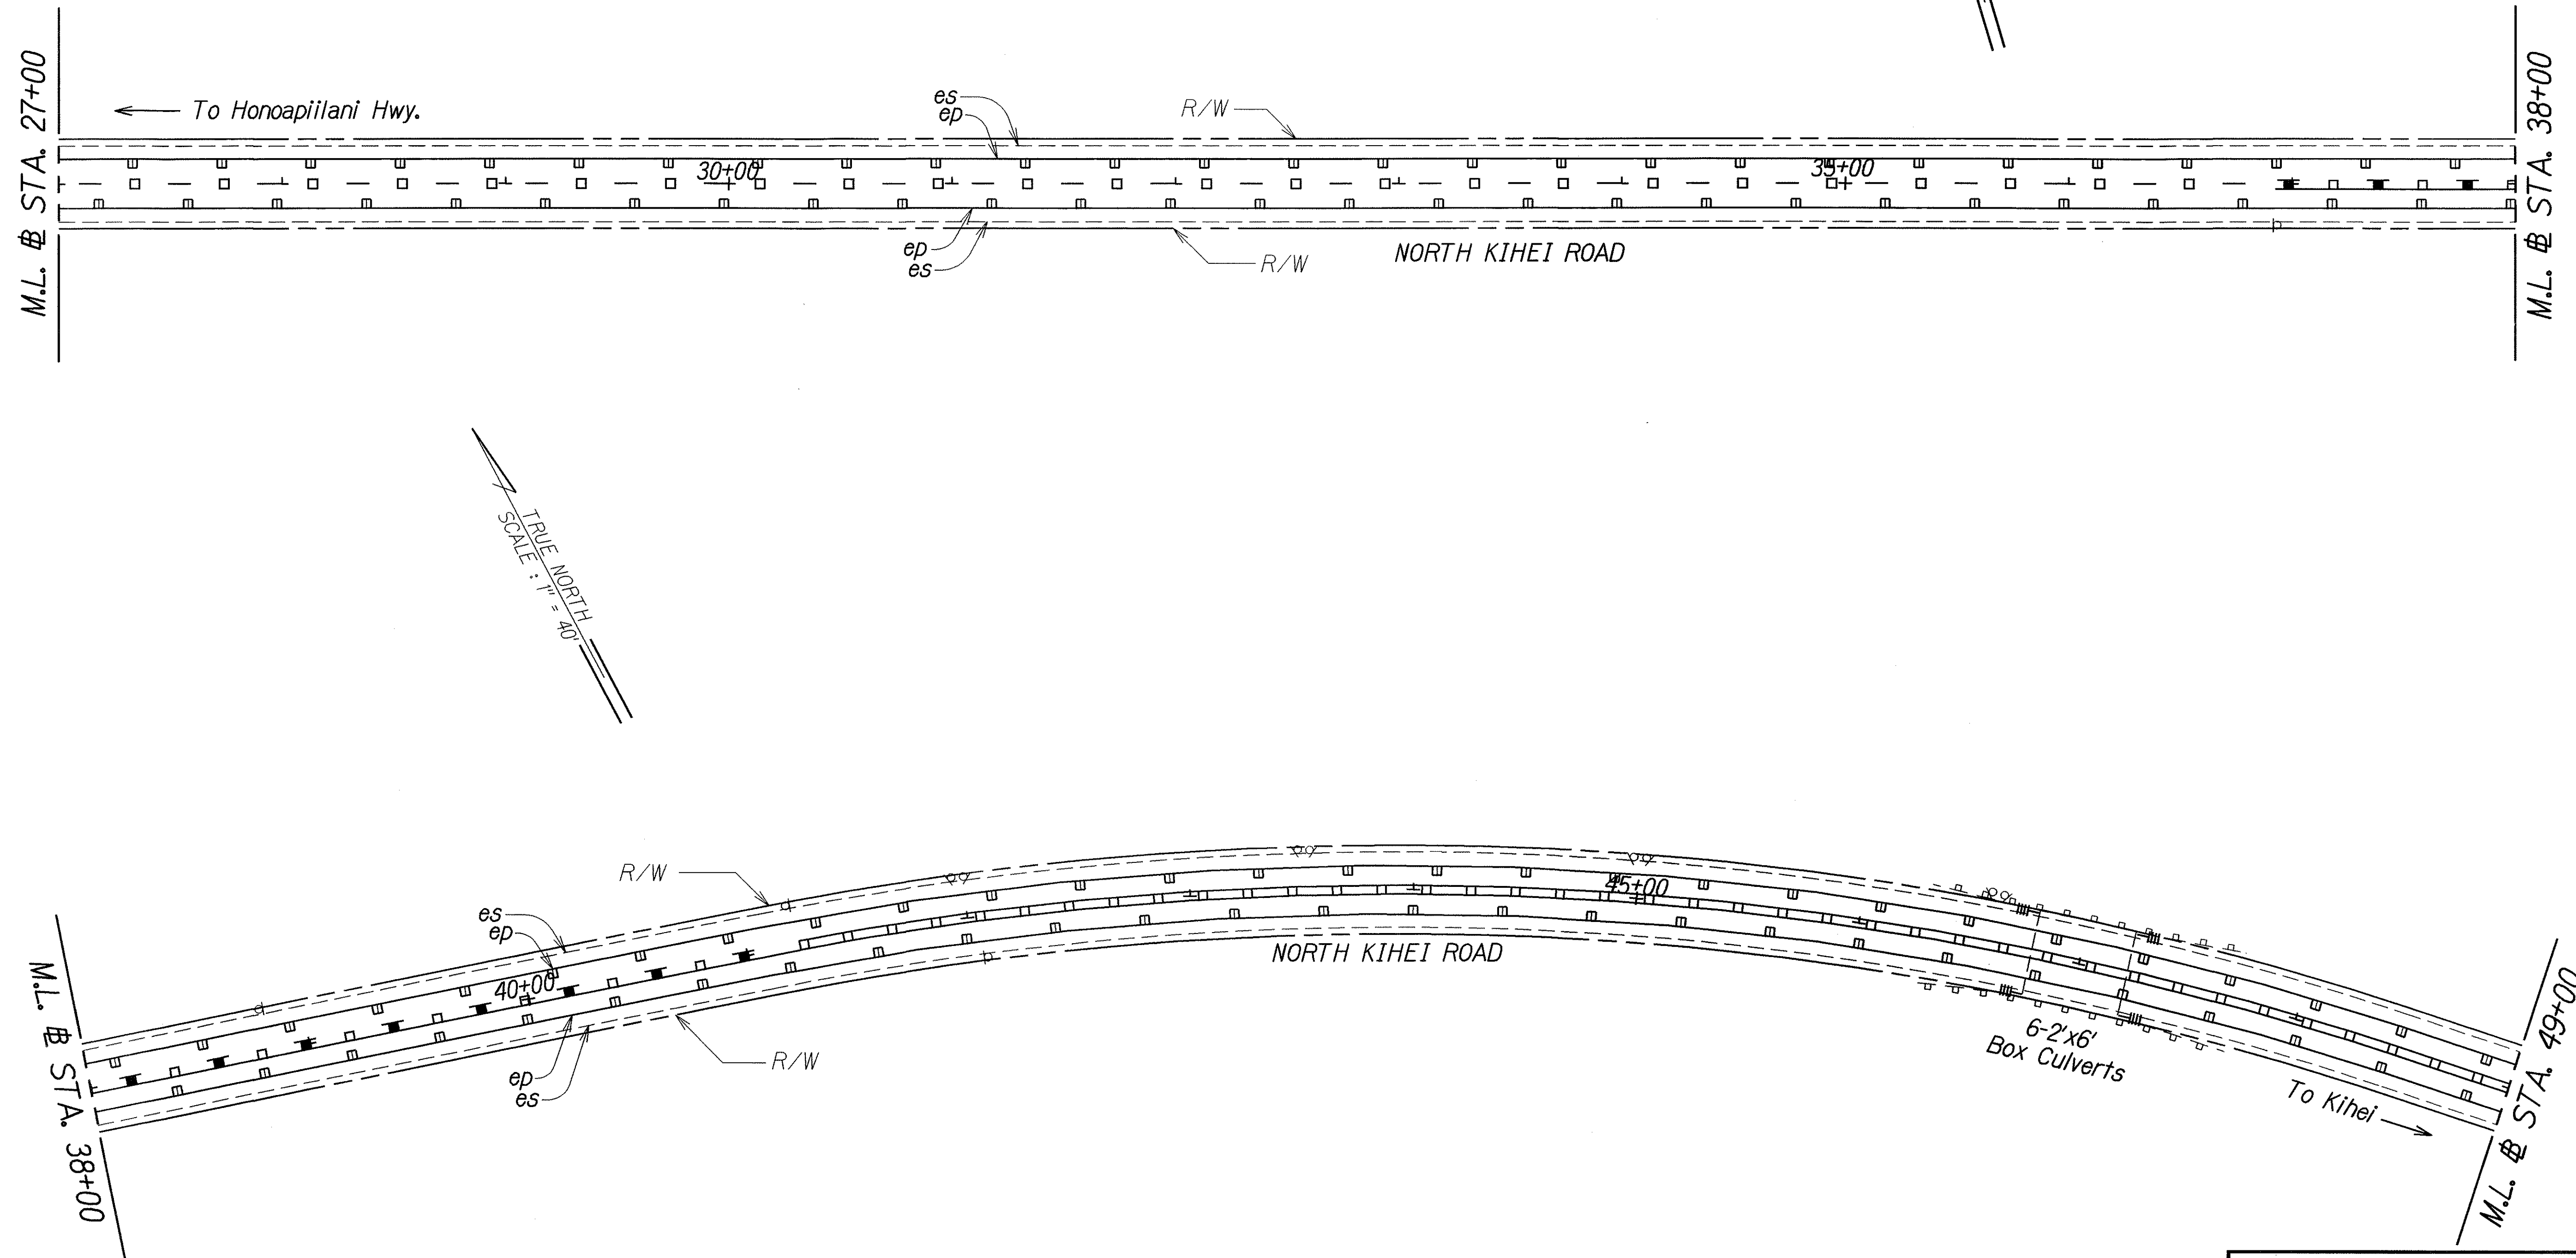

ORIGINAL PLAN	SURVEY PLOTTED BY	DATE
NOTE BOOK	DRAWN BY	AUG. 07
DESIGNED BY	TRACED BY	
CHECKED BY	CHECKED BY	


STATE OF HAWAII
DEPARTMENT OF TRANSPORTATION
HIGHWAYS DIVISION

PAVEMENT MARKING PLAN
NORTH KIHAI ROAD PAVEMENT PREVENTIVE MAINTENANCE
Honoapiilani Highway to Piilani Highway
Federal-Aid Project No. STP-0310(4)

Scale: 1" = 40' Date: August, 2007

SHEET No. 5 OF 9 SHEETS

FED. ROAD DIST. NO.	STATE	FED. AID PROJ. NO.	FISCAL YEAR	SHEET NO.	TOTAL SHEETS
HAWAII	HAW.	STP-0310(4)	2007	21	24

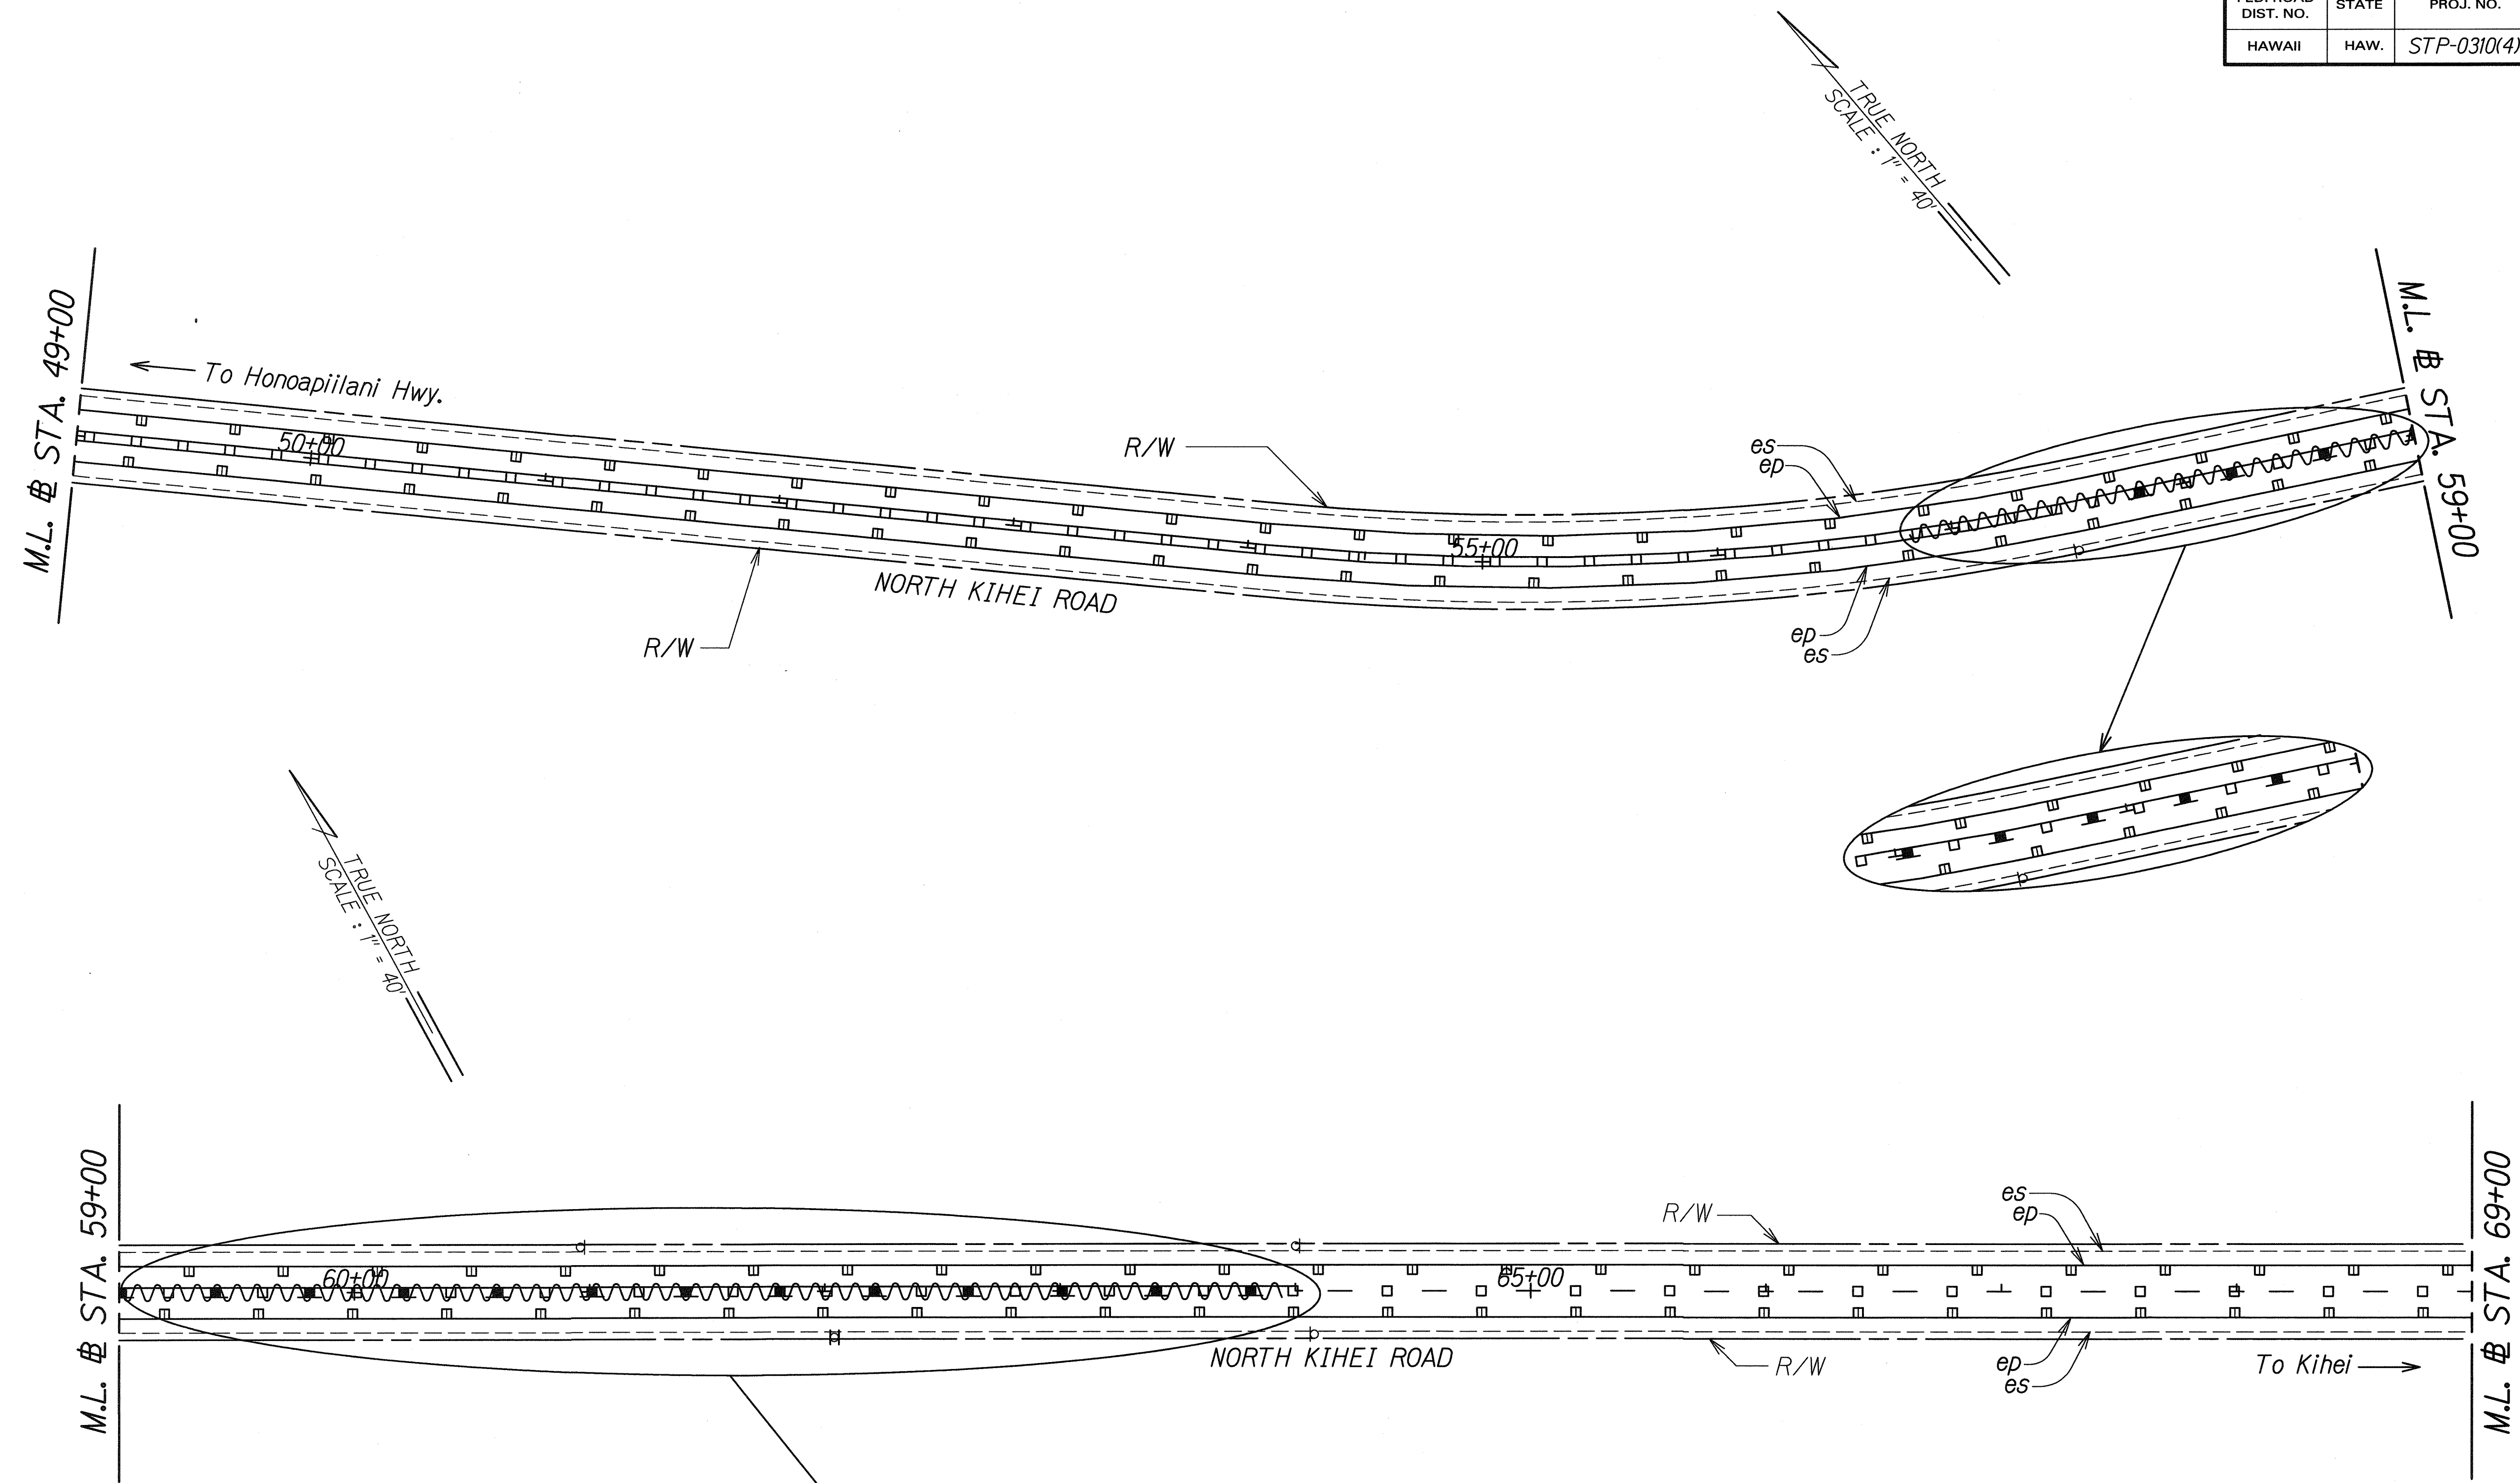

ORIGINAL PLAN	DATE	Aug. 07
DESIGNED BY	TRACED BY	TS
QUANTITIES BY	CHECKED BY	2/2/2008



LEGEND FOR AS-BUILT POSTINGS	
	Squiggly line for as-built deletion
	Double line for as-built deletion
Roadway	Text for as-built posting

STATE OF HAWAII
DEPARTMENT OF TRANSPORTATION
HIGHWAYS DIVISION

PAVEMENT MARKING PLAN
NORTH KIHAI ROAD PAVEMENT PREVENTIVE MAINTENANCE
Honoapiilani Highway to Piilani Highway
Federal-Aid Project No. STP-0310(4)

Scale: 1" = 40'
Date: August, 2007

FED. ROAD DIST. NO.	STATE	FED. AID PROJ. NO.	FISCAL YEAR	SHEET NO.	TOTAL SHEETS
HAWAII	HAW.	STP-0310(4)	2007	22	24

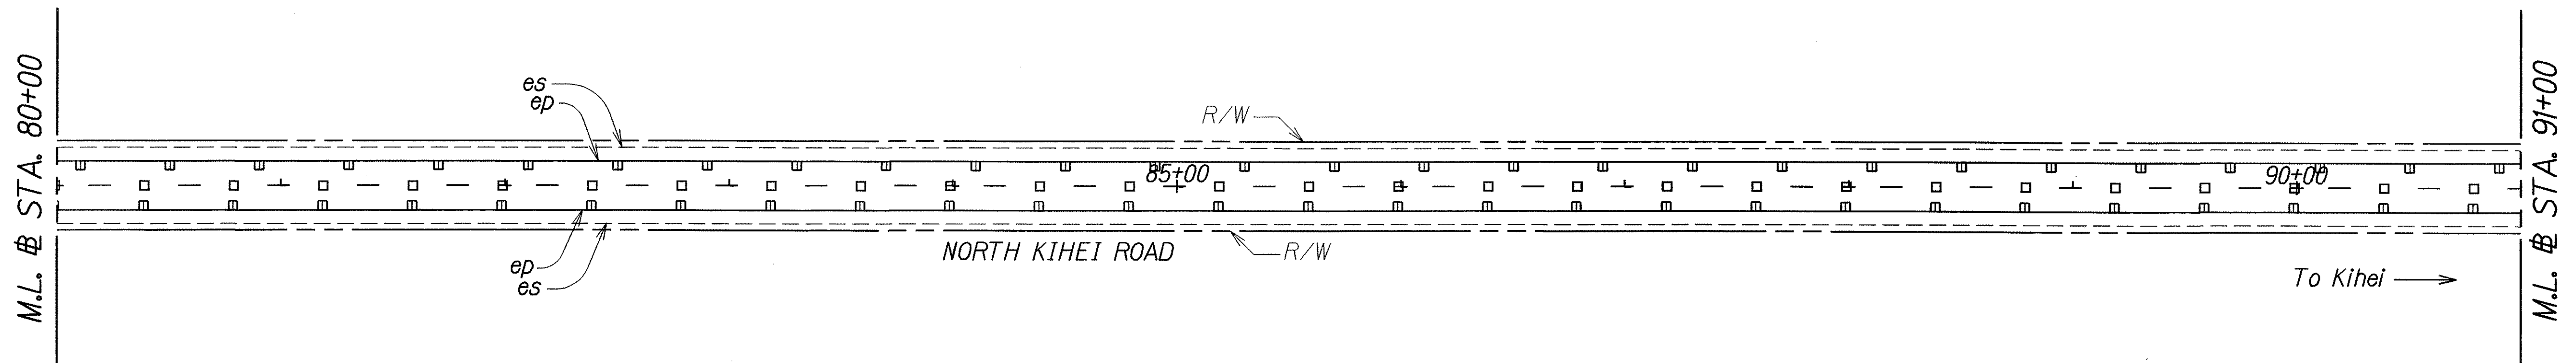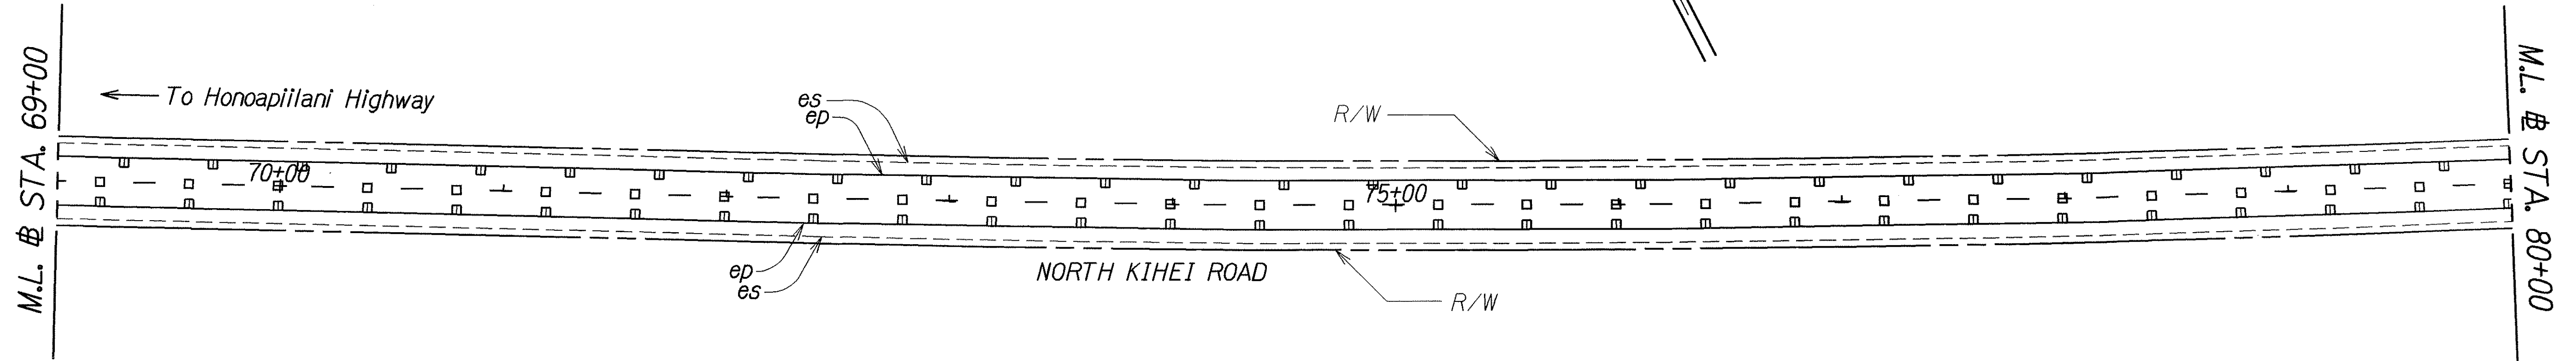

ORIGINAL PLAN	SURVEY PLOTTED BY	DATE
NOTED BY	DRAWN BY	2007
QUANTITIES BY	DESIGNED BY	
CHECKED BY		

STATE OF HAWAII
DEPARTMENT OF TRANSPORTATION
HIGHWAYS DIVISION

PAVEMENT MARKING PLAN

NORTH KIHAI ROAD PAVEMENT PREVENTIVE MAINTENANCE



Honoapiilani Highway to Piilani Highway

Federal-Aid Project No. STP-0310(4)

Scale: 1" = 40' Date: August, 2007

SHEET No. 7 OF 9 SHEETS

FED. ROAD DIST. NO.	STATE	FED. AID PROJ. NO.	FISCAL YEAR	SHEET NO.	TOTAL SHEETS
HAWAII	HAW.	STP-0310(4)	2007	23	24

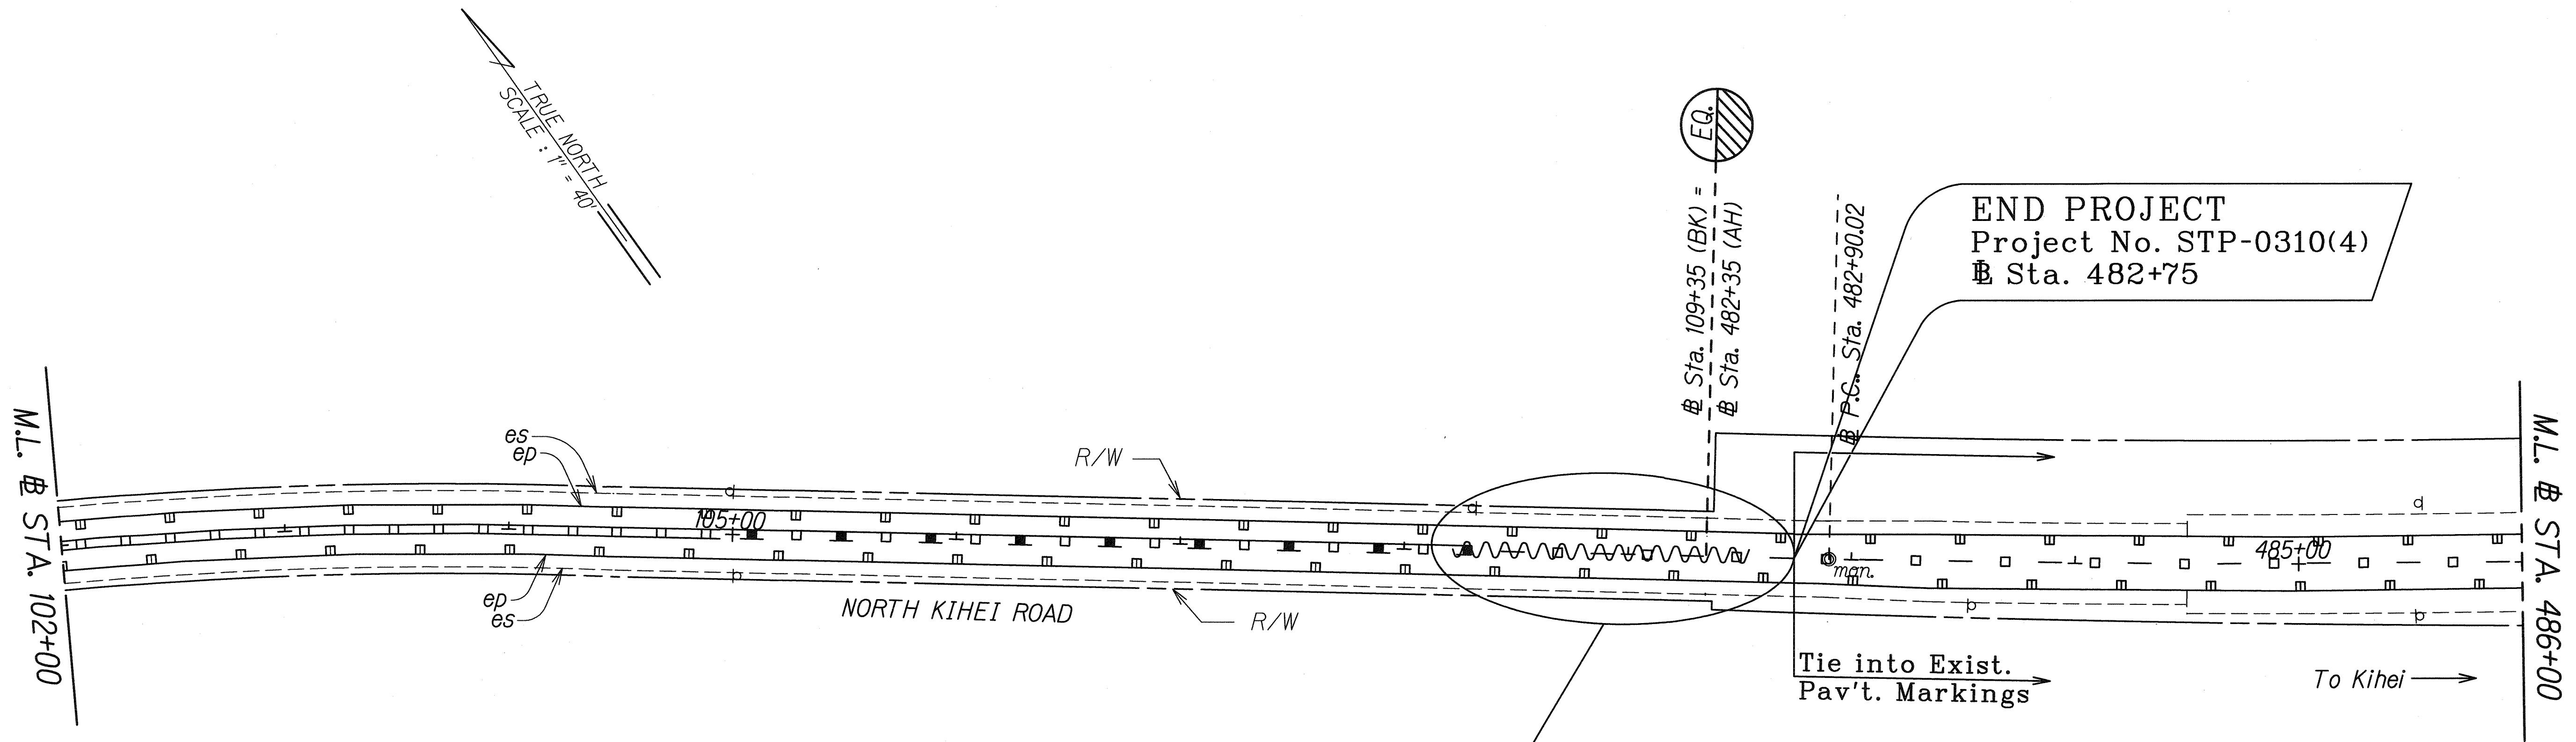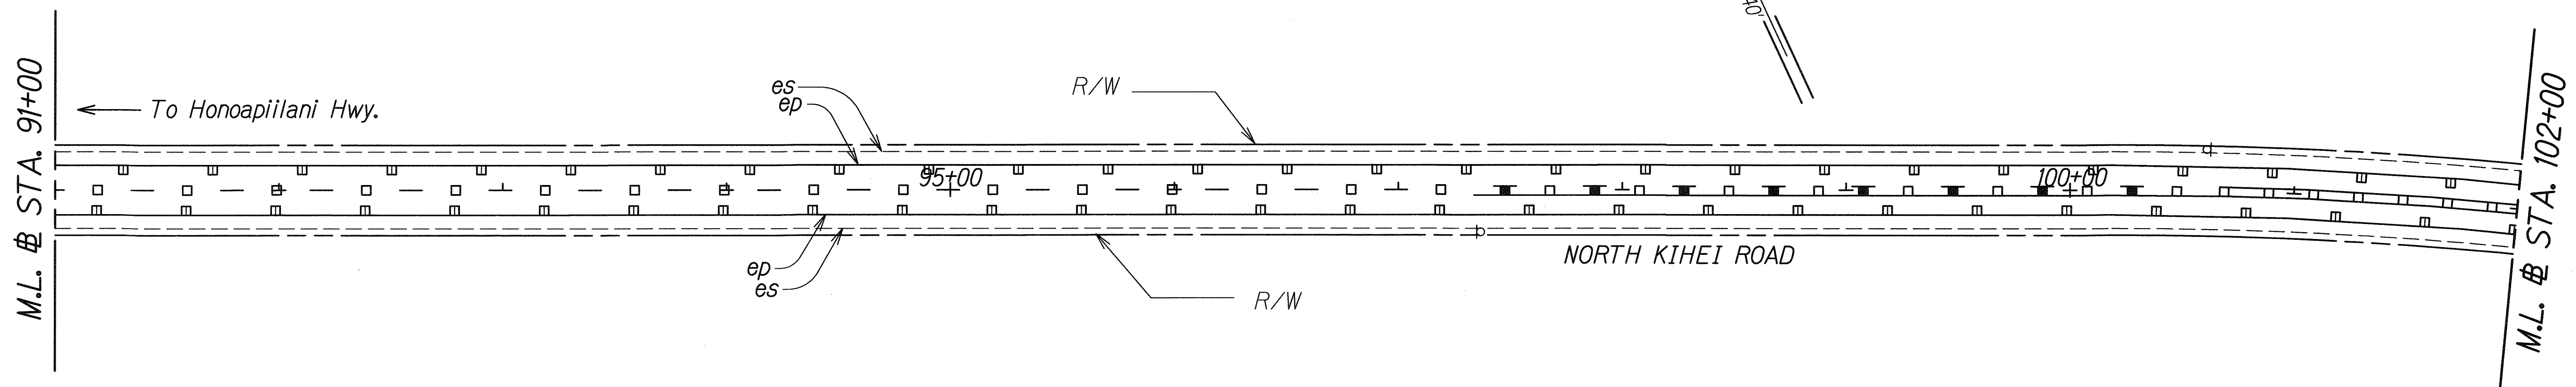

LEGEND FOR
AS-BUILT POSTINGS

Squiggly line for as-built deletion

Double line for as-built deletion

Roadway Text for as-built posting

STATE OF HAWAII
DEPARTMENT OF TRANSPORTATION
HIGHWAYS DIVISION

PAVEMENT MARKING PLAN

**NORTH KIHAI ROAD PAVEMENT
PREVENTIVE MAINTENANCE**

*Honoapiilani Highway to Piilani Highway
Federal-Aid Project No. STP-0310(4)*


Scale: 1" = 40' Date: August, 2007

SHEET No. 8 OF 9 SHEETS

ORIGINAL PLAN	DATE
NOTED	Aug. 07
DRAWN BY	
DESIGNED BY	
CHECKED BY	
APPROVED BY	

"AS-BUILT"

FED. ROAD DIST. NO.	STATE	FED. AID PROJ. NO.	FISCAL YEAR	SHEET NO.	TOTAL SHEETS
HAWAII	HAW.	STP-0310(4)	2007	24	24

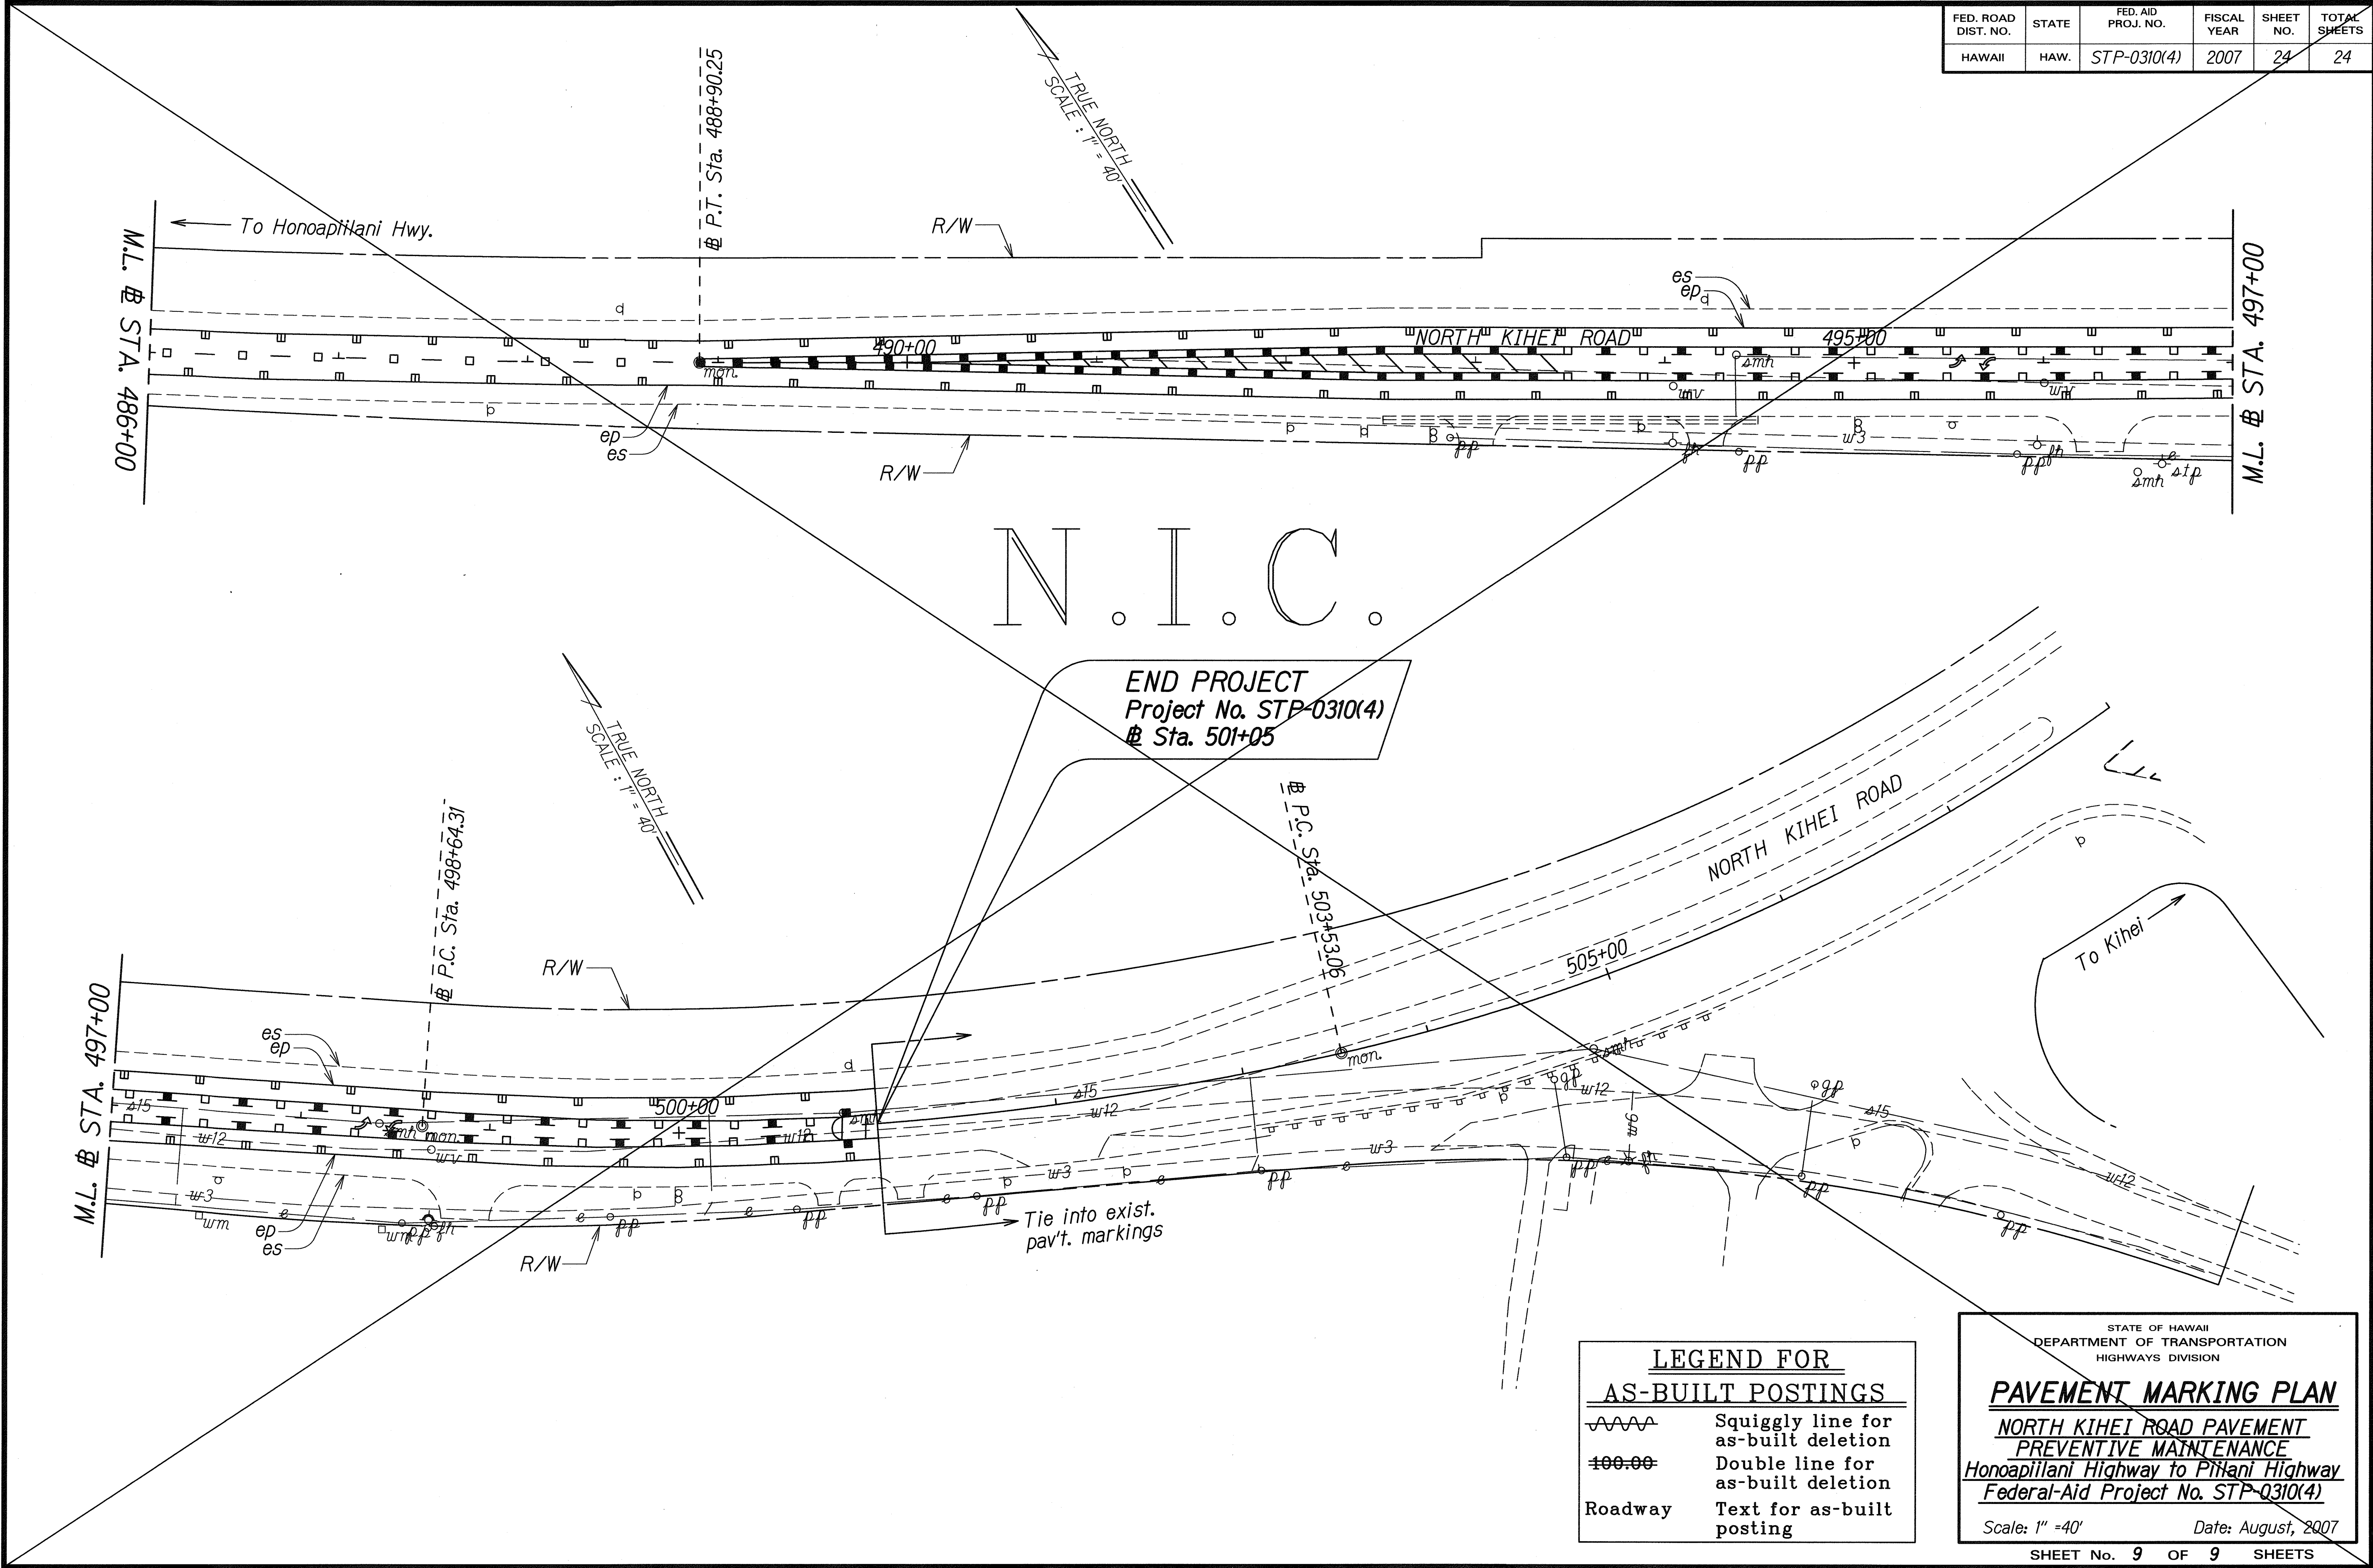

ORIGINAL PLAN	DATE
DESIGNED BY	2007.07
TRACED BY	
QUANTITIES BY	
CHECKED BY	

"AS-BUILT"