


FED. ROAD DIST. NO.	STATE	FED. AID PROJ. NO.	FISCAL YEAR	SHEET NO.	TOTAL SHEETS
HAWAII	HAW.	STP-0310(4)	2007	7	24

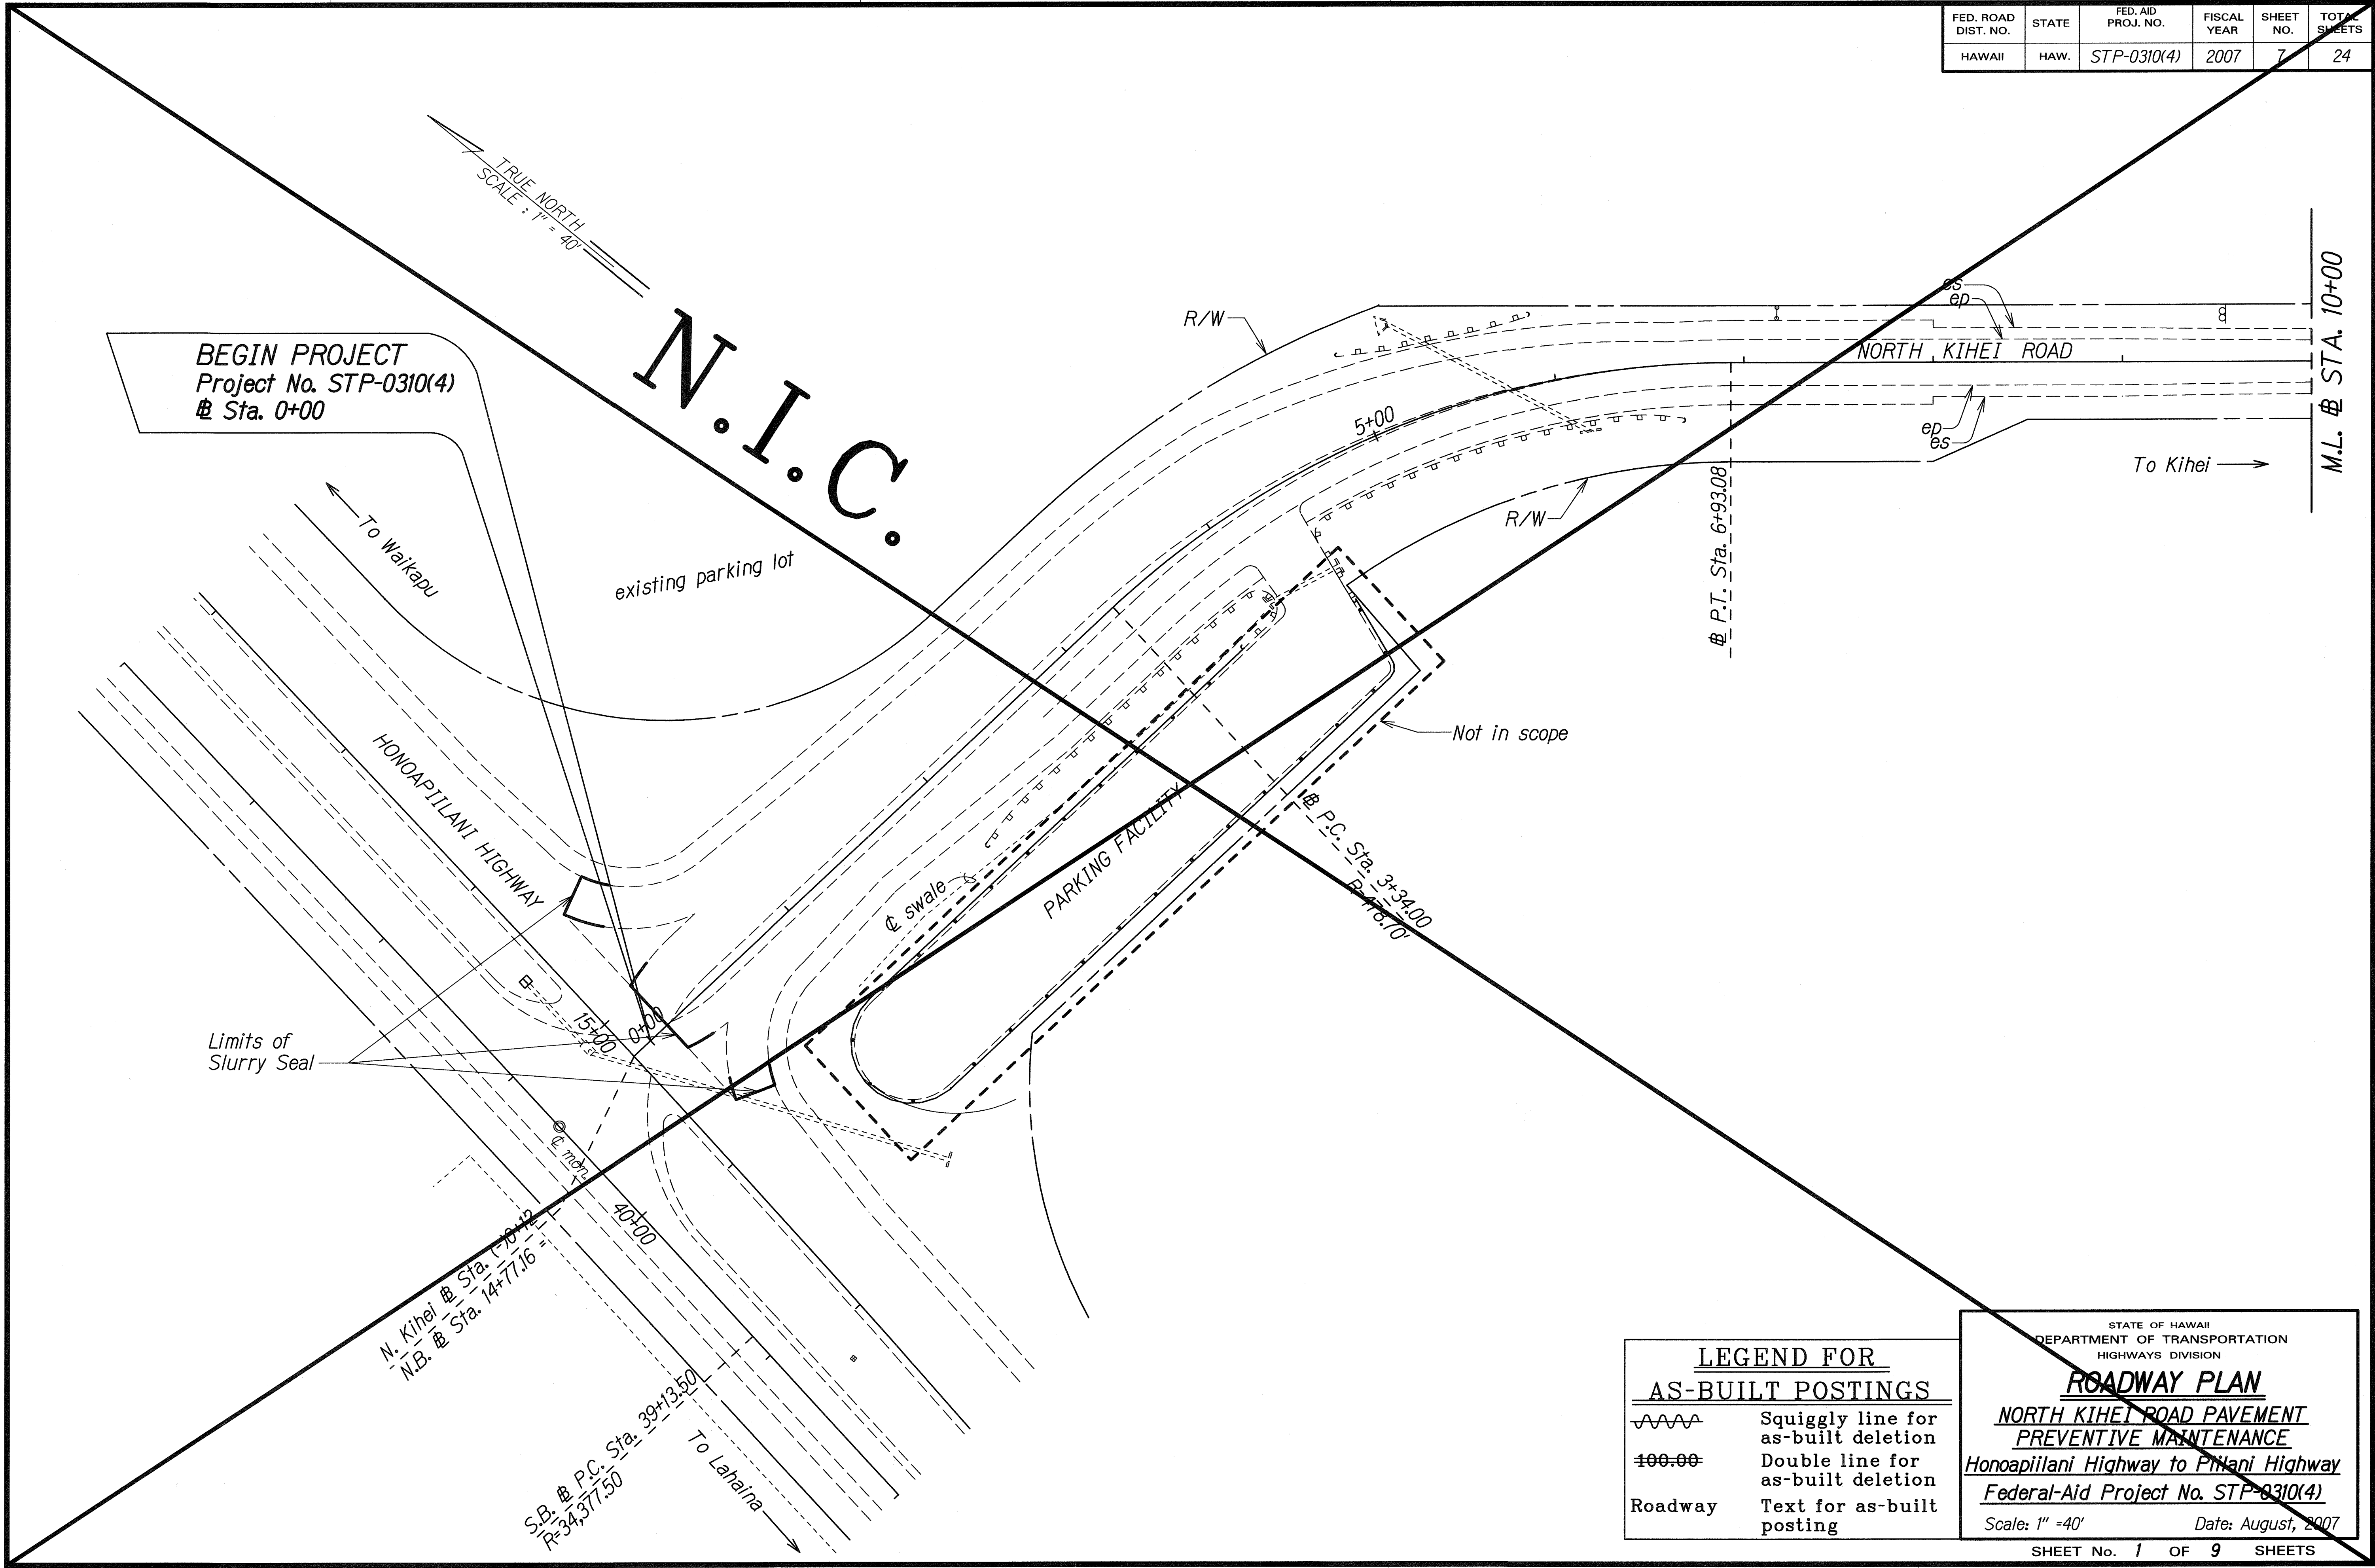

ORIGINAL PLAN	DATE
DESIGNED BY	DATE
CHECKED BY	DATE
NOTED BY	DATE
QUANTITIES BY	DATE
REVISIONS	DATE

LEGEND FOR AS-BUILT POSTINGS	
	Squiggly line for as-built deletion
	Double line for as-built deletion
Roadway	Text for as-built posting

STATE OF HAWAII
DEPARTMENT OF TRANSPORTATION
HIGHWAYS DIVISION

ROADWAY PLAN

NORTH KIHAI ROAD PAVEMENT PREVENTIVE MAINTENANCE


Honoapiilani Highway to Pihani Highway

Federal-Aid Project No. STP-0310(4)

Scale: 1" = 40' Date: August, 2007

"AS-BUILT"

FED. ROAD DIST. NO.	STATE	FED. AID PROJ. NO.	FISCAL YEAR	SHEET NO.	TOTAL SHEETS
HAWAII	HAW.	STP-0310(4)	2007	8	24

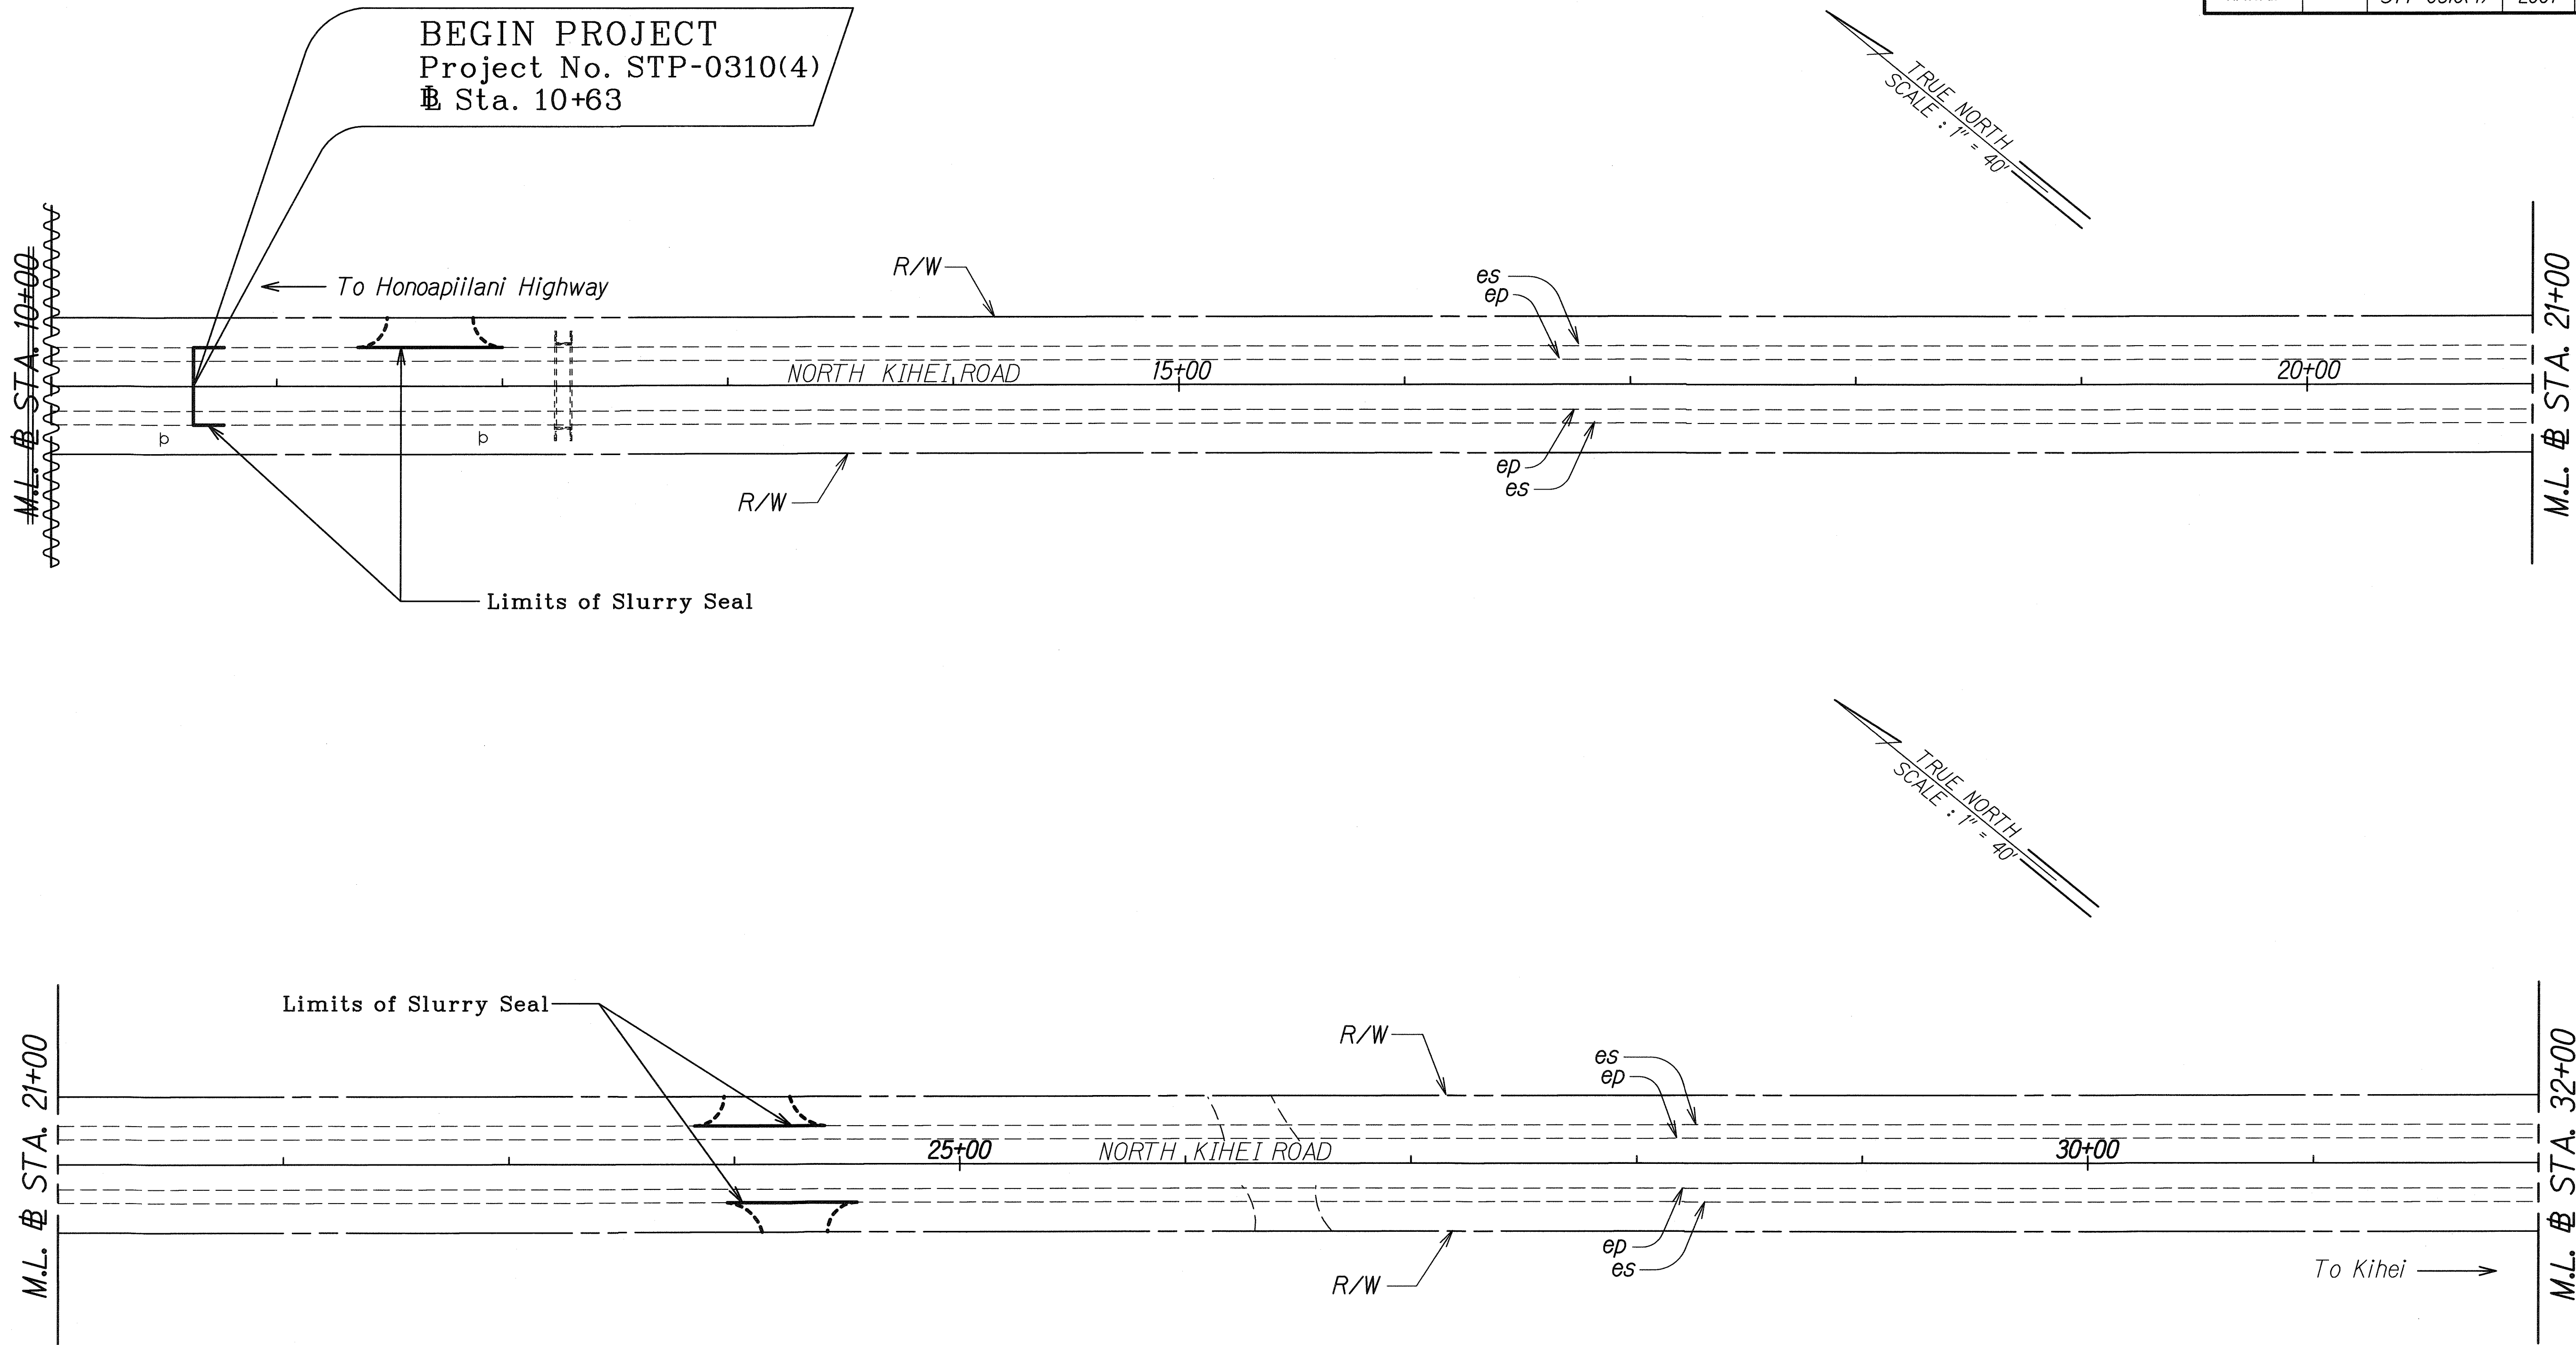


ORIGINAL PLAN	SURVEY PLOTTED BY	DATE
NOTE BOOK	DRAWN BY	Aug. 07
DESIGNED BY	TRACED BY	
QUANTITIES BY	CHECKED BY	

LEGEND FOR AS-BUILT POSTINGS	
	Squiggly line for as-built deletion
	Double line for as-built deletion
Roadway	Text for as-built posting

STATE OF HAWAII DEPARTMENT OF TRANSPORTATION HIGHWAYS DIVISION	
ROADWAY PLAN	
NORTH KIHAI ROAD PAVEMENT PREVENTIVE MAINTENANCE	
<i>Honoapiilani Highway to Pillani Highway</i>	
<i>Federal-Aid Project No. STP-0310(4)</i>	
Scale: 1" = 40'	Date: August, 2007

FED. ROAD DIST. NO.	STATE	FED. AID PROJ. NO.	FISCAL YEAR	SHEET NO.	TOTAL SHEETS
HAWAII	HAW.	STP-0310(4)	2007	9	24

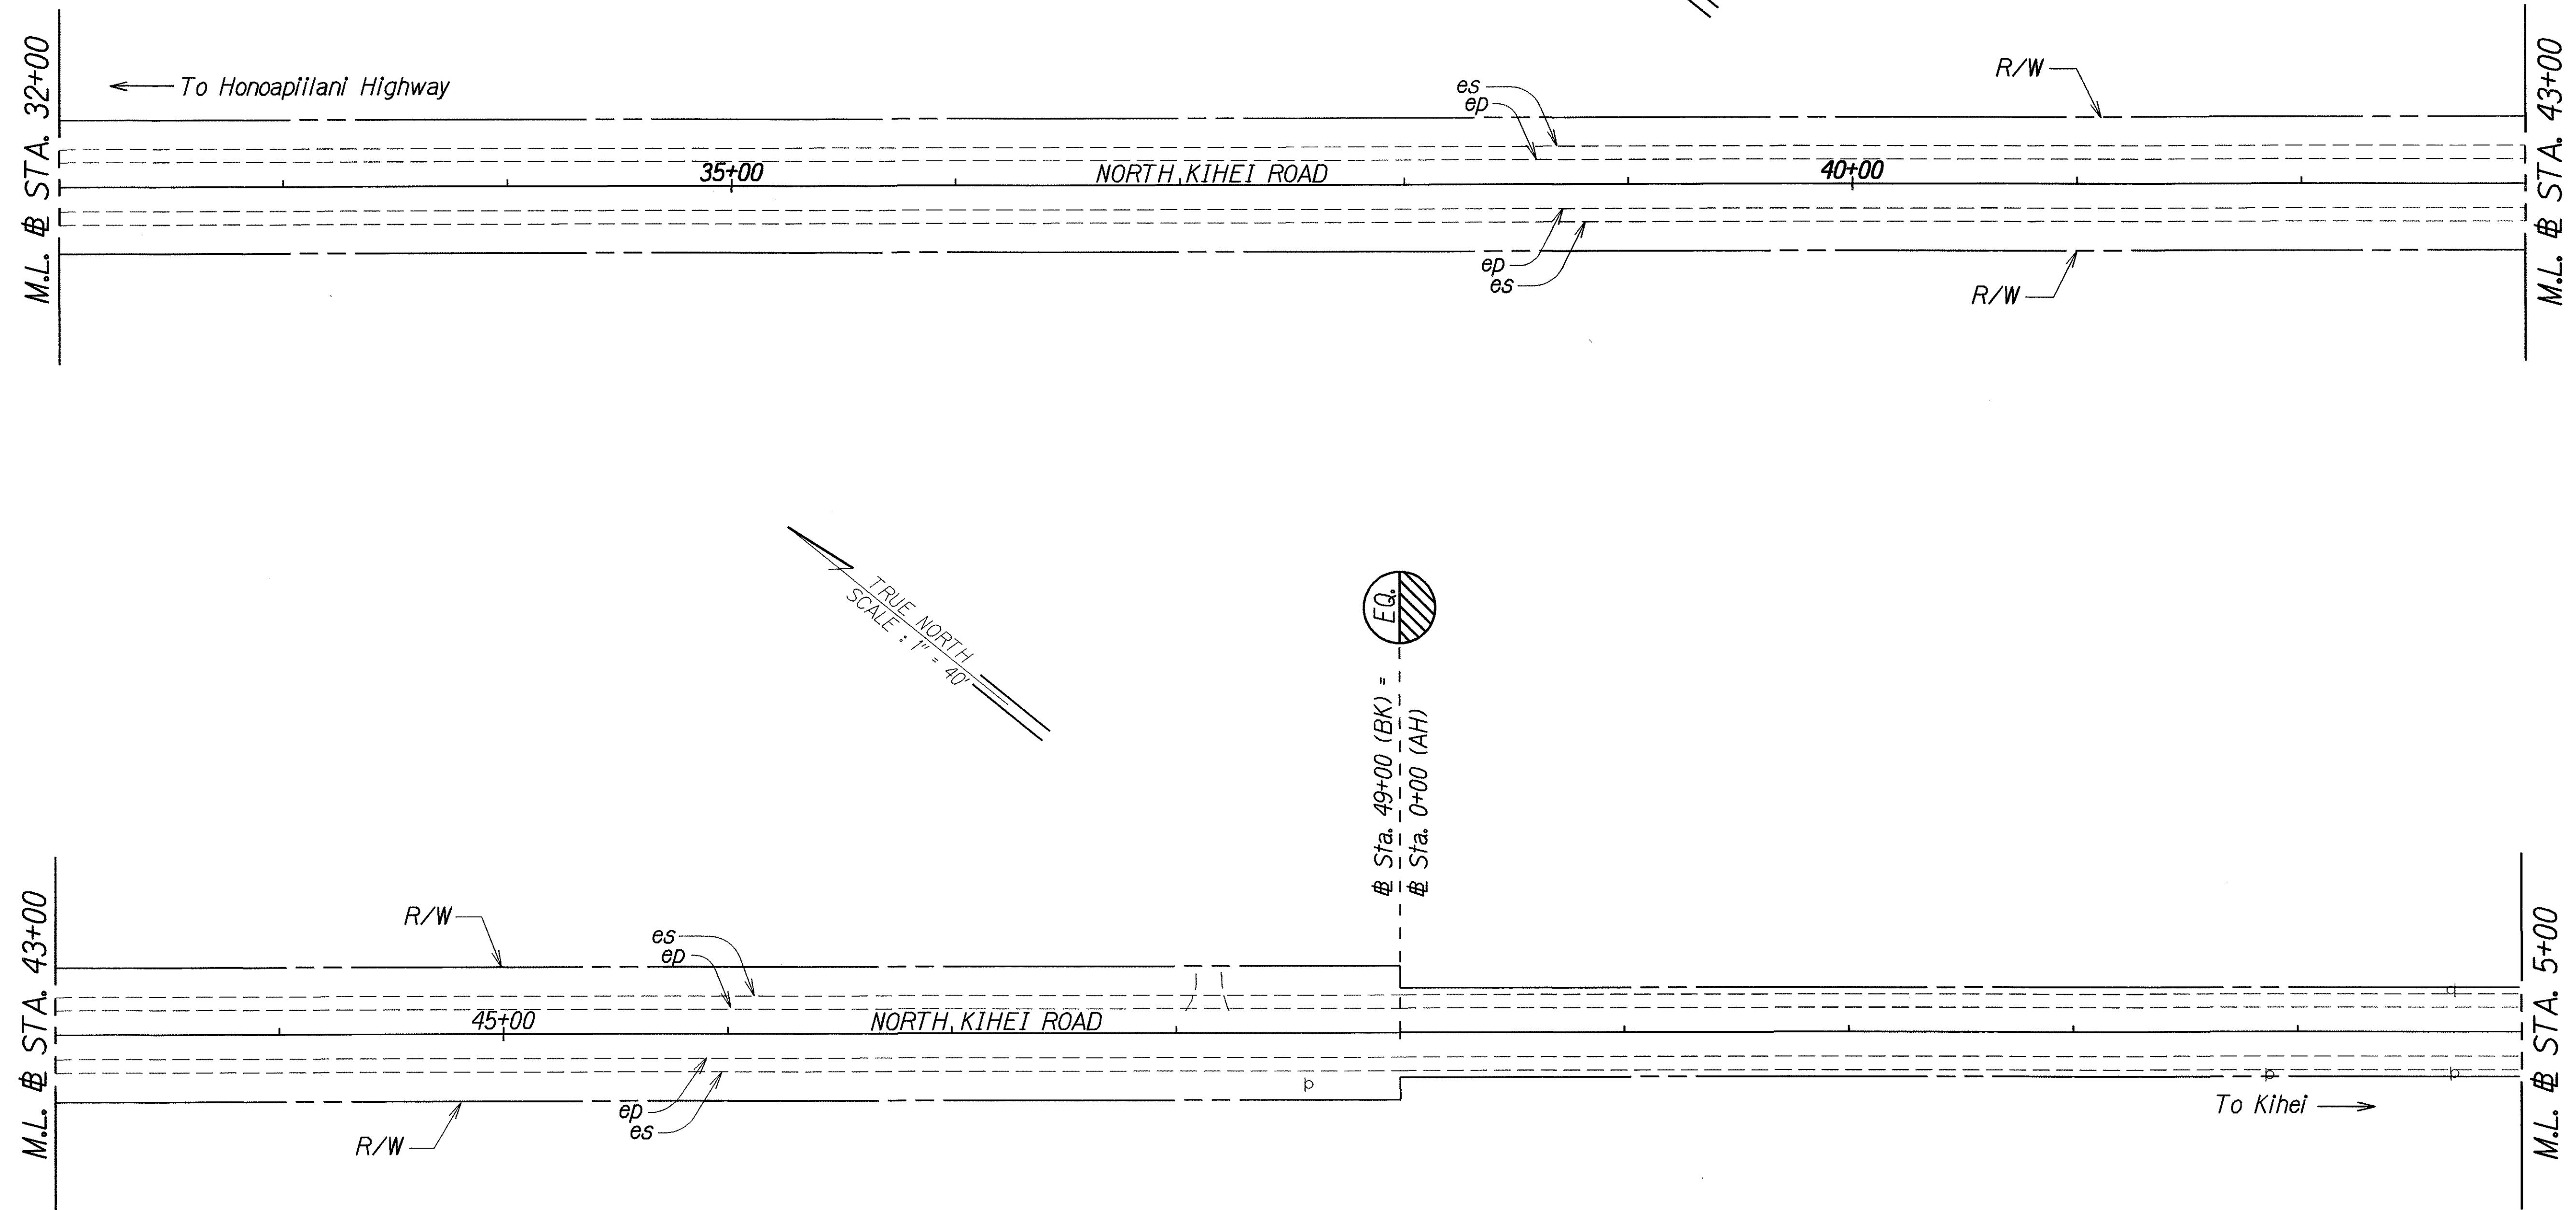

ORIGINAL PLAN	SURVEY PLOTTED BY	DATE
NOTE BOOK	DRAWN BY J.C.	AUG. 07
DESIGNED BY J.S.	CHECKED BY	
BY		


STATE OF HAWAII
DEPARTMENT OF TRANSPORTATION
HIGHWAYS DIVISION

ROADWAY PLAN
NORTH KIHEI ROAD PAVEMENT
PREVENTIVE MAINTENANCE
Honoapiilani Highway to Piilani Highway
Federal-Aid Project No. STP-0310(4)

Scale: 1" = 40' Date: August, 2007

SHEET No. 3 OF 9 SHEETS

FED. ROAD DIST. NO.	STATE	FED. AID PROJ. NO.	FISCAL YEAR	SHEET NO.	TOTAL SHEETS
HAWAII	HAW.	STP-0310(4)	2007	10	24

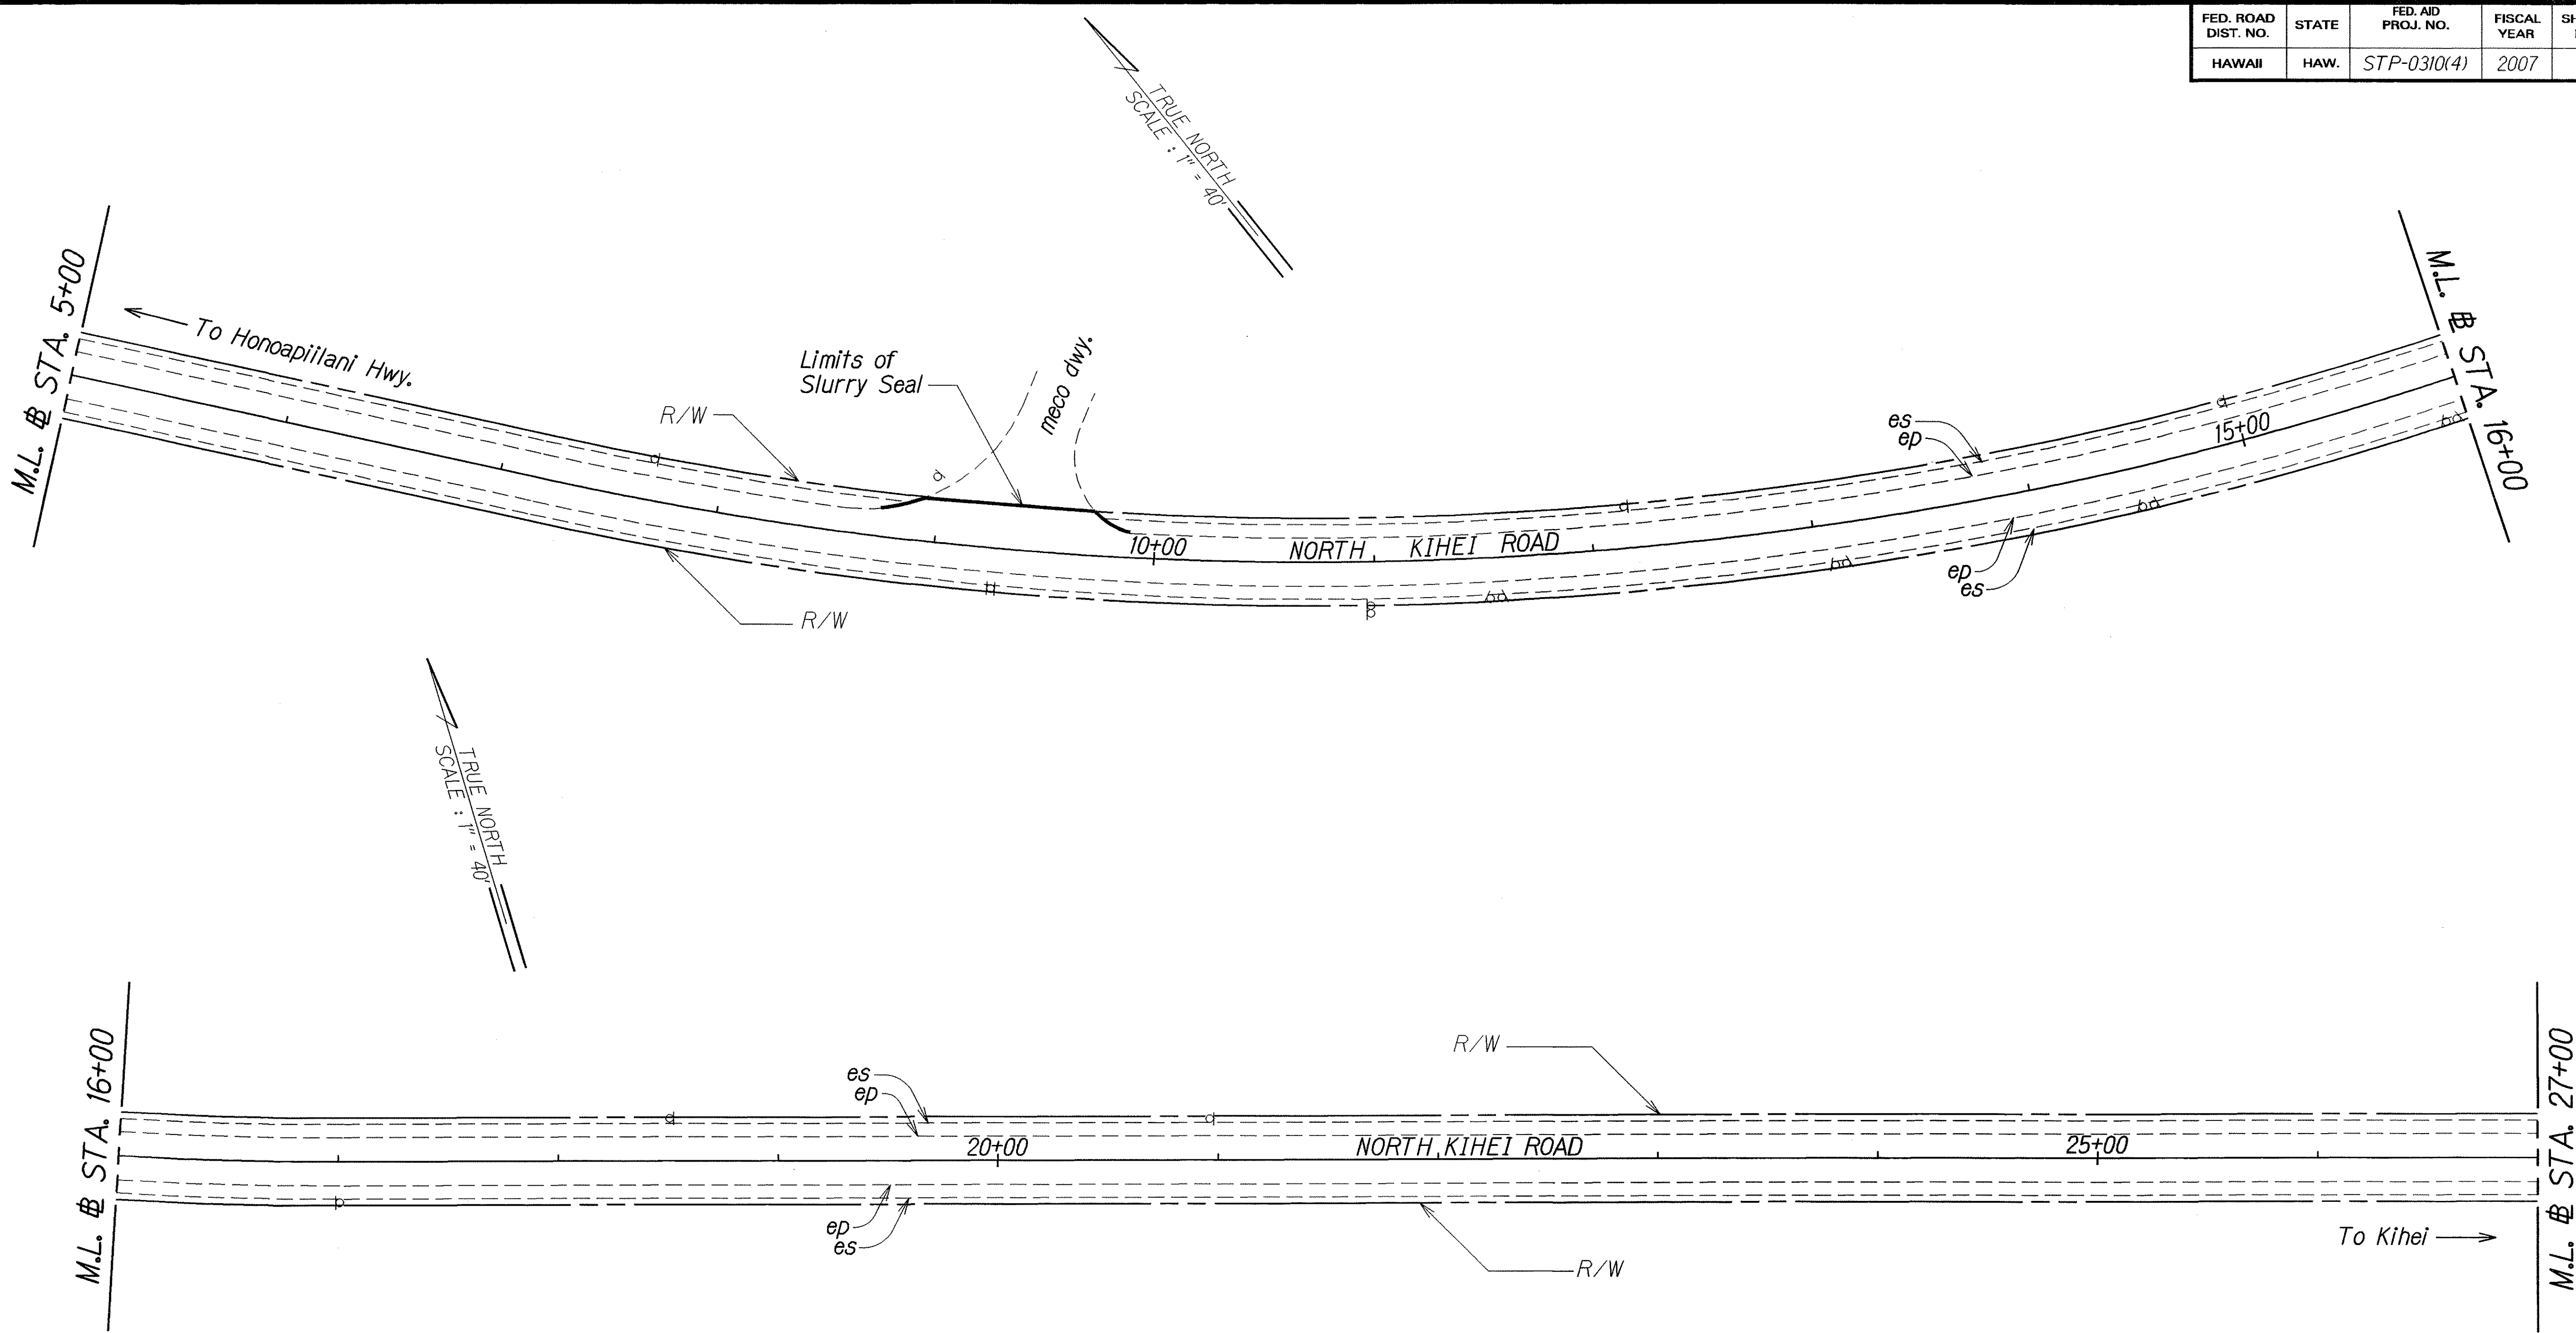

ORIGINAL PLAN	SURVEY PLOTTED BY	DATE
NOTE BOOK	DRAWN BY	2007
DESIGNED BY	TRACED BY	
CHECKED BY	DESIGNED BY	
	CHECKED BY	


STATE OF HAWAII
DEPARTMENT OF TRANSPORTATION
HIGHWAYS DIVISION

ROADWAY PLAN
NORTH KIHAI ROAD PAVEMENT PREVENTIVE MAINTENANCE
Honoapiilani Highway to Piilani Highway
Federal-Aid Project No. STP-0310(4)

Scale: 1" = 40' Date: August, 2007

SHEET No. 4 OF 9 SHEETS

FED. ROAD DIST. NO.	STATE	FED. AID PROJ. NO.	FISCAL YEAR	SHEET NO.	TOTAL SHEETS
HAWAII	HAW.	STP-0310(4)	2007	11	24

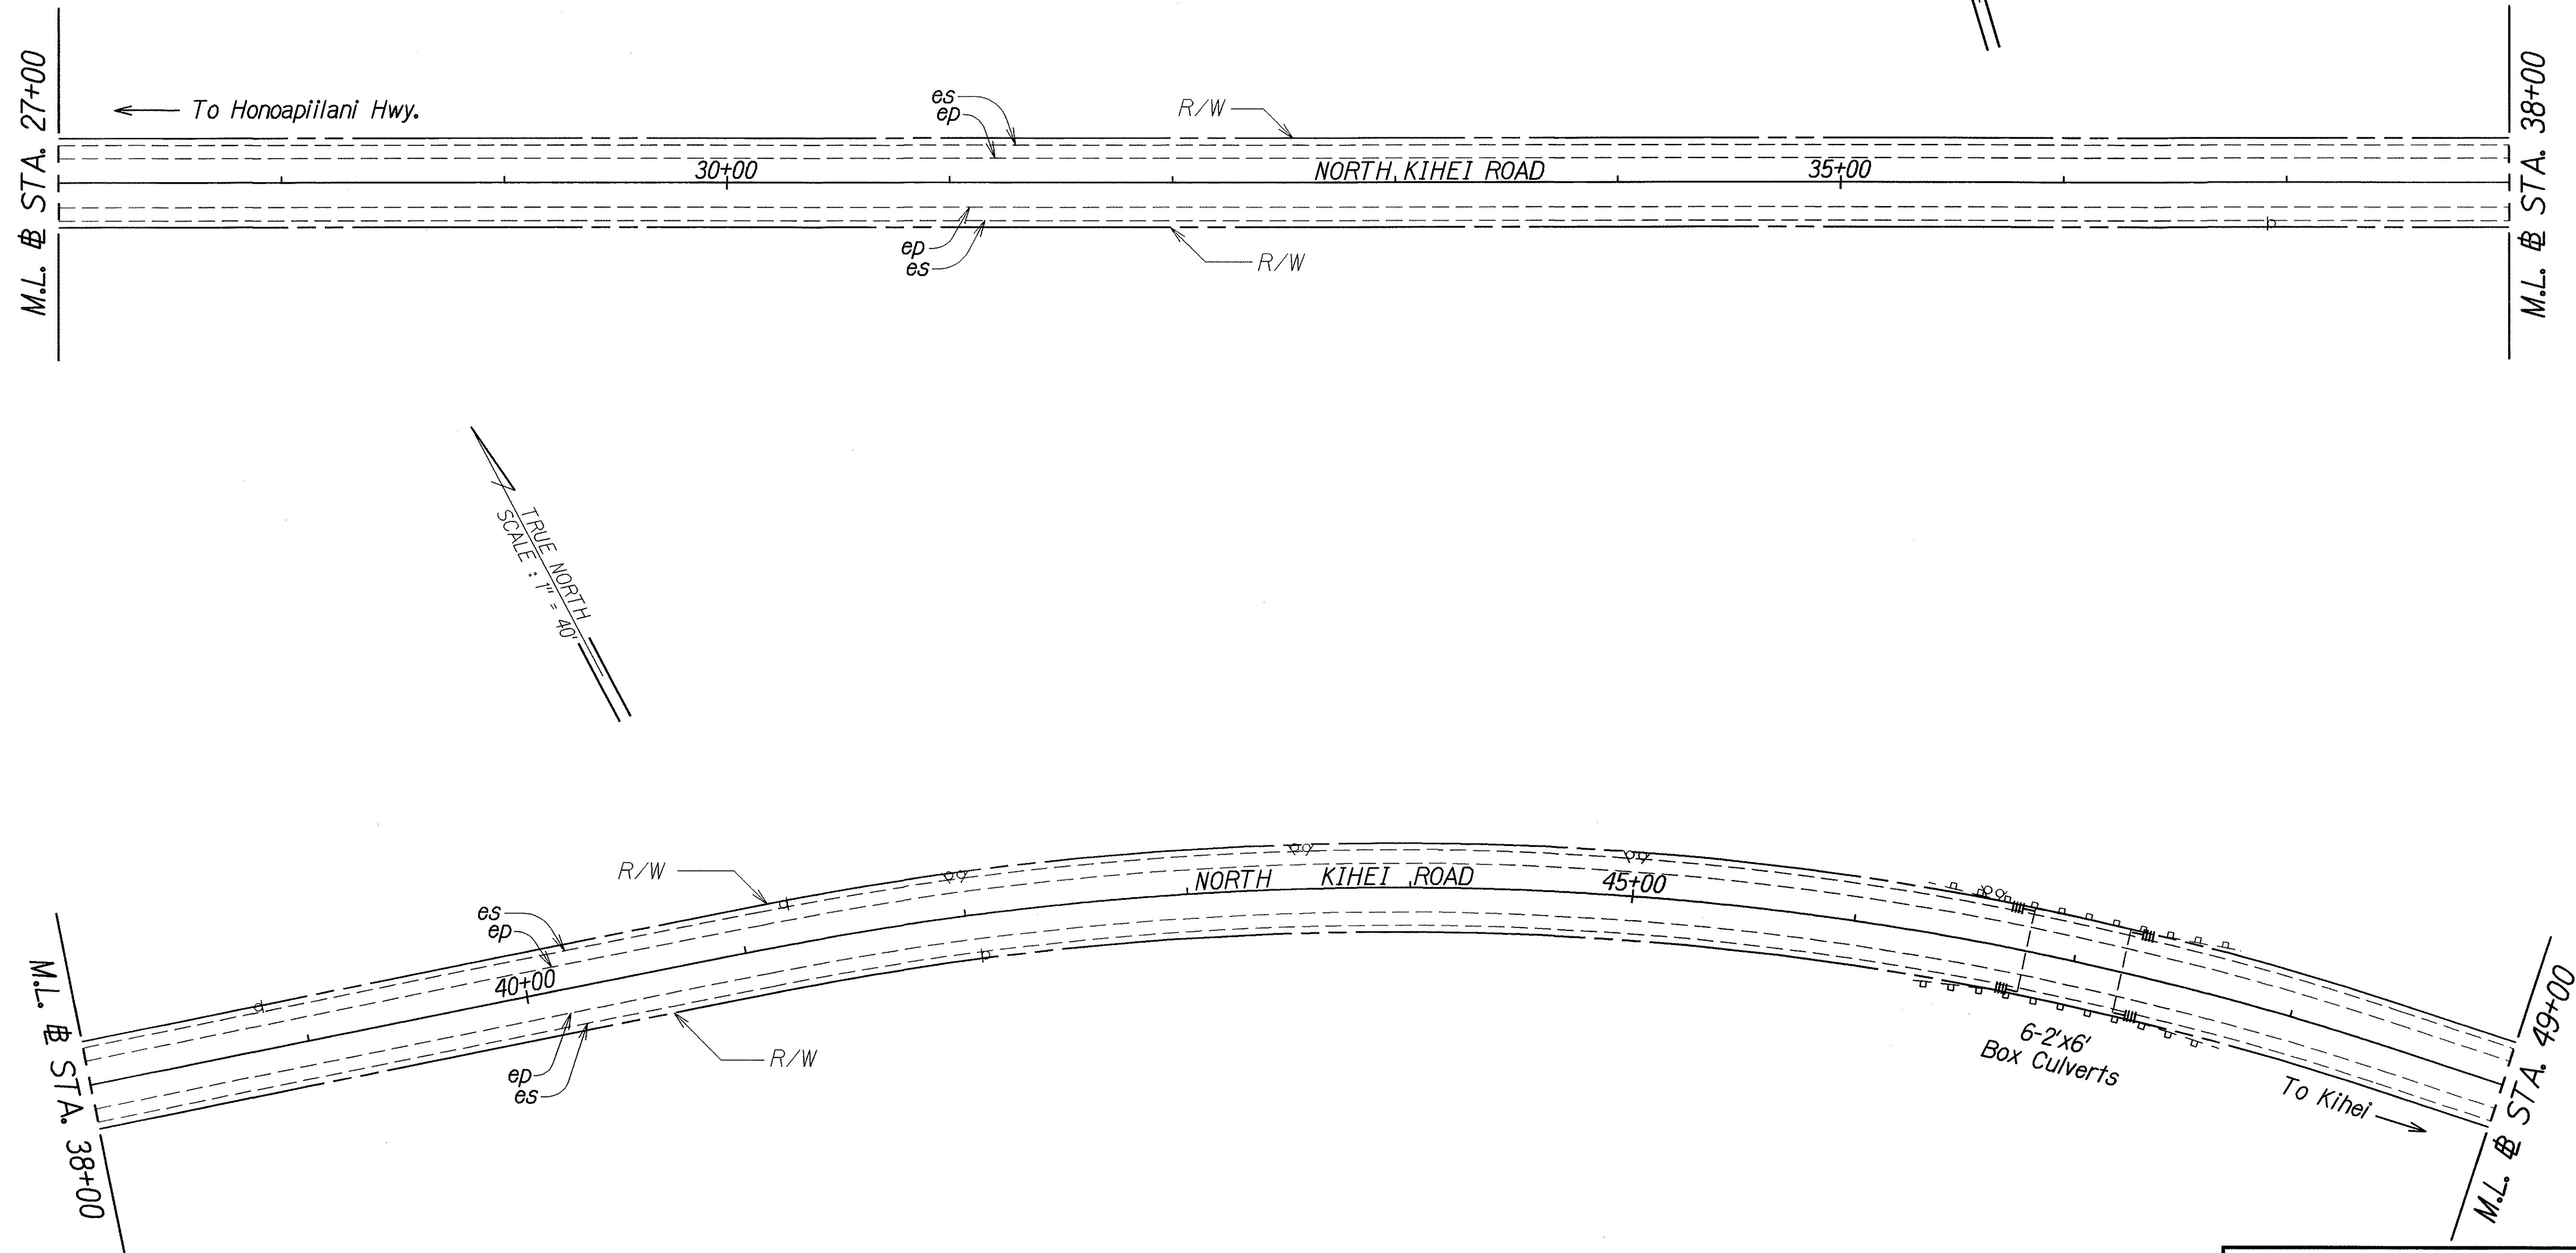

ORIGINAL PLAN	SURVEY PLOTTED BY	DATE
NOTE BOOK	DRAWN BY	aug. 07
mel/ey	TRACED BY	
841010025002	QUANTITIES BY	
	CHECKED BY	


STATE OF HAWAII
DEPARTMENT OF TRANSPORTATION
HIGHWAYS DIVISION

ROADWAY PLAN
**NORTH KIHAI ROAD PAVEMENT
PREVENTIVE MAINTENANCE**
Honoapiilani Highway to Piilani Highway
Federal-Aid Project No. STP-0310(4)

Scale: 1" = 40' Date: August, 2007

SHEET No. 5 OF 9 SHEETS

FED. ROAD DIST. NO.	STATE	FED. AID PROJ. NO.	FISCAL YEAR	SHEET NO.	TOTAL SHEETS
HAWAII	HAW.	STP-0310(4)	2007	12	24

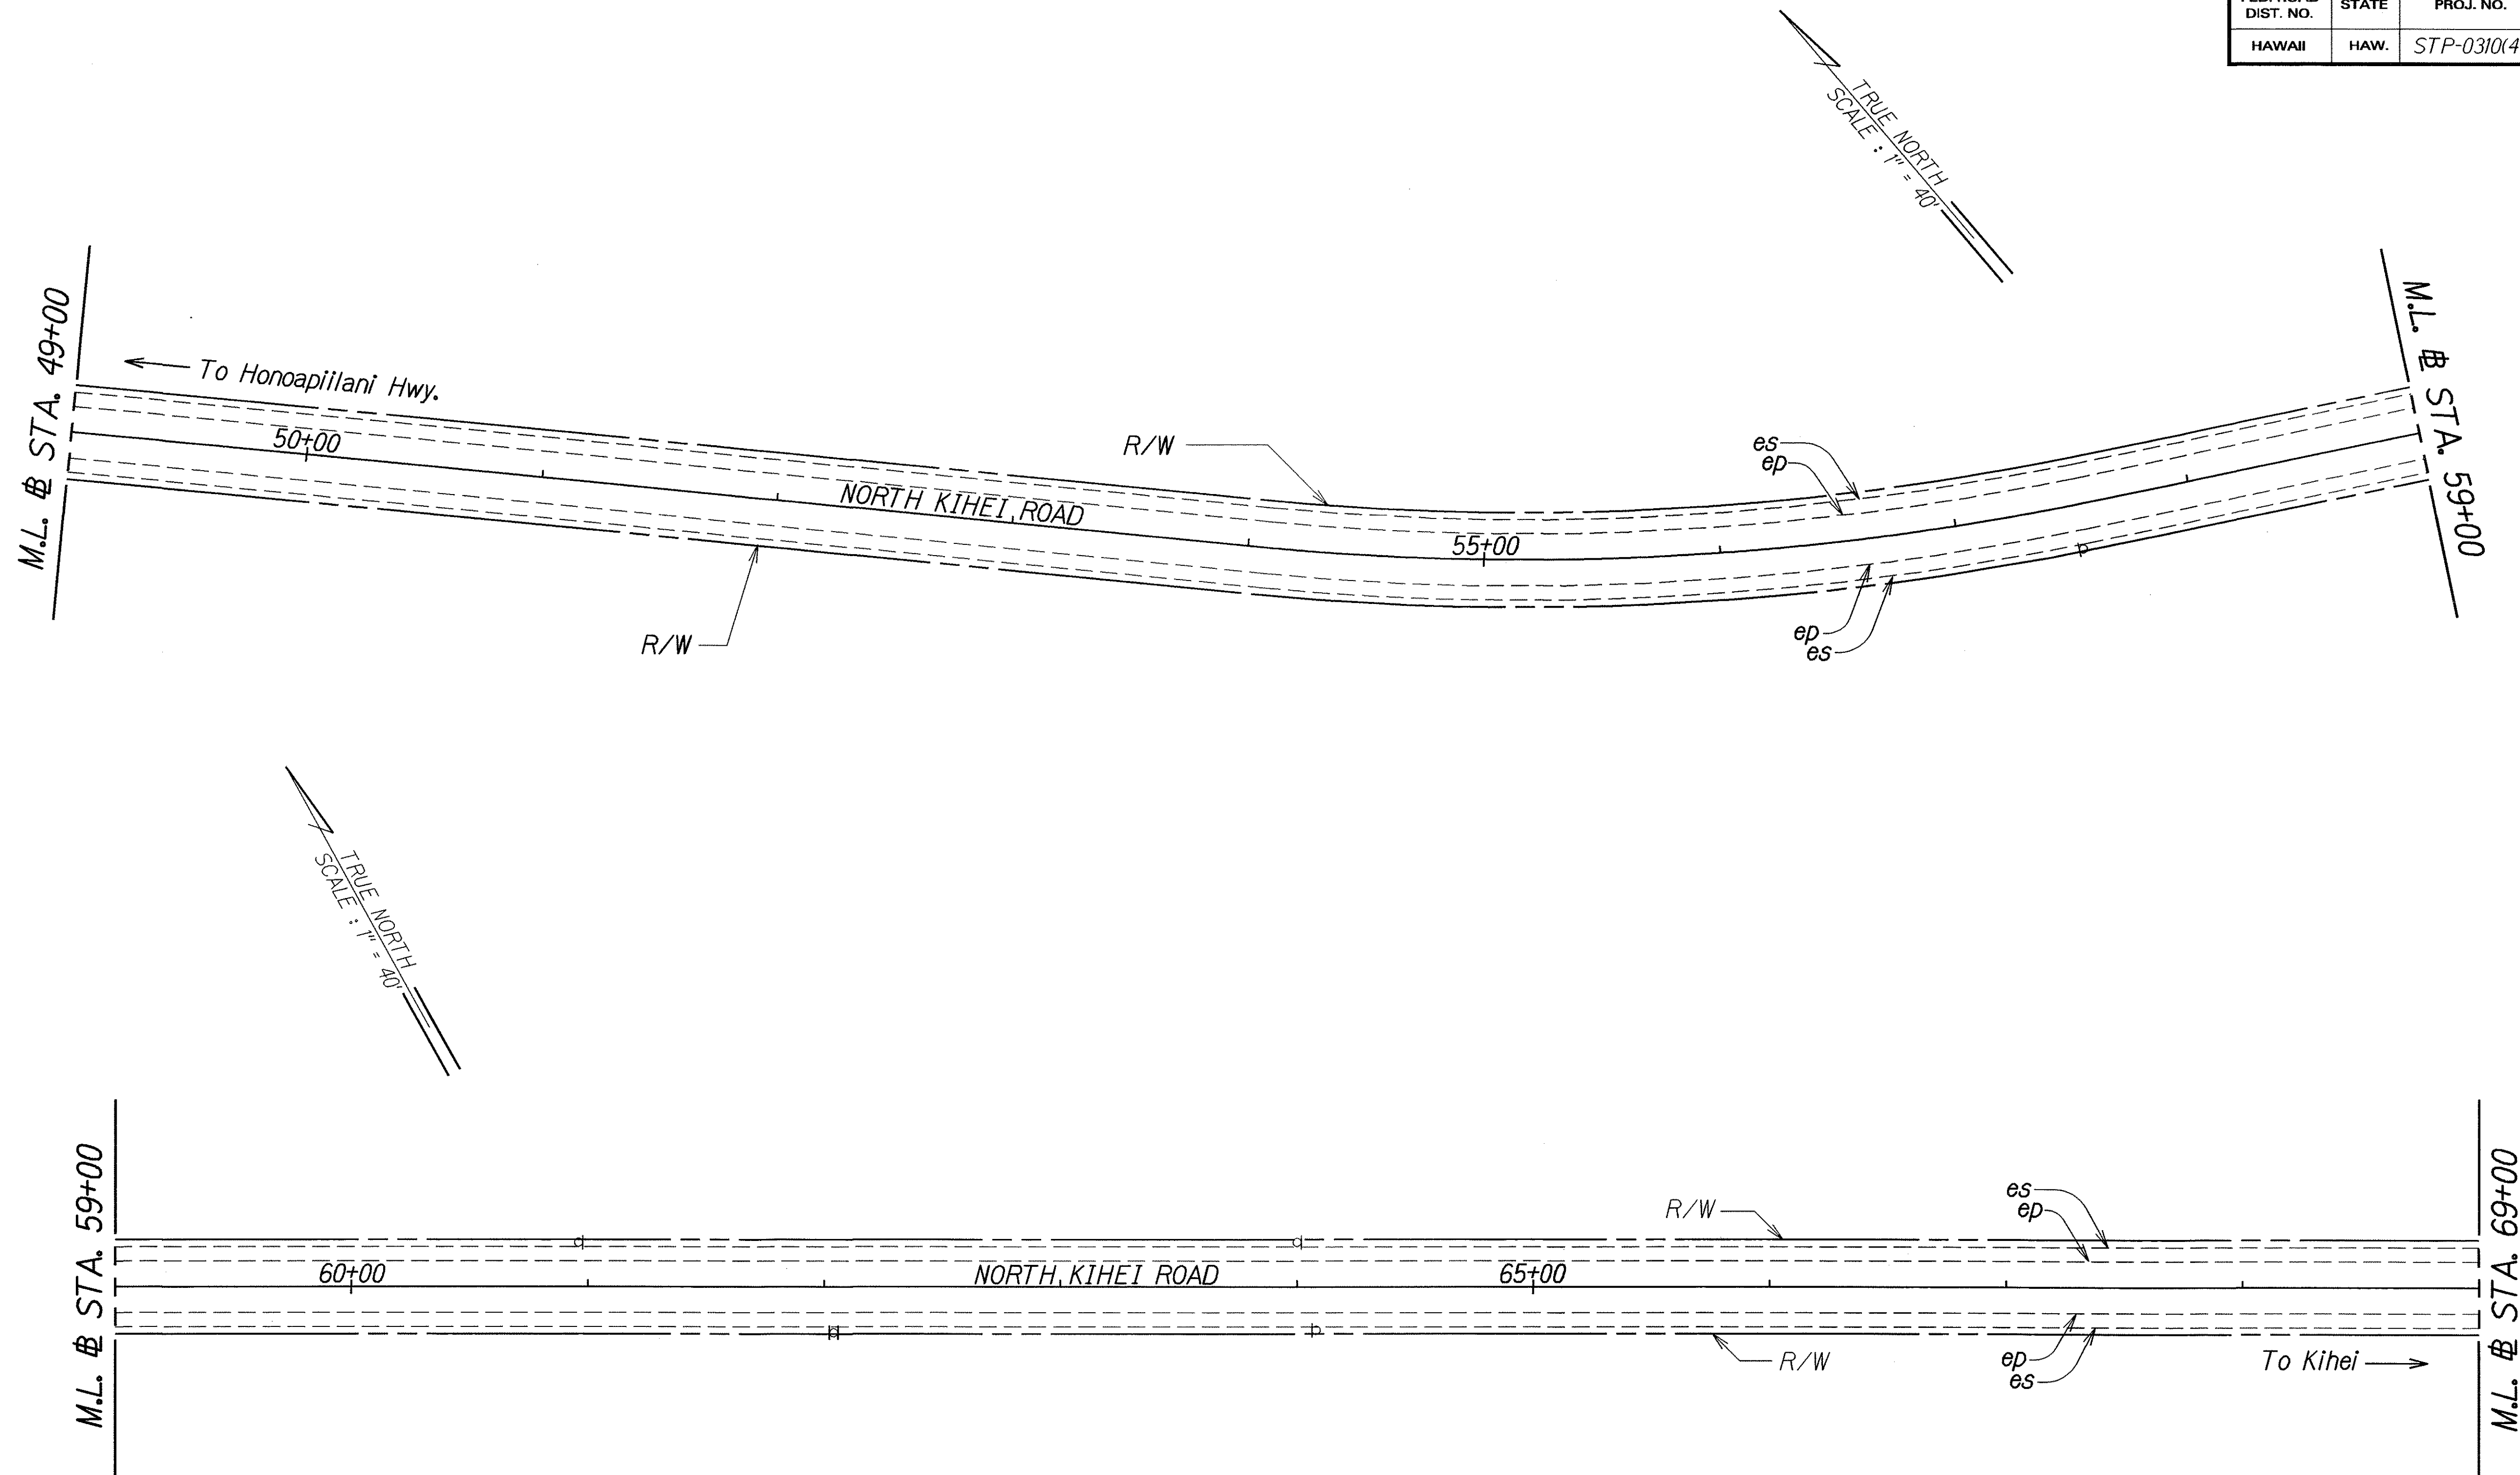

ORIGINAL PLAN	SURVEY PLOTTED BY	DATE
NOTE BOOK	DRAWN BY	8/10/07
DESIGNED BY	CHECKED BY	
BY		
CHECKED BY		

STATE OF HAWAII
DEPARTMENT OF TRANSPORTATION
HIGHWAYS DIVISION

ROADWAY PLAN



**NORTH KIHAI ROAD PAVEMENT
PREVENTIVE MAINTENANCE**

Honoapiilani Highway to Piilani Highway
Federal-Aid Project No. STP-0310(4)

Scale: 1" = 40' Date: August, 2007

SHEET No. 6 OF 9 SHEETS

FED. ROAD DIST. NO.	STATE	FED. AID PROJ. NO.	FISCAL YEAR	SHEET NO.	TOTAL SHEETS
HAWAII	HAW.	STP-0310(4)	2007	13	24

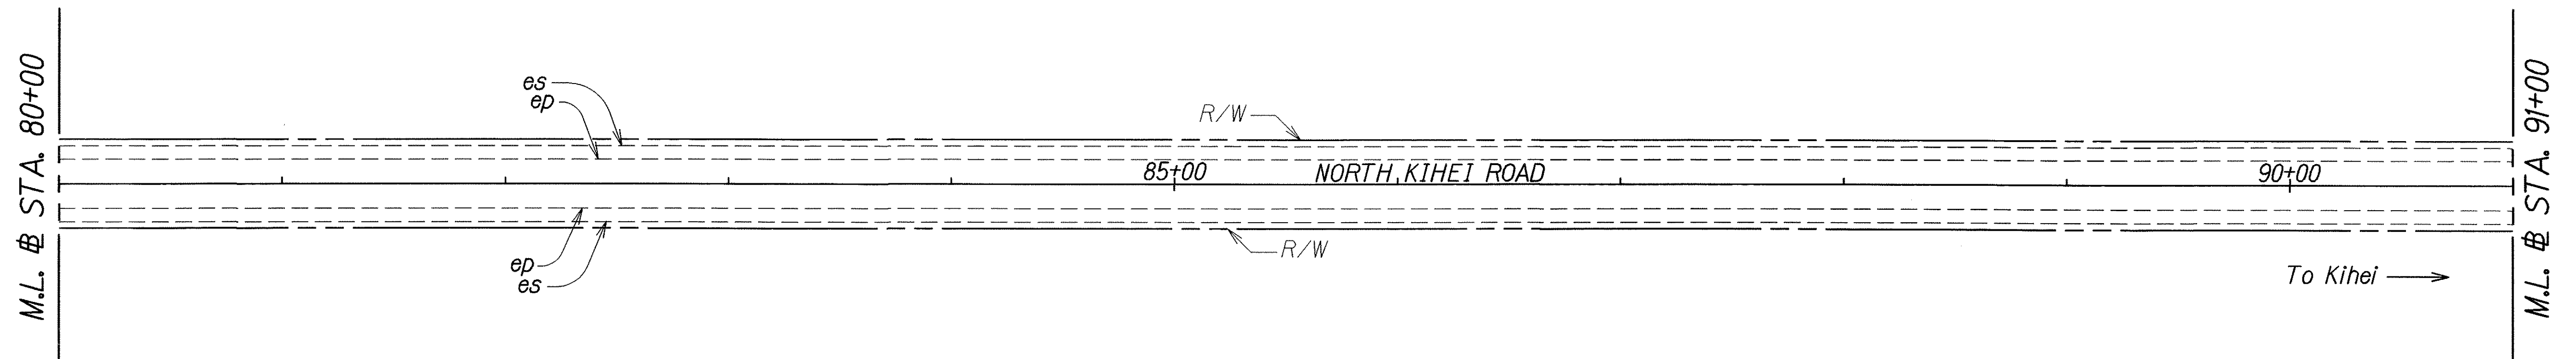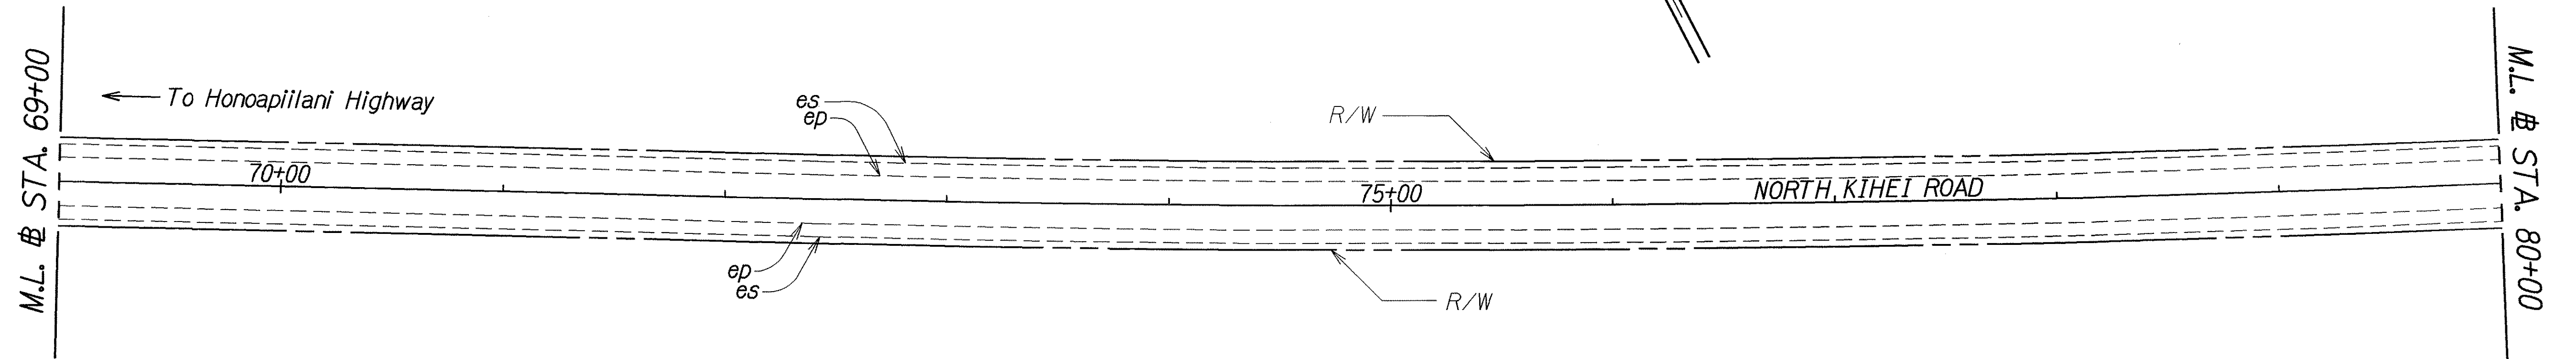

ORIGINAL PLAN	SURVEY PLOTTED BY	DATE
NOTED BY	DRAWN BY	AUG. 07
NOTED BY	CHECKED BY	
NOTED BY	CHECKED BY	


STATE OF HAWAII
DEPARTMENT OF TRANSPORTATION
HIGHWAYS DIVISION

ROADWAY PLAN
**NORTH KIHAI ROAD PAVEMENT
PREVENTIVE MAINTENANCE**
Honoapiilani Highway to Piilani Highway
Federal-Aid Project No. STP-0310(4)

Scale: 1" = 40' Date: August, 2007

SHEET No. 7 OF 9 SHEETS

FED. ROAD DIST. NO.	STATE	FED. AID PROJ. NO.	FISCAL YEAR	SHEET NO.	TOTAL SHEETS
HAWAII	HAW.	STP-0310(4)	2007	14	24

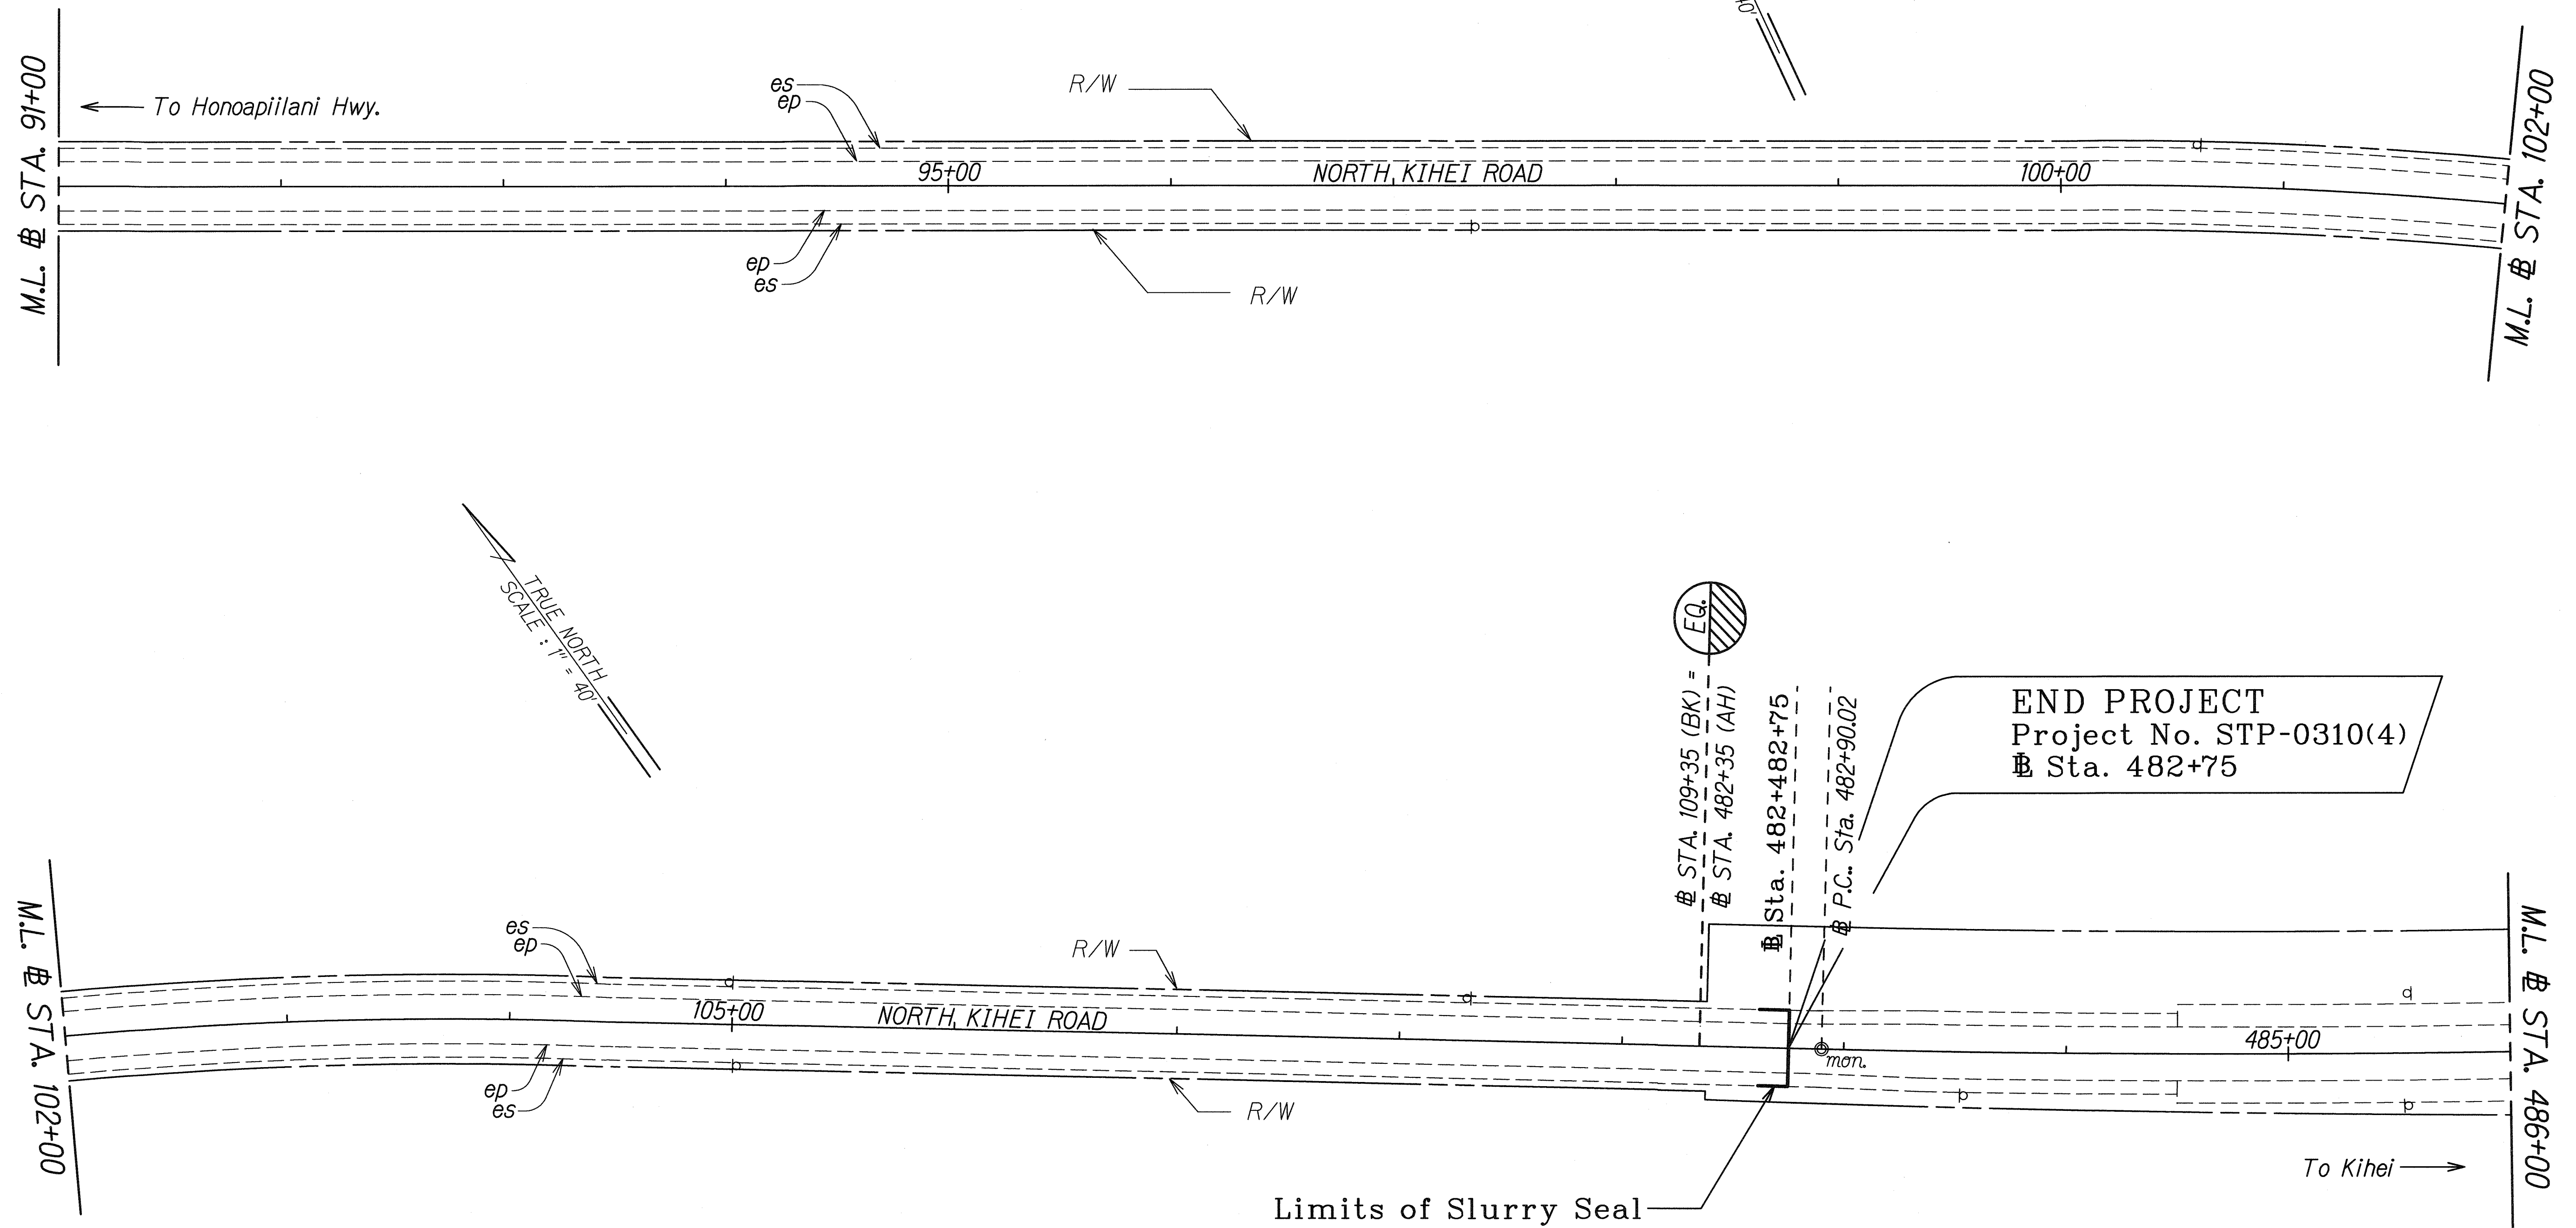

ORIGINAL PLAN	DATE
DESIGNED BY	DATE
CHECKED BY	DATE
NOTED BY	DATE
TRACED BY	DATE
DRAWN BY	DATE
SURVEY PLOTTED BY	DATE


LEGEND FOR AS-BUILT POSTINGS	
~~~~~	Squiggly line for as-built deletion
==	Double line for as-built deletion
Roadway	Text for as-built posting

STATE OF HAWAII DEPARTMENT OF TRANSPORTATION HIGHWAYS DIVISION
<b>ROADWAY PLAN</b>
<b>NORTH KIHAI ROAD PAVEMENT PREVENTIVE MAINTENANCE</b>
<b>Honoapiilani Highway to Pillani Highway</b>
<b>Federal-Aid Project No. STP-0310(4)</b>
Scale: 1" = 40' Date: August, 2007
SHEET No. 8 OF 9 SHEETS

"AS-BUILT"



FED. ROAD DIST. NO.	STATE	FED. AID PROJ. NO.	FISCAL YEAR	SHEET NO.	TOTAL SHEETS
HAWAII	HAW.	STP-0310(4)	2007	15	24

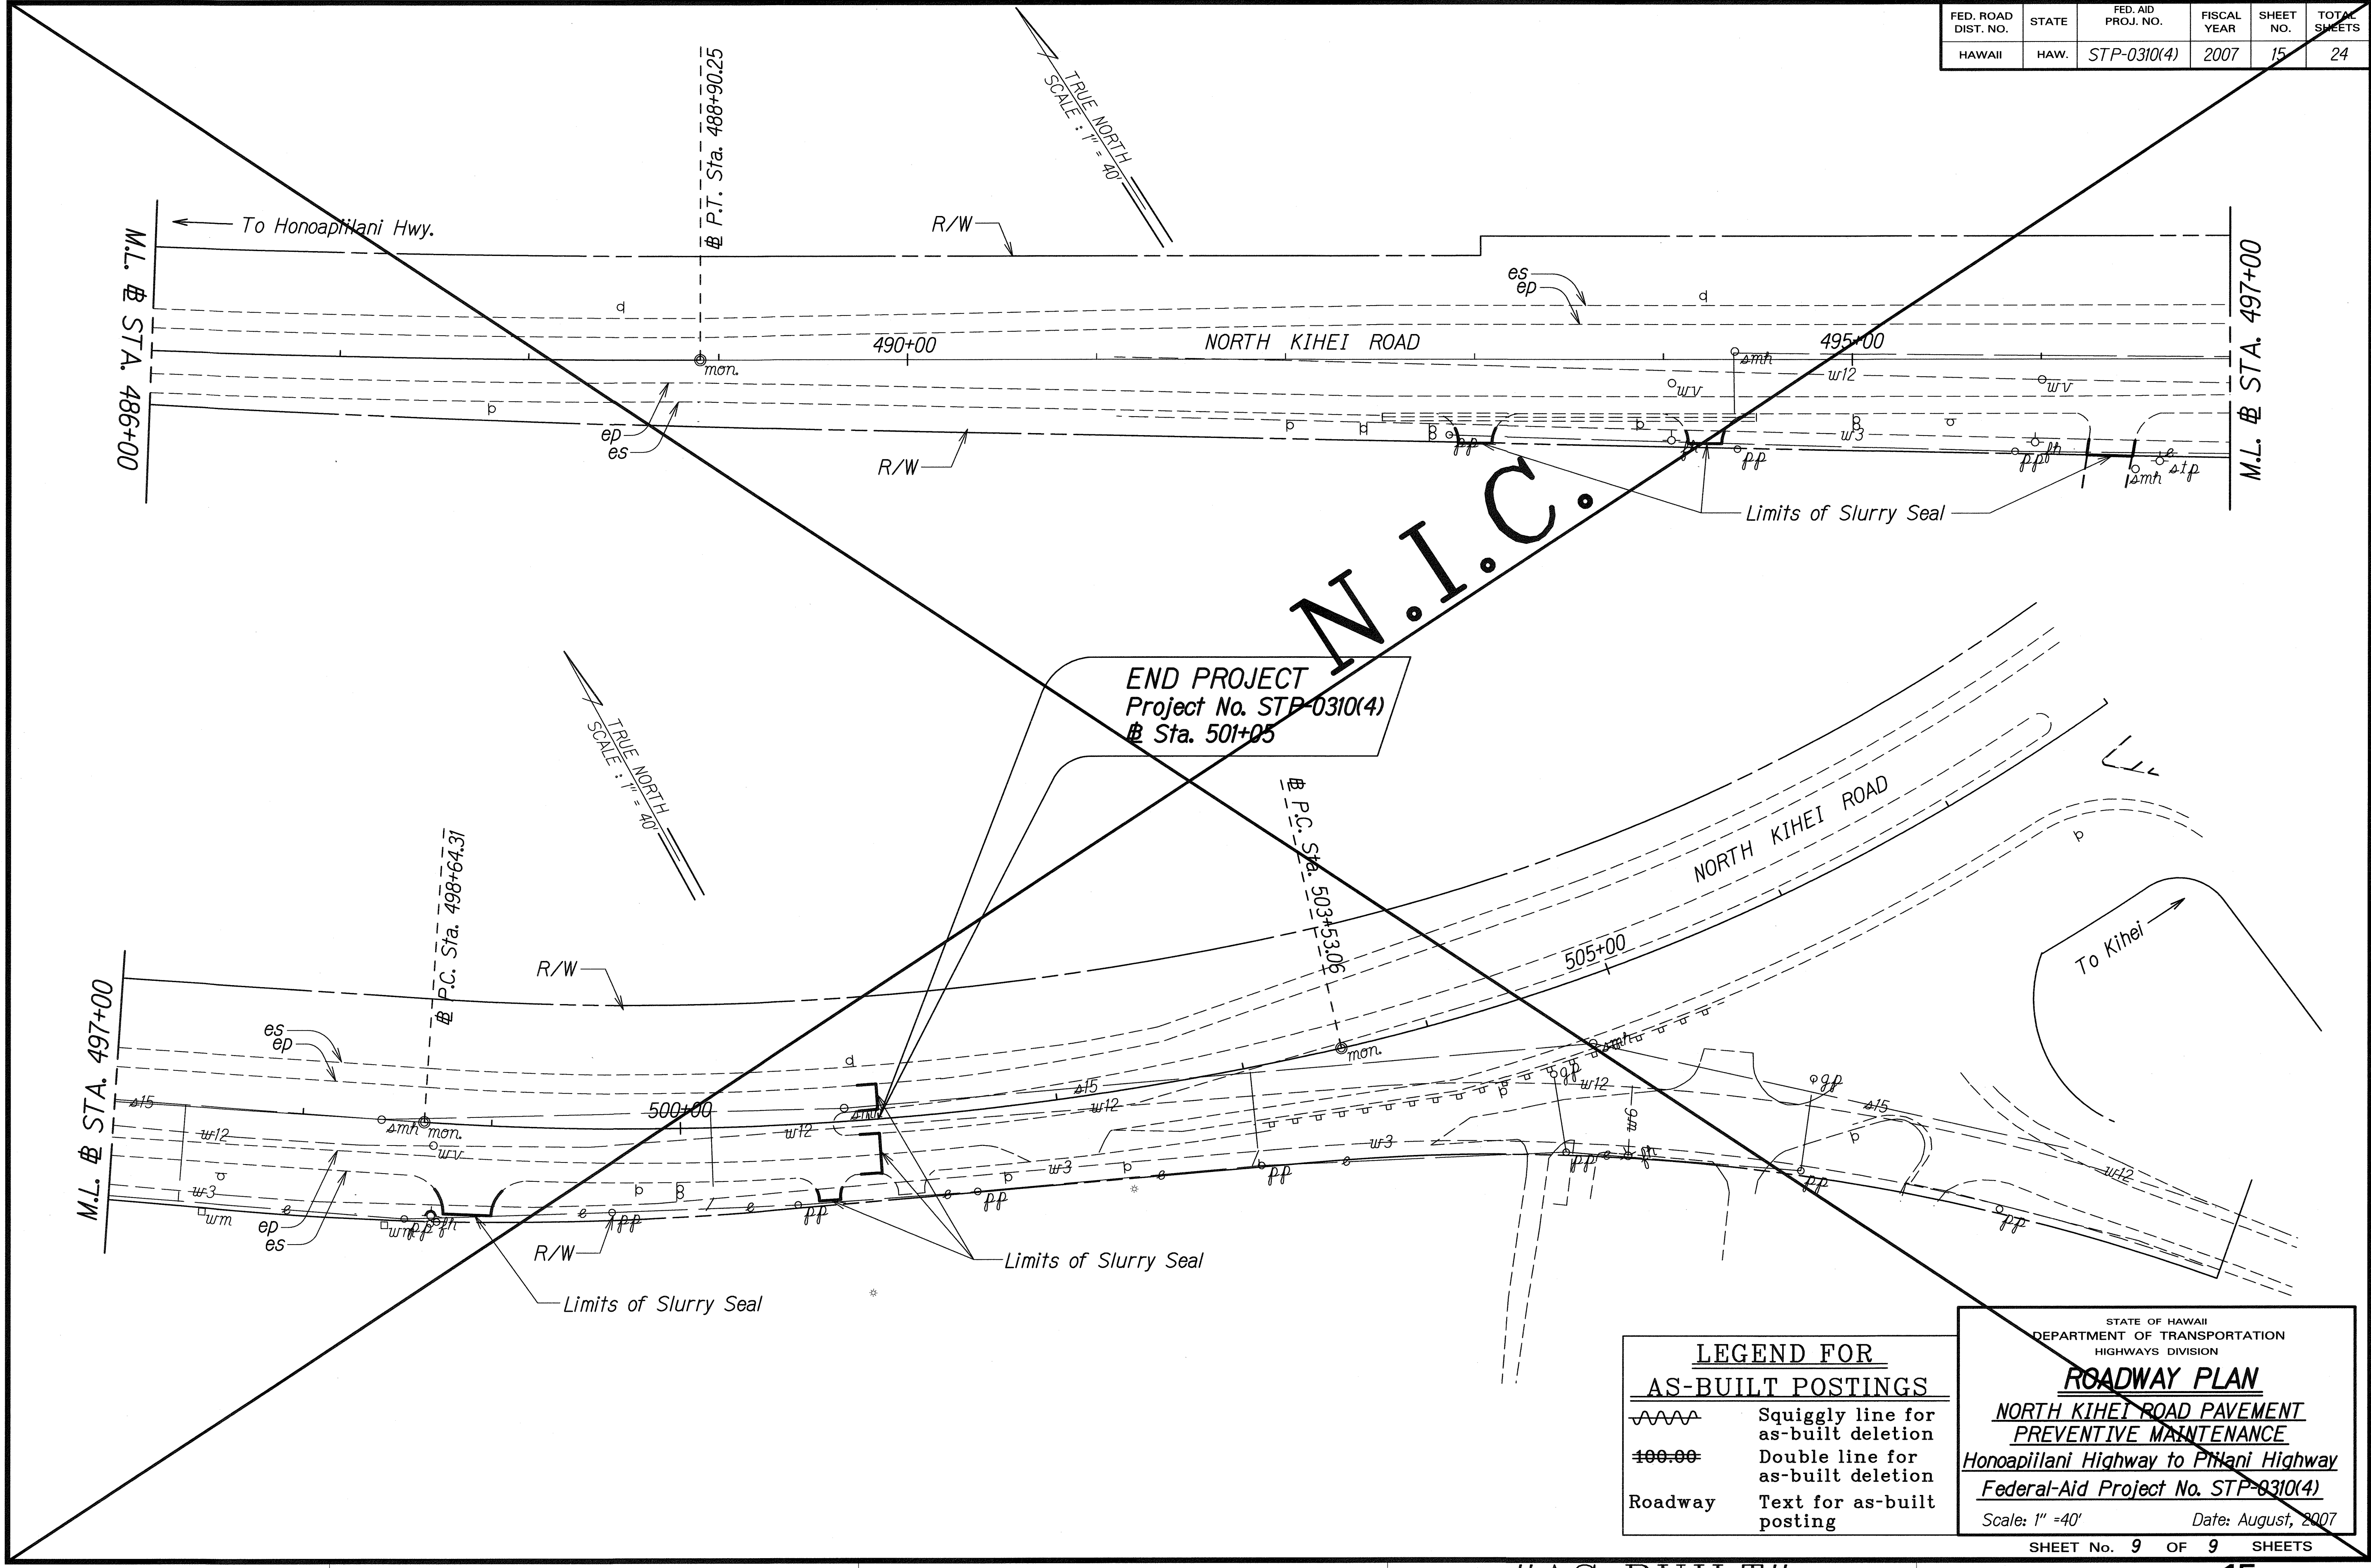

ORIGINAL PLAN	DATE
DESIGNED BY	07
DRAWN BY	
CHECKED BY	
NOTED BY	
QUANTITIES BY	
CHECKED BY	

LEGEND FOR AS-BUILT POSTINGS	
	Squiggly line for as-built deletion
	Double line for as-built deletion
Roadway	Text for as-built posting

STATE OF HAWAII  
DEPARTMENT OF TRANSPORTATION  
HIGHWAYS DIVISION

### ROADWAY PLAN

**NORTH KIHAI ROAD PAVEMENT PREVENTIVE MAINTENANCE**

Honoapiilani Highway to Pihani Highway

Federal-Aid Project No. STP-0310(4)

Scale: 1" = 40'      Date: August, 2007

"AS-BUILT"