



FED. ROAD DIST. NO.	STATE	FED. AID PROJ. NO.	FISCAL YEAR	SHEET NO.	TOTAL SHEETS
HAWAII	HAW.	STP-0310(4)	2007	6	24

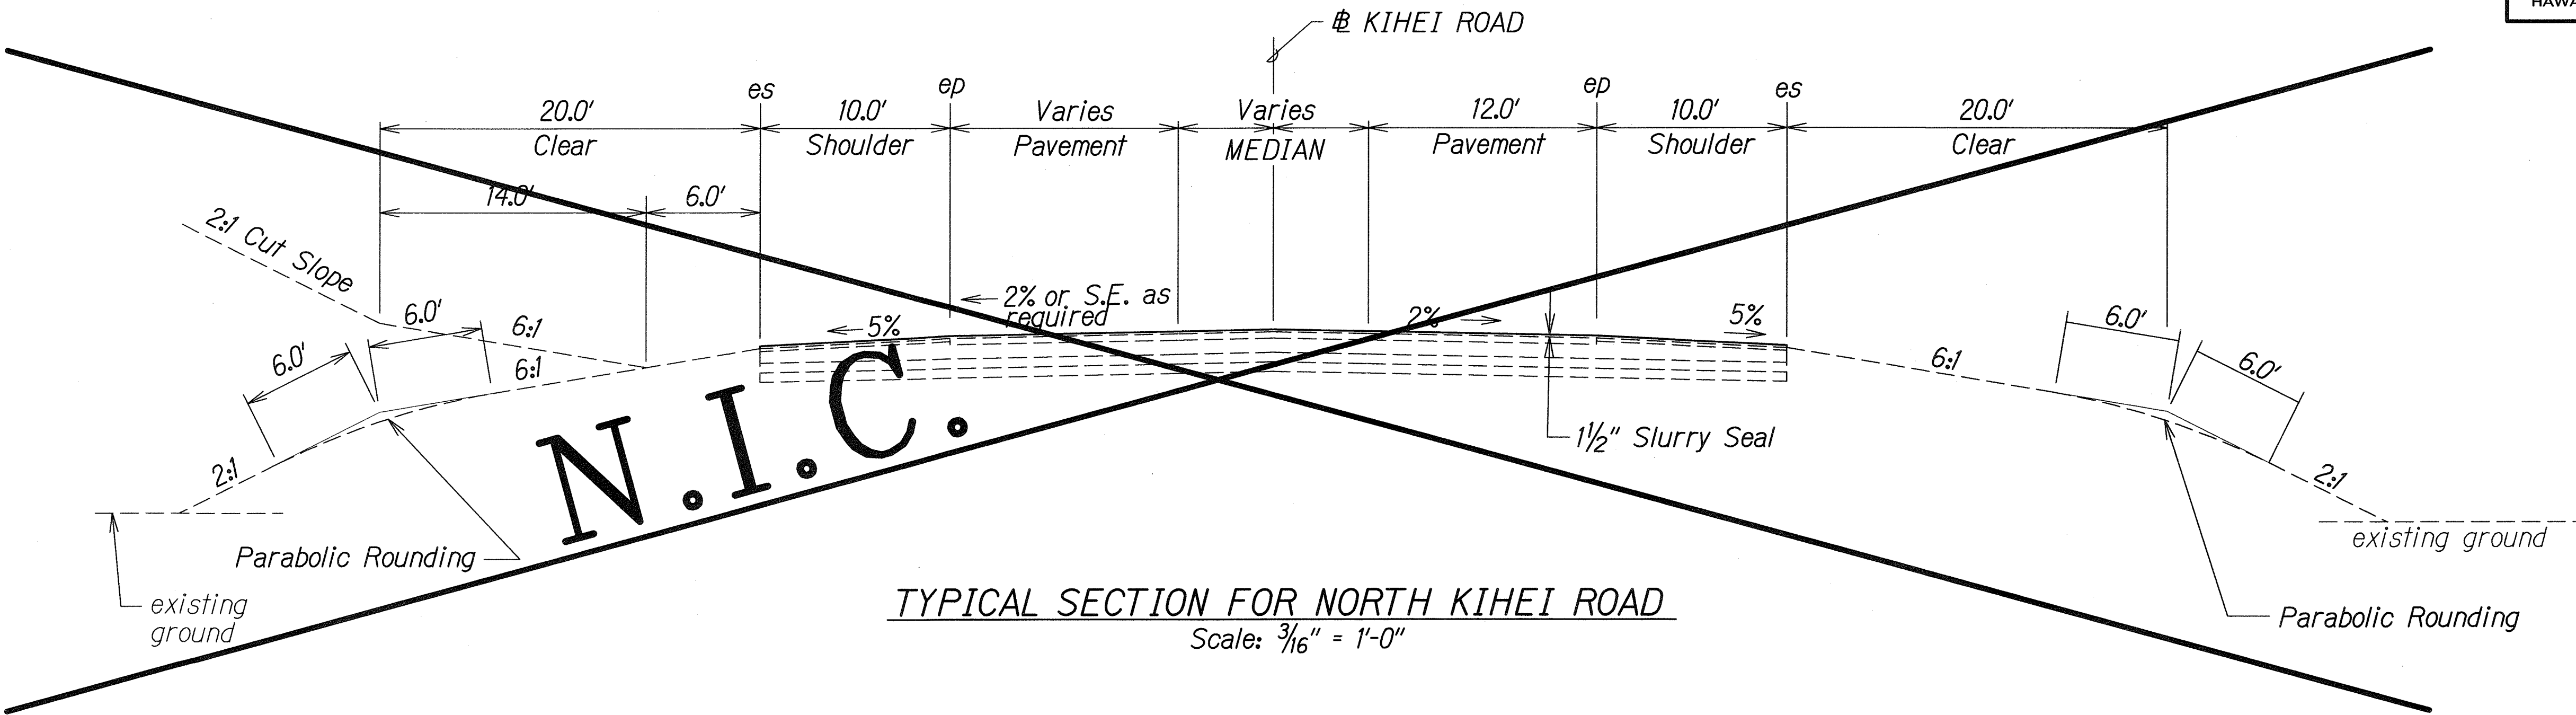

TYPICAL SECTION FOR NORTH KIHEI ROAD  
Scale:  $\frac{3}{16}'' = 1'-0''$

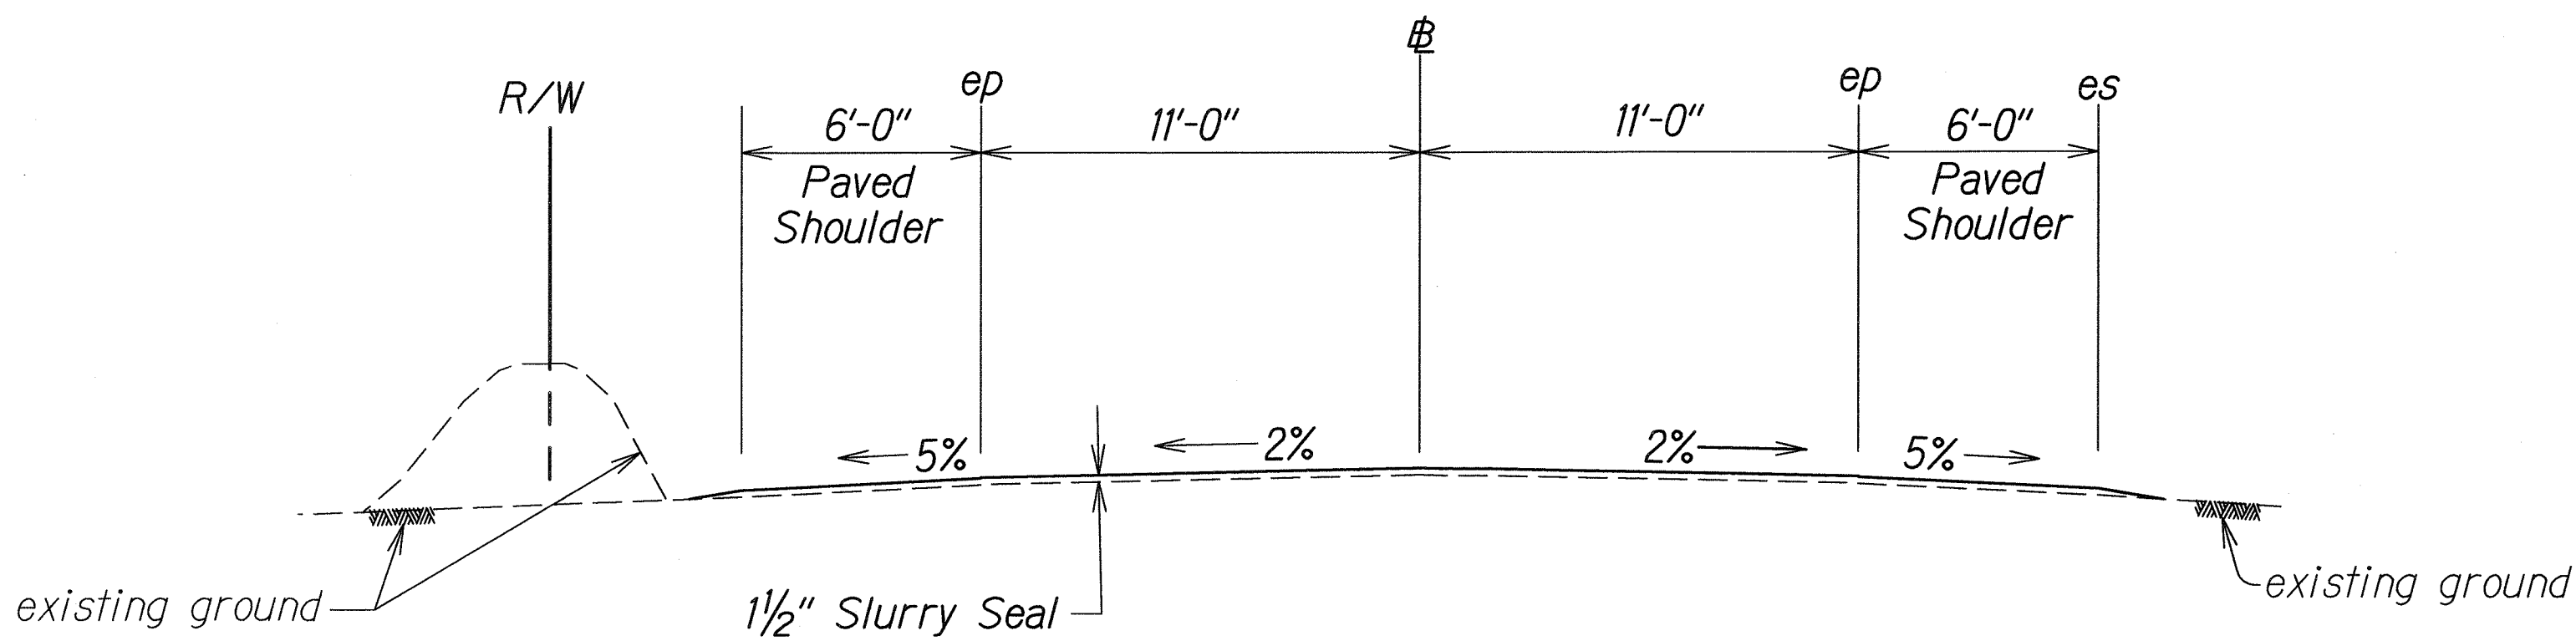

TYPICAL TANGENT SECTION FOR NORTH KEHEI ROAD  
Scale:  $\frac{1}{4}'' = 1'-0''$

ORIGINAL PLAN	DESIGNED BY	DATE
NOTED BY	TRACED BY	Aug. 07
QUANTITIES BY	CHECKED BY	

LEGEND FOR	
AS-BUILT POSTINGS	
	Squiggly line for as-built deletion
	Double line for as-built deletion
Roadway	Text for as-built posting

STATE OF HAWAII DEPARTMENT OF TRANSPORTATION HIGHWAYS DIVISION	
<b>TYPICAL SECTIONS &amp; DETAILS</b>	
<b>NORTH KIHEI ROAD PAVEMENT PREVENTIVE MAINTENANCE</b>	
<i>Honoapiilani Highway to Piilani Highway</i>	
<i>Federal-Aid Project No. STP-0310(4)</i>	
Scale: As Shown	Date: August, 2007