


FED. ROAD DIST. NO.	STATE	PROJ. NO.	FISCAL YEAR	SHEET NO.	TOTAL SHEETS
HAWAII	HAW.	310A-01-13M	2013	8	30

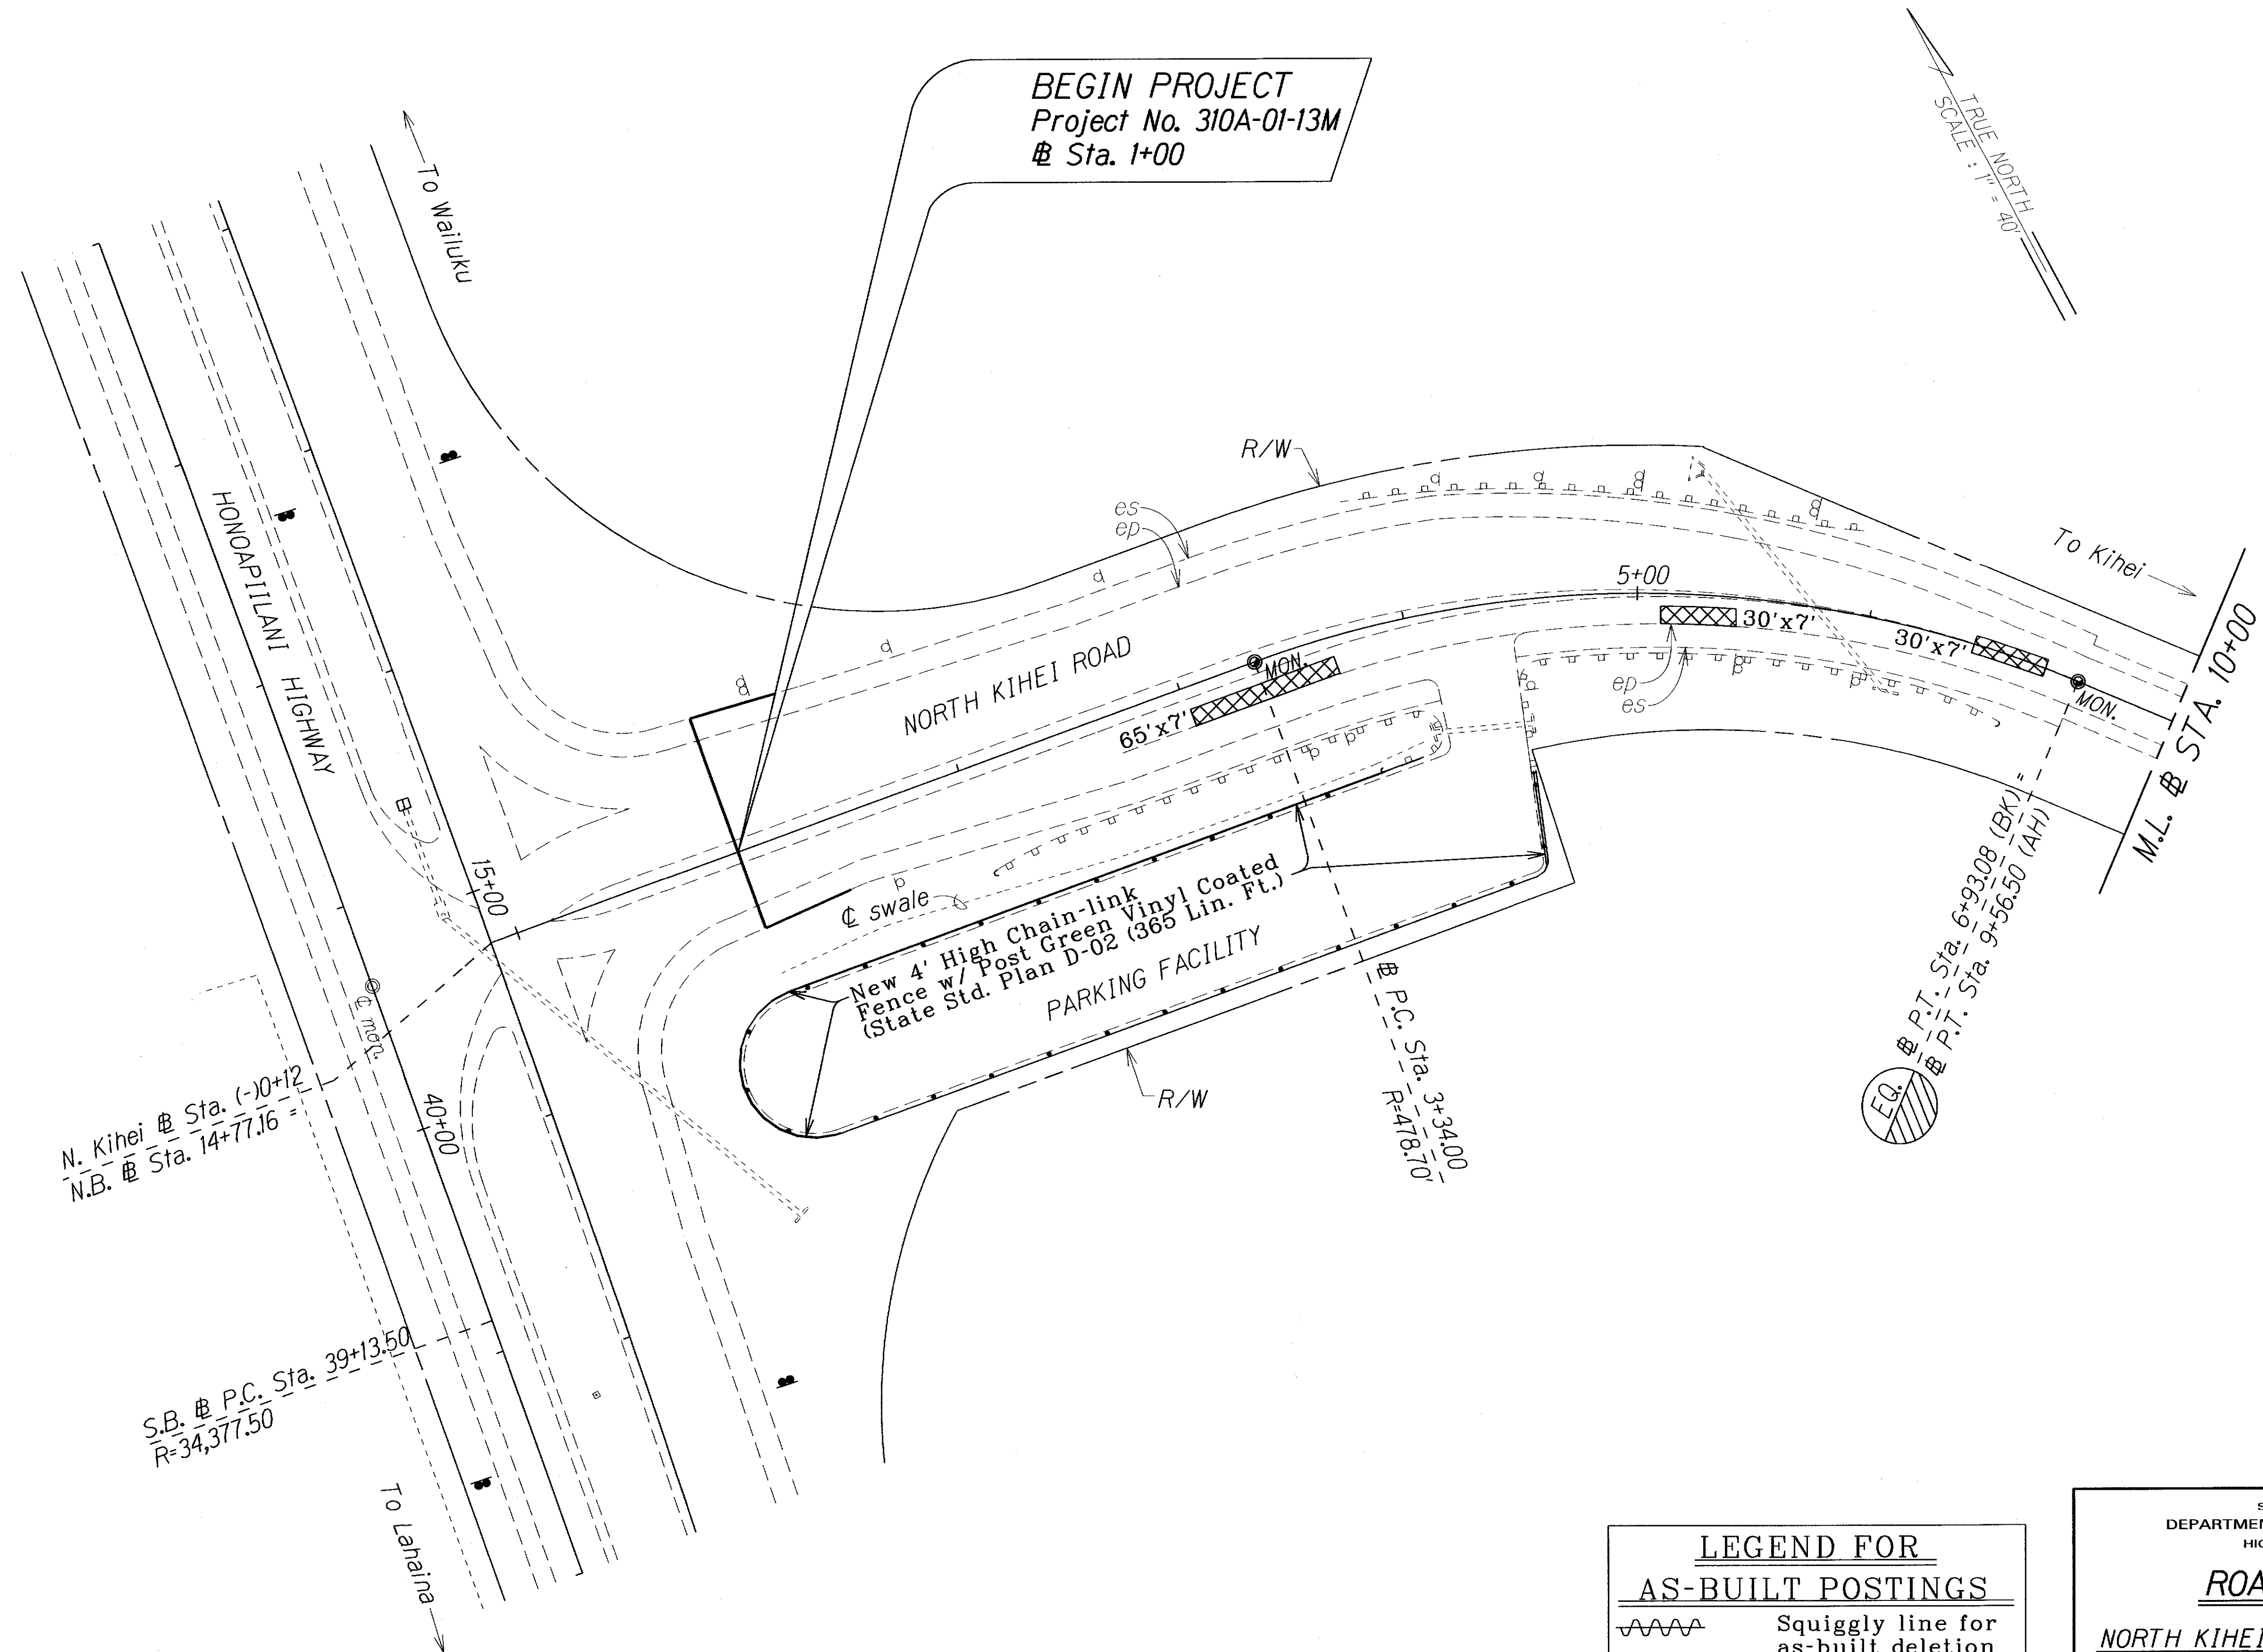

ORIGINAL PLAN	DATE
SURVEY PLOTTED BY	
DRAWN BY	
DESIGNED BY	
QUANTITIES BY	
CHECKED BY	

LEGEND FOR AS-BUILT POSTINGS	
	Squiggly line for as-built deletion
	Double line for as-built deletion
Roadway	Text for as-built posting

STATE OF HAWAII
DEPARTMENT OF TRANSPORTATION
HIGHWAYS DIVISION

ROADWAY PLAN



NORTH KIEHI ROAD RESURFACING
Honoapiilani Highway to Piilani Highway
Project No. 310A-01-13M

Scale: 1" = 40' Date: October, 2012

SHEET No. 1 OF 9 SHEETS

"AS-BUILT"

FED. ROAD DIST. NO.	STATE	PROJ. NO.	FISCAL YEAR	SHEET NO.	TOTAL SHEETS
HAWAII	HAW.	310A-01-13M	2013	9	30

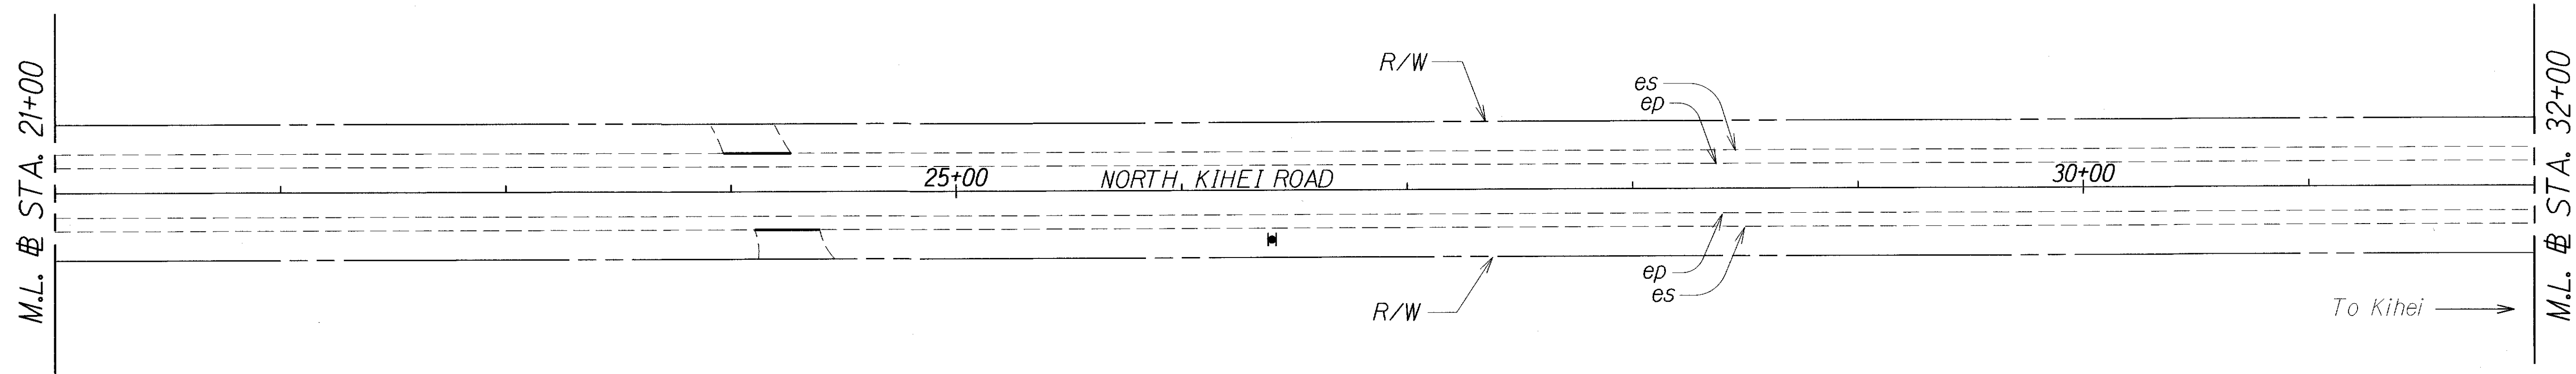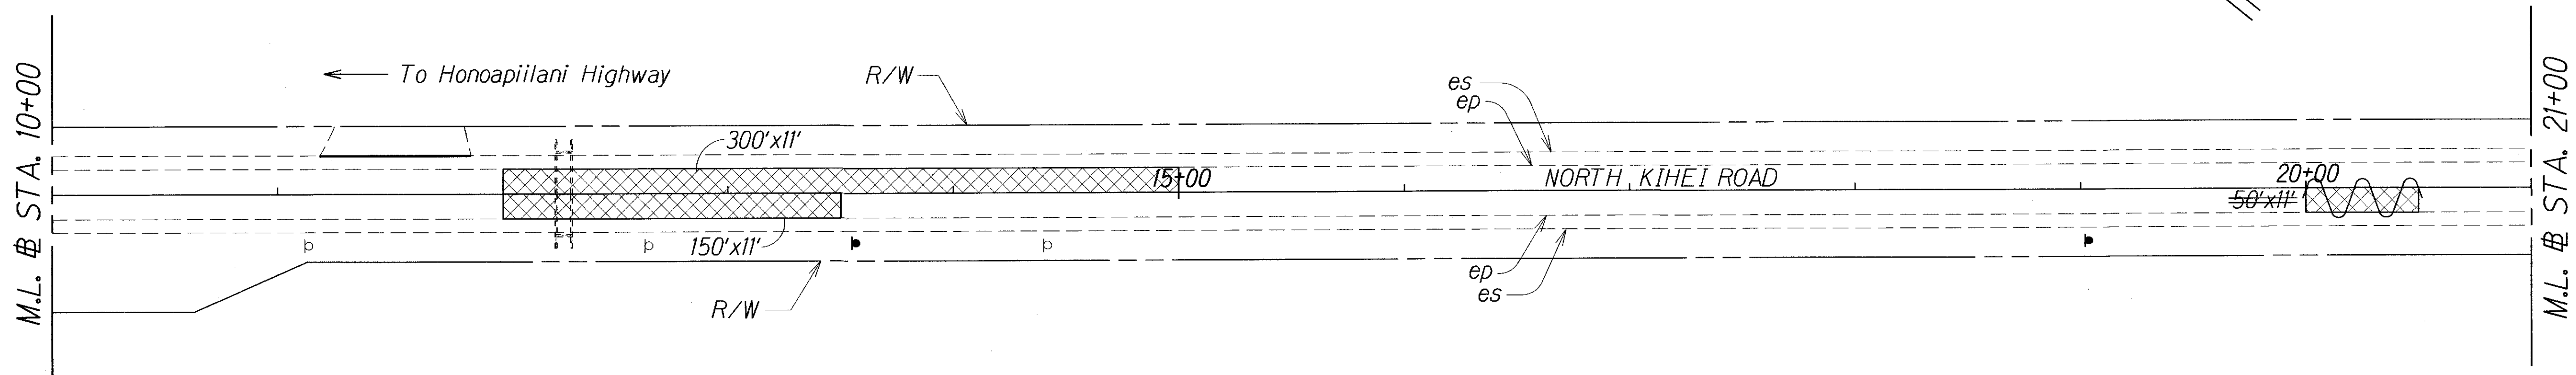

ORIGINAL PLAN	SURVEY PLOTTED BY	DATE
NOTE BOOK	DESIGNED BY	
QUANTITIES BY	CHECKED BY	
NO. CHANGES		

LEGEND FOR AS-BUILT POSTINGS	
	Squiggly line for as-built deletion
	Double line for as-built deletion
Roadway	Text for as-built posting

STATE OF HAWAII
DEPARTMENT OF TRANSPORTATION
HIGHWAYS DIVISION

ROADWAY PLAN



NORTH KIHAI ROAD RESURFACING
Honoapiilani Highway to Piilani Highway
Project No. 310A-01-13M

Scale: 1" = 40' Date: October, 2012

SHEET No. 2 OF 9 SHEETS

"AS-BUILT"

FED. ROAD DIST. NO.	STATE	PROJ. NO.	FISCAL YEAR	SHEET NO.	TOTAL SHEETS
HAWAII	HAW.	310A-01-13M	2013	10	30

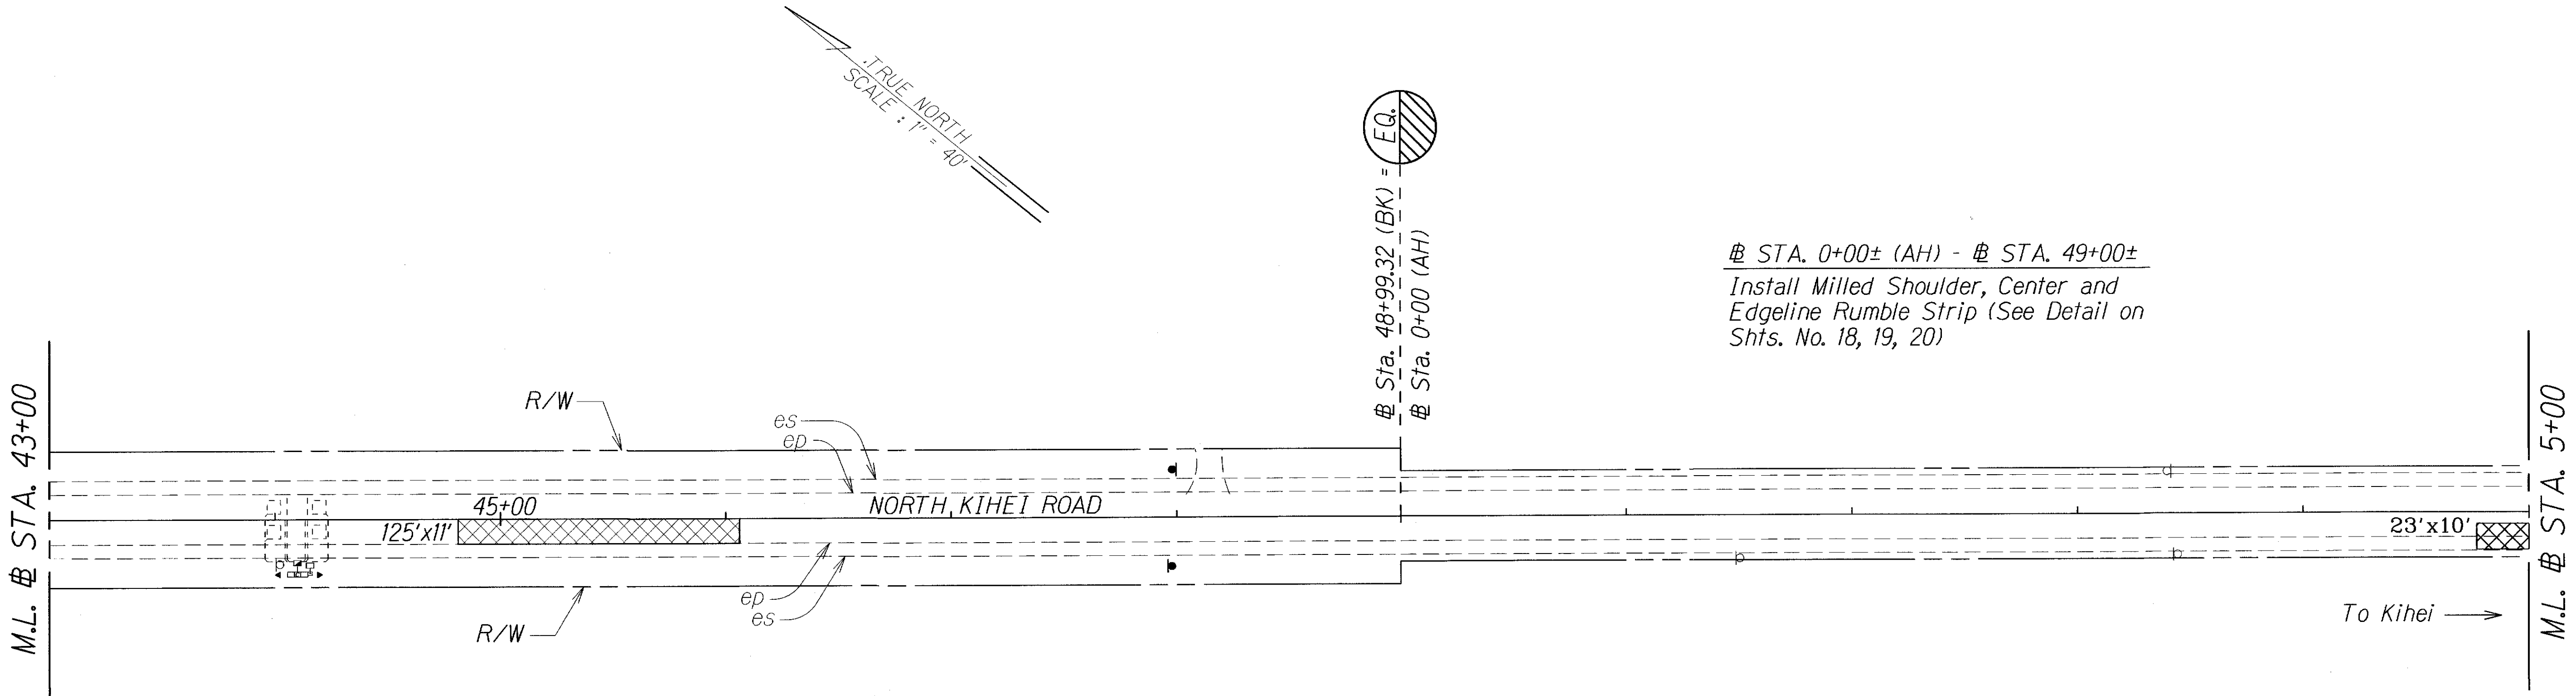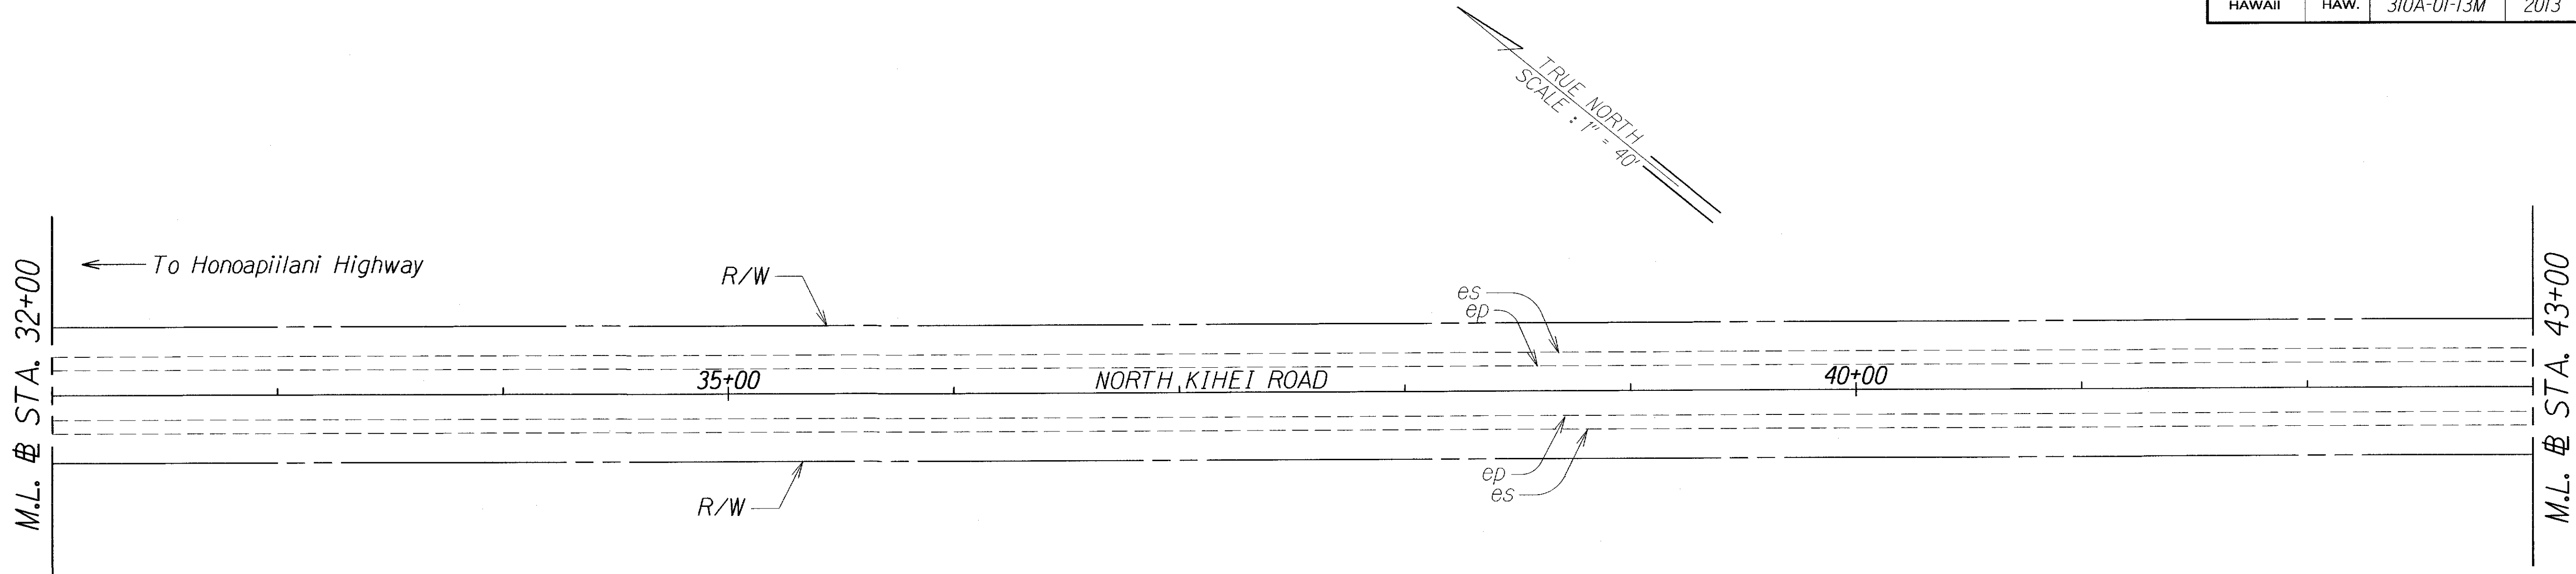

ORIGINAL PLAN	DATE	2012.10.01
DESIGNED BY	TRACED BY	
QUANTITIES BY	CHECKED BY	

LEGEND FOR AS-BUILT POSTINGS	
	Squiggly line for as-built deletion
	Double line for as-built deletion
Roadway	Text for as-built posting

STATE OF HAWAII
DEPARTMENT OF TRANSPORTATION
HIGHWAYS DIVISION


ROADWAY PLAN

NORTH KIHAI ROAD RESURFACING
Honoapiilani Highway to Piilani Highway
Project No. 310A-01-13M

Scale: 1" = 40' Date: October, 2012

SHEET No. 3 OF 9 SHEETS

FED. ROAD DIST. NO.	STATE	PROJ. NO.	FISCAL YEAR	SHEET NO.	TOTAL SHEETS
HAWAII	HAW.	310A-01-13M	2013	11	30

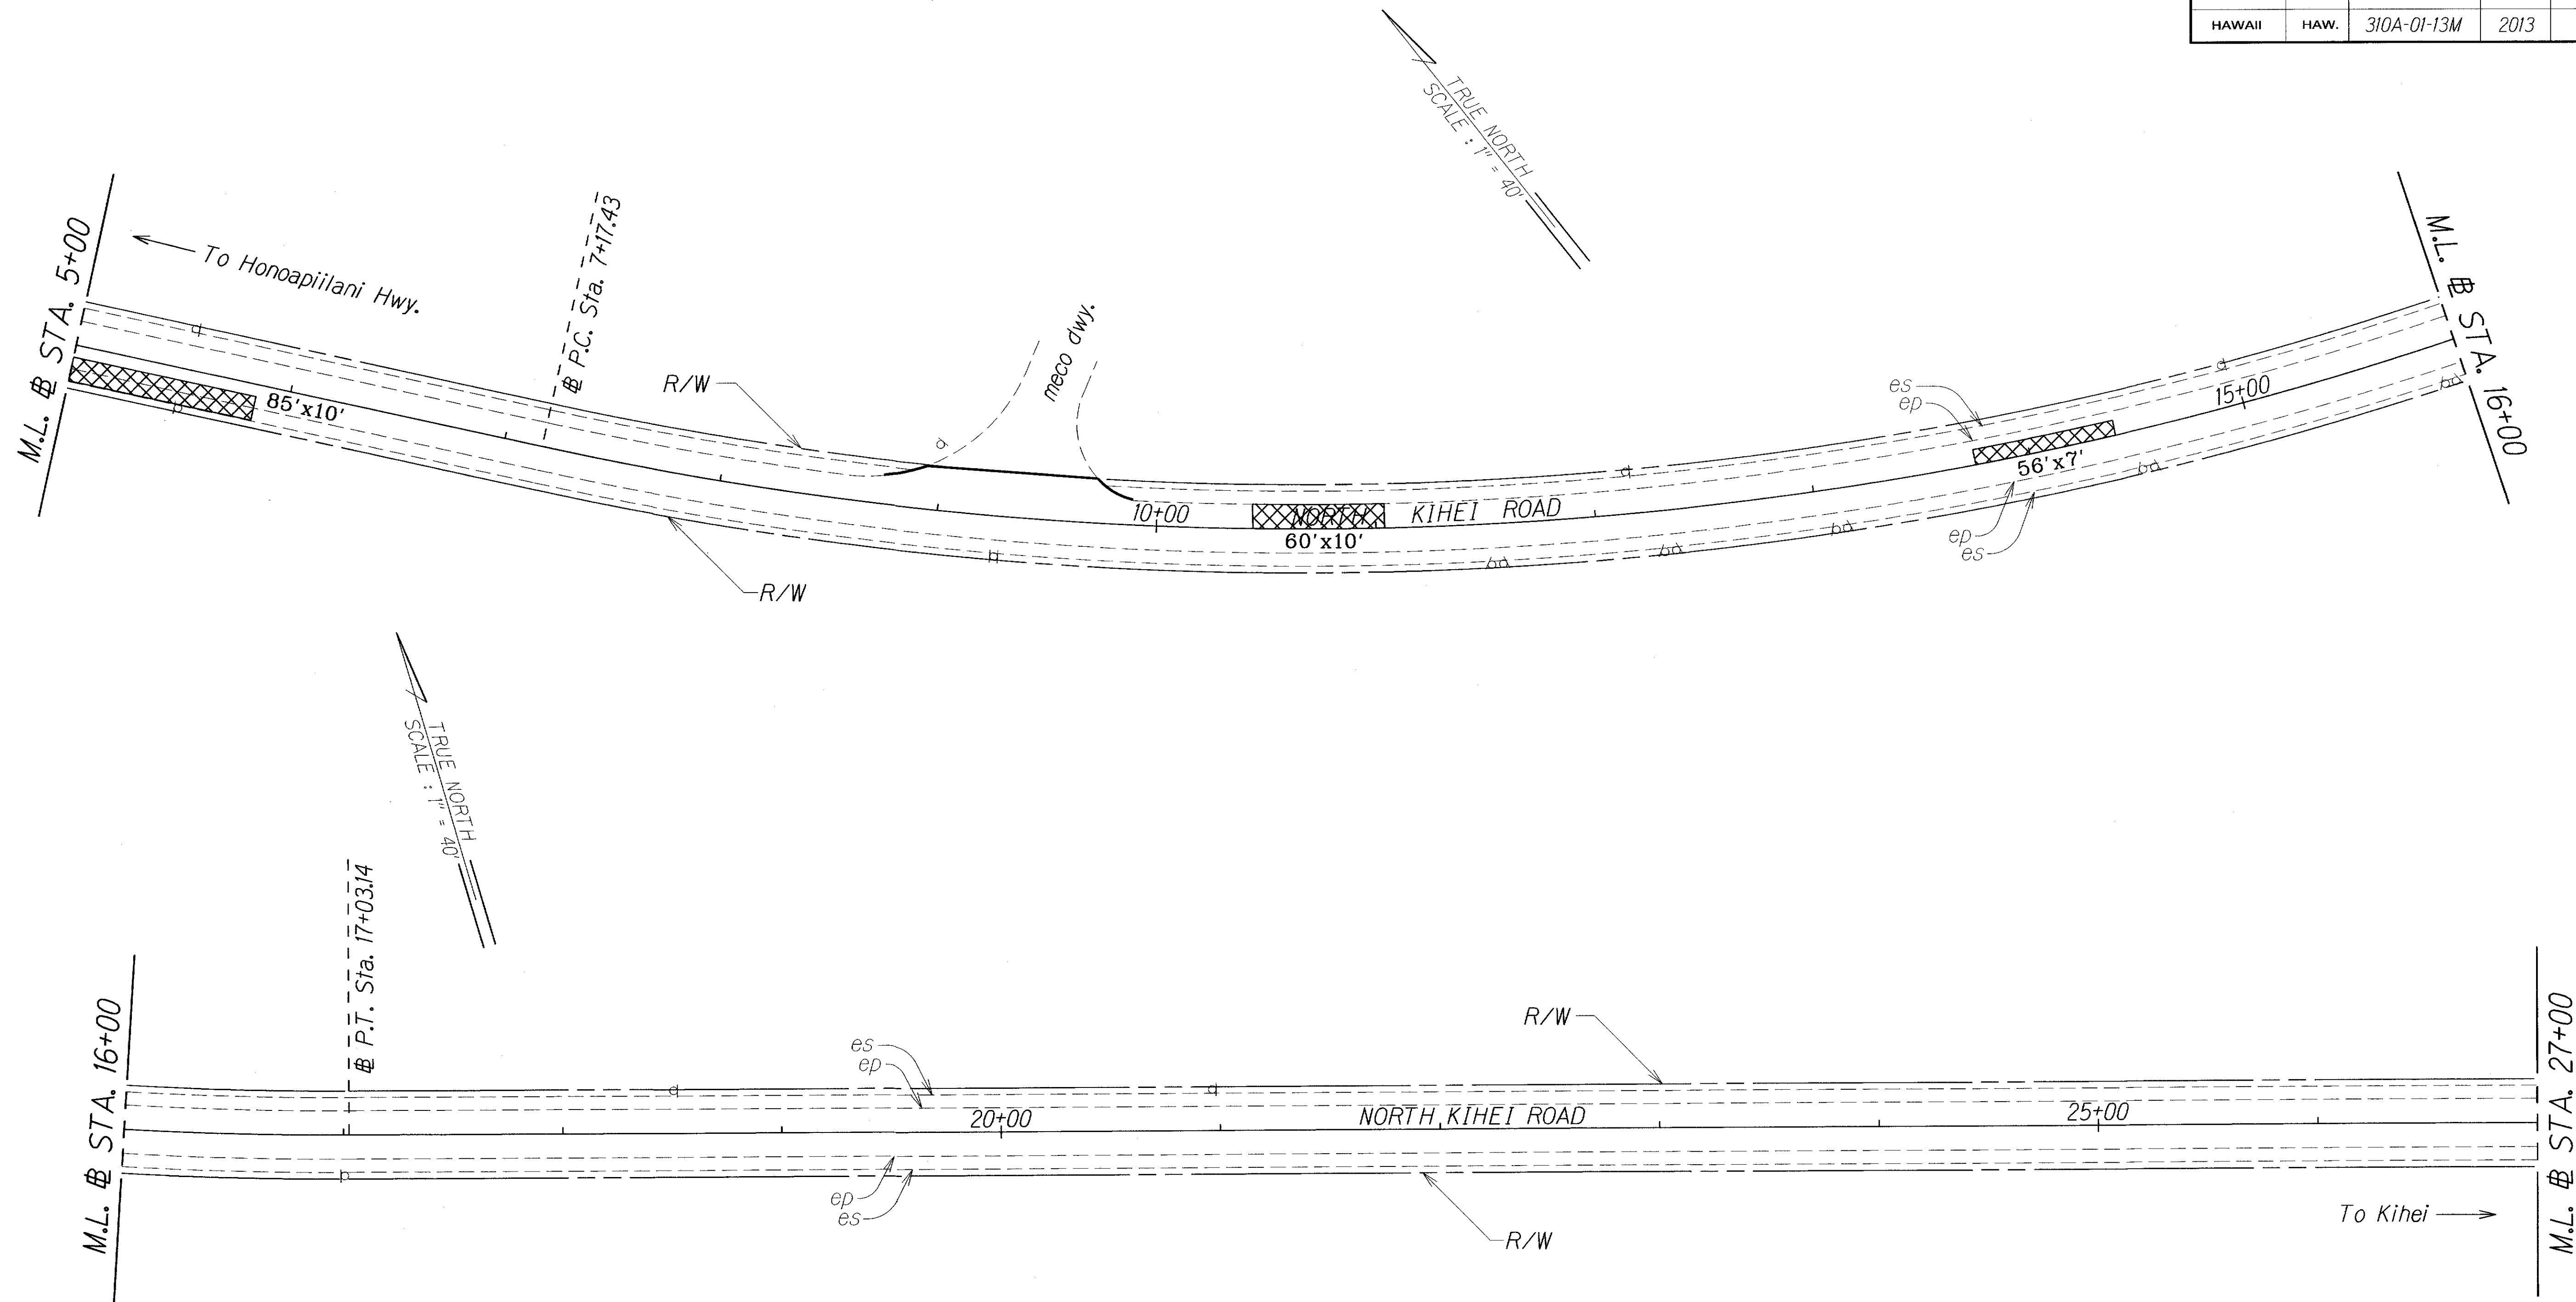

ORIGINAL PLAN	SURVEY PLOTTED BY	DATE
NOTE BOOK	DESIGNED BY	
QUANTITIES BY	CHECKED BY	

LEGEND FOR AS-BUILT POSTINGS	
	Squiggly line for as-built deletion
	Double line for as-built deletion
Roadway	Text for as-built posting

STATE OF HAWAII
DEPARTMENT OF TRANSPORTATION
HIGHWAYS DIVISION

ROADWAY PLAN


NORTH KIHEI ROAD RESURFACING
Honoapiilani Highway to Piilani Highway
Project No. 310A-01-13M

Scale: 1" = 40' Date: October, 2012

SHEET No. 4 OF 9 SHEETS

"AS-BUILT"

FED. ROAD DIST. NO.	STATE	PROJ. NO.	FISCAL YEAR	SHEET NO.	TOTAL SHEETS
HAWAII	HAW.	310A-01-13M	2013	12	30

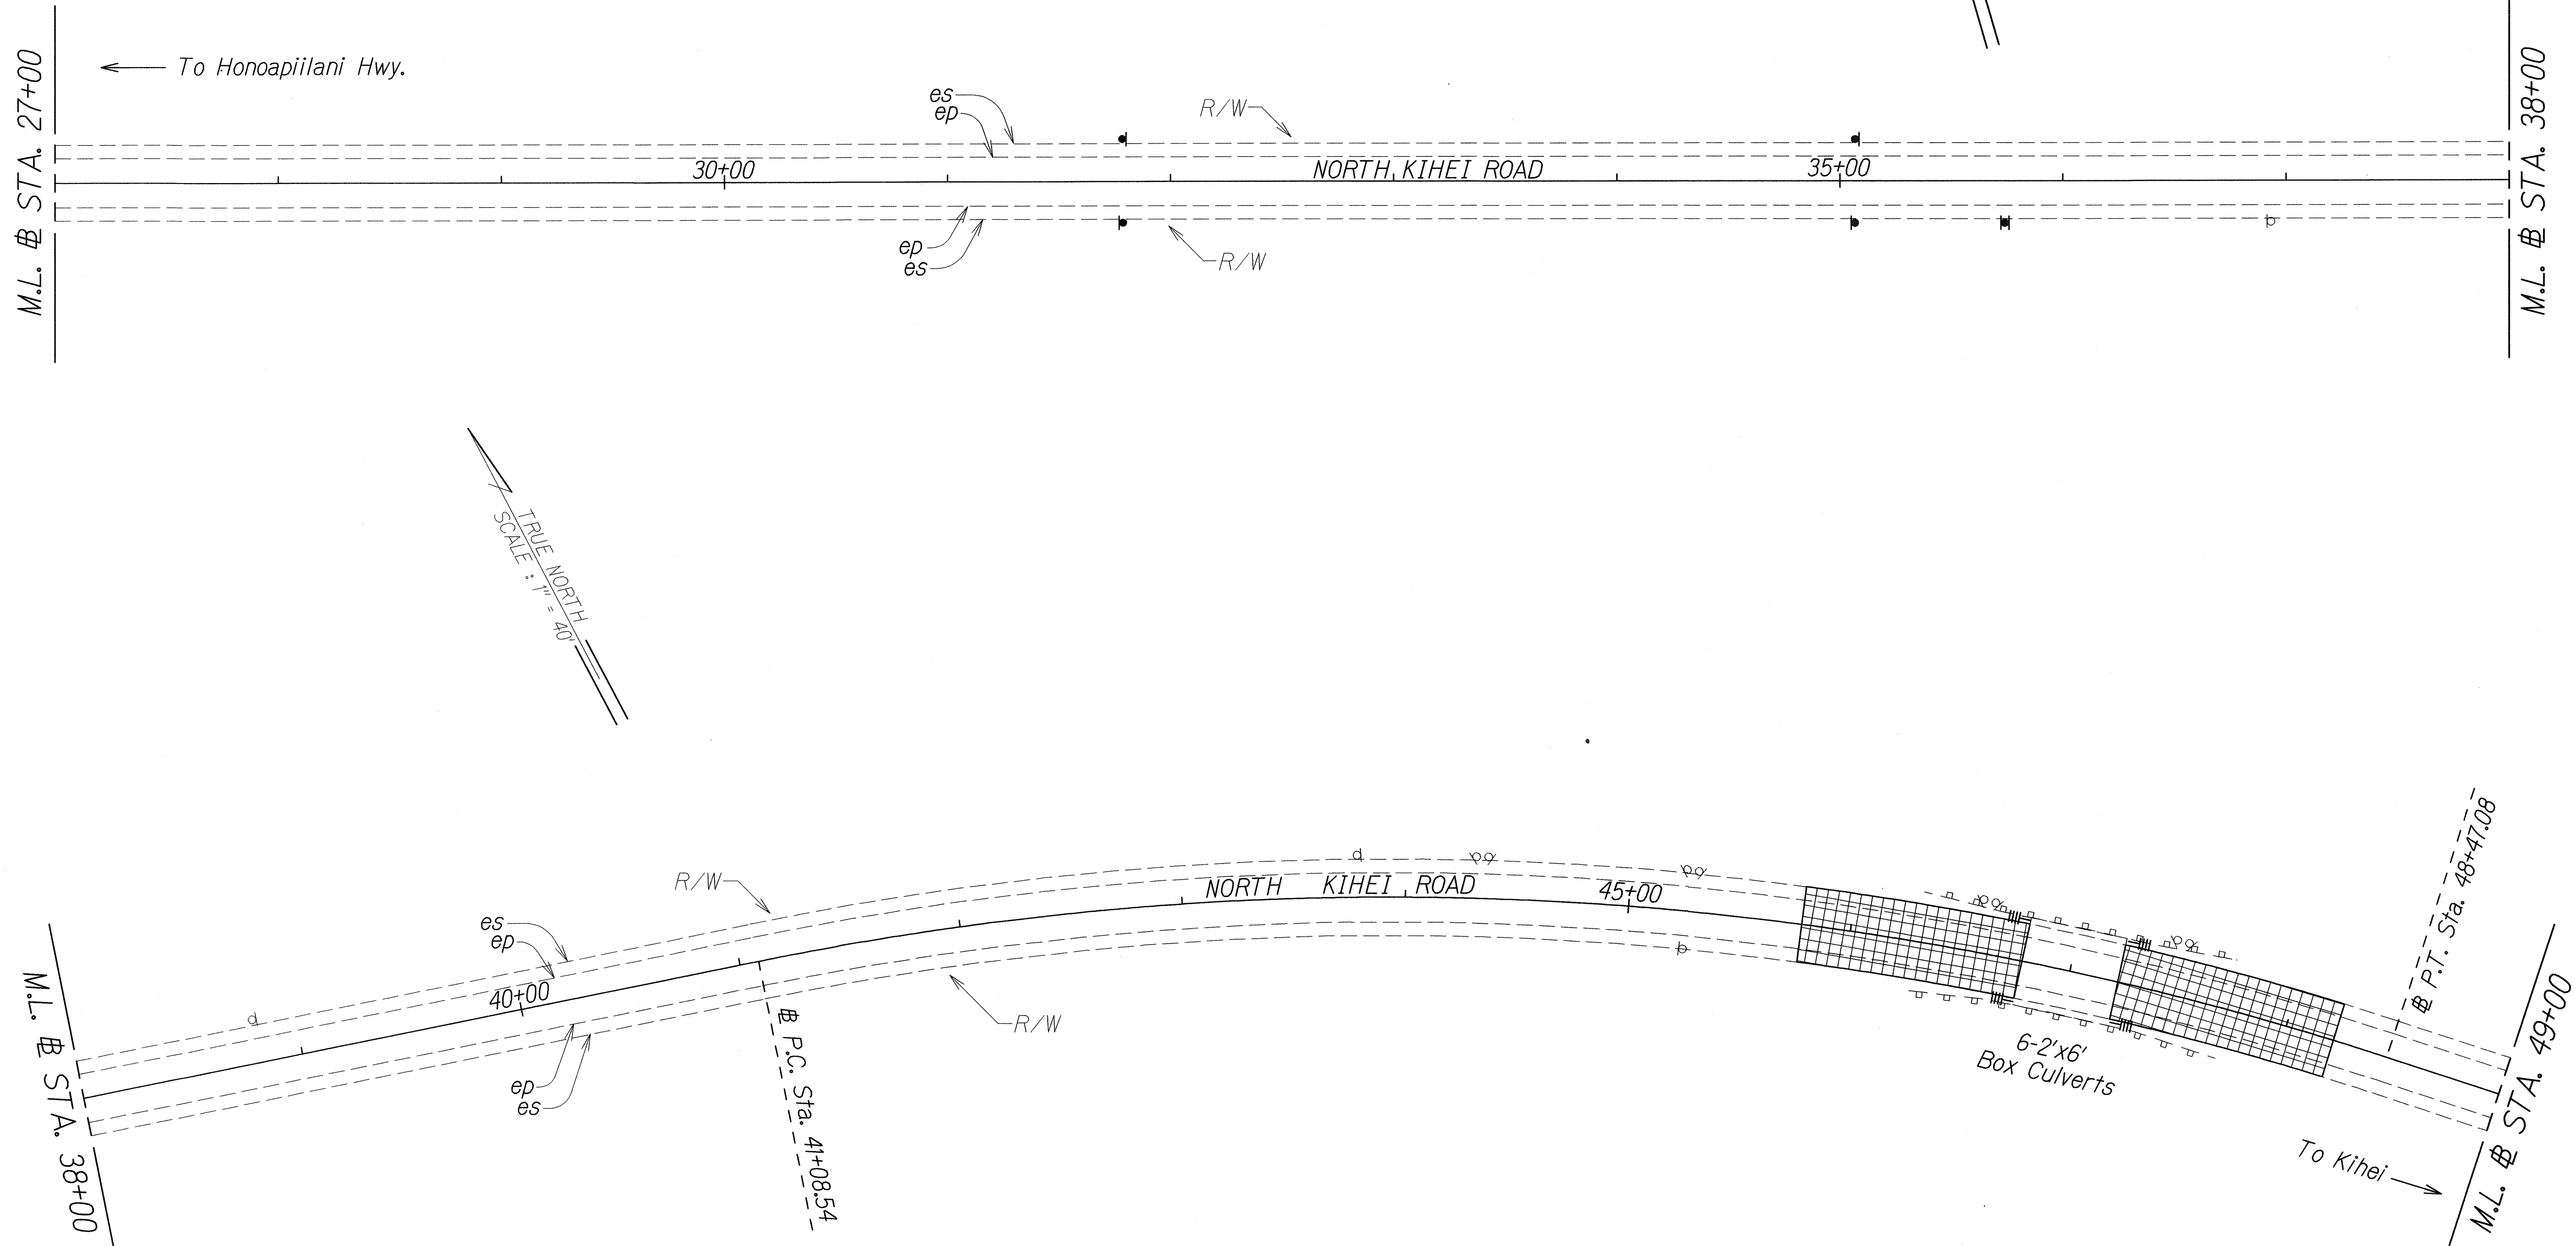

DATE	10/12
SURVEY PLOTTED BY	ig
DRAWN BY	ig
DESIGNED BY	cd
QUANTITIES BY	mei
CHECKED BY	mei

STATE OF HAWAII
DEPARTMENT OF TRANSPORTATION
HIGHWAYS DIVISION


ROADWAY PLAN

NORTH KIHEI ROAD RESURFACING
Honoapiilani Highway to Piilani Highway
Project No. 310A-01-13M

Scale: 1" = 40' Date: October, 2012

SHEET No. 5 OF 9 SHEETS

FED. ROAD DIST. NO.	STATE	PROJ. NO.	FISCAL YEAR	SHEET NO.	TOTAL SHEETS
HAWAII	HAW.	310A-01-13M	2013	13	30

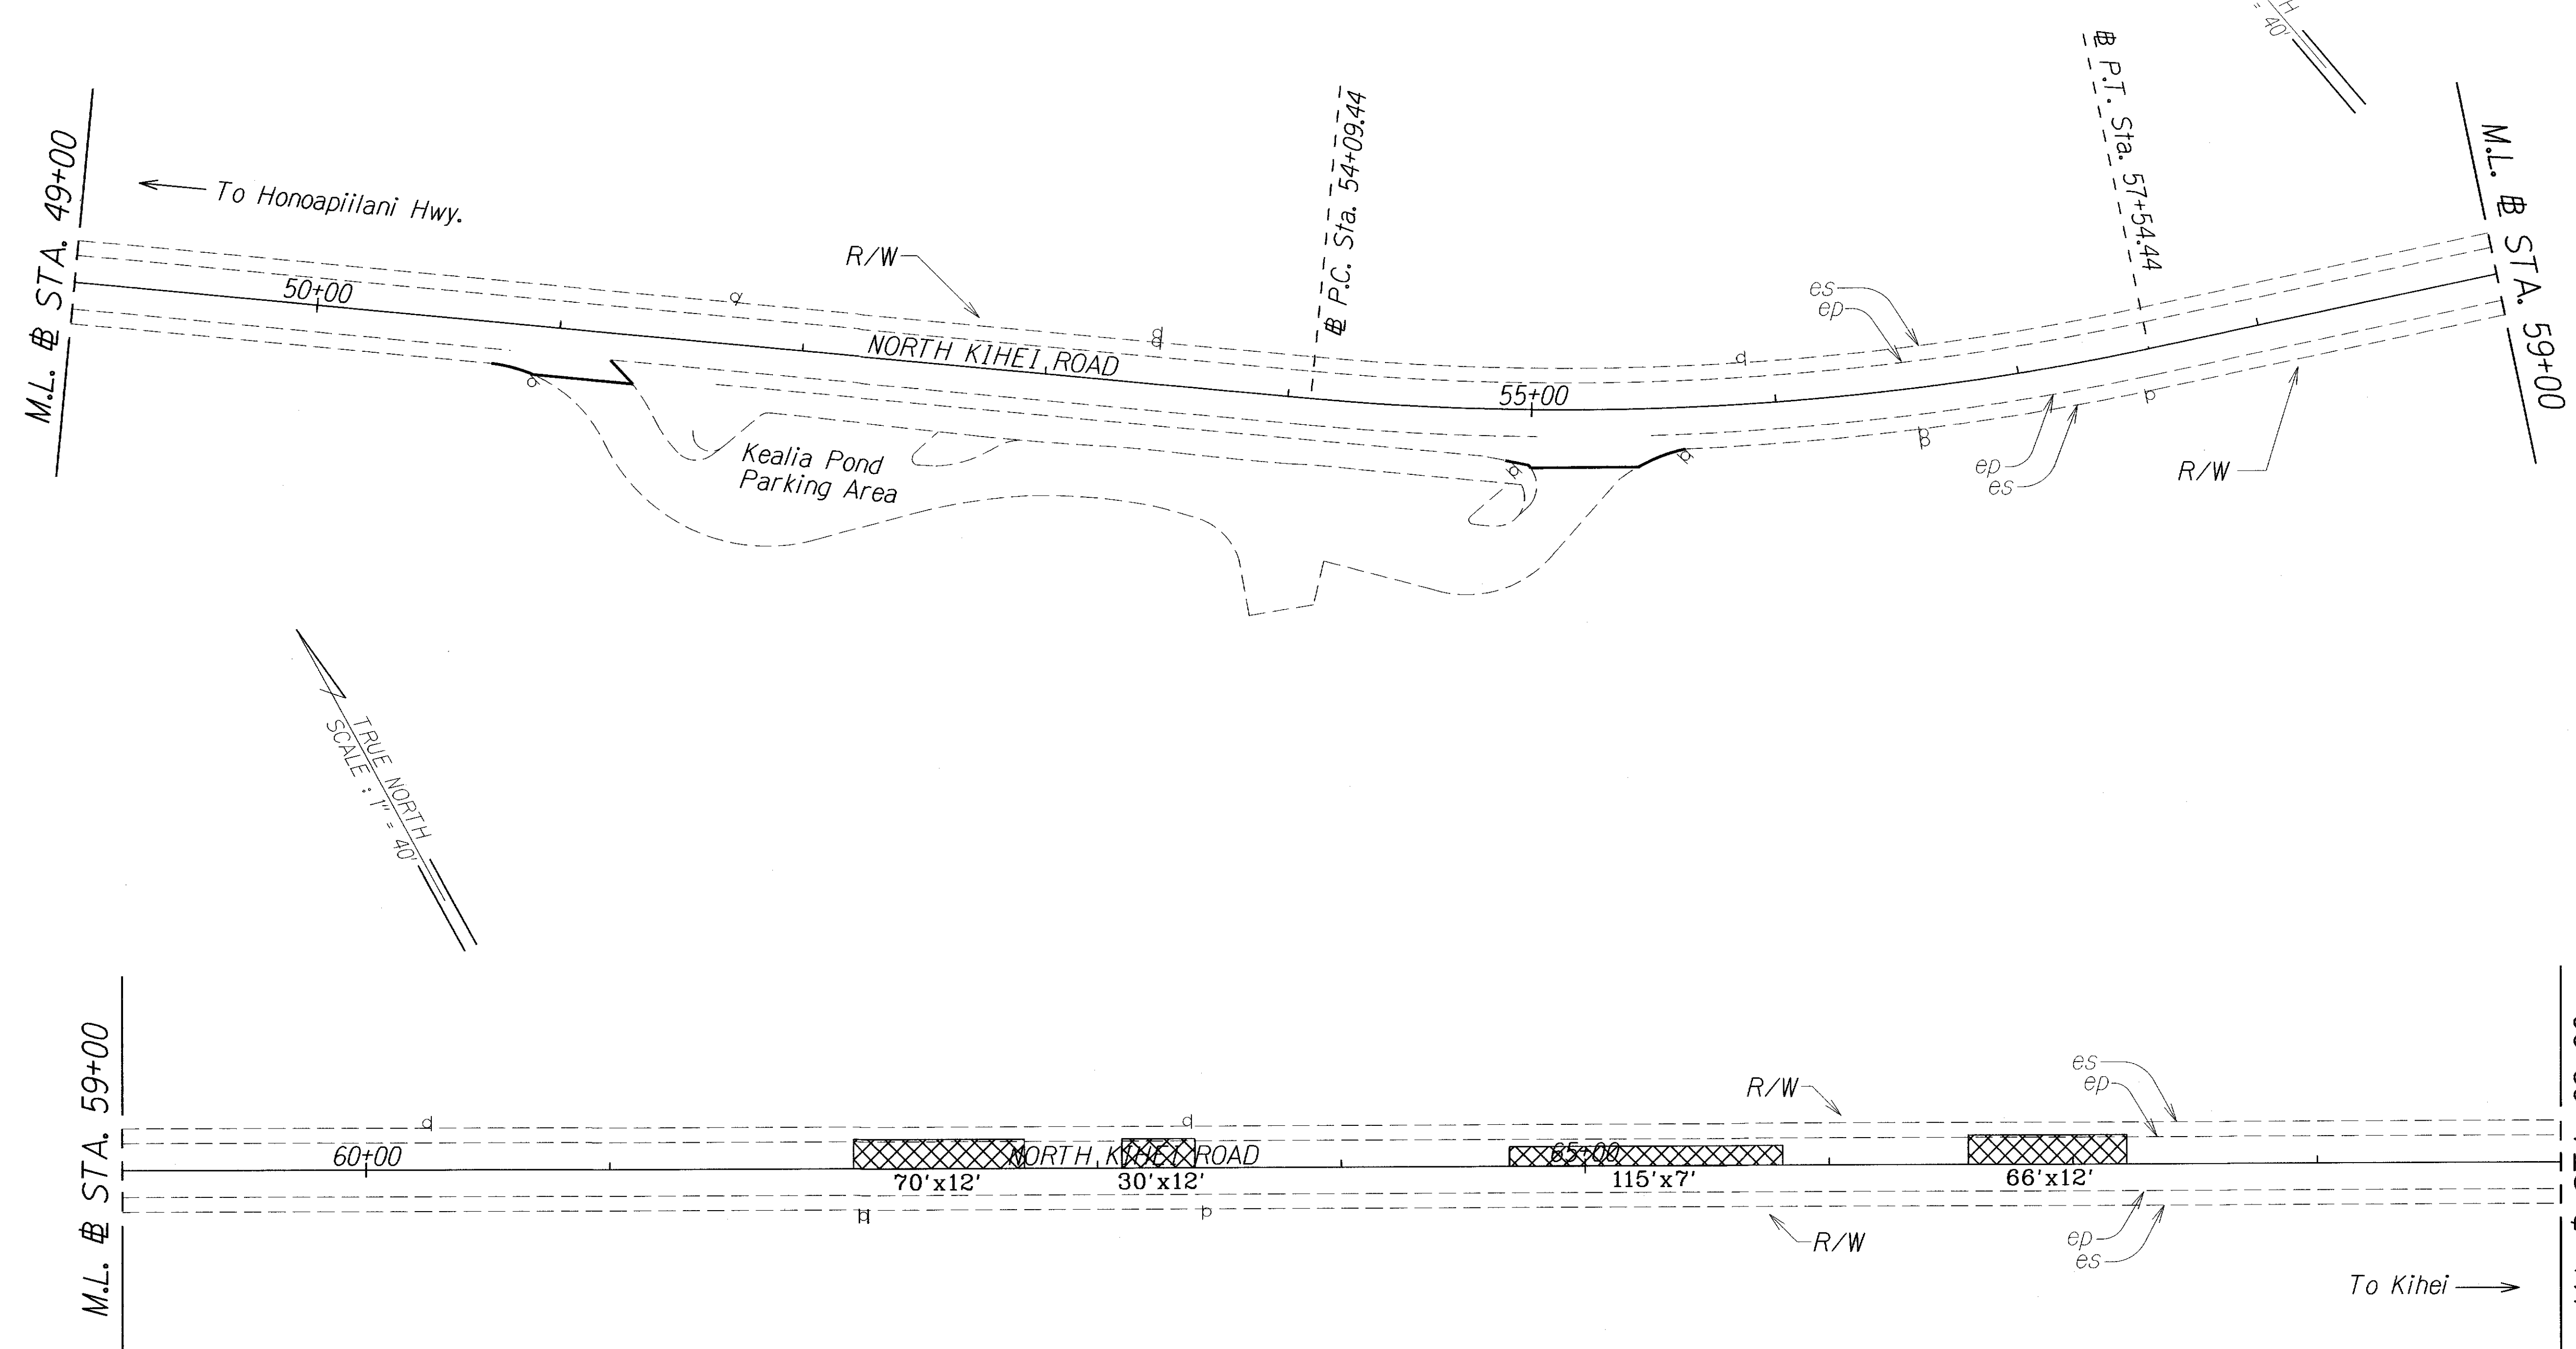

ORIGINAL PLAN	DATE
DESIGNED BY	2012.12
TRACED BY	
NOTE BOOK	
DESIGNED BY	
QUANTITIES BY	
CHECKED BY	

LEGEND FOR AS-BUILT POSTINGS	
	Squiggly line for as-built deletion
	Double line for as-built deletion
Roadway	Text for as-built posting

STATE OF HAWAII
DEPARTMENT OF TRANSPORTATION
HIGHWAYS DIVISION

ROADWAY PLAN



NORTH KIHAI ROAD RESURFACING
Honoapiilani Highway to Piilani Highway
Project No. 310A-01-13M

Scale: 1" = 40' Date: October, 2012

SHEET No. 6 OF 9 SHEETS

"AS-BUILT"

FED. ROAD DIST. NO.	STATE	PROJ. NO.	FISCAL YEAR	SHEET NO.	TOTAL SHEETS
HAWAII	HAW.	310A-01-13M	2013	14	30

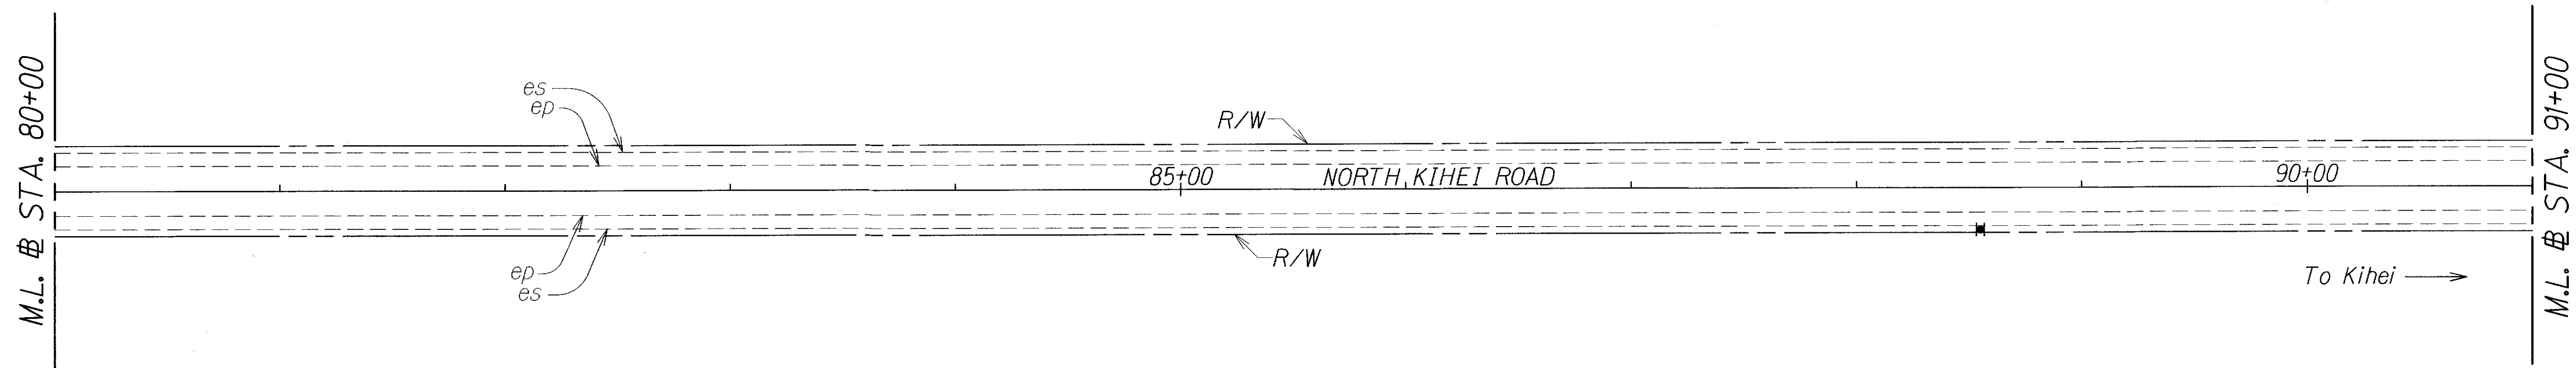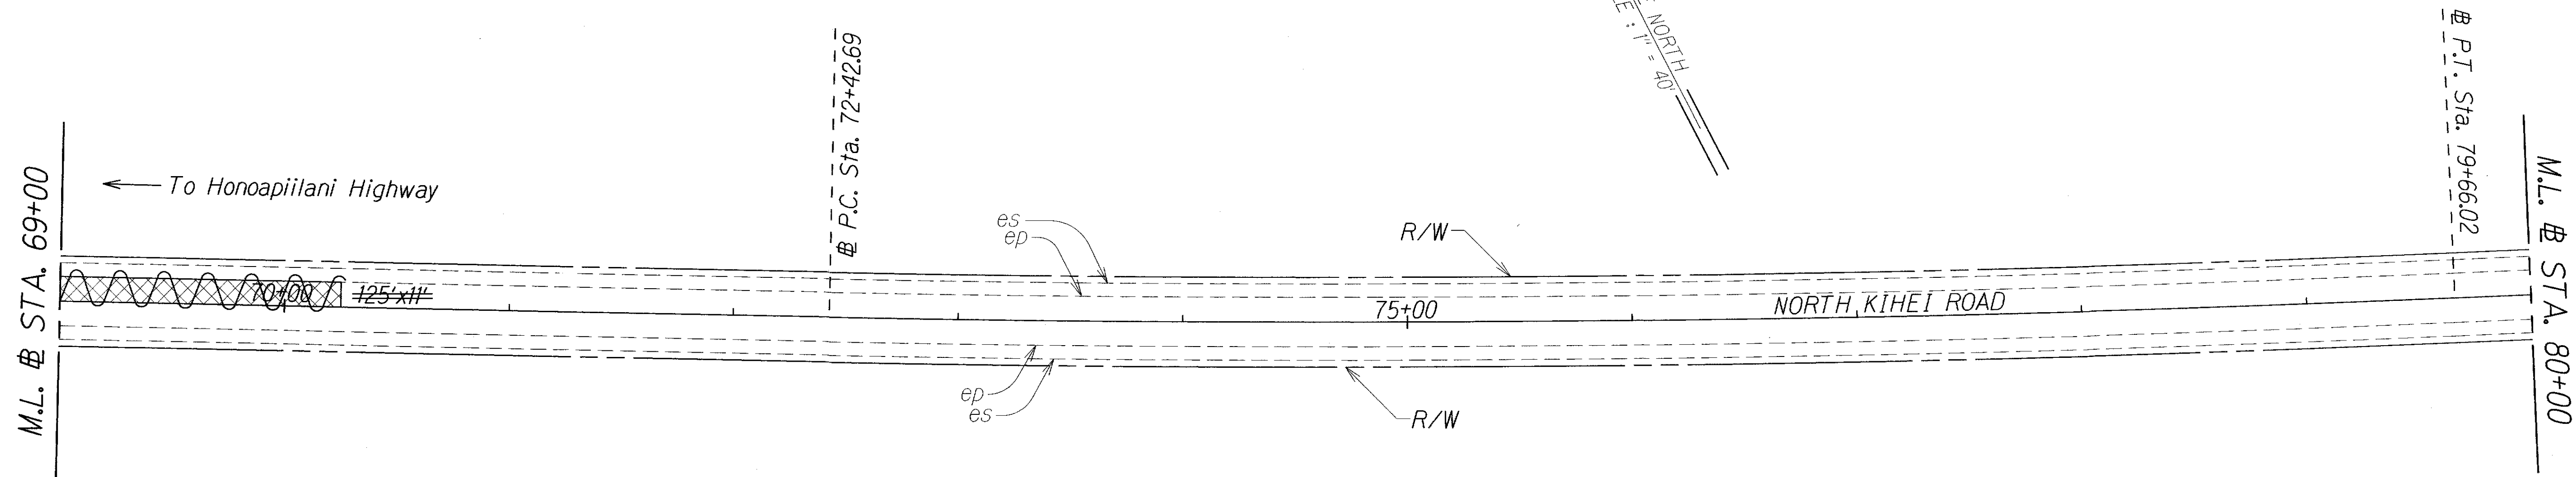

ORIGINAL PLAN	SURVEY PLOTTED BY	DATE
NOTE BOOK	DESIGNED BY	2012
QUANTITIES BY	CHECKED BY	

LEGEND FOR AS-BUILT POSTINGS	
	Squiggly line for as-built deletion
	Double line for as-built deletion
Roadway	Text for as-built posting

STATE OF HAWAII
DEPARTMENT OF TRANSPORTATION
HIGHWAYS DIVISION

ROADWAY PLAN

NORTH KIHAI ROAD RESURFACING
Honoapiilani Highway to Piilani Highway
Project No. 310A-01-13M

Scale: 1" = 40' Date: October, 2012

SHEET No. 7 OF 9 SHEETS

"AS-BUILT"

Plan view of North Kihei Road showing stationing, right-of-way, and proposed paving grid. The drawing includes station markers from 91+00 to 102+00, right-of-way (R/W) lines, and proposed paving grid lines (ep, es). A note indicates that the paving grid will be before overlay work. A legend for as-built postings is provided.

LEGEND FOR AS-BUILT POSTINGS

	Squiggly line for as-built deletion
	Double line for as-built deletion
Roadway	Text for as-built posting

Plan view of North Kihei Road showing stationing, right-of-way, and proposed paving grid. The drawing includes station markers from 91+00 to 102+00, right-of-way (R/W) lines, and proposed paving grid lines. A note indicates that the paving grid will be before overlay work, and limits or areas in the field will be paid under Item 100.00. A legend for as-built postings is provided at the bottom right.

LEGEND FOR AS-BUILT POSTINGS

	Squiggly line for as-built deletion
	Double line for as-built deletion
Roadway	Text for as-built posting

