
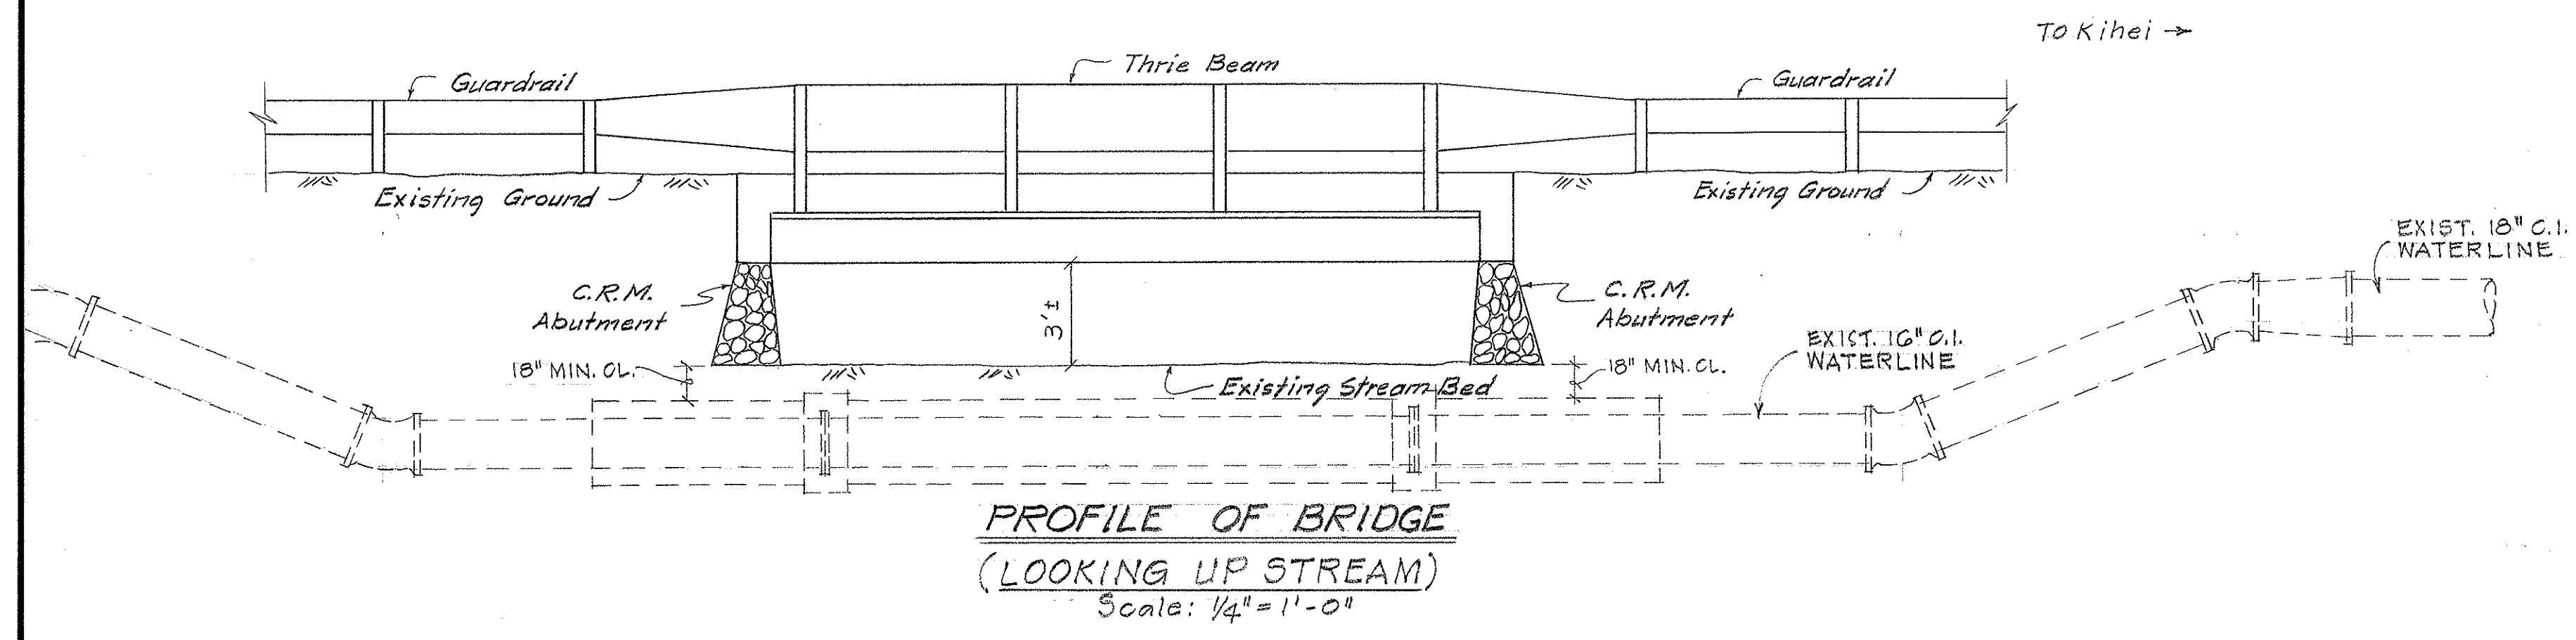


DESIGN	DATE	BY	CHECKED	DATE	BY

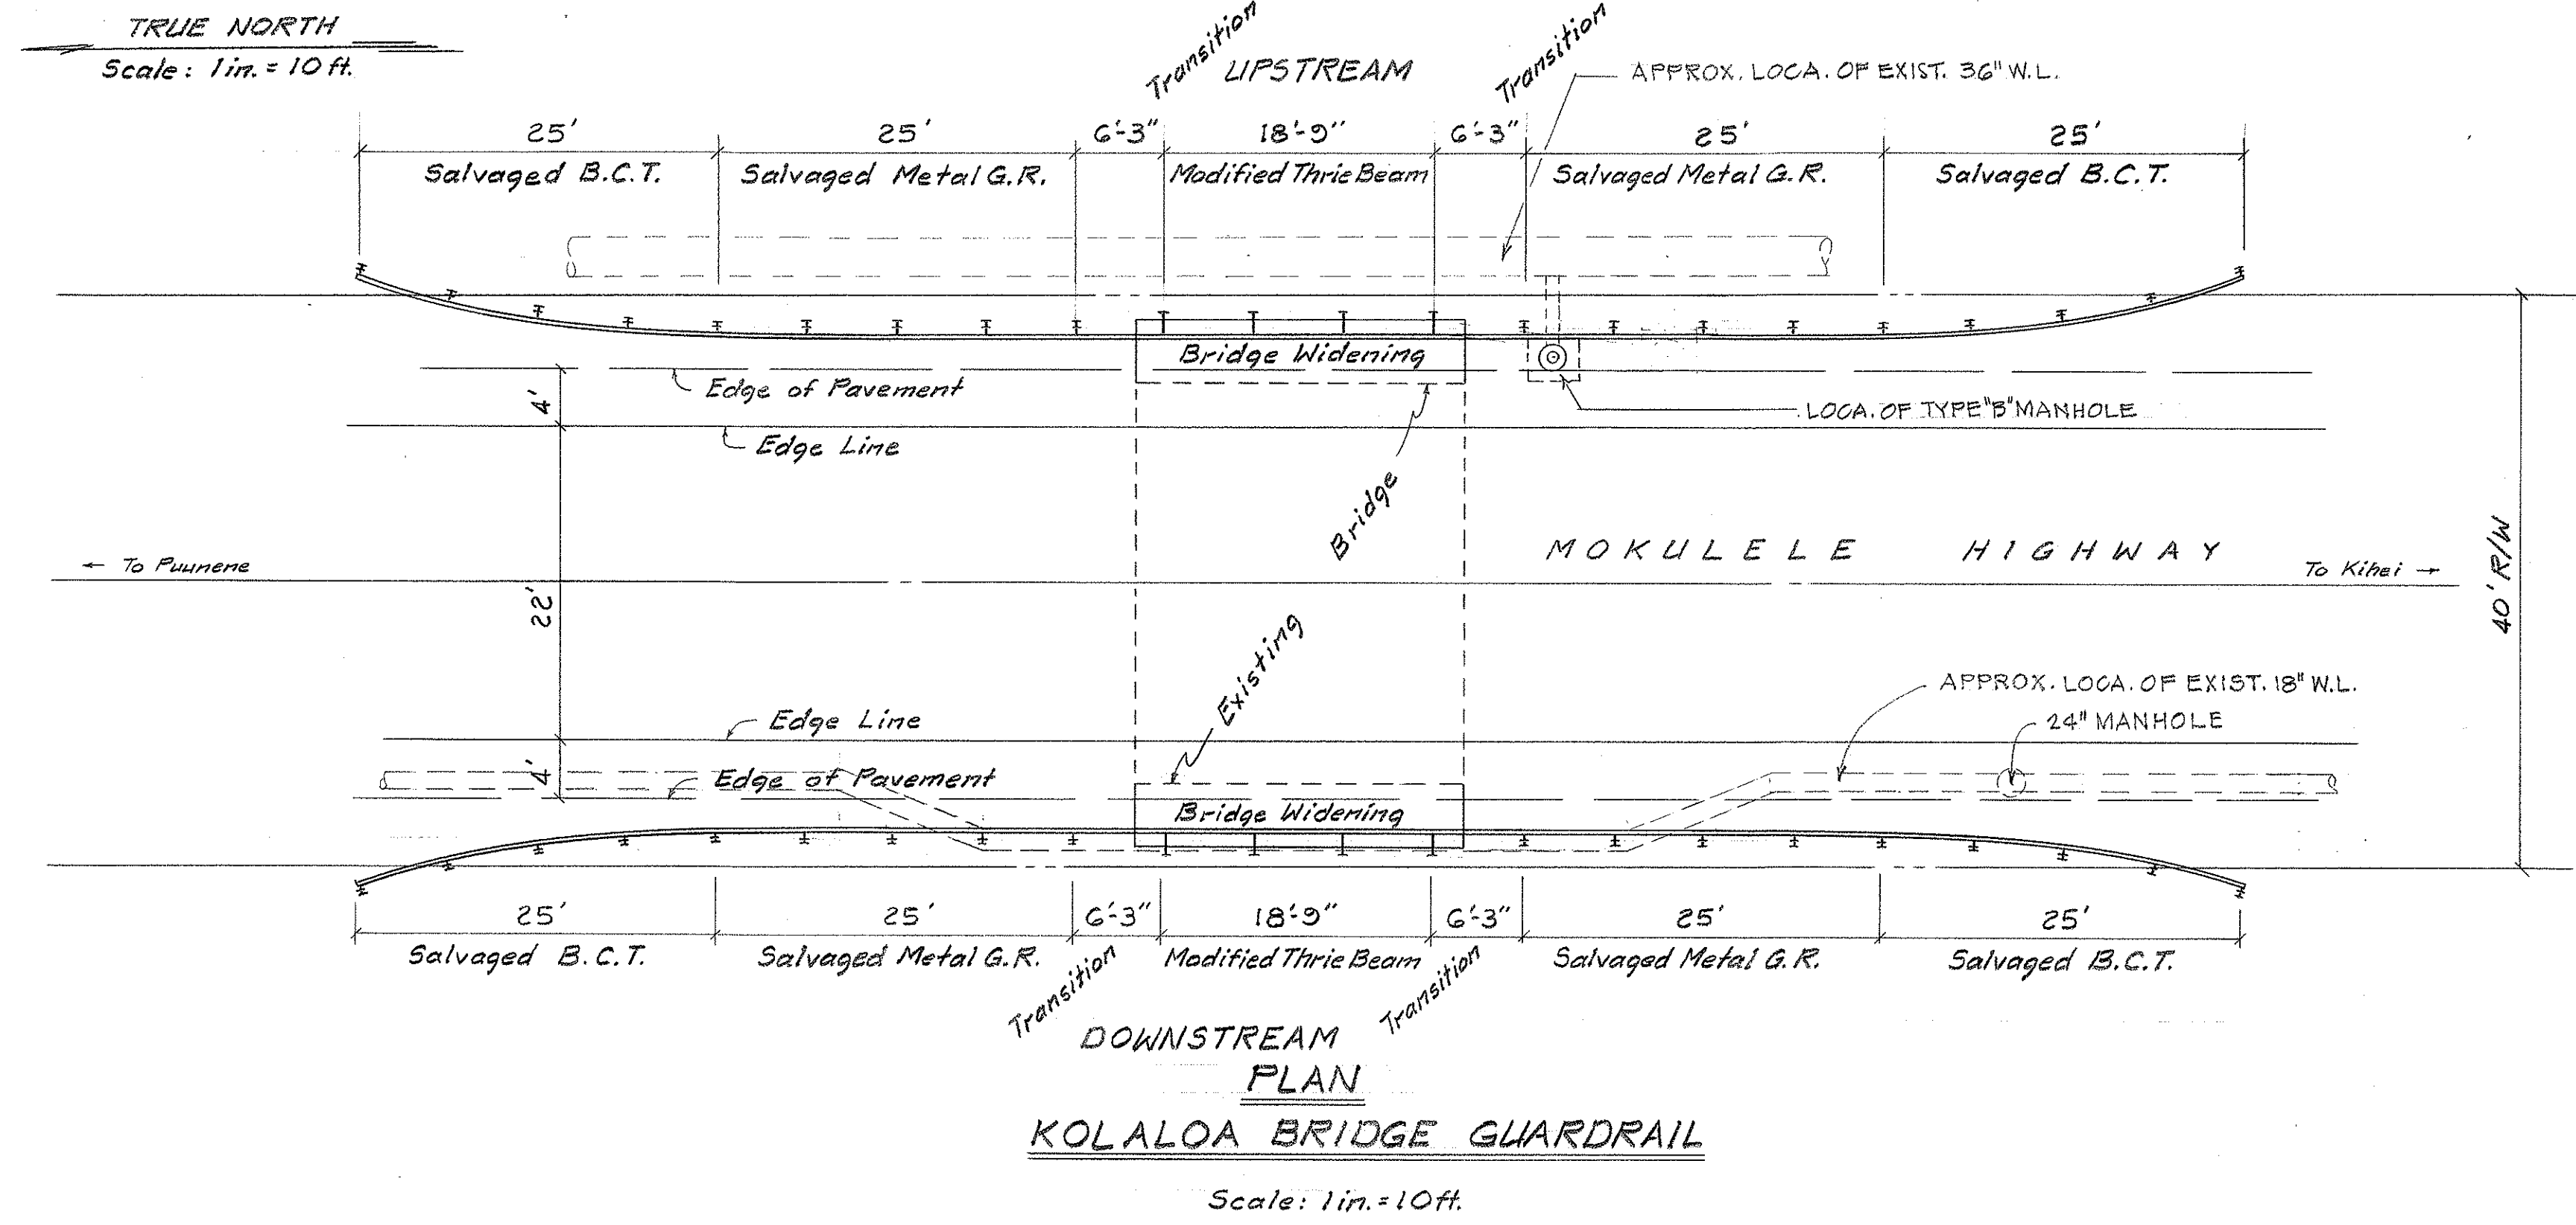

COUNTY OF MAUI
DEPARTMENT OF PUBLIC WORKS
WAILUKU, MAUI, HAWAII

BRIDGE & GUARDRAIL DETAILS
(KOLALO A BRIDGE)

MOKULELE HIGHWAY
SHOULDER WORK

JOB No. 89-41

DATE: Nov. 20, 1987 REV. DATE: JUL 14, 1989

Checked by: *Fred K. Araki*