e de distribuit de destruire de	INDEX TO DRAWINGS
SHEET NO.	DESCRIPTION
1	TITLE SHEET
2	STANDARD PLAN SUMMARY
3	GENERAL NOTES AND LEGEND
4	TYPICAL SECTIONS
5–7	PLANS
8	PAVEMENT MARKINGS LEGENDS, DETAIL AND NOTES
9	STRIPING PLAN
10–12	MISCELLANEOUS SUMMARIES

STATE OF HAWAII

DEPARTMENT OF TRANSPORTATION


HIGHWAYS DIVISION HONOLULU, HAWAII

"AS-BUILT"
PLANS FOR

PUUNENE AVENUE IMPROVEMENTS


KUIHELANI HIGHWAY TO MOKULELE HIGHWAY PROJECT NO. 311A-02-93

DISTRICT OF WAILUKU ISLAND OF MAUI

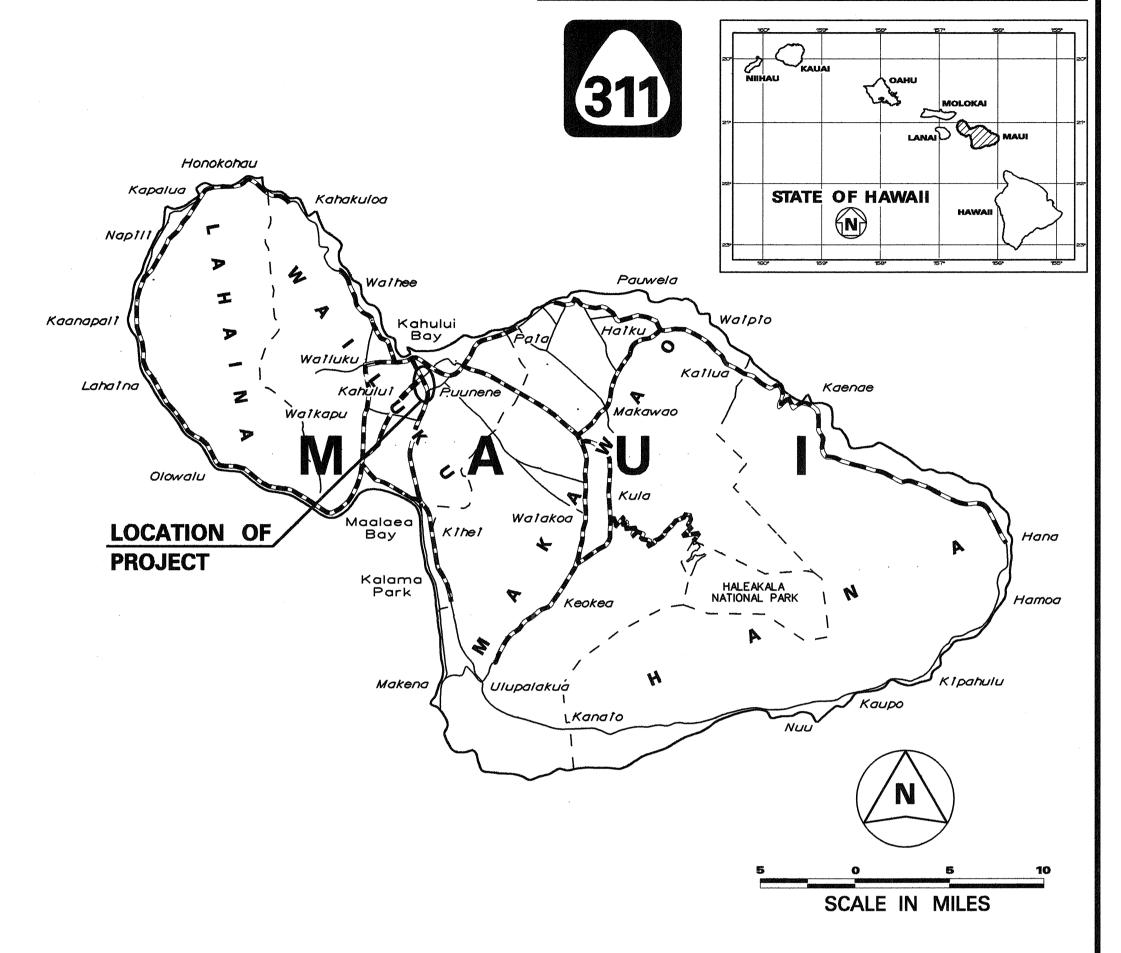

FEDERAL AID PROJECTS PREVIOUSLY CONSTRUCTED OR UNDER CONSTRUCTION

PUUNENE AVE. MILE POST 0.00 TO MILE POST 0.64

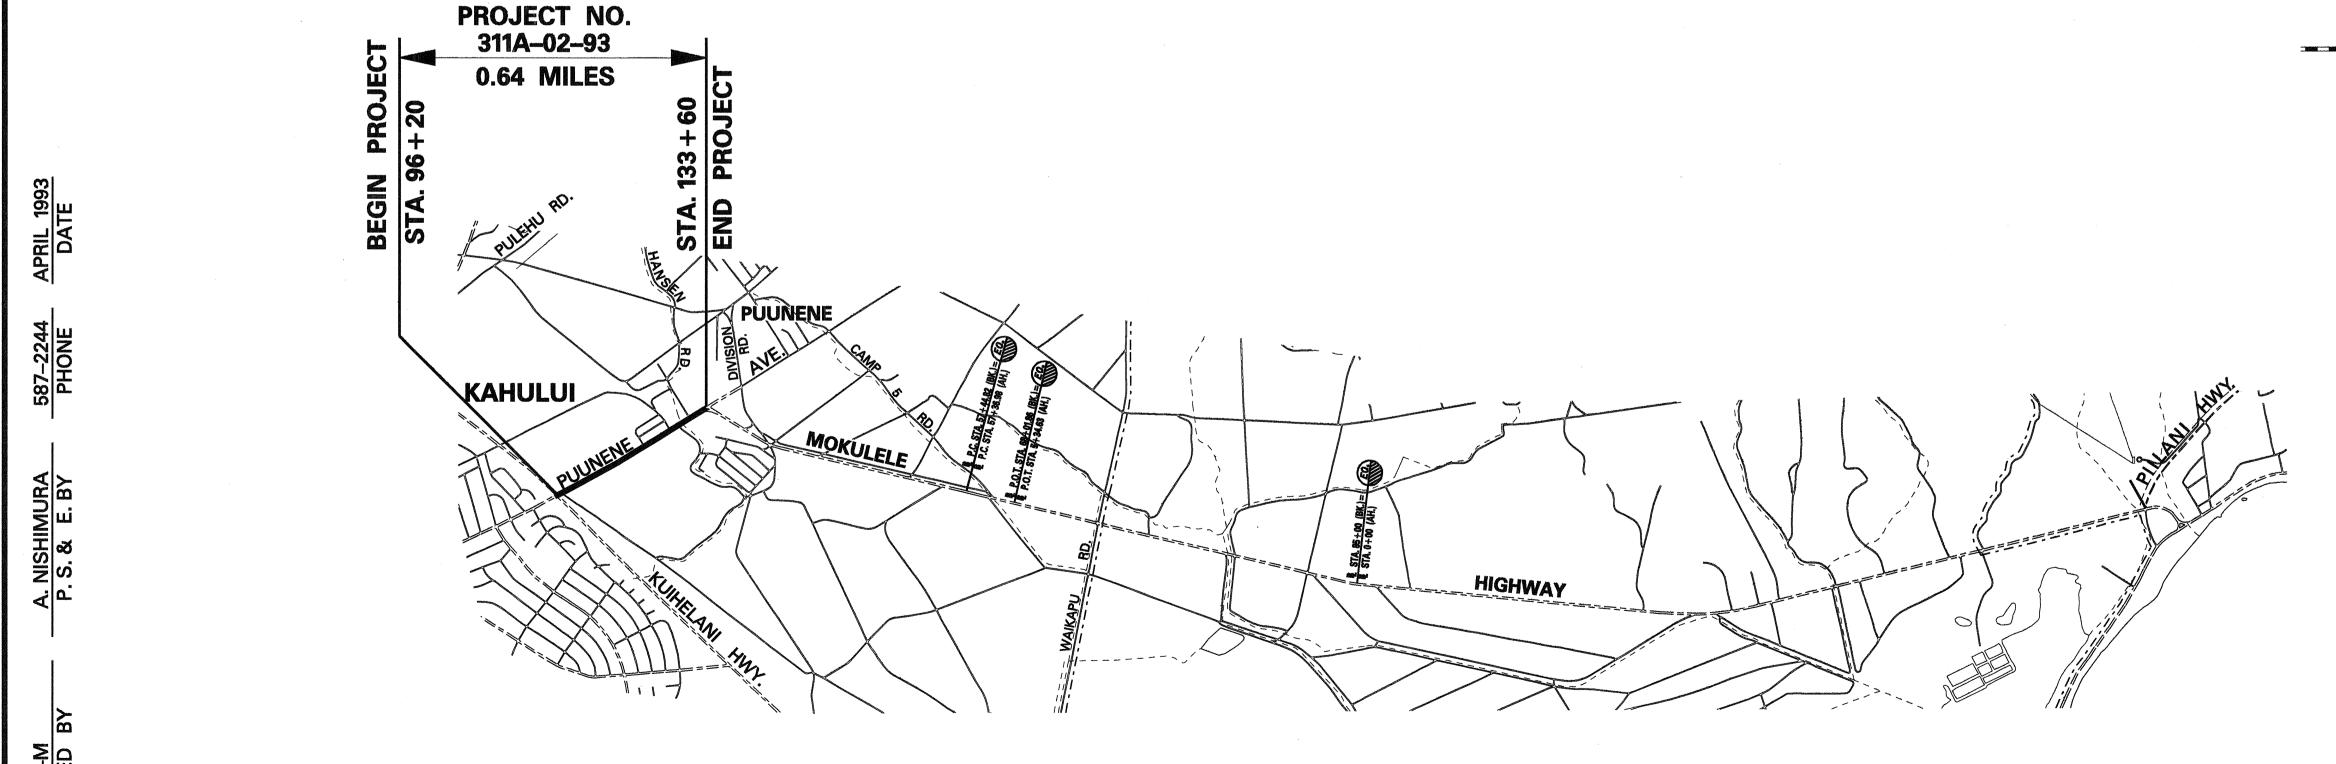

ALL CHANGES MADE DURING CONSTRUCTION HAVE BEEN NOTED IN RED ON THESE TRACINGS AND CHECKED BY

PROJECT ENGINEER

DATE

FISCAL SHEET YEAR NO.

PROJ. NO.

311A-02-93

STATE

DEPARTMENT OF TRANSPORTATION
STATE OF HAWAII

APPROVED:

Standard Strong 6/1/93
WDIR. OF TRANSPORTATION DATE

O 2 4 6

SCALE IN THOUSAND FEET

LAYOUT PLAN

Z

T THANSFORTATION