

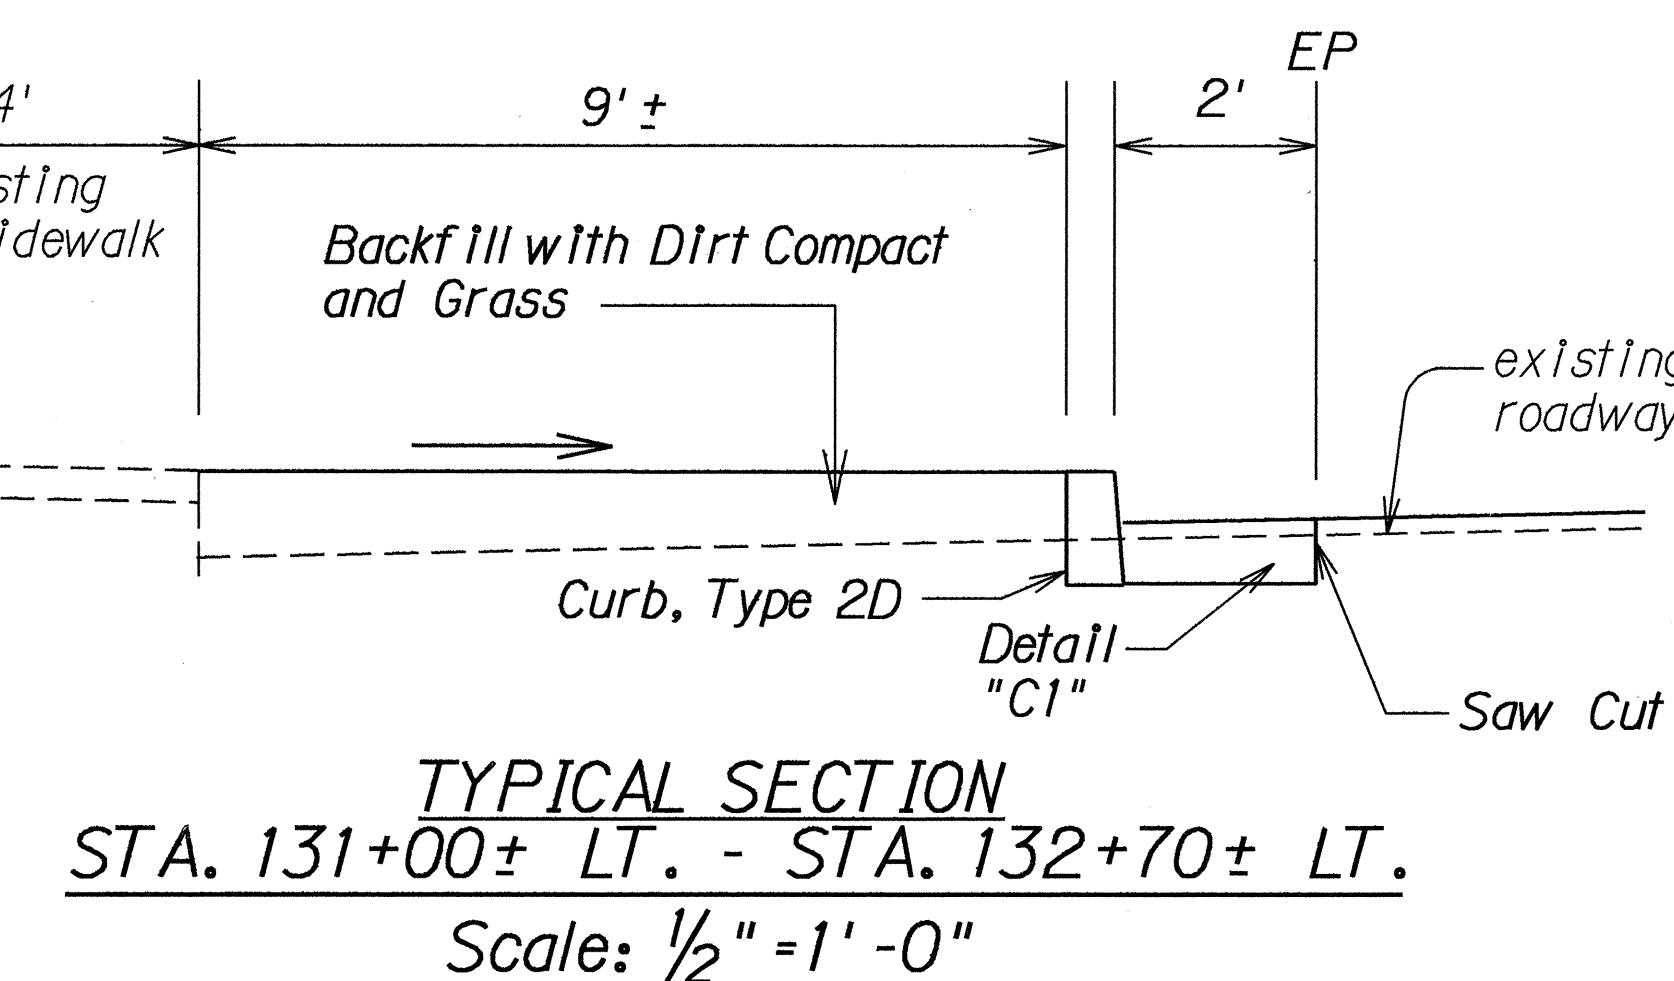
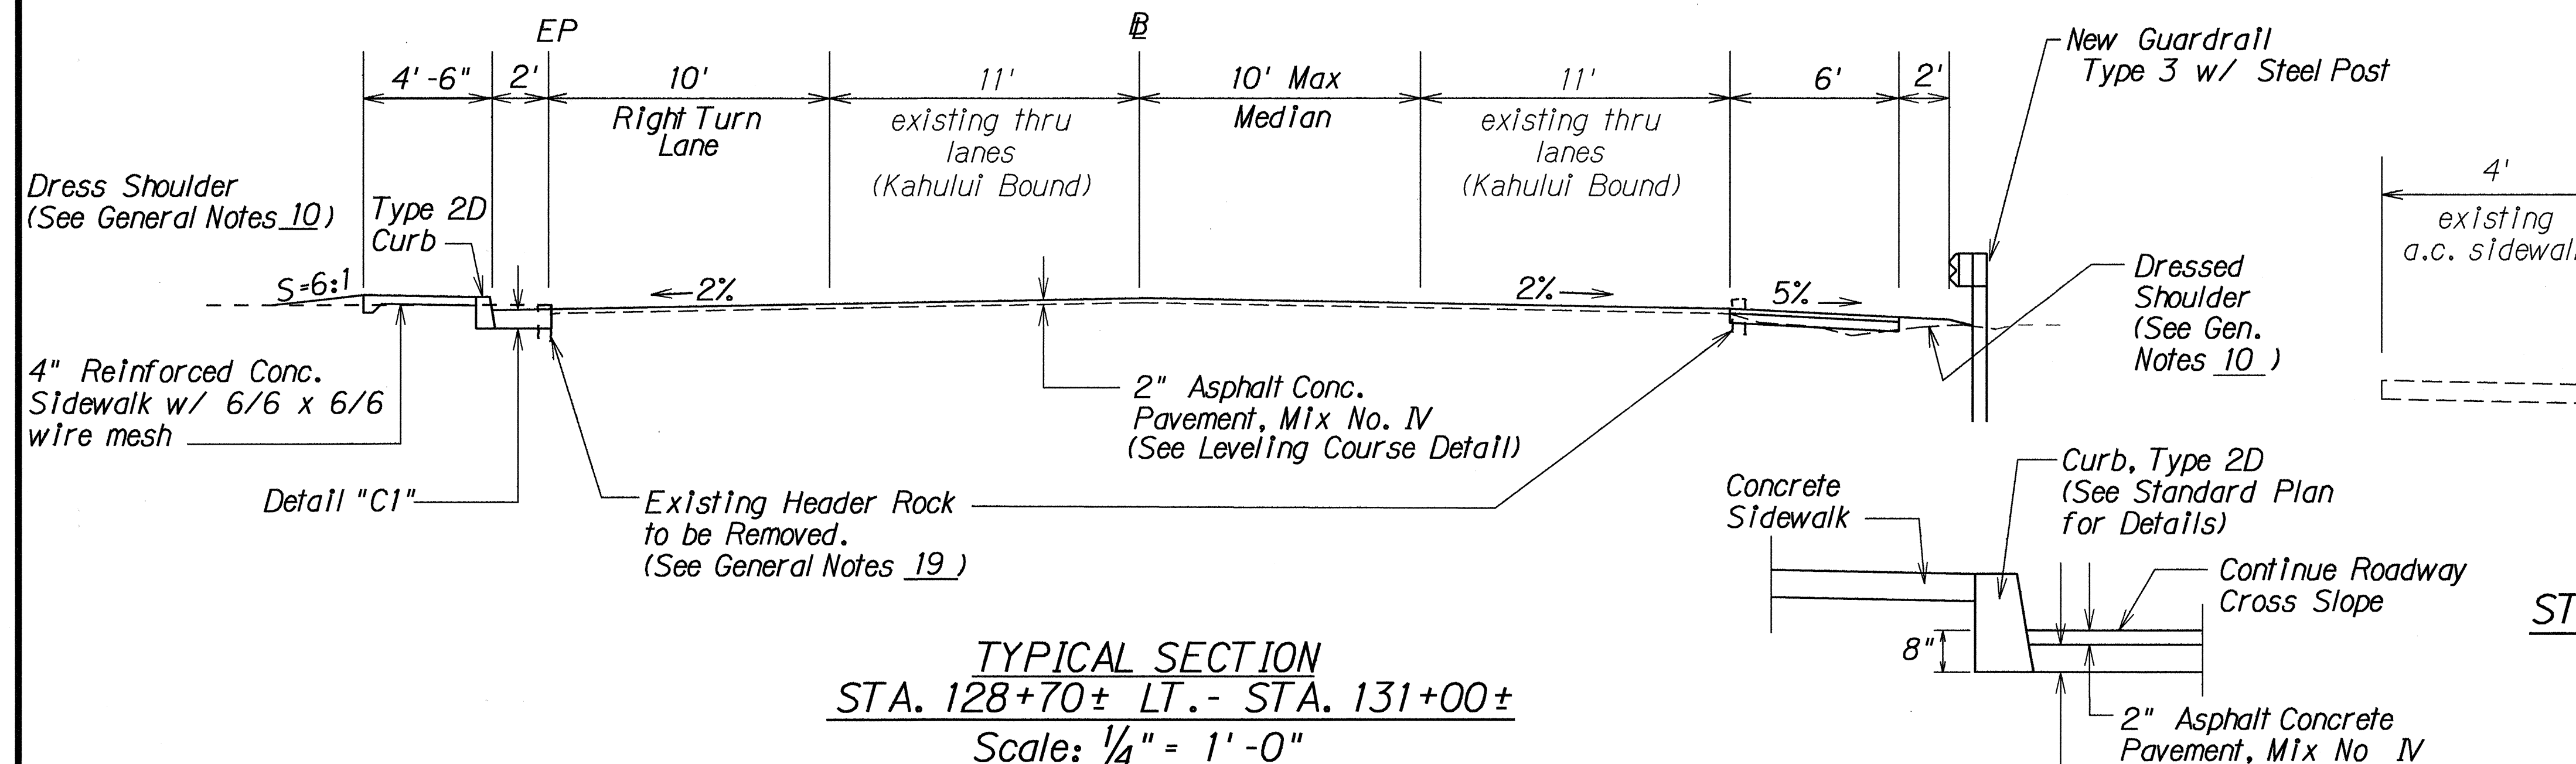




| FED. ROAD DIST. NO. | STATE | PROJ. NO.  | FISCAL YEAR | SHEET NO. | TOTAL SHEETS |
|---------------------|-------|------------|-------------|-----------|--------------|
| HAWAII              | HAW.  | 311A-02-93 | 1993        | 4         | 12           |

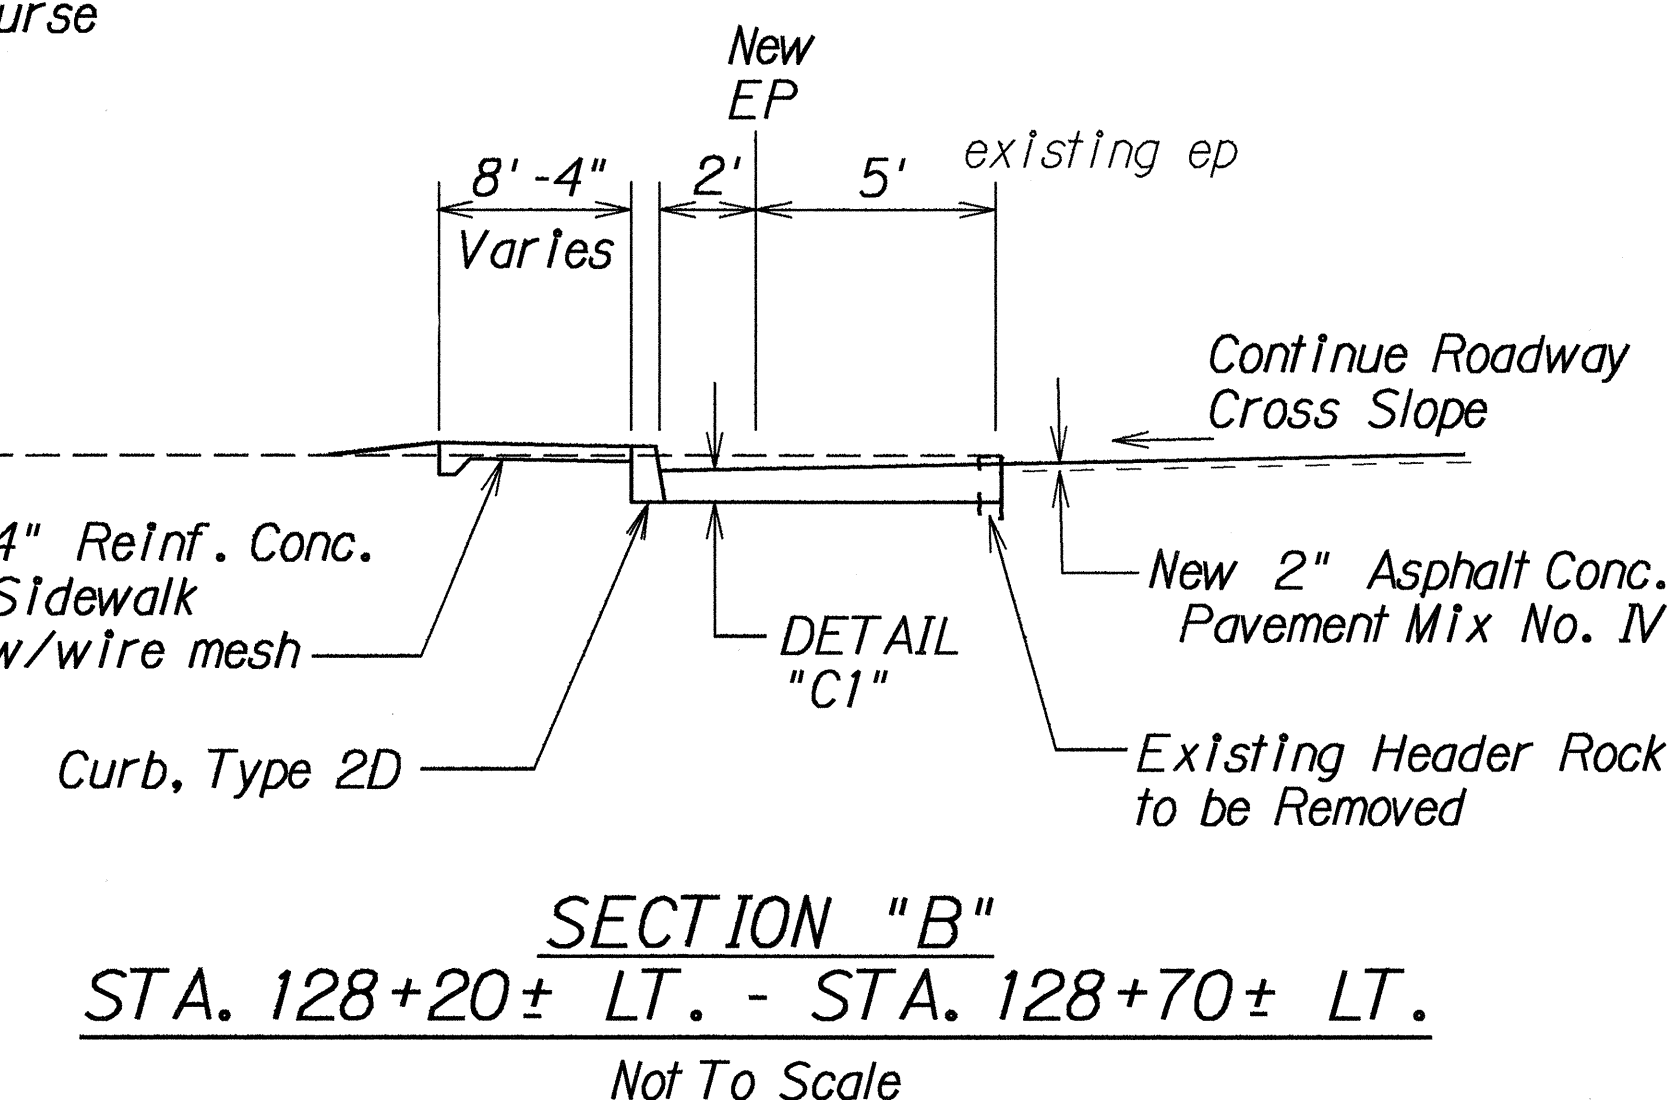

**DETAIL CI**  
Not To Scale

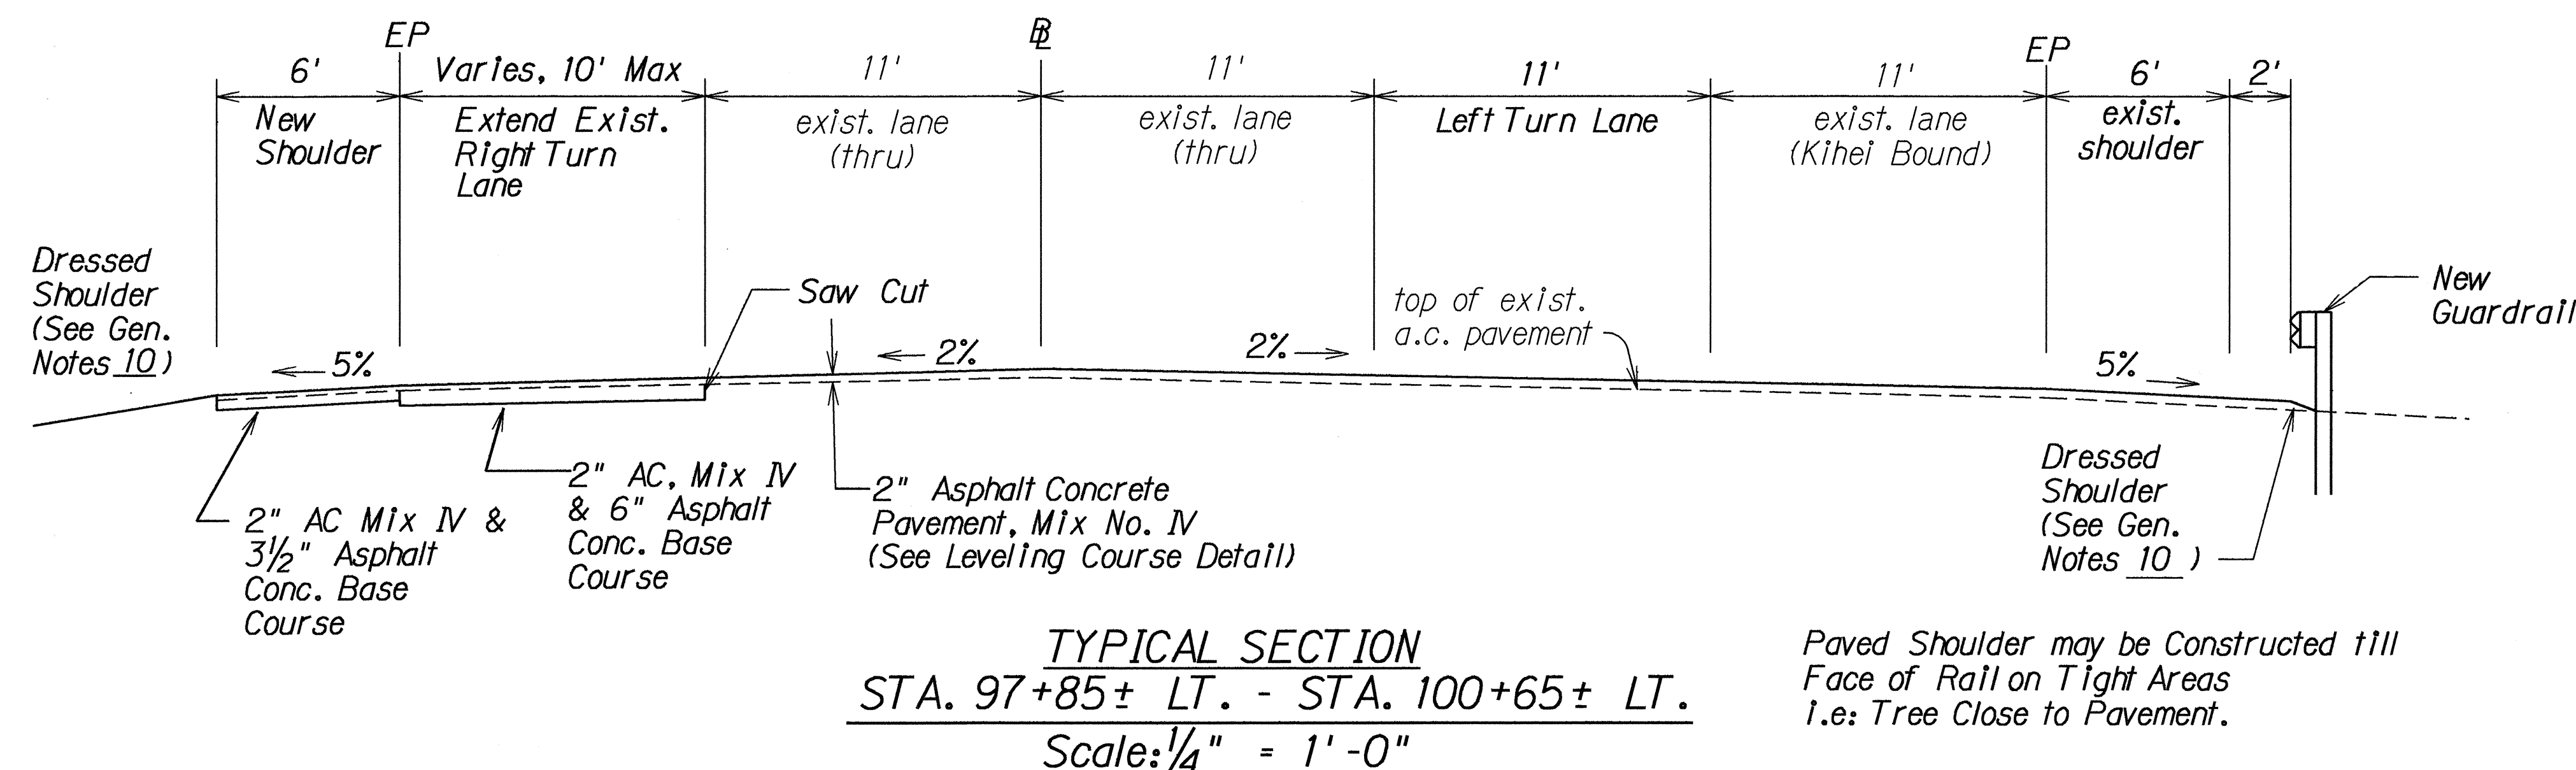

Paved Shoulder may be Constructed till Face of Rail on Tight Areas i.e. Tree Close to Pavement.

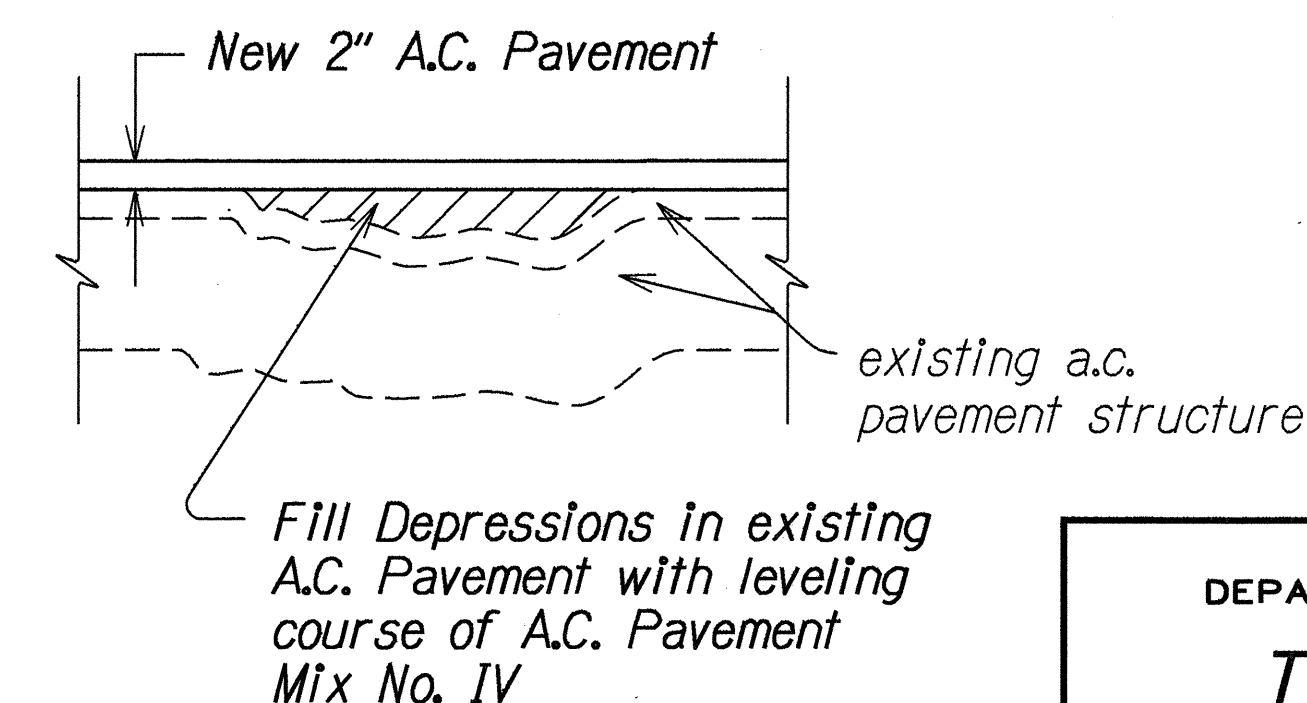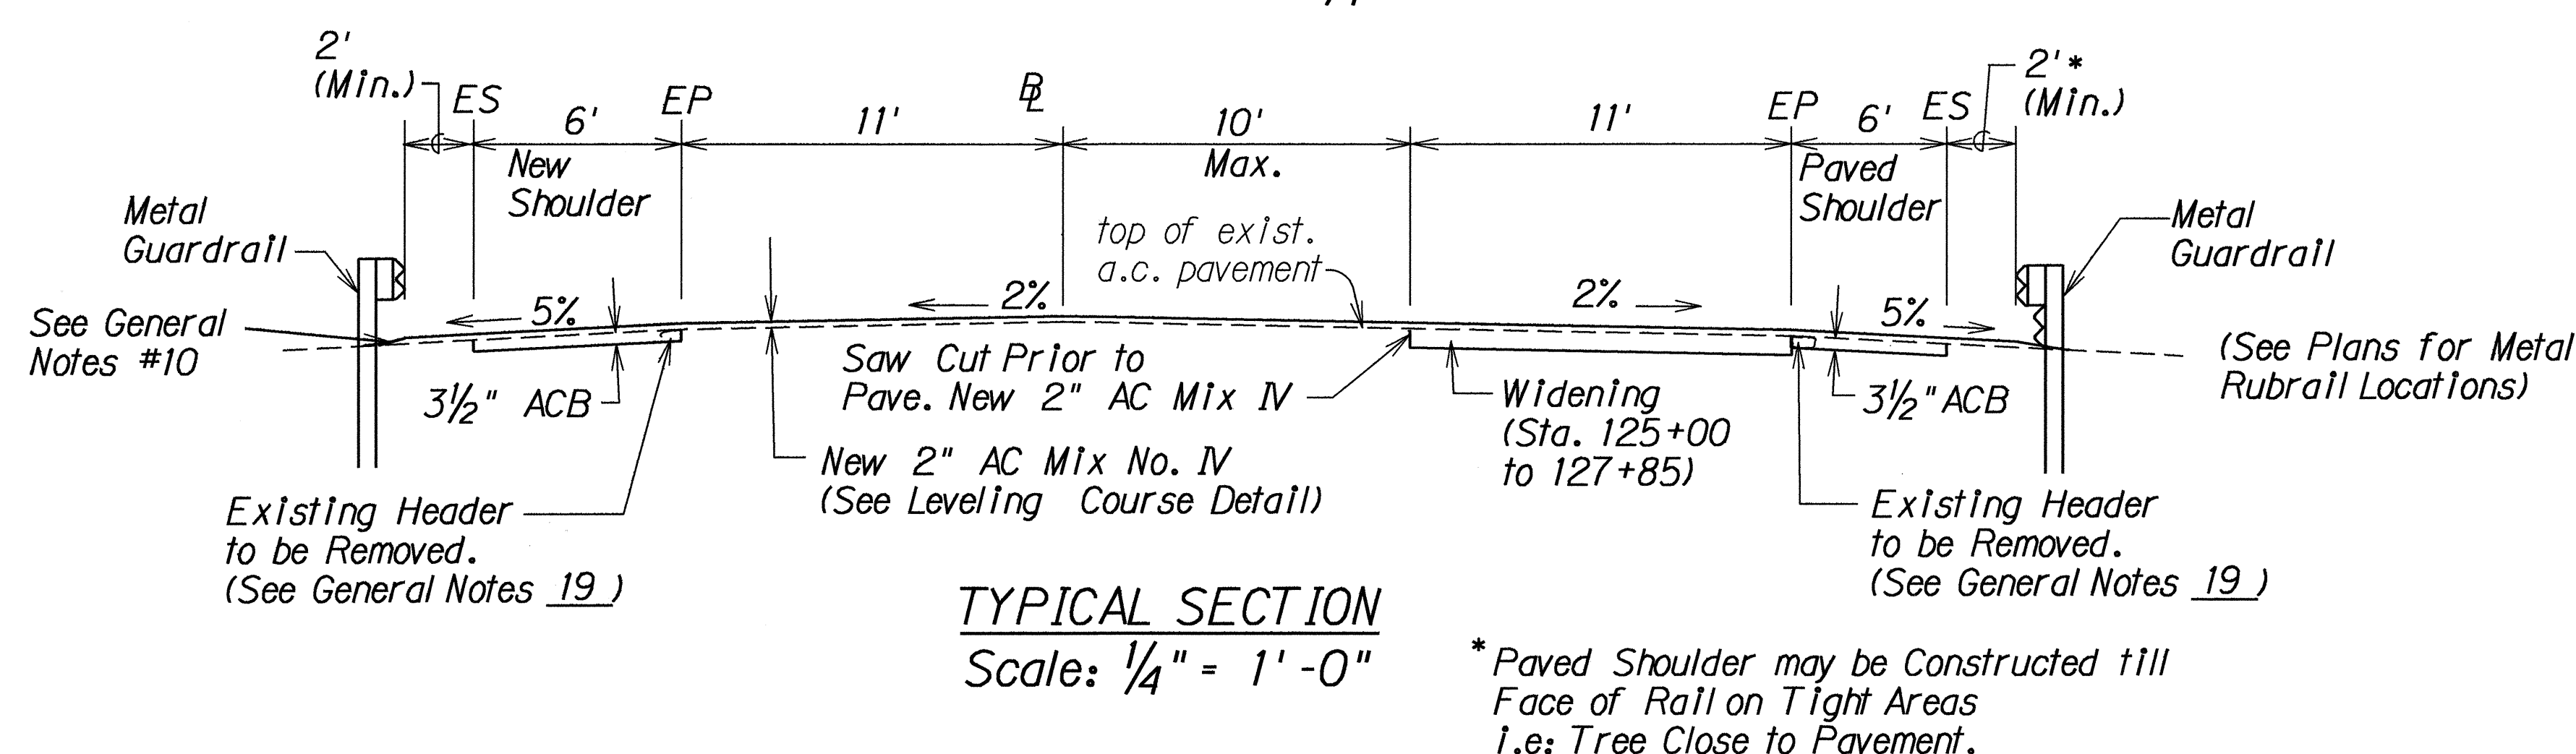

|                                                                      |                   |
|----------------------------------------------------------------------|-------------------|
| STATE OF HAWAII<br>DEPARTMENT OF TRANSPORTATION<br>HIGHWAYS DIVISION |                   |
| <b>TYPICAL SECTIONS<br/>AND DETAILS</b>                              |                   |
| PUUNENE AVENUE IMPROVEMENTS<br>Kuhelani Highway to Mokulele Highway  |                   |
| PROJECT NO. 311A-02-93                                               |                   |
| Scale: As Shown                                                      | Date: March, 1993 |
| SHEET No. 1 OF 1 SHEETS                                              |                   |