



FED. ROAD DIST. NO.	STATE	FEDERAL - AID PROJ. NO.	FISCAL YEAR	SHEET NO.	TOTAL SHEETS
HAWAII	HAW.	NH-A311(3)	2002	41	159

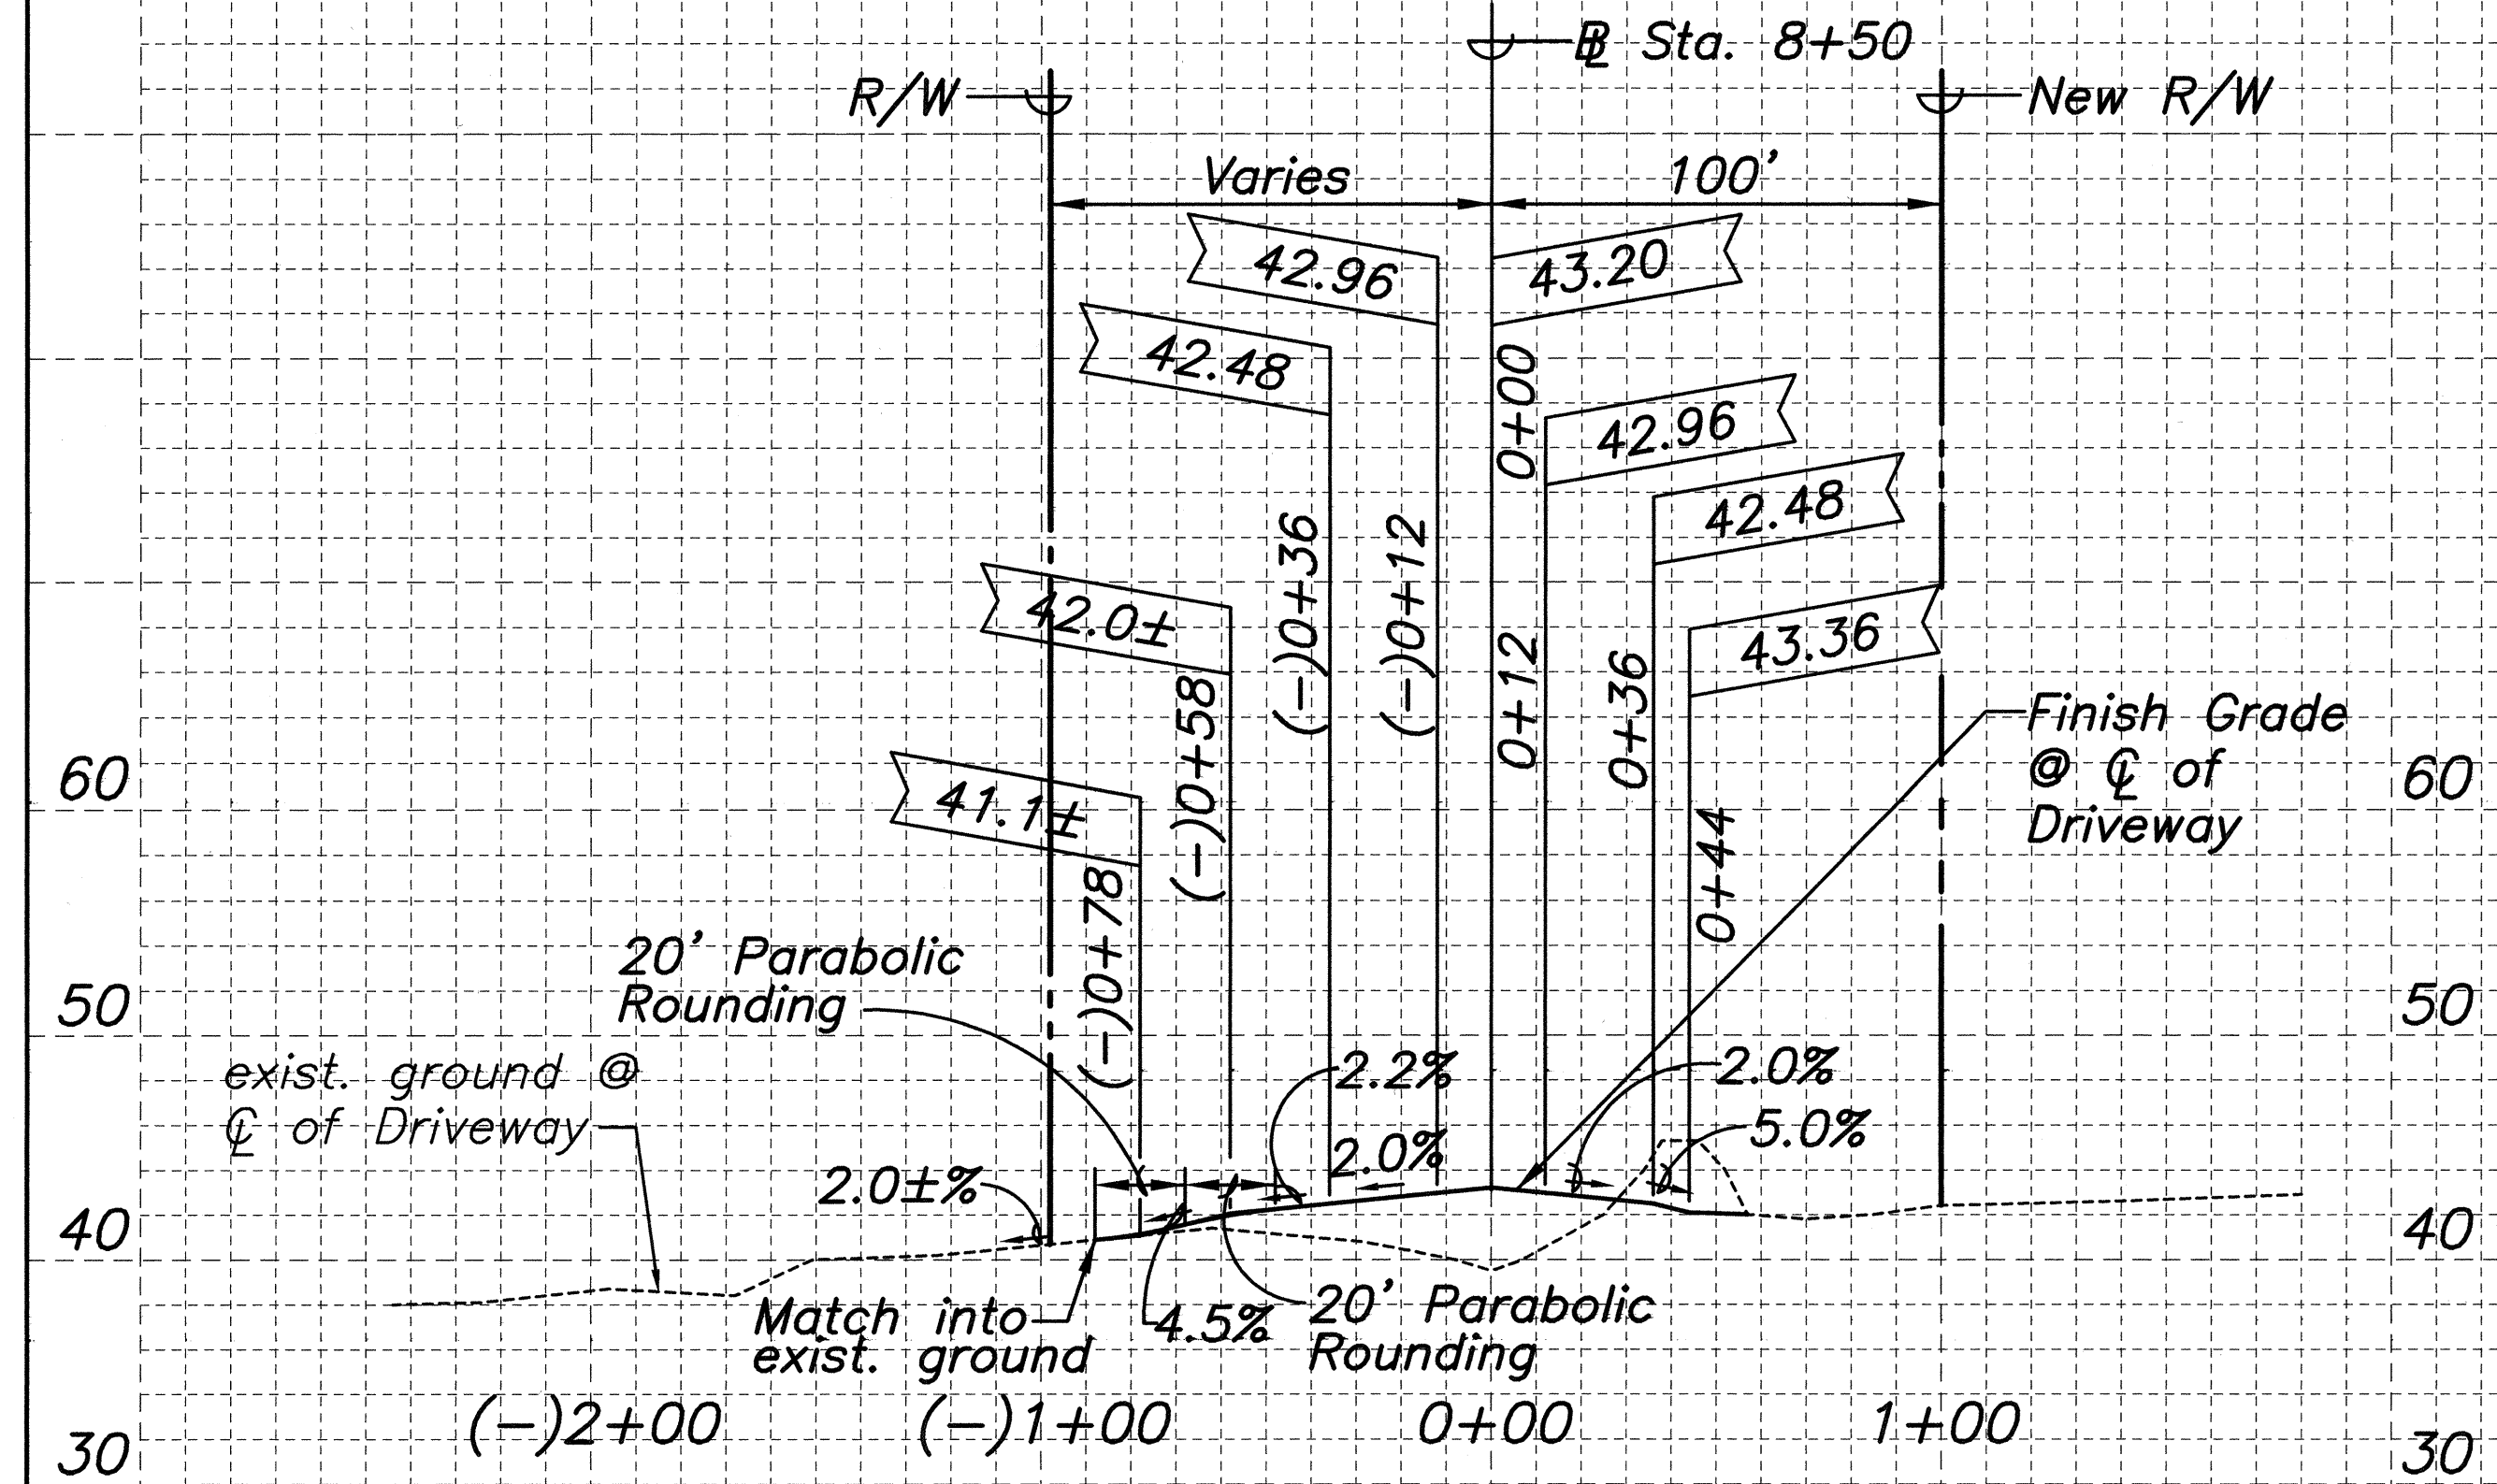


PROFILE-FIRST ASSEMBLY OF GOD
@ STA. 8+50

Scale: 1"=40' Horiz.
1"=8' Vert.

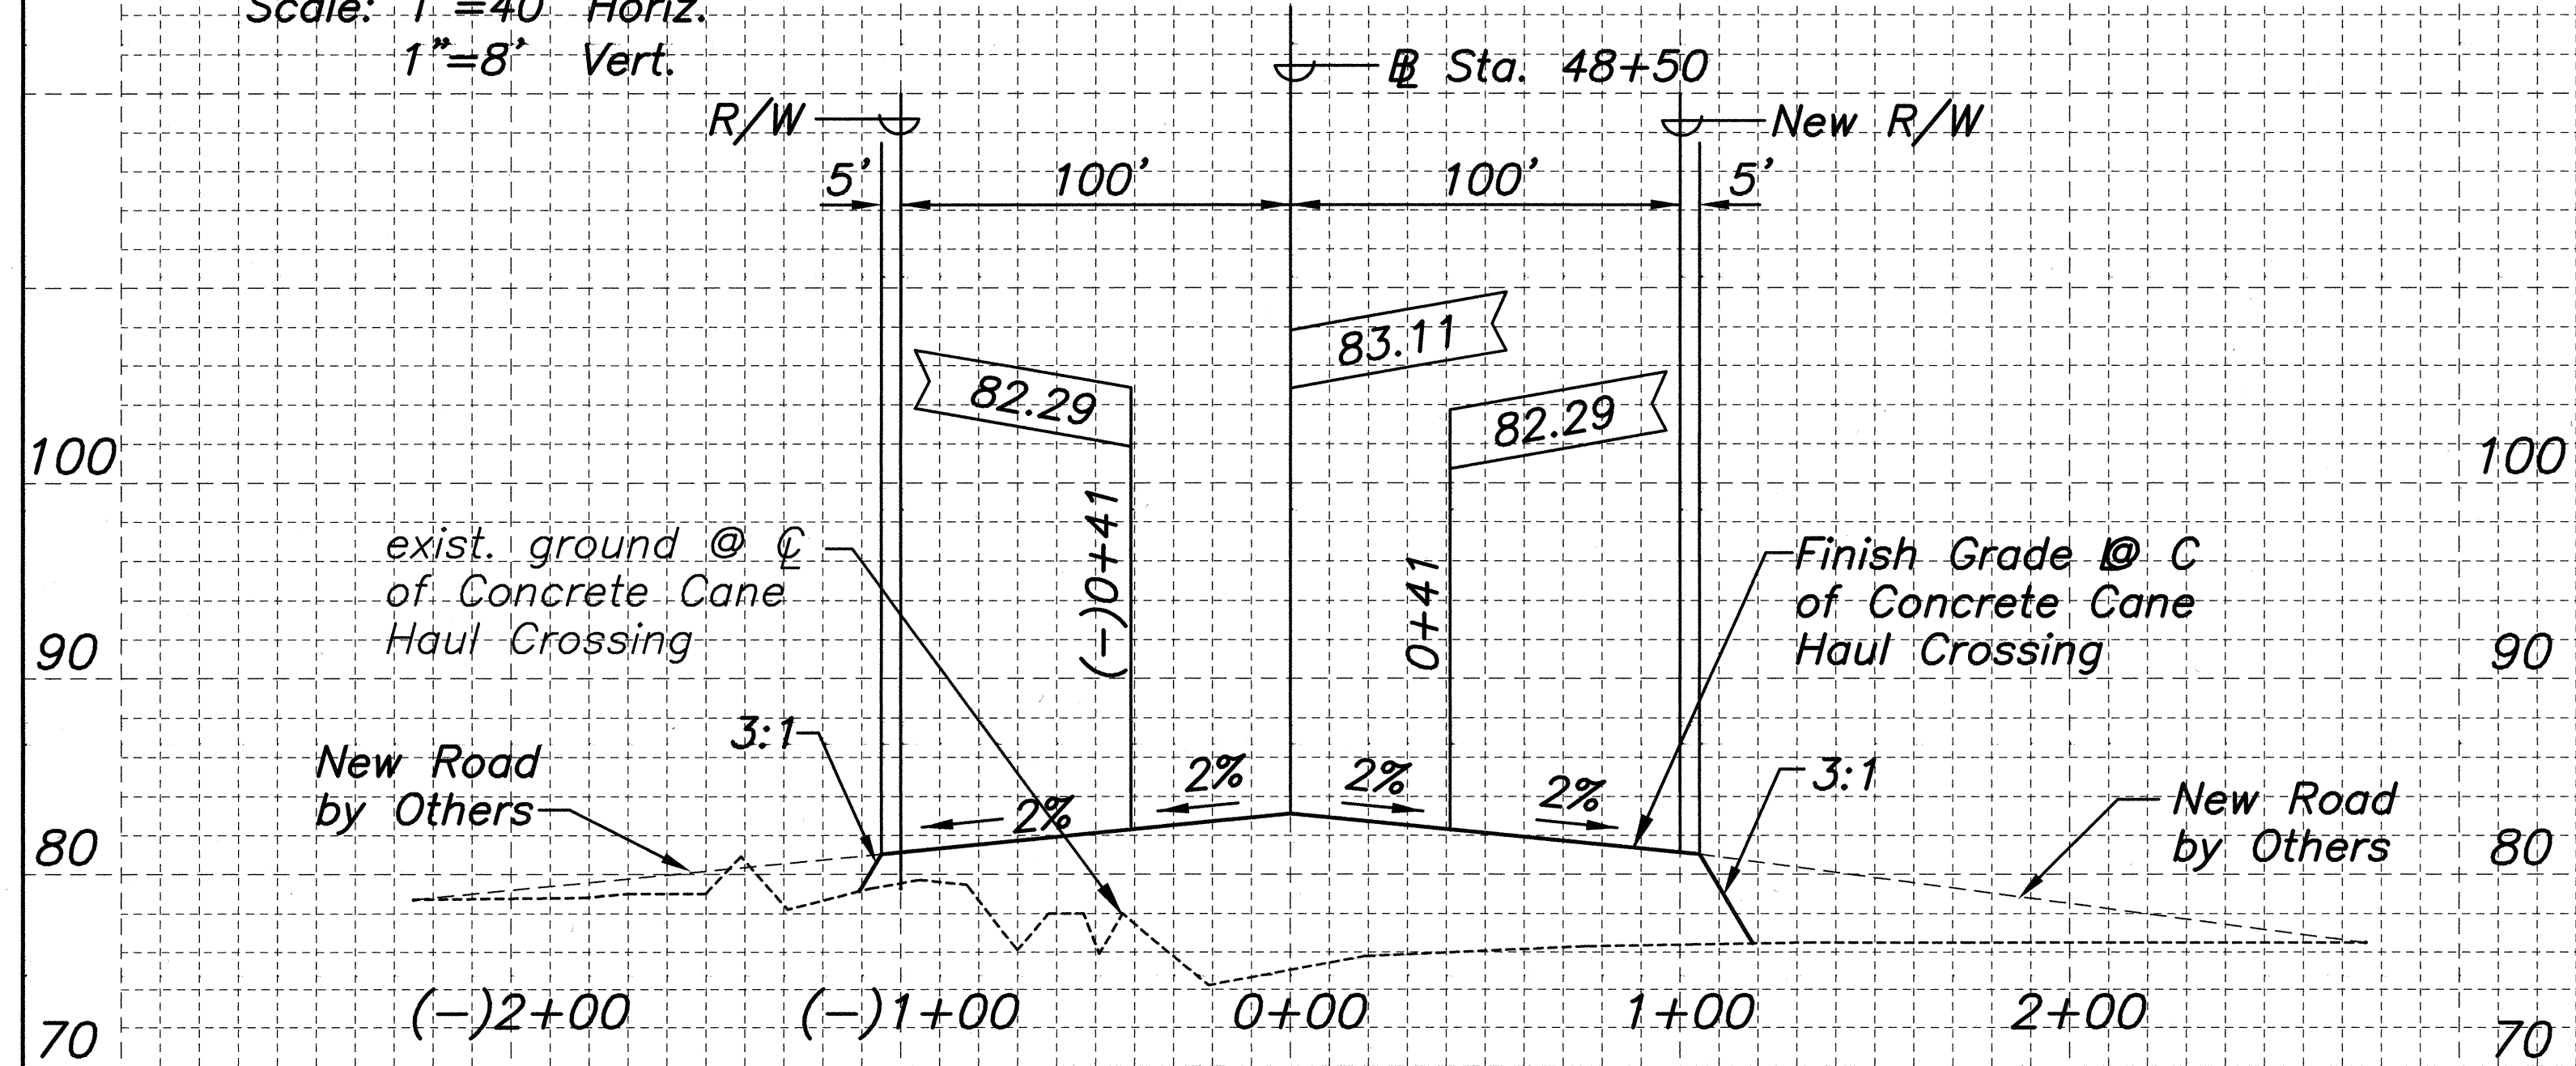


PROFILE-CONCRETE CANE HAUL CROSSING @ STA. 48+50

Scale: 1"=40' Horiz.
1"=8' Vert.

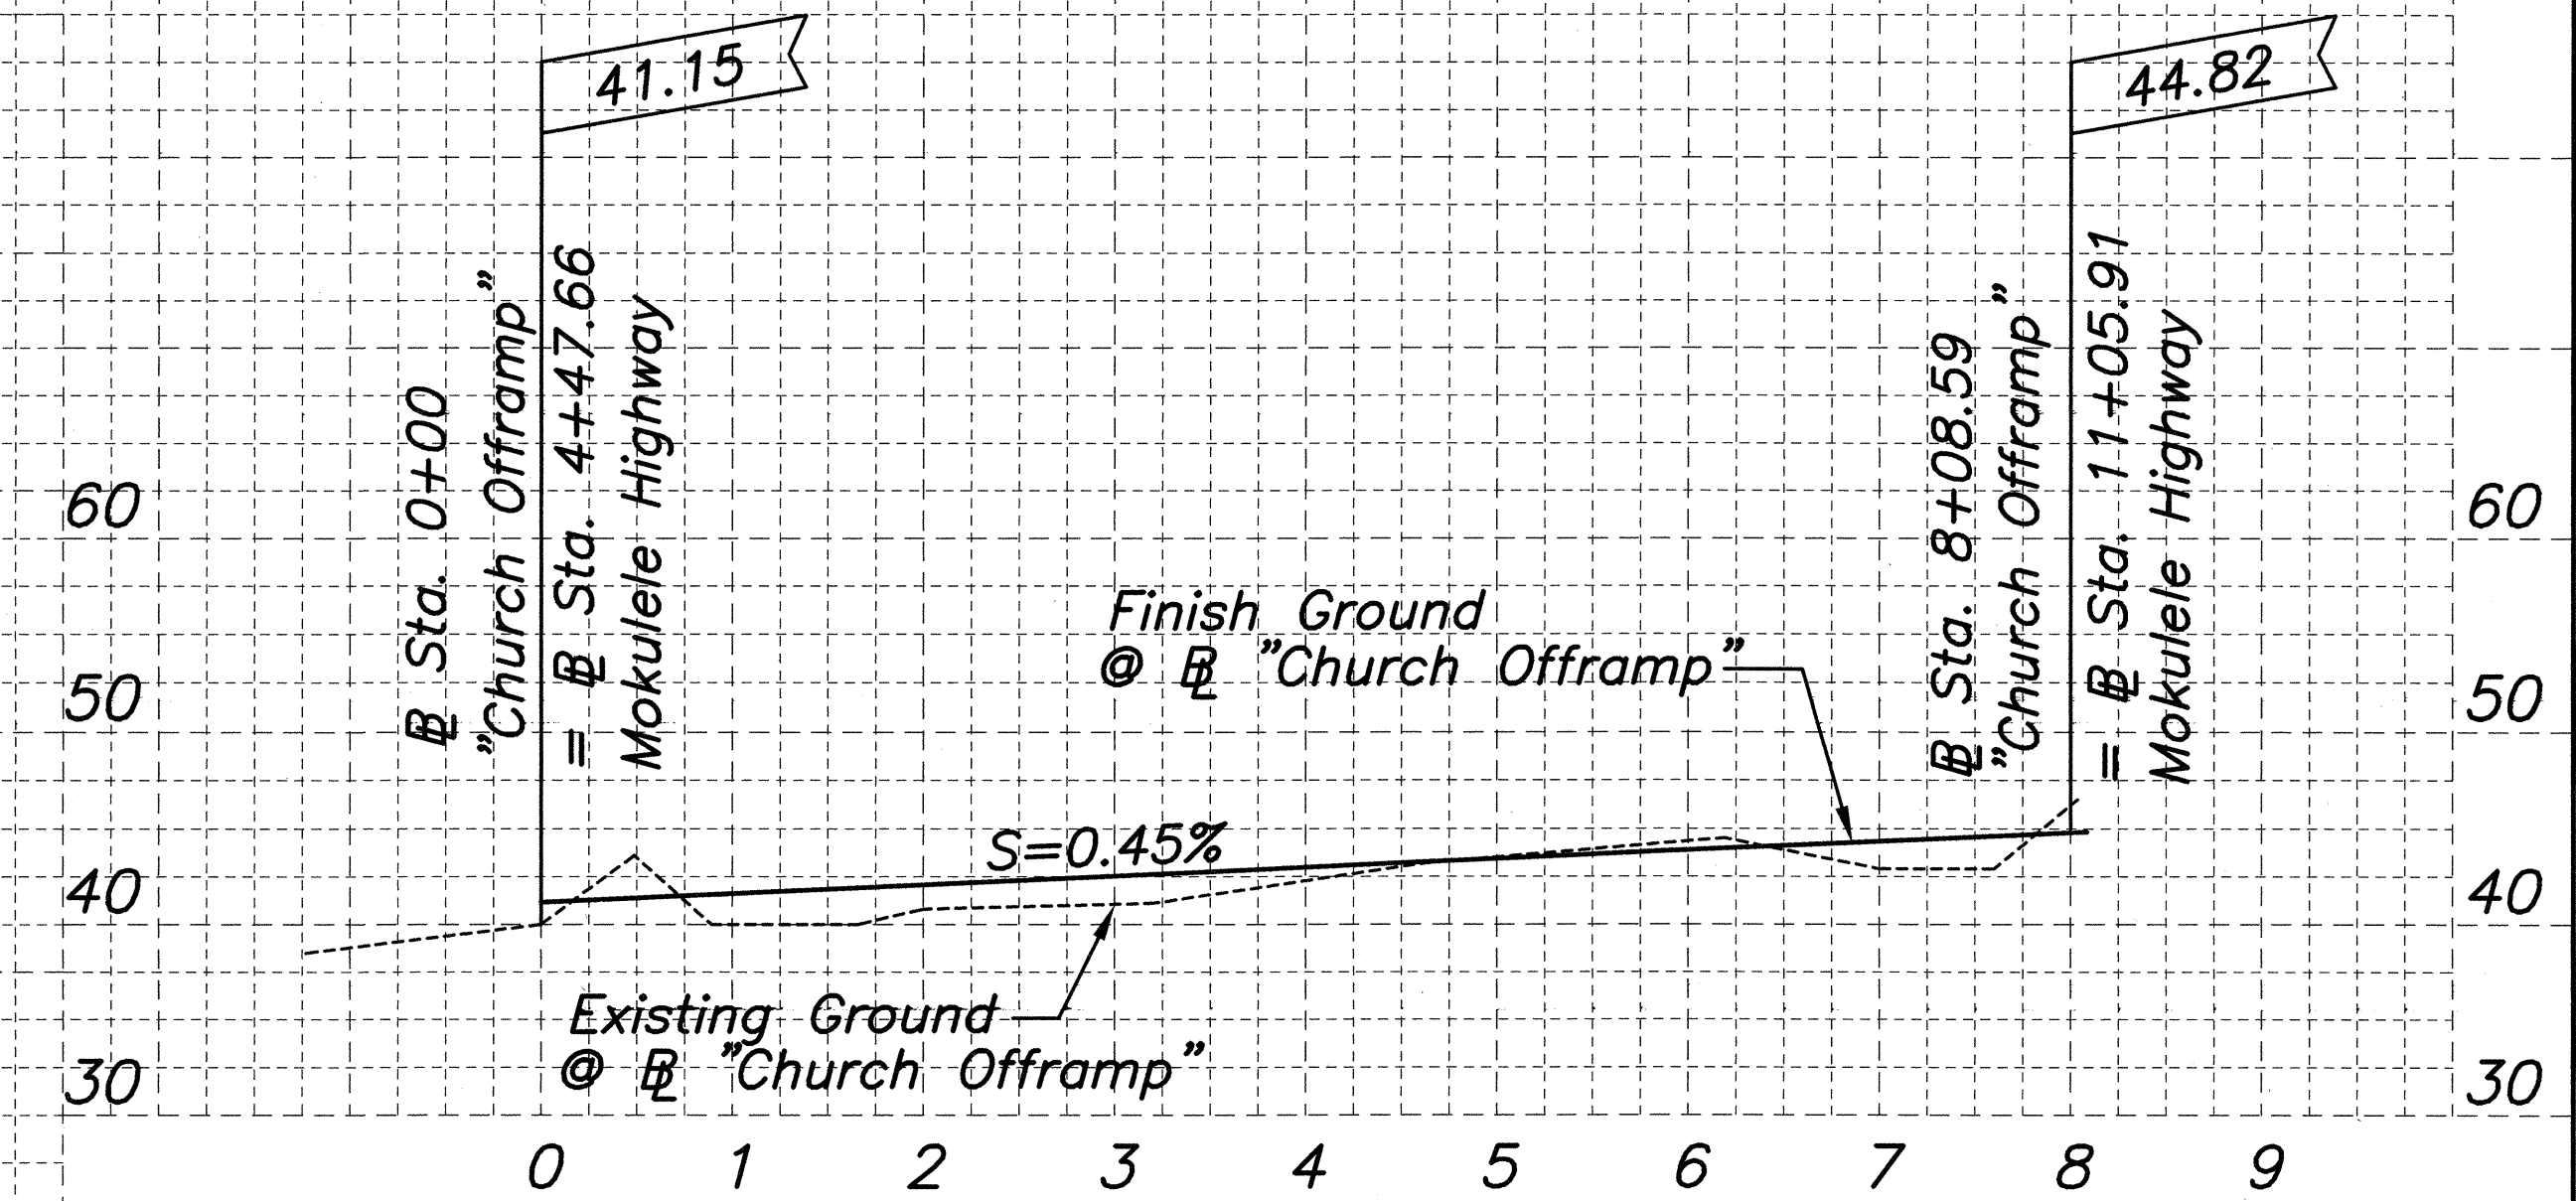

PROFILE-CHURCH OFFRAMP
@ STA. 4+47.88 to 11+05.48

Scale: 1"=100' Horiz.
1"=10' Vert.

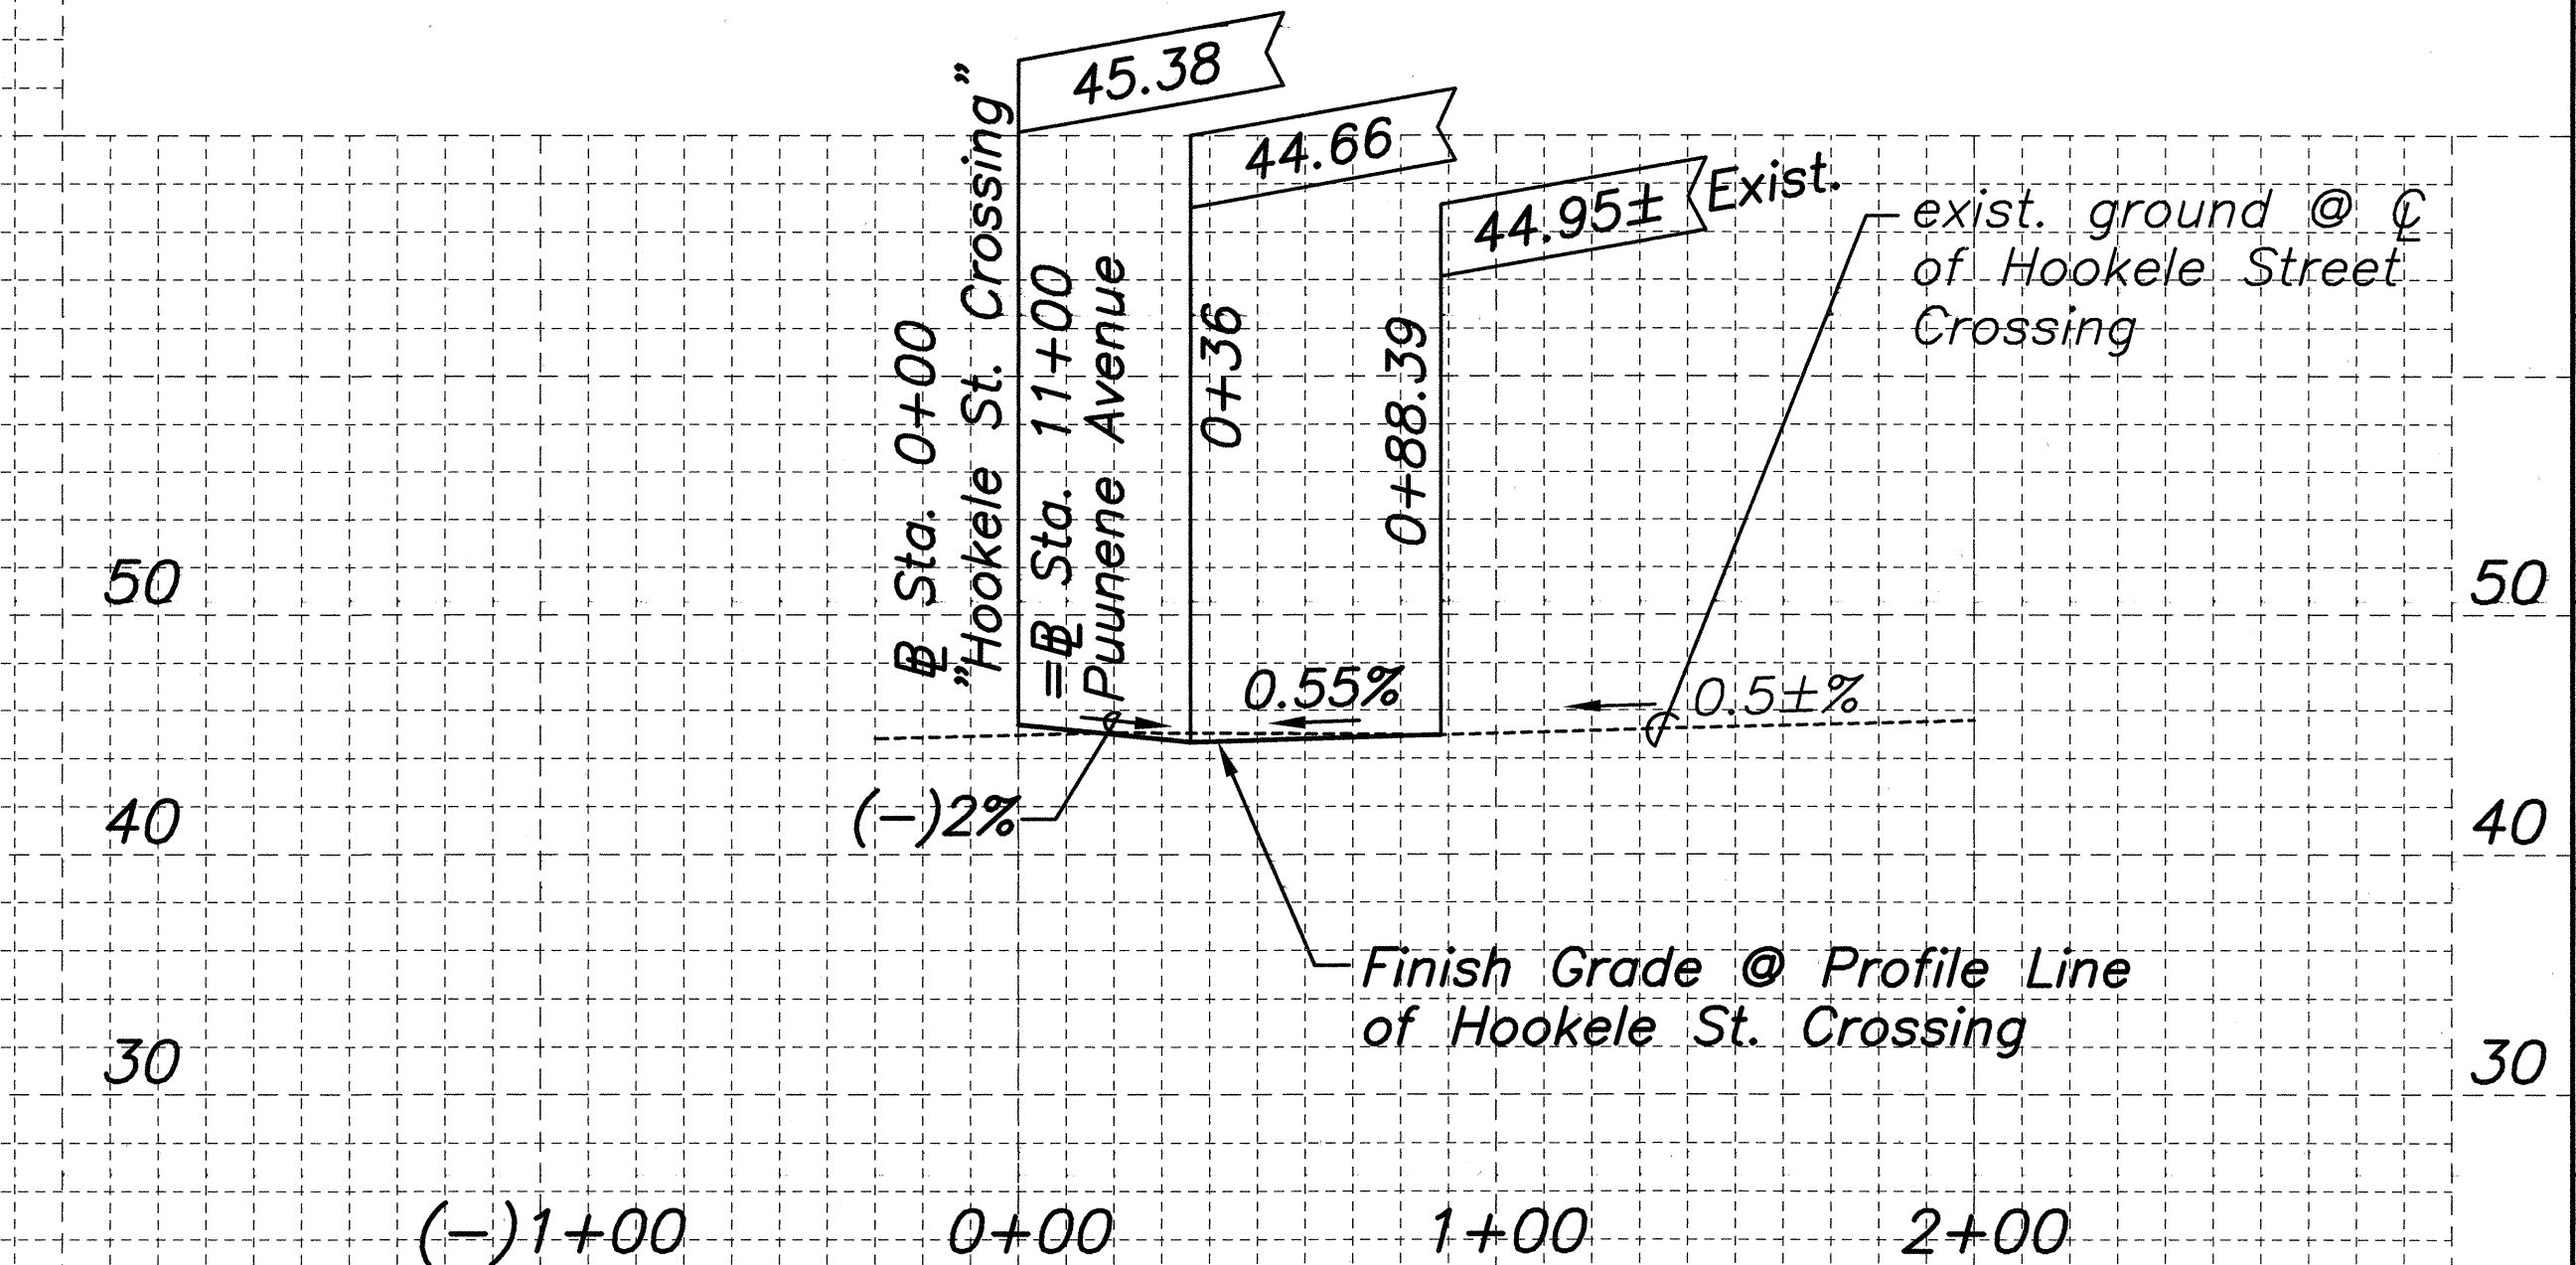

PROFILE-HOOKELE ST. CROSSING

Scale: 1"=40' Horiz.
1"=8' Vert.

DANIEL S. MIYAMOTO
LICENSED PROFESSIONAL ENGINEER
No. 3443-C
HAWAII, U.S.A.

STATE OF HAWAII
DEPARTMENT OF TRANSPORTATION
HIGHWAYS DIVISION

DRIVEWAY PROFILES

PUUNENE AVENUE WIDENING
Kuihelani Highway to Hansen Road
And
MOKULELE HIGHWAY WIDENING
Hansen Road to Vicinity of
Cane Haul Road Crossing
Federal - Aid Project No. NH-A311(3)

Scale: As Noted Date: October 2001

SHEET No. 1 OF 1 SHEETS