
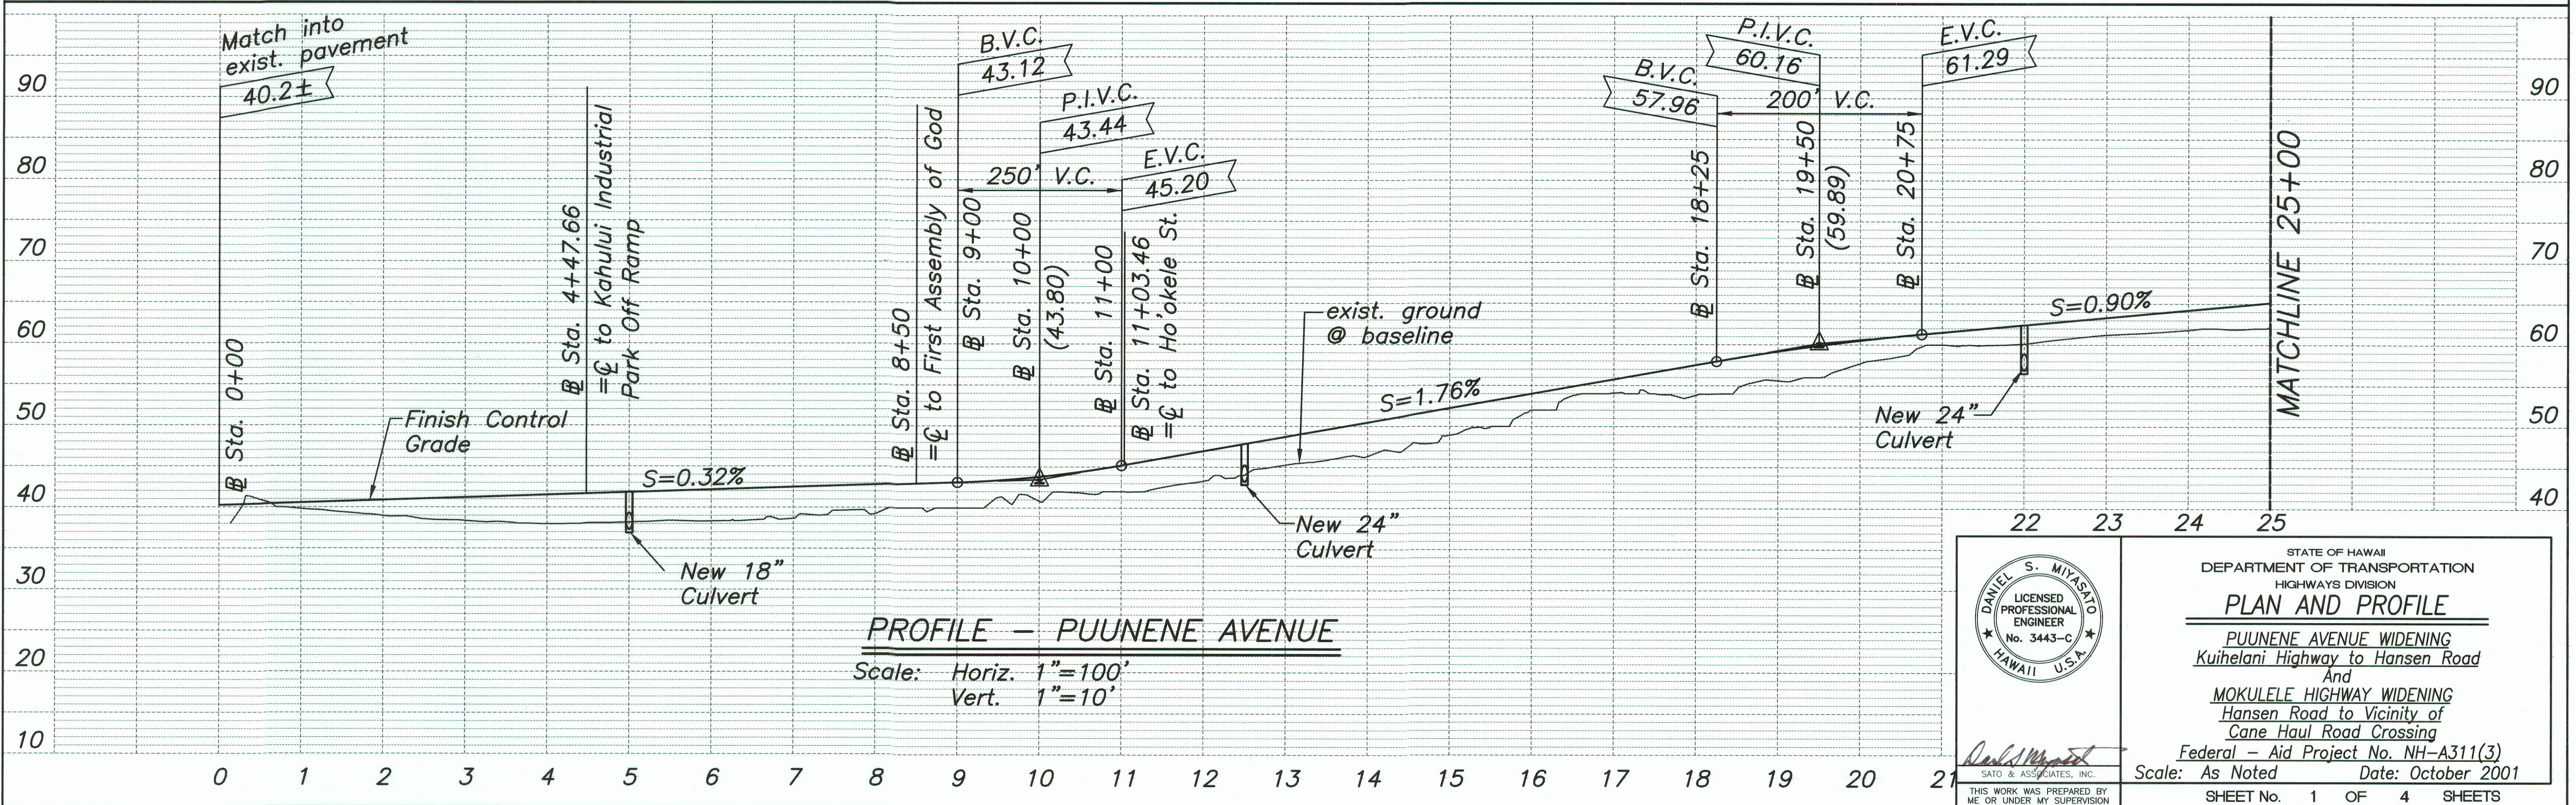


| FED. ROAD DIST. NO. | STATE | FEDERAL - AID PROJ. NO. | FISCAL YEAR | SHEET NO. | TOTAL SHEETS |
|---------------------|-------|-------------------------|-------------|-----------|--------------|
| HAWAII              | HAW.  | NH-A311(3)              | 2002        | 36        | 159          |

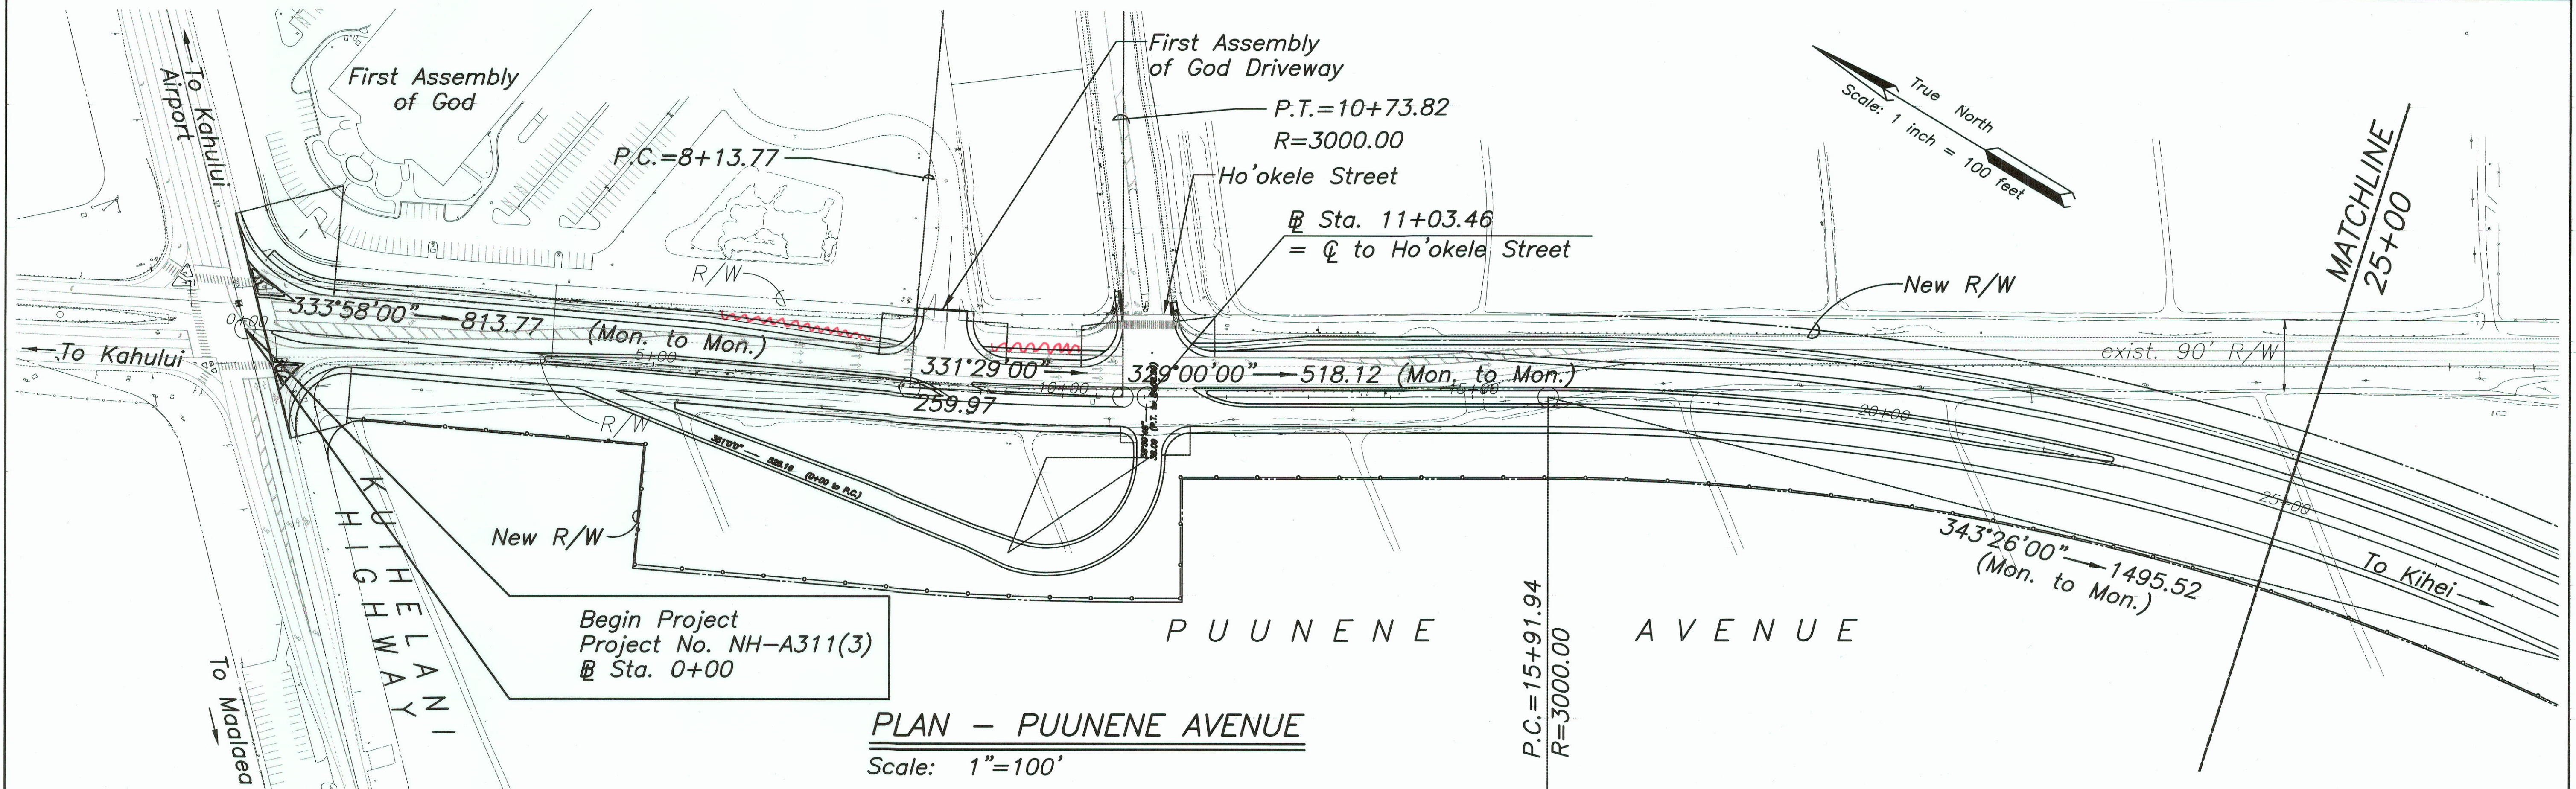

STATE OF HAWAII  
DEPARTMENT OF TRANSPORTATION  
HIGHWAYS DIVISION

**PLAN AND PROFILE**

PUUNENE AVENUE WIDENING  
Kuihelani Highway to Hansen Road  
And  
MOKULELE HIGHWAY WIDENING  
Hansen Road to Vicinity of  
Cane Haul Road Crossing  
Federal - Aid Project No. NH-A311(3)

Scale: As Noted Date: October 2001




SHEET No. 1 OF 4 SHEETS

THIS WORK WAS PREPARED BY  
ME OR UNDER MY SUPERVISION

**"AS-BUILT"**





| FED. ROAD DIST. NO. | STATE | FEDERAL - AID PROJ. NO. | FISCAL YEAR | SHEET NO. | TOTAL SHEETS |
|---------------------|-------|-------------------------|-------------|-----------|--------------|
| HAWAII              | HAW.  | NH-A311(3)              | 2002        | 37        | 159          |

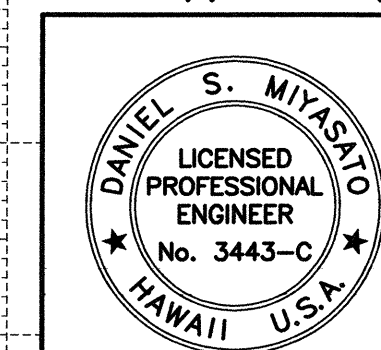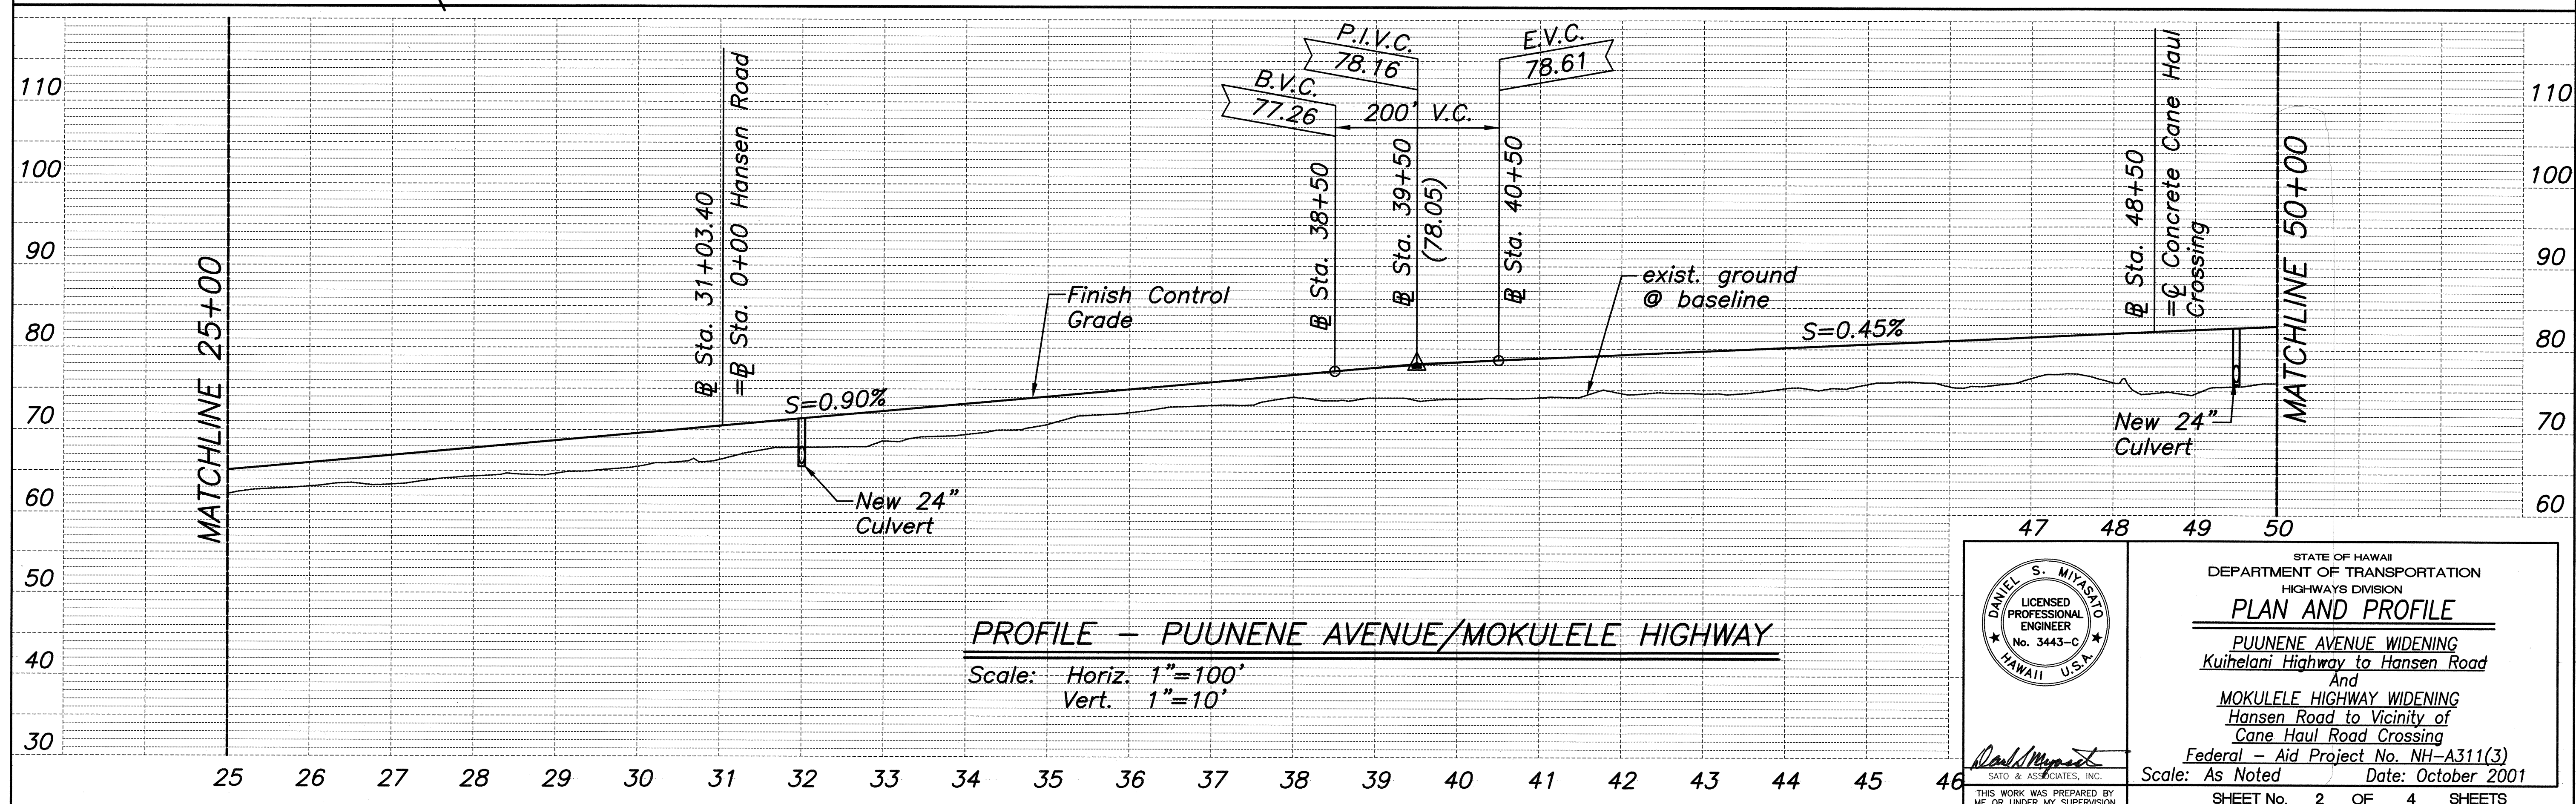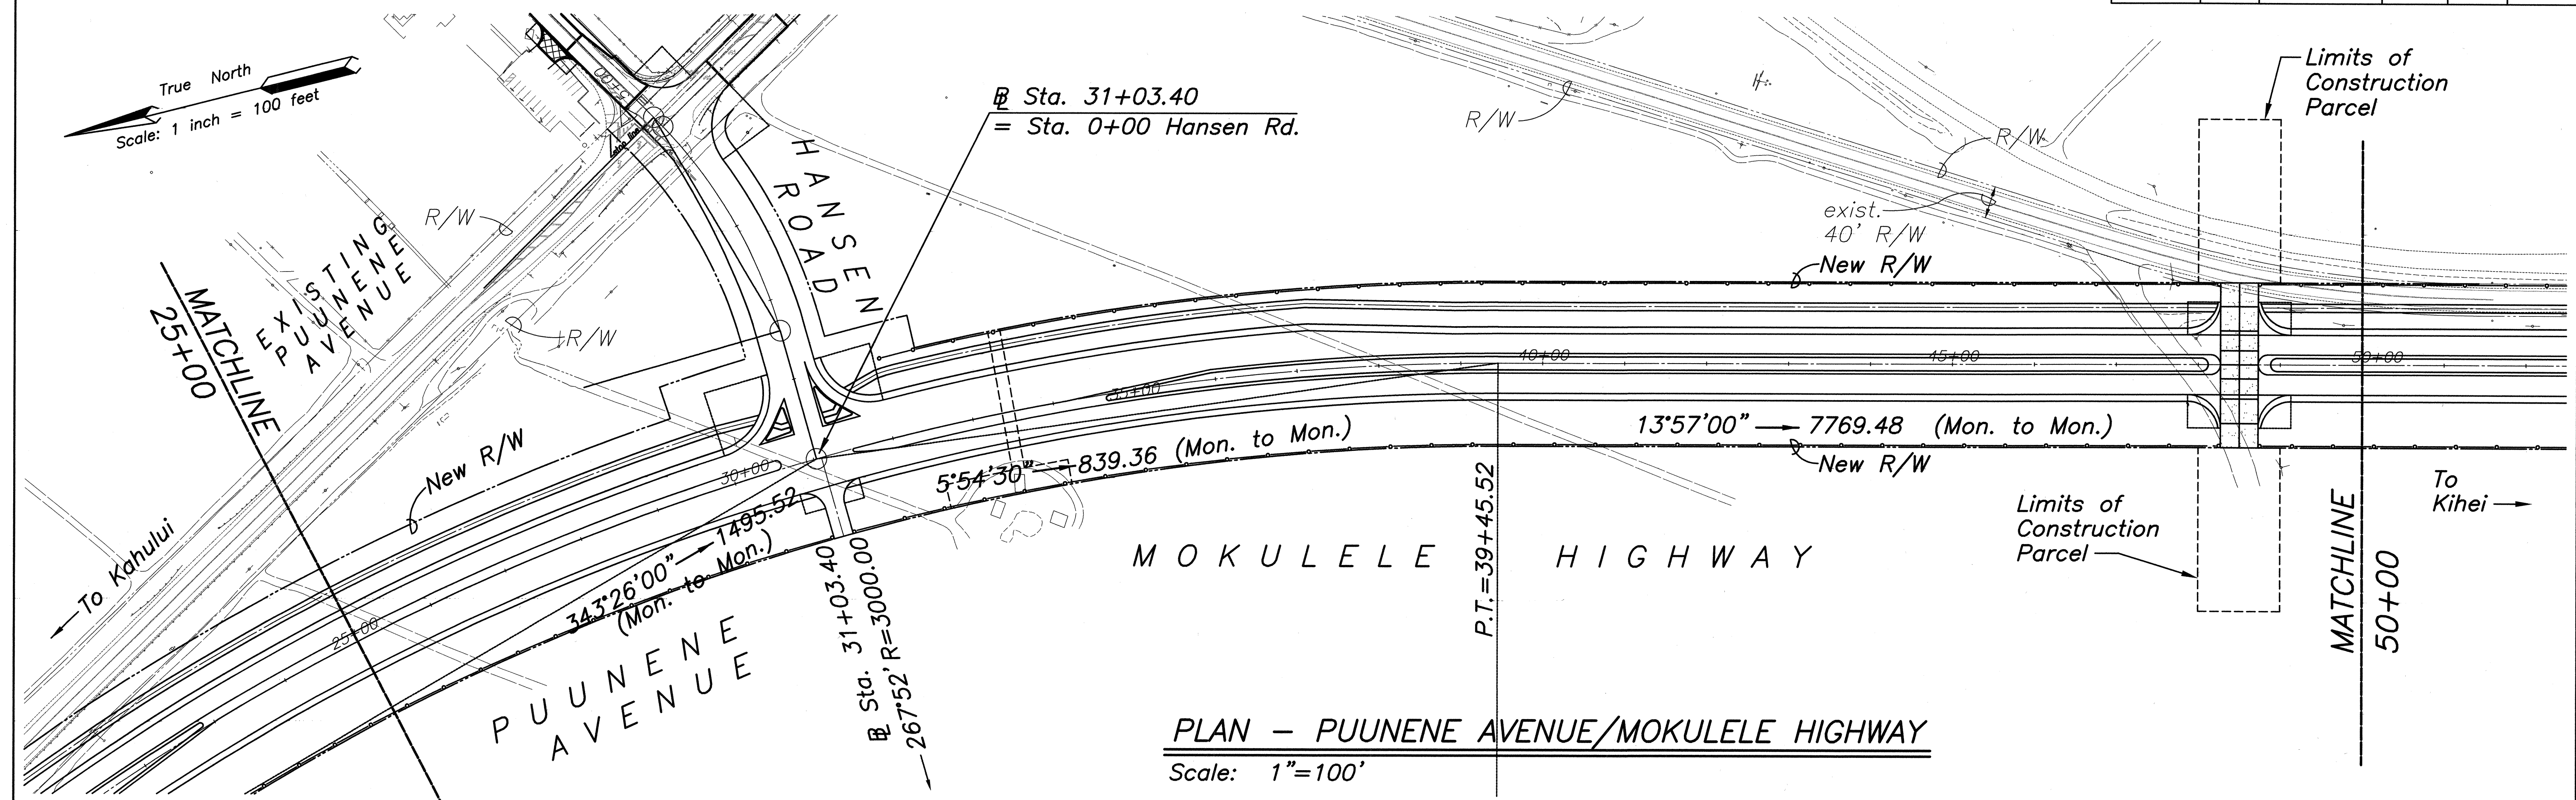

STATE OF HAWAII  
DEPARTMENT OF TRANSPORTATION  
HIGHWAYS DIVISION  
**PLAN AND PROFILE**  
PUUNENE AVENUE WIDENING  
Kuihelani Highway to Hansen Road  
And  
MOKULELE HIGHWAY WIDENING  
Hansen Road to Vicinity of  
Cane Haul Road Crossing  
Federal - Aid Project No. NH-A311(3)  
Scale: As Noted Date: October 2001  
SHEET No. 2 OF 4 SHEETS



| FED. ROAD DIST. NO. | STATE | FEDERAL - AID PROJ. NO. | FISCAL YEAR | SHEET NO. | TOTAL SHEETS |
|---------------------|-------|-------------------------|-------------|-----------|--------------|
| HAWAII              | HAW.  | NH-A311(3)              | 2002        | 38        | 159          |

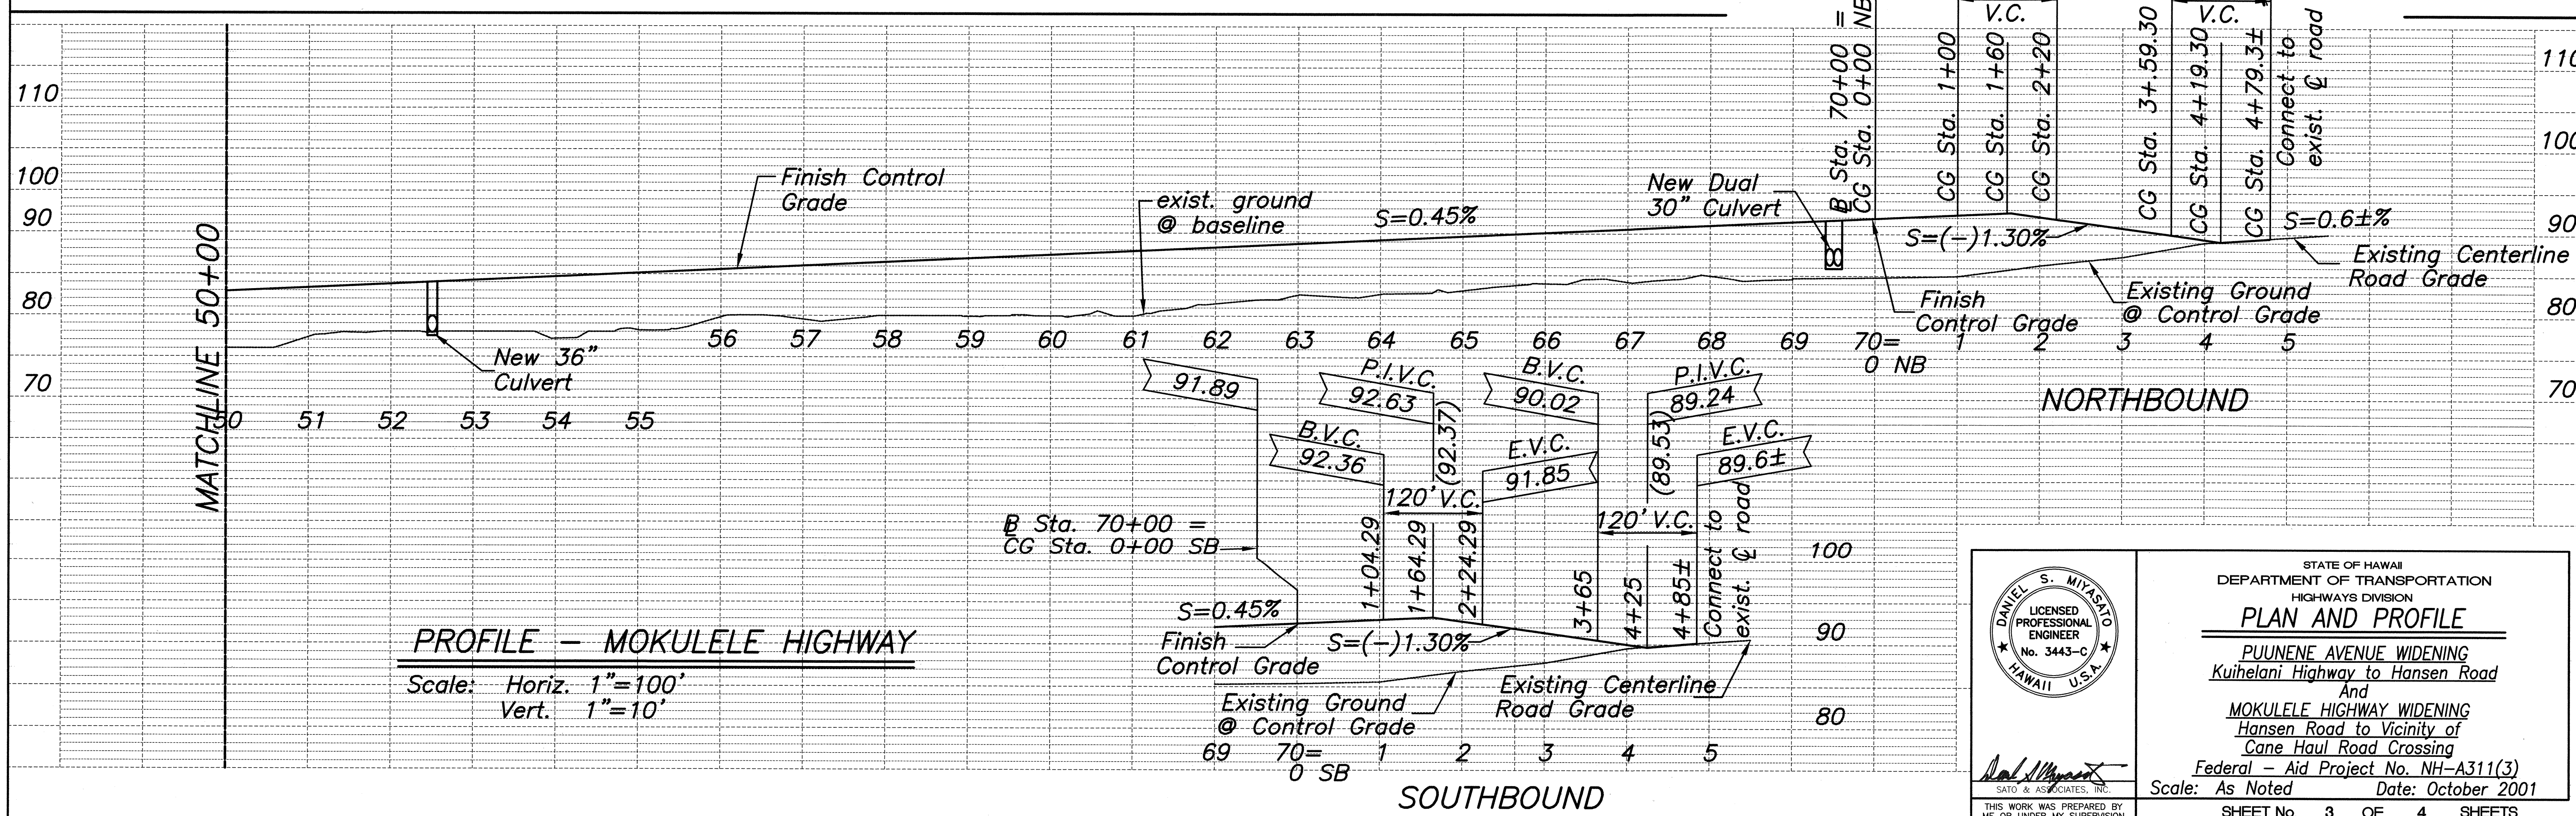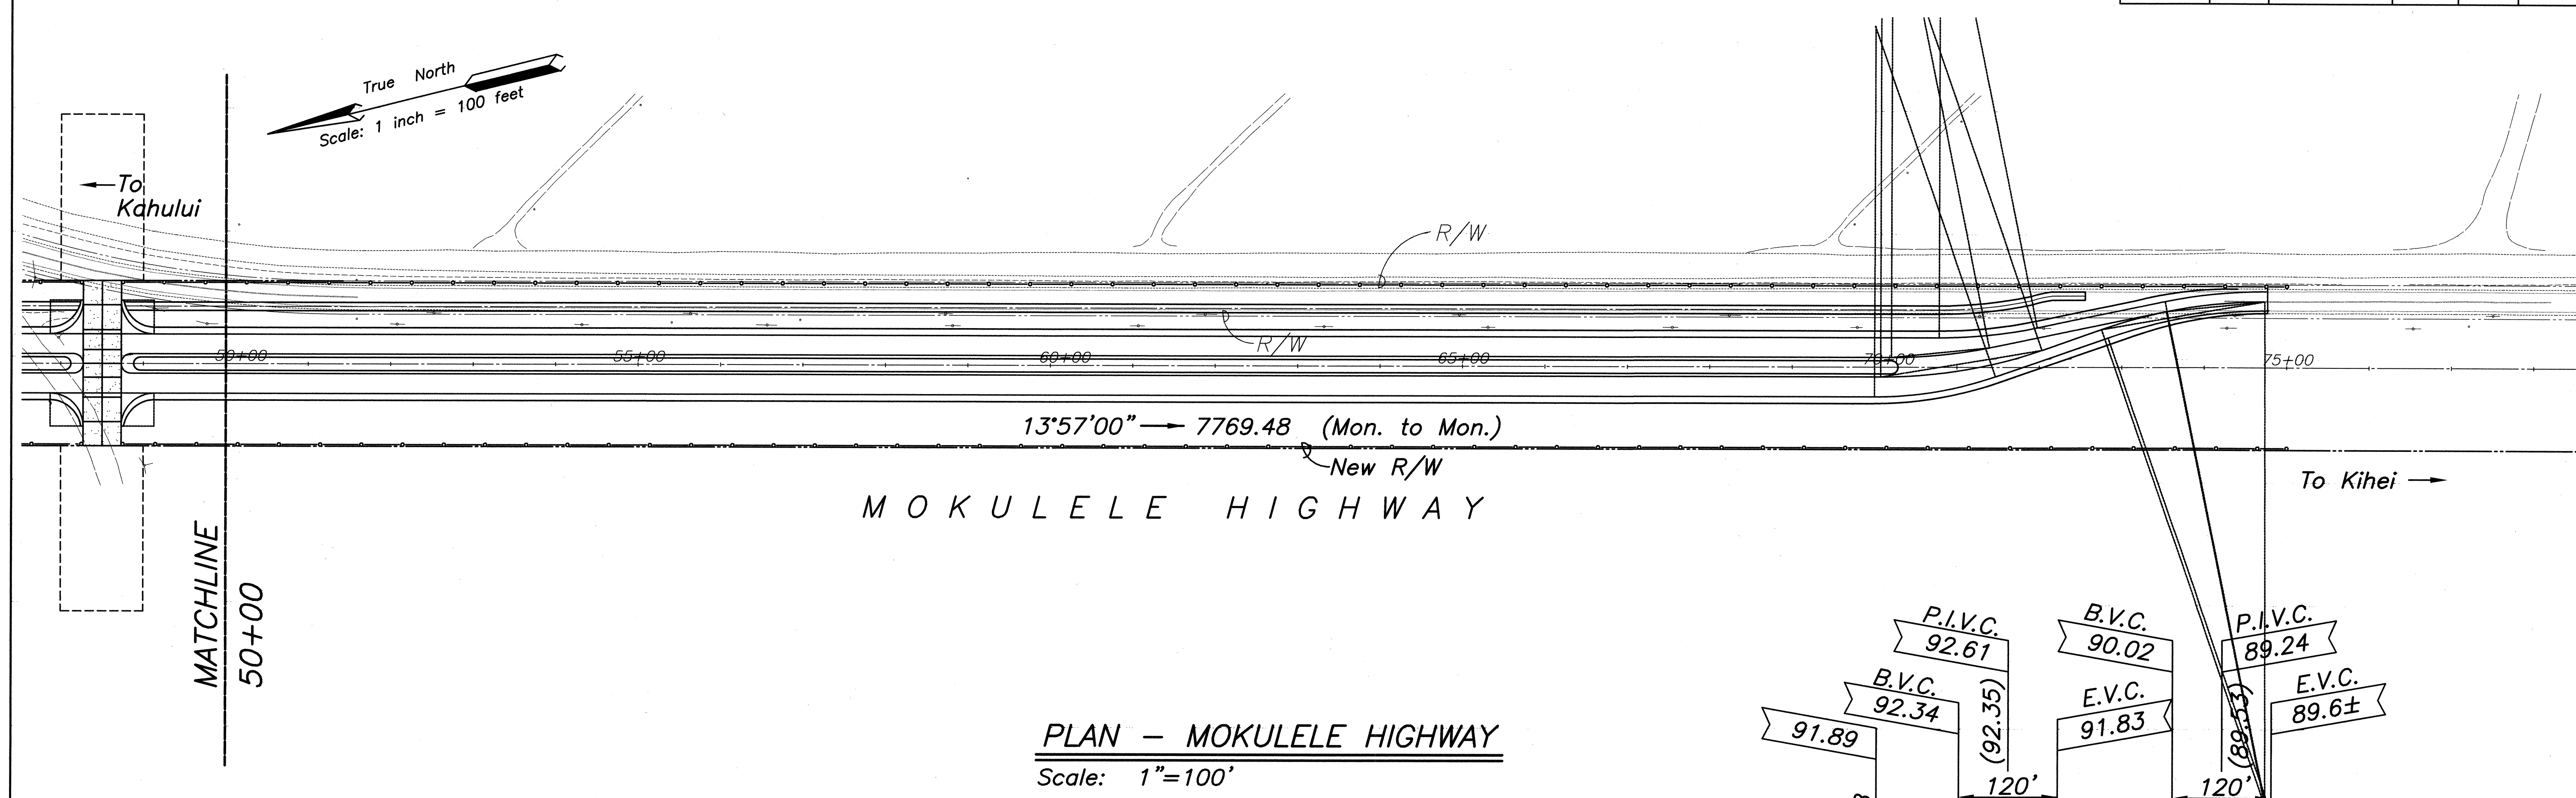

STATE OF HAWAII  
DEPARTMENT OF TRANSPORTATION  
HIGHWAYS DIVISION

**PLAN AND PROFILE**

PUUNENE AVENUE WIDENING  
Kuihelani Highway to Hansen Road  
And  
MOKULELE HIGHWAY WIDENING  
Hansen Road to Vicinity of  
Cane Haul Road Crossing  
Federal - Aid Project No. NH-A311(3)

Scale: As Noted Date: October 2001

SHEET No. 3 OF 4 SHEETS

DANIEL S. MIYASATO  
LICENSED PROFESSIONAL ENGINEER  
No. 3443-C  
HAWAII U.S.A.

*Daniel Miyasato*

SATO & ASSOCIATES, INC.

THIS WORK WAS PREPARED BY  
ME OR UNDER MY SUPERVISION



9/8/01

UN: M9901.00

PLOT: 1=40



| FED. ROAD DIST. NO. | STATE | FEDERAL - AID PROJ. NO. | FISCAL YEAR | SHEET NO. | TOTAL SHEETS |
|---------------------|-------|-------------------------|-------------|-----------|--------------|
| HAWAII              | HAW.  | NH-A311(3)              | 2002        | 39        | 159          |

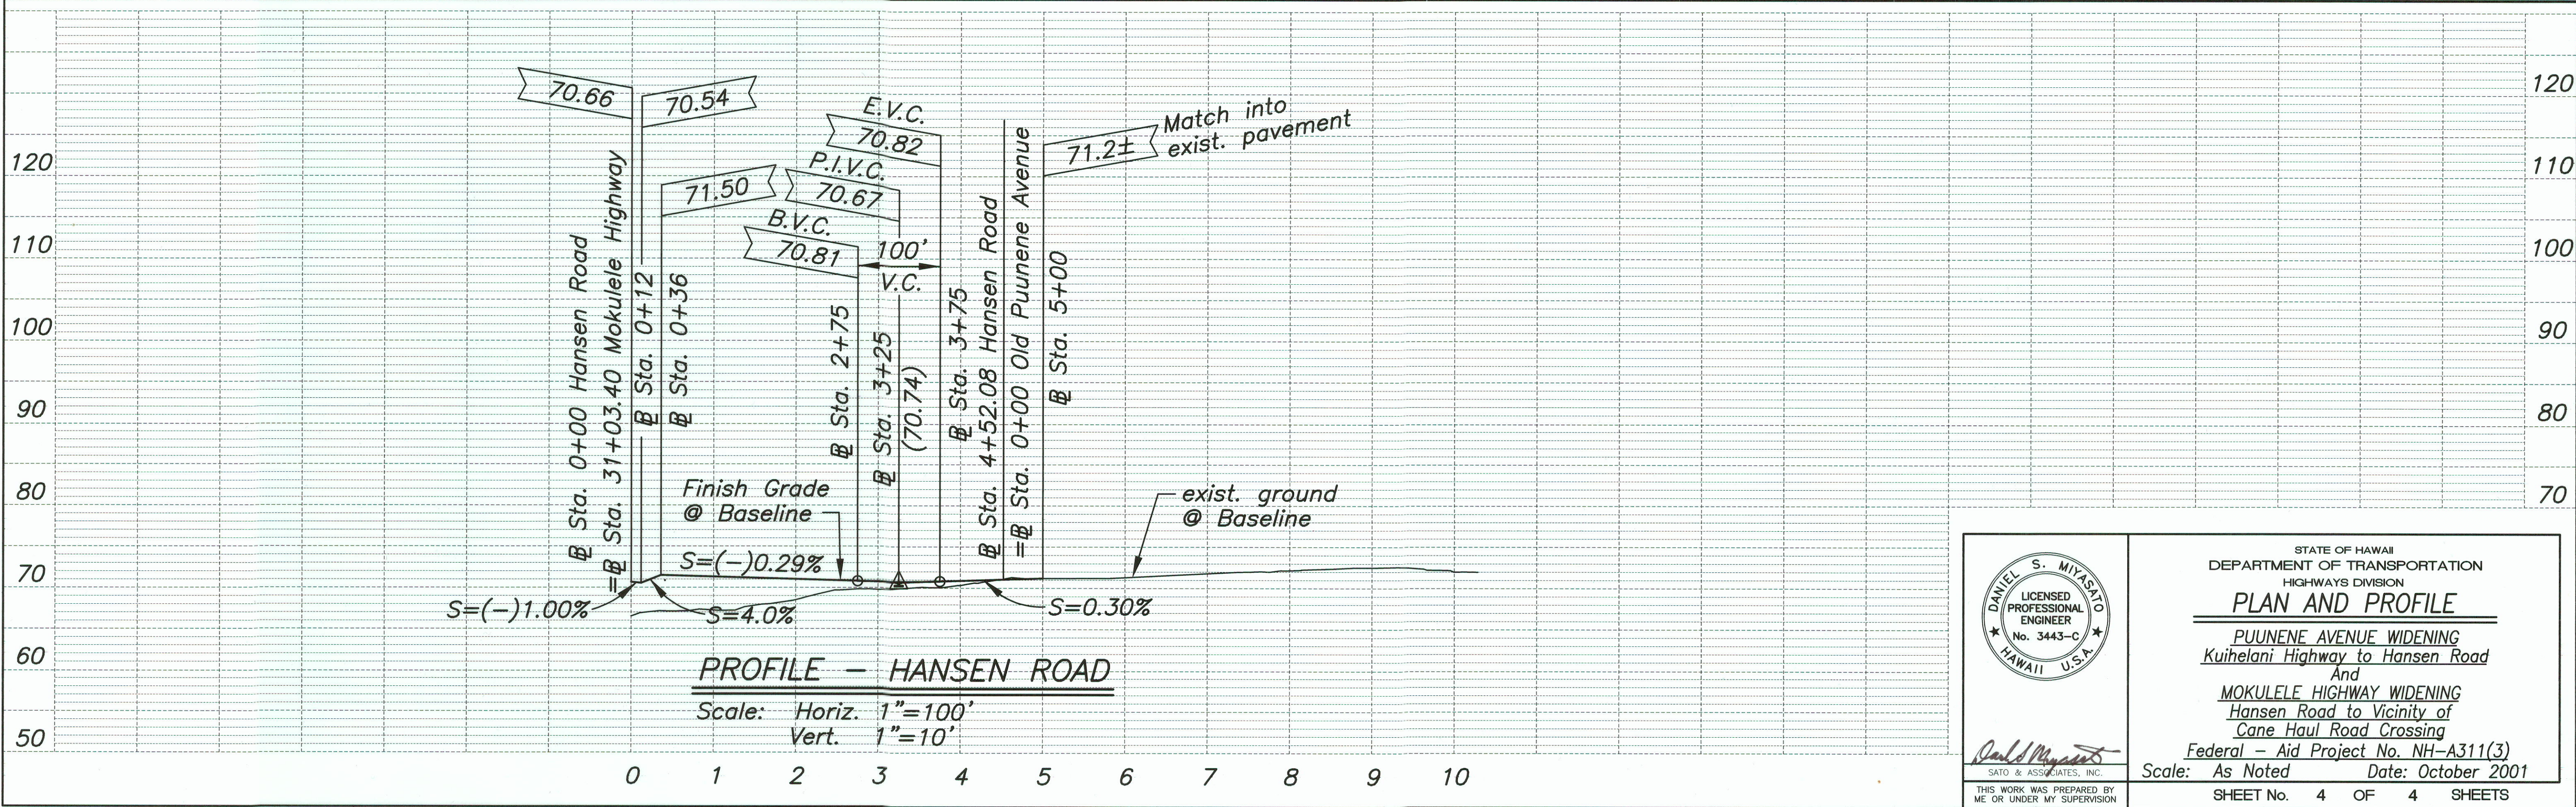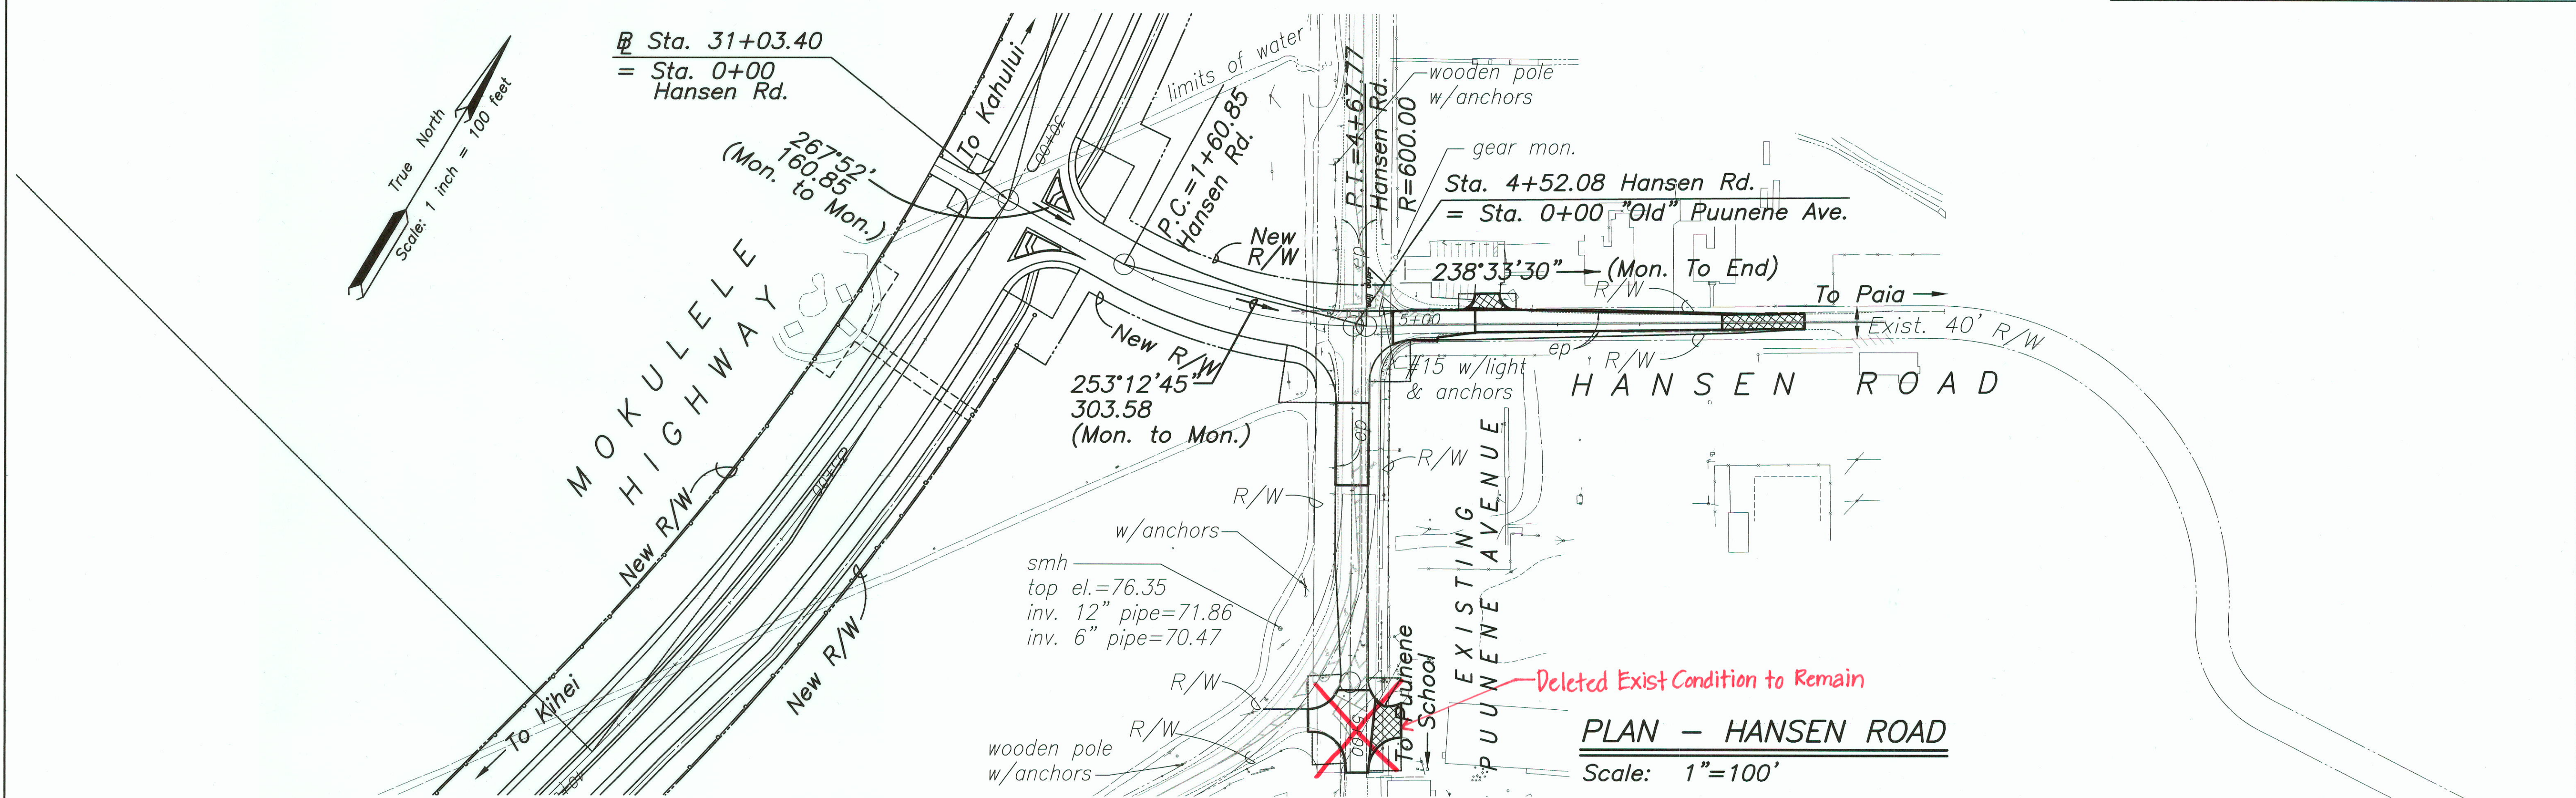

STATE OF HAWAII  
DEPARTMENT OF TRANSPORTATION  
HIGHWAYS DIVISION

**PLAN AND PROFILE**

**PUUNENE AVENUE WIDENING**  
Kuihelani Highway to Hansen Road  
And  
**MOKULELE HIGHWAY WIDENING**  
Hansen Road to Vicinity of  
Cane Haul Road Crossing  
Federal - Aid Project No. NH-A311(3)

Scale: As Noted Date: October 2001

SHEET No. 4 OF 4 SHEETS

ORIGINAL PLAN DATE  
DRAWN BY  
NOTE BOOK  
DESIGNED BY  
QUANTITIES BY  
CHECKED BY

8/8/01

JN: M9901.00

PLOT: 1=40

"AS-BUILT"