


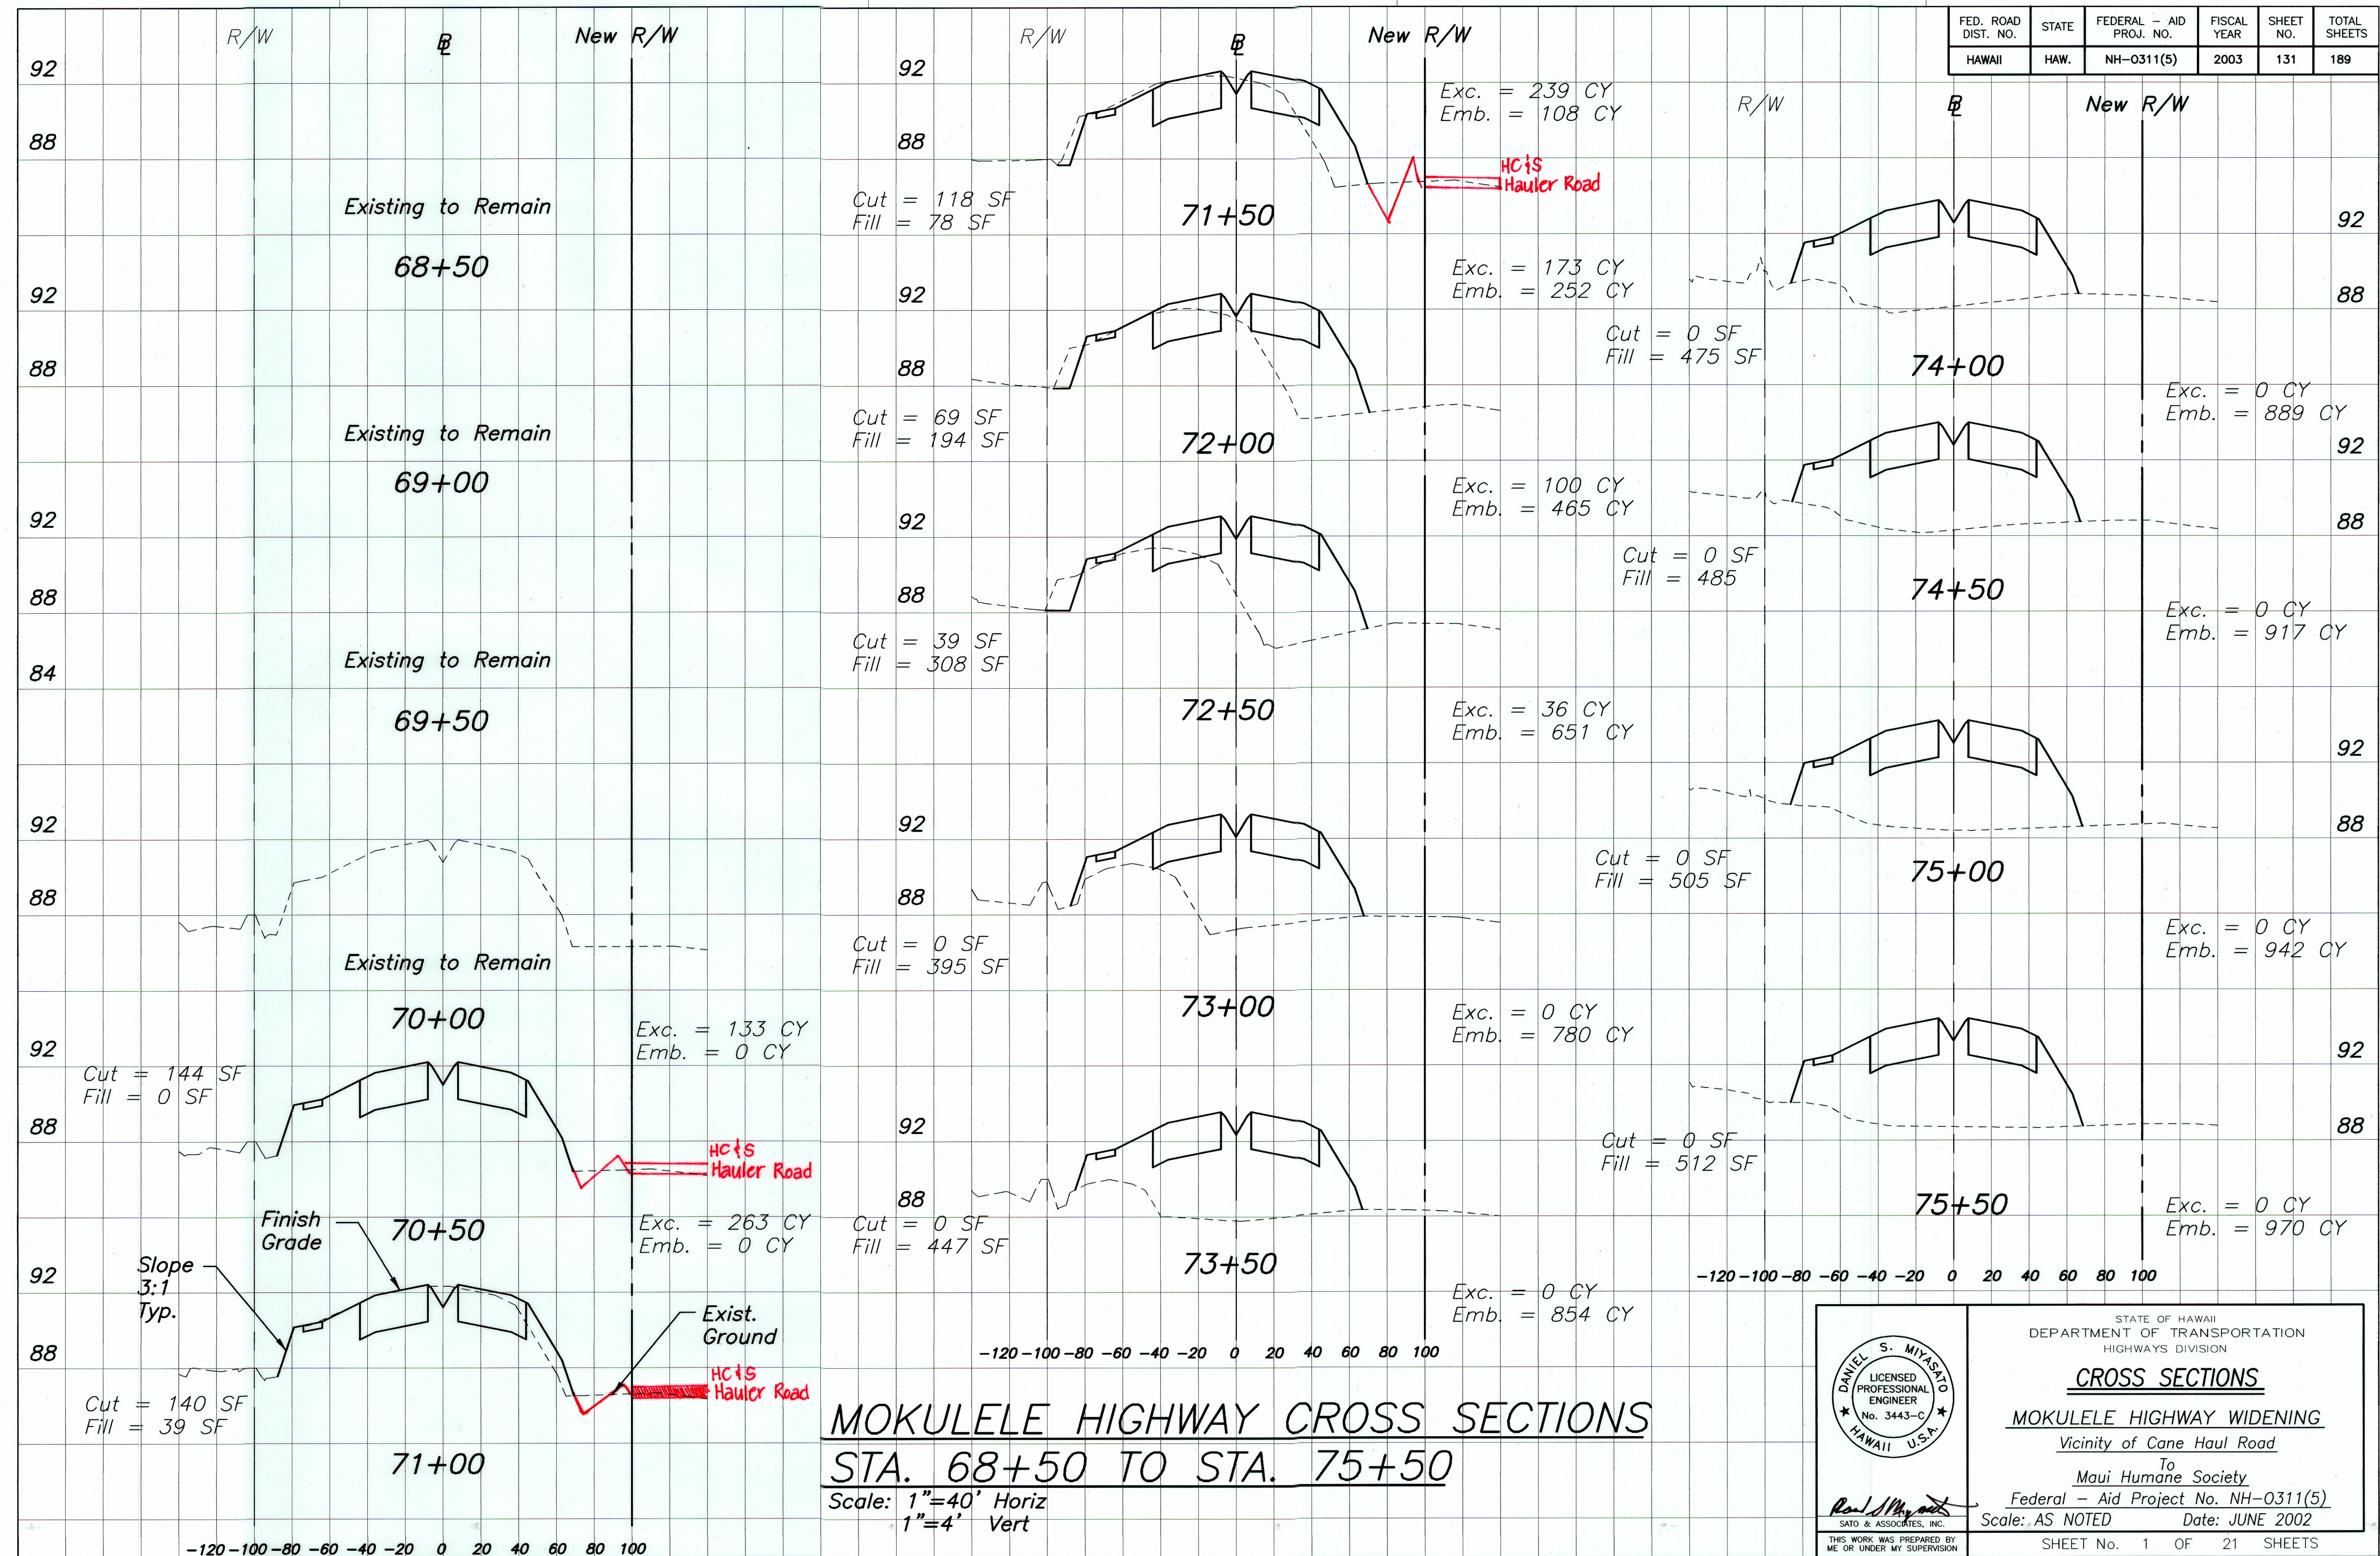

STATE OF HAWAII
 DEPARTMENT OF TRANSPORTATION
 HIGHWAYS DIVISION

CROSS SECTIONS

MOKULELE HIGHWAY WIDENING
 Vicinity of Cane Haul Road
 To
 Maui Humane Society
 Federal - Aid Project No. NH-0311(5)
 Scale: AS NOTED Date: JUNE 2002


SHEET No. 1 OF 21 SHEETS

DANIEL S. MIYASATO
 LICENSED PROFESSIONAL ENGINEER
 No. 3443-C
 HAWAII U.S.A.

Rail J. Miyasato
 SATO & ASSOCIATES, INC.
THIS WORK WAS PREPARED BY ME OR UNDER MY SUPERVISION

"AS-BUILT"

FED. ROAD DIST. NO.	STATE	FEDERAL - AID PROJ. NO.	FISCAL YEAR	SHEET NO.	TOTAL SHEETS
HAWAII	HAW.	NH-0311(5)	2003	132	189

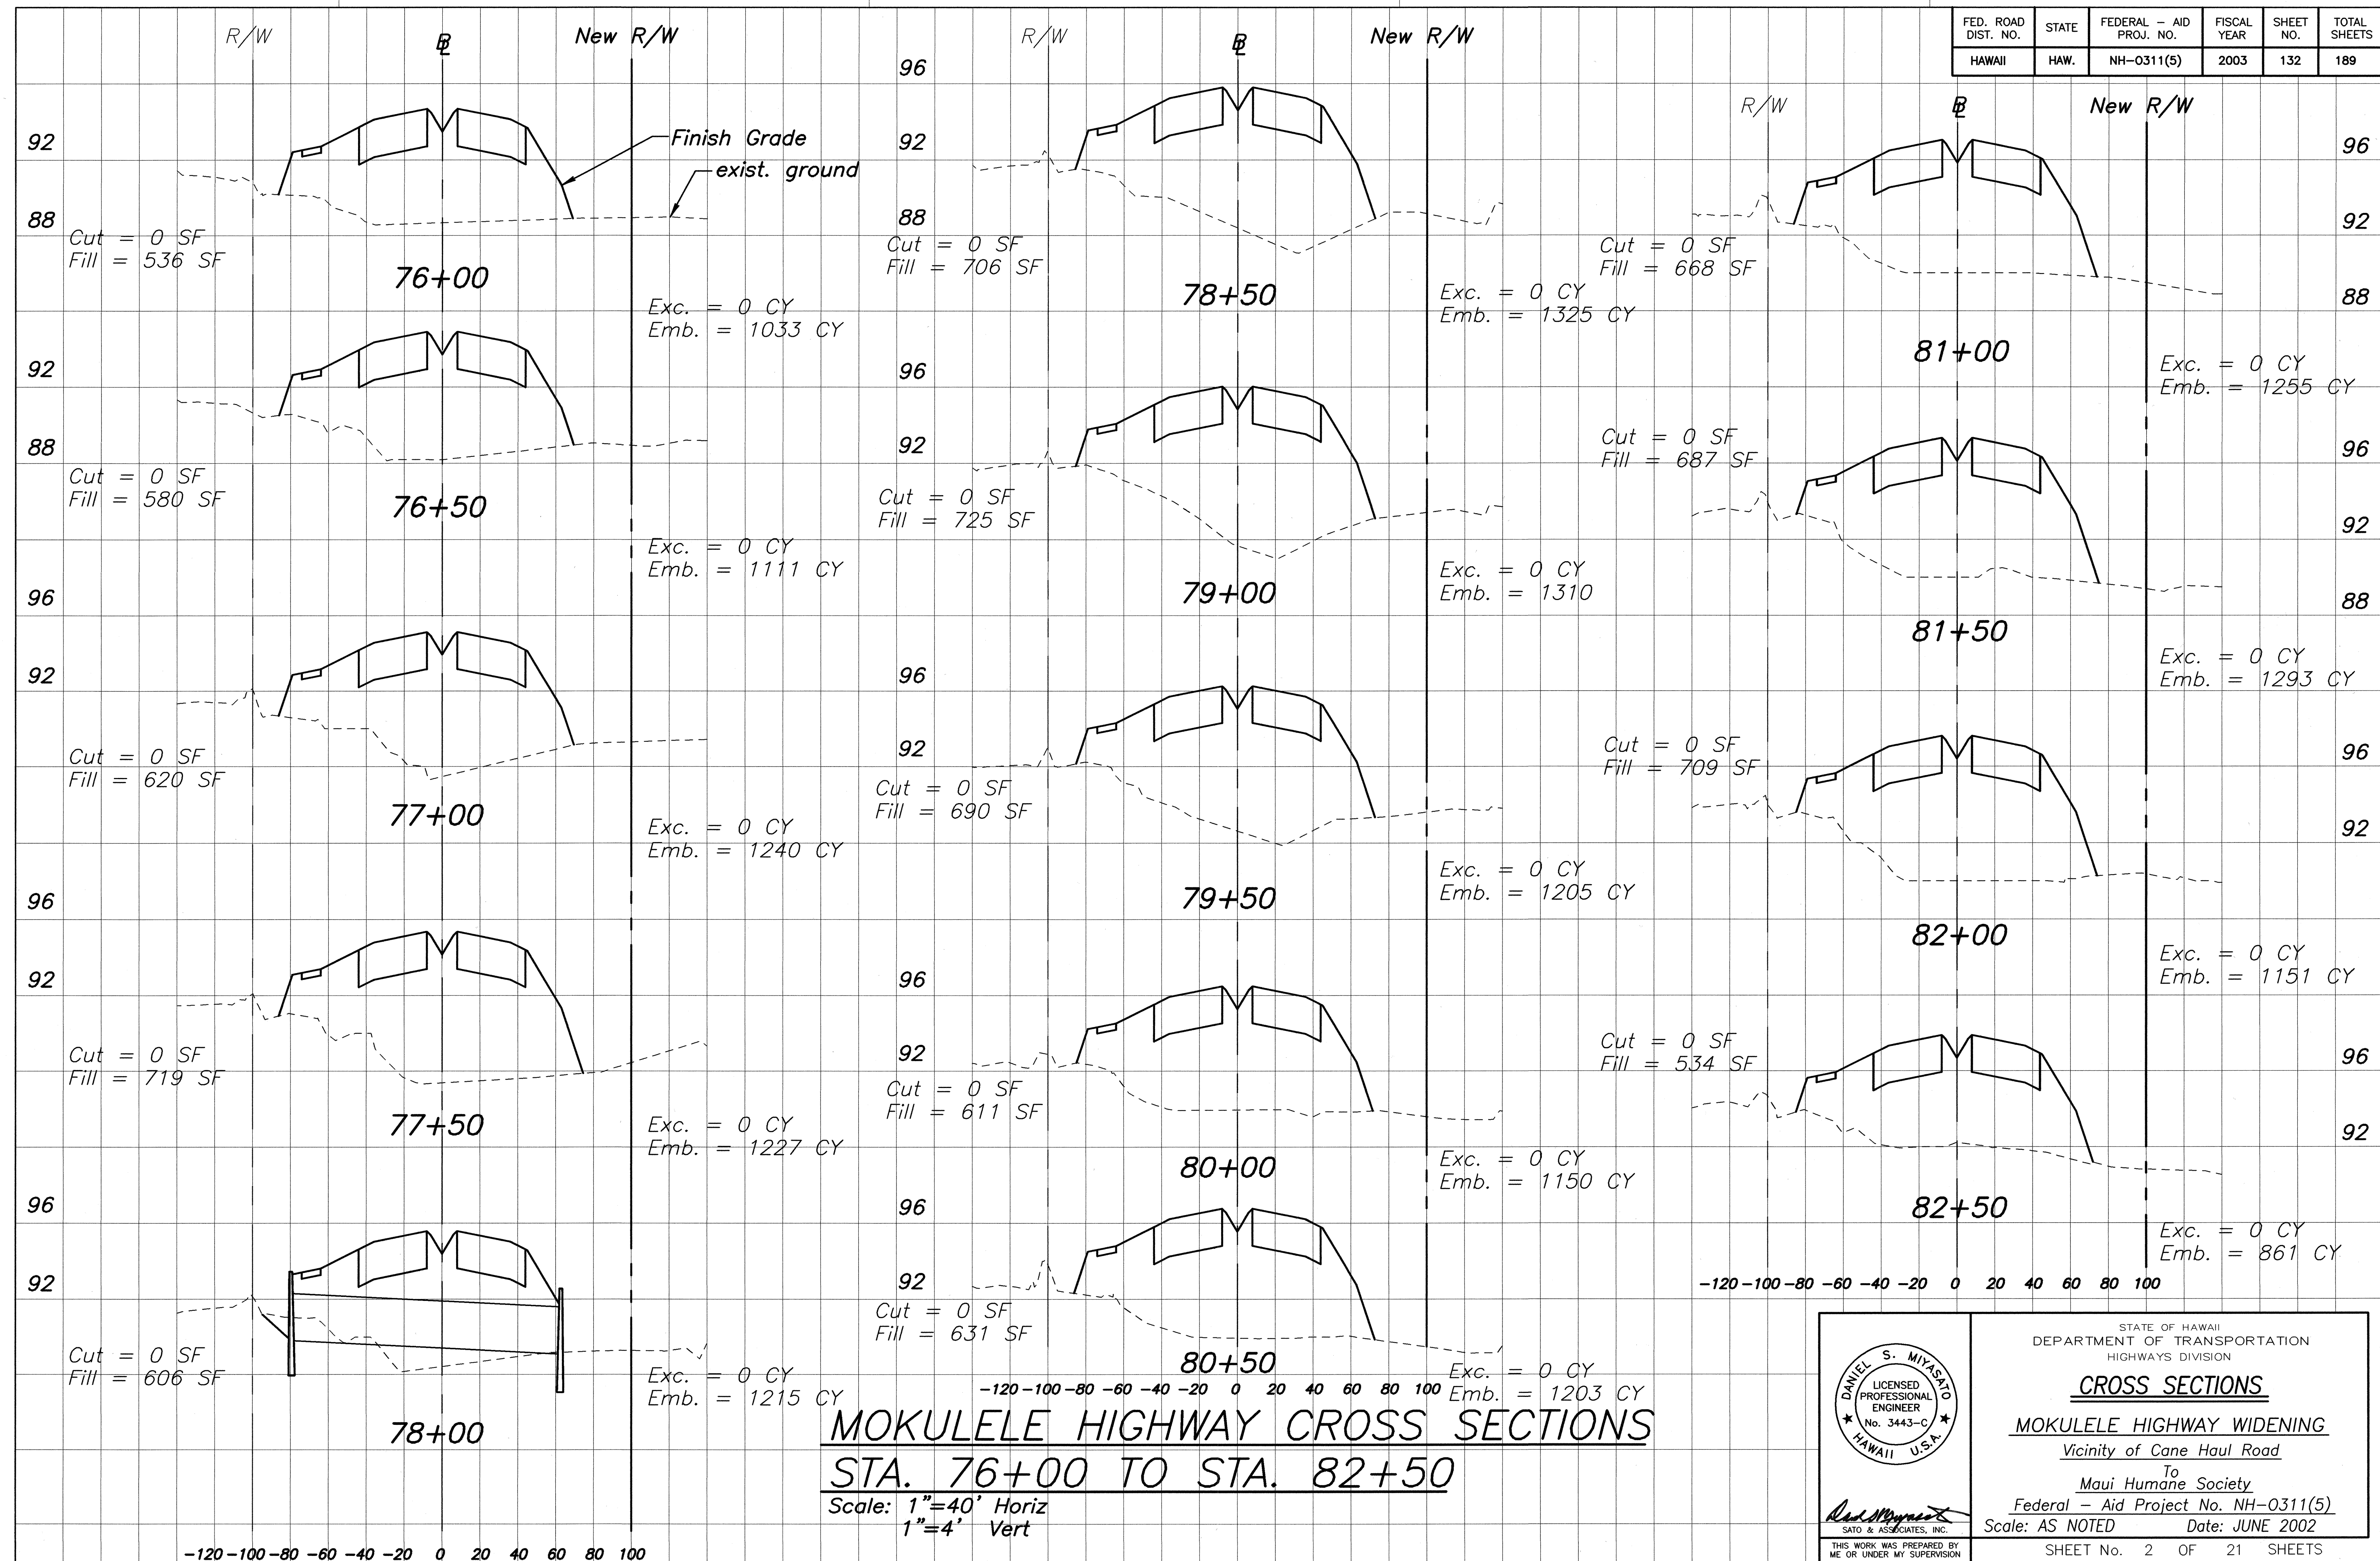

STATE OF HAWAII
 DEPARTMENT OF TRANSPORTATION
 HIGHWAYS DIVISION

CROSS SECTIONS
MOKULELE HIGHWAY WIDENING
 Vicinity of Cane Haul Road
 To
 Maui Humane Society
 Federal - Aid Project No. NH-0311(5)
 Scale: AS NOTED Date: JUNE 2002

THIS WORK WAS PREPARED BY
 ME OR UNDER MY SUPERVISION


DANIEL S. MIYASATO
 LICENSED PROFESSIONAL ENGINEER
 No. 3443-C
 HAWAII U.S.A.

PROJ. NO.: M9901.00


RV:moku-pl2b\X-SECT1.dwg

3/8/02

SURVEY PLOTTED BY	DATE
DRAWN BY	
RECHECKED BY	
QUANTITIES BY	
CHECKED BY	
NO.	

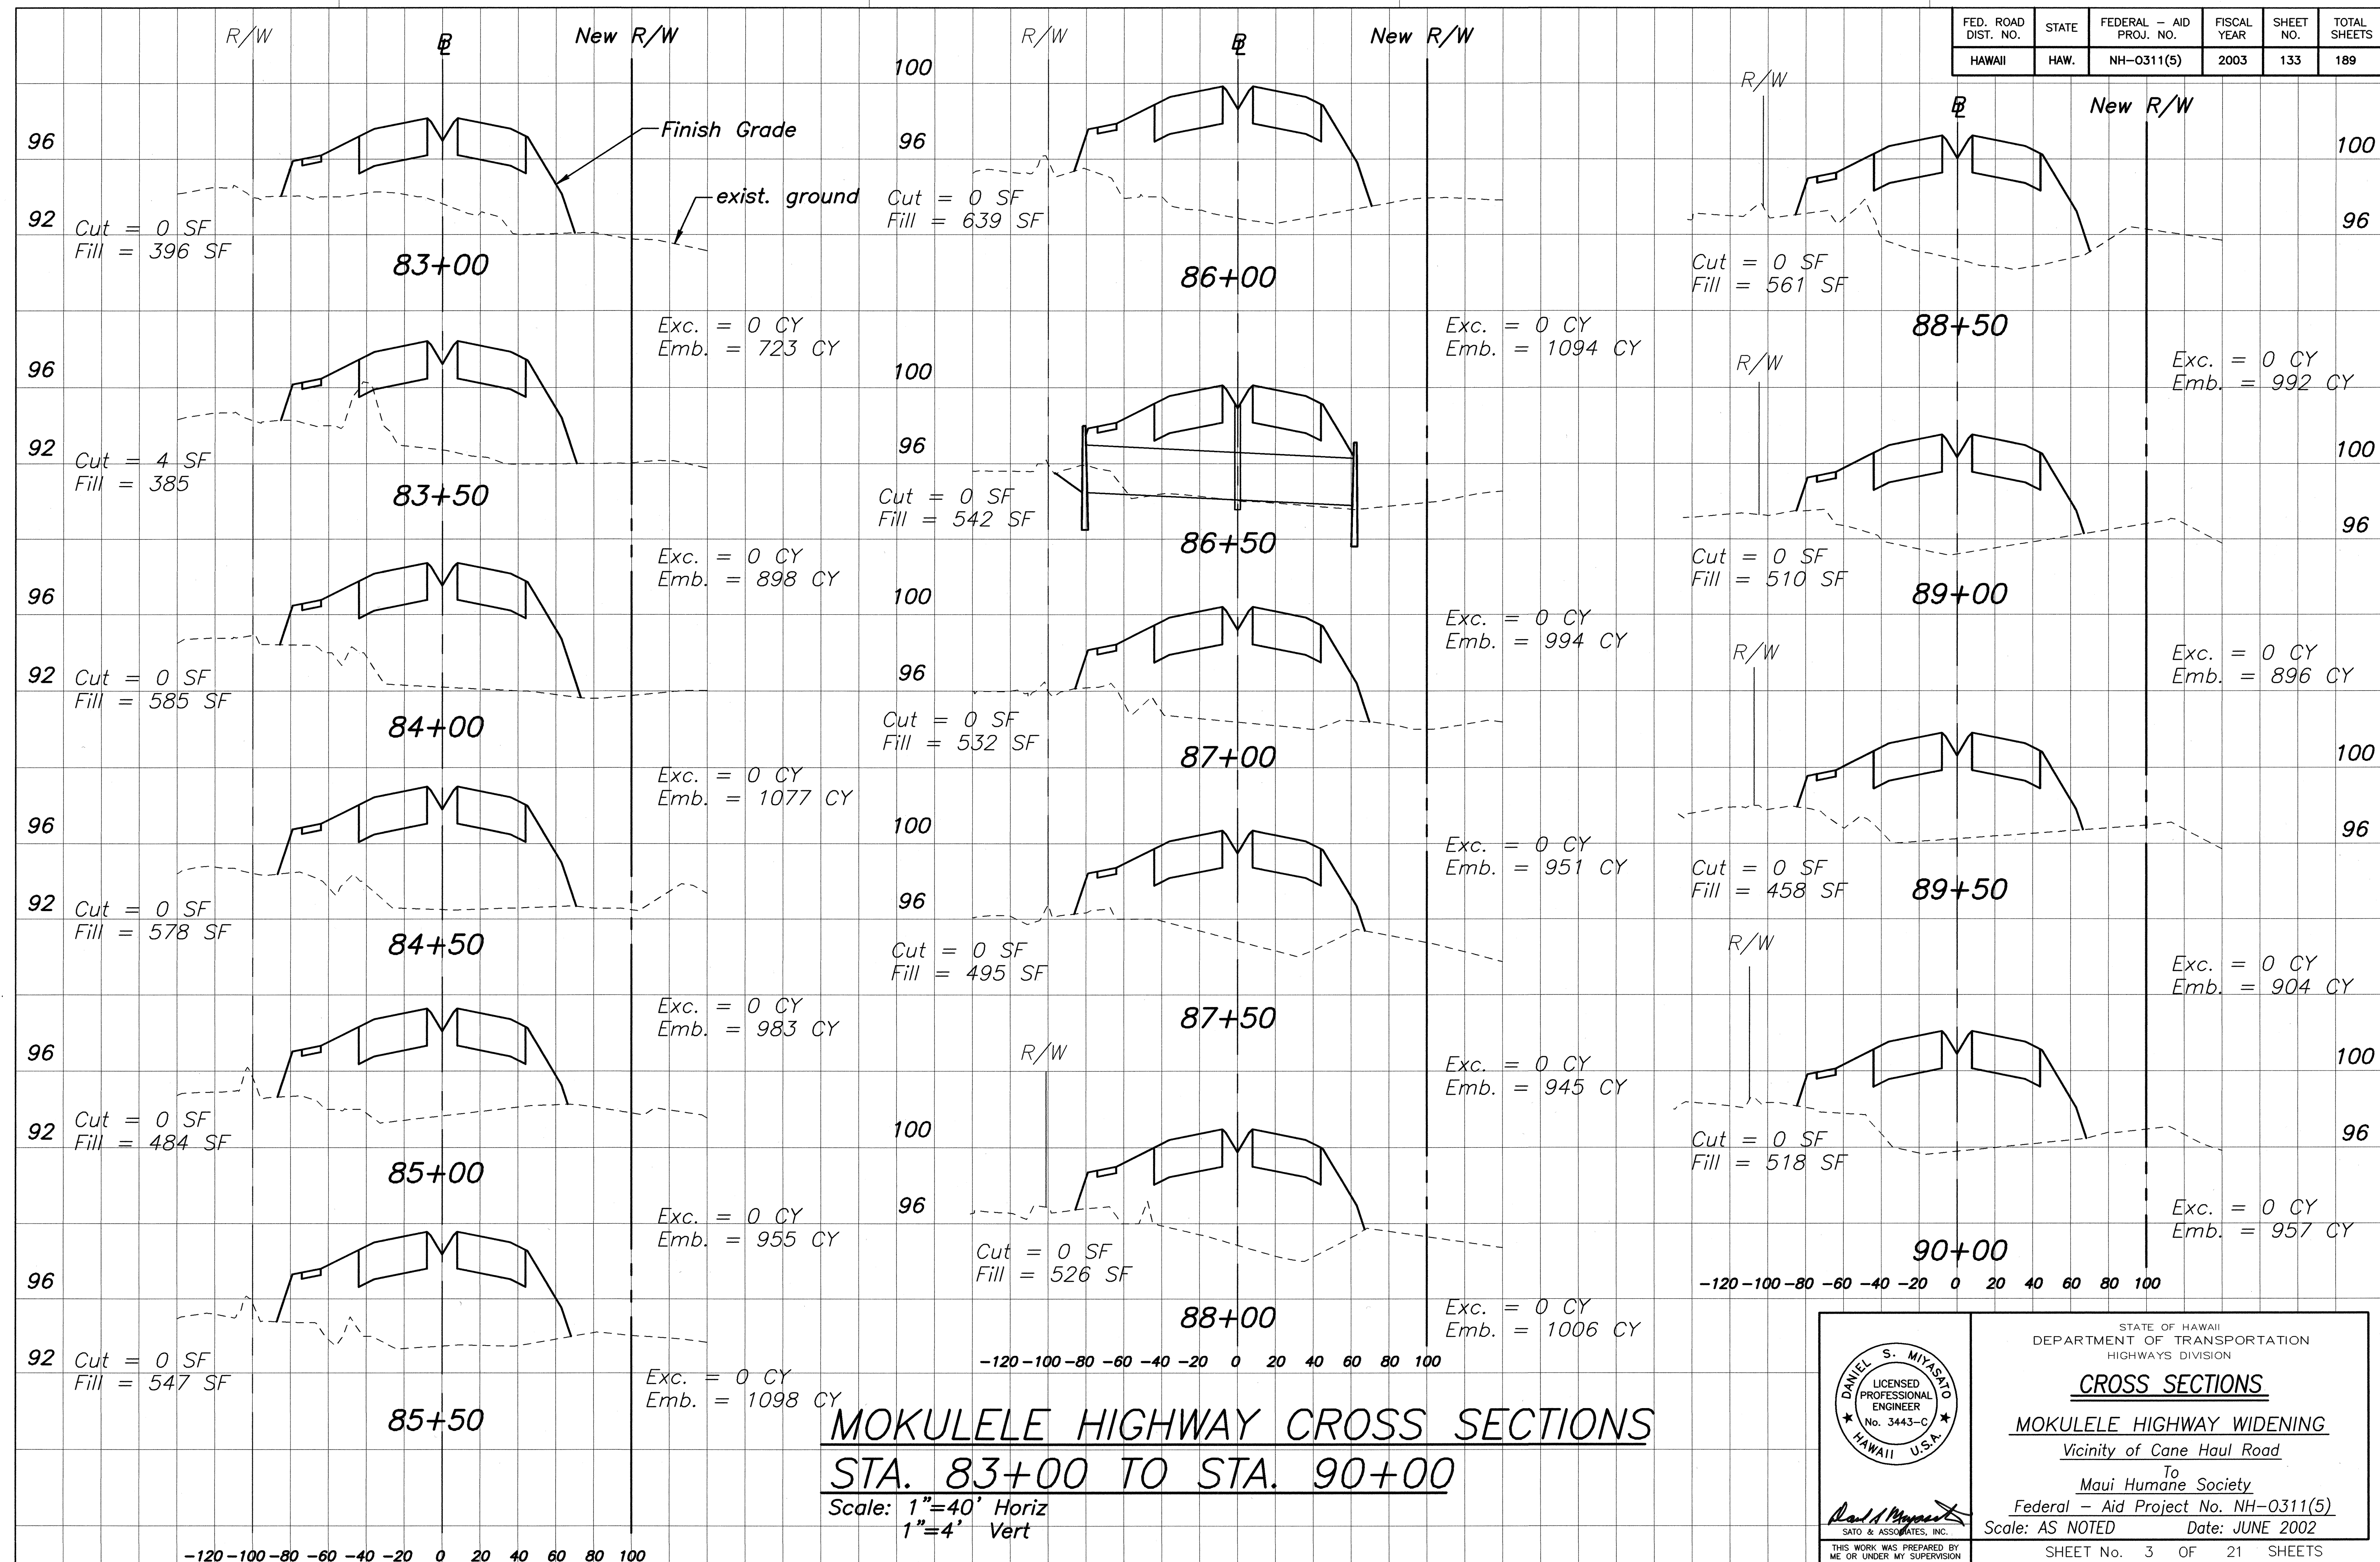

FED. ROAD DIST. NO.	STATE	FEDERAL - AID PROJ. NO.	FISCAL YEAR	SHEET NO.	TOTAL SHEETS
HAWAII	HAW.	NH-0311(5)	2003	134	189

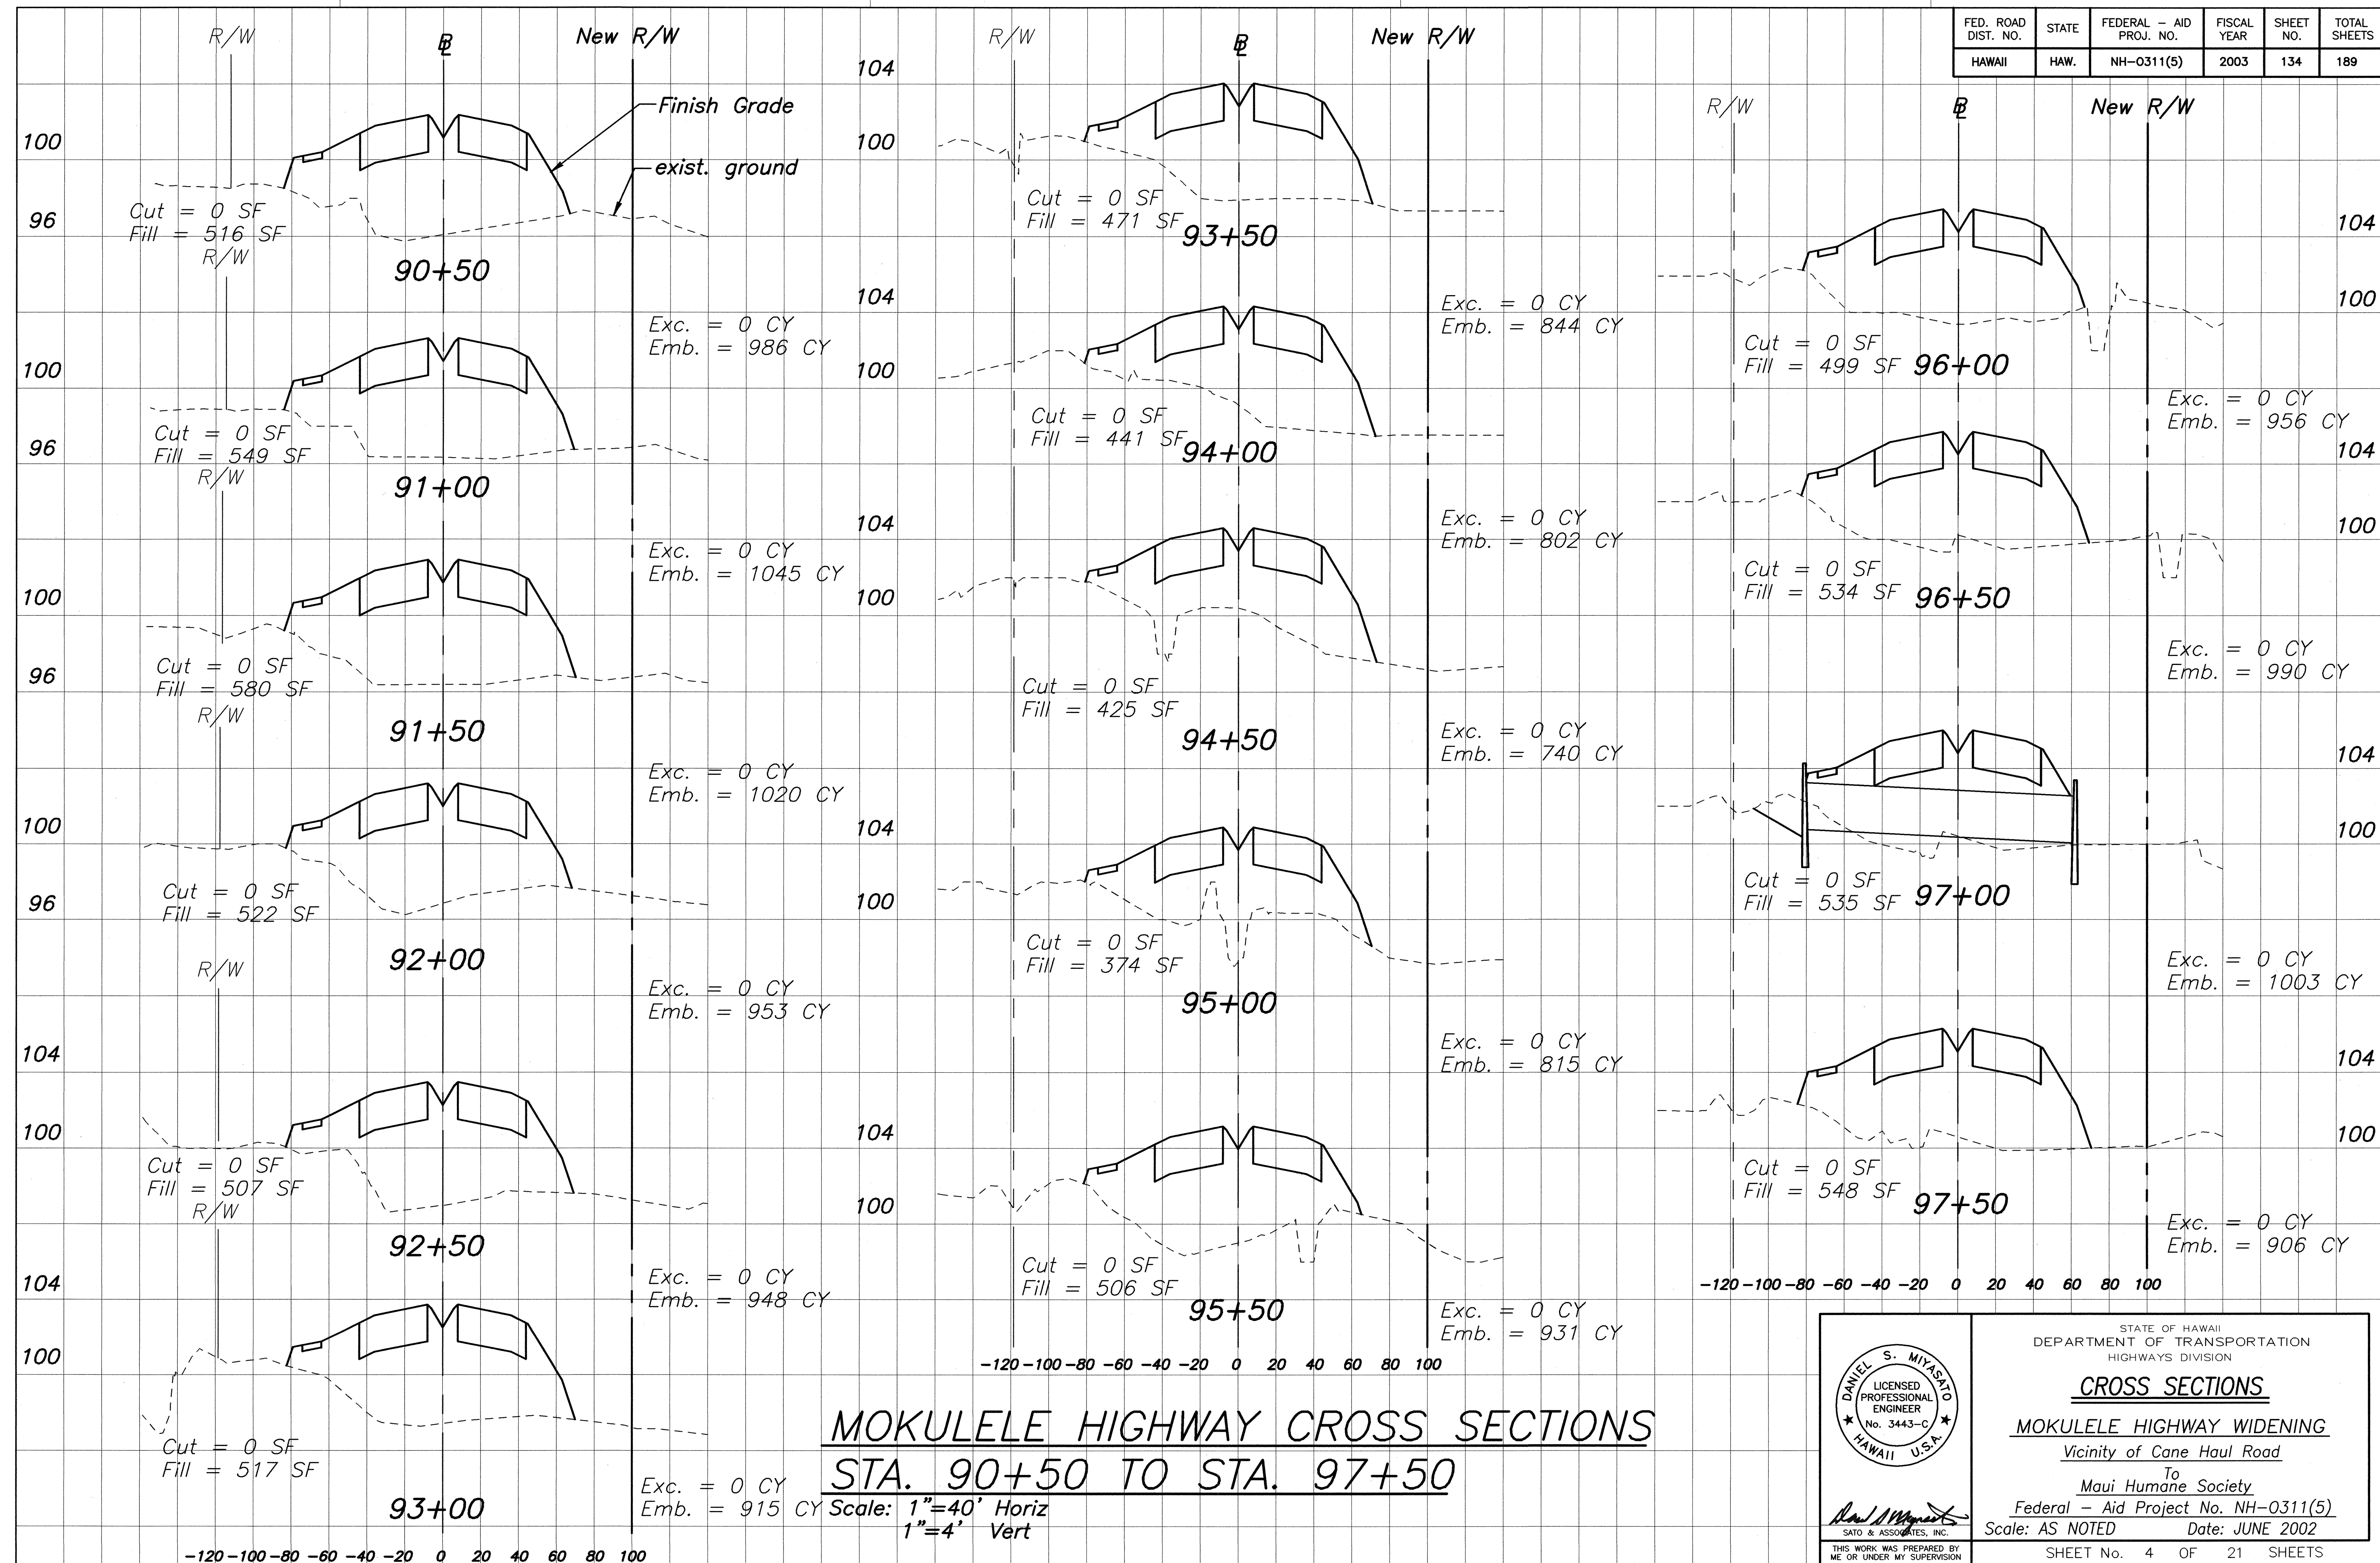

MOKULELE HIGHWAY CROSS SECTIONS

STA. 90+50 TO STA. 97+50

Scale: 1"=40' Horiz
1"=4' Vert

DANIEL S. MIYASATO
LICENSED PROFESSIONAL ENGINEER
No. 3443-C
HAWAII U.S.A.

STATE OF HAWAII
DEPARTMENT OF TRANSPORTATION
HIGHWAYS DIVISION

CROSS SECTIONS

MOKULELE HIGHWAY WIDENING
Vicinity of Cane Haul Road


To
Maui Humane Society
Federal - Aid Project No. NH-0311(5)

Scale: AS NOTED Date: JUNE 2002

SHEET No. 4 OF 21 SHEETS

THIS WORK WAS PREPARED BY
ME OR UNDER MY SUPERVISION

ORIGINAL PLAN	SURVEY PLOTTED BY	DATE
	DRAWN BY	
	TRACED BY	
	NOTED BY	
NOTE BOOK	QUANTITIES BY	
	CHECKED BY	
No.		

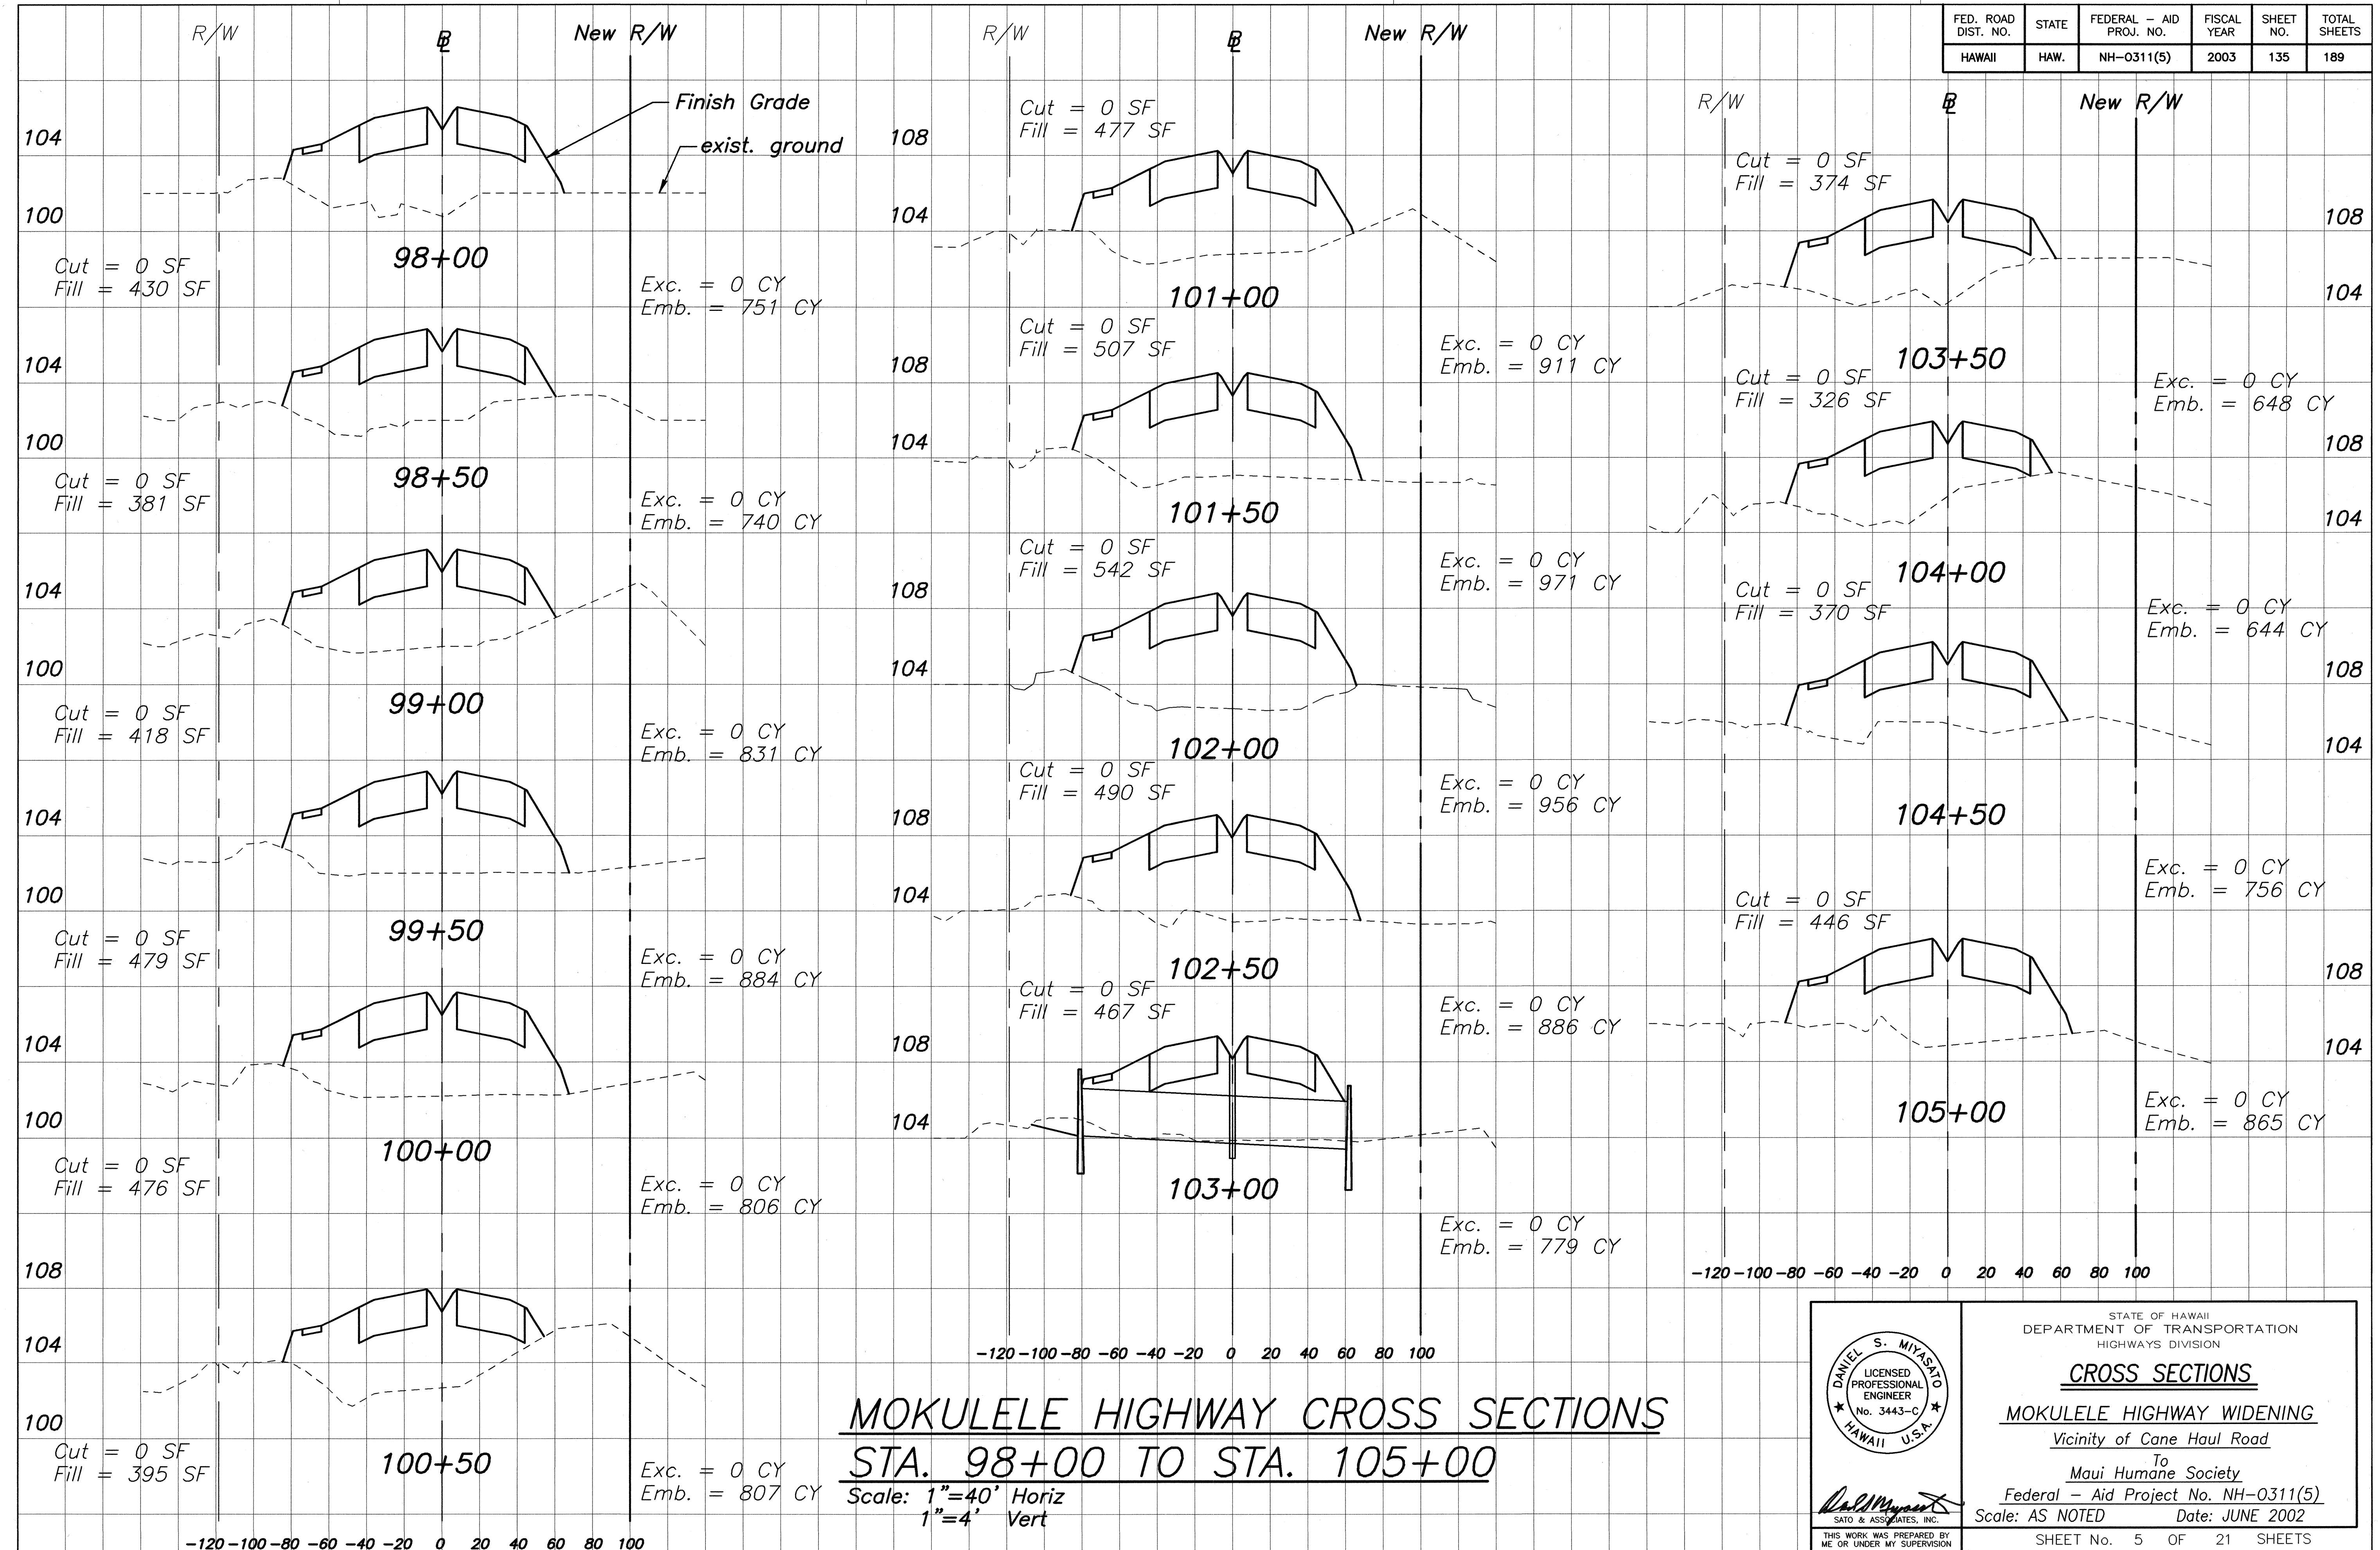

STATE OF HAWAII
 DEPARTMENT OF TRANSPORTATION
 HIGHWAYS DIVISION

CROSS SECTIONS
MOKULELE HIGHWAY WIDENING
 Vicinity of Cane Haul Road

To
 Maui Humane Society
 Federal - Aid Project No. NH-0311(5)
 Scale: AS NOTED Date: JUNE 2002


SHEET No. 5 OF 21 SHEETS

DANIEL S. MIYASAKO
 LICENSED PROFESSIONAL ENGINEER
 No. 3443-C
 HAWAII U.S.A.

SATO & ASSOCIATES, INC.
 THIS WORK WAS PREPARED BY ME OR UNDER MY SUPERVISION

PROJ. NO.: M9901.00
3/16/02
R:\moku\p2b\X-SECT1.dwg

SURVEY PLOTTED BY	DATE
DRAWN BY	
CHECKED BY	
NOTE BOOK	
QUANTITIES BY	
CHECKED BY	
No.	

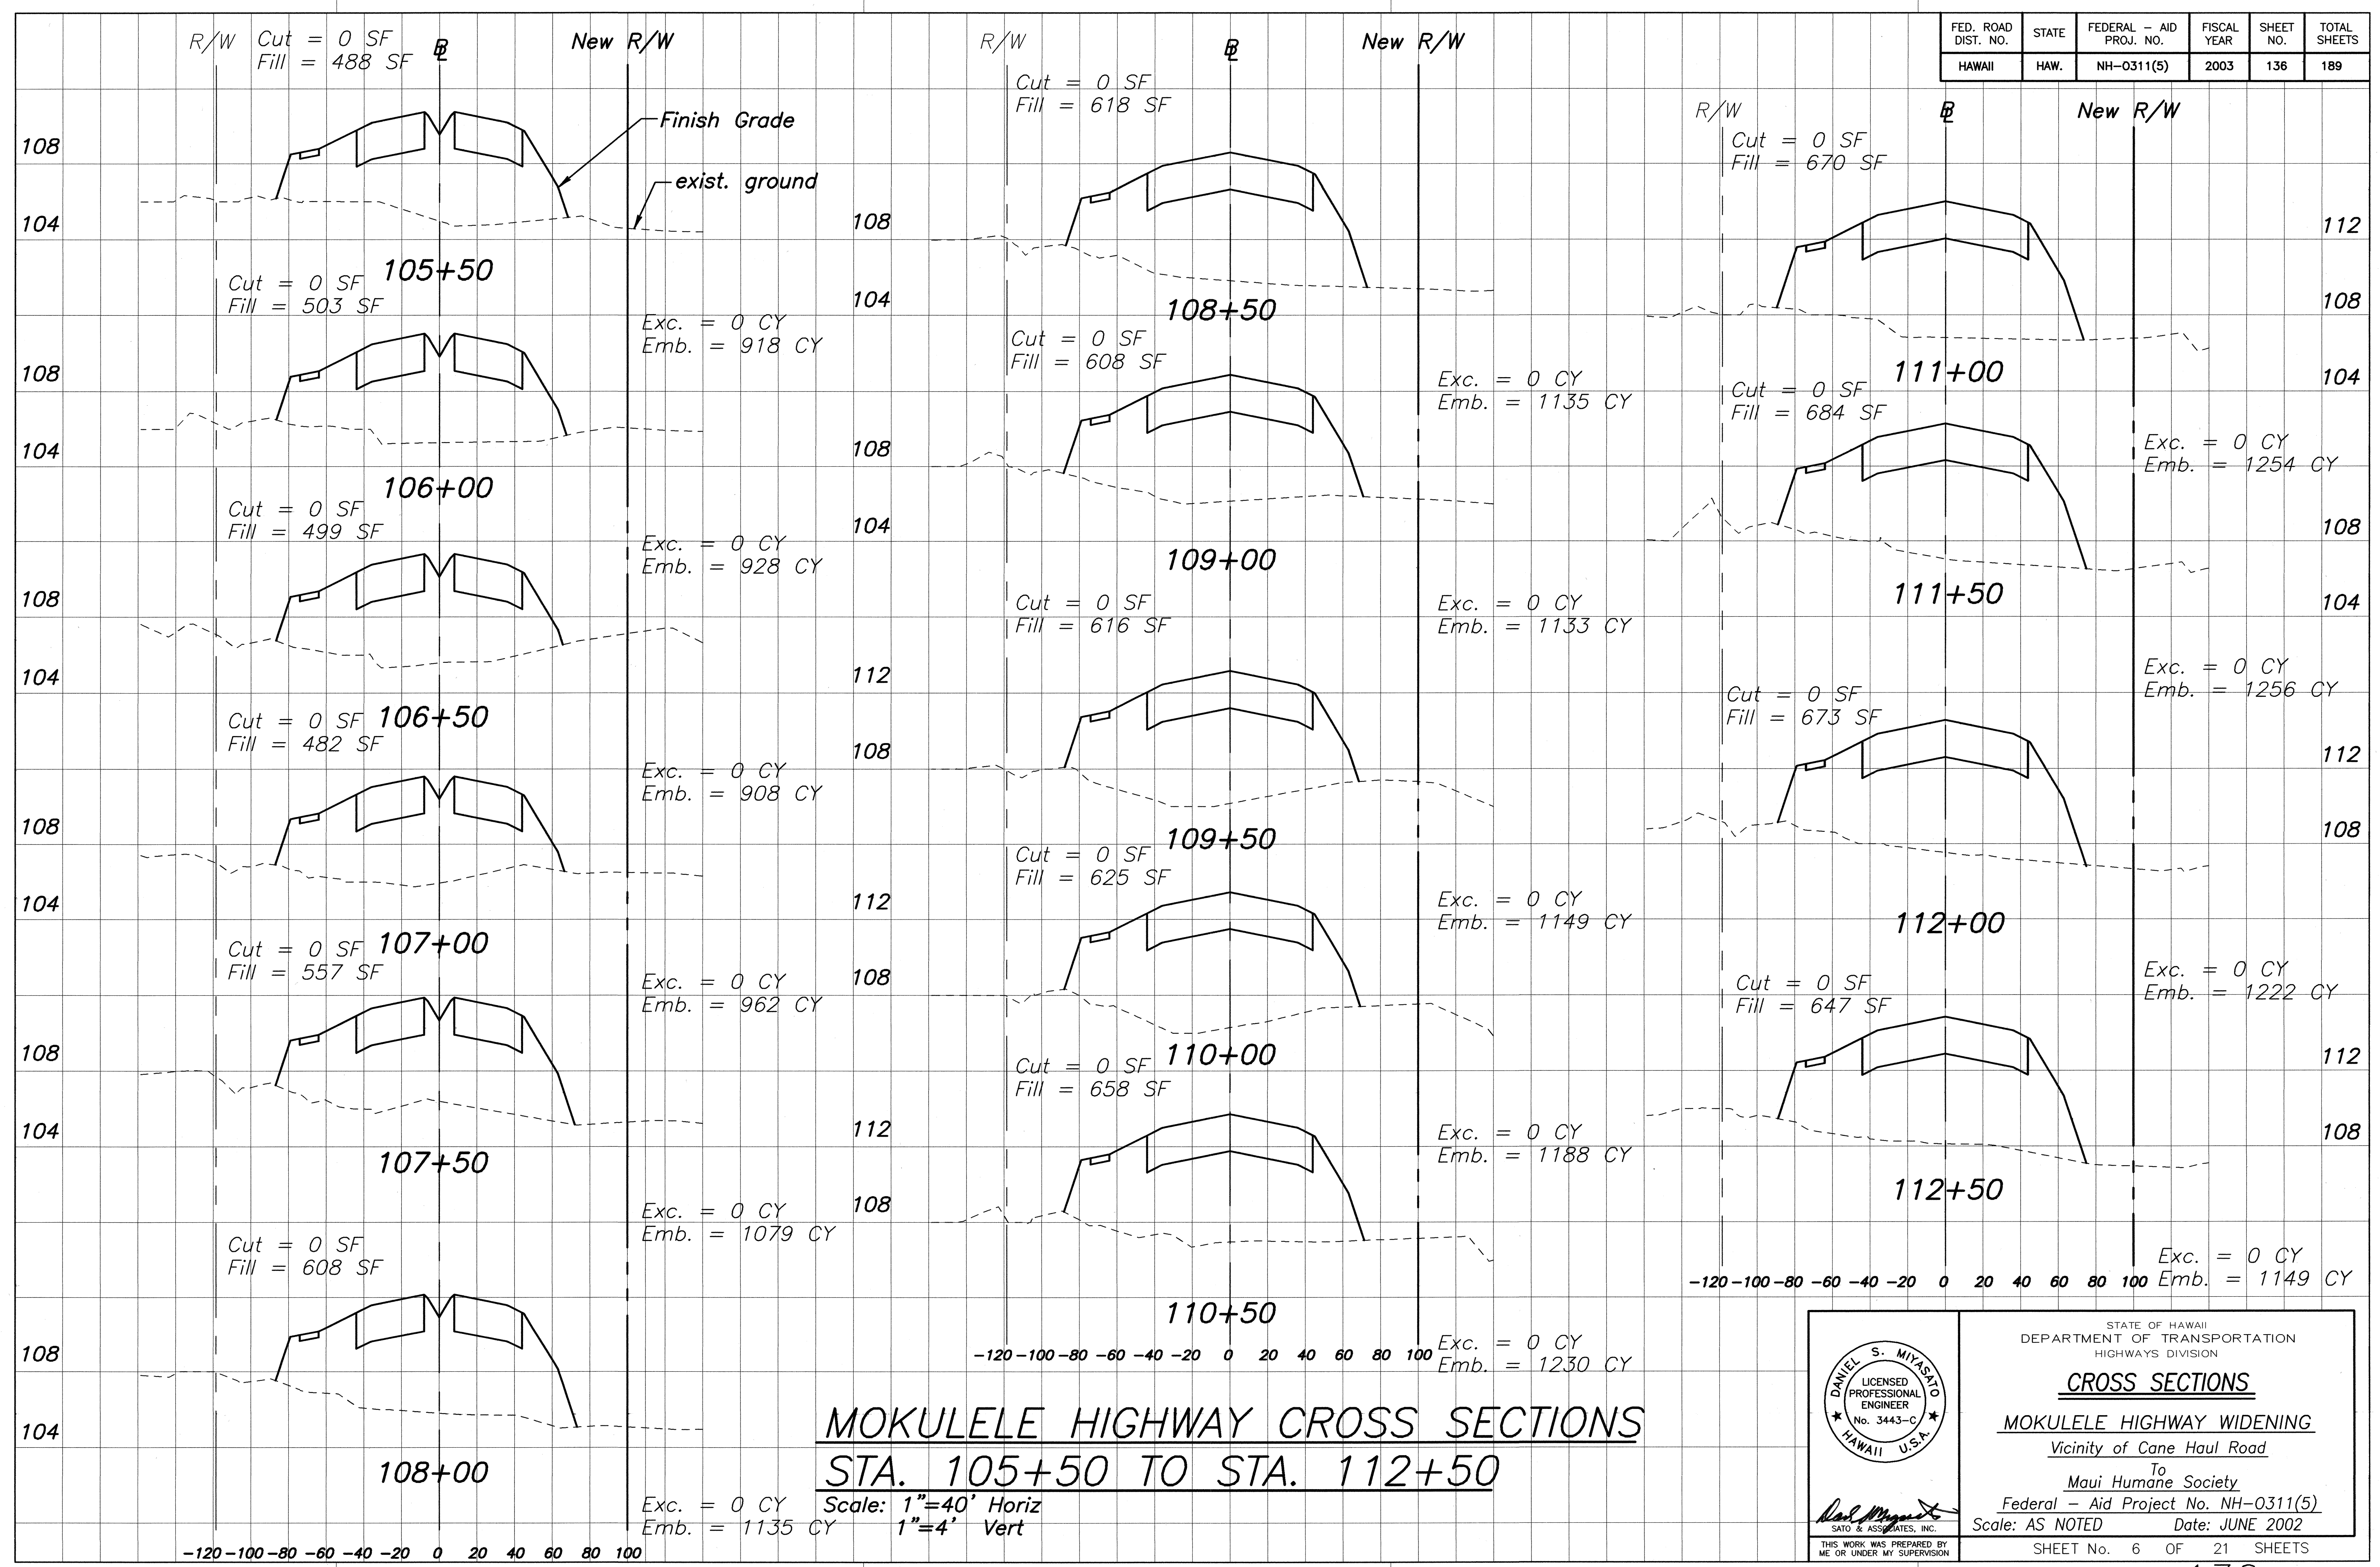


PROJ. NO.: M9901.00


3/16/02

R:\moku\p2b\X-SECT1.dwg

ORIGINAL PLAN	SURVEY PLOTTED BY	DATE
NOTE BOOK	DRAWN BY	
	TRACED BY	
	QUANTITIES BY	
	CHECKED BY	
No.		

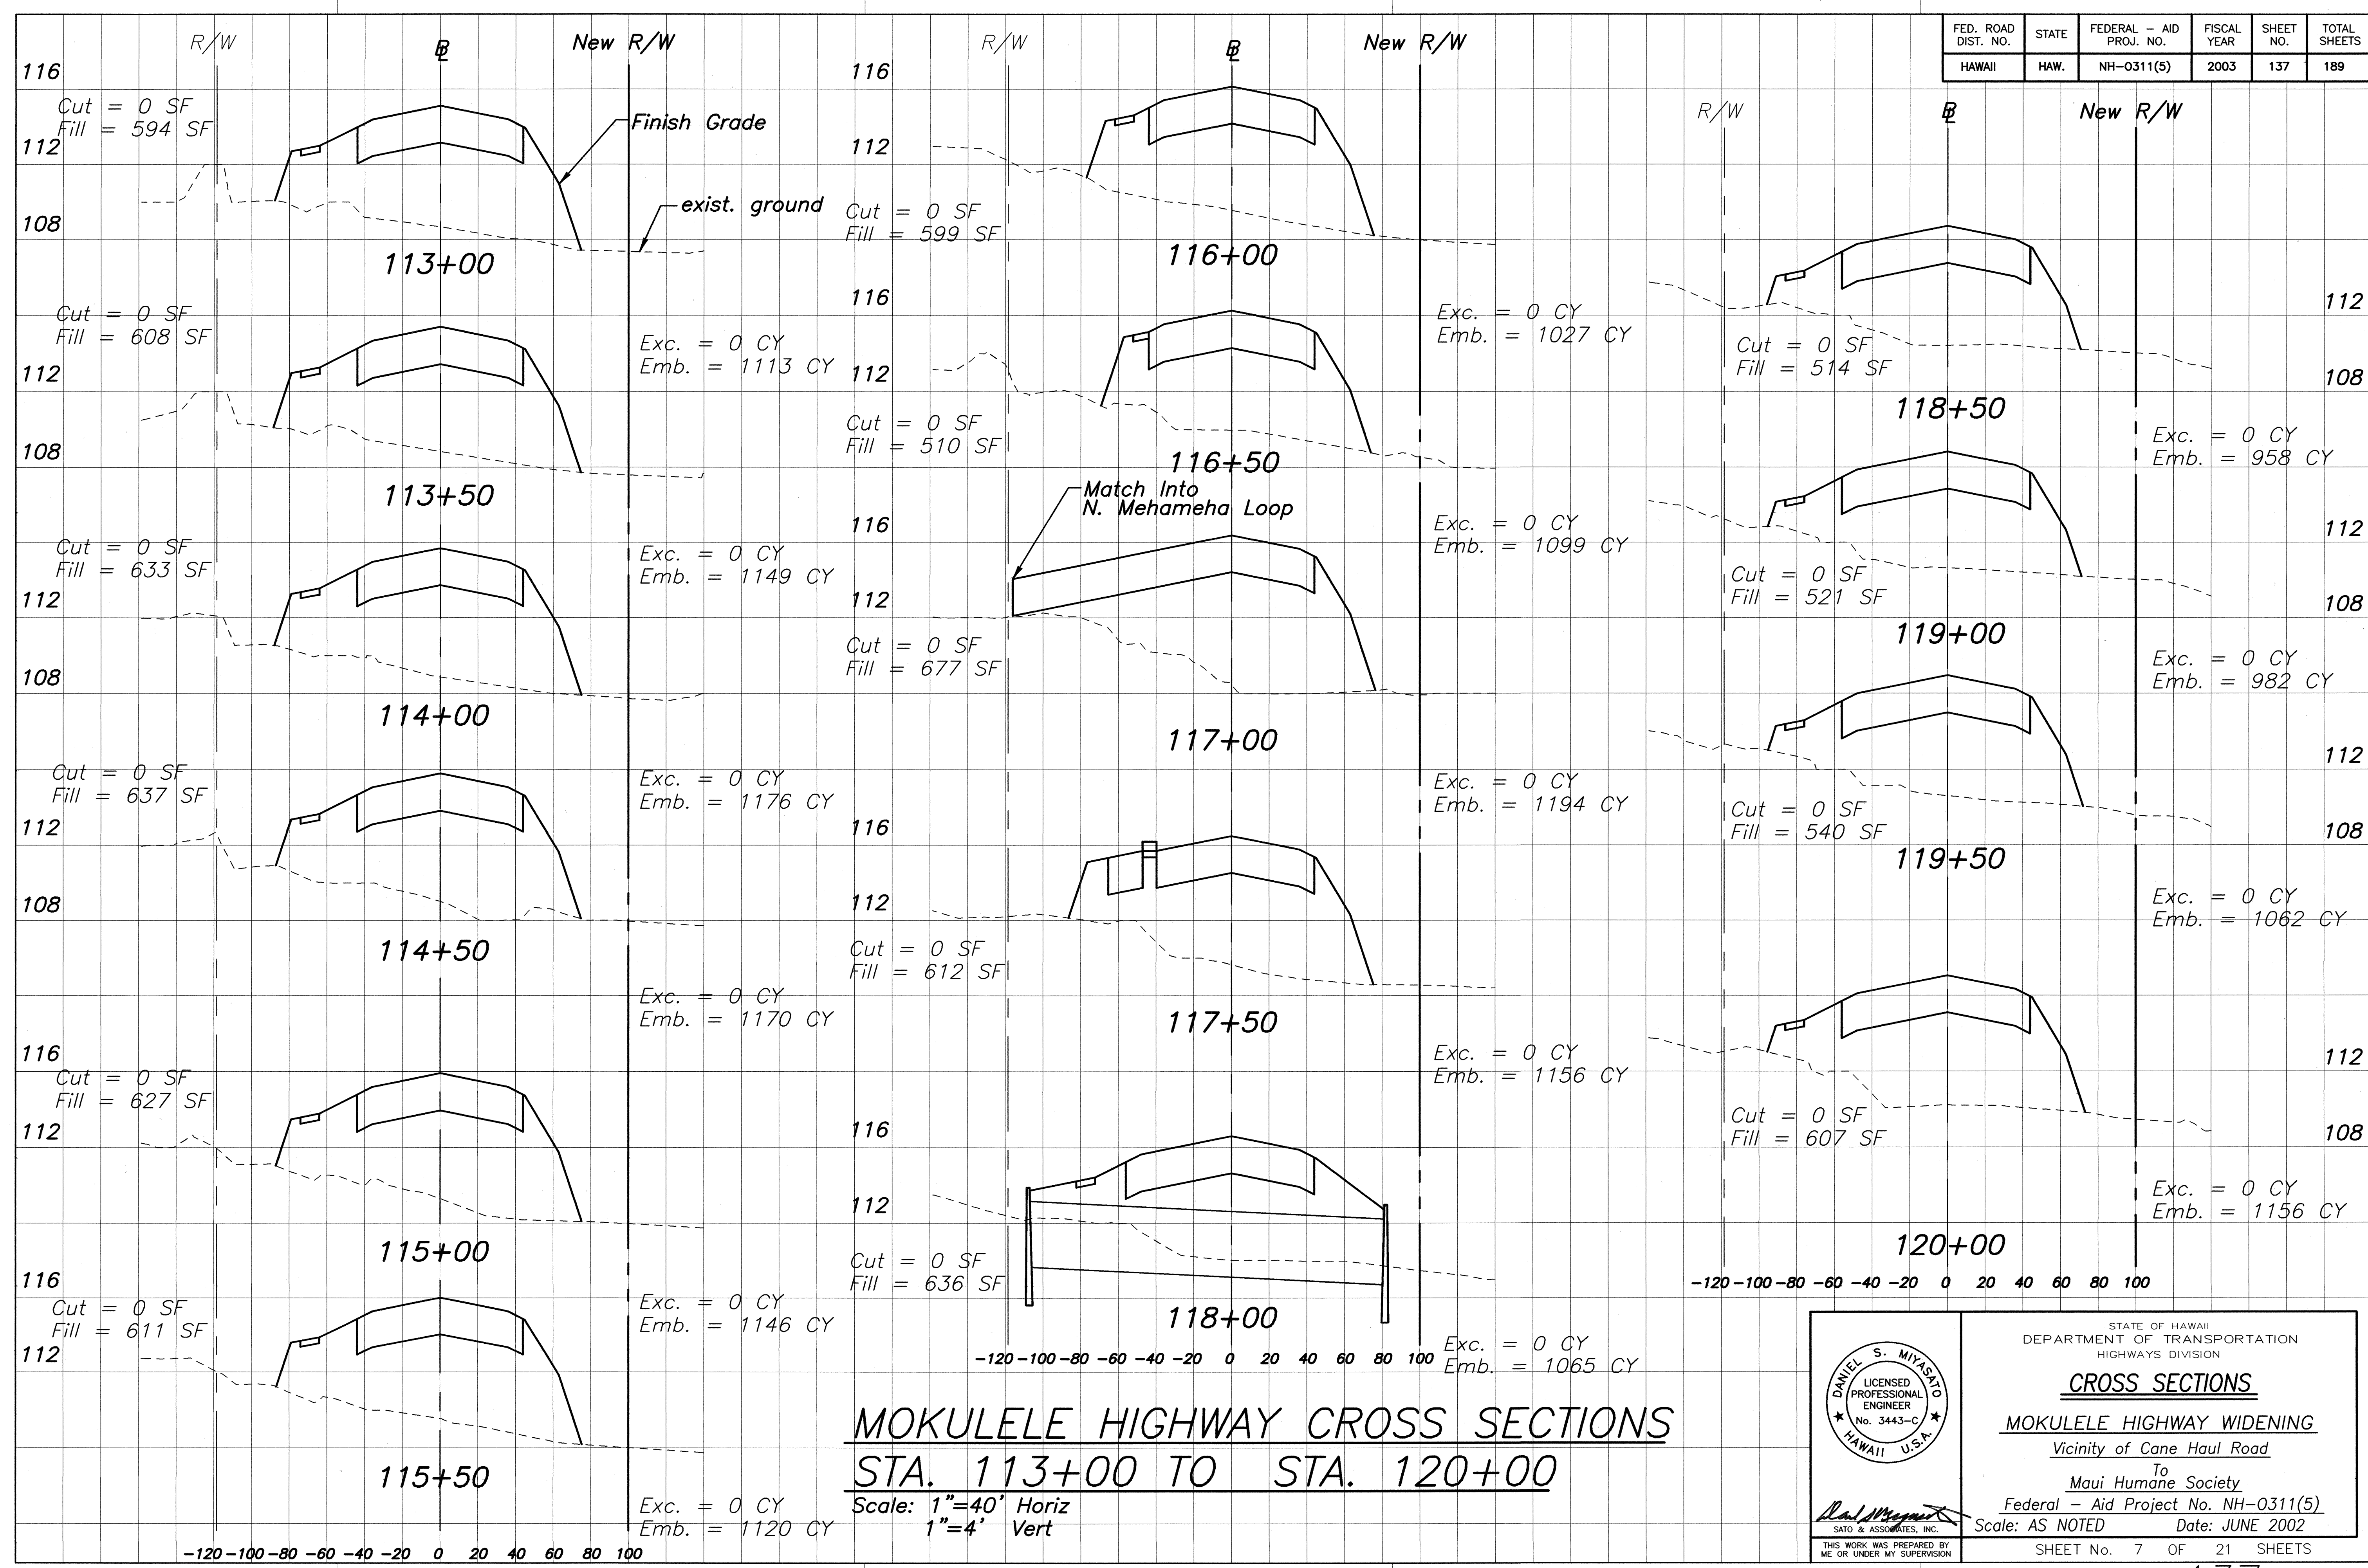

FED. ROAD DIST. NO.	STATE	FEDERAL - AID PROJ. NO.	FISCAL YEAR	SHEET NO.	TOTAL SHEETS
HAWAII	HAW.	NH-0311(5)	2003	138	189

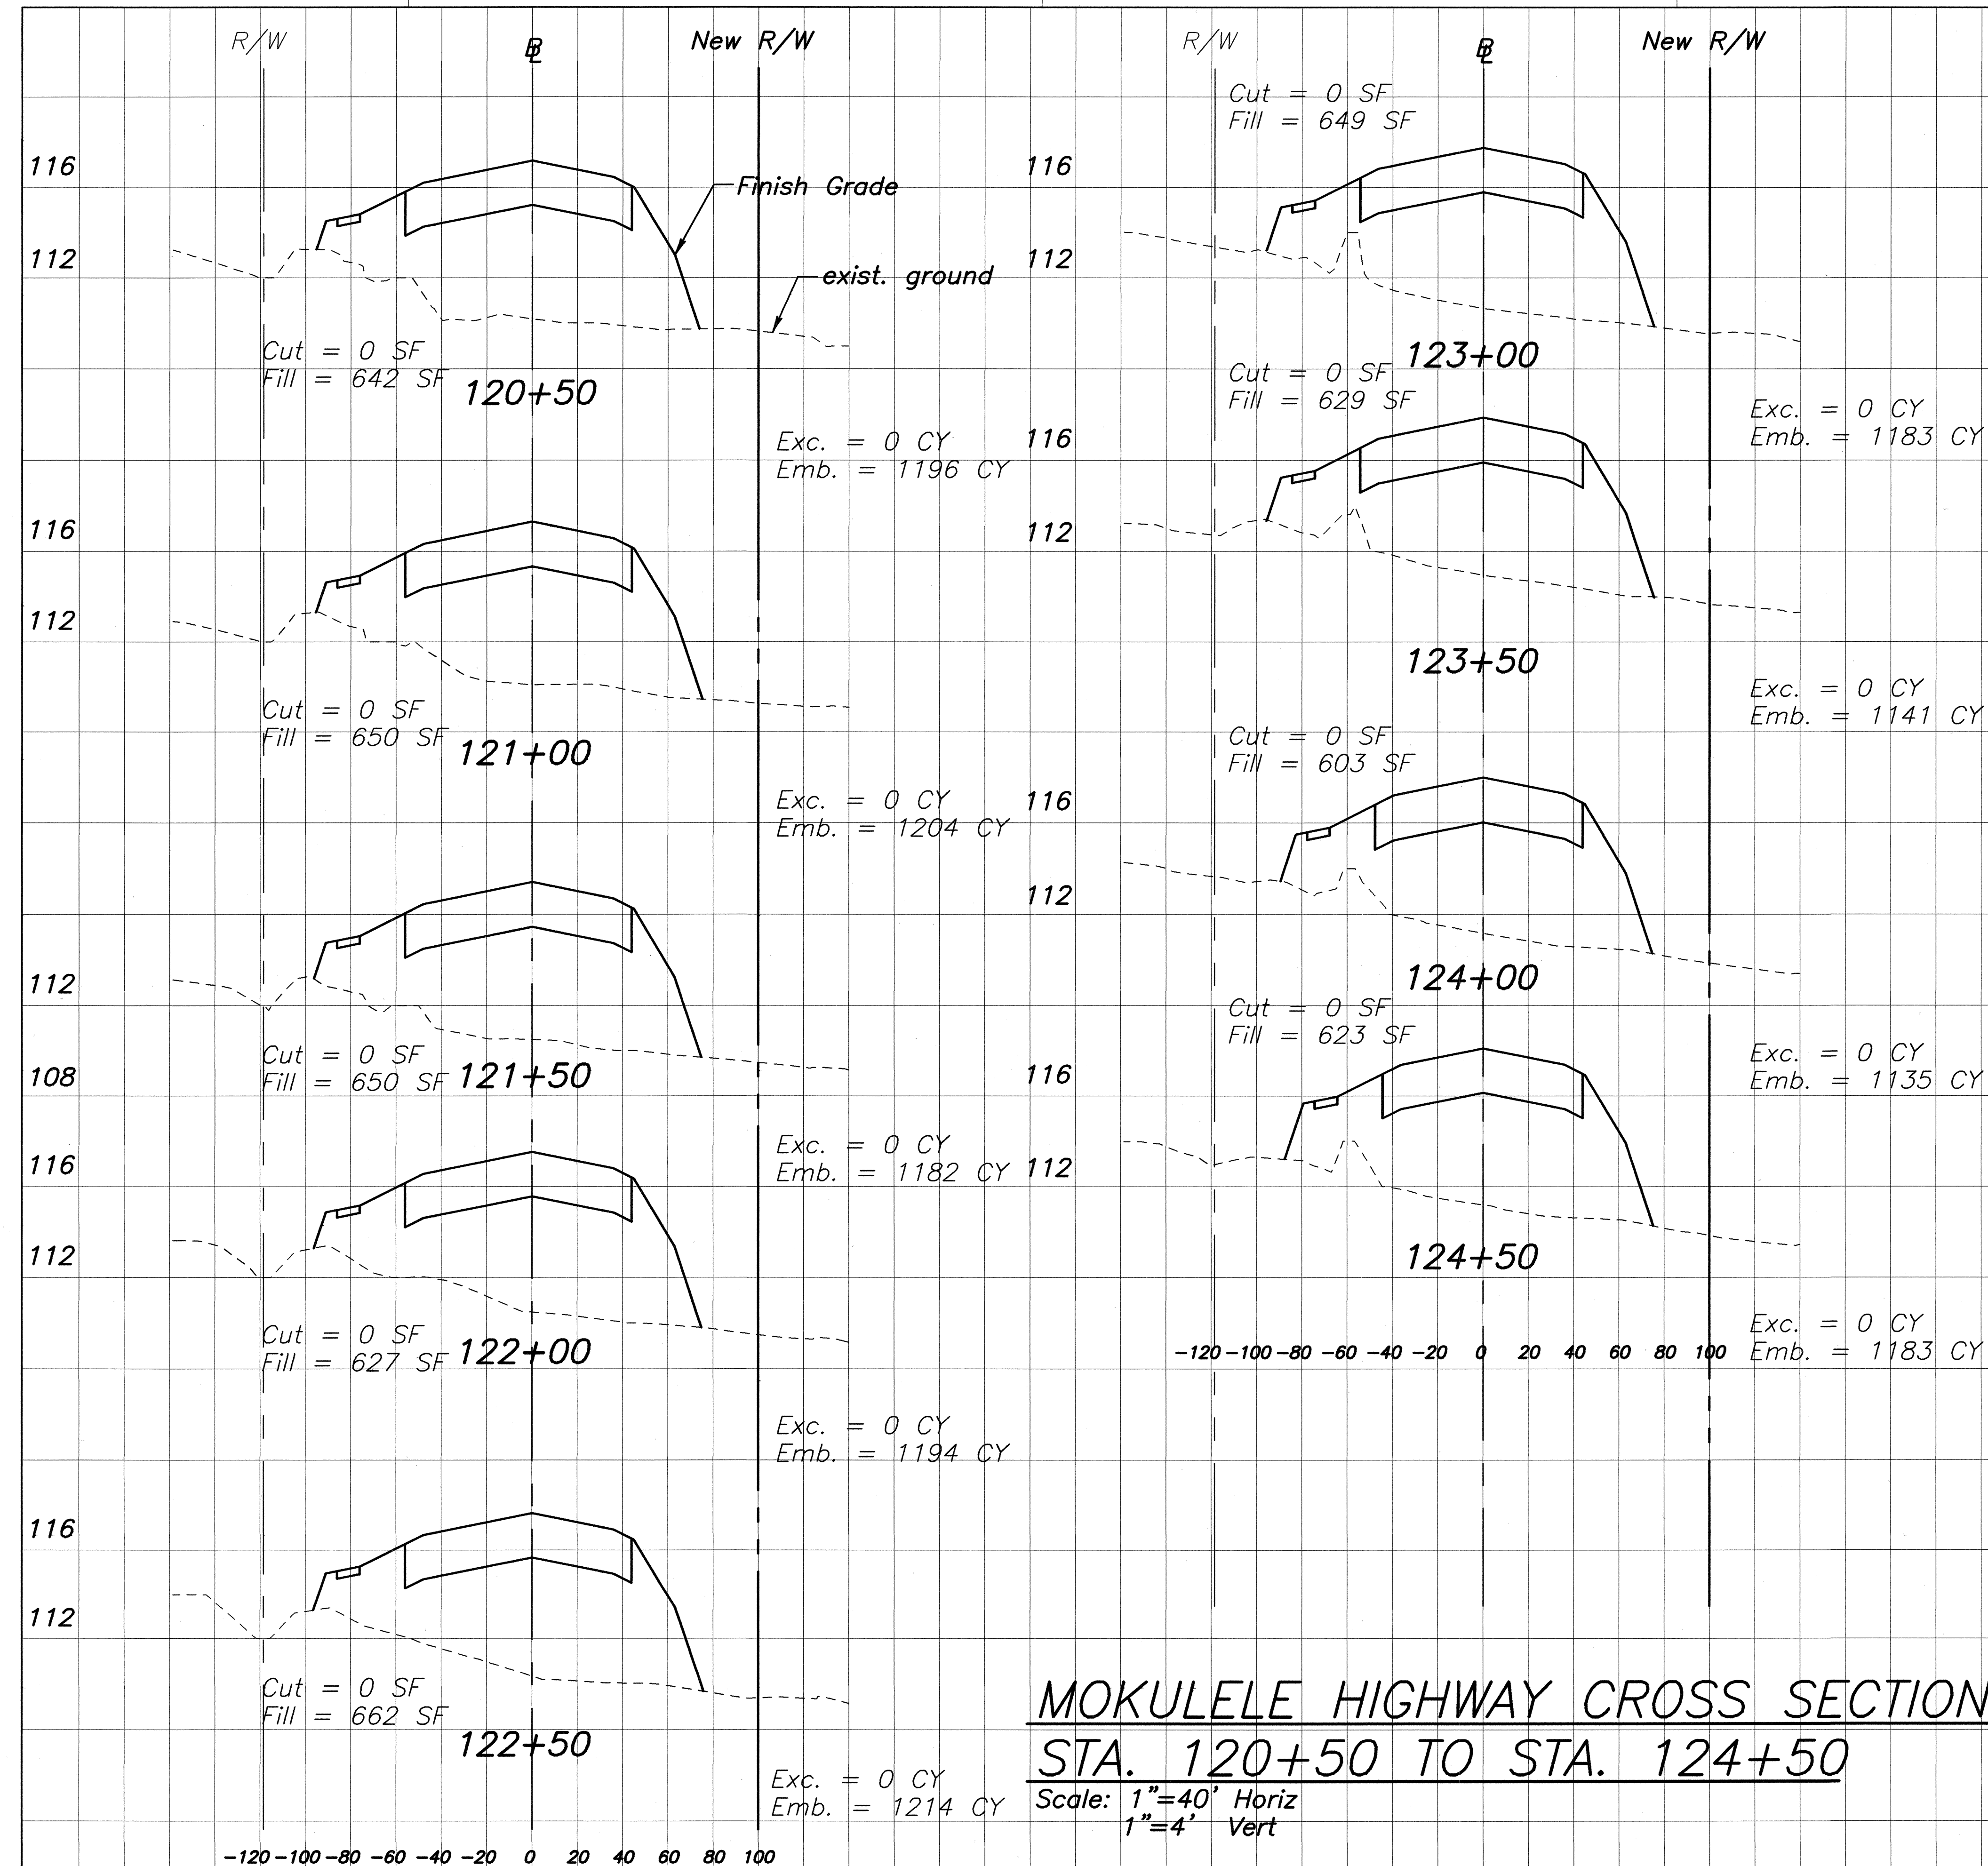

SURVEY PLOTTED BY	DATE
DRAWN BY	
TRACED BY	
QUANTITIES BY	
CHECKED BY	
No.	

STATE OF HAWAII
DEPARTMENT OF TRANSPORTATION
HIGHWAYS DIVISION

CROSS SECTIONS

MOKULELE HIGHWAY WIDENING

Vicinity of Cane Haul Road


To
Maui Humane Society

Federal - Aid Project No. NH-0311(5)

Scale: AS NOTED Date: JUNE 2002

SHEET No. 8 OF 21 SHEETS

FED. ROAD DIST. NO.	STATE	FEDERAL - AID PROJ. NO.	FISCAL YEAR	SHEET NO.	TOTAL SHEETS
HAWAII	HAW.	NH-0311(5)	2003	139	189

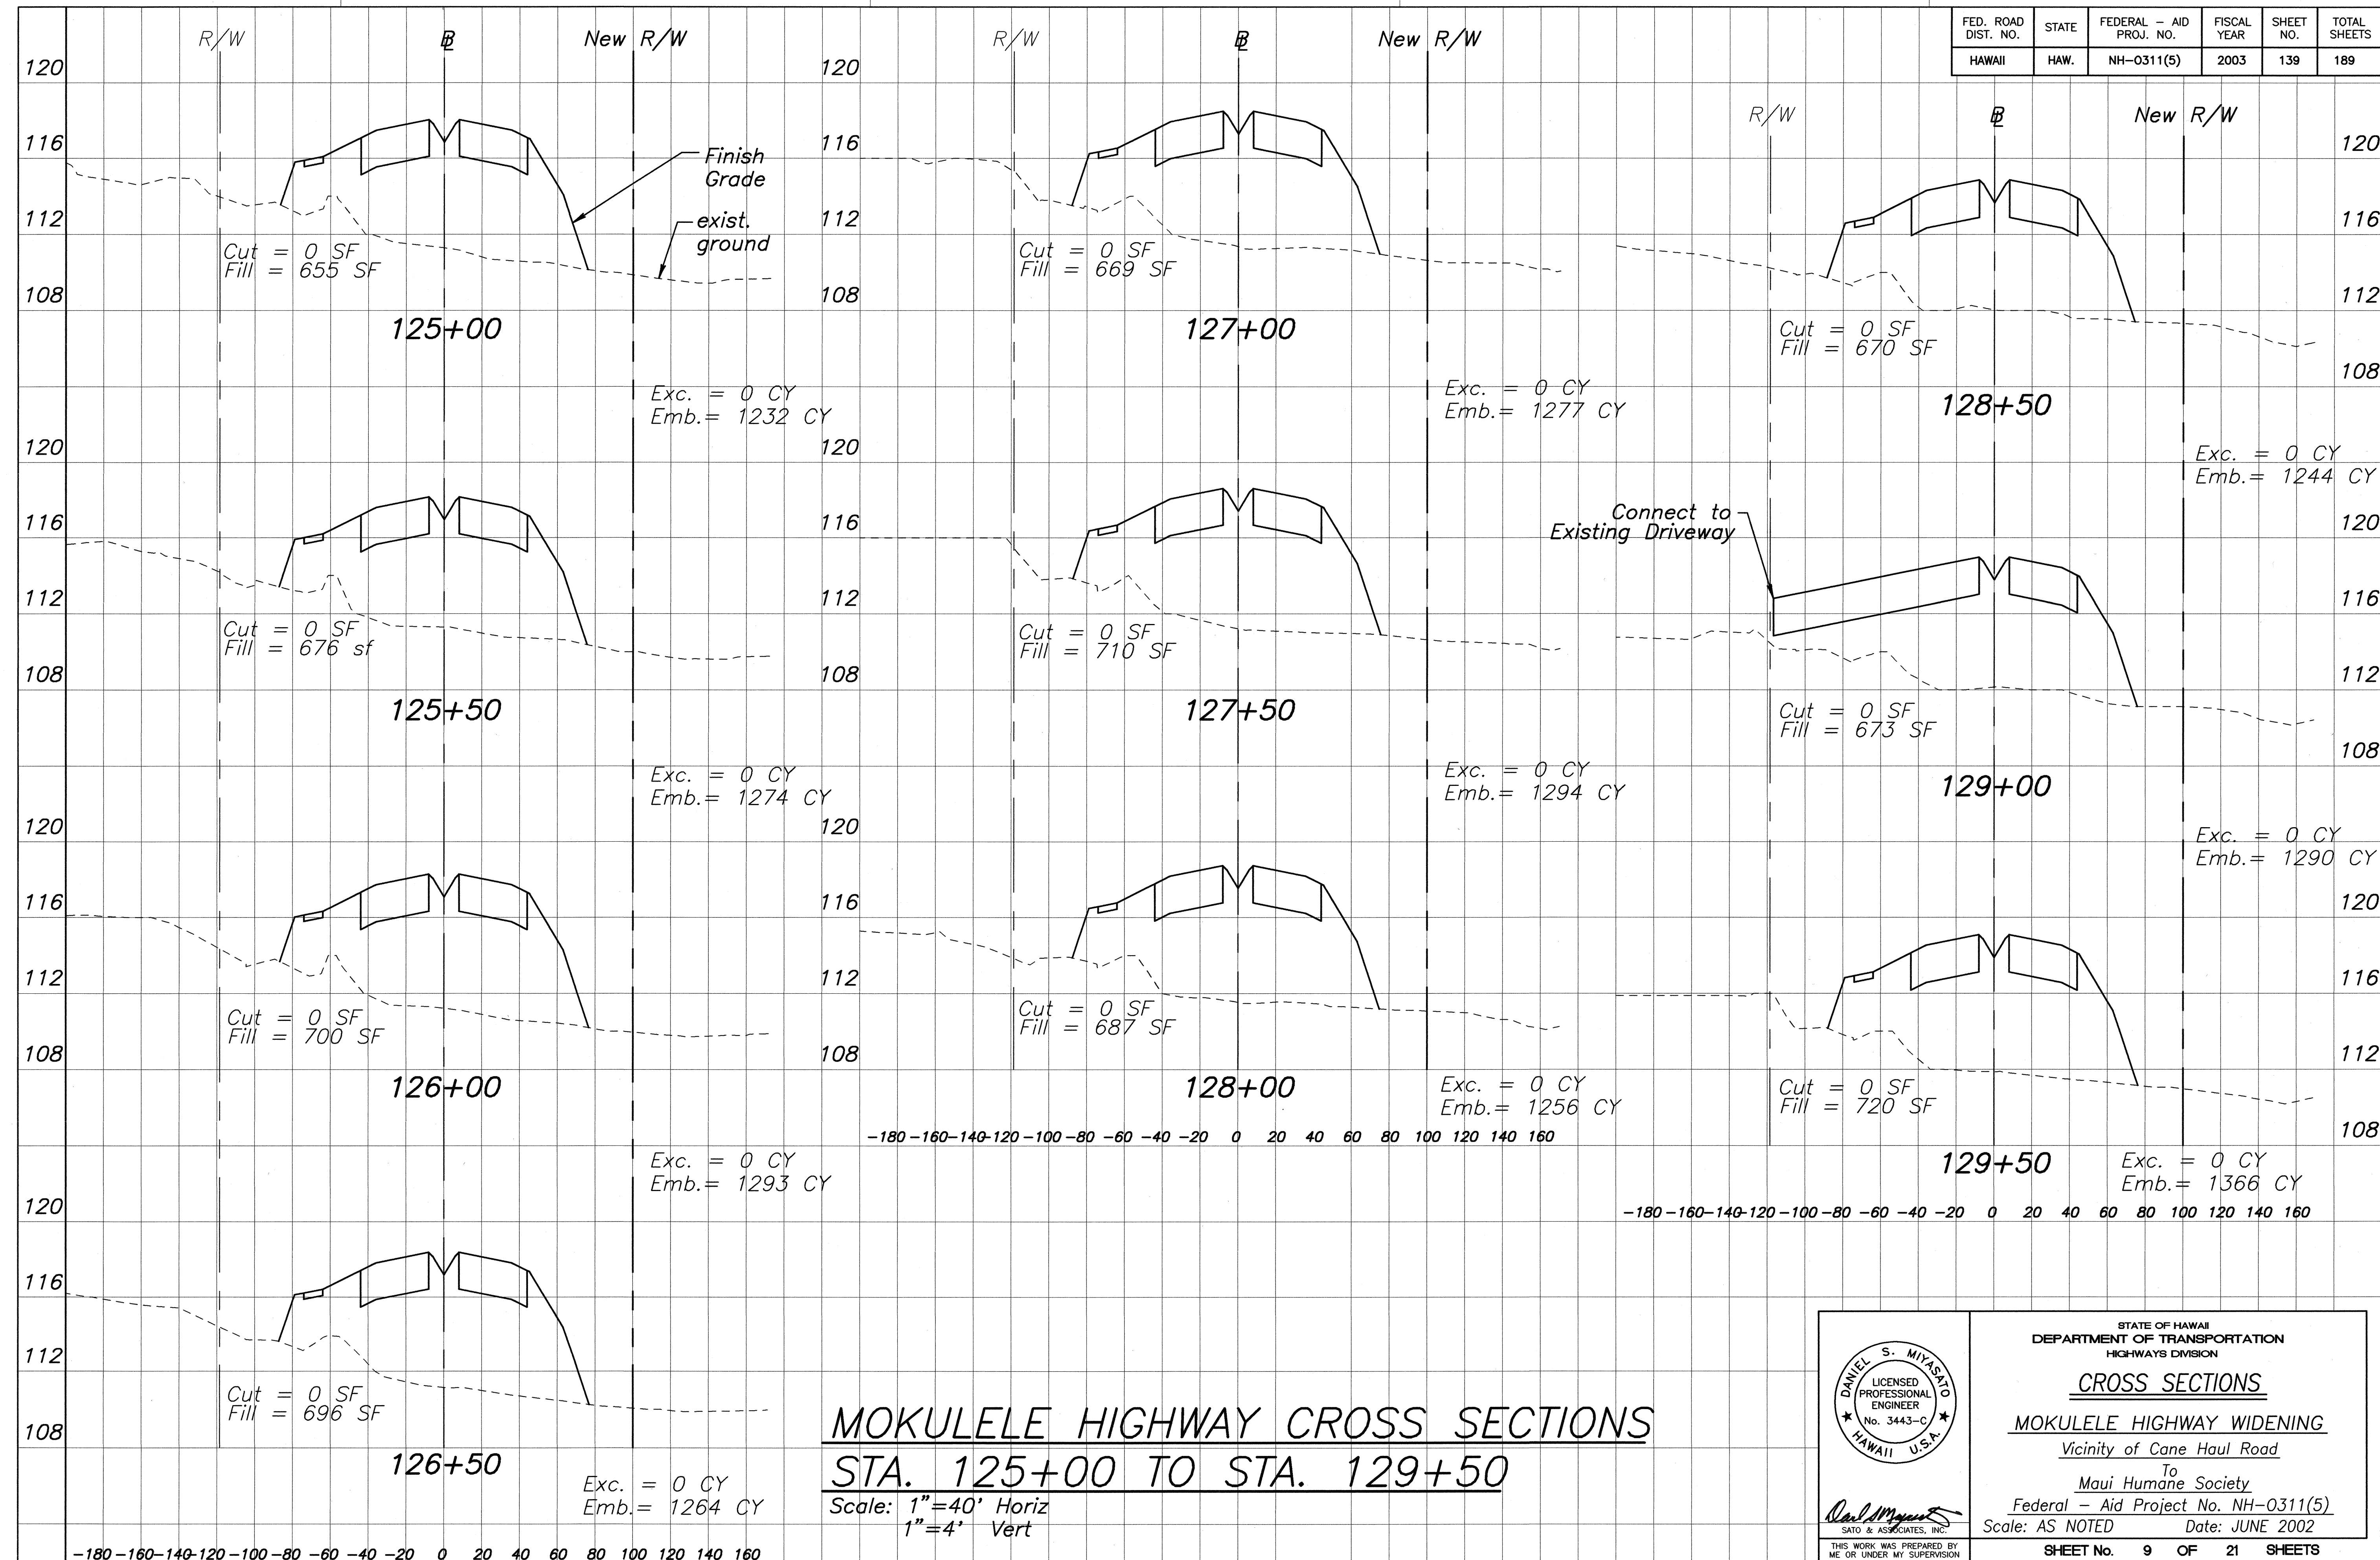

STATE OF HAWAII
DEPARTMENT OF TRANSPORTATION
HIGHWAYS DIVISION

CROSS SECTIONS

MOKULELE HIGHWAY WIDENING

Vicinity of Cane Haul Road

To
Maui Humane Society

Federal - Aid Project No. NH-0311(5)

Scale: AS NOTED Date: JUNE 2002


THIS WORK WAS PREPARED BY
ME OR UNDER MY SUPERVISION

DANIEL S. MIYASATO
LICENSED PROFESSIONAL ENGINEER
No. 3443-C
HAWAII U.S.A.

SATO & ASSOCIATES, INC.

SHEET No. 9 OF 21 SHEETS

FED. ROAD DIST. NO.	STATE	FEDERAL - AID PROJ. NO.	FISCAL YEAR	SHEET NO.	TOTAL SHEETS
HAWAII	HAW.	NH-0311(5)	2003	140	189

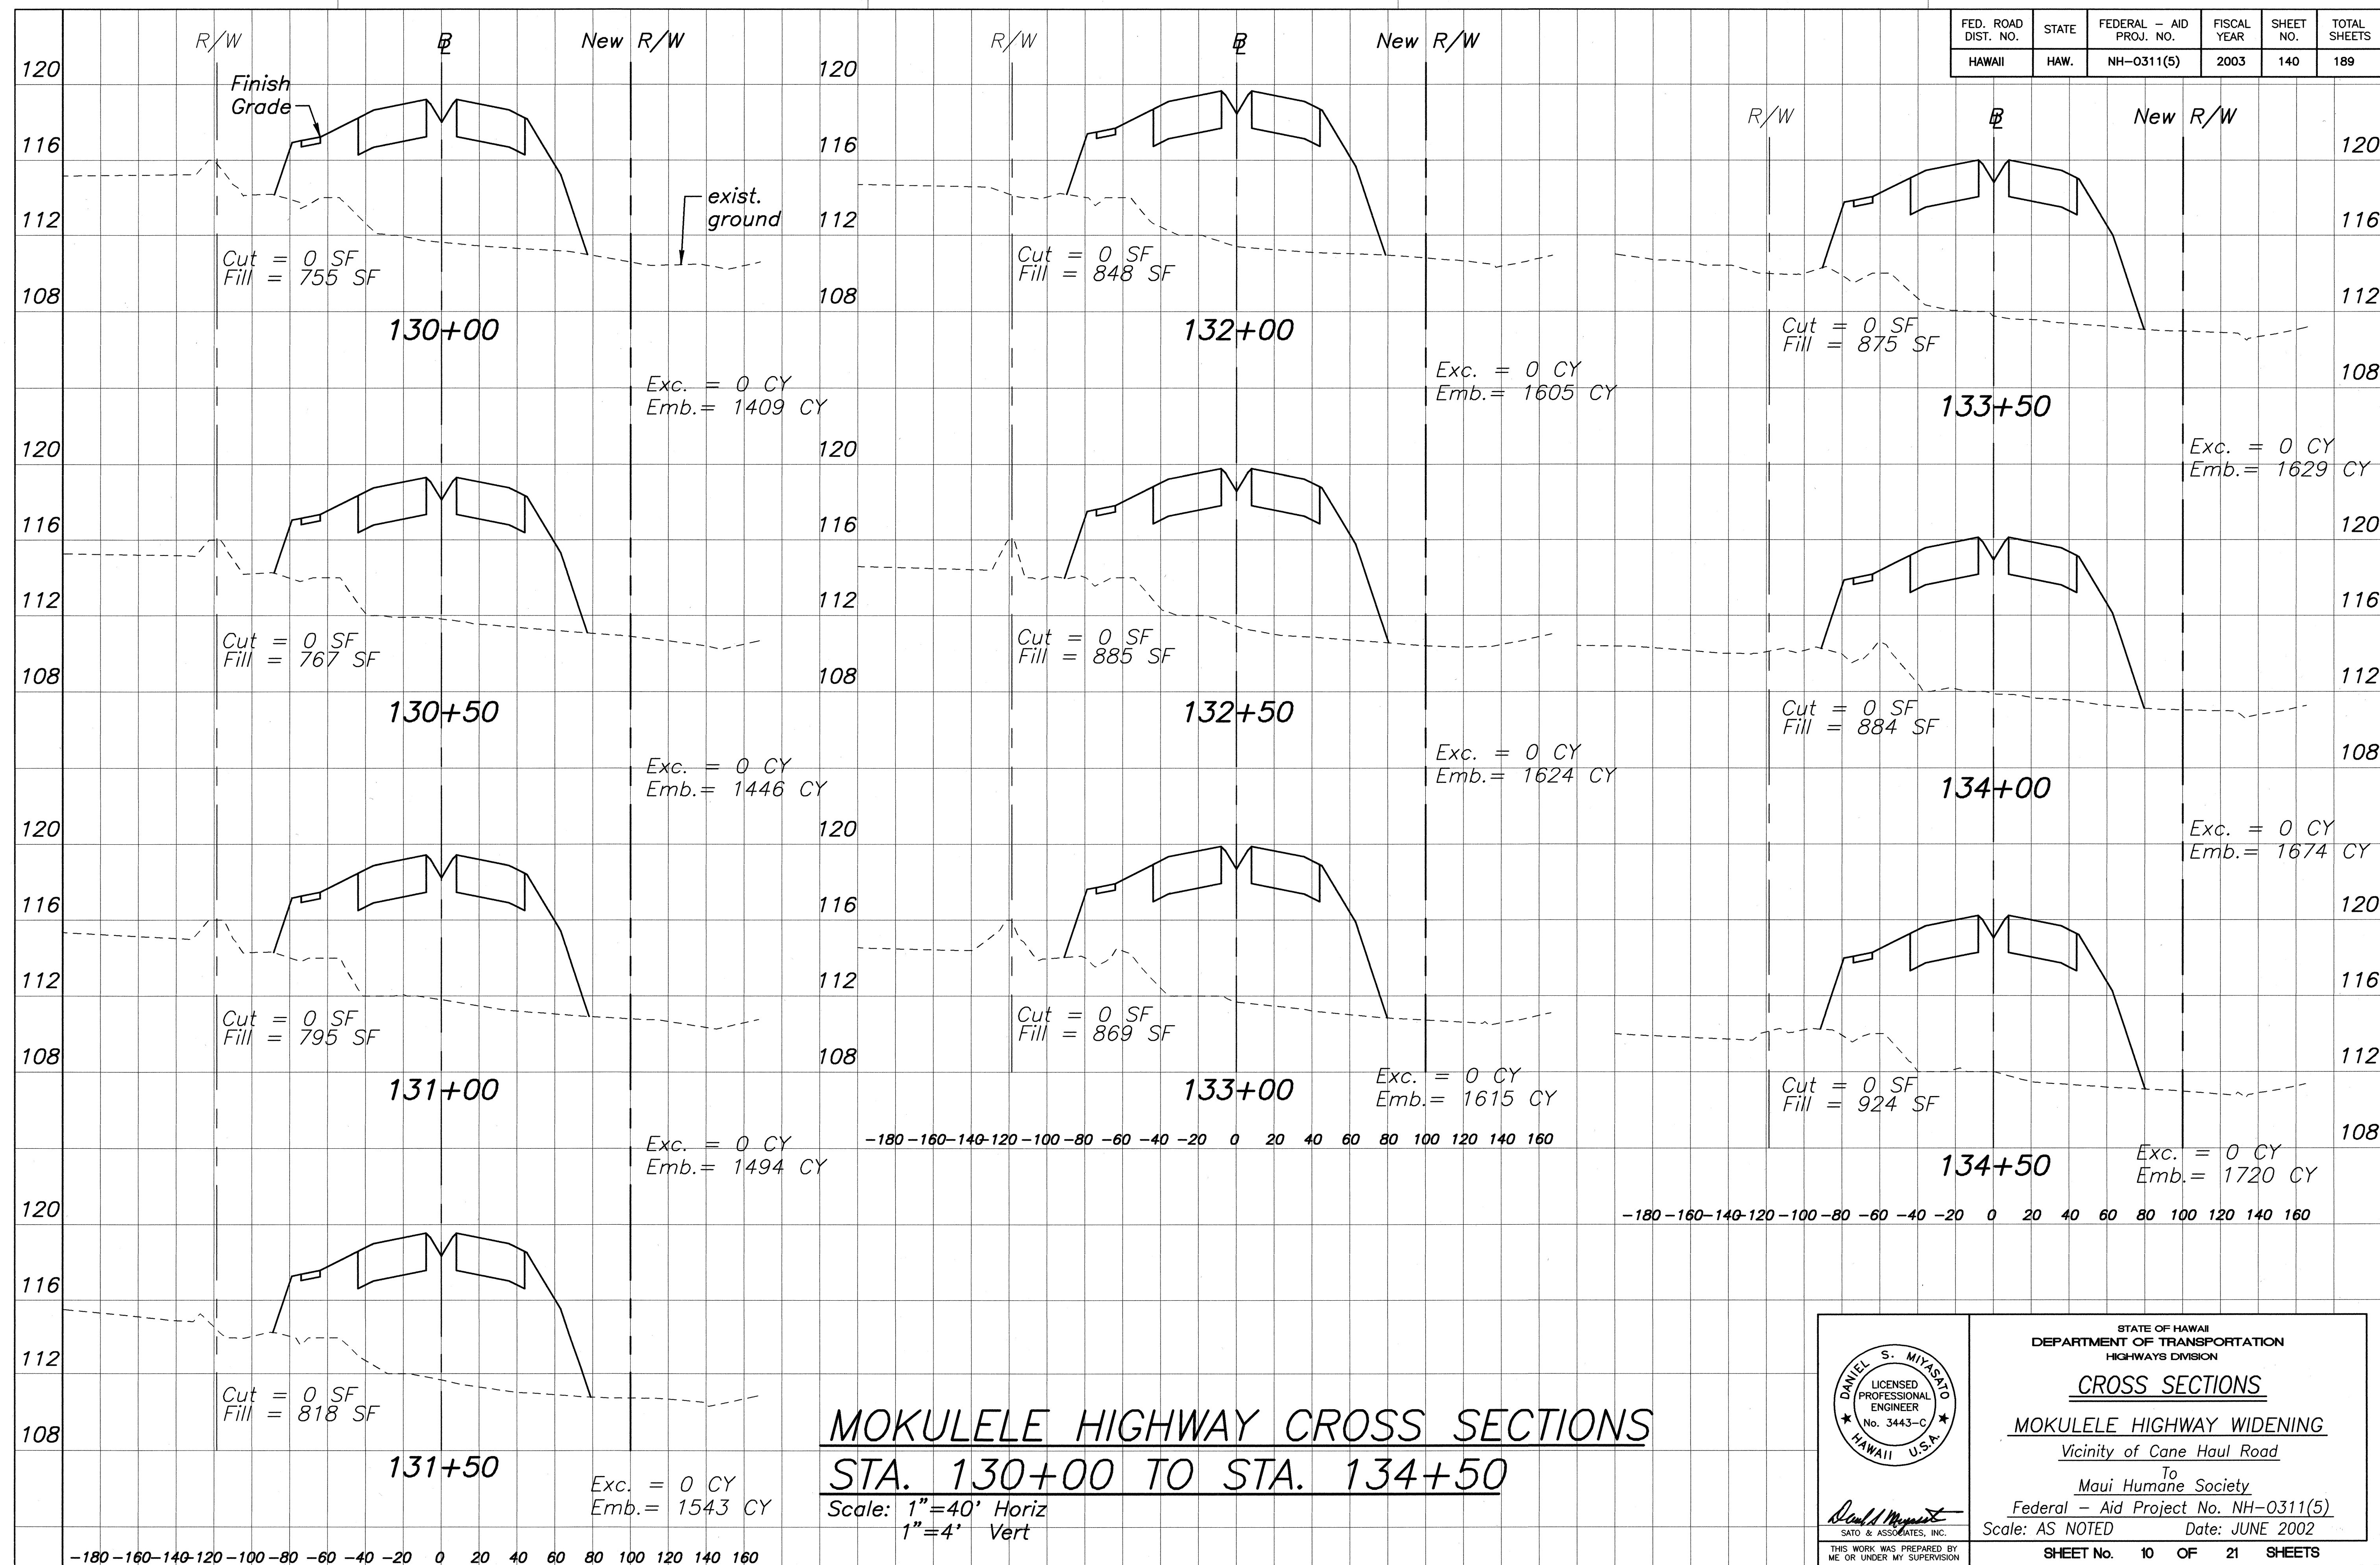


MOKULELE HIGHWAY CROSS SECTIONS
STA. 130+00 TO STA. 134+50
 Scale: 1"=40' Horiz
 1"=4' Vert

STATE OF HAWAII
 DEPARTMENT OF TRANSPORTATION
 HIGHWAYS DIVISION

CROSS SECTIONS
MOKULELE HIGHWAY WIDENING
 Vicinity of Cane Haul Road
 To
 Maui Humane Society
 Federal - Aid Project No. NH-0311(5)
 Scale: AS NOTED Date: JUNE 2002

SHEET No. 10 OF 21 SHEETS

FED. ROAD DIST. NO.	STATE	FEDERAL - AID PROJ. NO.	FISCAL YEAR	SHEET NO.	TOTAL SHEETS
HAWAII	HAW.	NH-0311(5)	2003	141	189

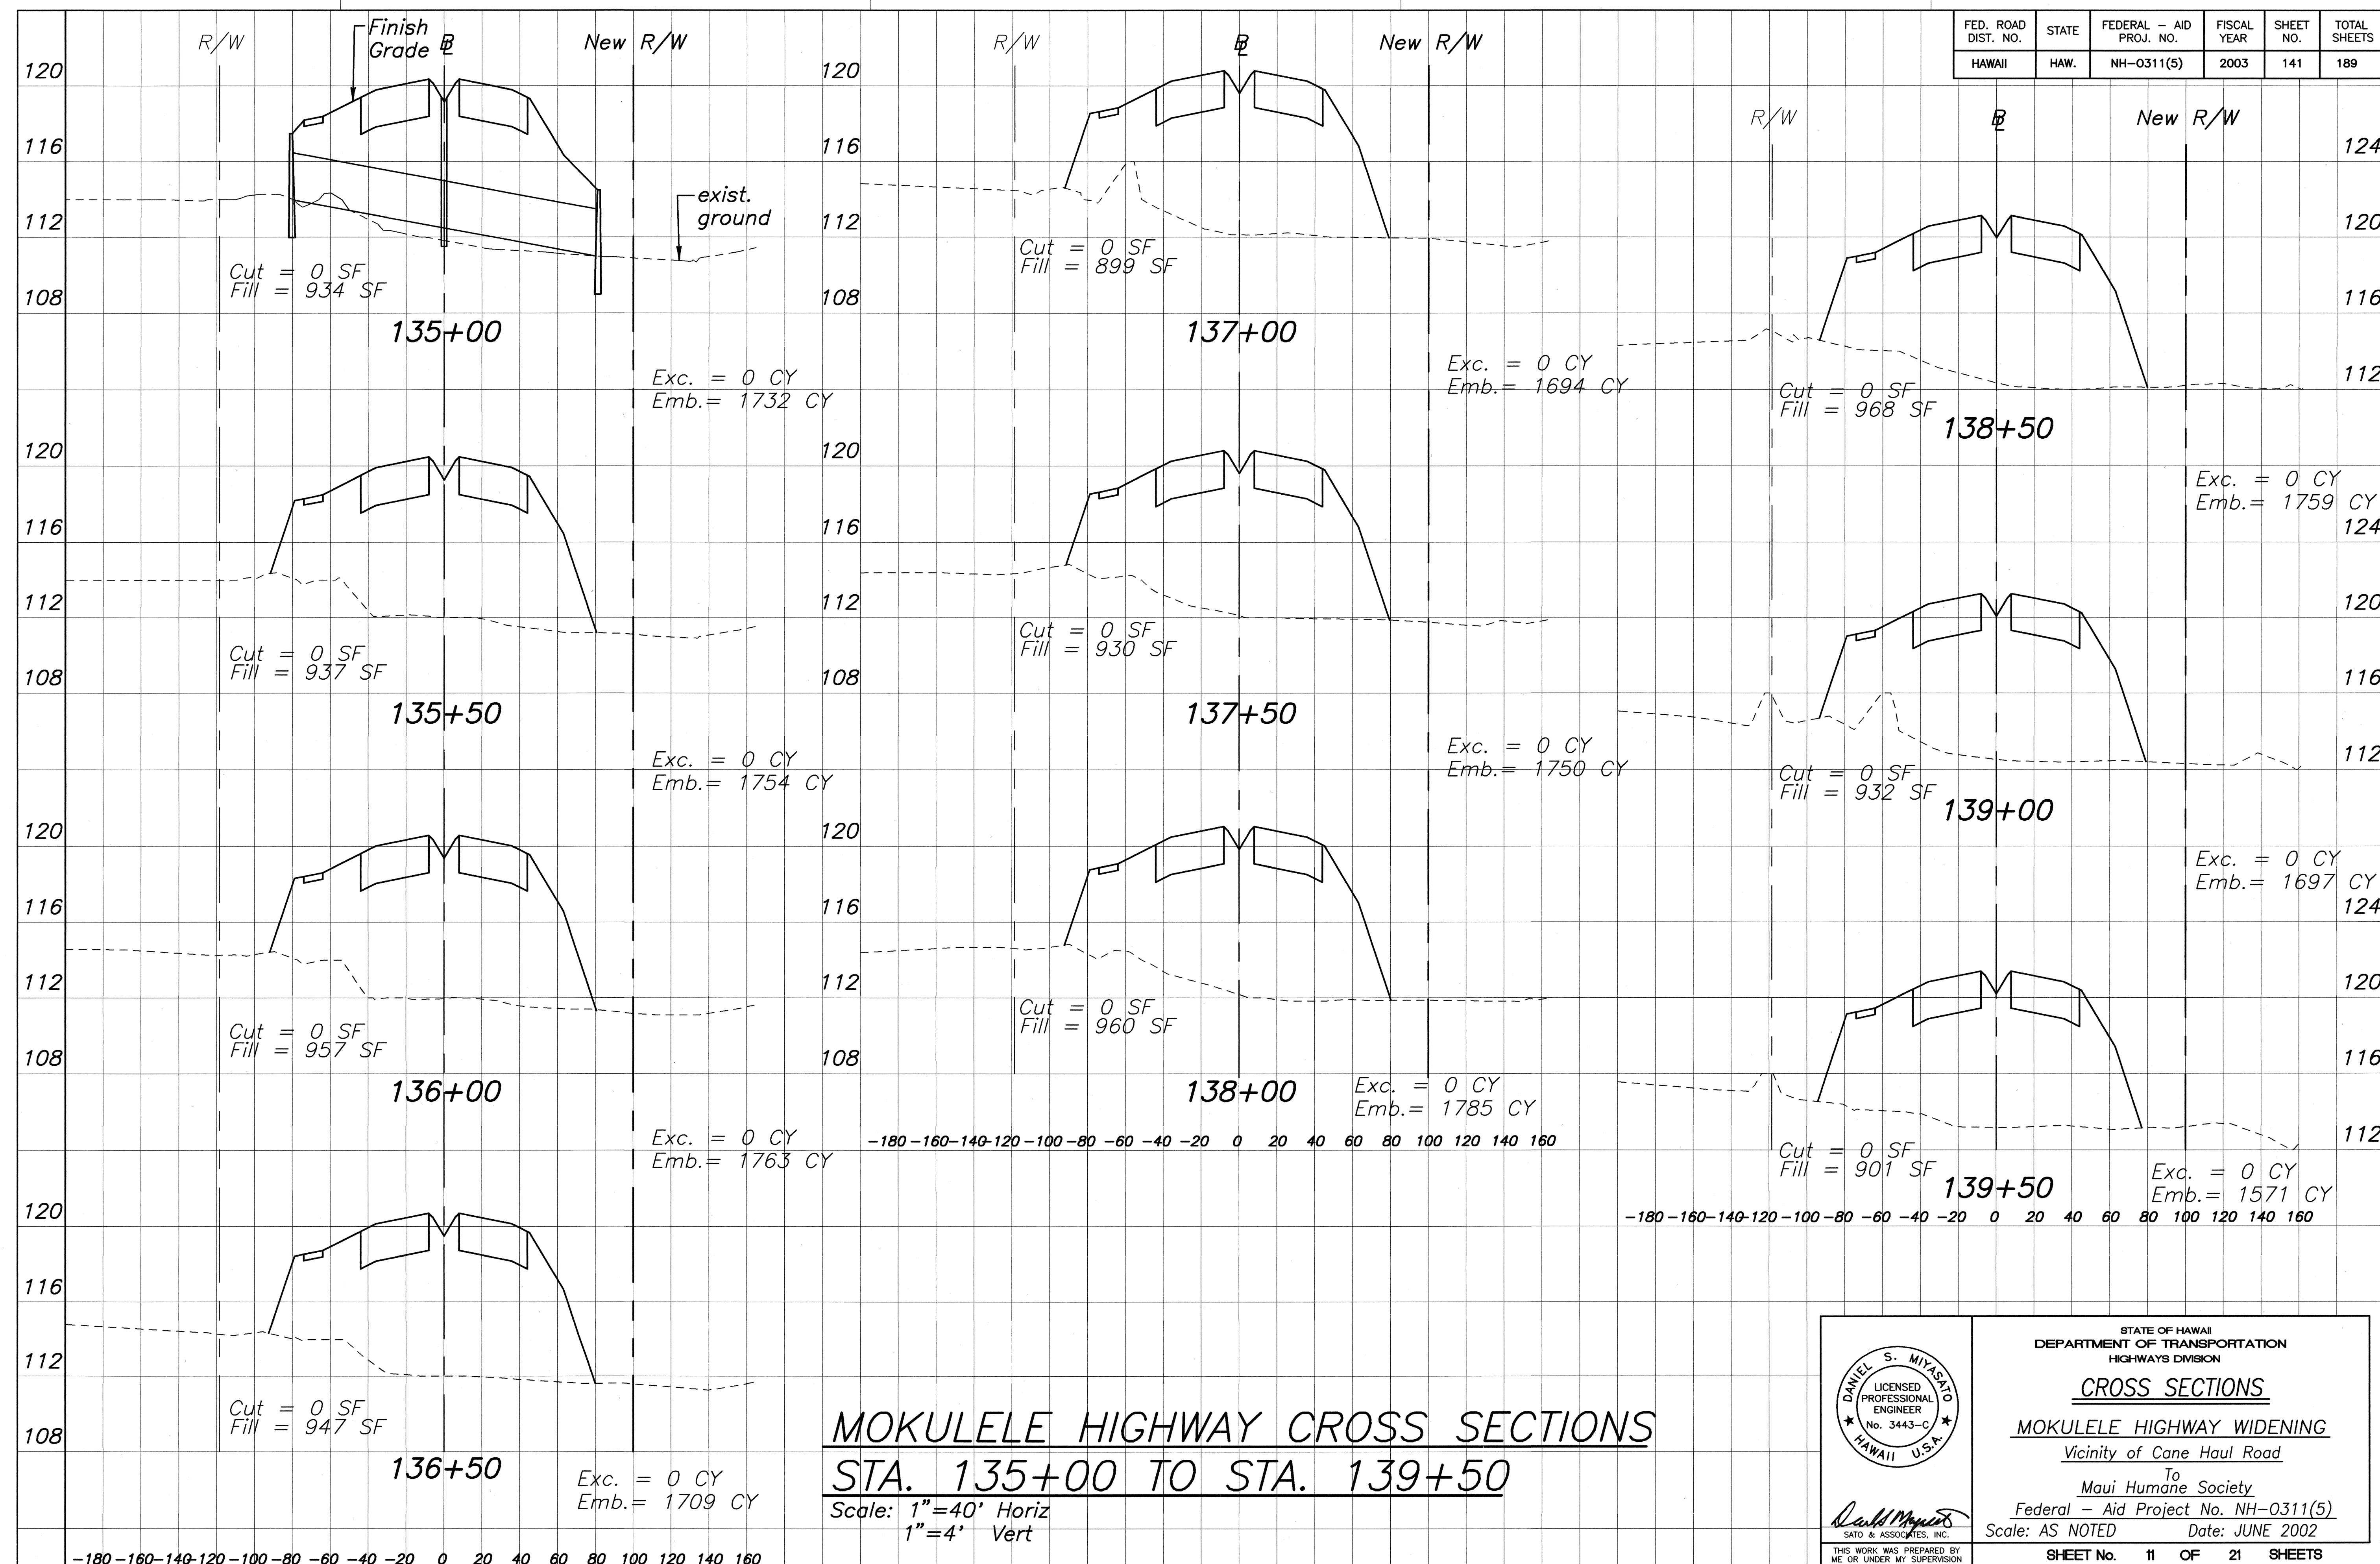

SURVEY PLOTTED BY	DATE
DRAWN BY	
CHECKED BY	
NOTE BOOK	
QUANTITIES BY	
CHECKED BY	

STATE OF HAWAII
DEPARTMENT OF TRANSPORTATION
HIGHWAYS DIVISION

CROSS SECTIONS

MOKULELE HIGHWAY WIDENING

Vicinity of Cane Haul Road

To
Maui Humane Society

Federal - Aid Project No. NH-0311(5)

Scale: AS NOTED Date: JUNE 2002


SHEET No. 11 OF 21 SHEETS

DANIEL S. MIYASATO
LICENSED PROFESSIONAL ENGINEER
No. 3443-C
HAWAII U.S.A.

Daniel Miyasato
SATO & ASSOCIATES, INC.

THIS WORK WAS PREPARED BY
ME OR UNDER MY SUPERVISION

FED. ROAD DIST. NO.	STATE	FEDERAL - AID PROJ. NO.	FISCAL YEAR	SHEET NO.	TOTAL SHEETS
HAWAII	HAW.	NH-0311(5)	2003	142	189

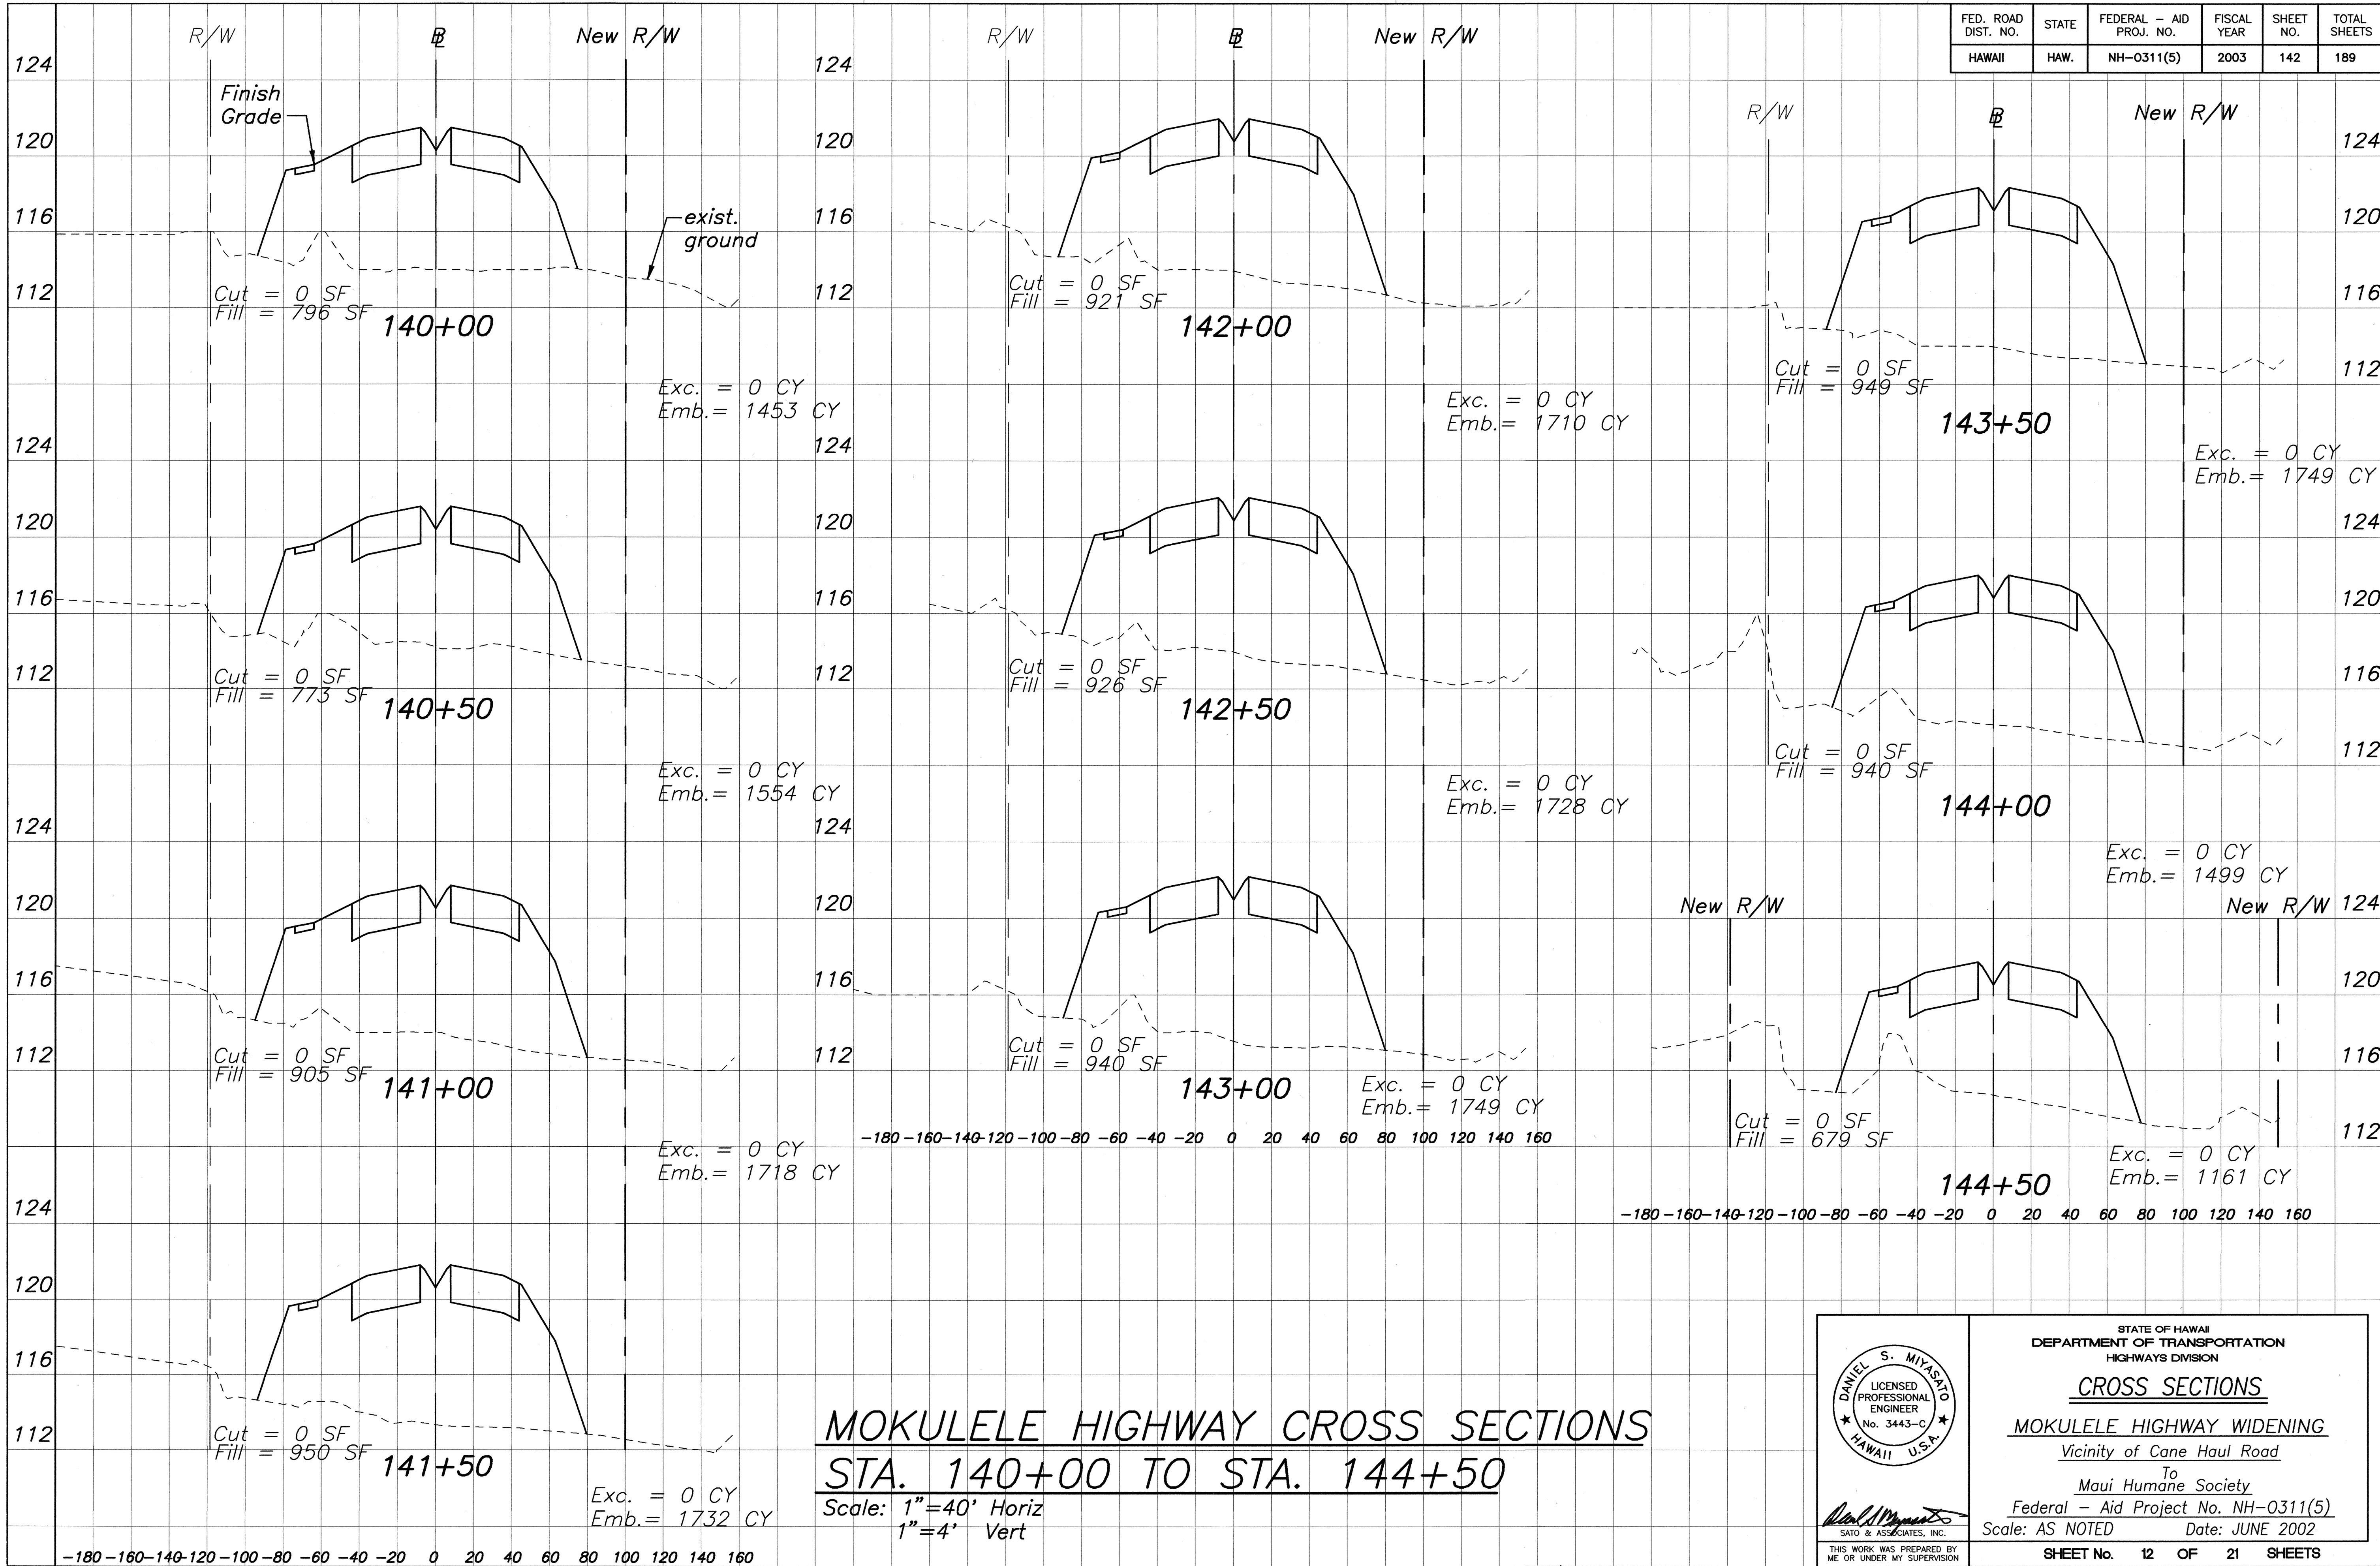

SURVEY PLOTTED BY _____
 DATE _____
 DRAWN BY _____
 TRACED BY _____
 NOTE BOOK _____
 QUANTITIES BY _____
 CHECKED BY _____
 No. _____

STATE OF HAWAII
DEPARTMENT OF TRANSPORTATION
HIGHWAYS DIVISION

CROSS SECTIONS

MOKULELE HIGHWAY WIDENING
Vicinity of Cane Haul Road

To
Maui Humane Society

Federal - Aid Project No. NH-0311(5)

Scale: AS NOTED Date: JUNE 2002

SHEET No. 12 OF 21 SHEETS

STATE OF HAWAII
DEPARTMENT OF TRANSPORTATION
HIGHWAYS DIVISION

CROSS SECTIONS

MOKULELE HIGHWAY WIDENING
Vicinity of Cane Haul Road


To
Maui Humane Society

Federal - Aid Project No. NH-0311(5)

Scale: AS NOTED Date: JUNE 2002

SHEET No. 12 OF 21 SHEETS

FED. ROAD DIST. NO.	STATE	FEDERAL - AID PROJ. NO.	FISCAL YEAR	SHEET NO.	TOTAL SHEETS
HAWAII	HAW.	NH-0311(5)	2003	143	189

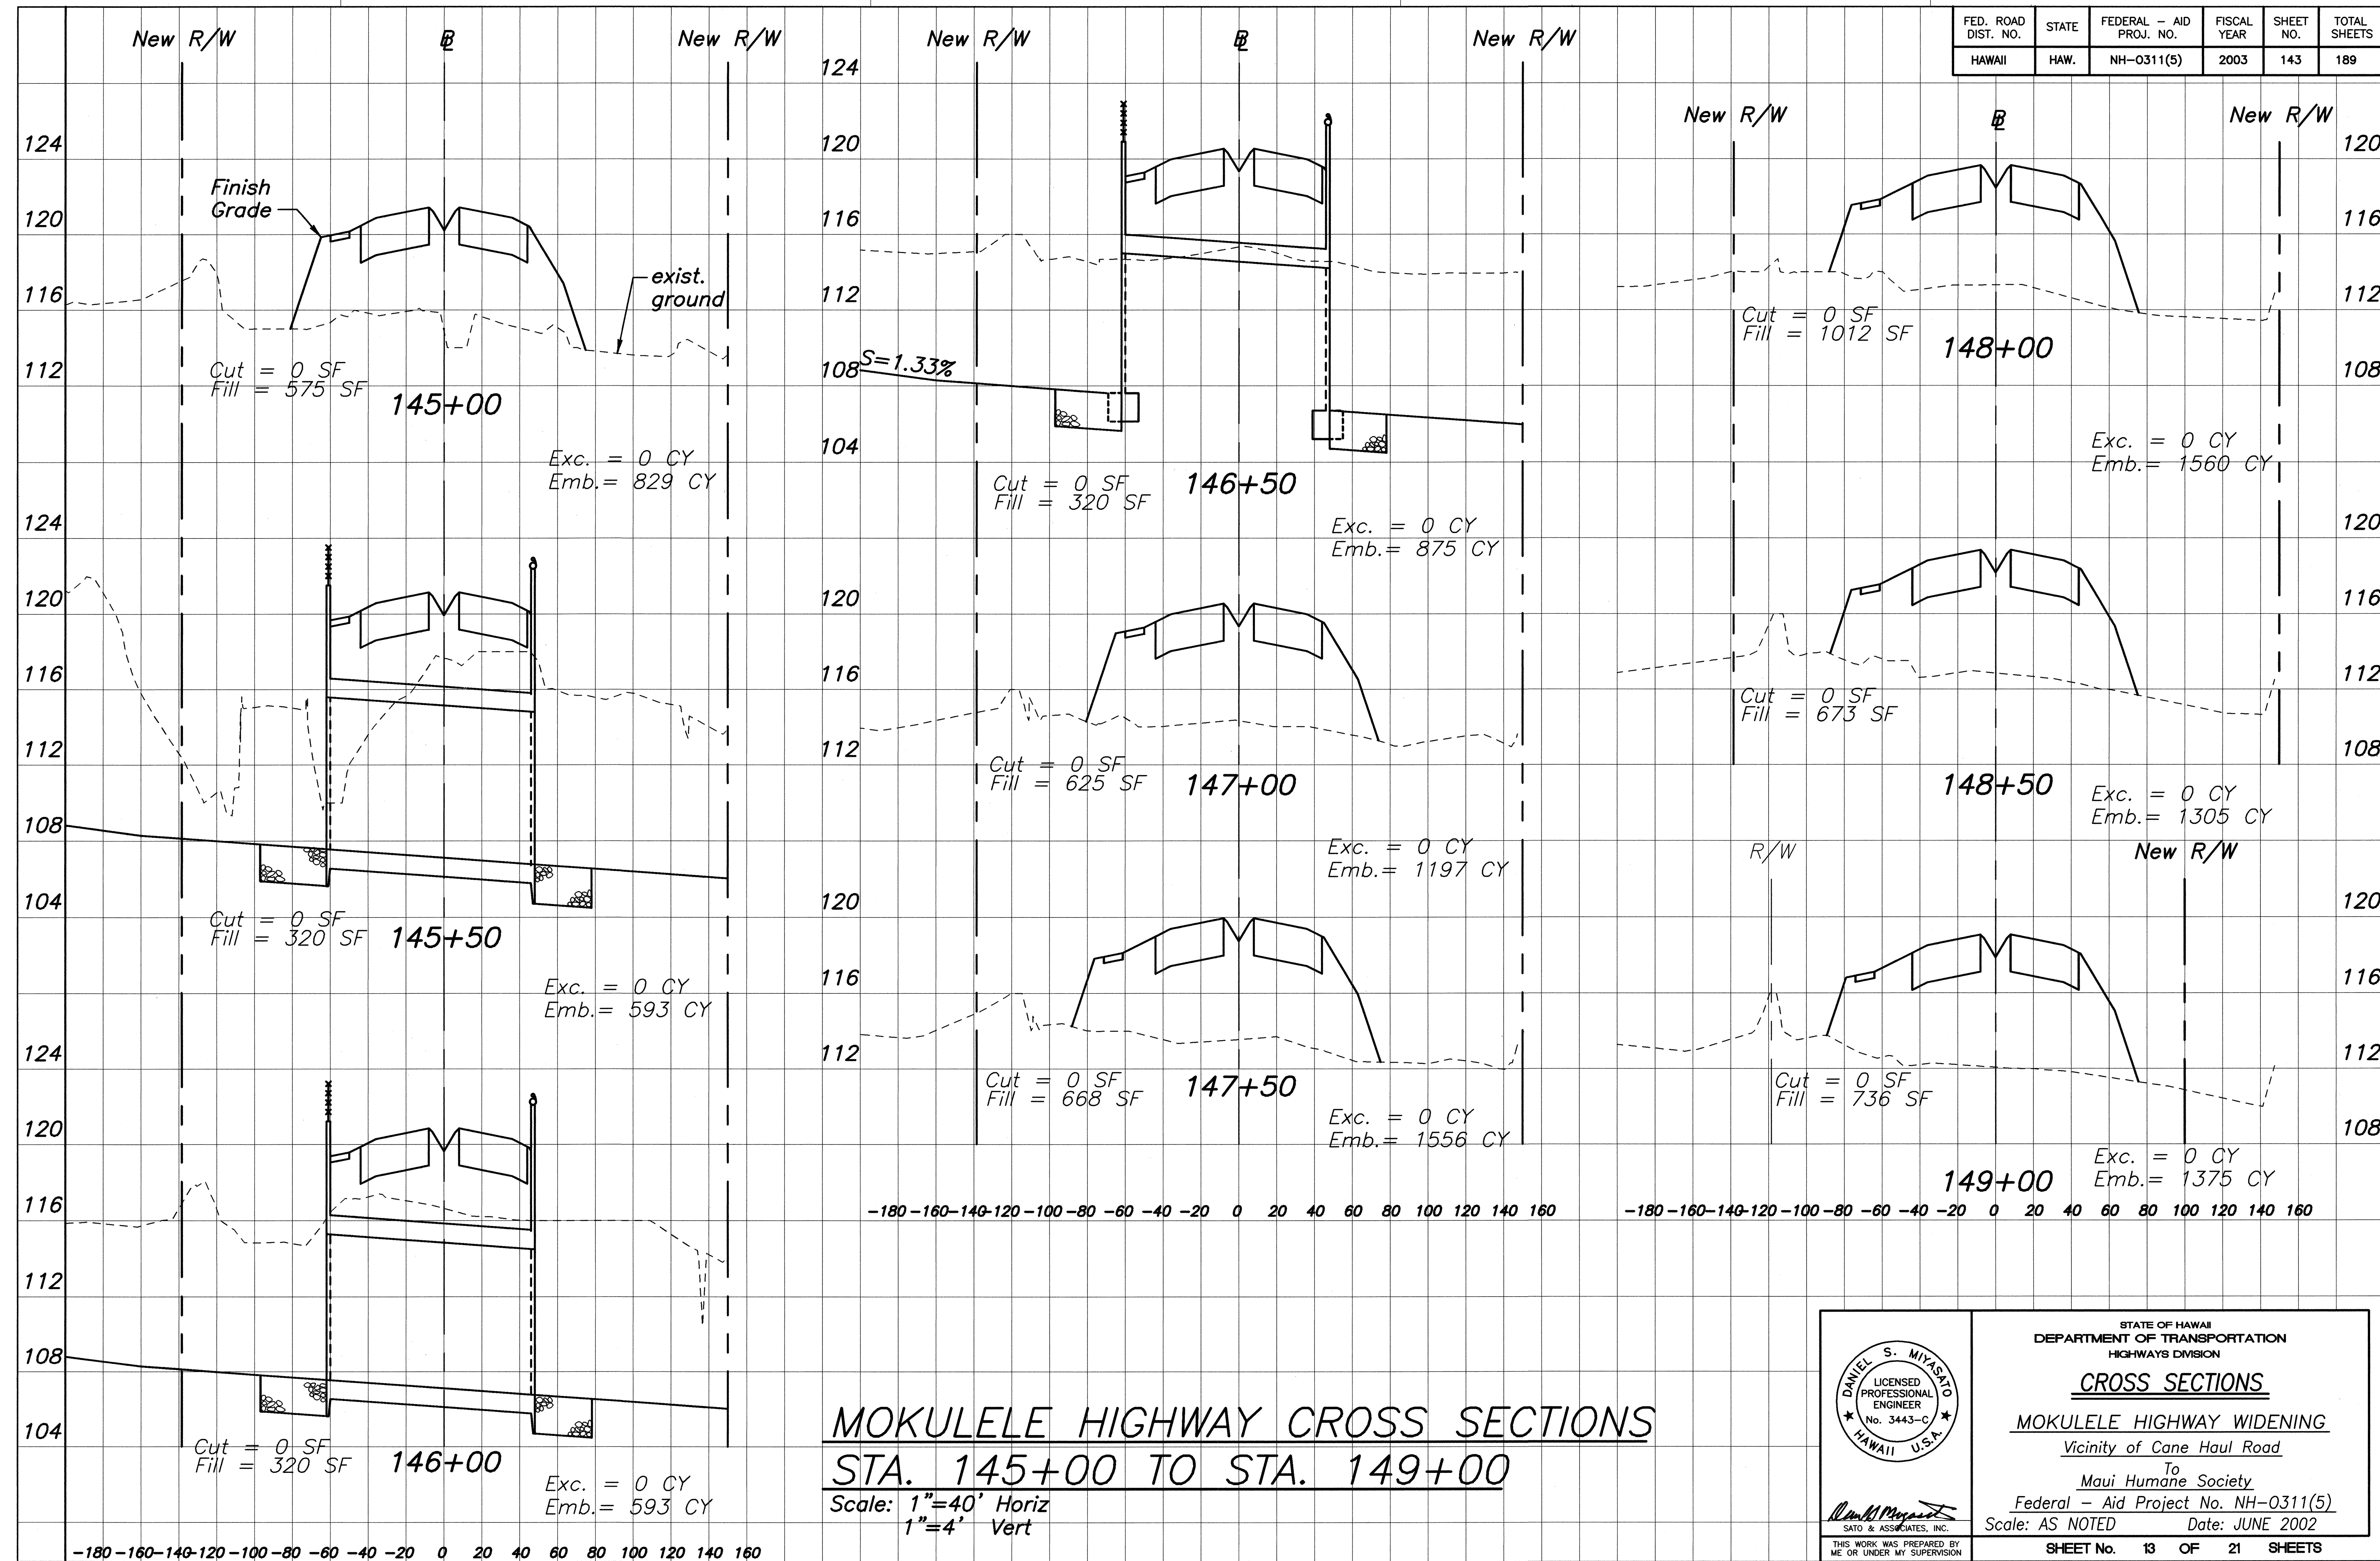

STATE OF HAWAII
DEPARTMENT OF TRANSPORTATION
HIGHWAYS DIVISION

CROSS SECTIONS

MOKULELE HIGHWAY WIDENING
 Vicinity of Cane Haul Road

To
Maui Humane Society
 Federal - Aid Project No. NH-0311(5)

Scale: AS NOTED Date: JUNE 2002


SHEET No. 13 OF 21 SHEETS

DANIEL S. MIYASATO
 LICENSED PROFESSIONAL ENGINEER
 No. 3443-C
 HAWAII U.S.A.

Daniel Miyasato
 SATO & ASSOCIATES, INC.

THIS WORK WAS PREPARED BY ME OR UNDER MY SUPERVISION

FED. ROAD DIST. NO.	STATE	FEDERAL - AID PROJ. NO.	FISCAL YEAR	SHEET NO.	TOTAL SHEETS
HAWAII	HAW.	NH-0311(5)	2003	144	189

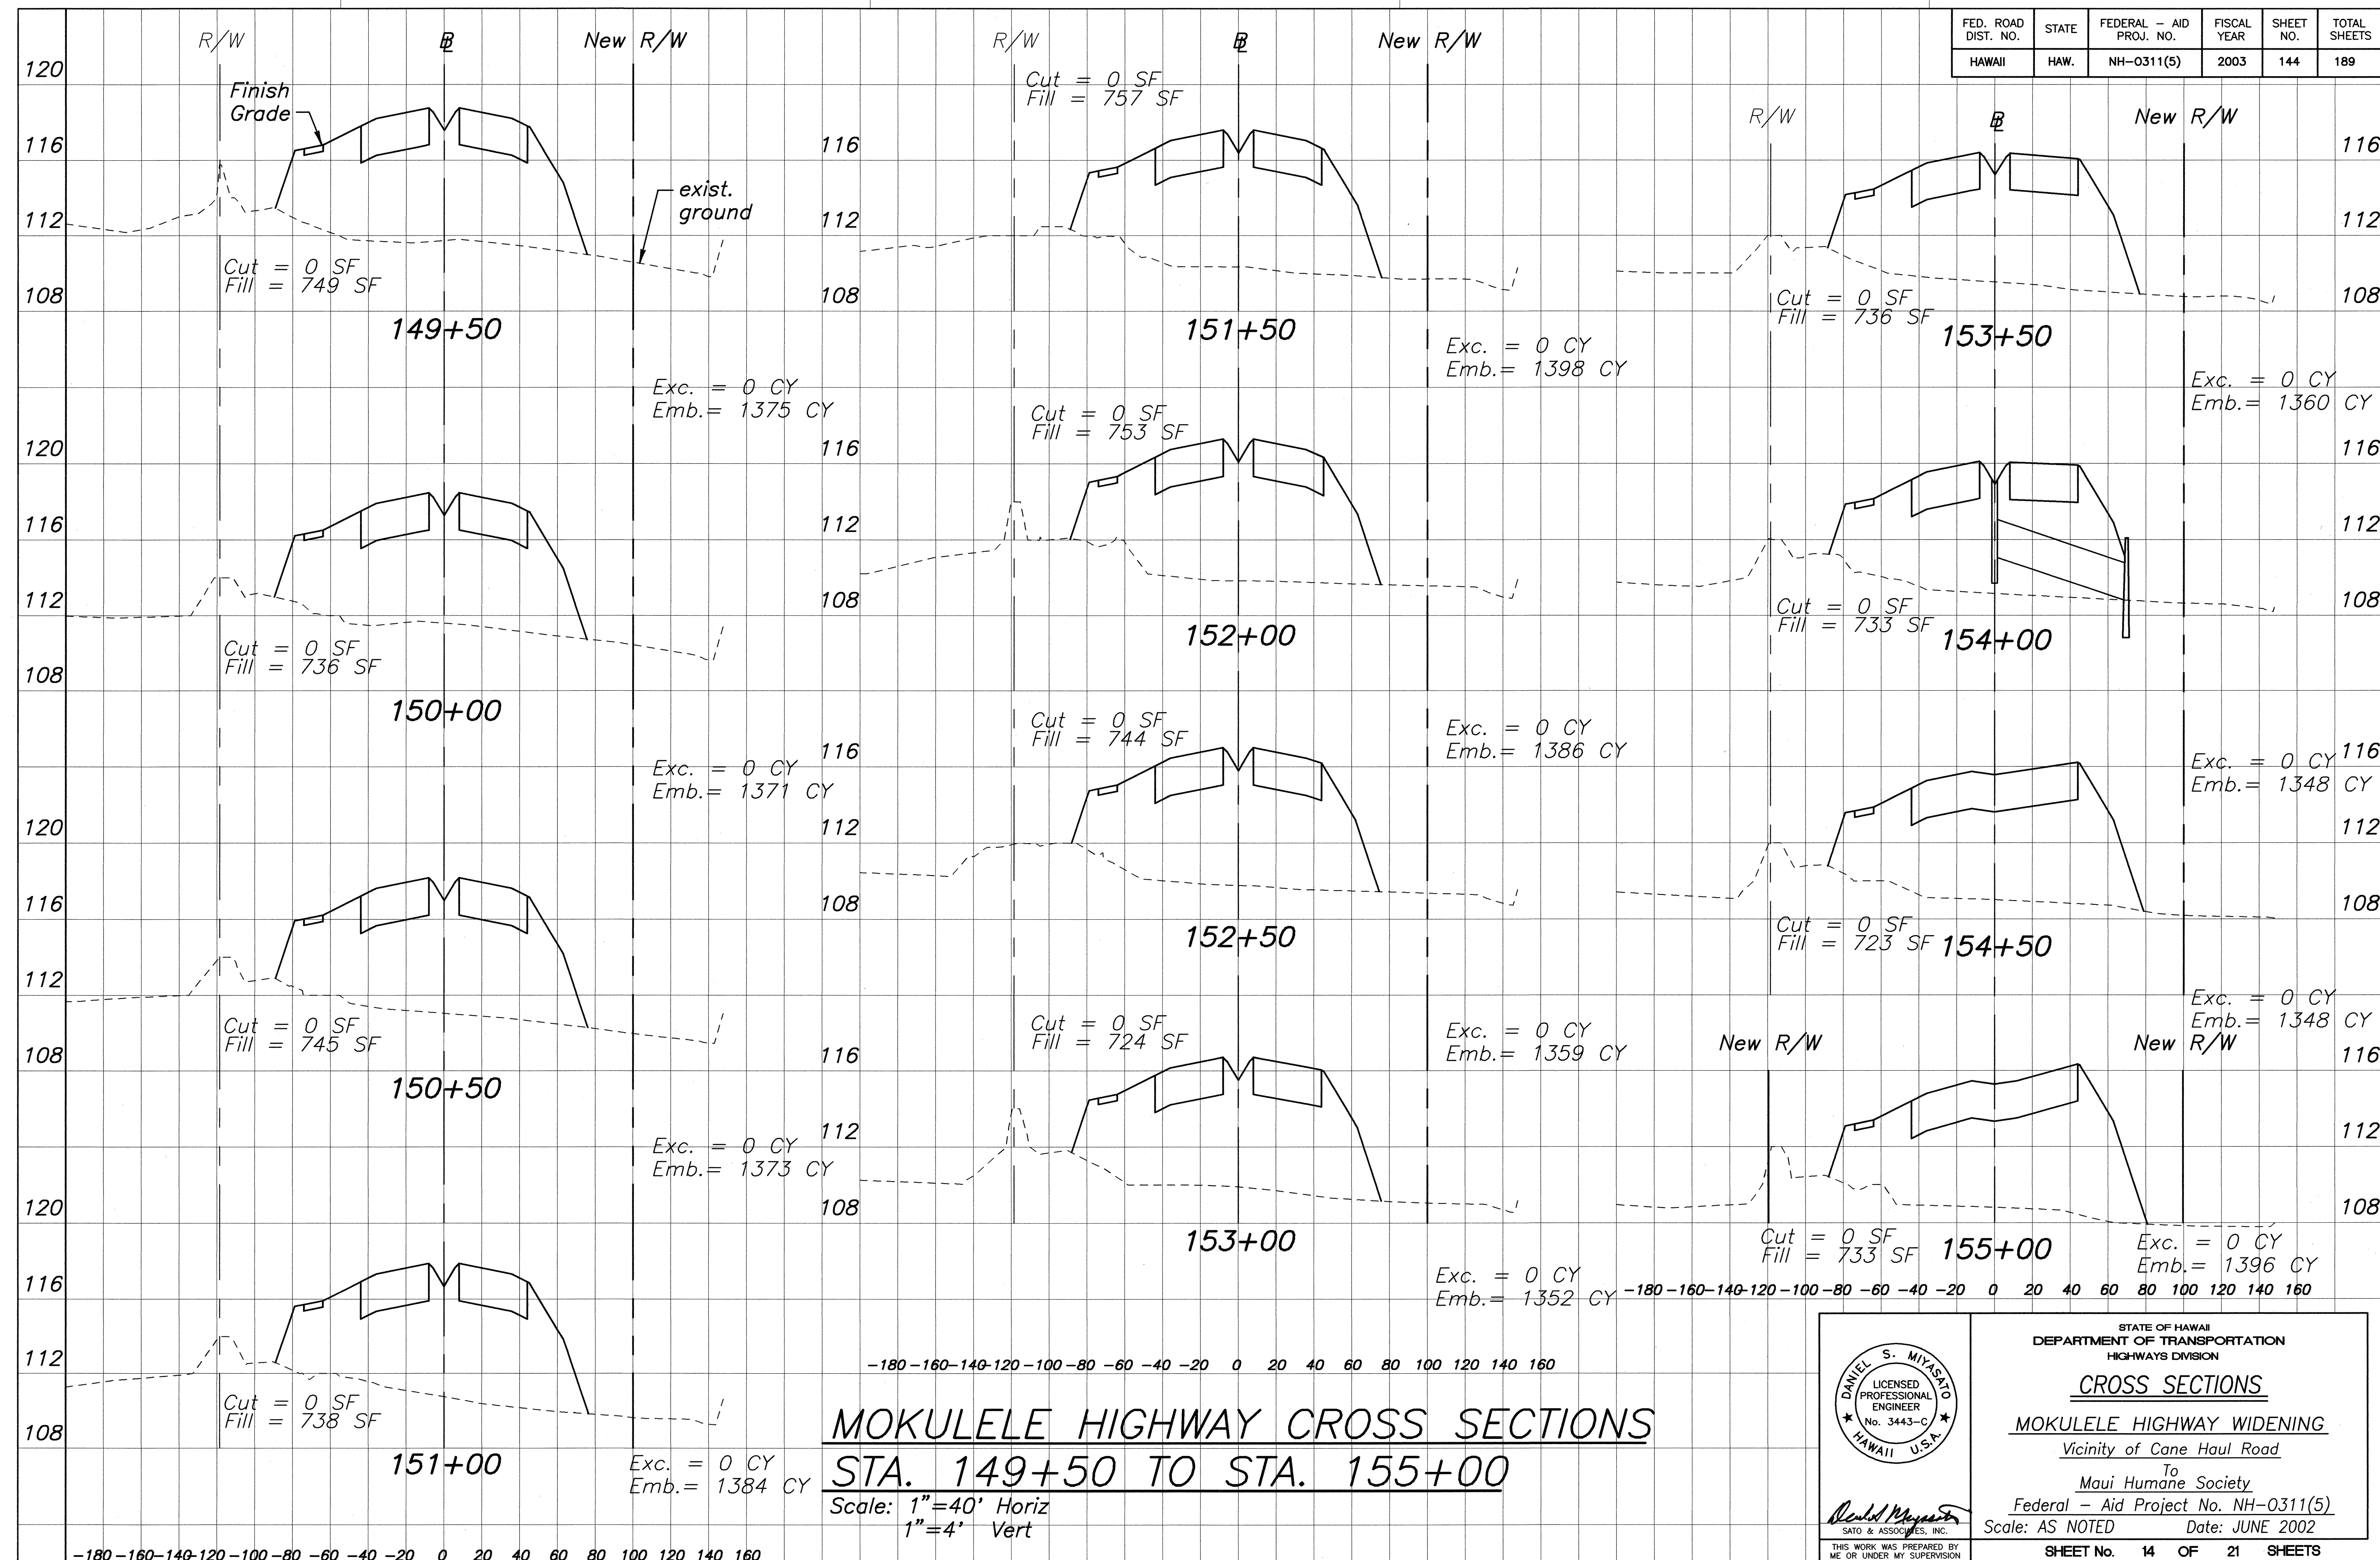

STATE OF HAWAII
DEPARTMENT OF TRANSPORTATION
HIGHWAYS DIVISION

CROSS SECTIONS

MOKULELE HIGHWAY WIDENING

Vicinity of Cane Haul Road

To
Maui Humane Society


Federal - Aid Project No. NH-0311(5)

Scale: AS NOTED Date: JUNE 2002

THIS WORK WAS PREPARED BY
ME OR UNDER MY SUPERVISION

SHEET No. 14 OF 21 SHEETS

FED. ROAD DIST. NO.	STATE	FEDERAL - AID PROJ. NO.	FISCAL YEAR	SHEET NO.	TOTAL SHEETS
HAWAII	HAW.	NH-0311(5)	2003	145	189

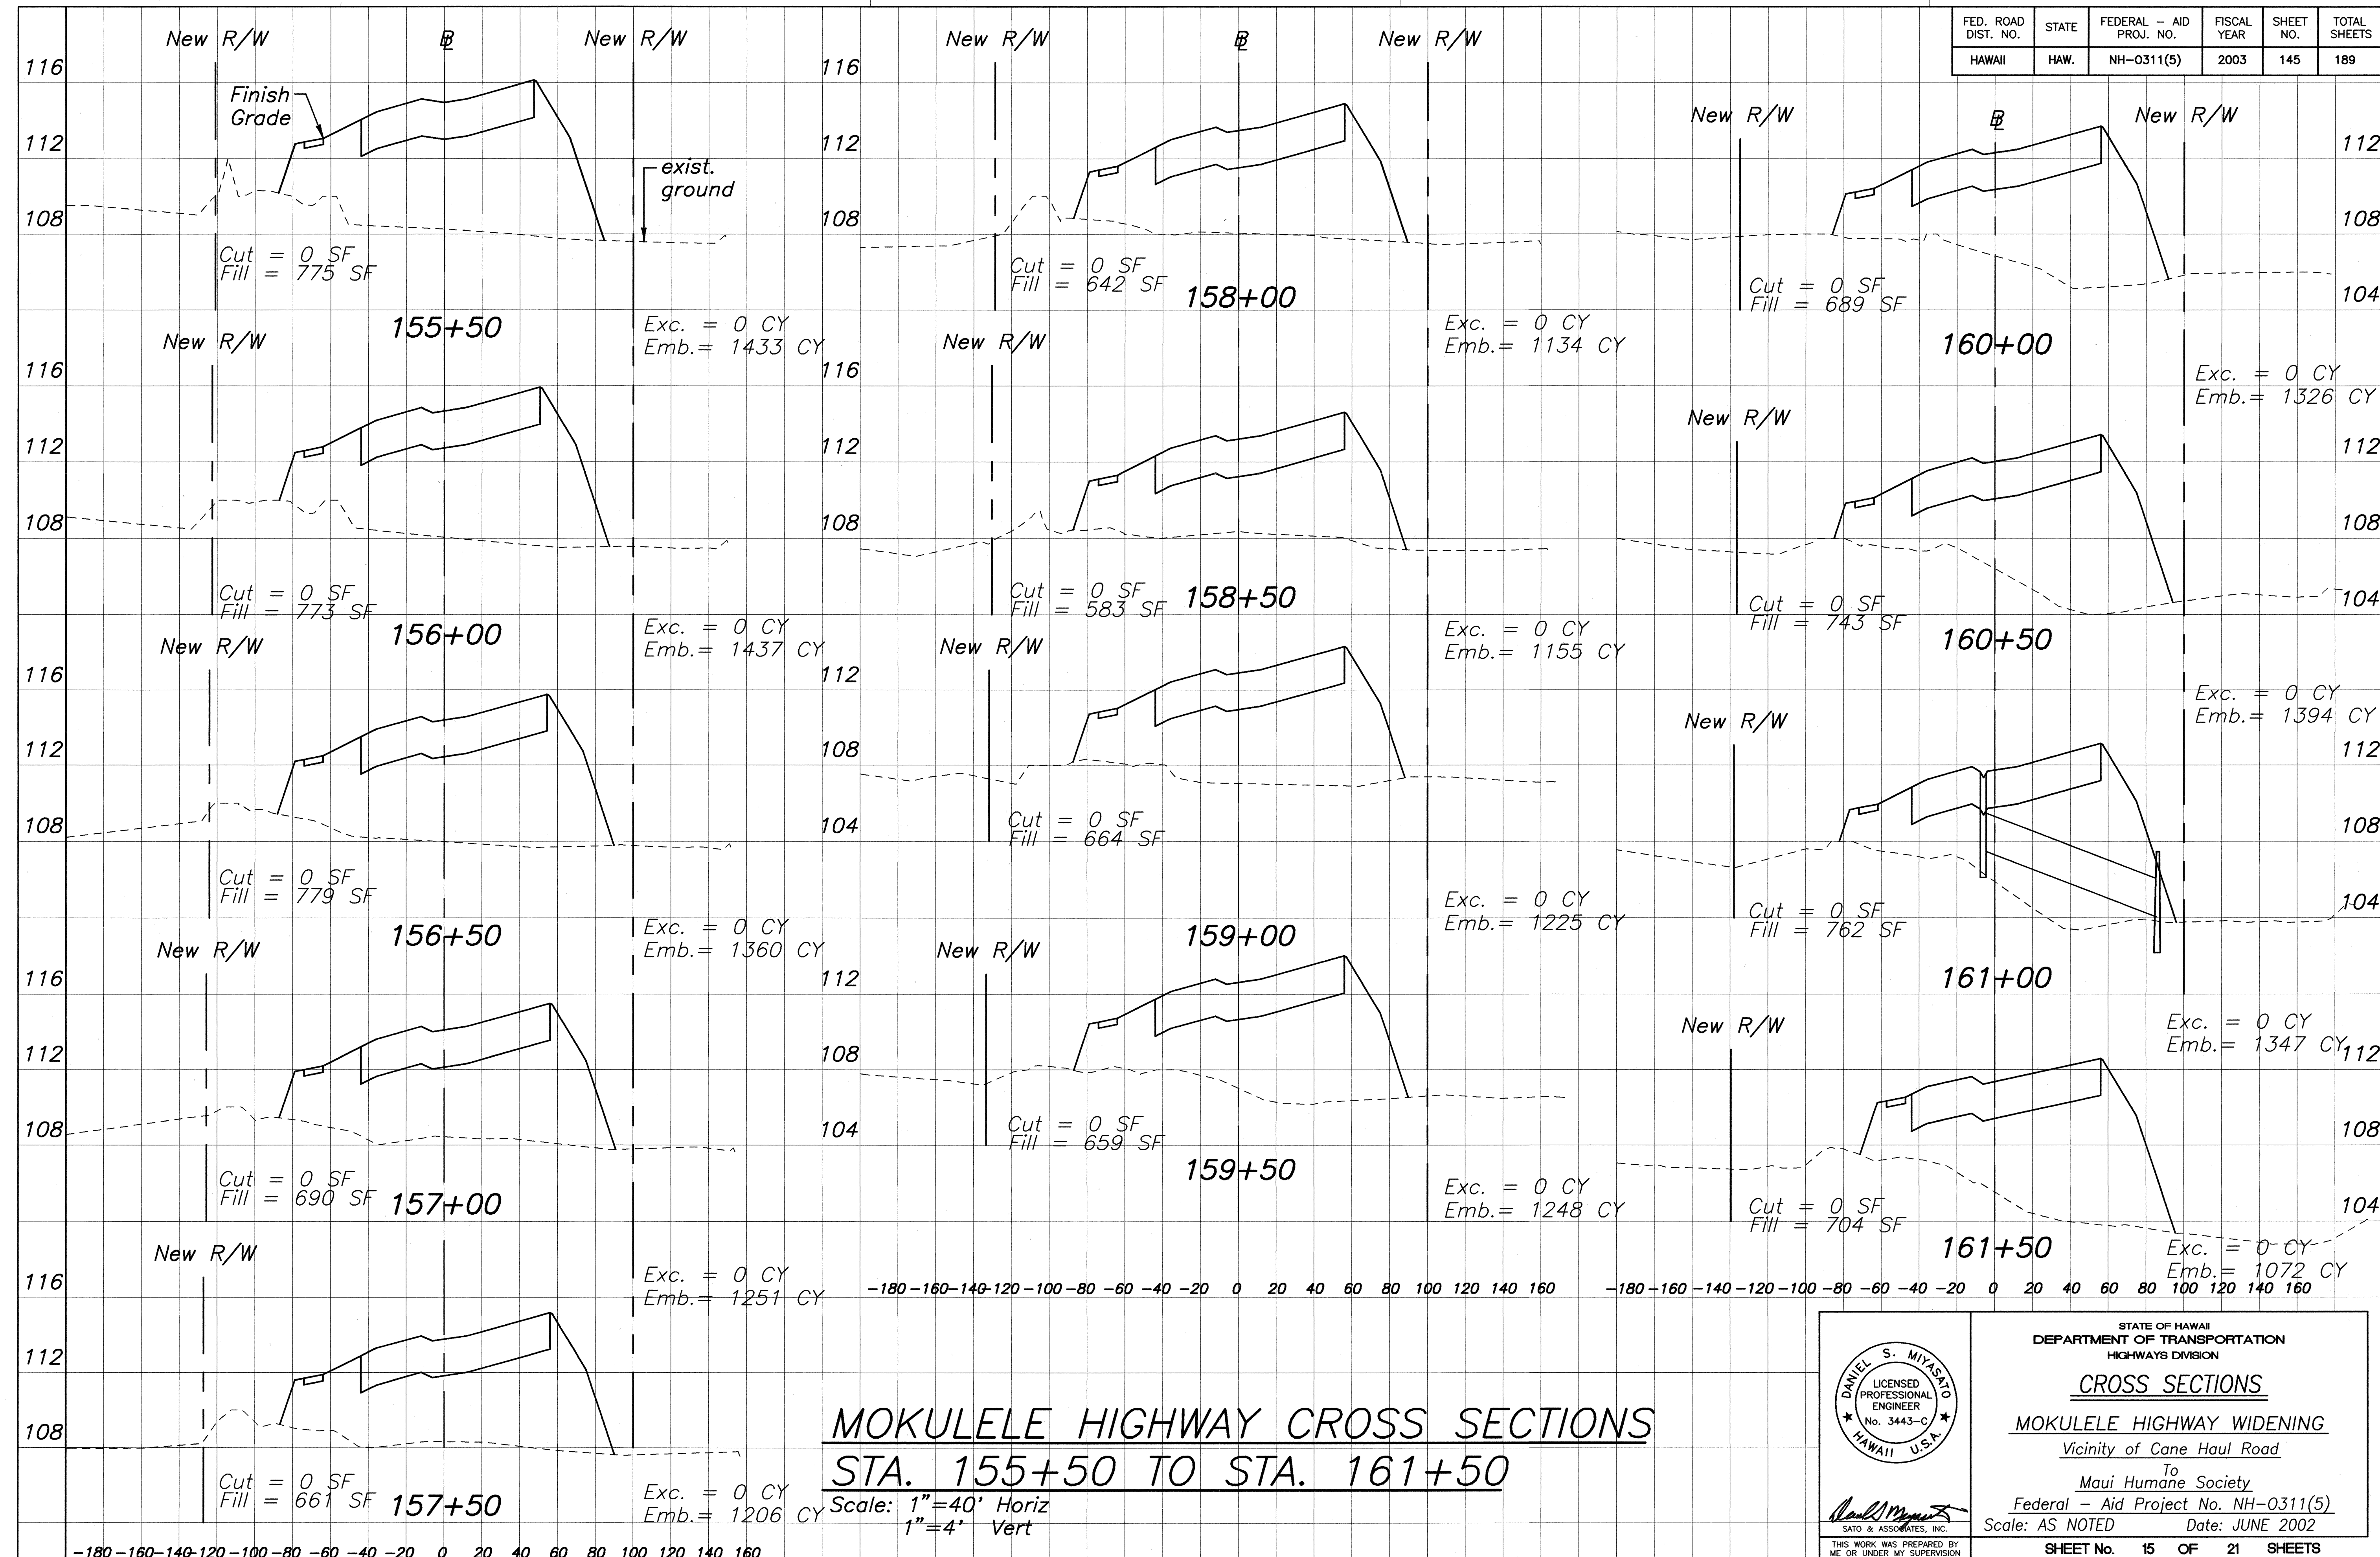

MOKULELE HIGHWAY CROSS SECTIONS STA. 155+50 TO STA. 161+50


DANIEL S. MIYASATO
LICENSED PROFESSIONAL ENGINEER
No. 3443-C
HAWAII, U.S.A.

STATE OF HAWAII
DEPARTMENT OF TRANSPORTATION
HIGHWAYS DIVISION

CROSS SECTIONS
MOKULELE HIGHWAY WIDENING
Vicinity of Cane Haul Road
To
Maui Humane Society
Federal - Aid Project No. NH-0311(5)
Scale: AS NOTED Date: JUNE 2002

SHEET No. 15 OF 21 SHEETS

ORIGINAL PLAN	SURVEY PLOTTED BY	DATE
	DRAWN BY	
	TRACED BY	
	NOTED BY	
NOTE BOOK QUANTITIES BY	CHECKED BY	

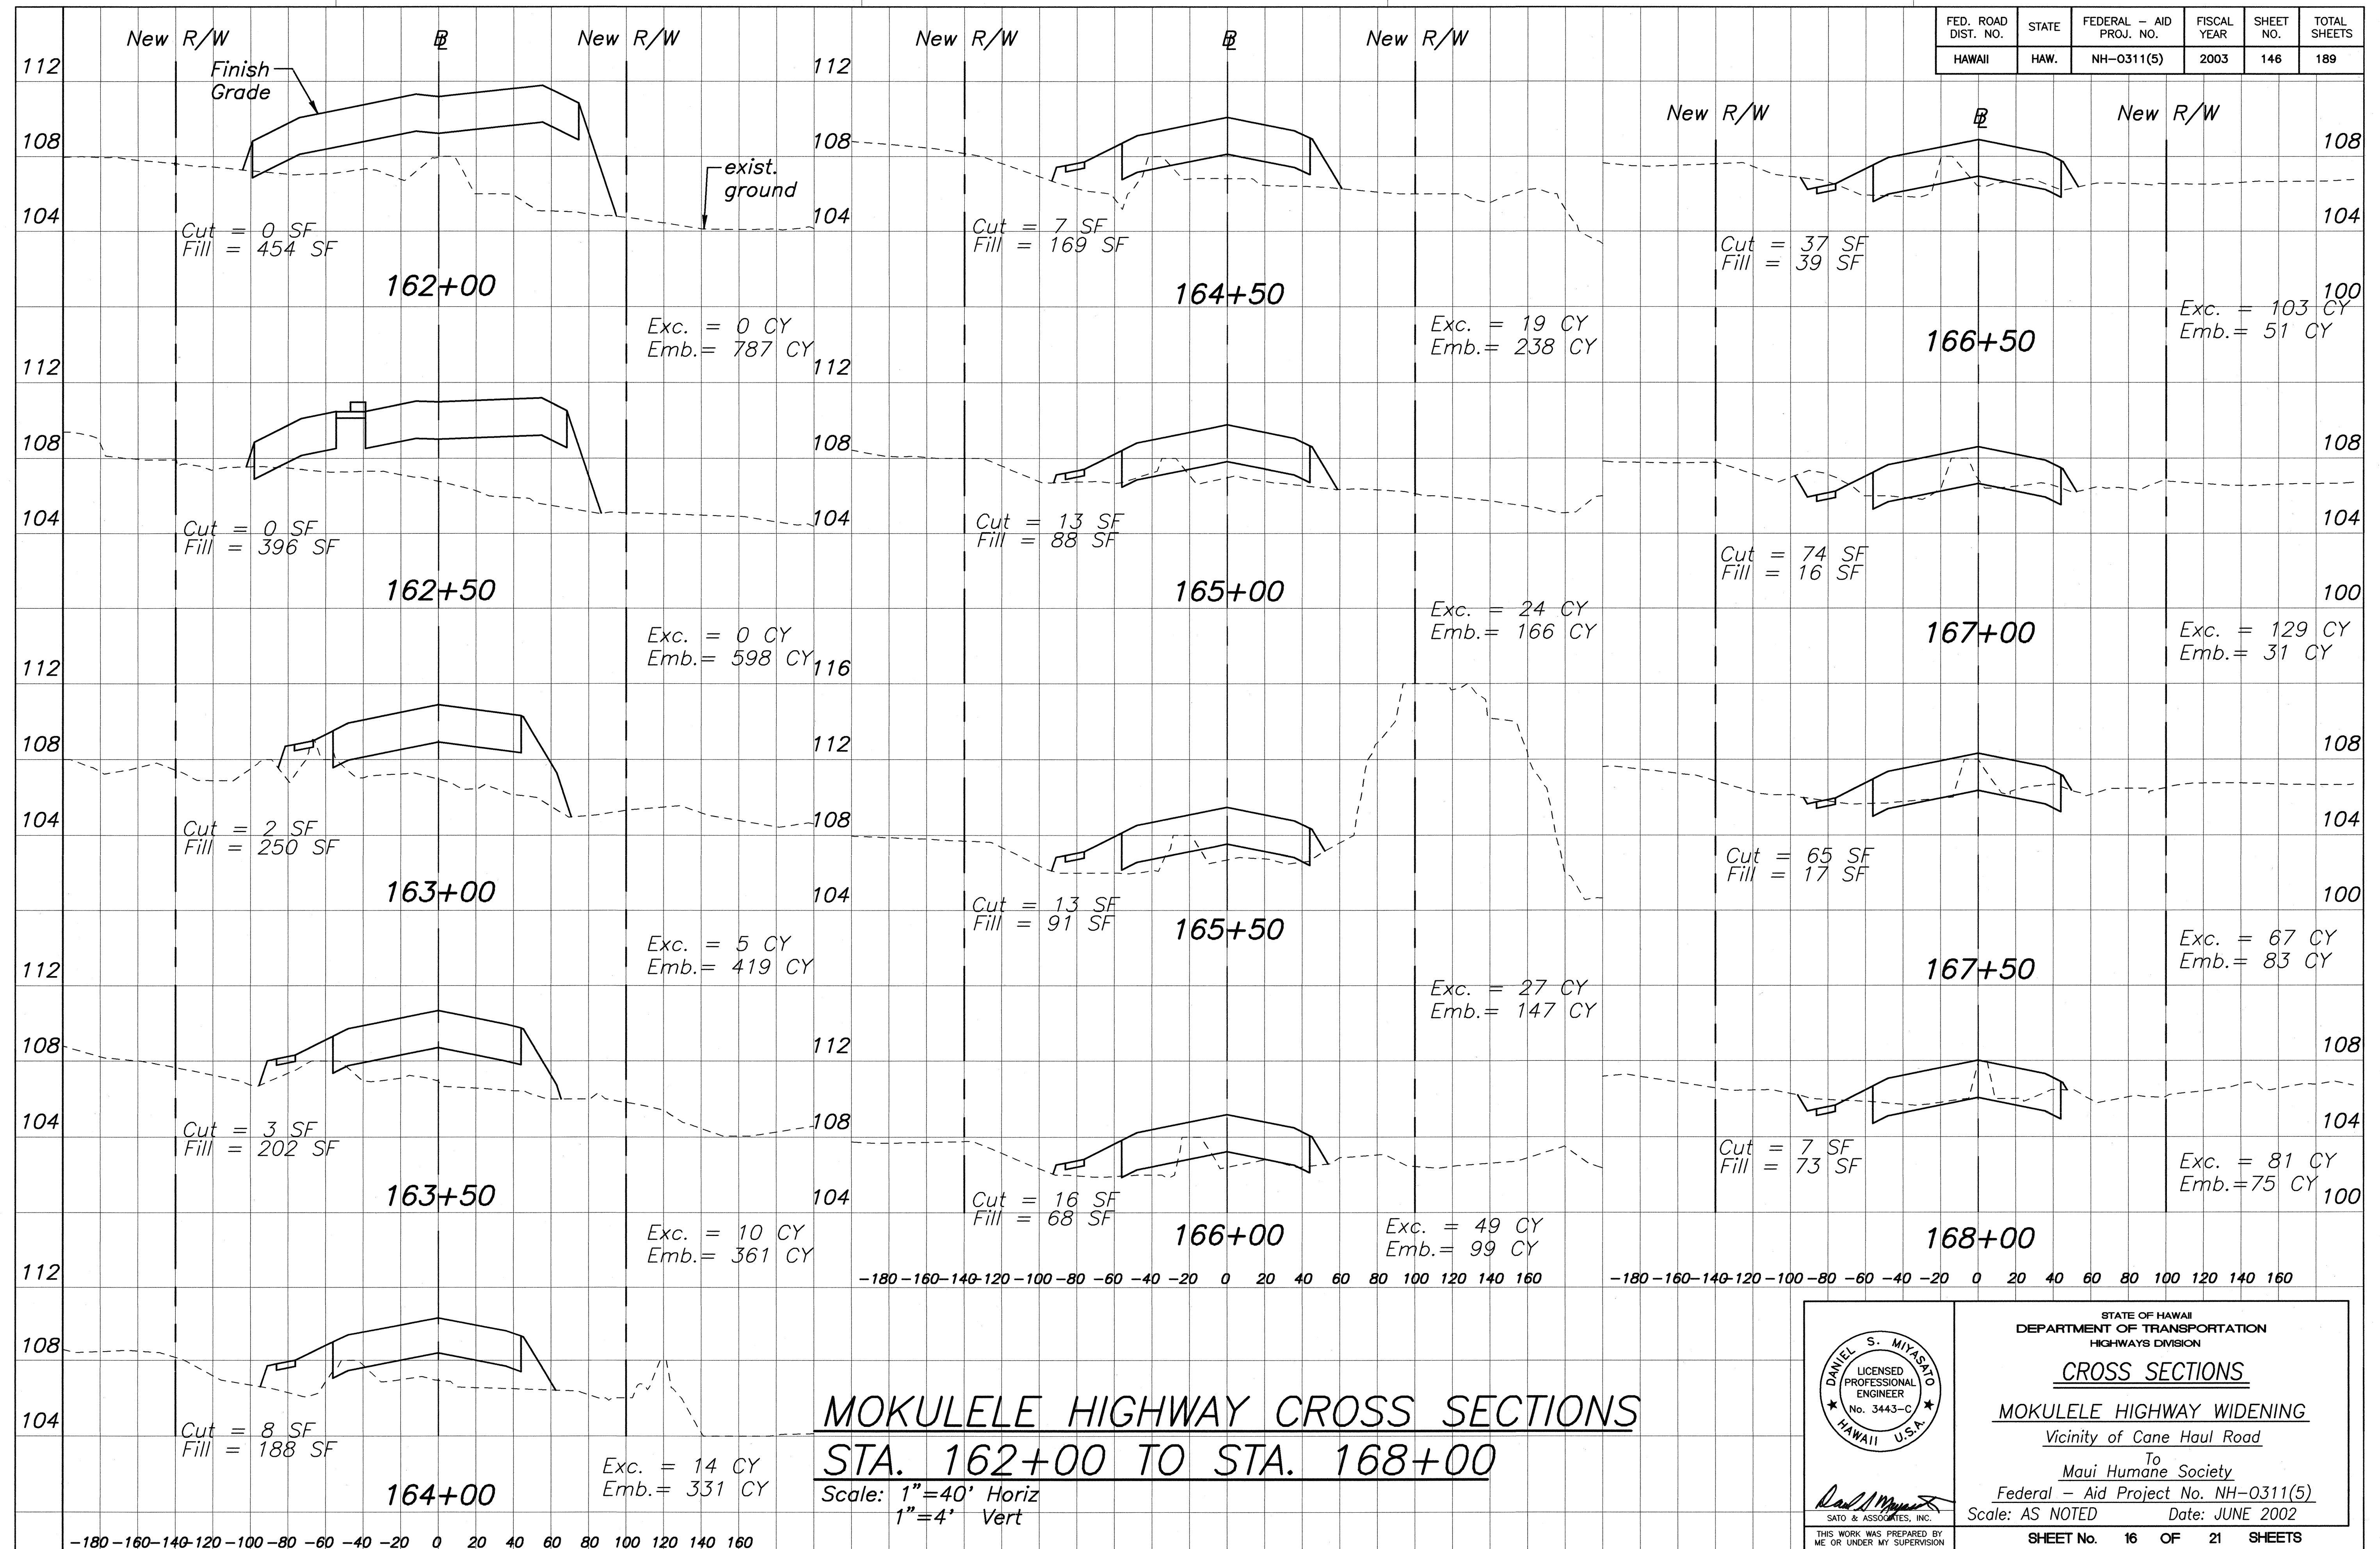


STATE OF HAWAII
 DEPARTMENT OF TRANSPORTATION
 HIGHWAYS DIVISION

CROSS SECTIONS
MOKULELE HIGHWAY WIDENING
 Vicinity of Cane Haul Road
 To
 Maui Humane Society
 Federal - Aid Project No. NH-0311(5)
 Scale: AS NOTED Date: JUNE 2002

SHEET No. 16 OF 21 SHEETS


THIS WORK WAS PREPARED BY
 ME OR UNDER MY SUPERVISION

ORIGINAL PLAN	SURVEY PLOTTED BY	DATE
	DRAWN BY	
	TRACED BY	
	NOTE BOOK QUANTITIES BY CHECKED BY	
No.		

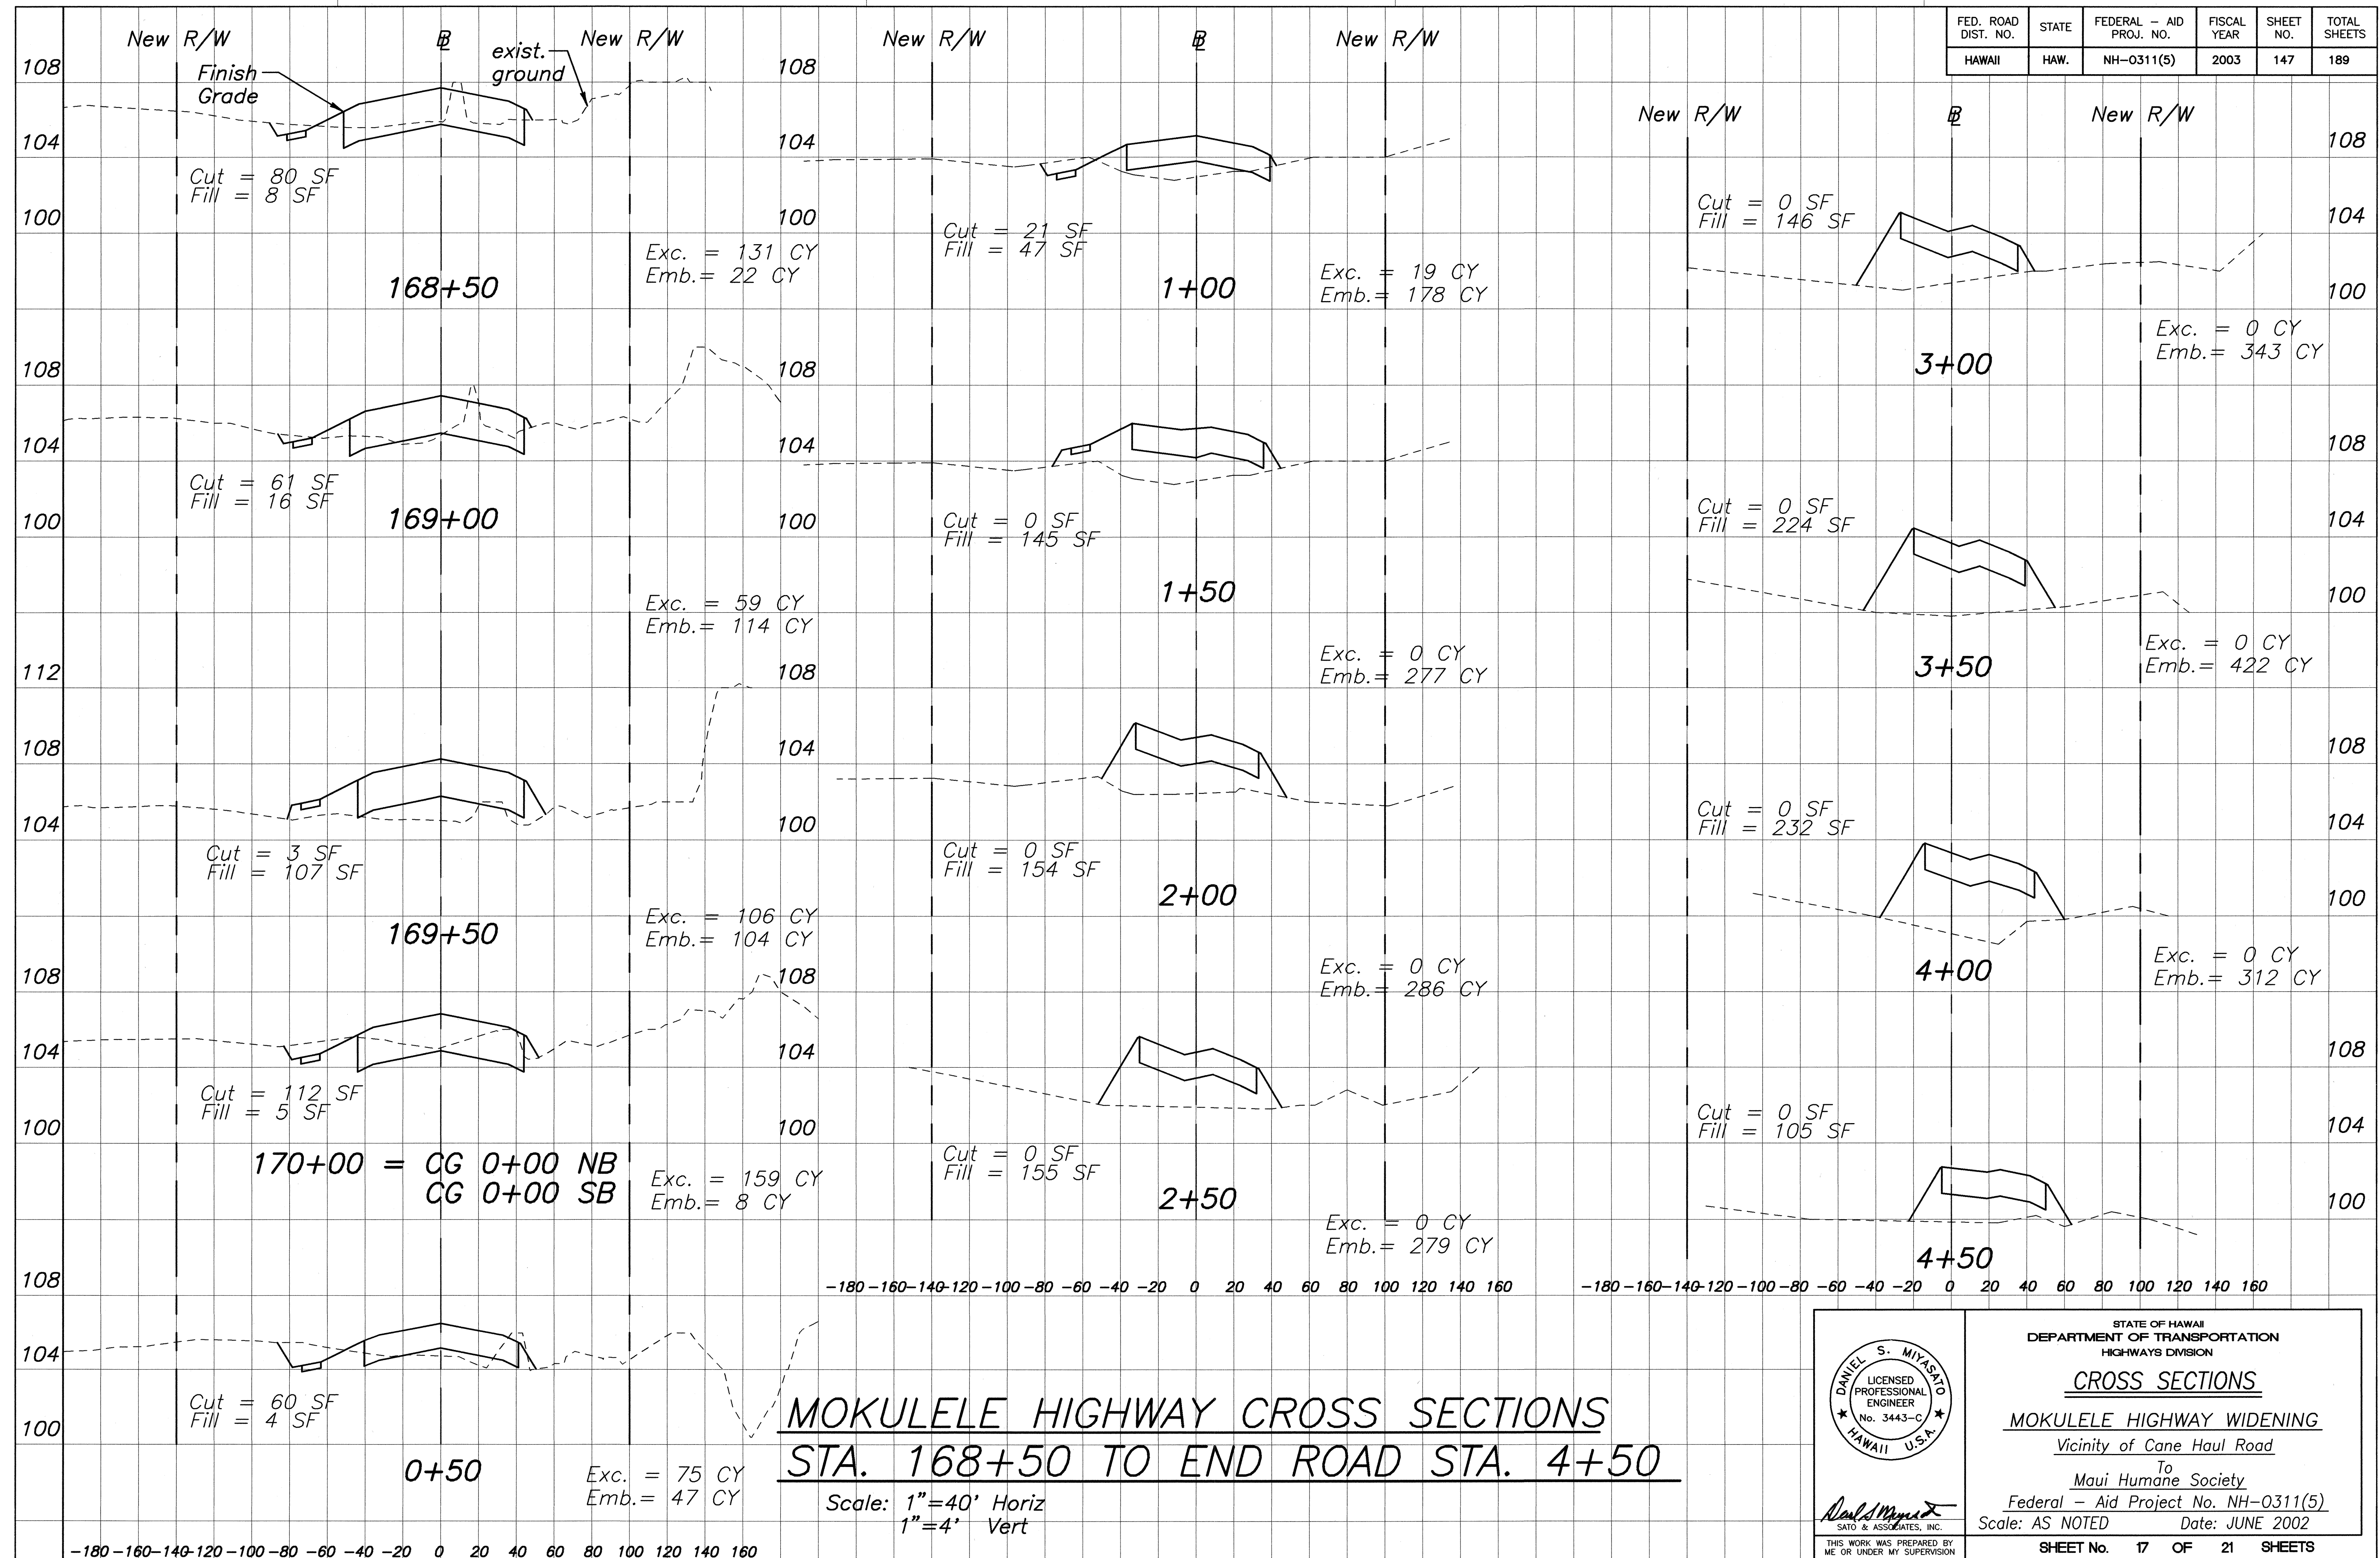


PROJ. NO.: M3901.00
3/9/02
R:\moku\p2\X-SECT2.dwg

ORIGINAL PLAN	SURVEY PLOTTED BY	DATE
	DRAWN BY	
	RECHECKED BY	
	NOTED BY	
NOTE BOOK	QUANTITIES BY	
	CHECKED BY	
No.		

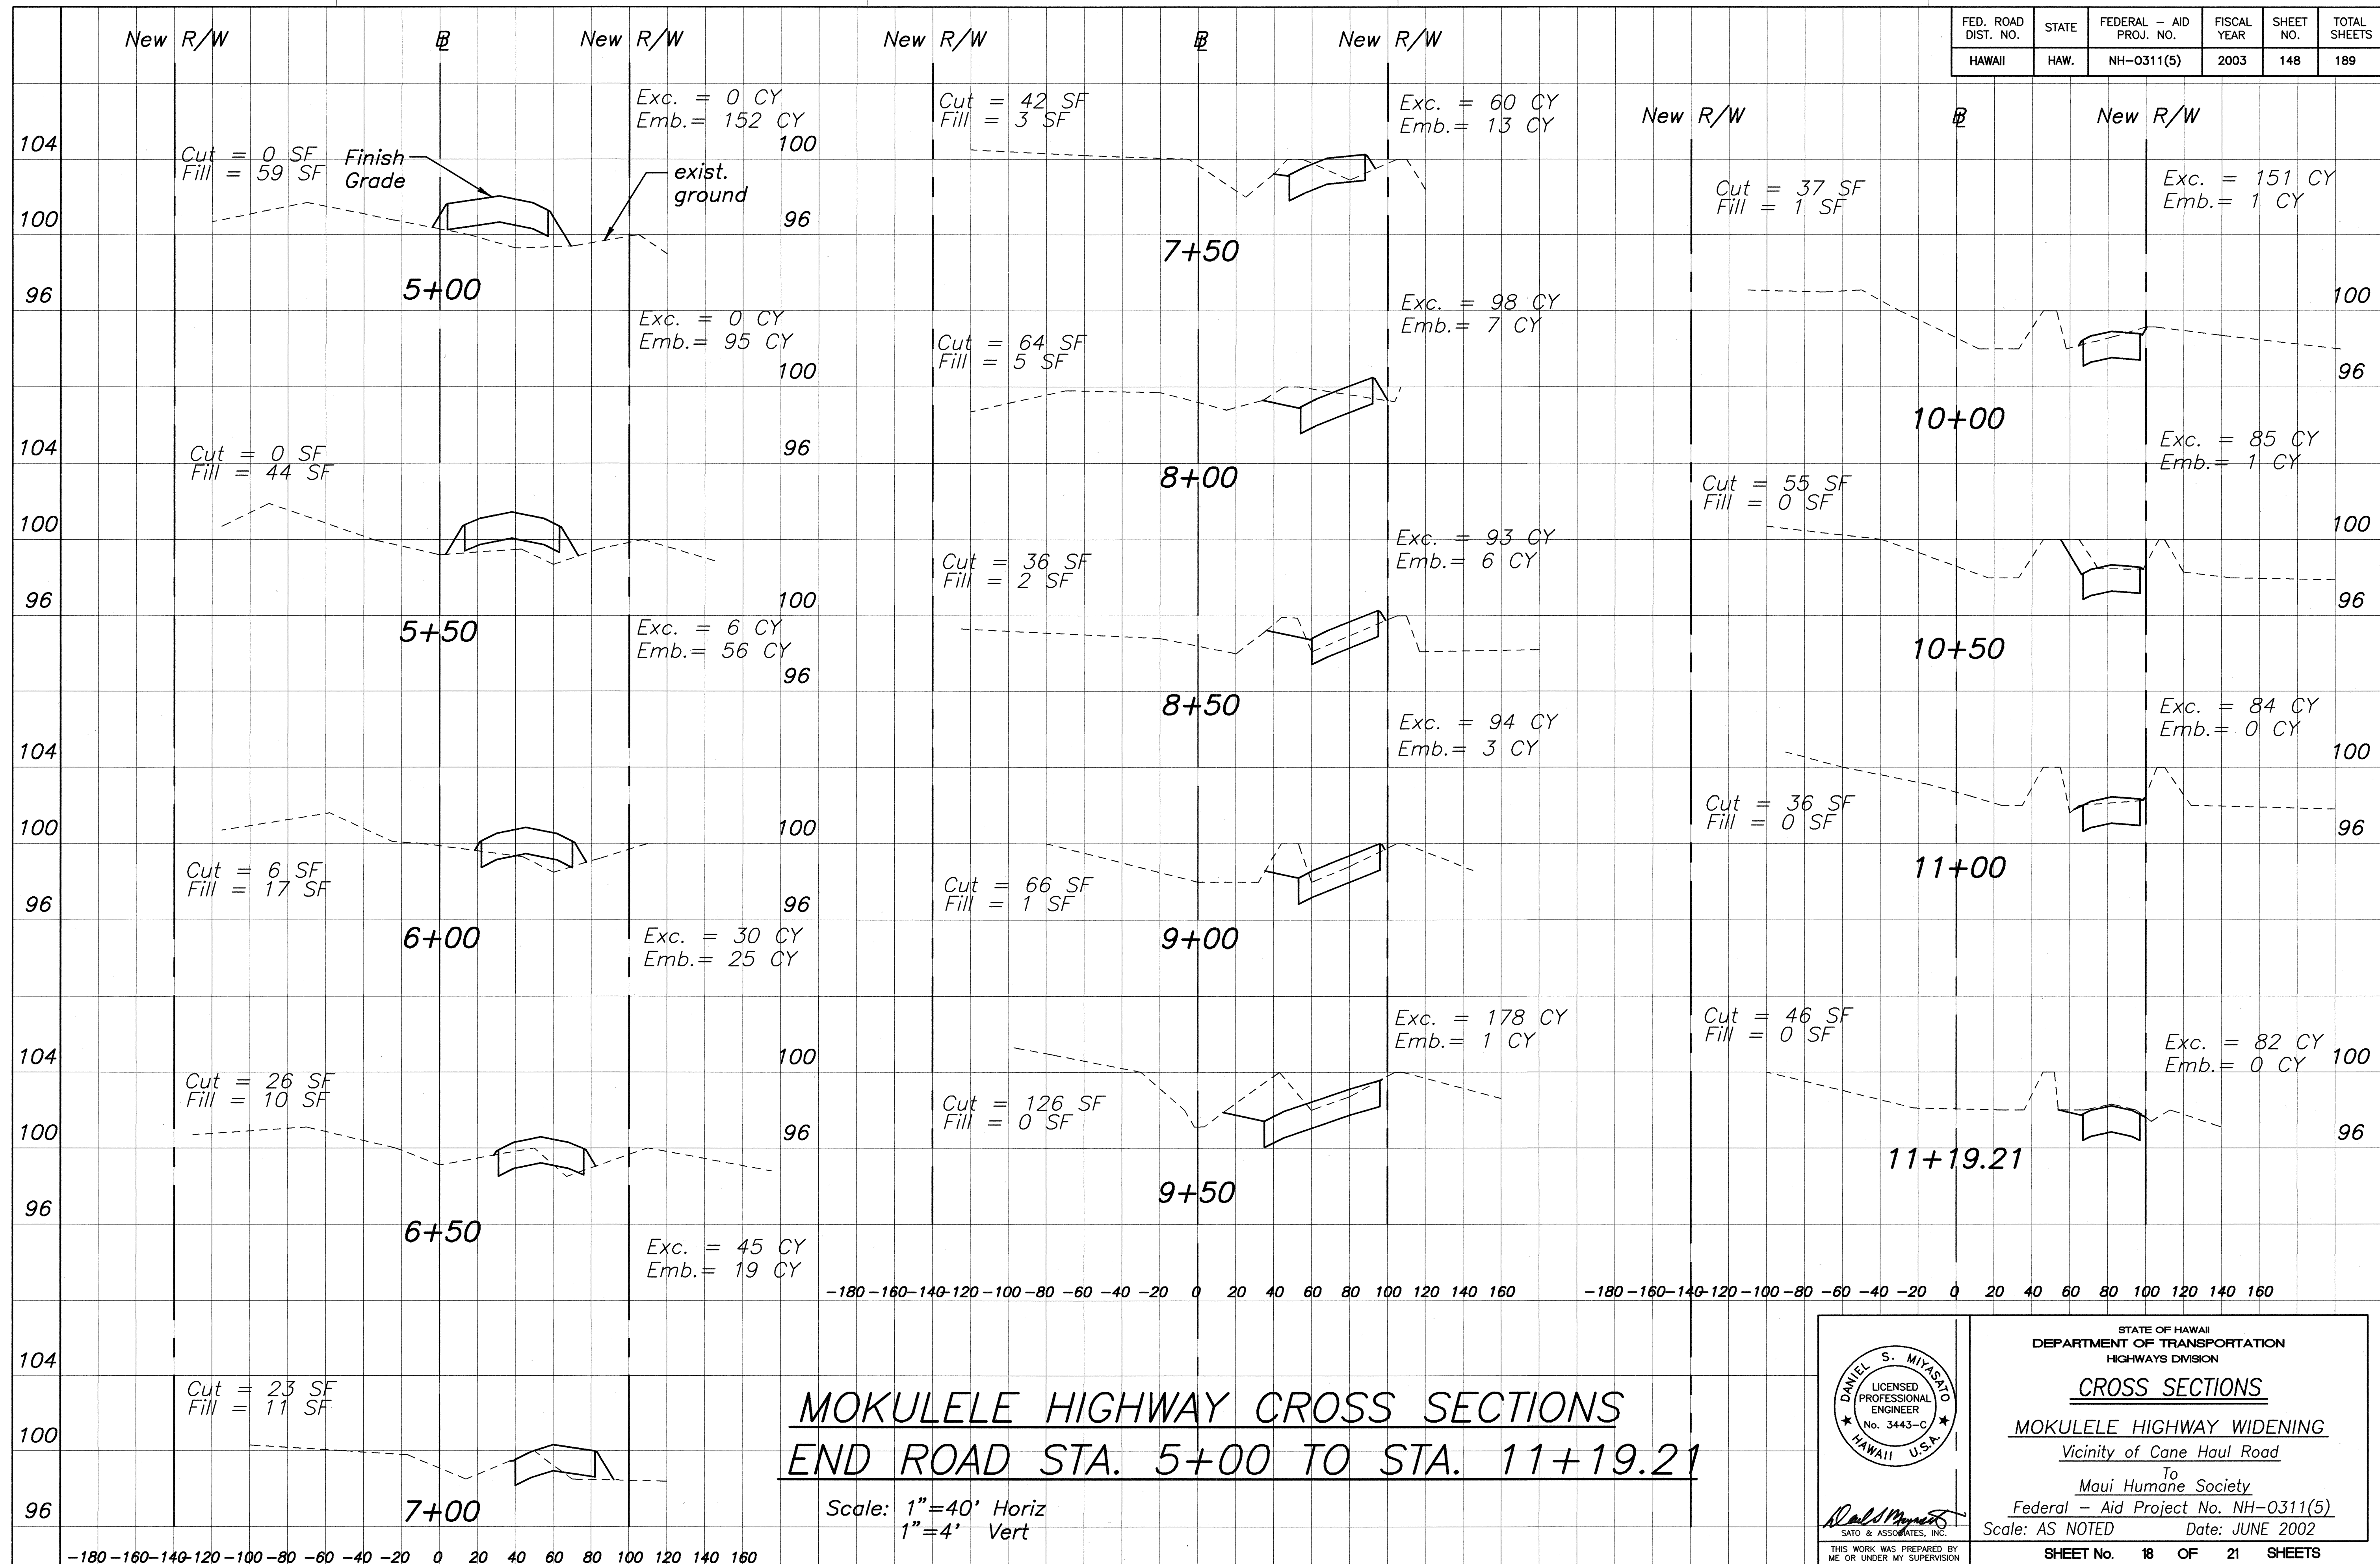


PROJ. NO.: M9901.00
4/11/02
R:\moku\p2b\X-SECT3.dwg

ORIGINAL	SURVEY PLOTTED BY	DATE
PLAN	DRAWN BY	
NOTE BOOK	TRACED BY	
	DESIGNED BY	
	QUANTITIES BY	
	CHECKED BY	
	No.	

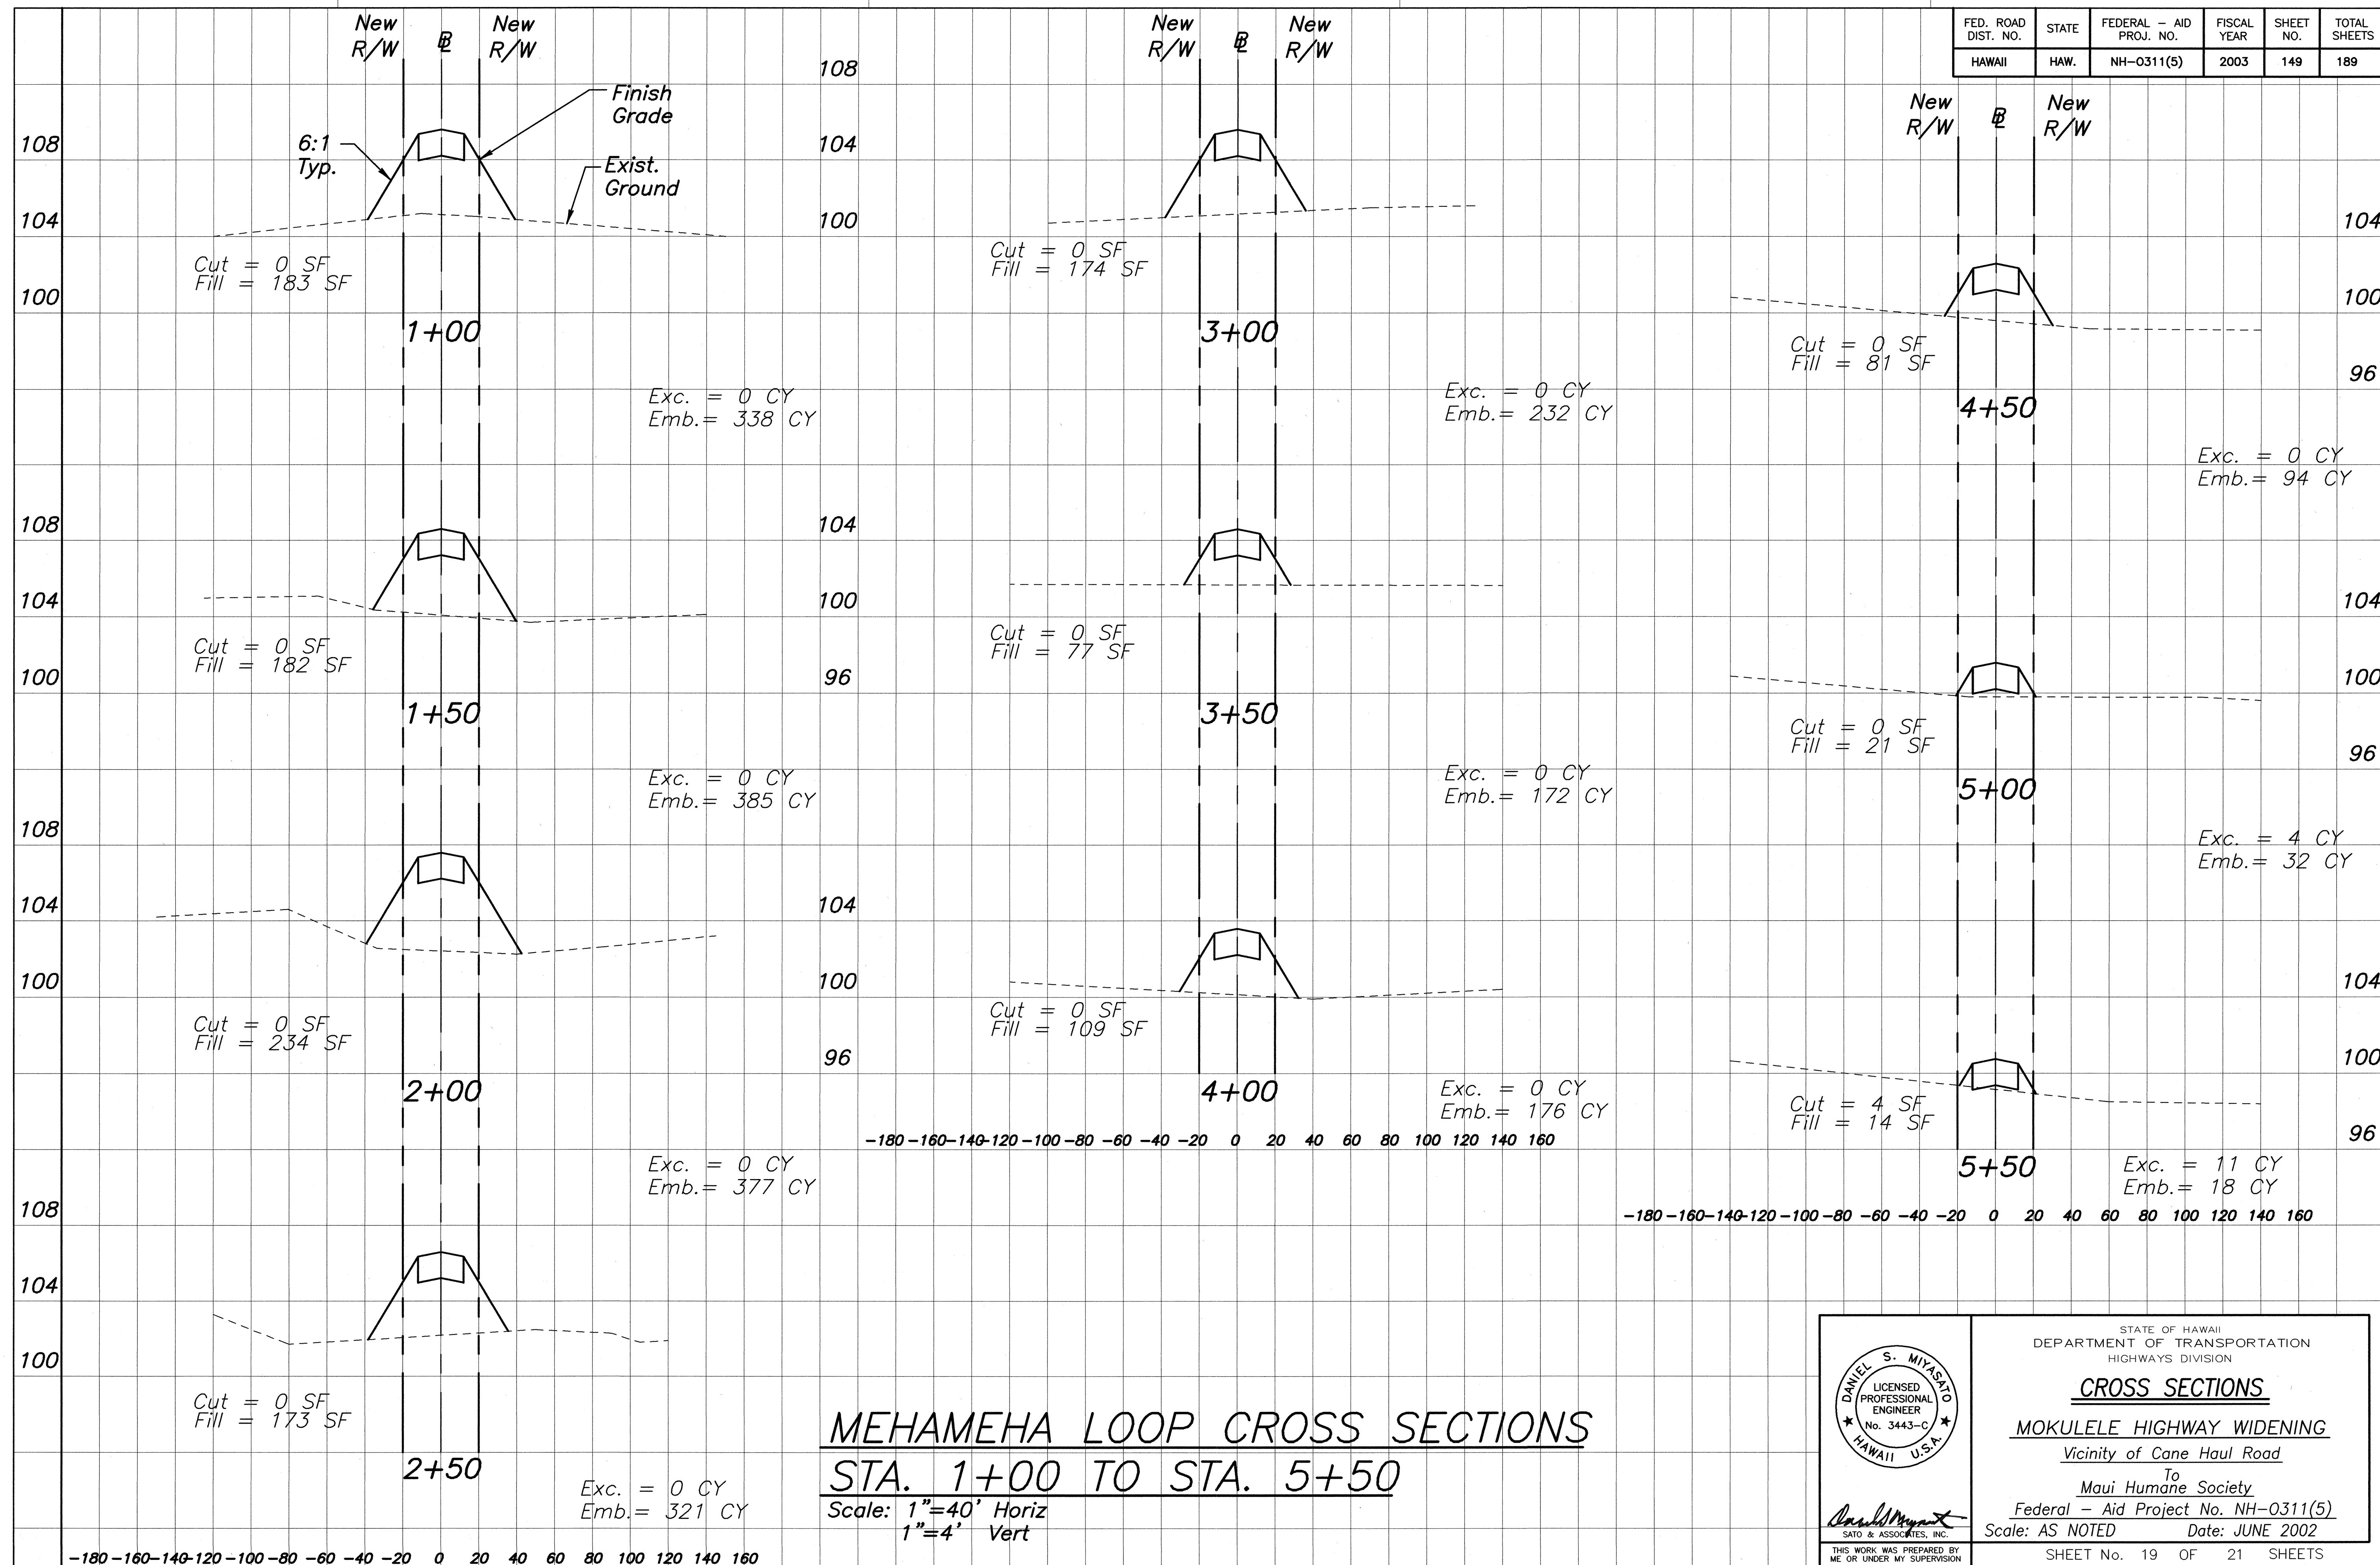

 <i>Daniel S. Miyasato</i> SATO & ASSOCIATES, INC. THIS WORK WAS PREPARED BY ME OR UNDER MY SUPERVISION	STATE OF HAWAII DEPARTMENT OF TRANSPORTATION HIGHWAYS DIVISION
	CROSS SECTIONS
	MOKULELE HIGHWAY WIDENING
	Vicinity of Cane Haul Road
	To Maui Humane Society Federal - Aid Project No. NH-0311(5) Scale: AS NOTED Date: JUNE 2002
SHEET No. 19 OF 21 SHEETS	

ORIGINAL PLAN	SURVEY PLOTTED BY	DATE
	DRAWN BY	
	TRACED BY	
	DESIGNED BY	
NOTE BOOK	CHECKED BY	
	No.	

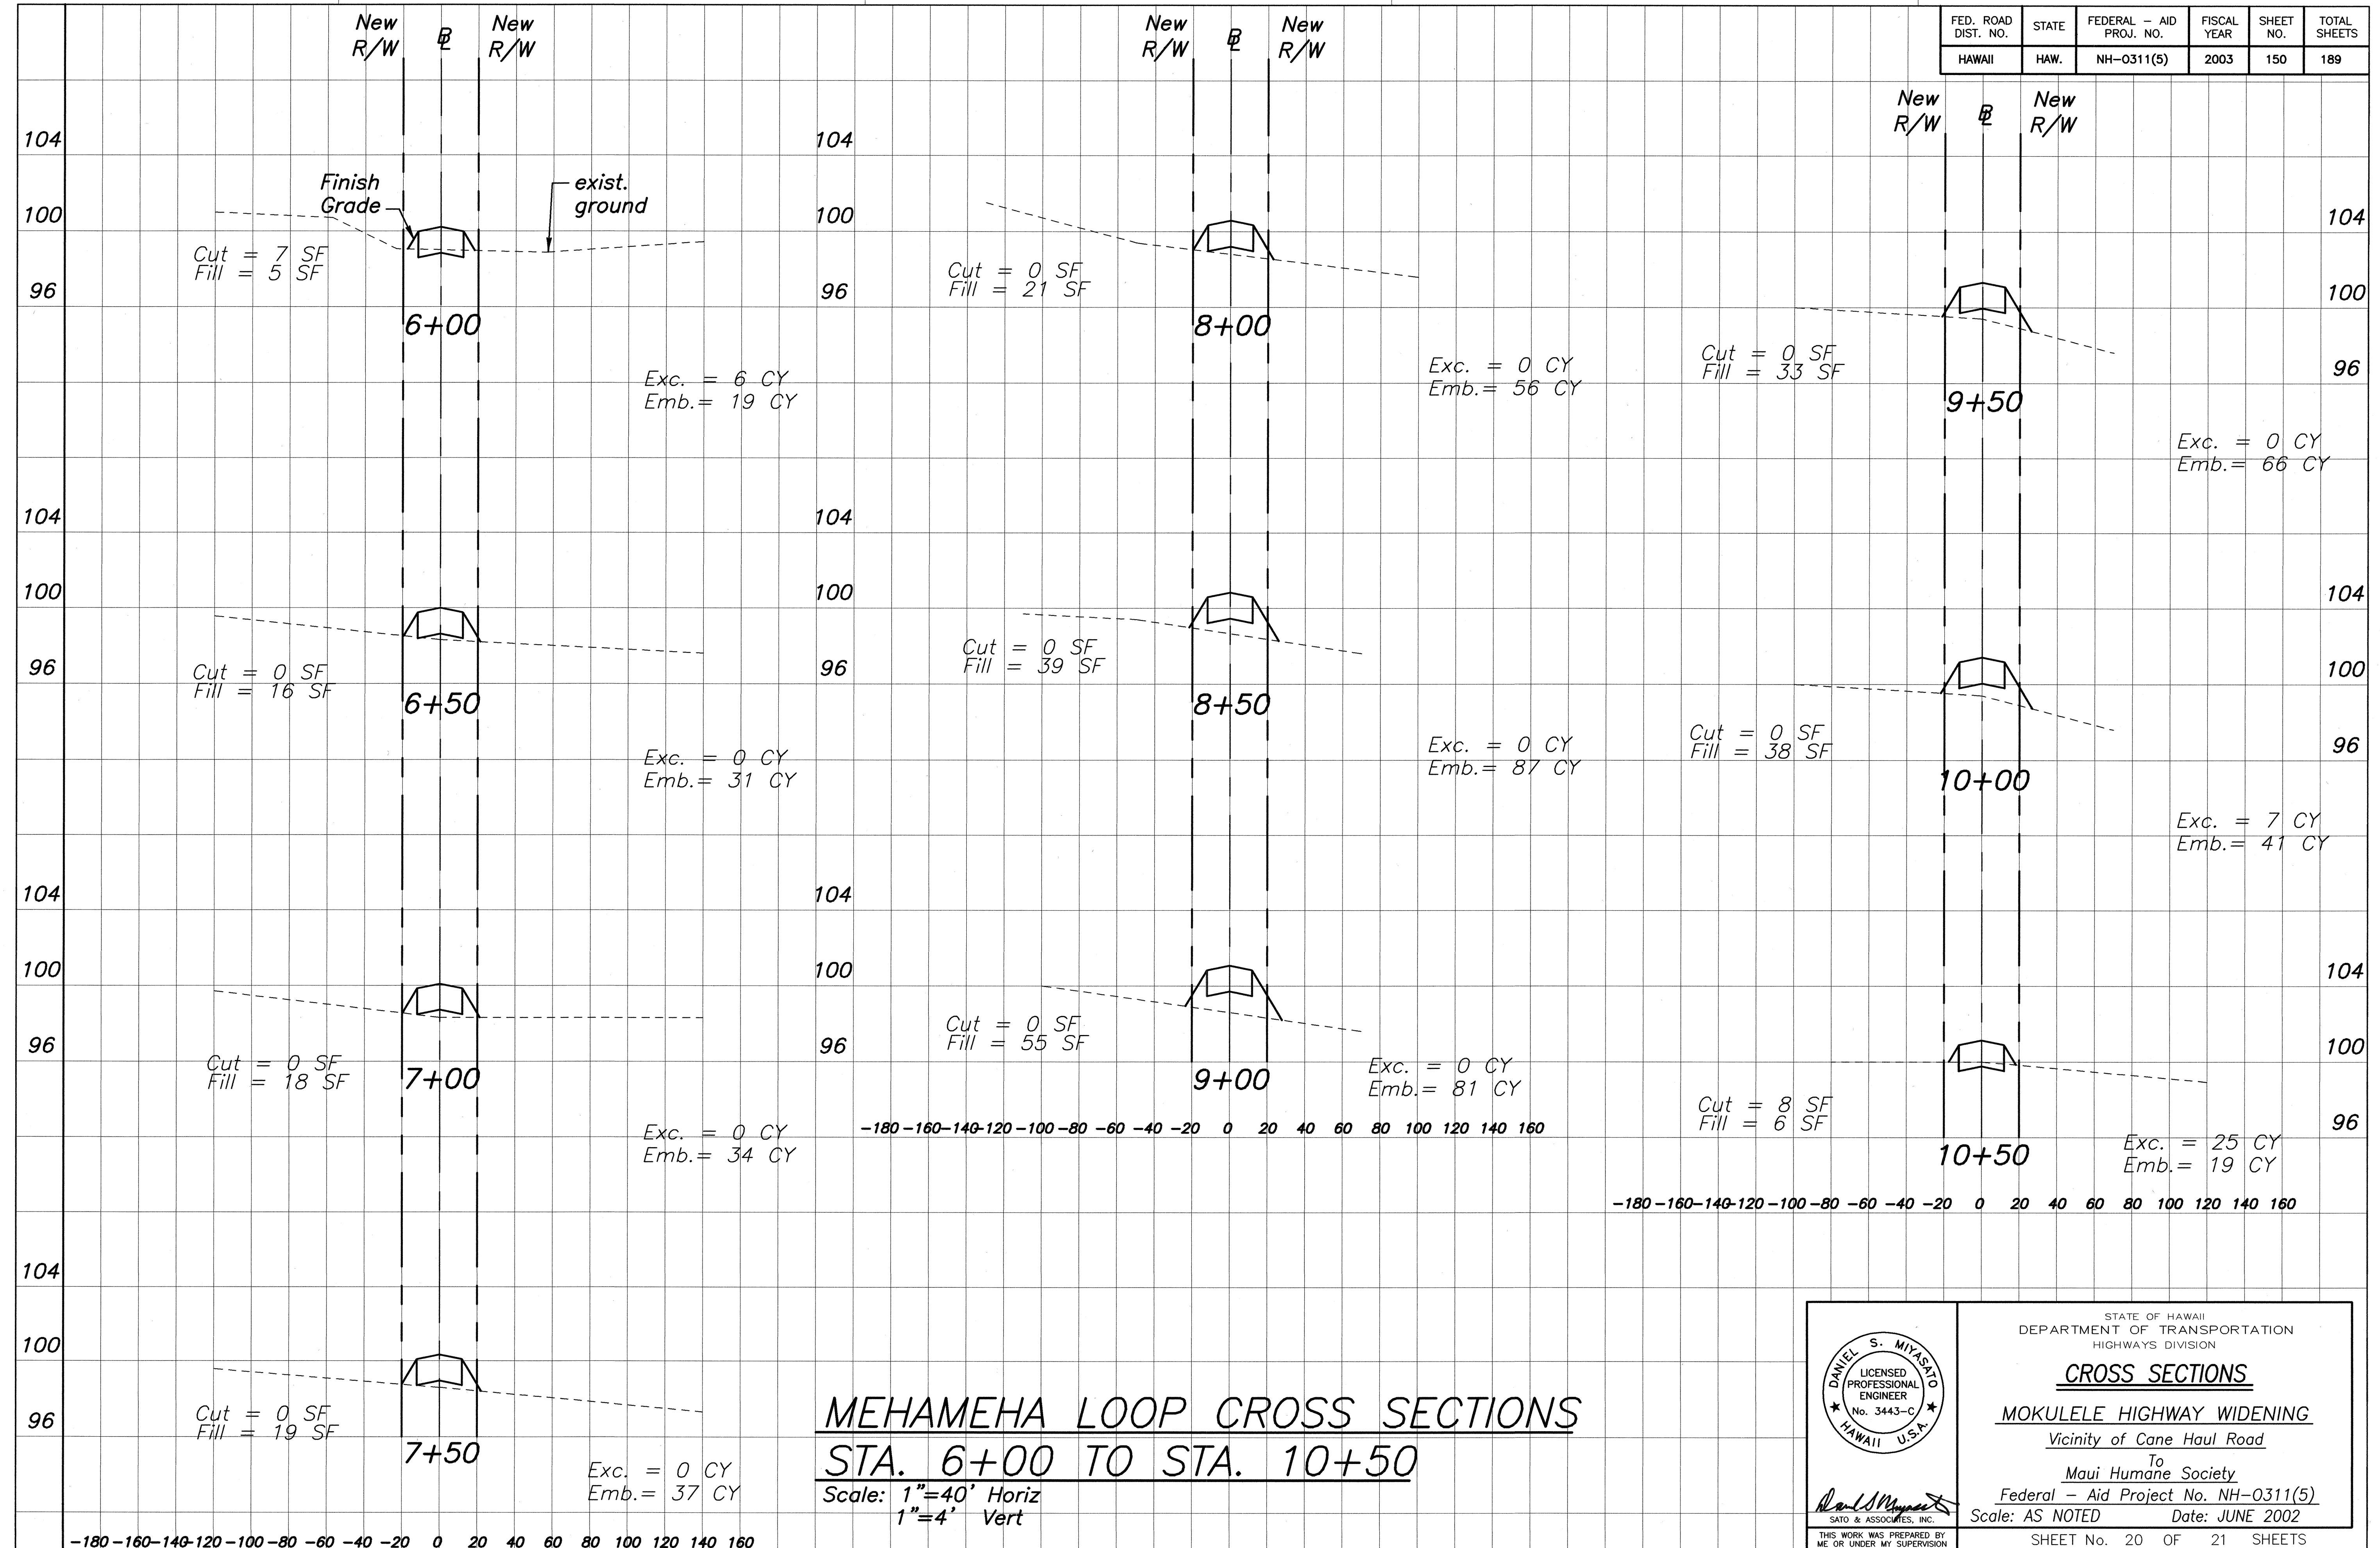

STATE OF HAWAII
DEPARTMENT OF TRANSPORTATION
HIGHWAYS DIVISION

CROSS SECTIONS

MOKULELE HIGHWAY WIDENING
Vicinity of Cane Haul Road

To
Maui Humane Society
Federal - Aid Project No. NH-0311(5)


Scale: AS NOTED Date: JUNE 2002

SHEET No. 20 OF 21 SHEETS

DANIEL S. MIYASHIRO
LICENSED PROFESSIONAL ENGINEER
No. 3443-C
HAWAII U.S.A.


THIS WORK WAS PREPARED BY
ME OR UNDER MY SUPERVISION

FED. ROAD DIST. NO.	STATE	FEDERAL - AID PROJ. NO.	FISCAL YEAR	SHEET NO.	TOTAL SHEETS
HAWAII	HAW.	NH-0311(5)	2003	151	189

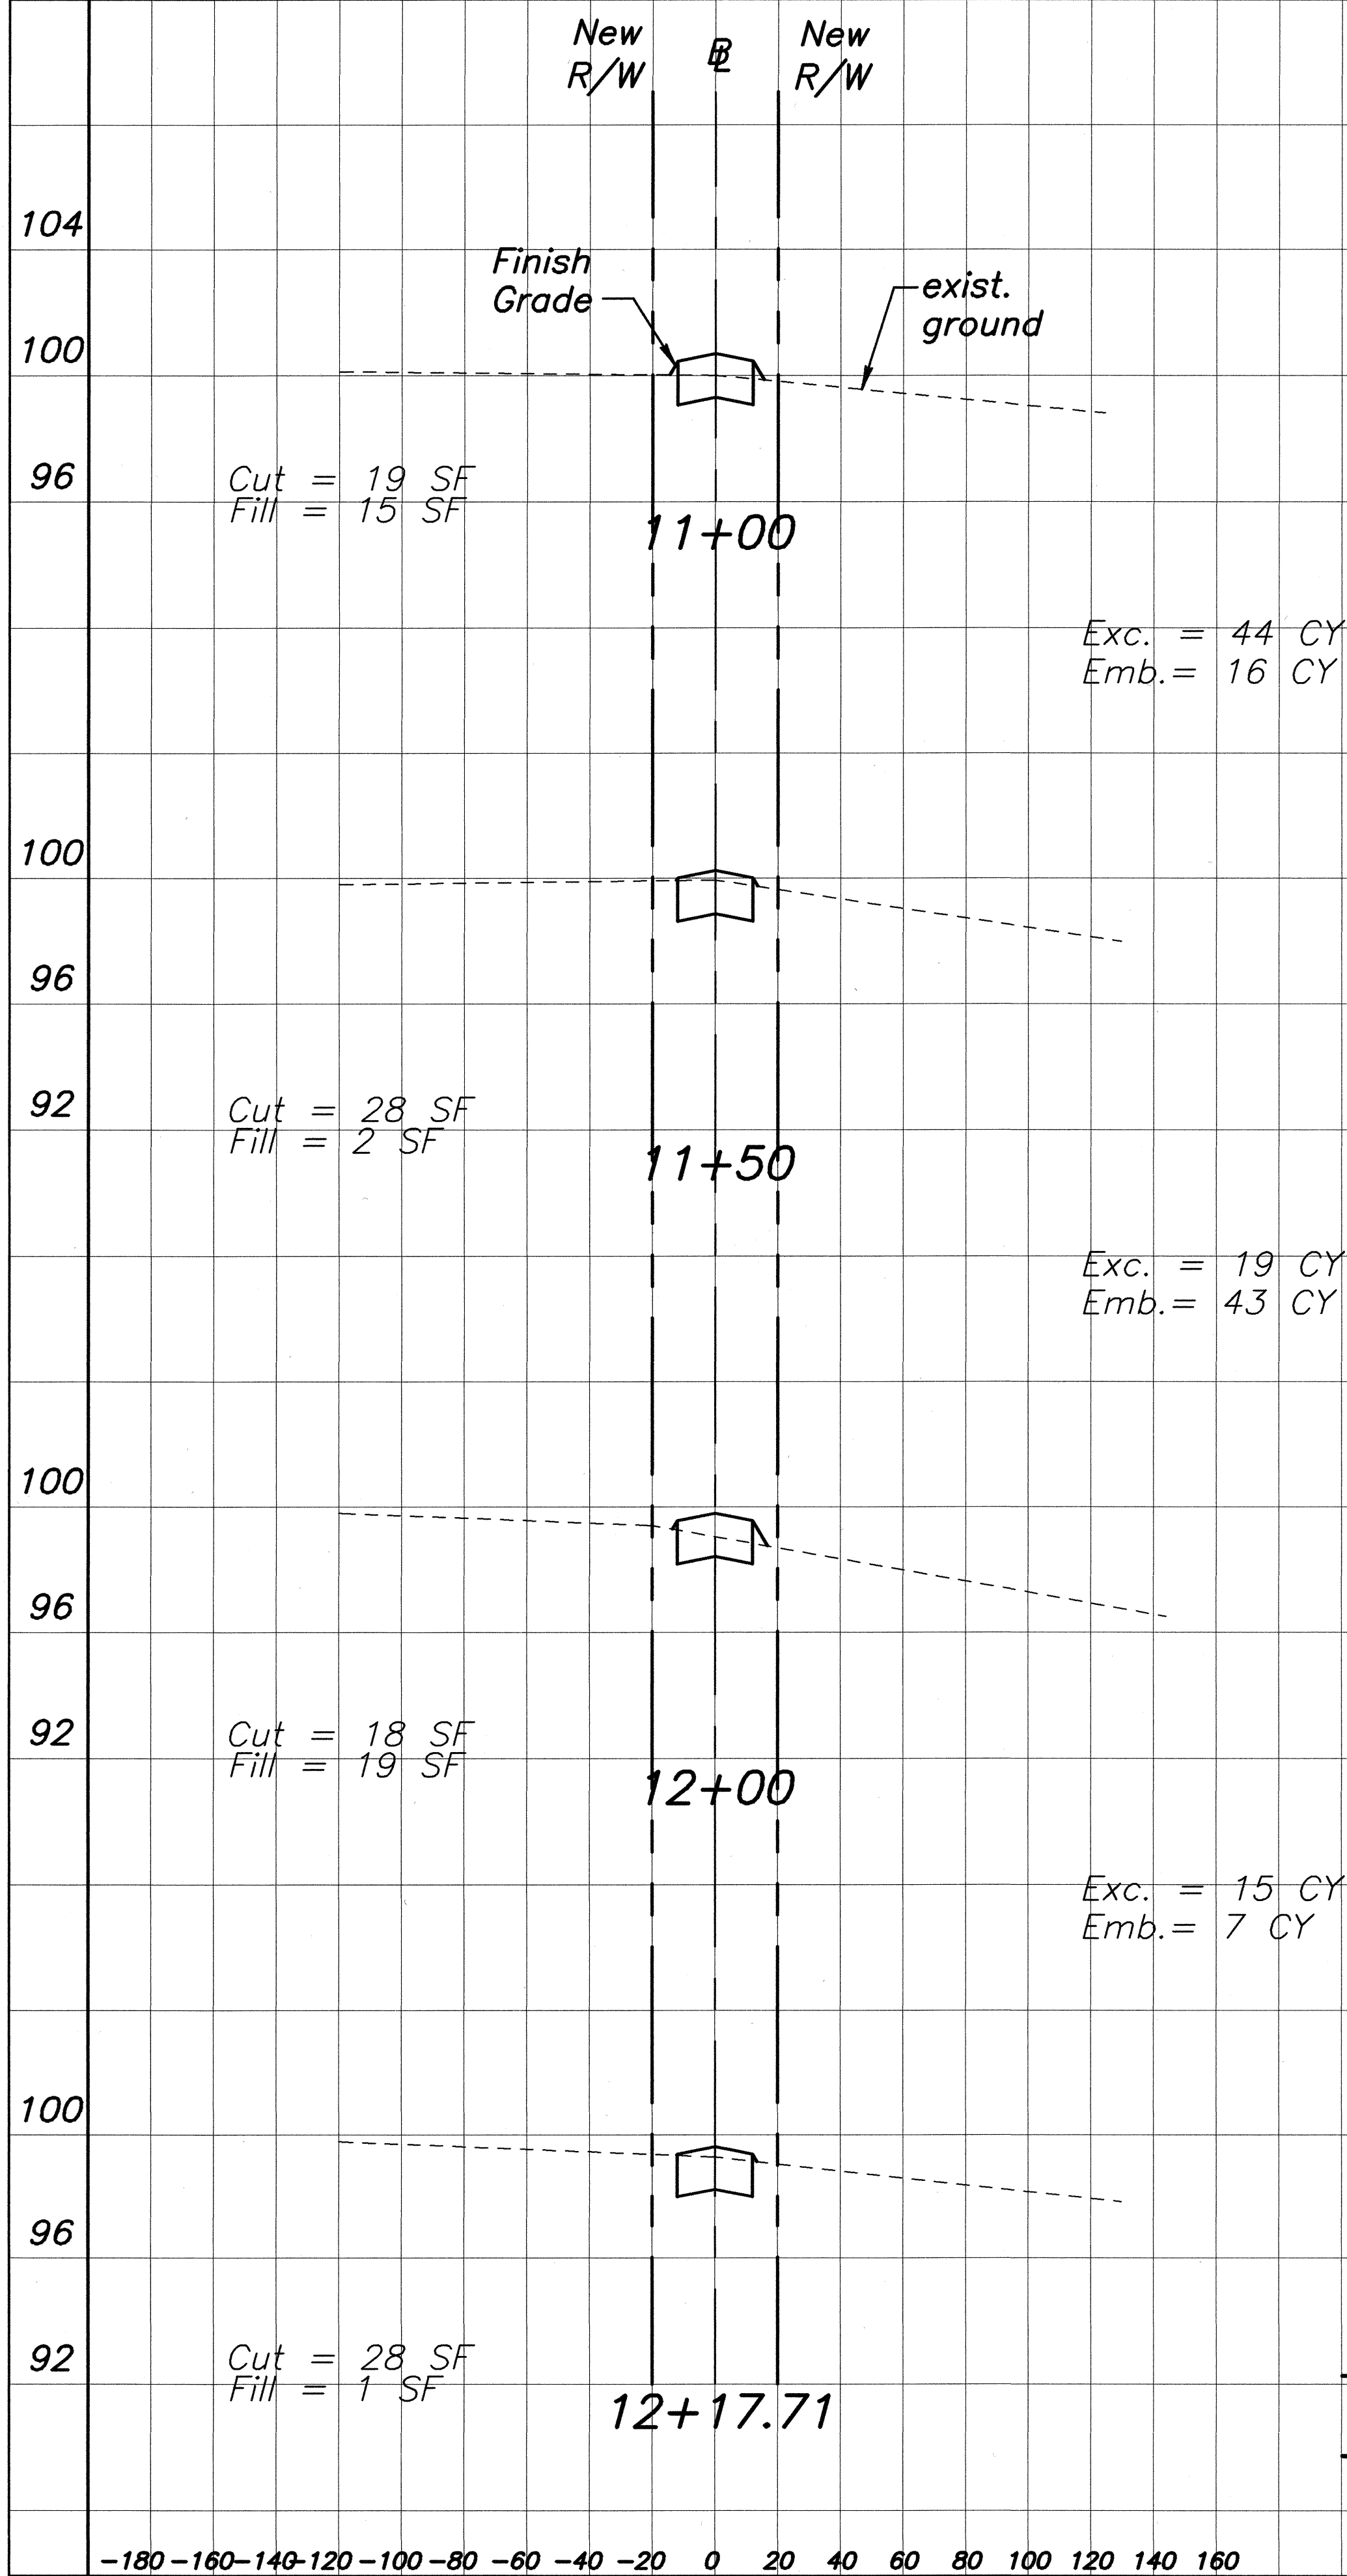

ORIGINAL SURVEY PLOTTED BY	DATE
DRAWN BY	
TRACED BY	
REVIEWED BY	
NOTE BOOK	
QUANTITIES BY	
CHECKED BY	
No.	

MEHAMEHA LOOP CROSS SECTIONS **STA. 11+00 TO STA. 12+17.71** Scale: 1"=40' Horiz 1"=4' Vert

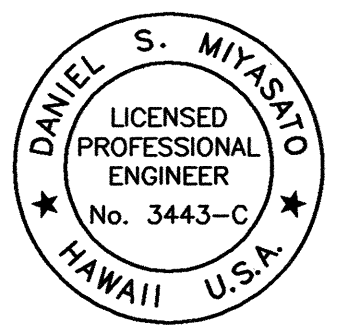

STATE OF HAWAII
 DEPARTMENT OF TRANSPORTATION
 HIGHWAYS DIVISION

CROSS SECTIONS
MOKULELE HIGHWAY WIDENING
 Vicinity of Cane Haul Road
 To
 Maui Humane Society
 Federal - Aid Project No. NH-0311(5)
 Scale: AS NOTED Date: JUNE 2002

THIS WORK WAS PREPARED BY
 ME OR UNDER MY SUPERVISION

SHEET No. 21 OF 21 SHEETS