
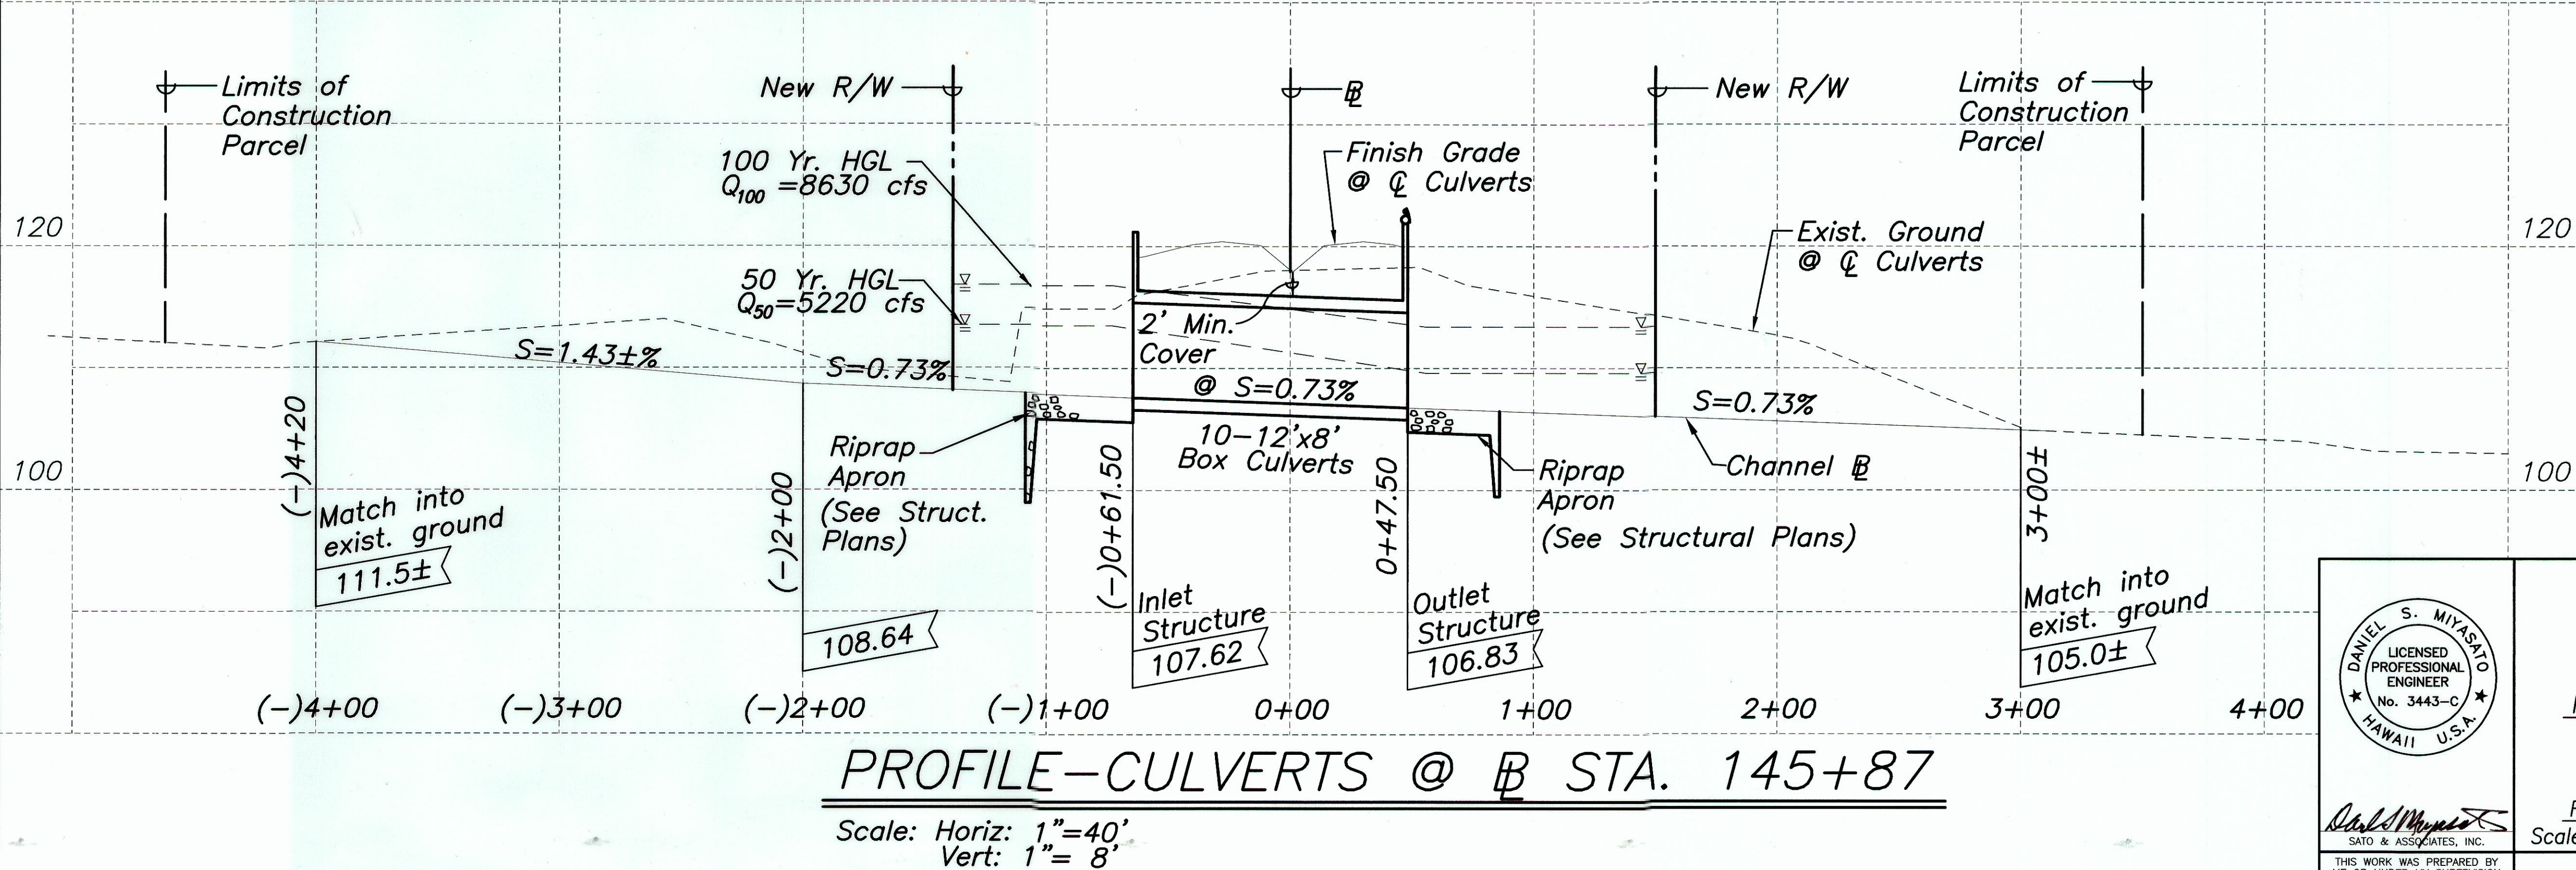
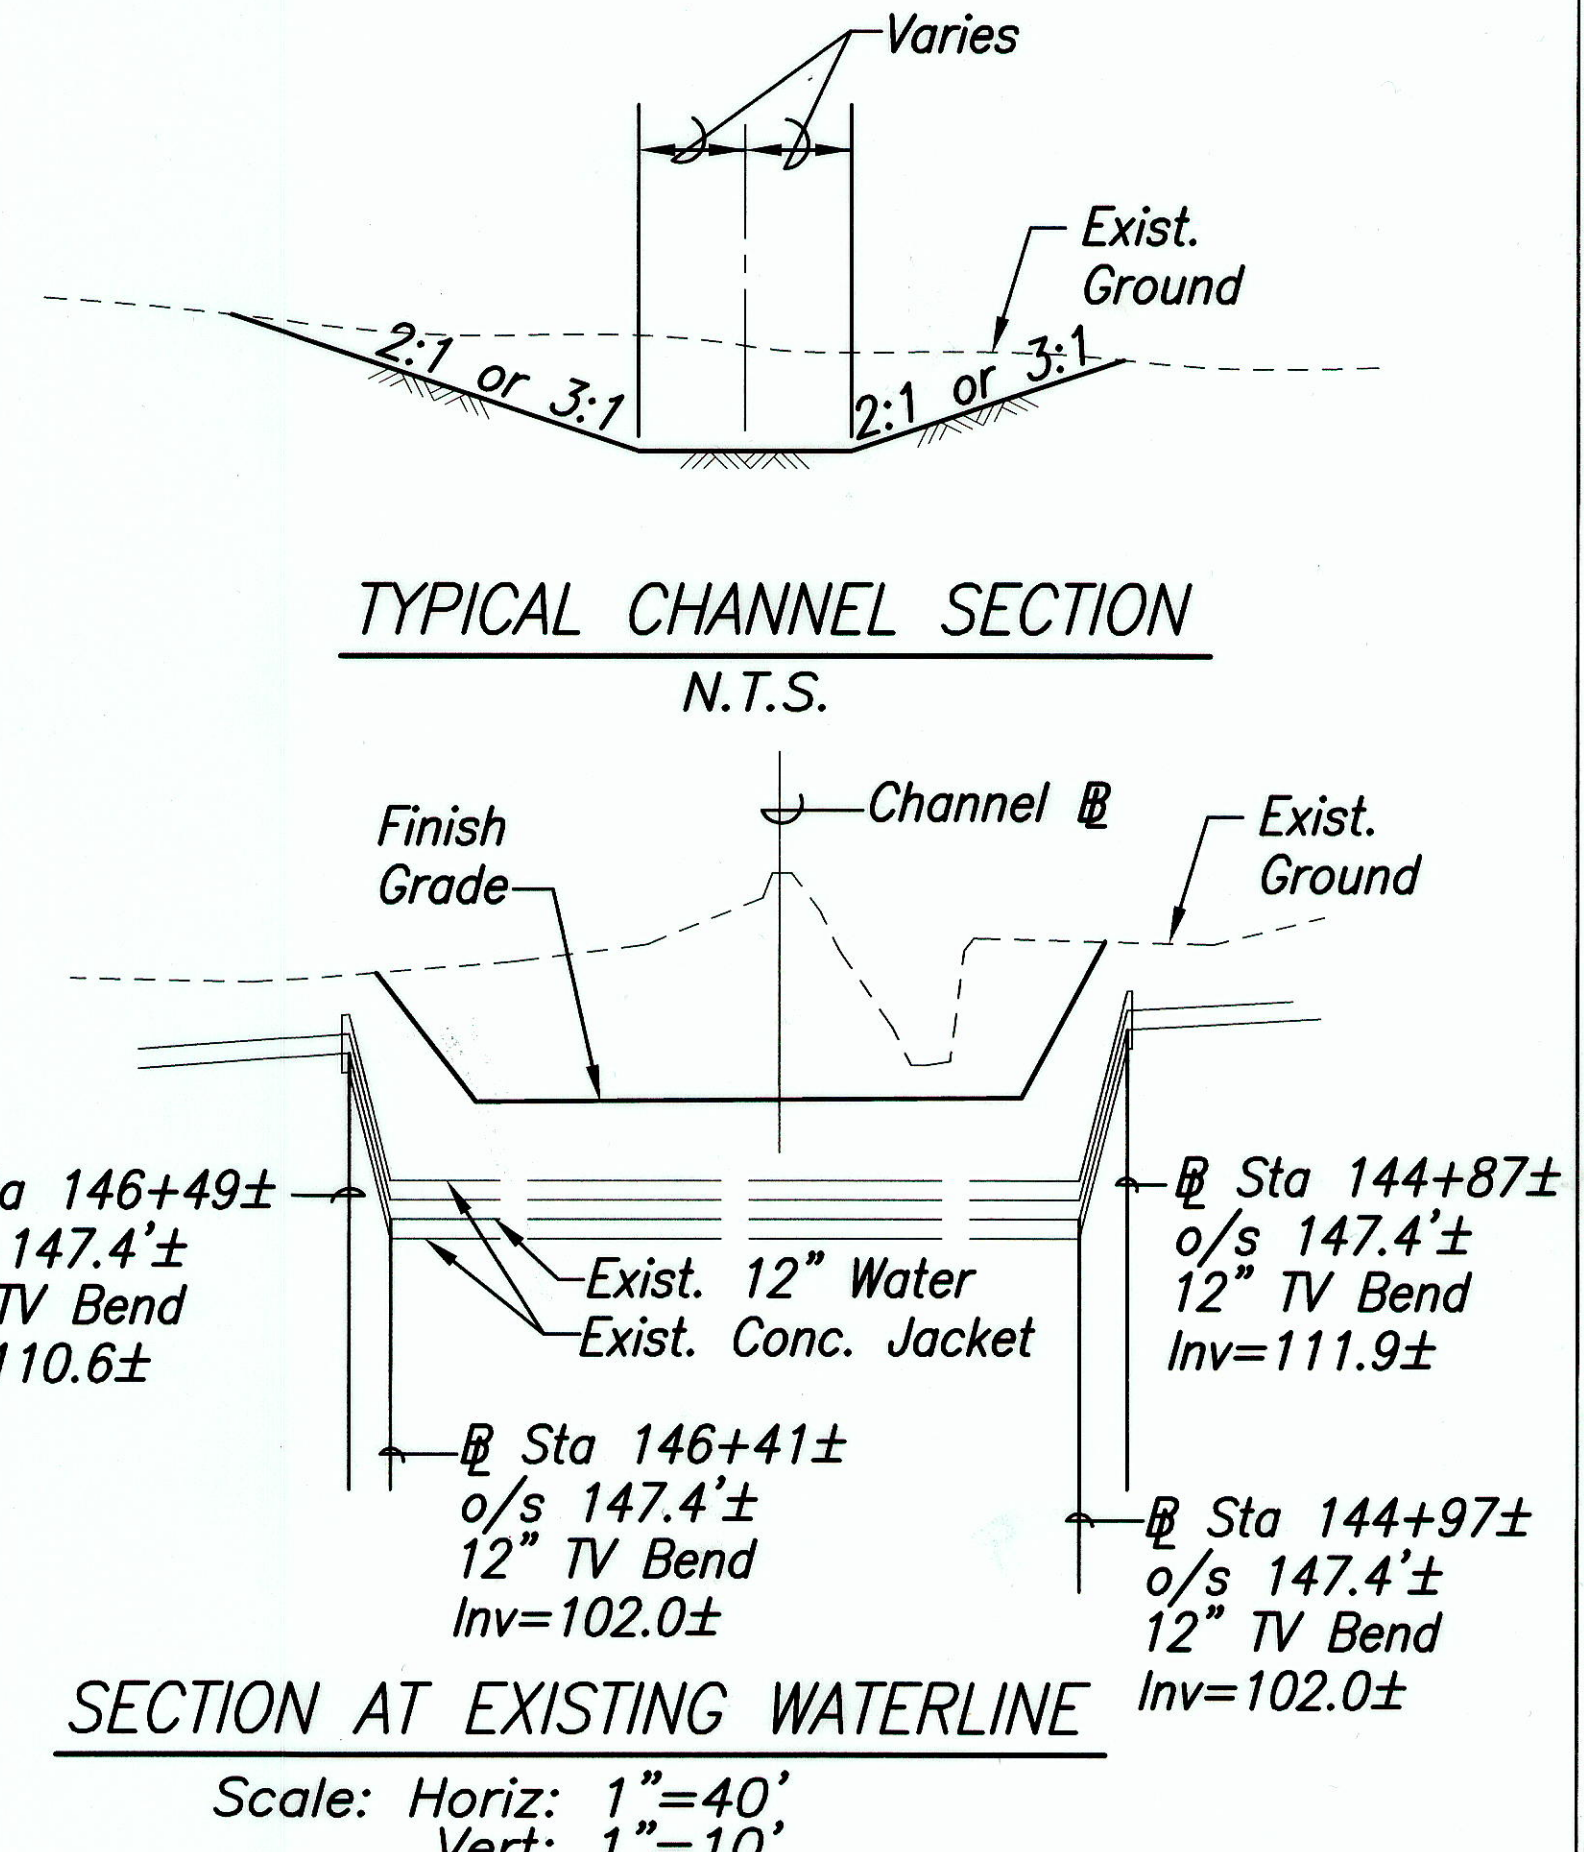


FED. ROAD DIST. NO.	STATE	FEDERAL - AID PROJ. NO.	FISCAL YEAR	SHEET NO.	TOTAL SHEETS
HAWAII	HAW.	NH-0311(5)	2003	80	189

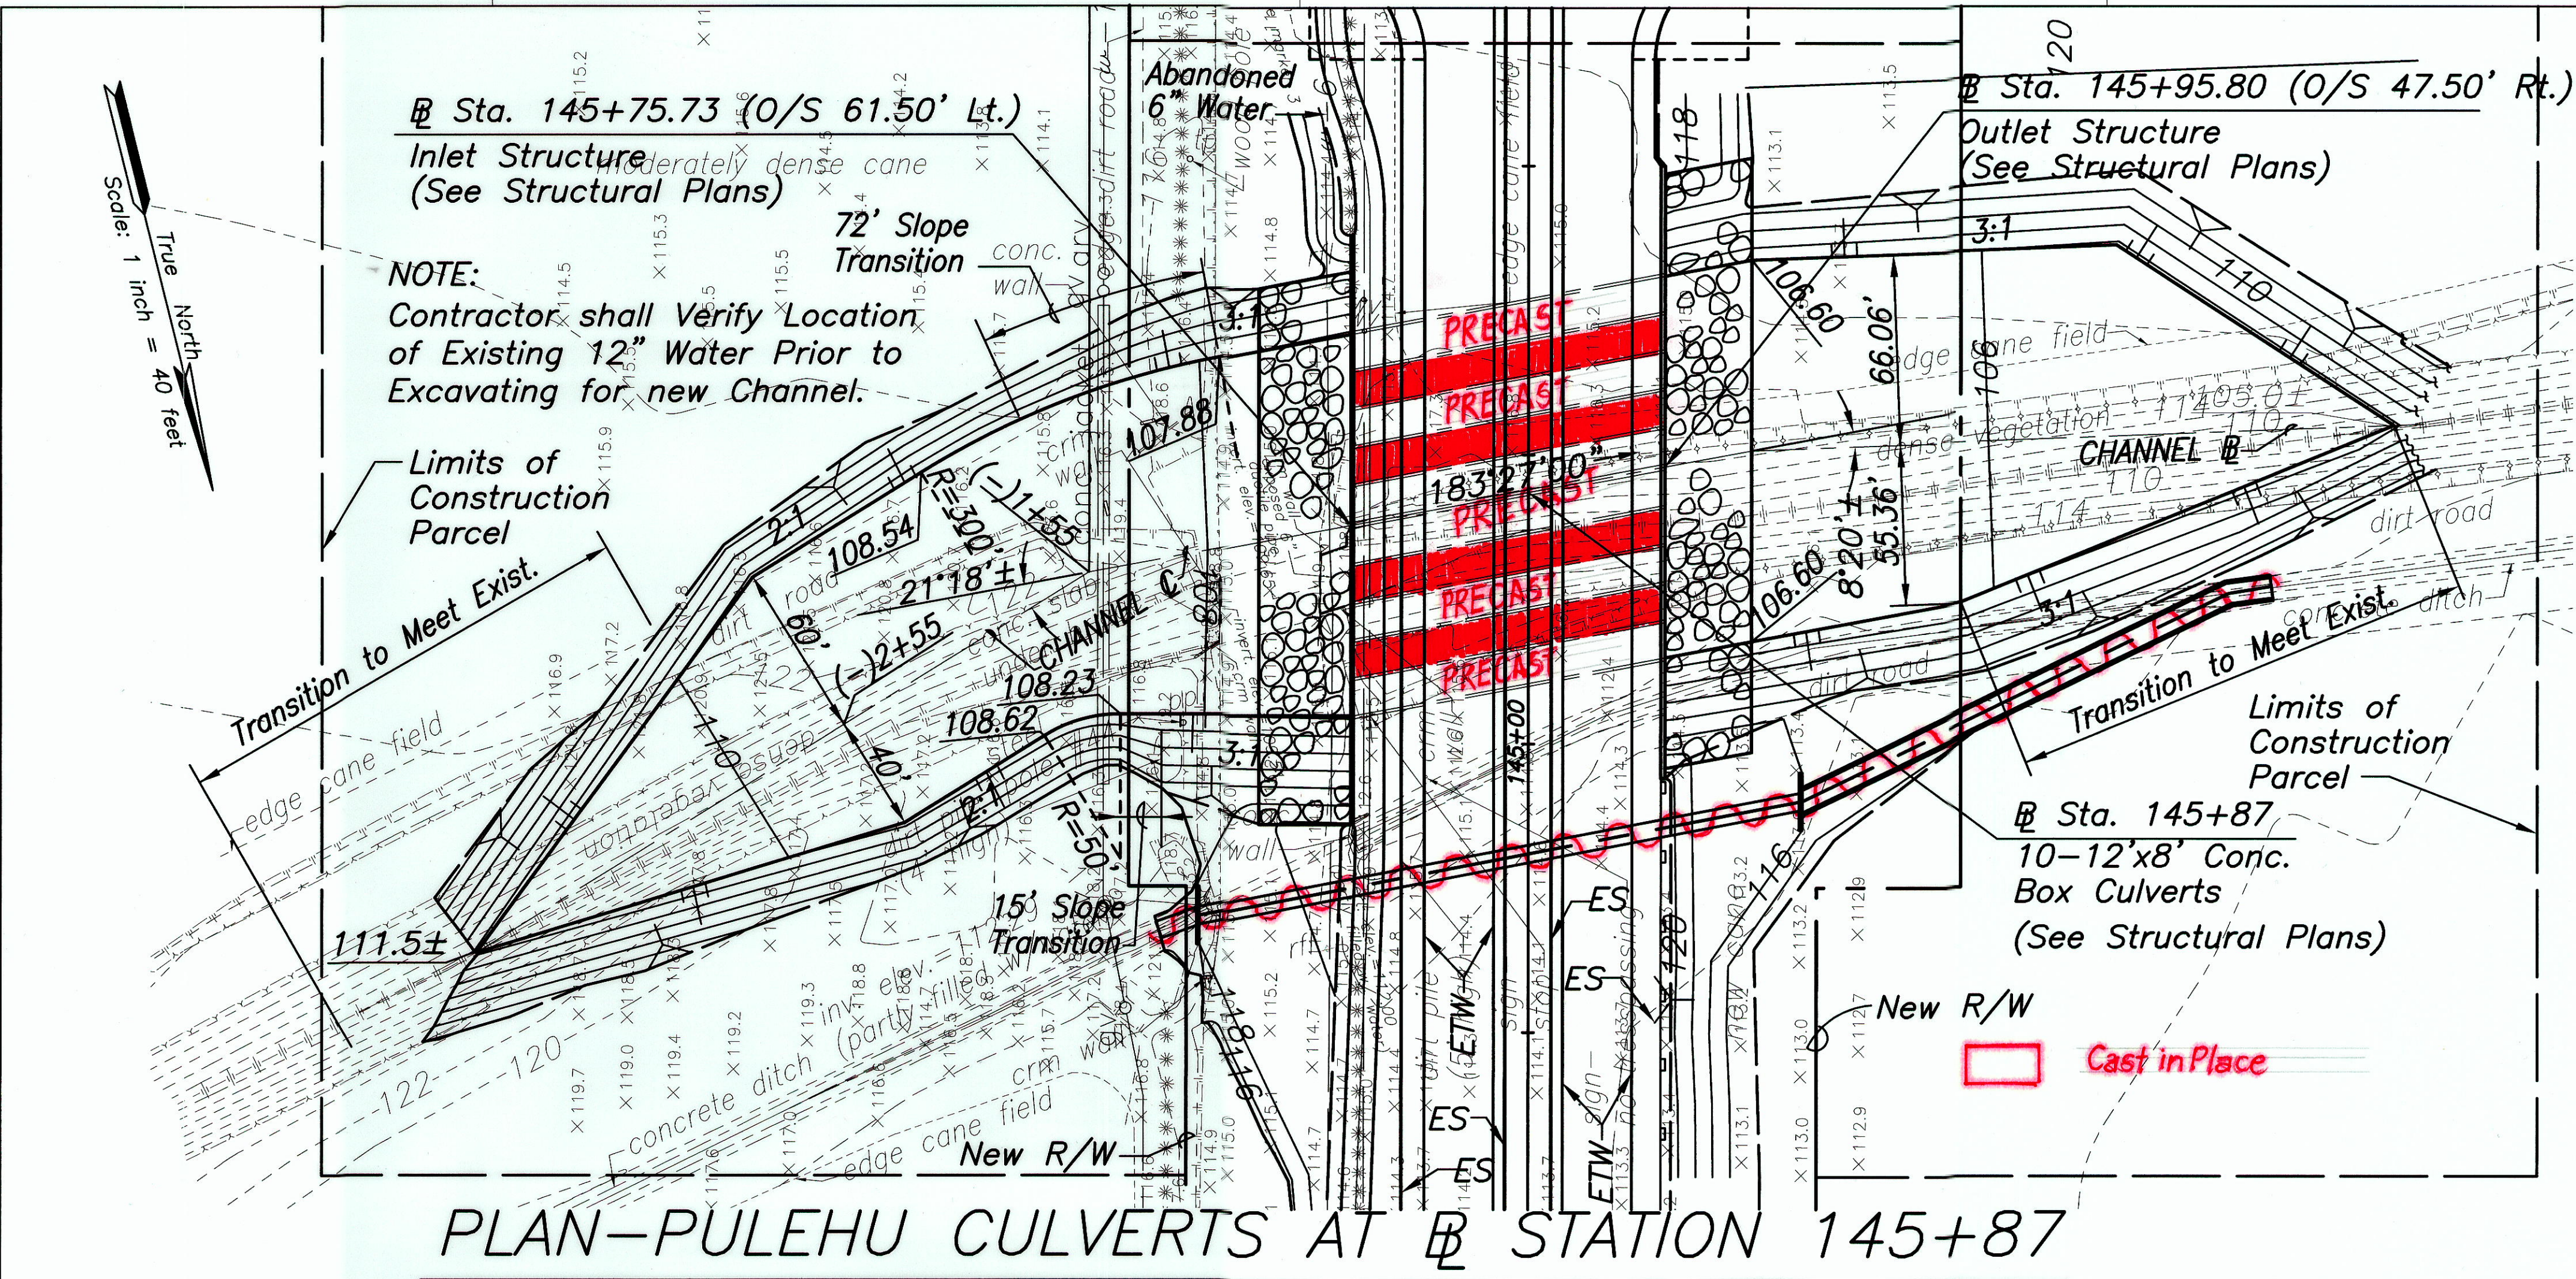

STATE OF HAWAII
DEPARTMENT OF TRANSPORTATION
HIGHWAYS DIVISION

DRAINAGE DETAILS

MOKULELE HIGHWAY WIDENING
Vicinity of Cane Haul Road
To
Maui Humane Society
Federal - Aid Project No. NH-0311(5)
Scale: AS NOTED Date: JUNE 2002

SHEET NO. 1 OF 1 SHEETS

DANIEL S. MIYASHIRO
LICENSED PROFESSIONAL ENGINEER
No. 3443-C
HAWAII U.S.A.

Daniel Miyashiro
SATO & ASSOCIATES, INC.

THIS WORK WAS PREPARED BY ME OR UNDER MY SUPERVISION

"AS-BUILT"