

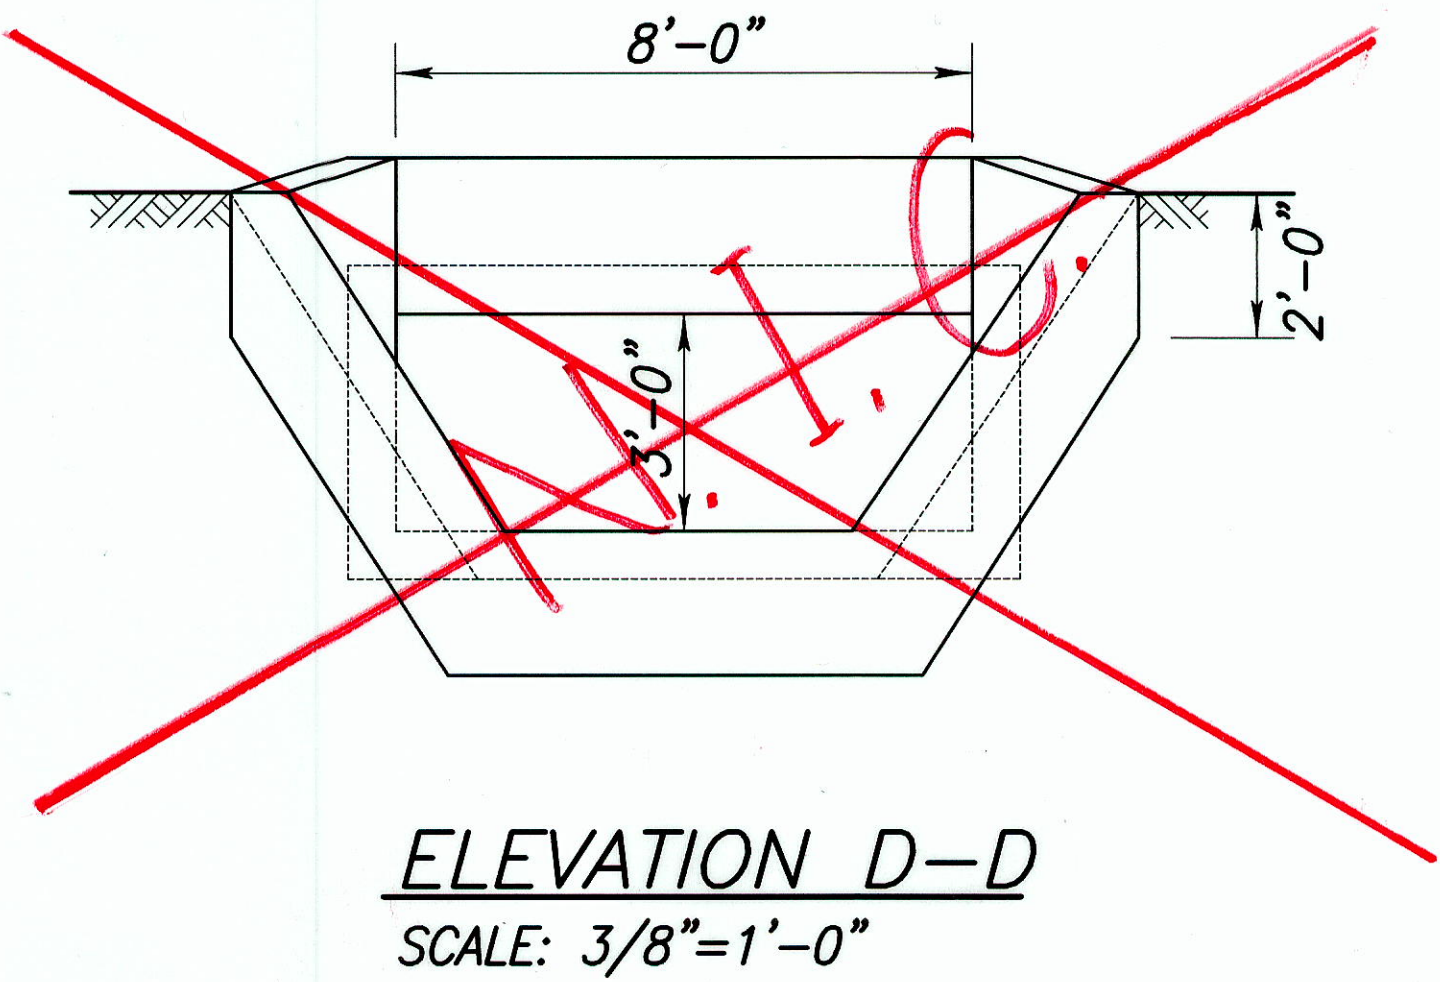
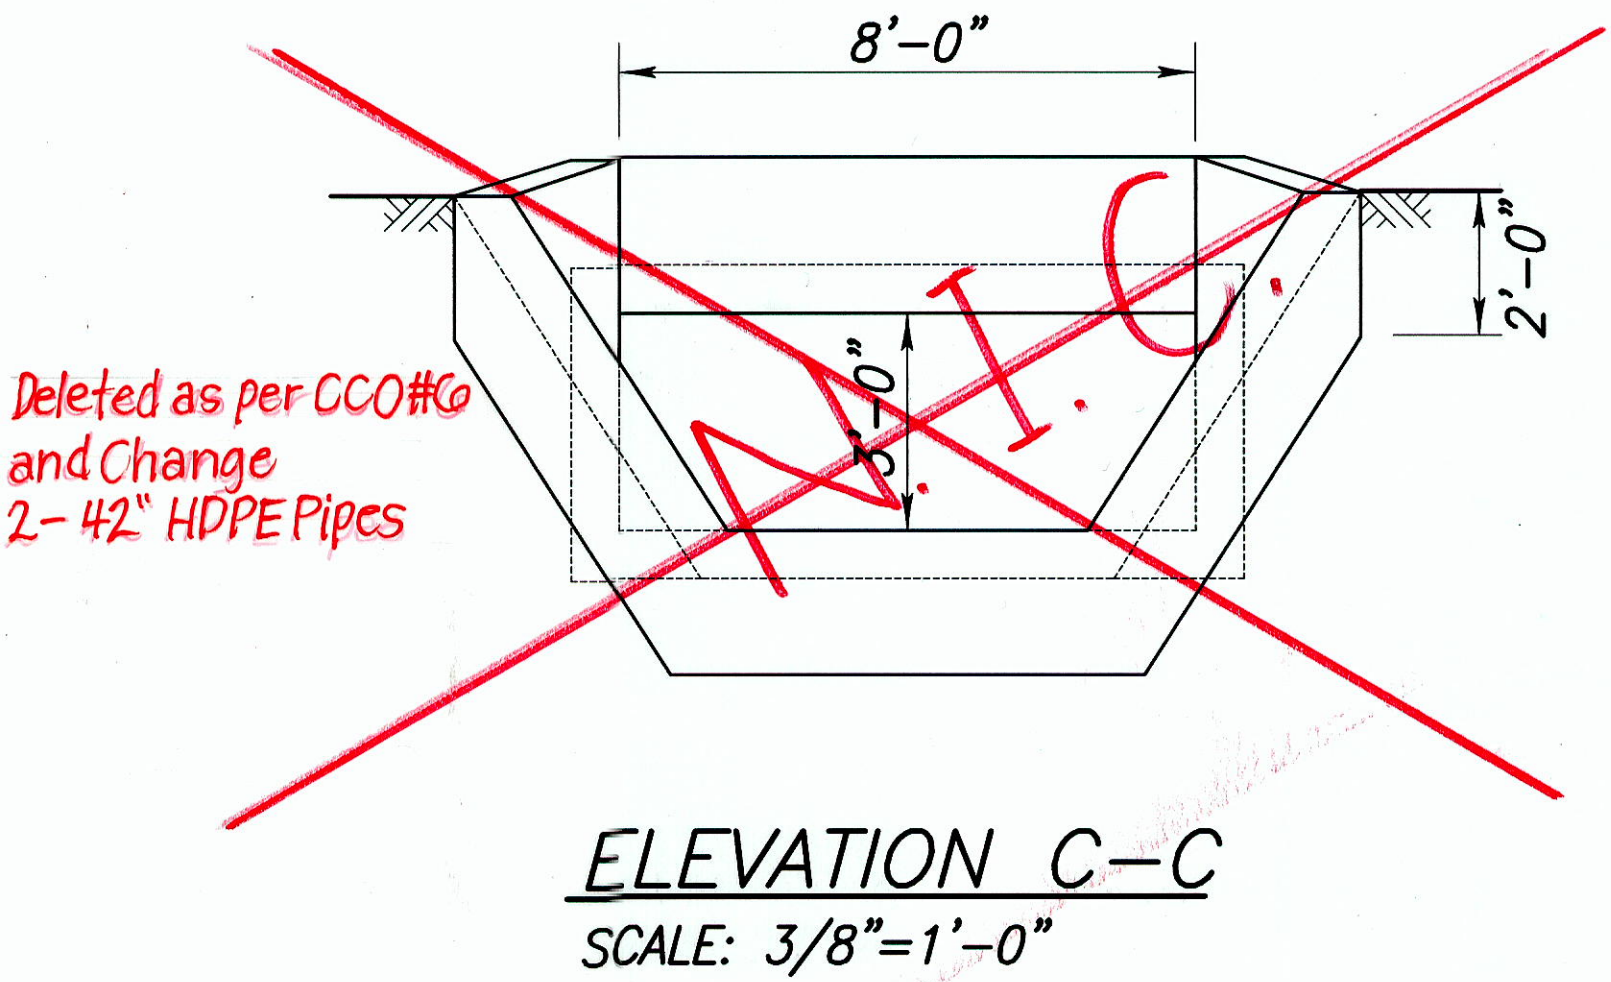


FED. ROAD DIST. NO.	STATE	FEDERAL - AID PROJ. NO.	FISCAL YEAR	SHEET NO.	TOTAL SHEETS
HAWAII	HAW.	NH-0311(5)	2003	81	189

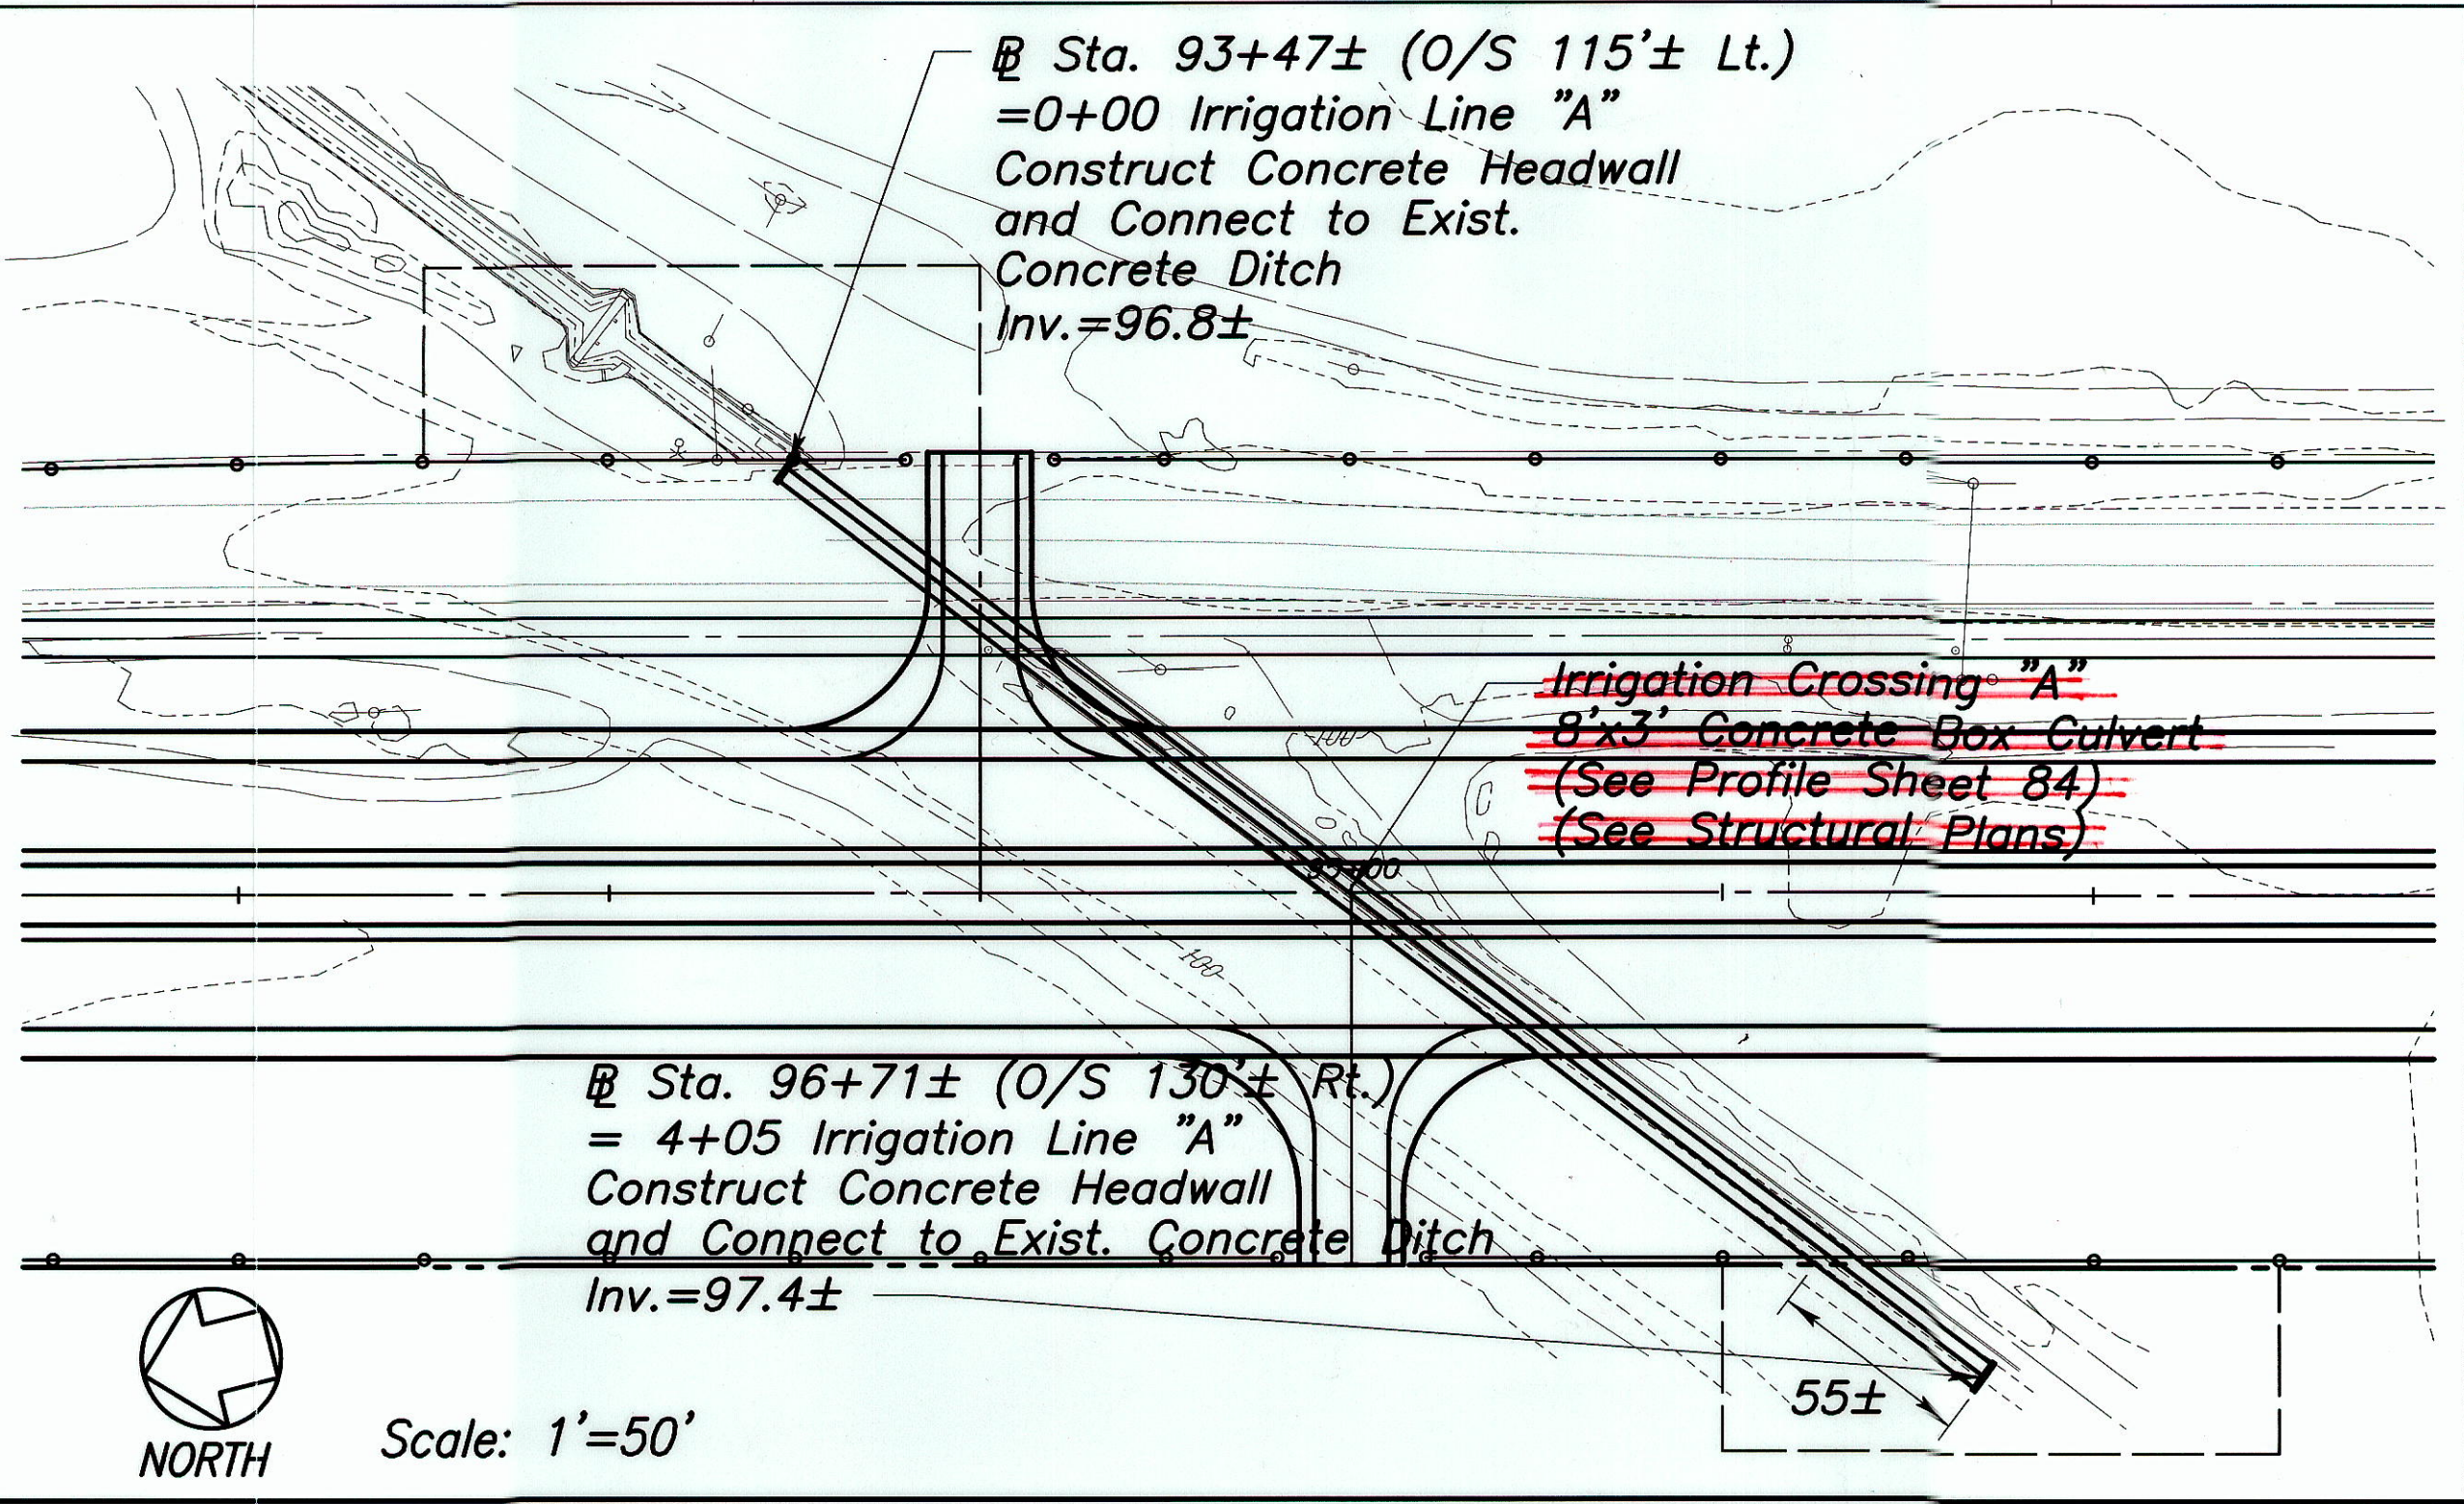









Note:
 See Sht. 84 for Profiles

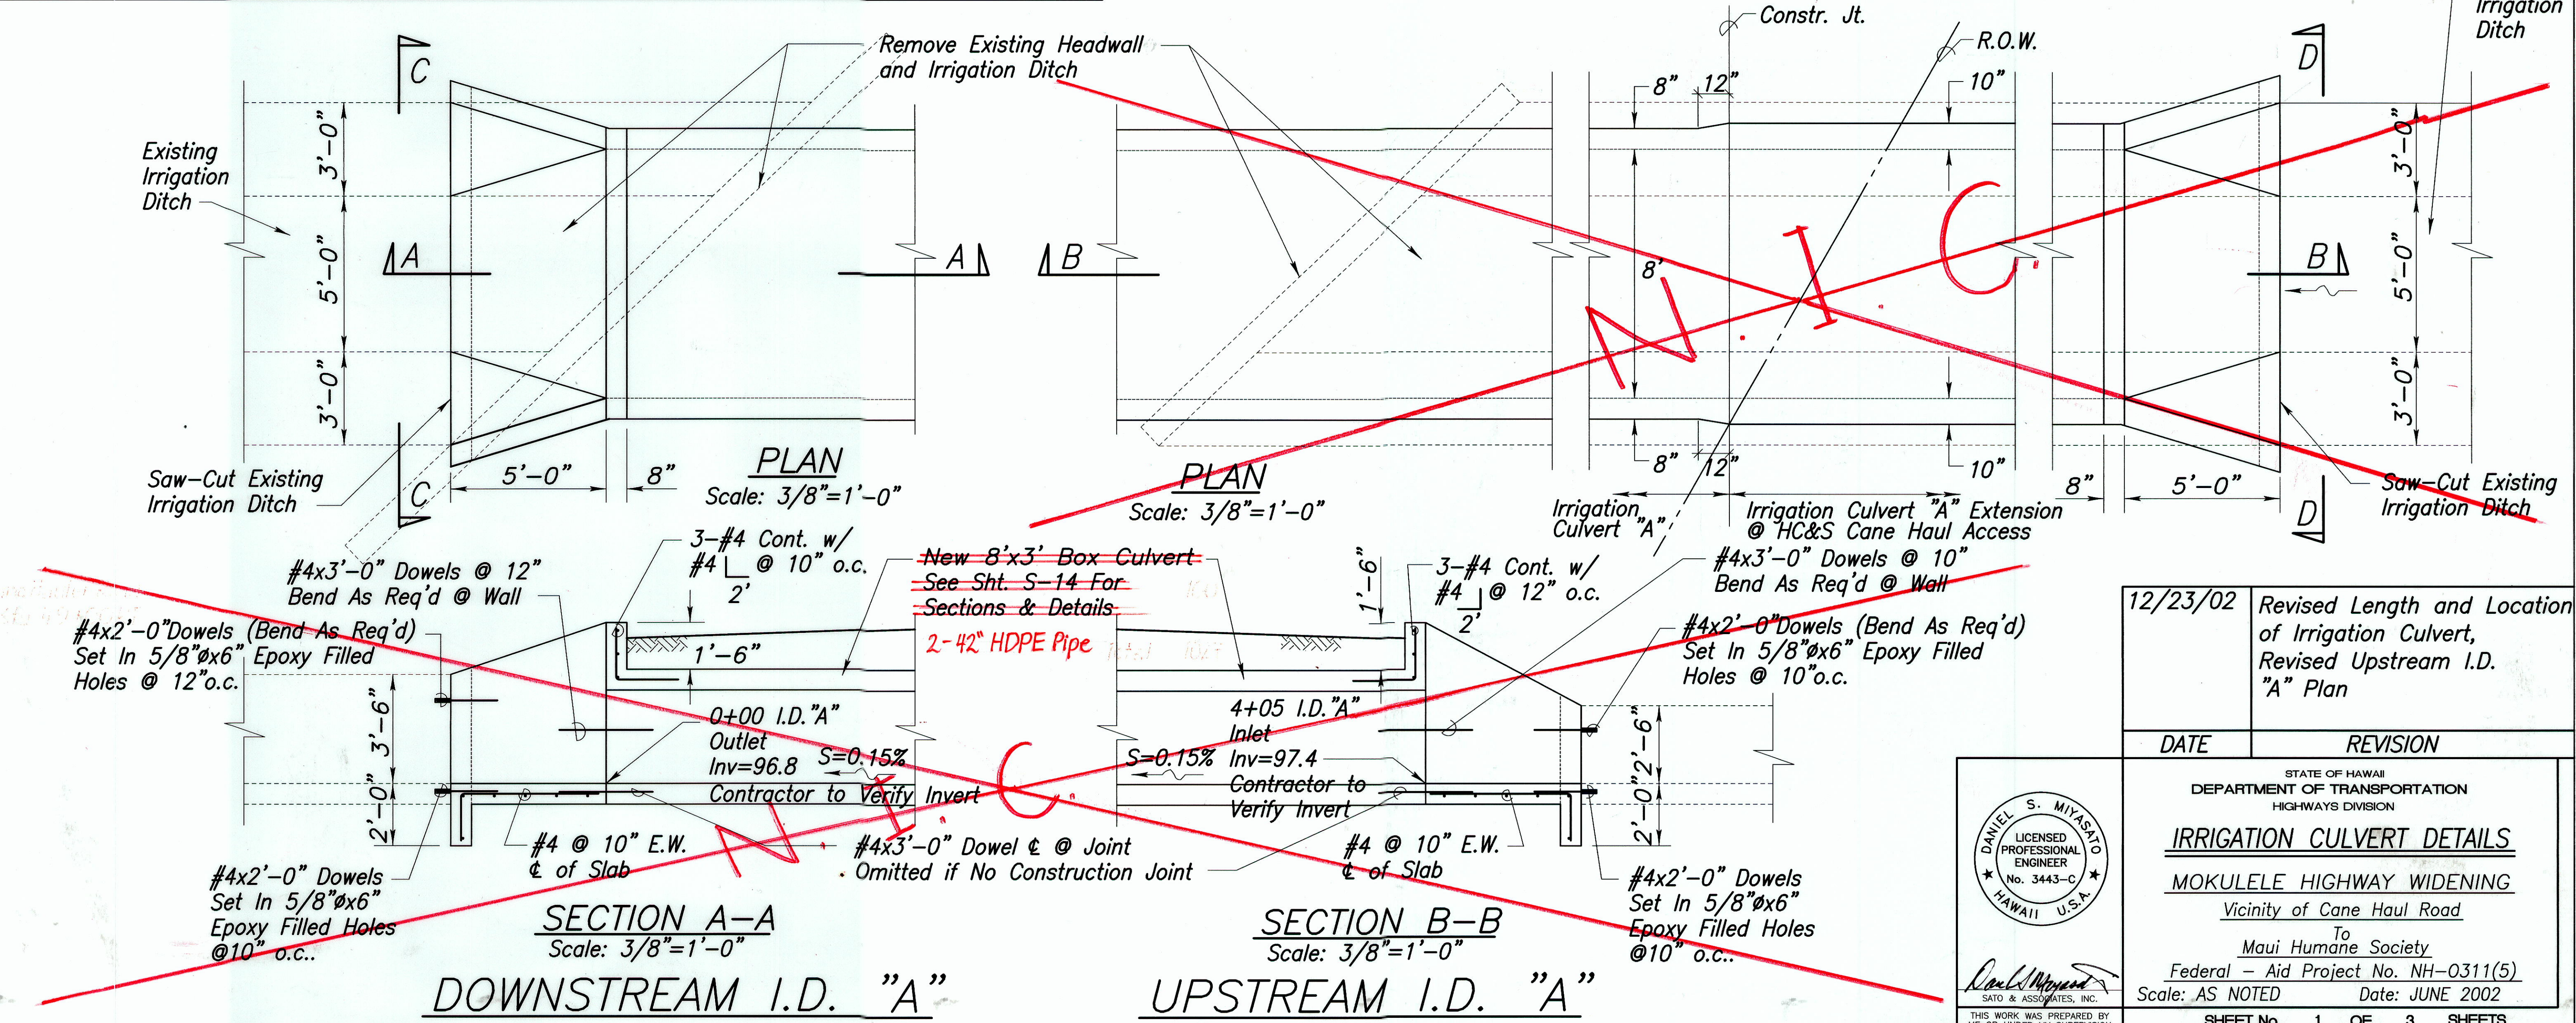

"AS-BUILT"

ADD. 81

FED. ROAD DIST. NO.	STATE	FEDERAL - AID PROJ. NO.	FISCAL YEAR	SHEET NO.	TOTAL SHEETS
HAWAII	HAW.	NH-0311(5)	2003	82	189

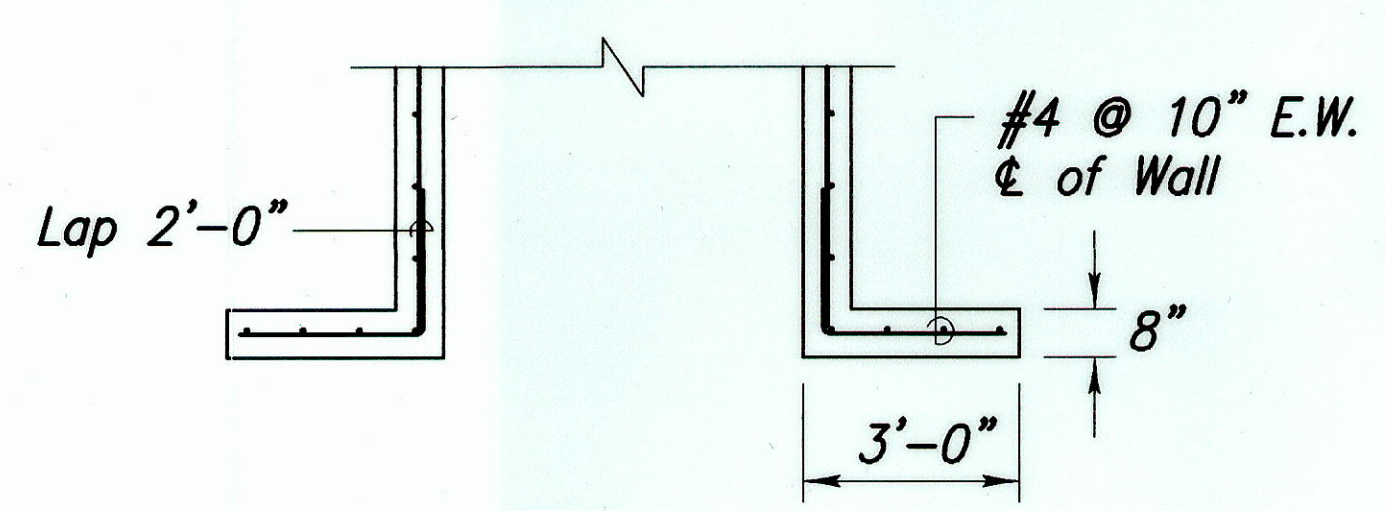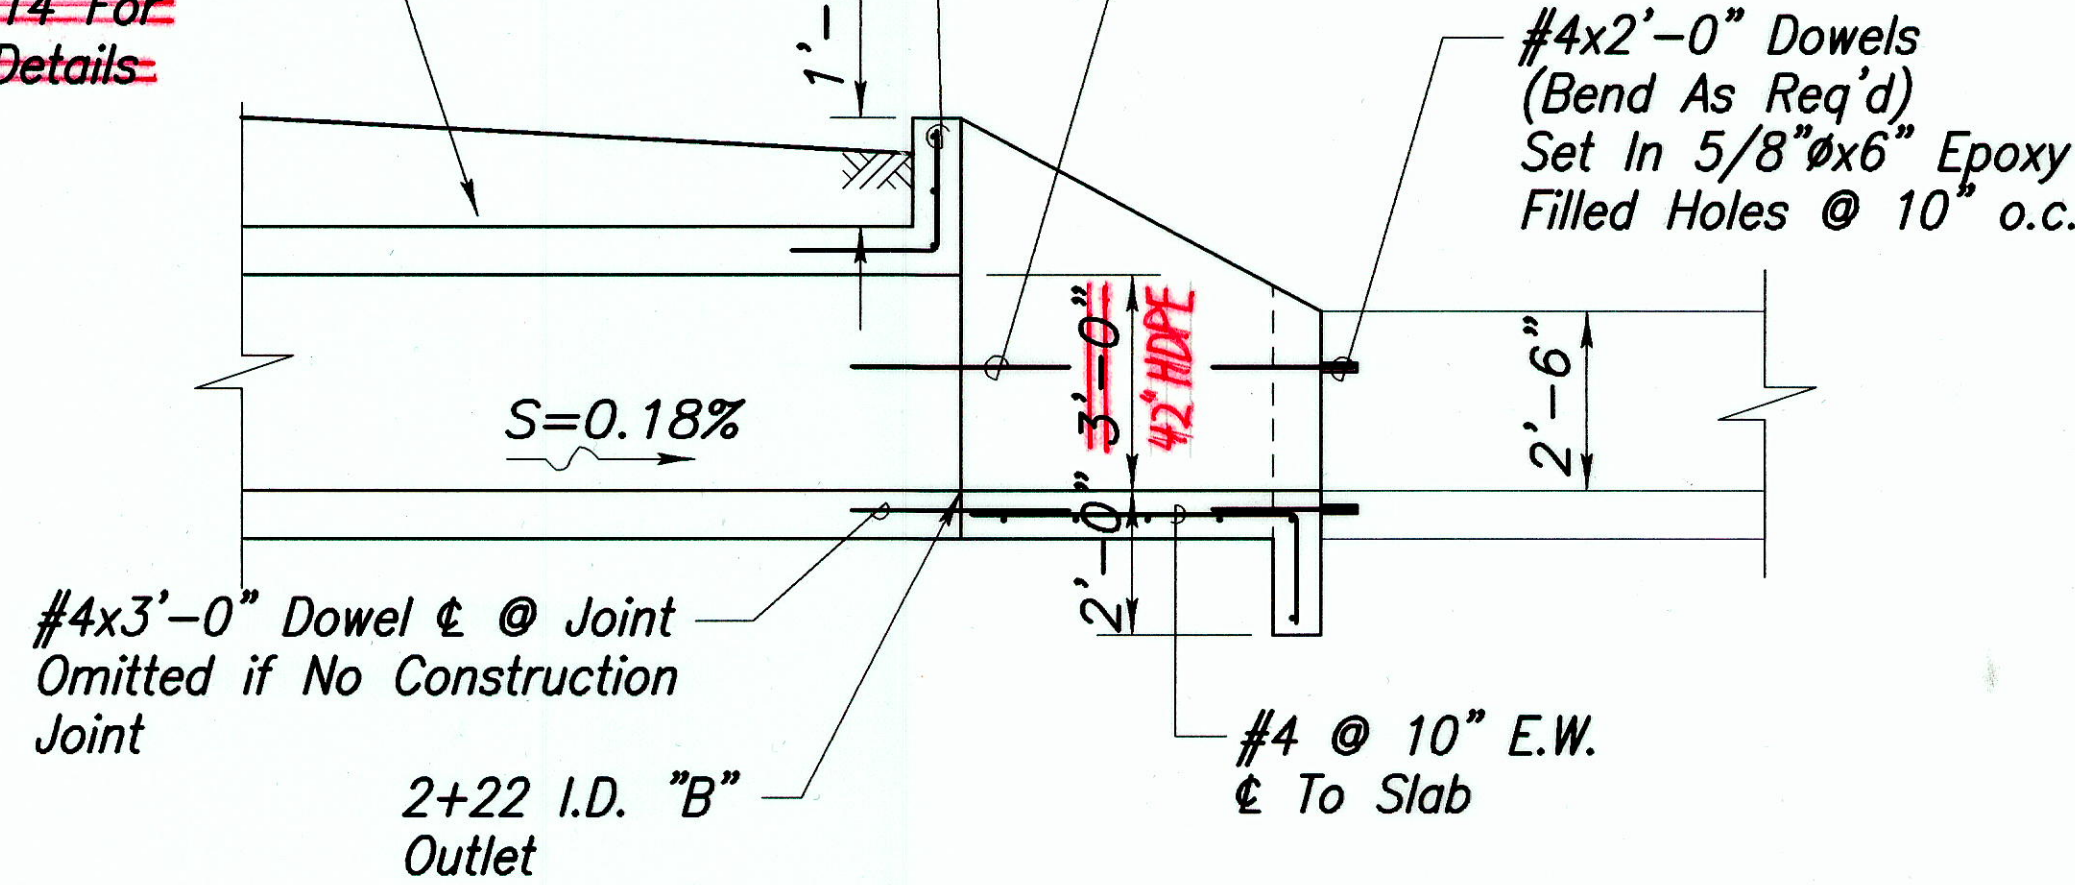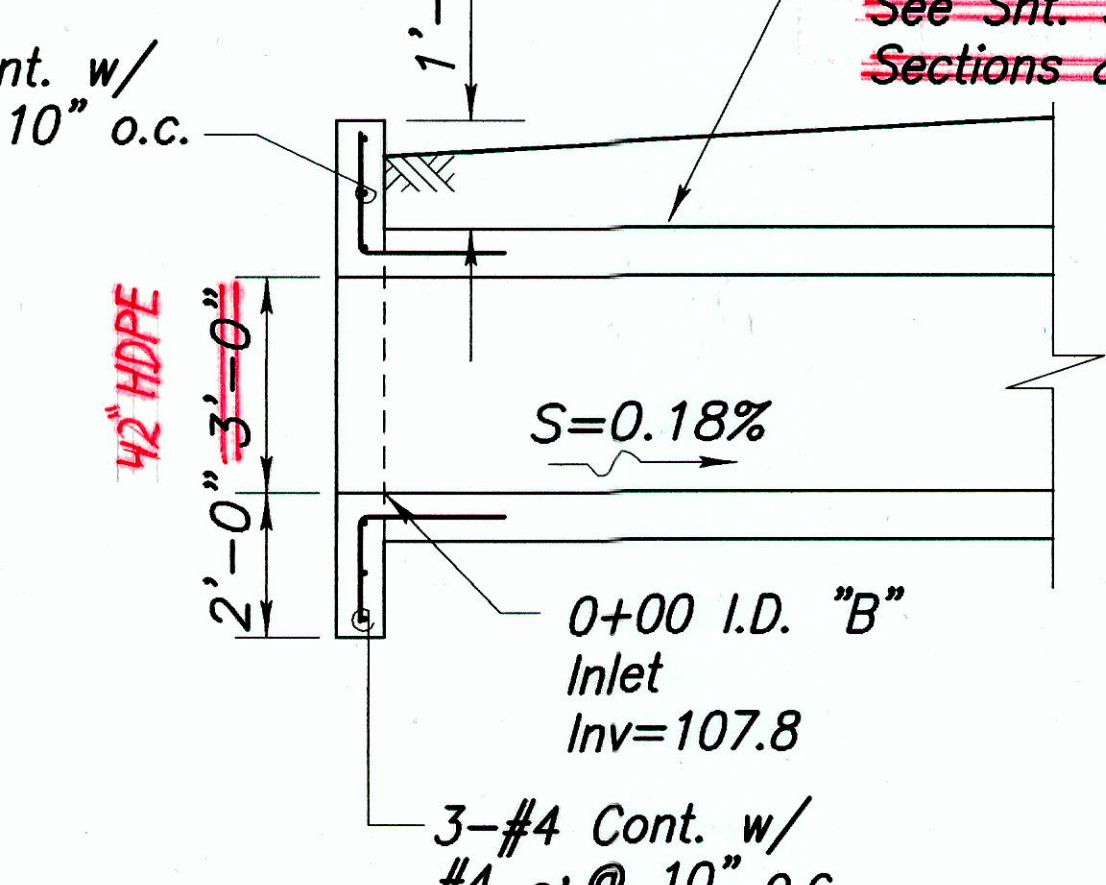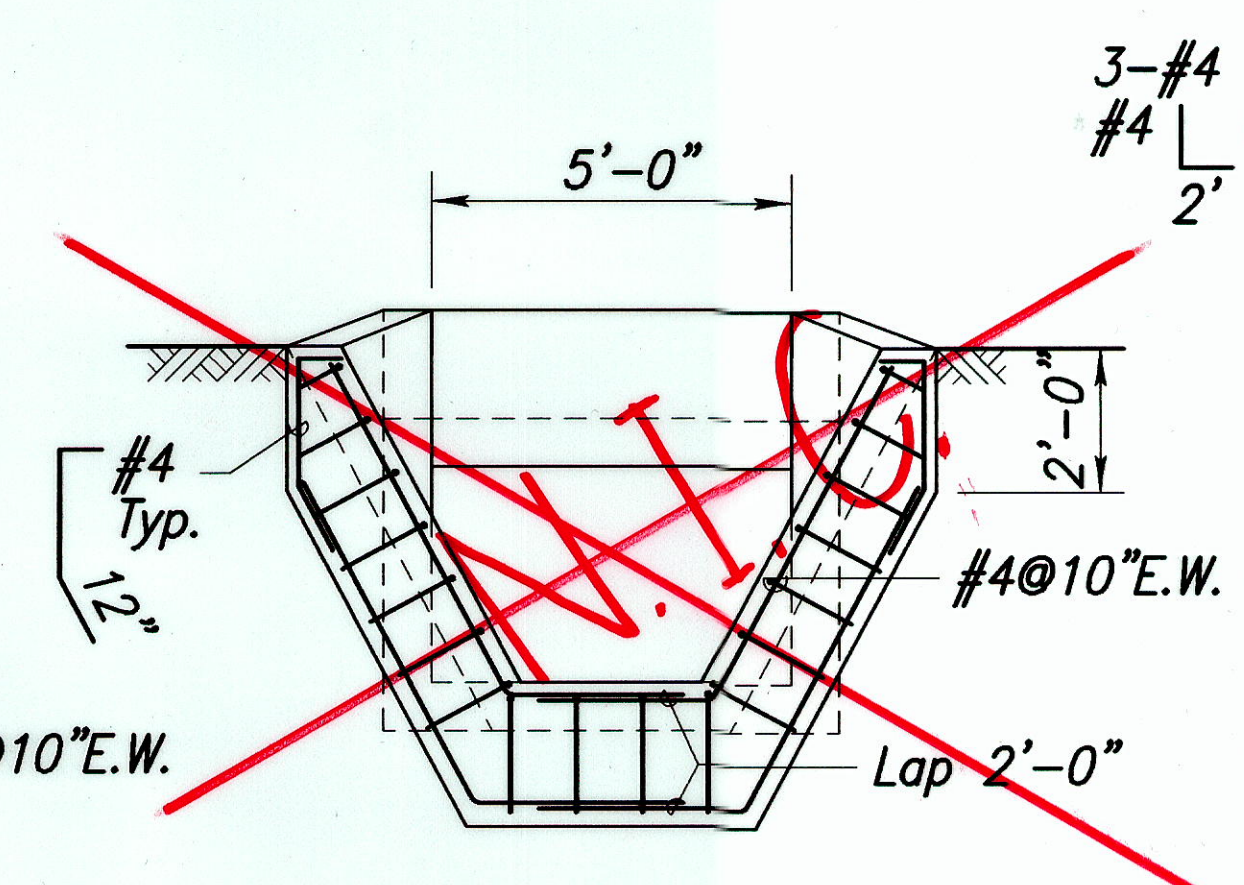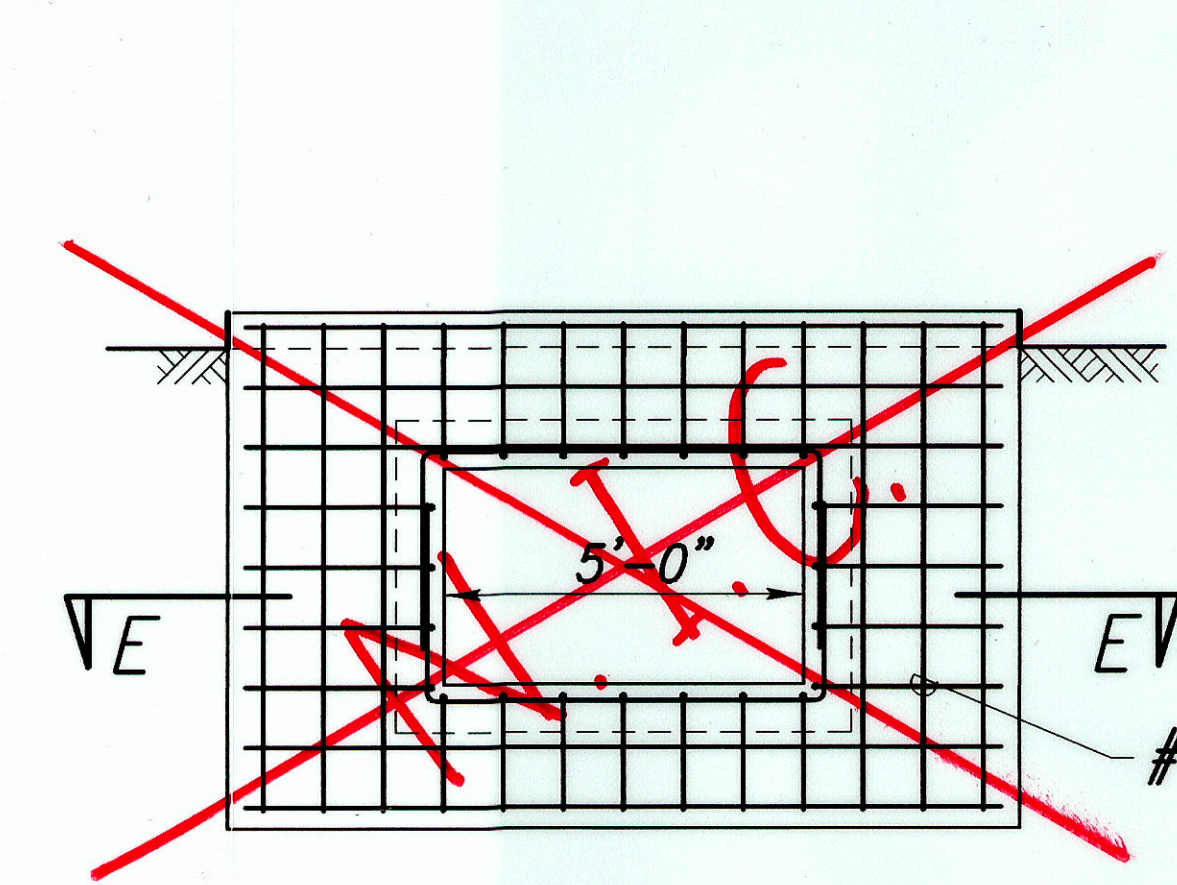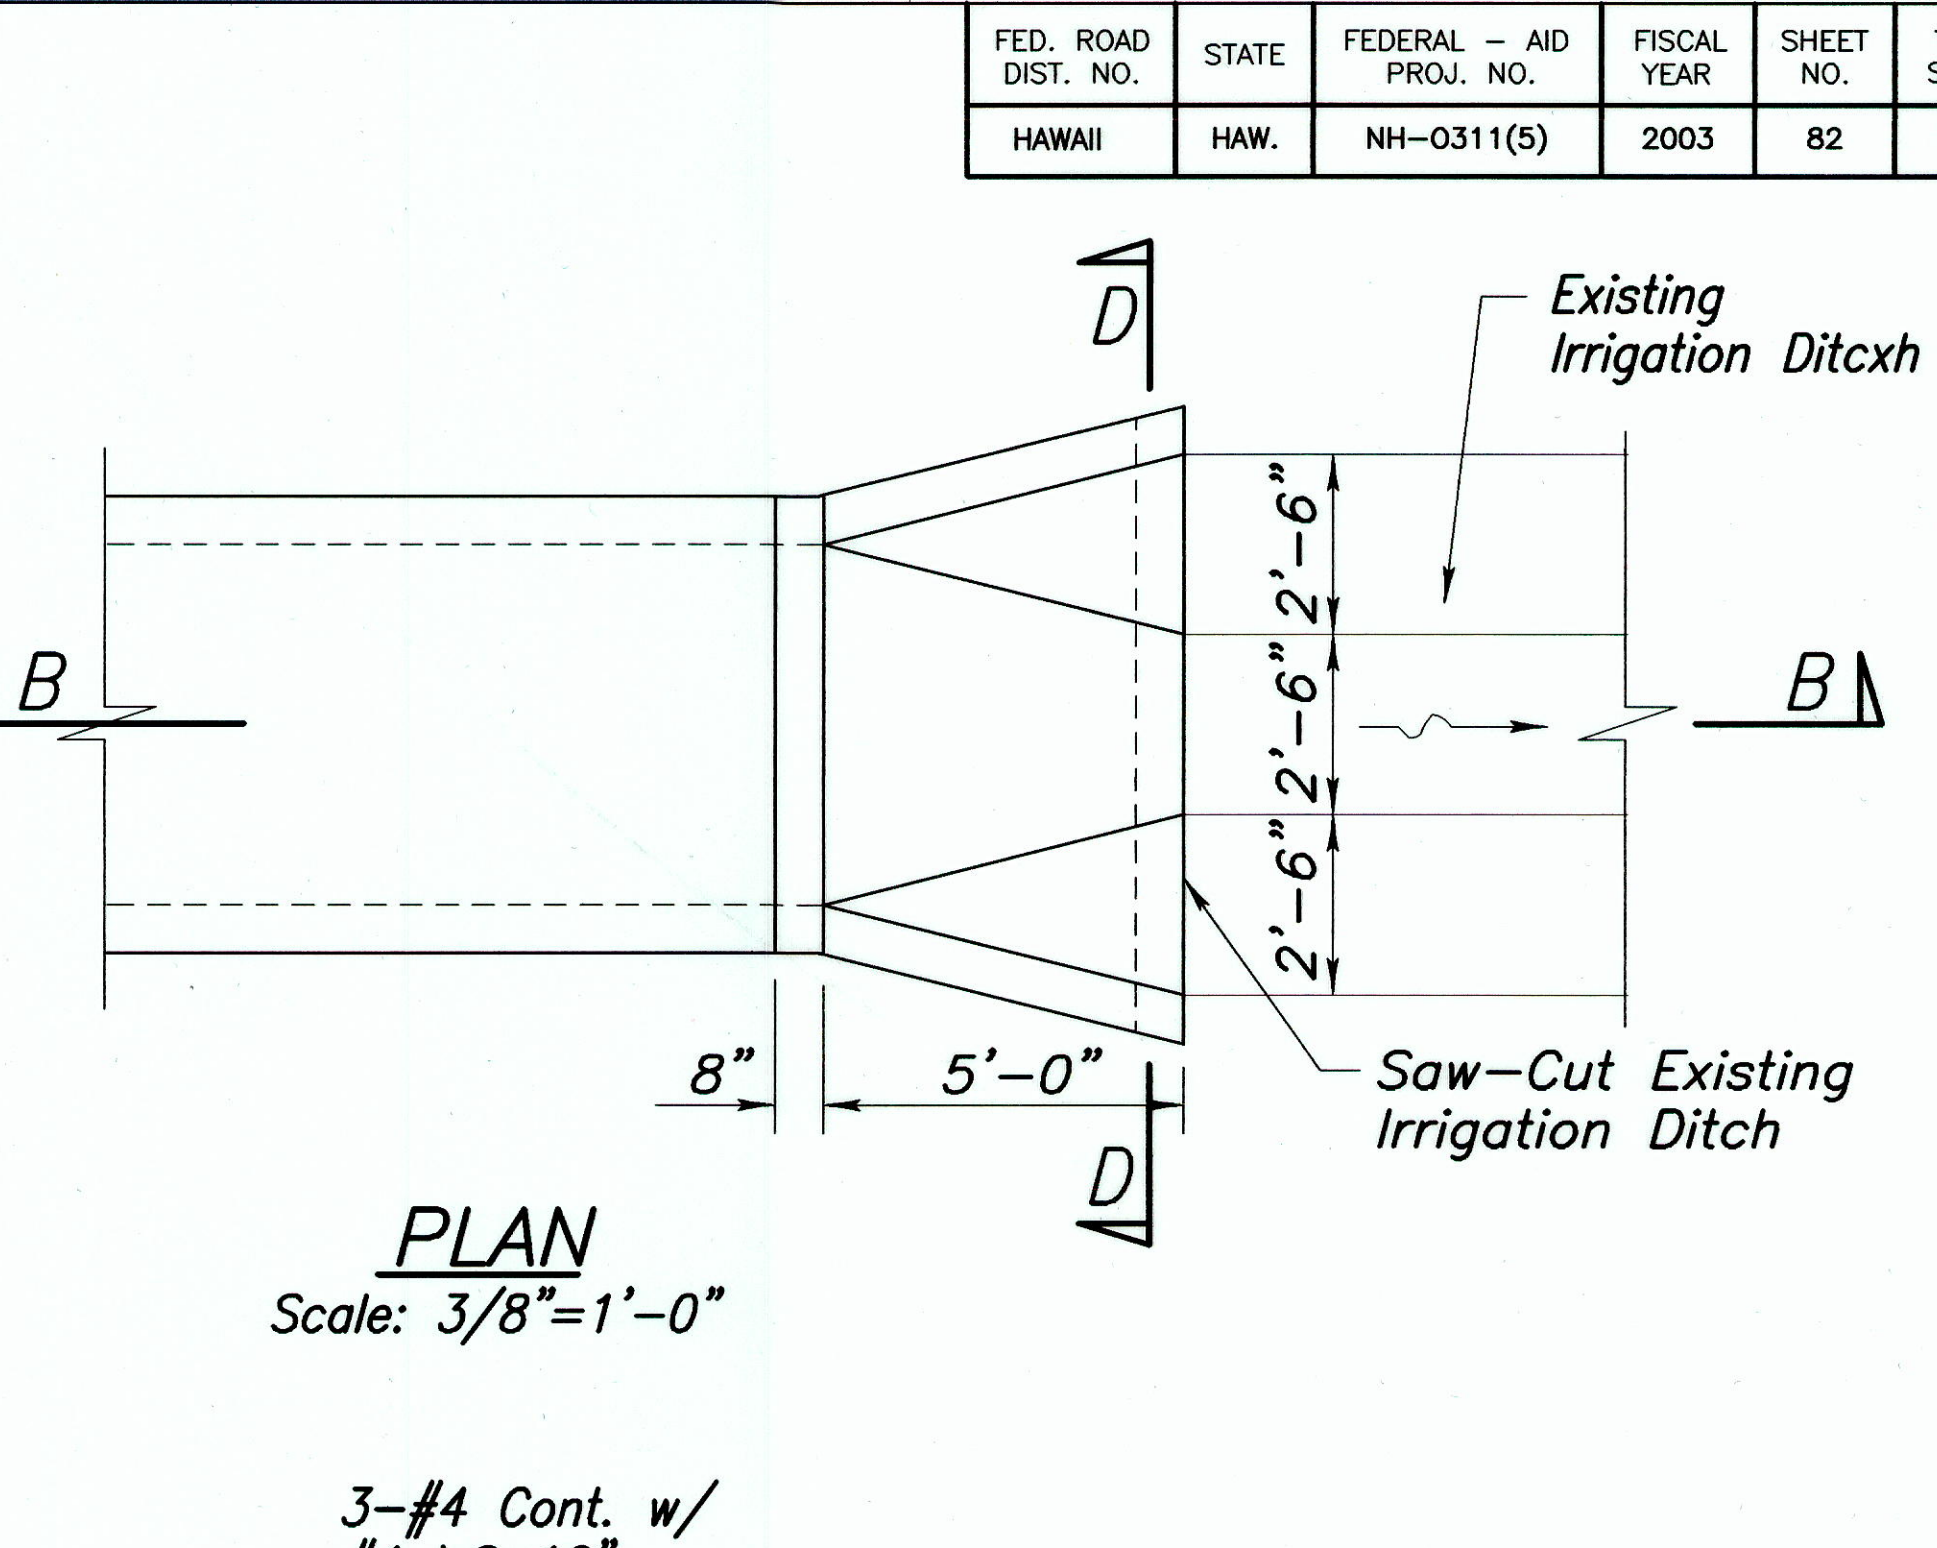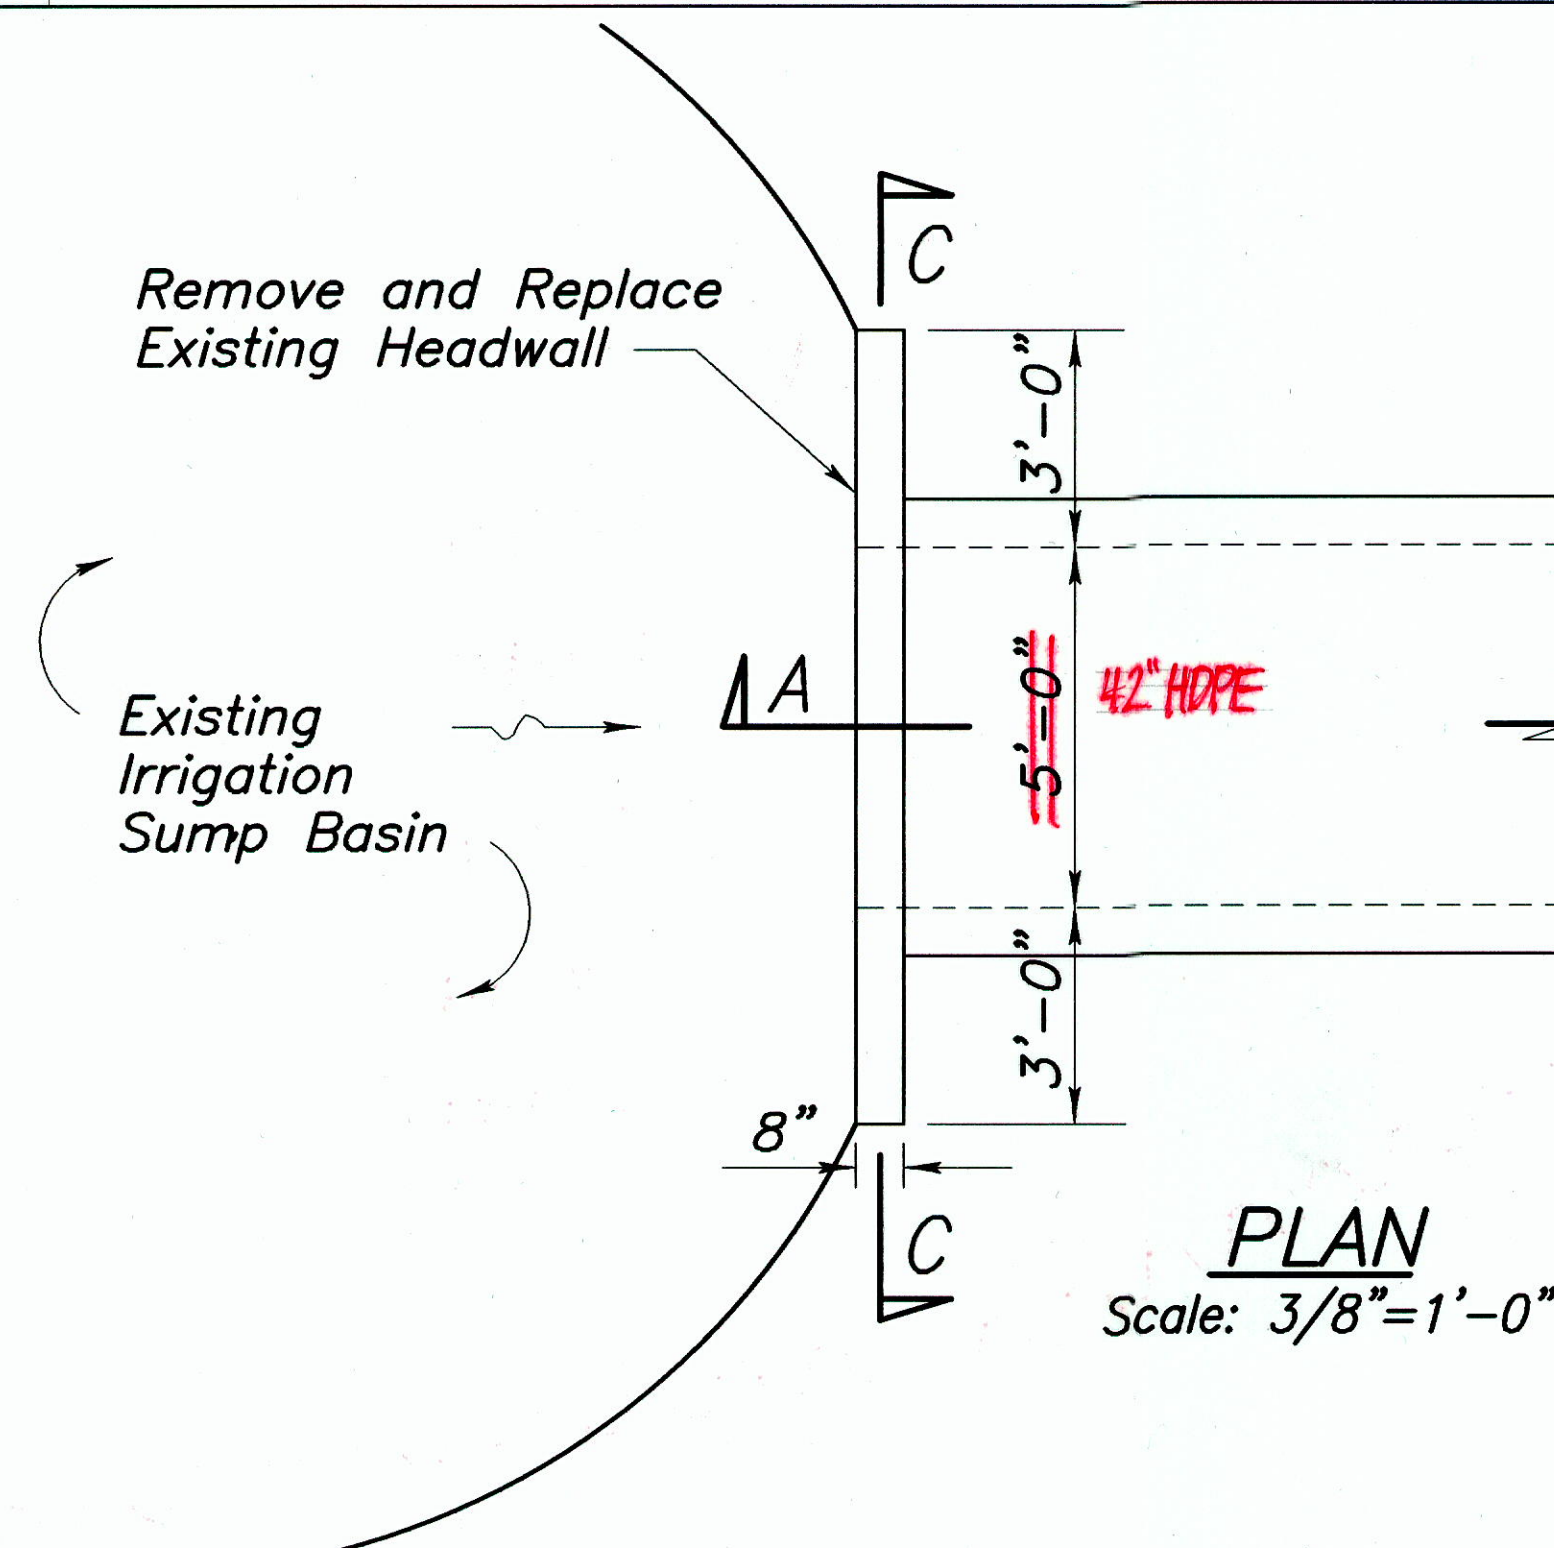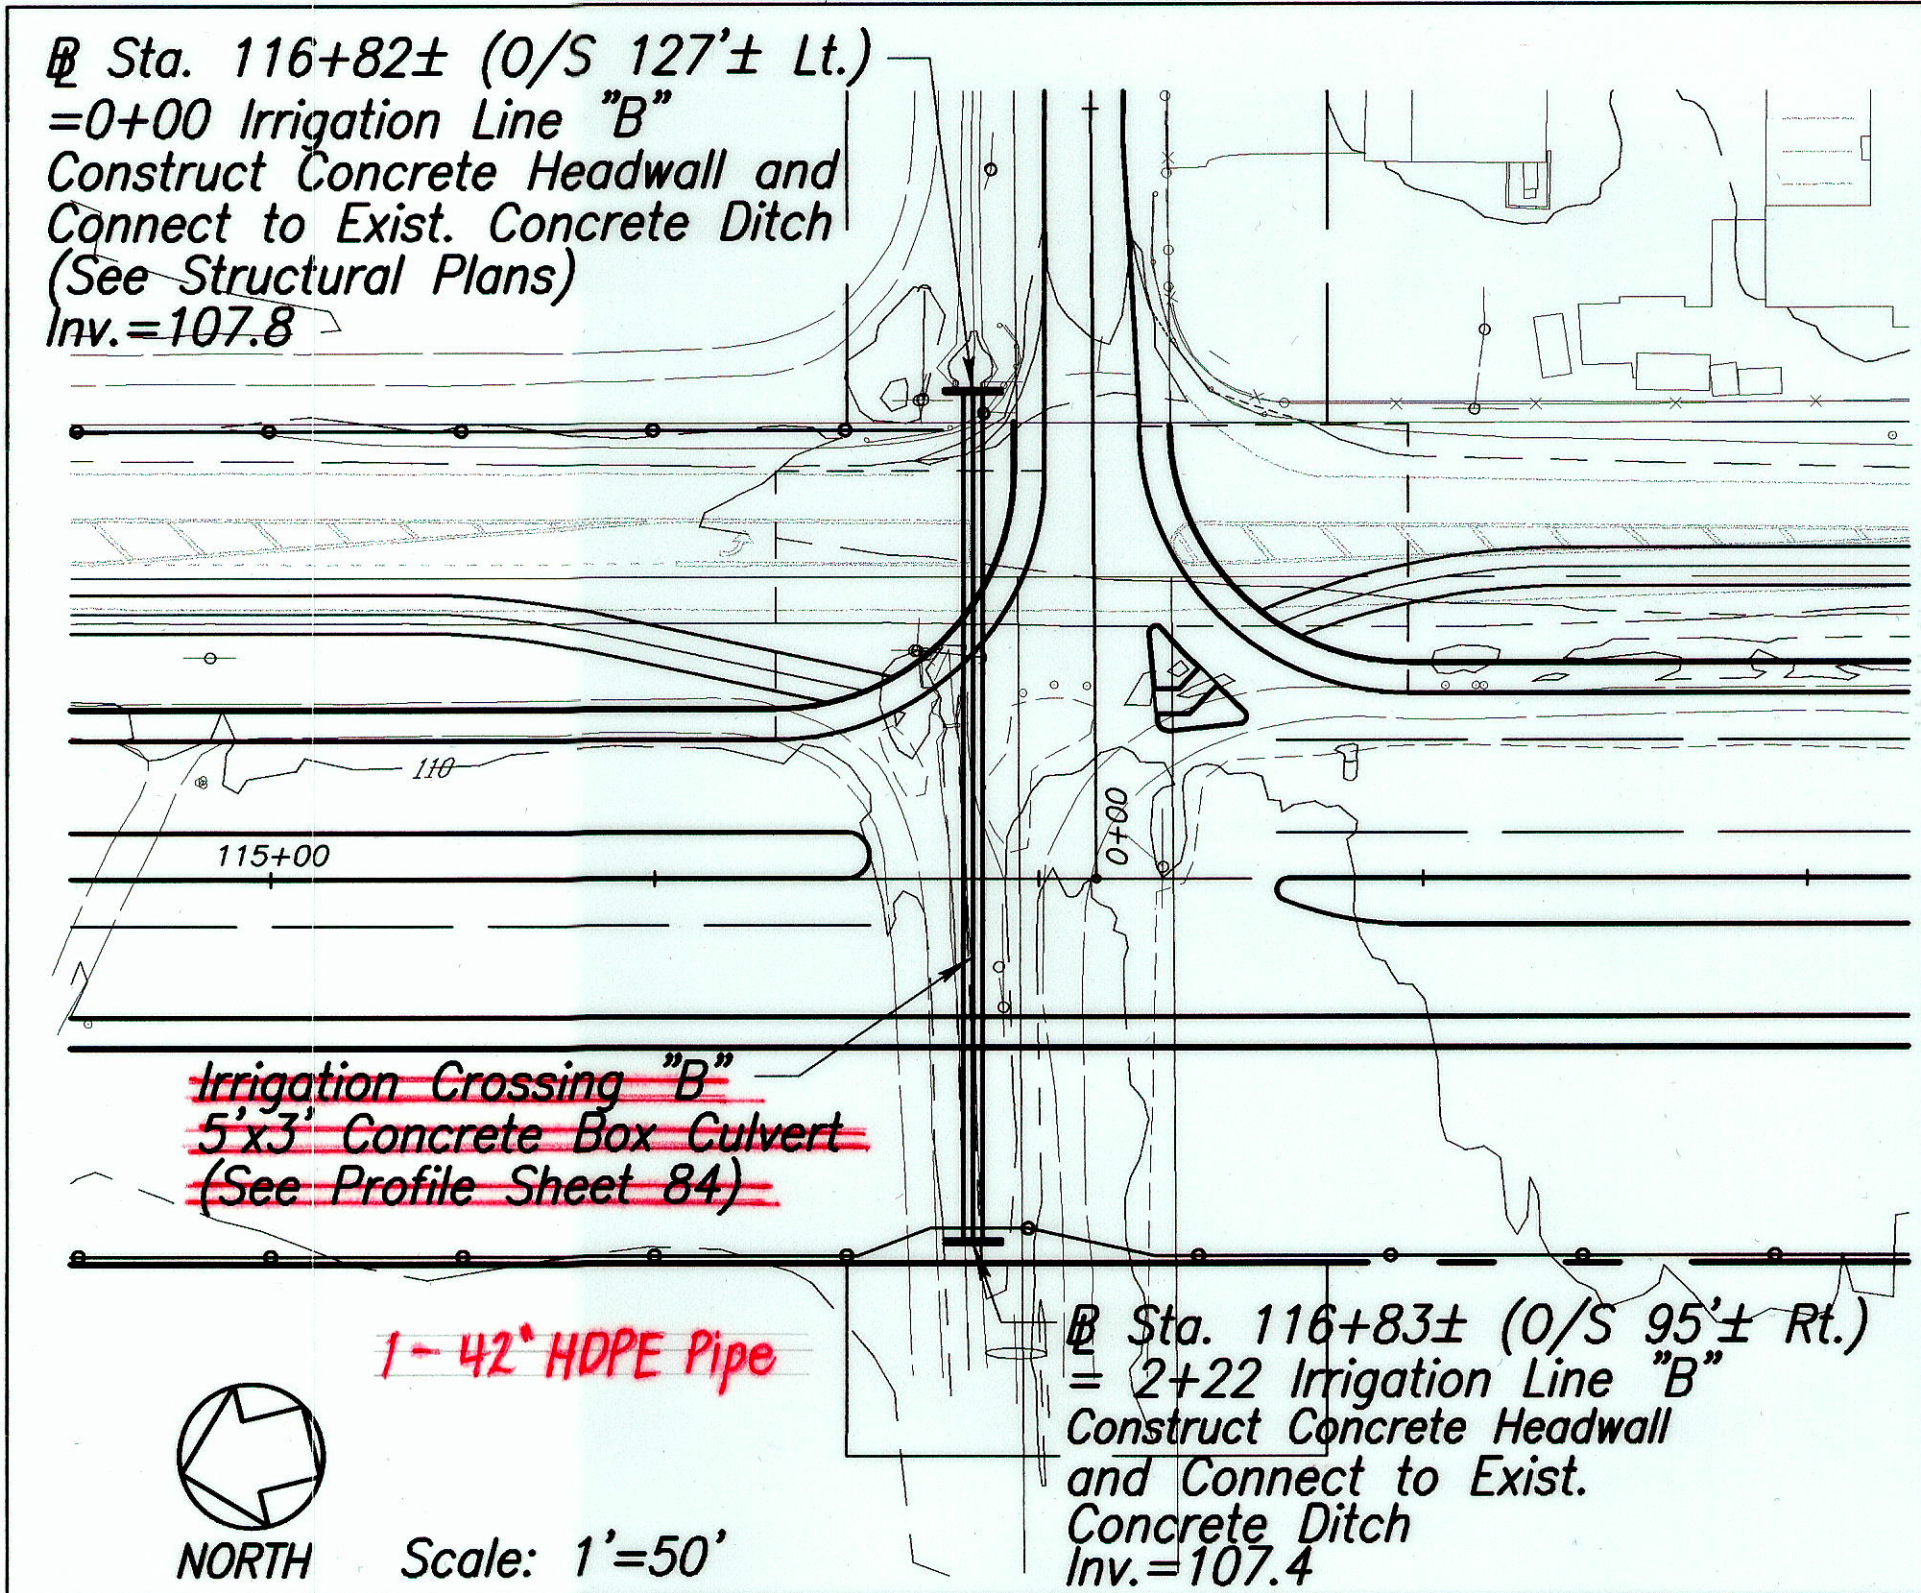

UPSTREAM I.D. "B"

DOWNSTREAM I.D. "B"

Note:
See Sht. 84 for Profiles

"AS-BUILT"

DANIEL S. MIYASATO
LICENSED PROFESSIONAL ENGINEER
No. 3443-C
HAWAII U.S.A.

STATE OF HAWAII
DEPARTMENT OF TRANSPORTATION
HIGHWAYS DIVISION









IRRIGATION CULVERT DETAILS

MOKULELE HIGHWAY WIDENING

Vicinity of Cane Haul Road
To
Maui Humane Society
Federal - Aid Project No. NH-0311(5)
Scale: AS NOTED Date: JUNE 2002

SHEET No. 2 OF 3 SHEETS

FED. ROAD DIST. NO.	STATE	FEDERAL - AID PROJ. NO.	FISCAL YEAR	SHEET NO.	TOTAL SHEETS
HAWAII	HAW.	NH-0311(5)	2003	83	189

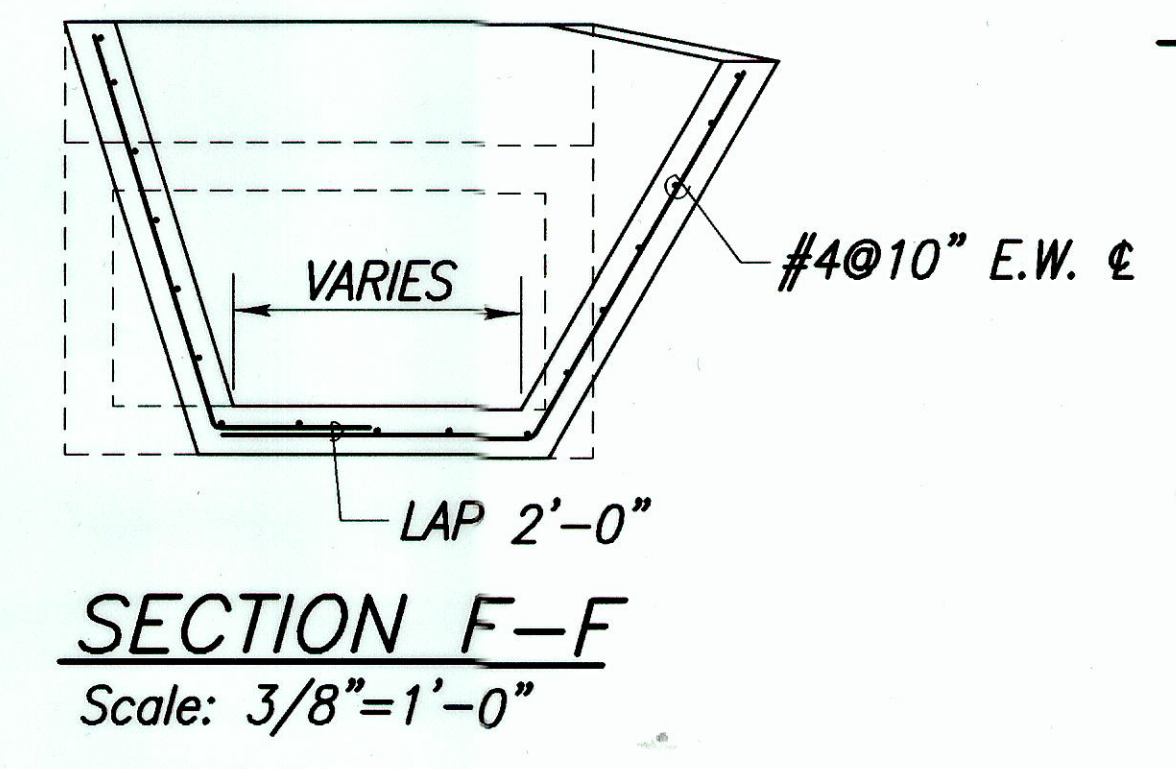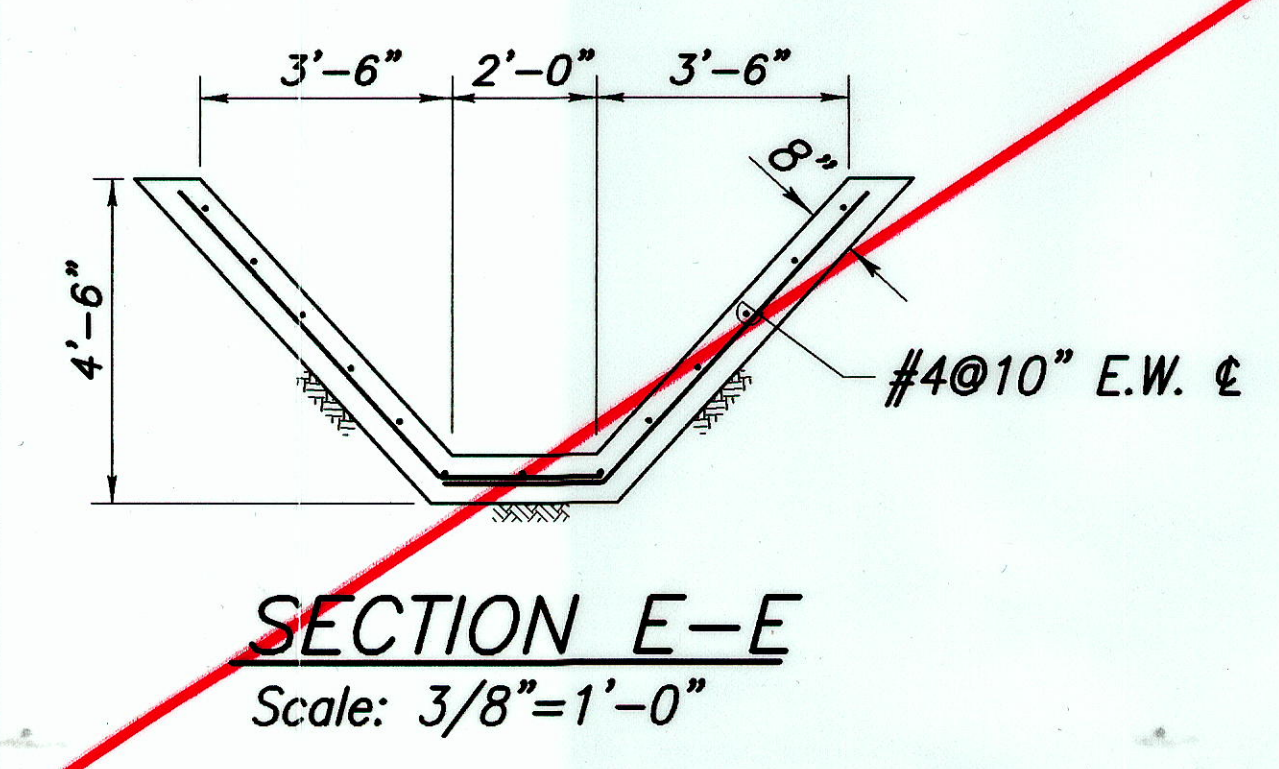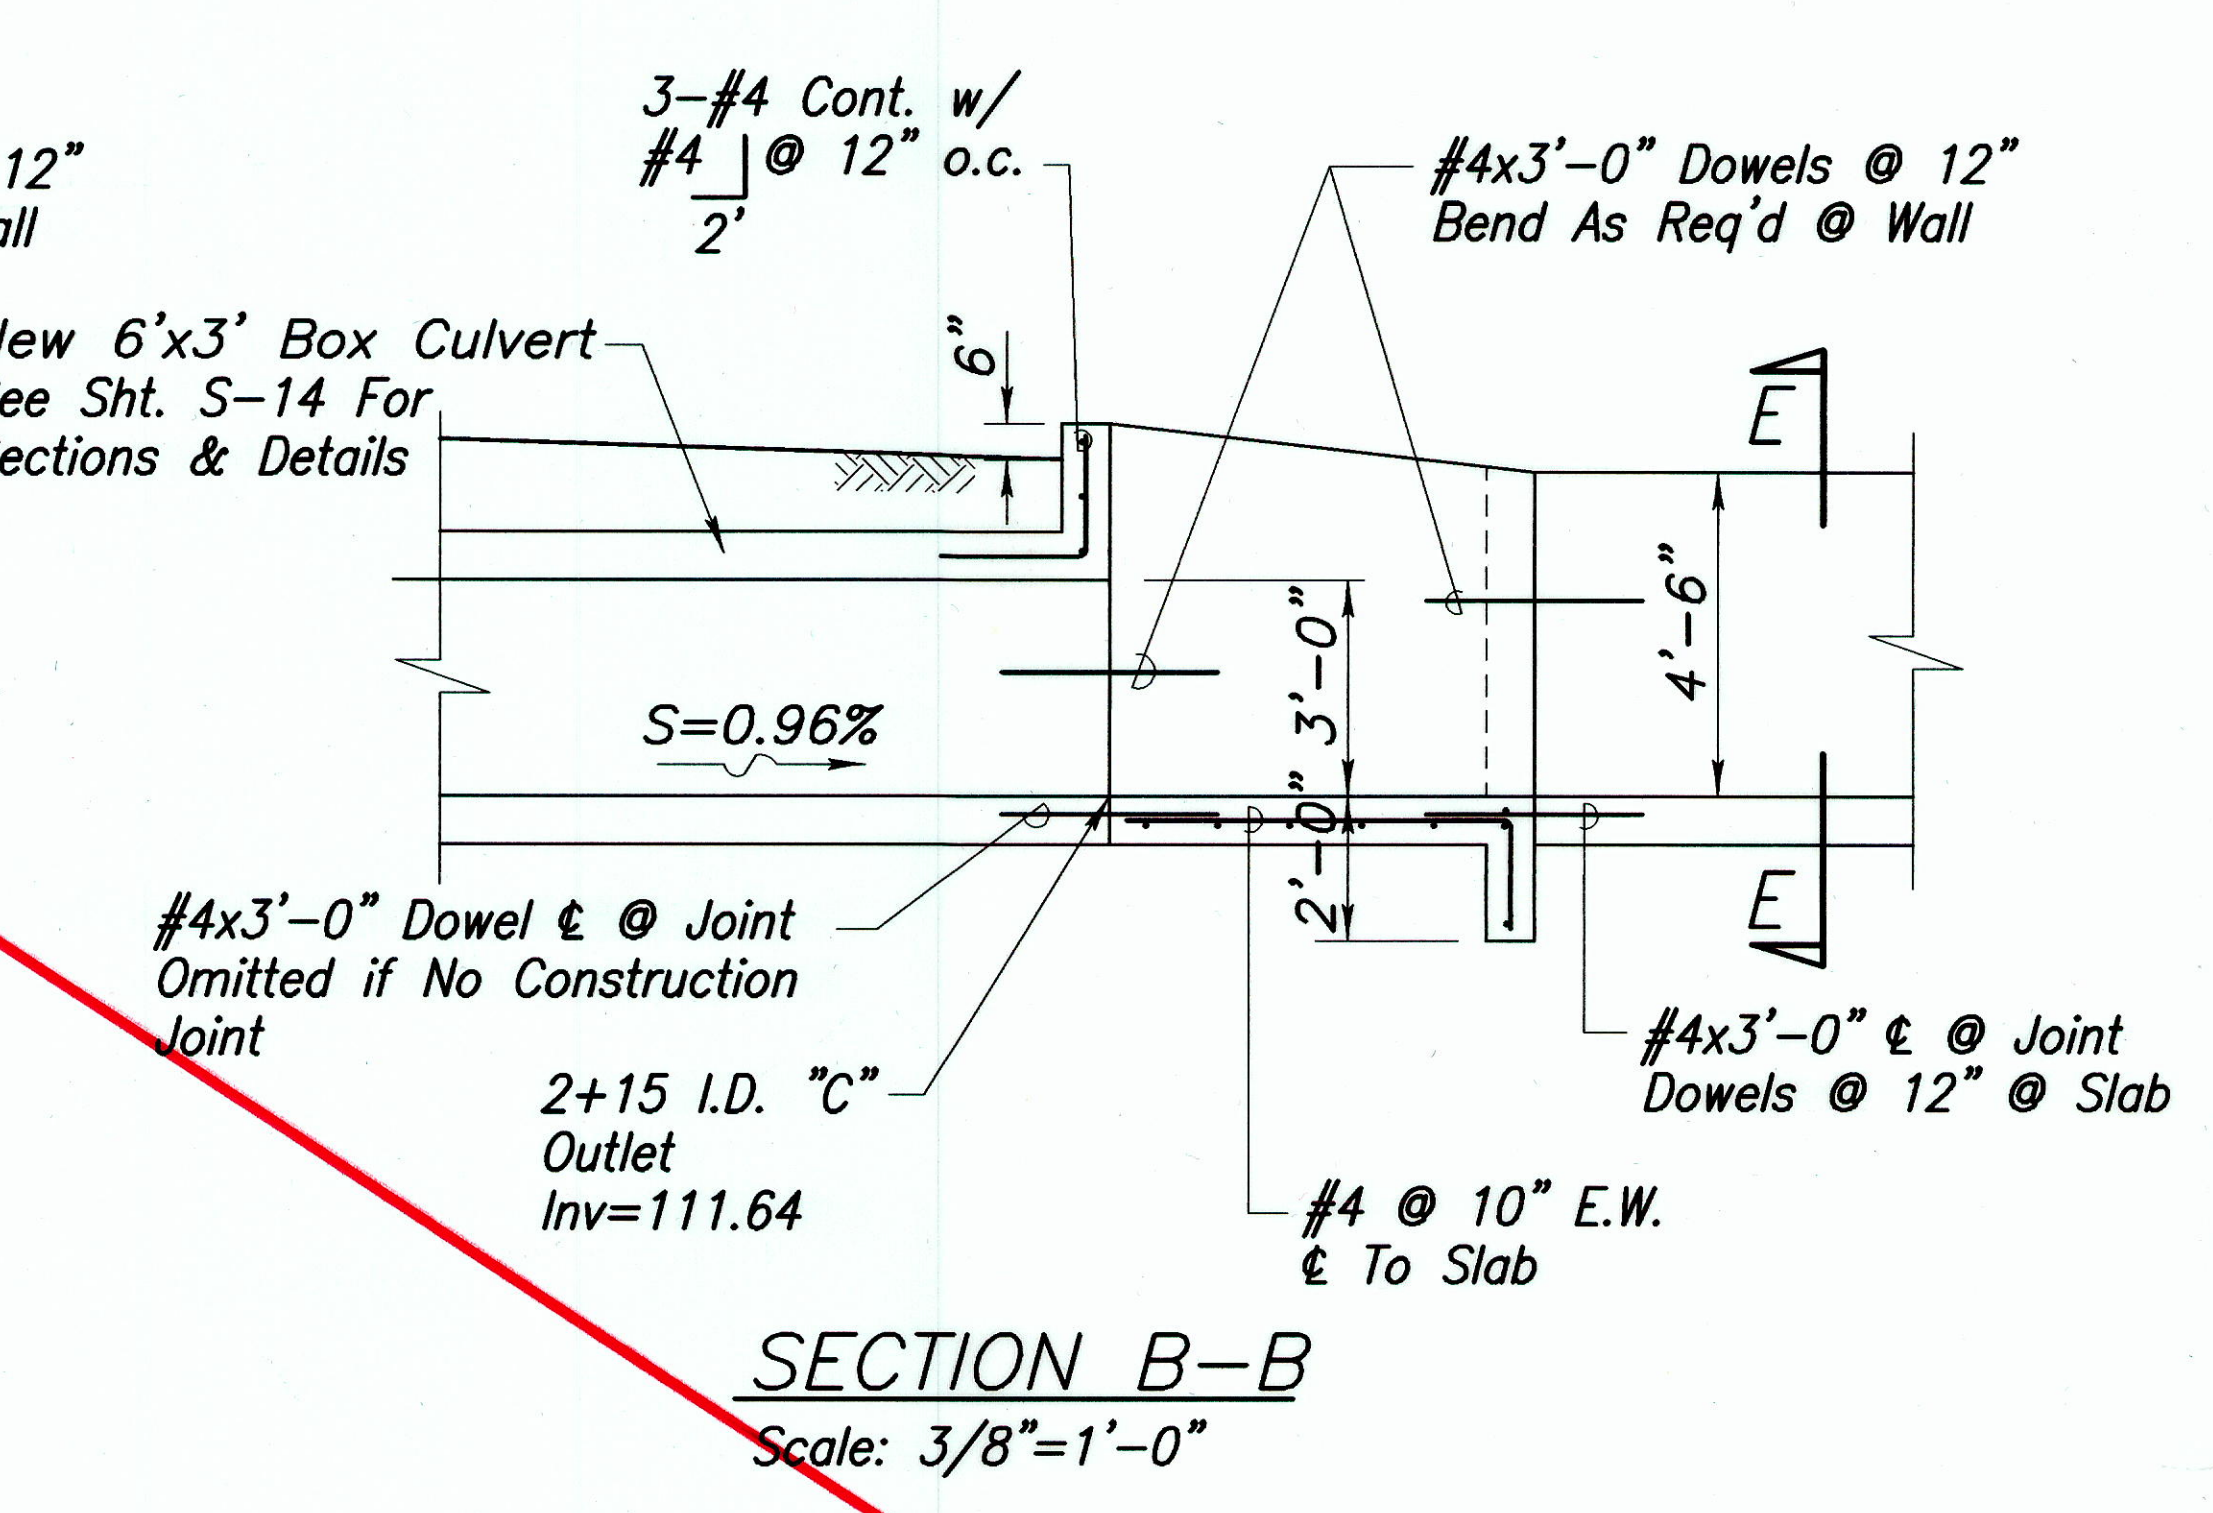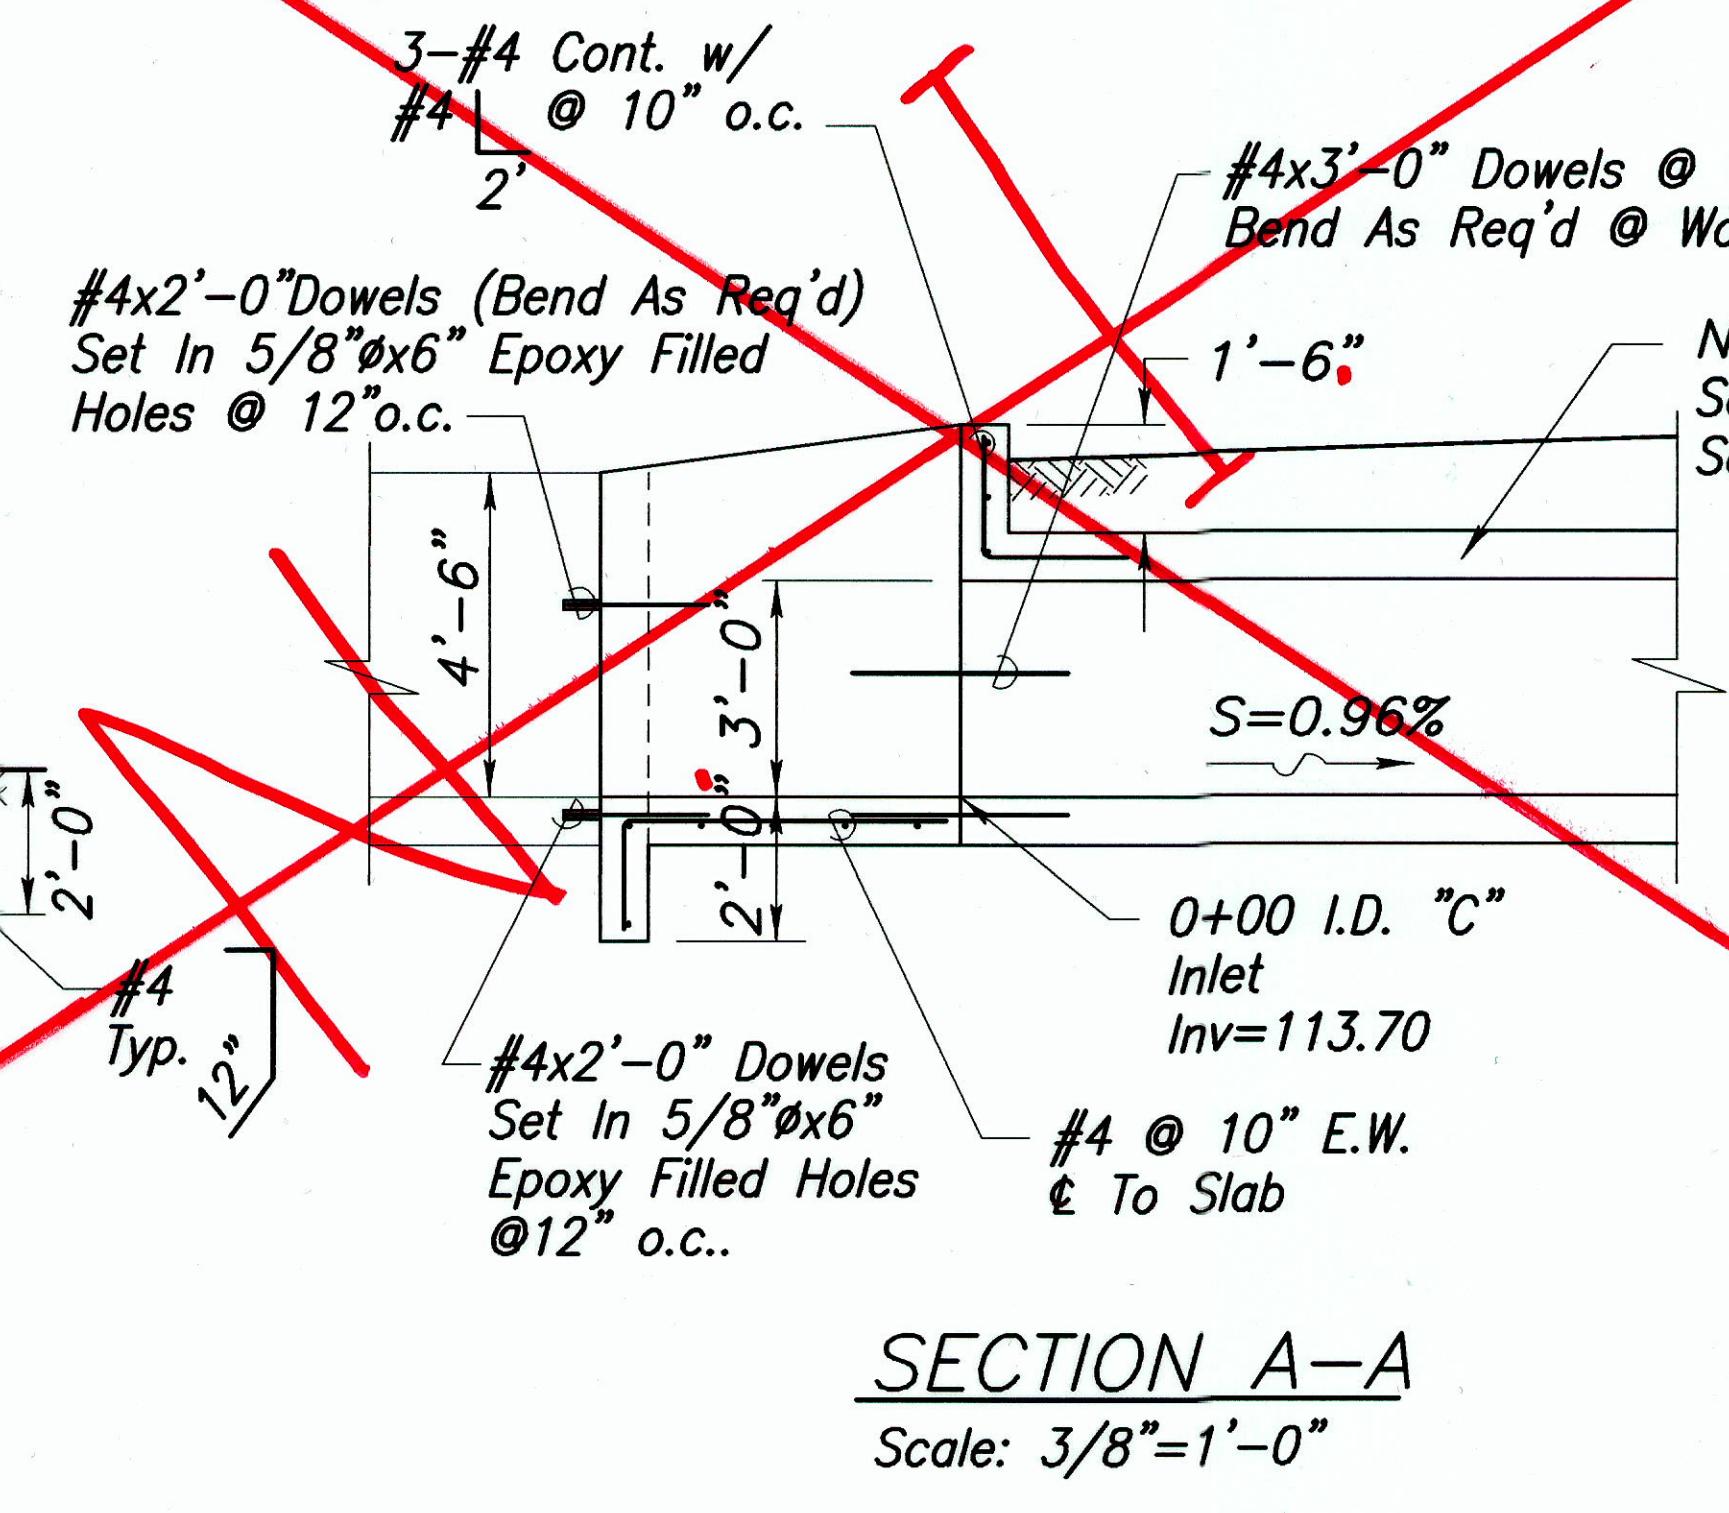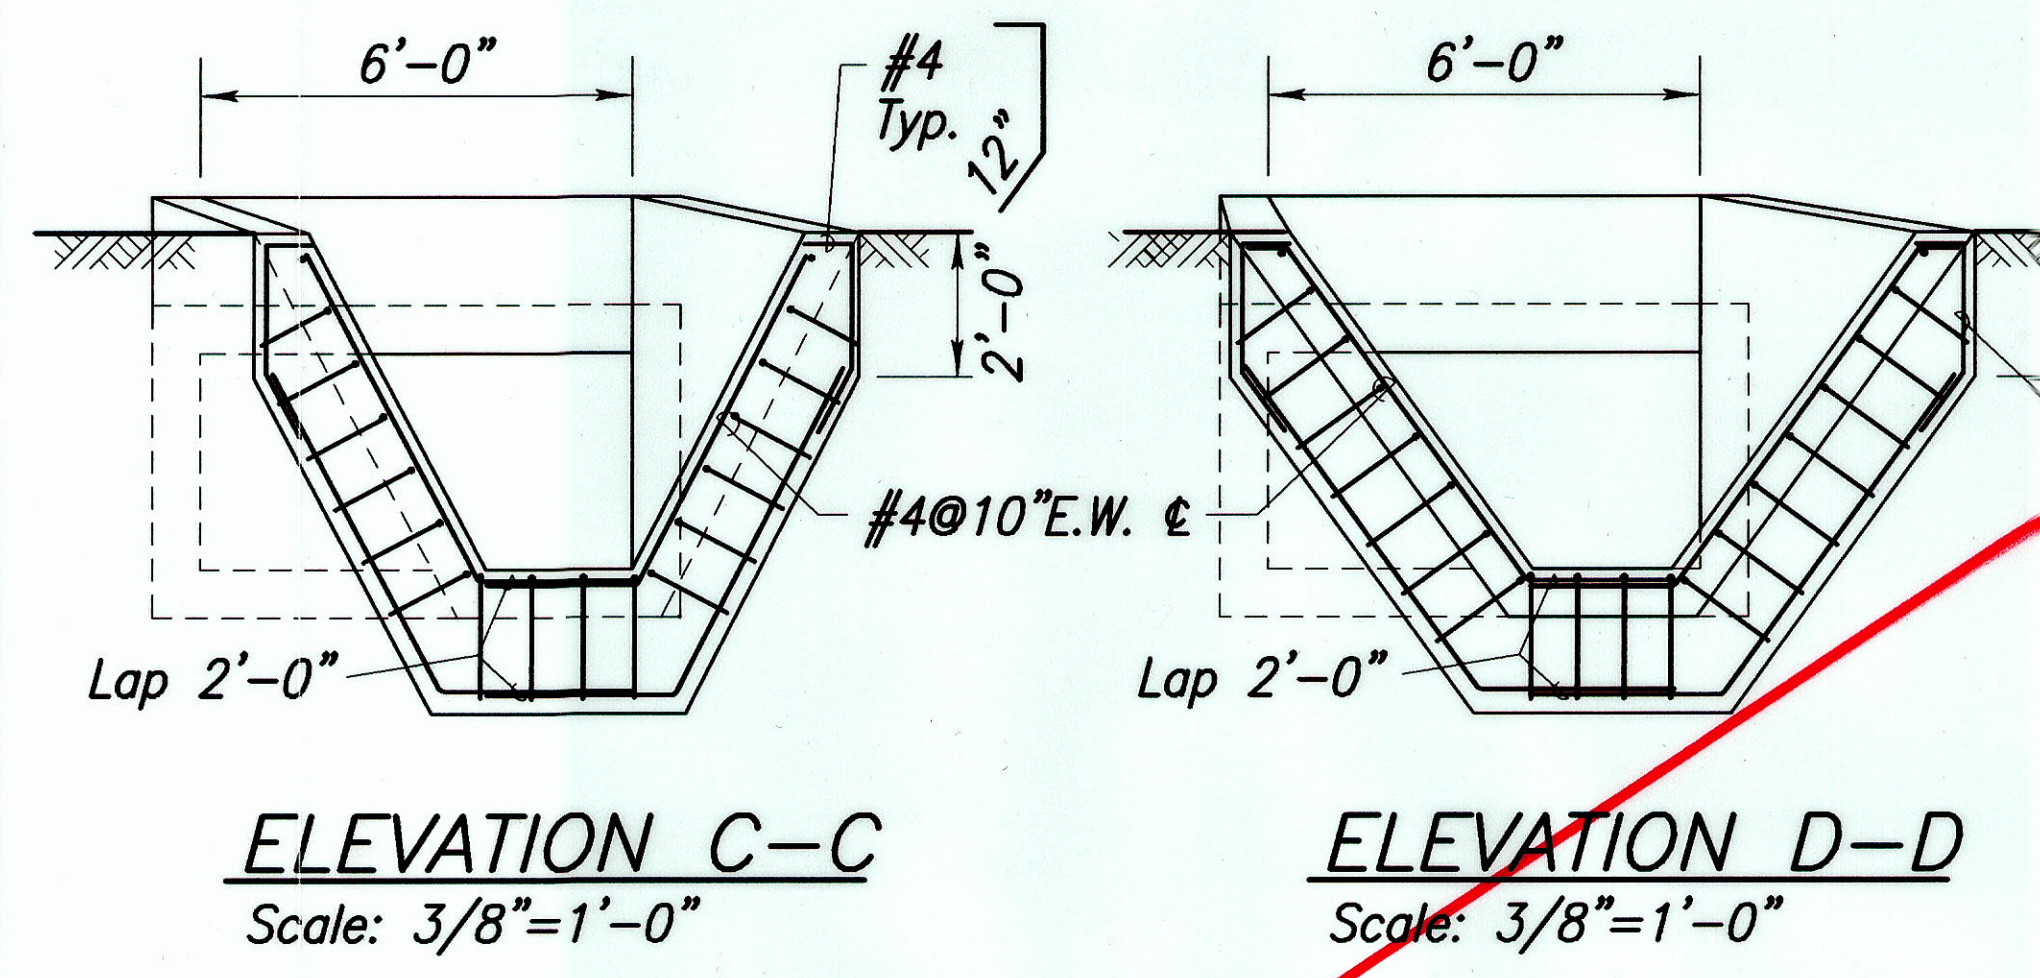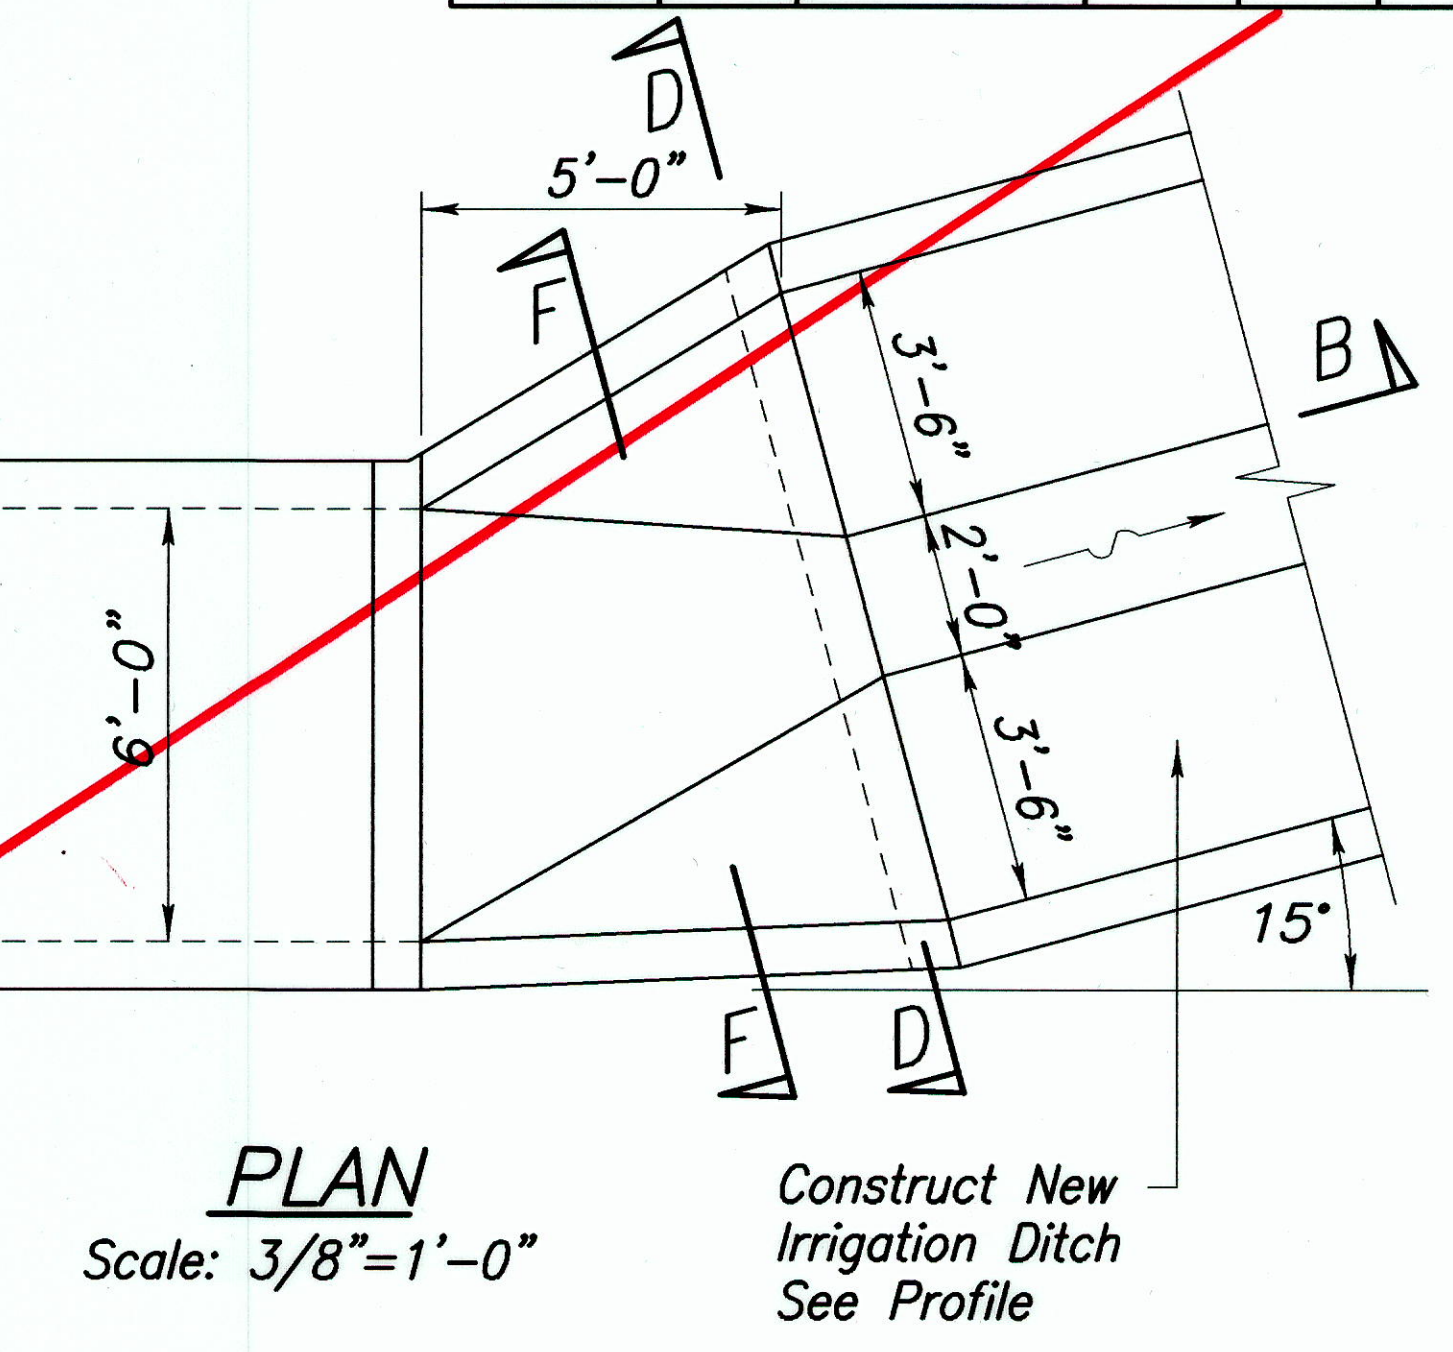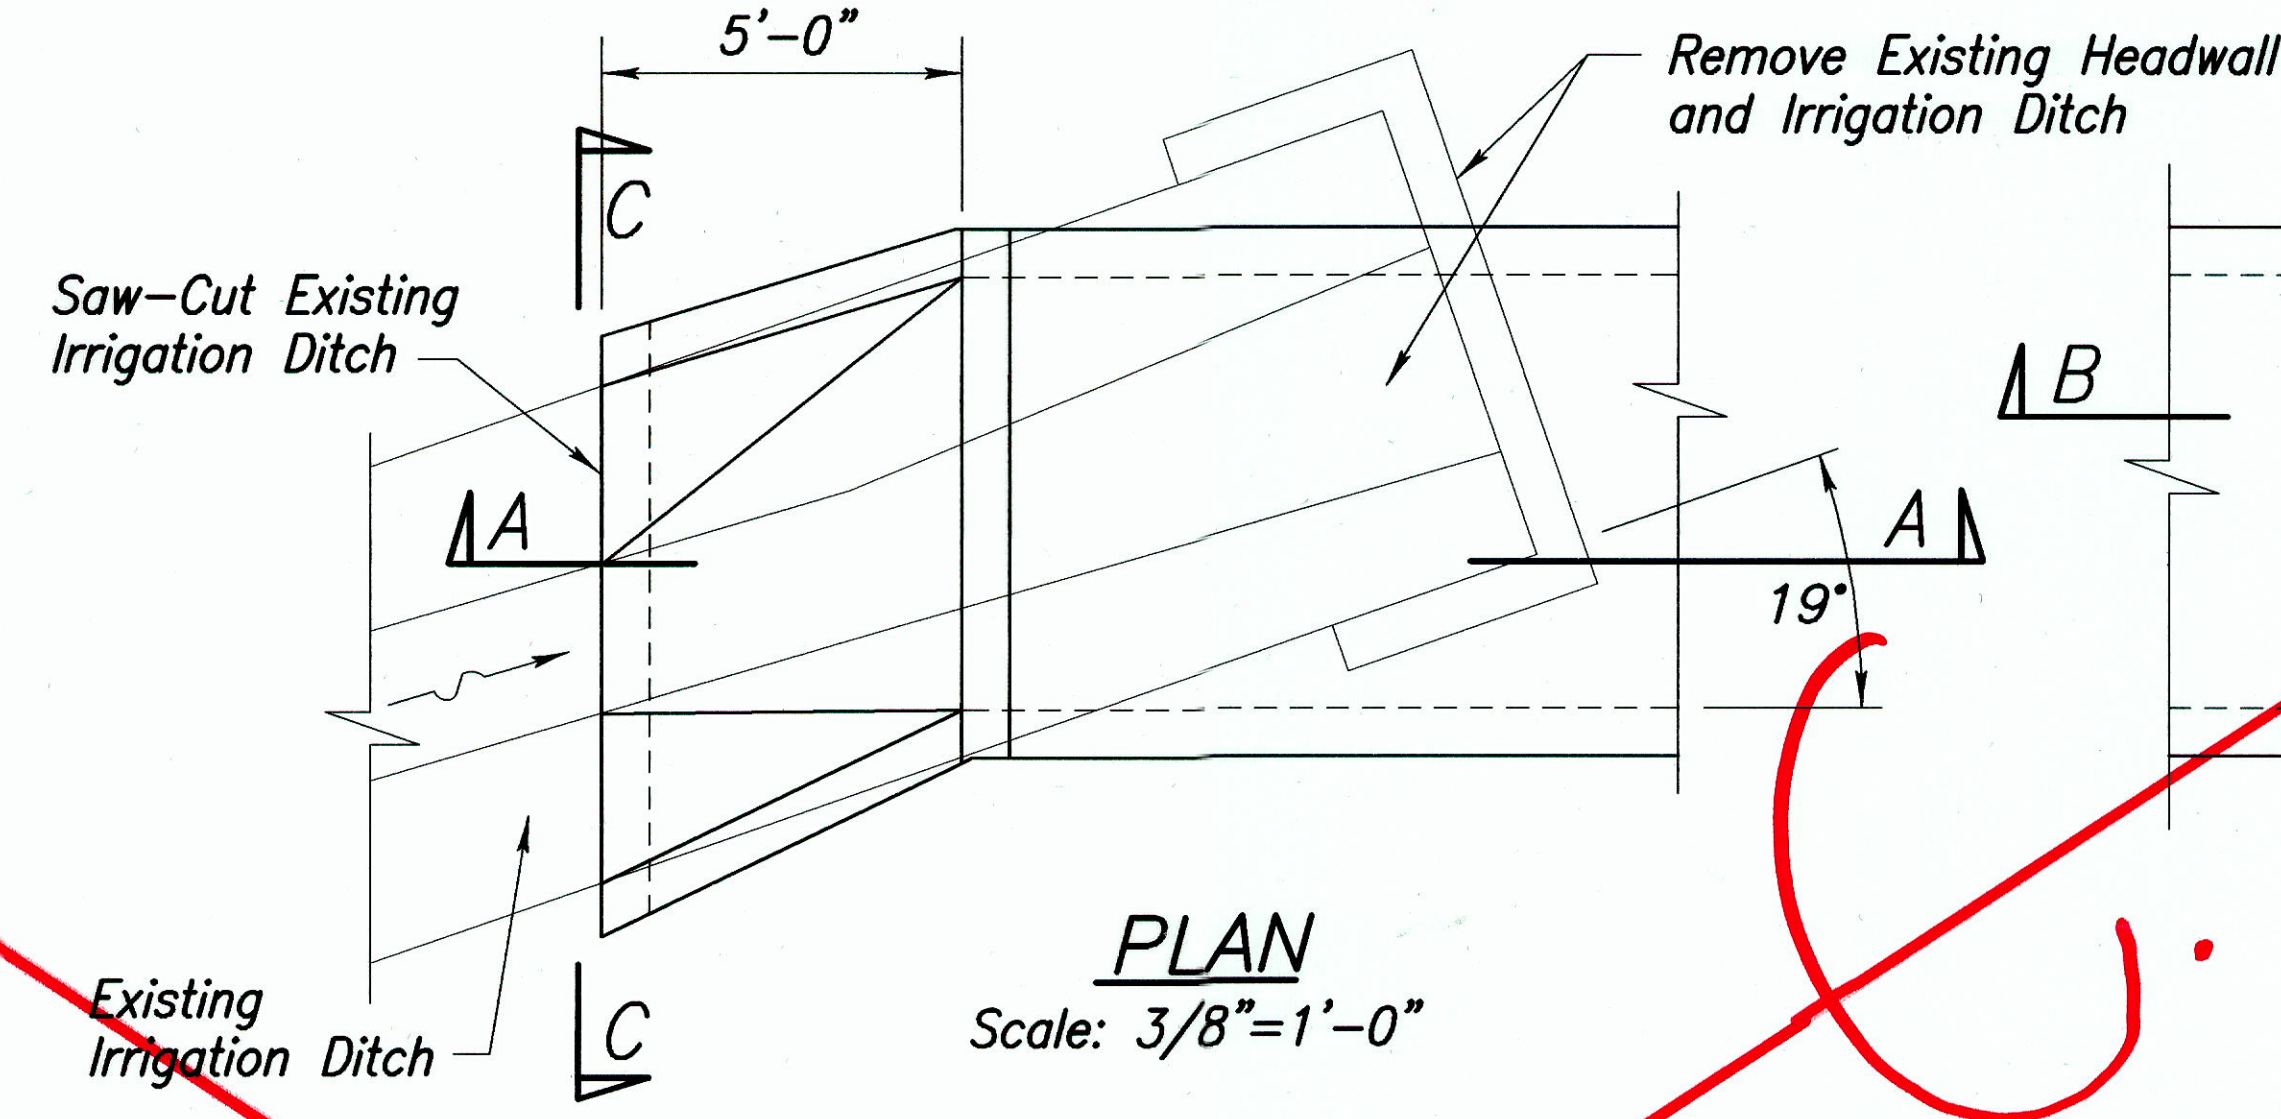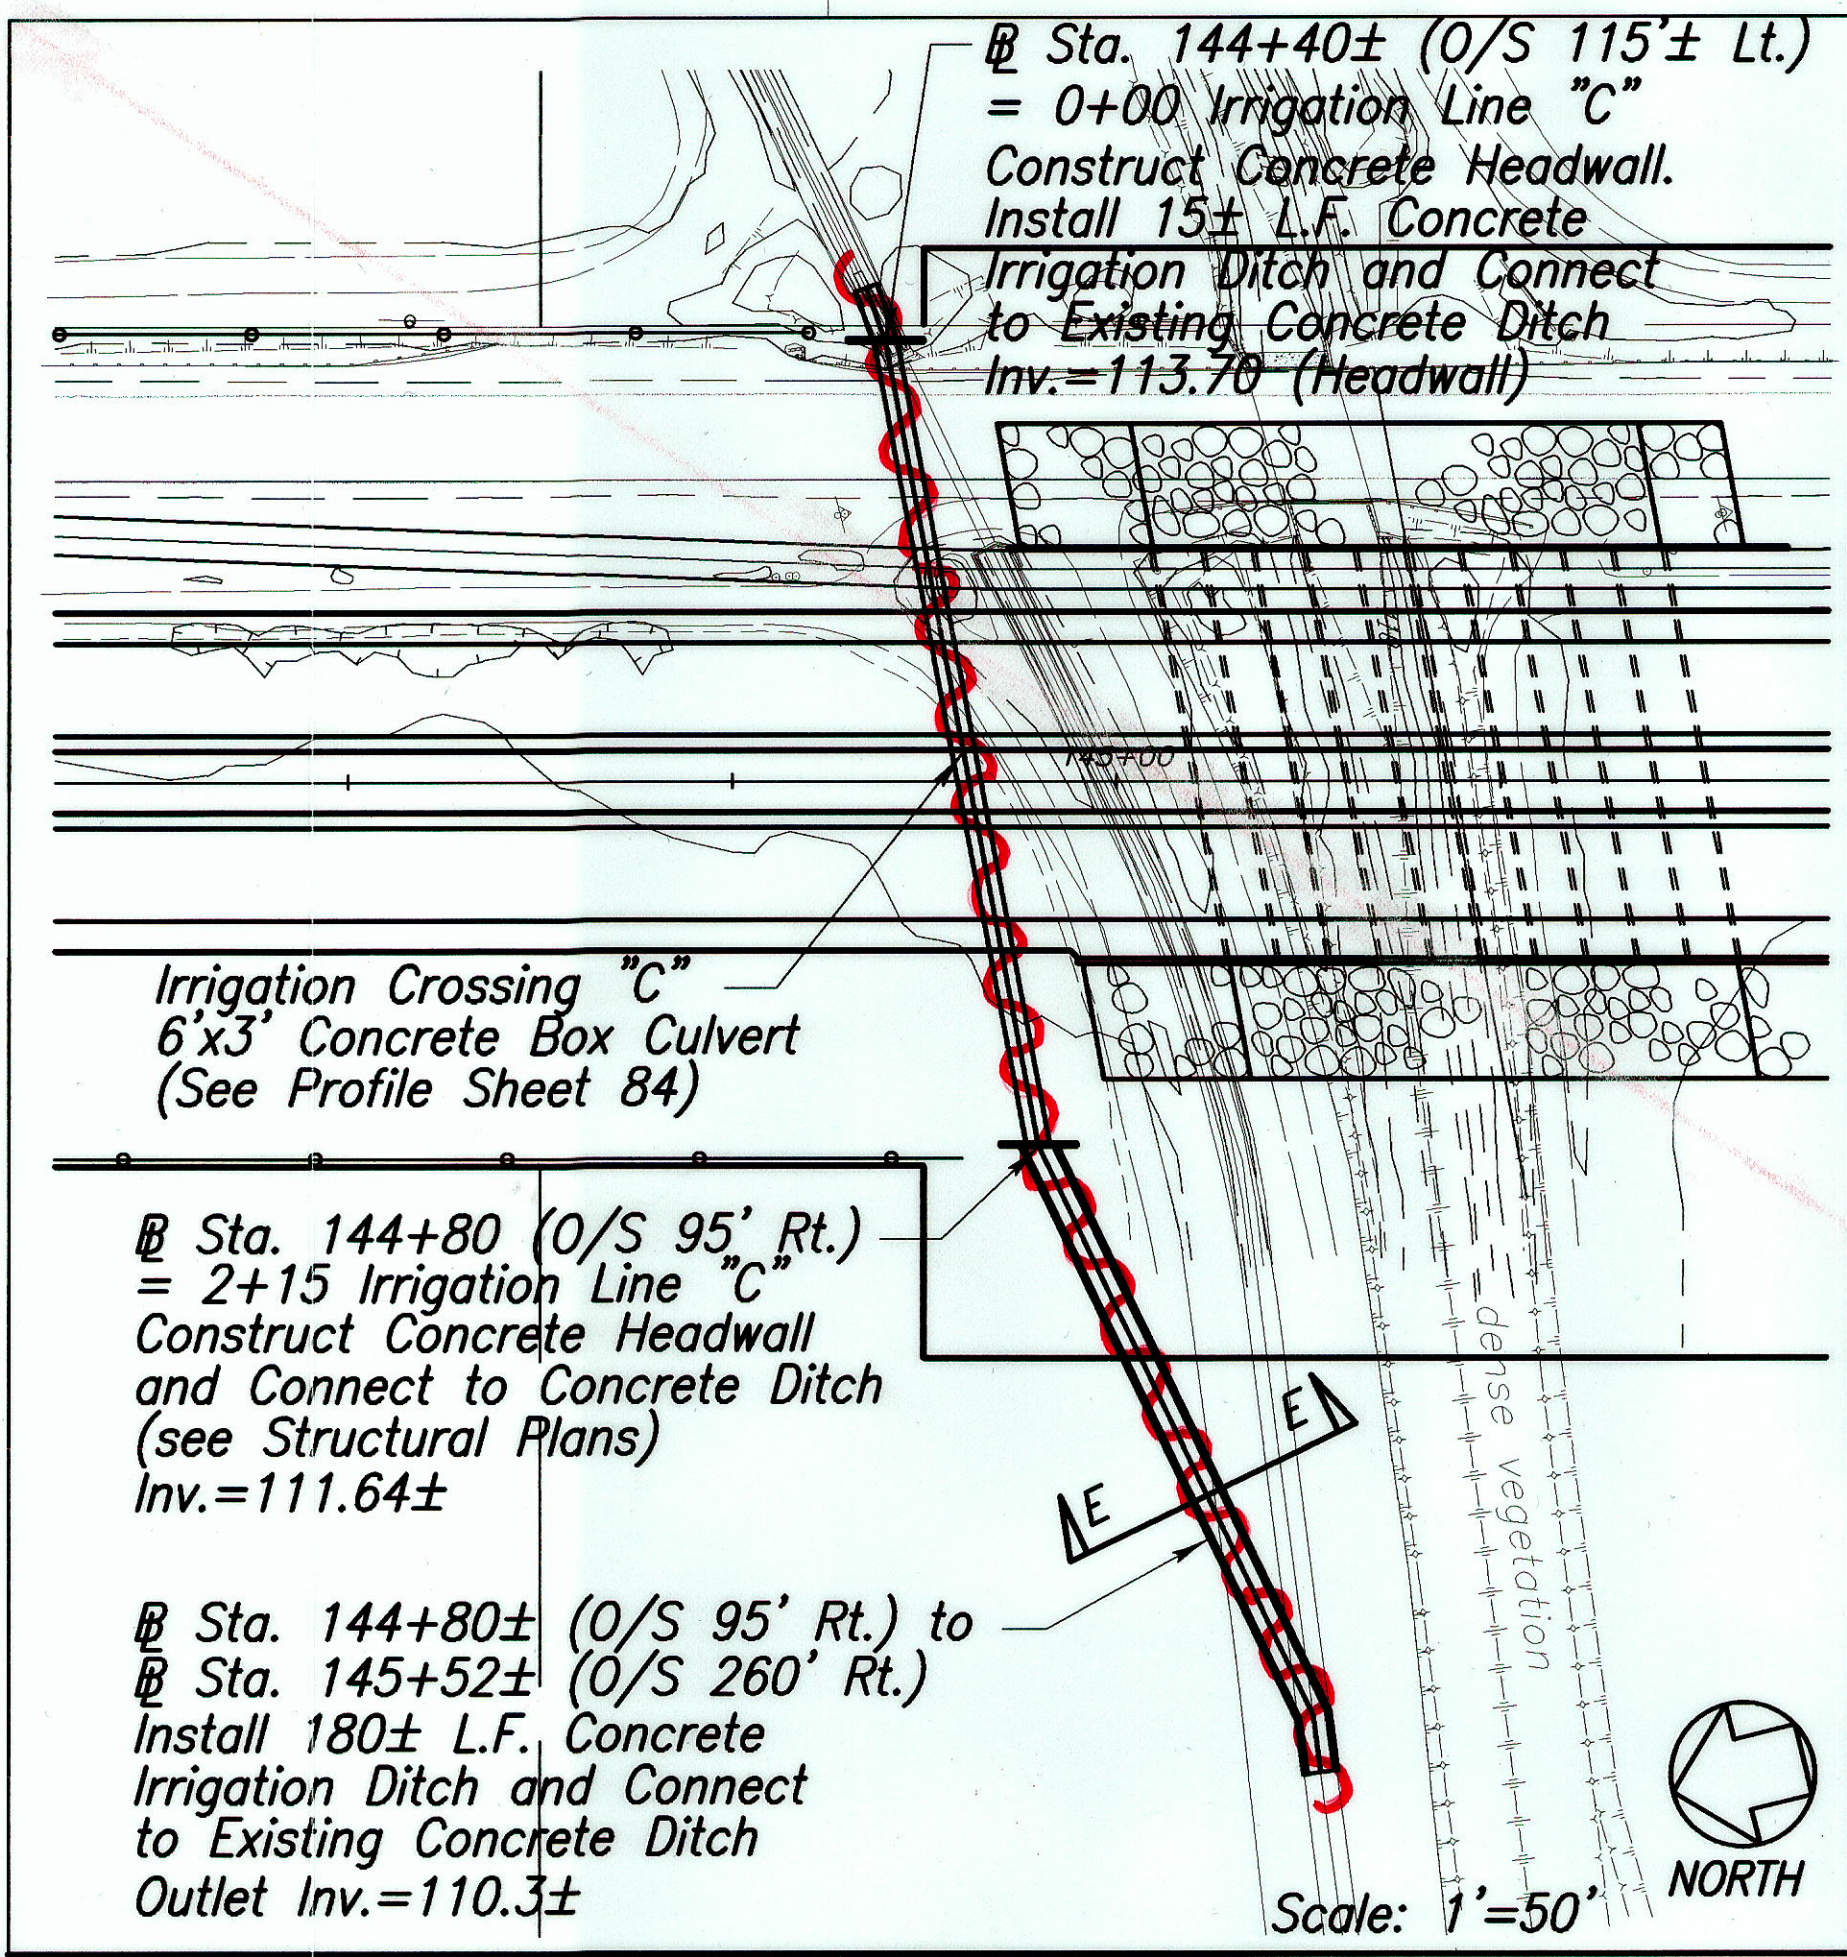

Note:
See Sht. 84 for Profiles

STATE OF HAWAII
DEPARTMENT OF TRANSPORTATION
HIGHWAYS DIVISION

IRRIGATION CULVERT DETAILS

MOKULELE HIGHWAY WIDENING

Vicinity of Cane Haul Road

To
Maui Humane Society

Federal - Aid Project No. NH-0311(5)

Scale: AS NOTED Date: JUNE 2002

SHEET No. 3 OF 3 SHEETS

"AS-BUILT"