

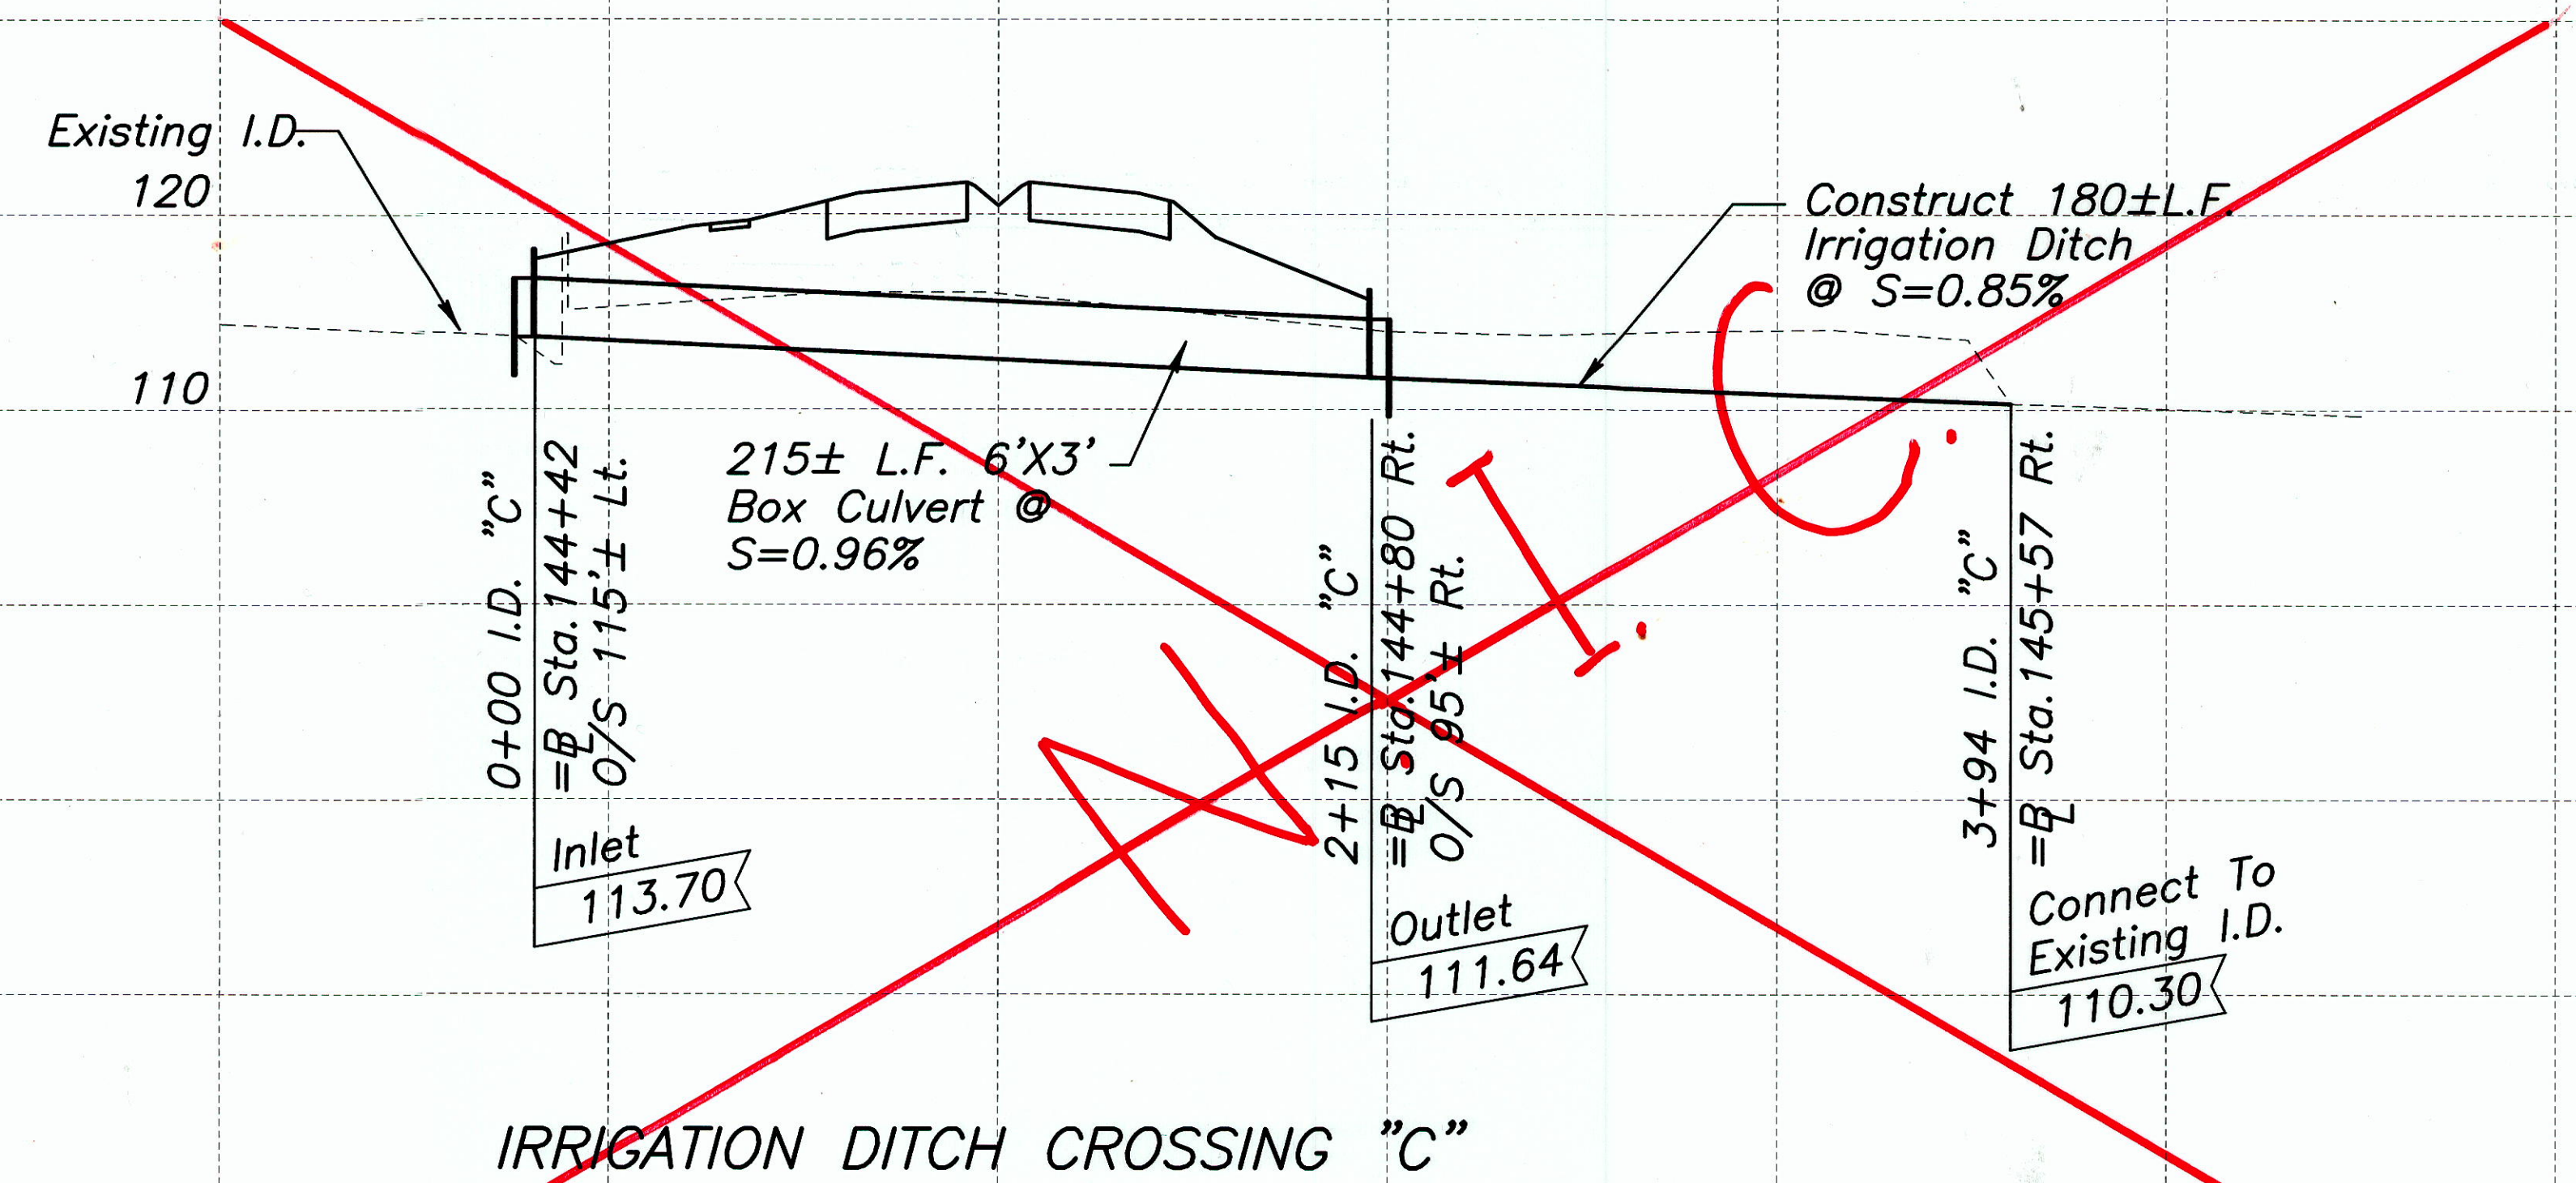
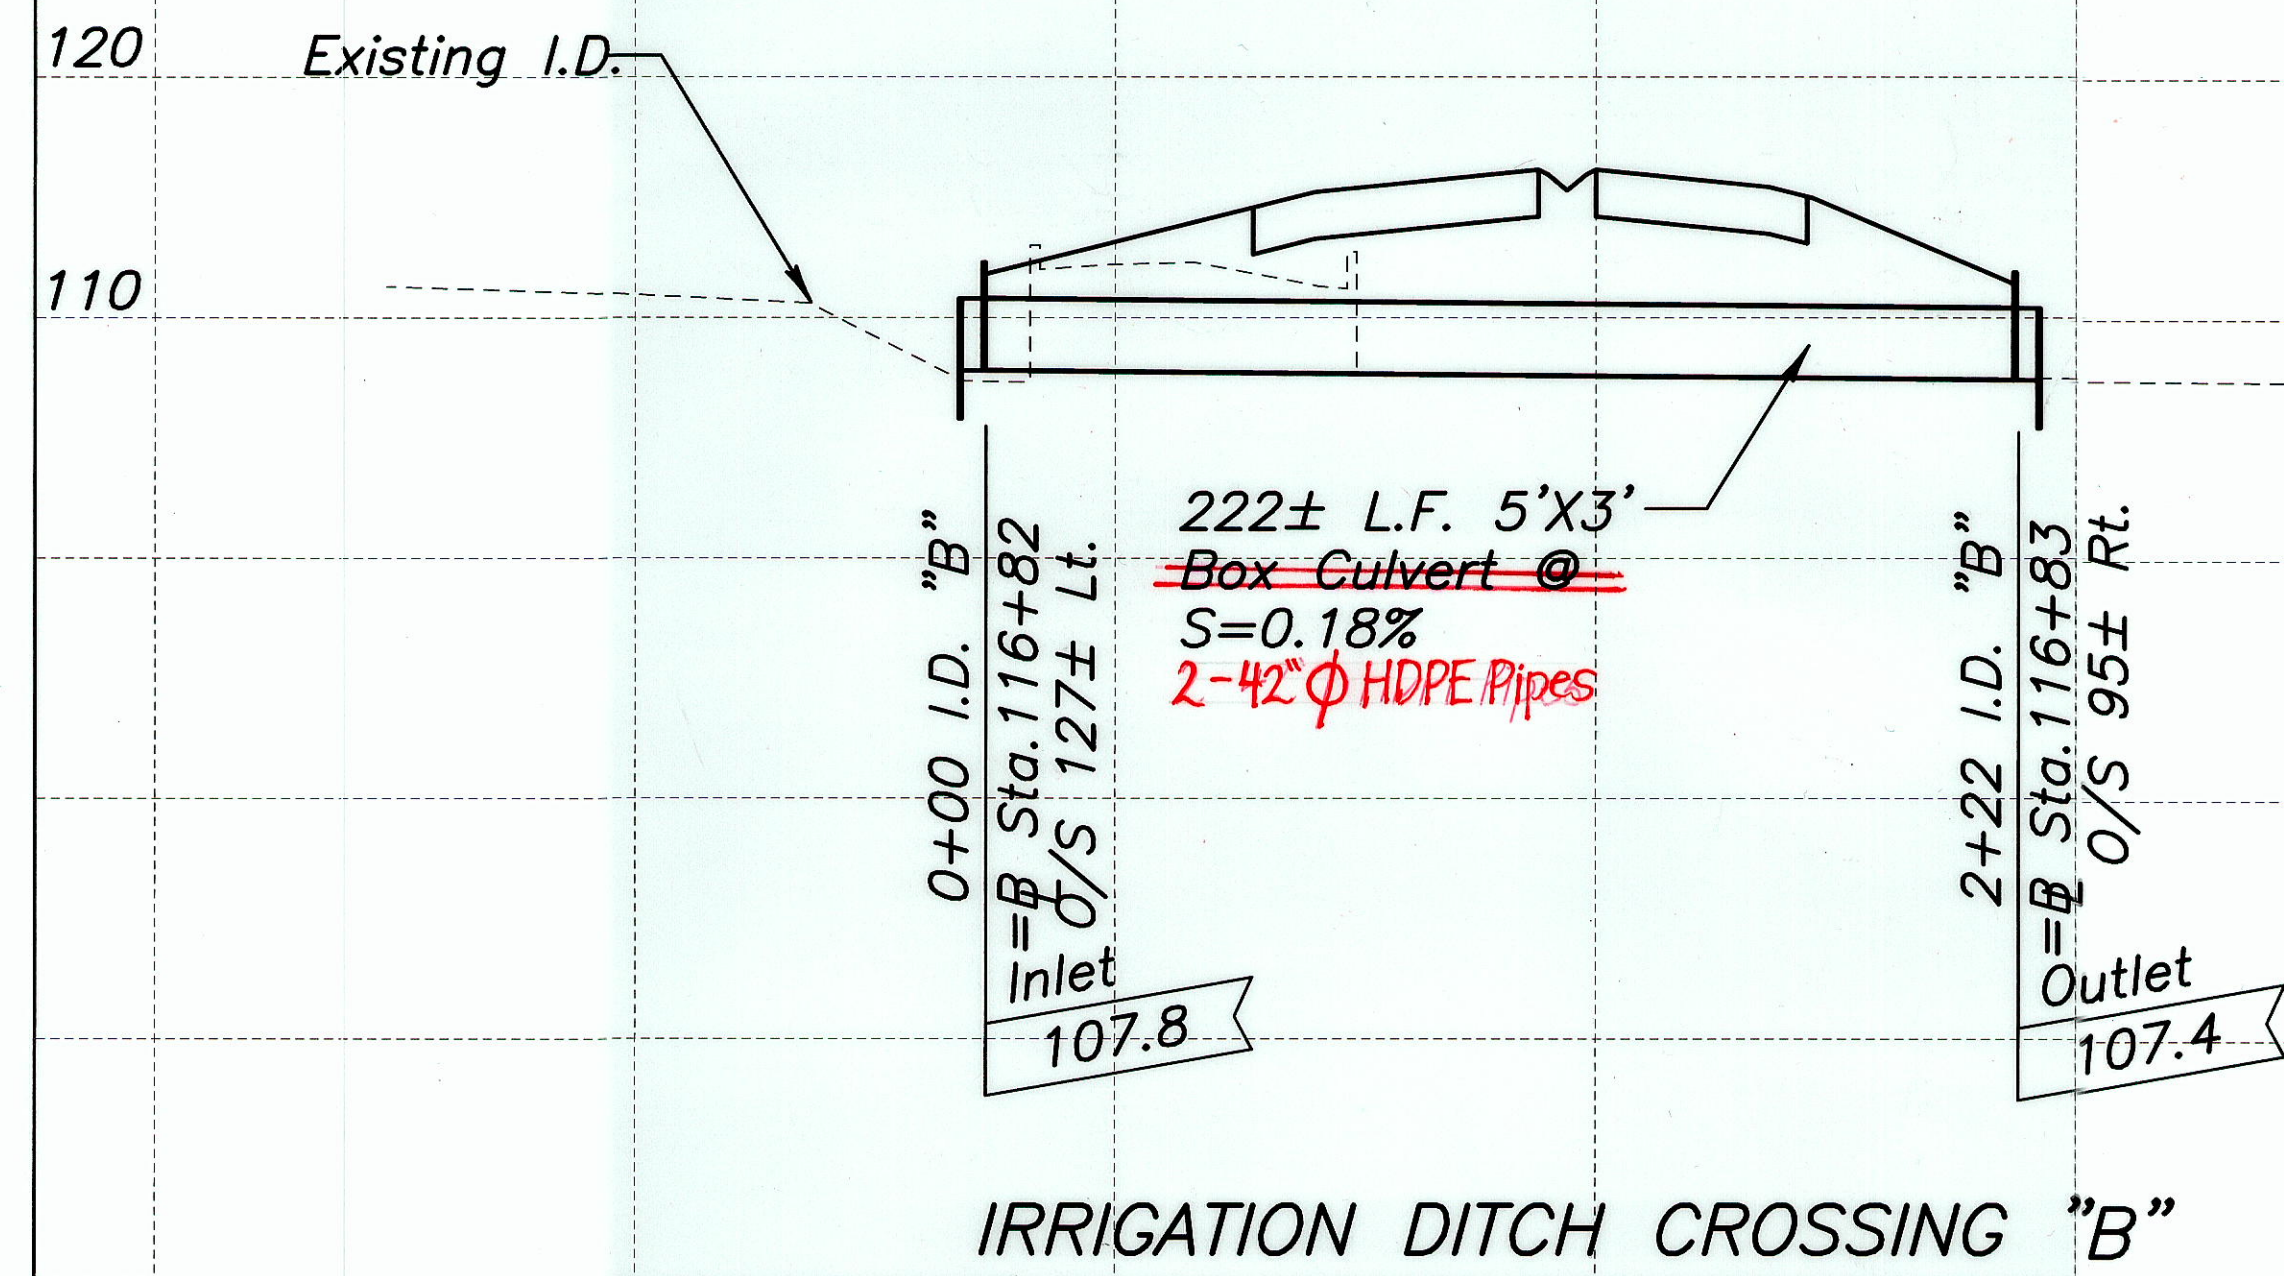


FED. ROAD DIST. NO.	STATE	FEDERAL - AID PROJ. NO.	FISCAL YEAR	SHEET NO.	TOTAL SHEETS
HAWAII	HAW.	NH-0311(5)	2003	84	189

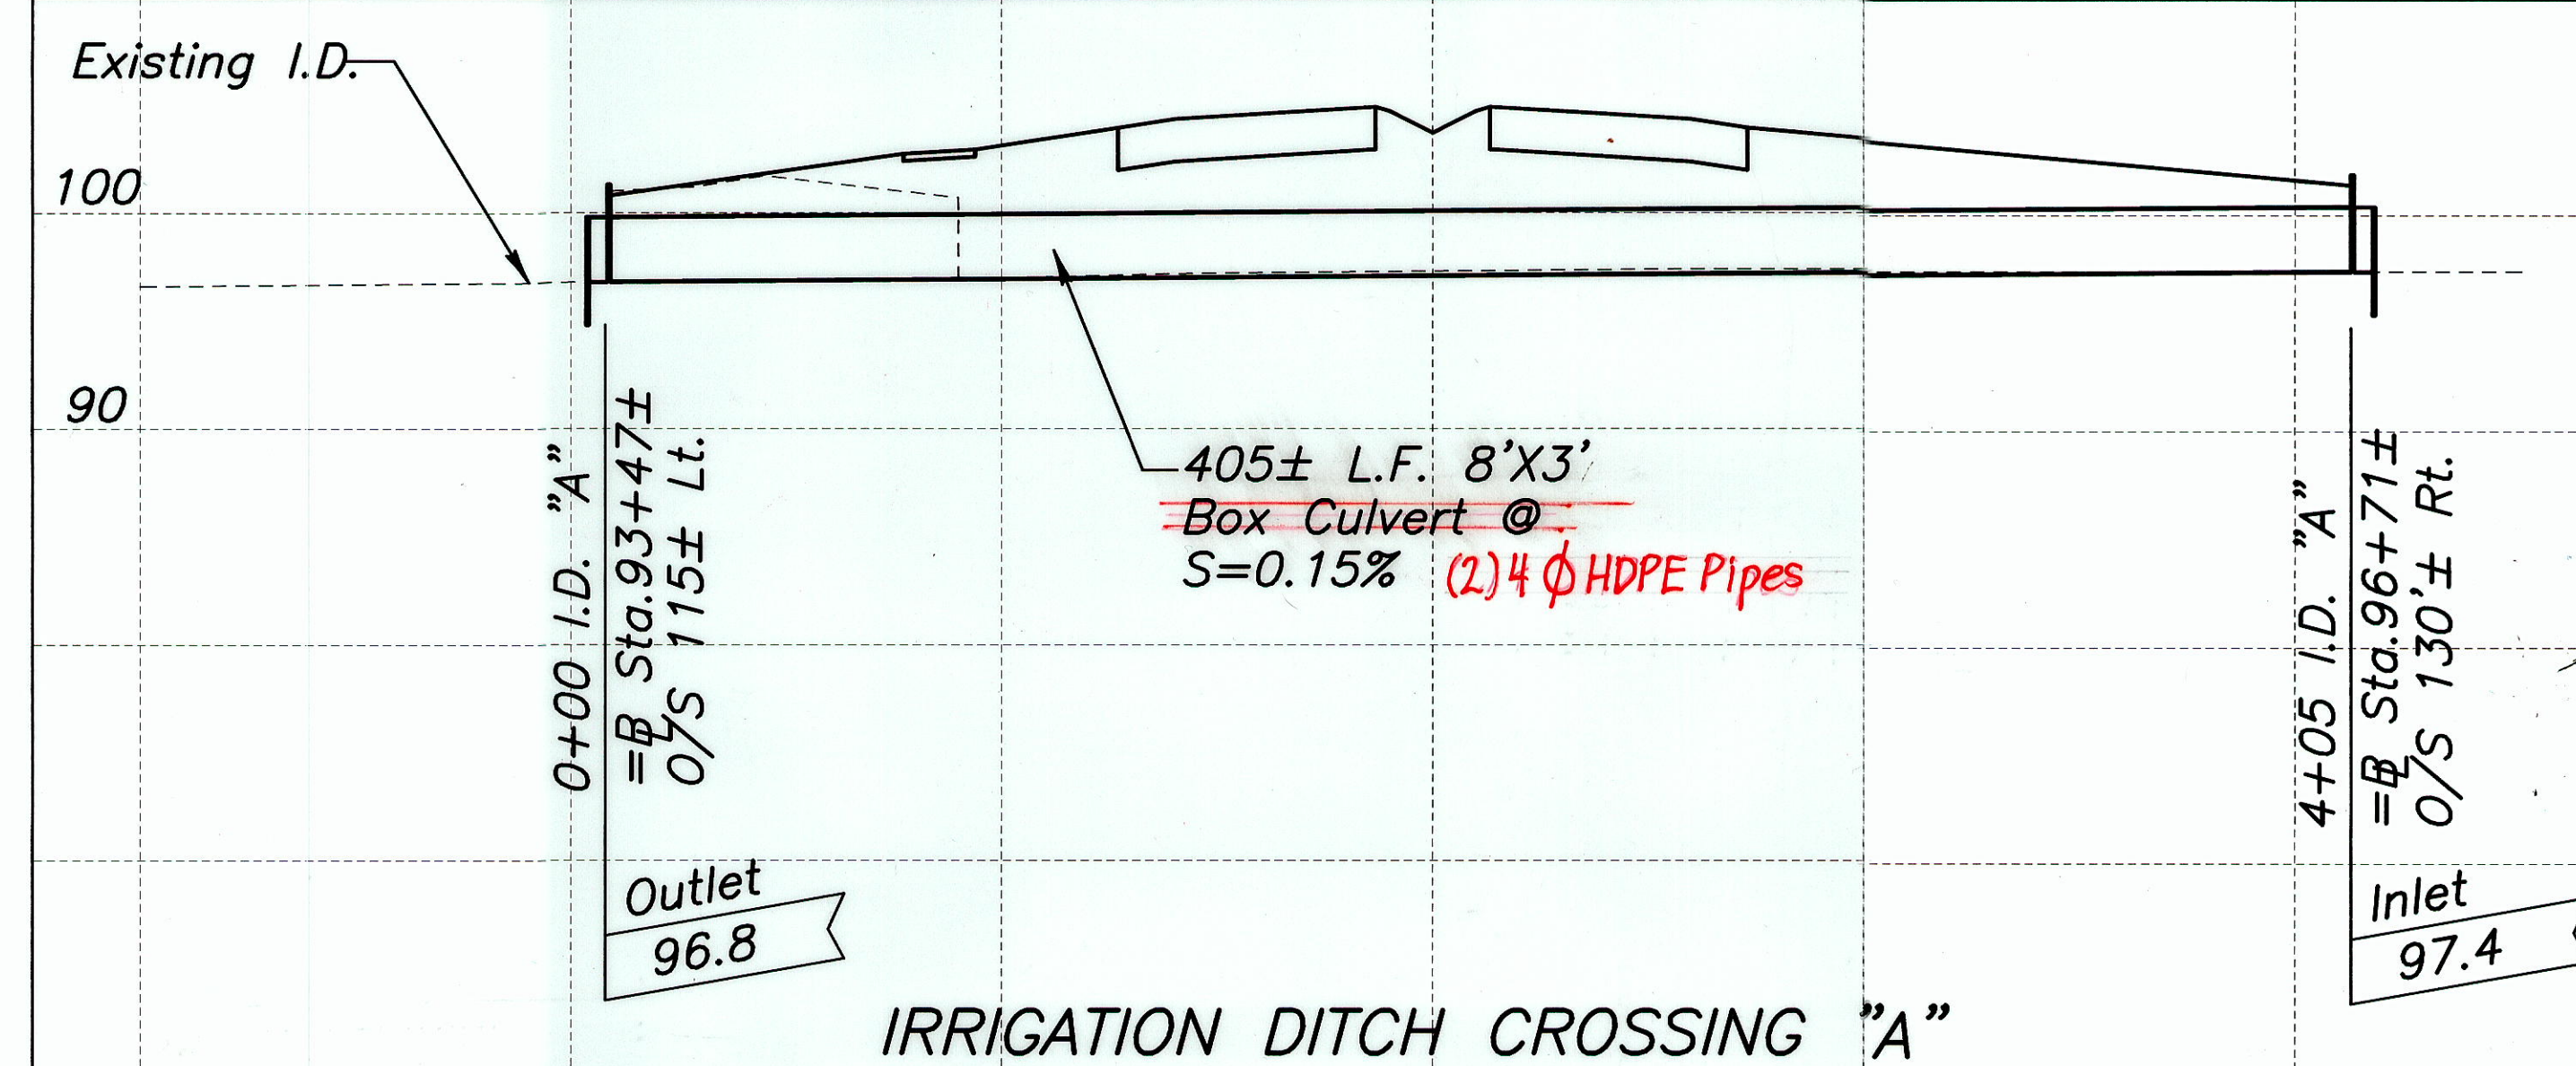

IRRIGATION PROFILE
Scale: 1"=40' Horiz.
1"=8' Vert.

12/23/02	Revised Irrigation Ditch Crossing "A" Profile
DATE	REVISION

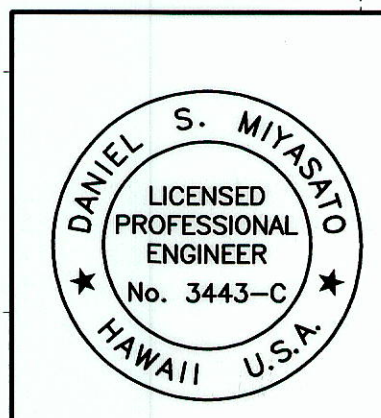

STATE OF HAWAII
DEPARTMENT OF TRANSPORTATION
HIGHWAYS DIVISION

IRRIGATION CULVERT PROFILES

MOKULELE HIGHWAY WIDENING
Vicinity of Cane Haul Road
To
Maui Humane Society
Federal - Aid Project No. NH-0311(5)
Scale: AS NOTED Date: JUNE 2002

SHEET No. 1 OF 1 SHEETS

"AS-BUILT"

ADD. 84

ORIGINAL PLAN	DATE
DESIGNED BY	
TRACED BY	
NOTED BY	
CHECKED BY	
No.	