



True North  0 feet

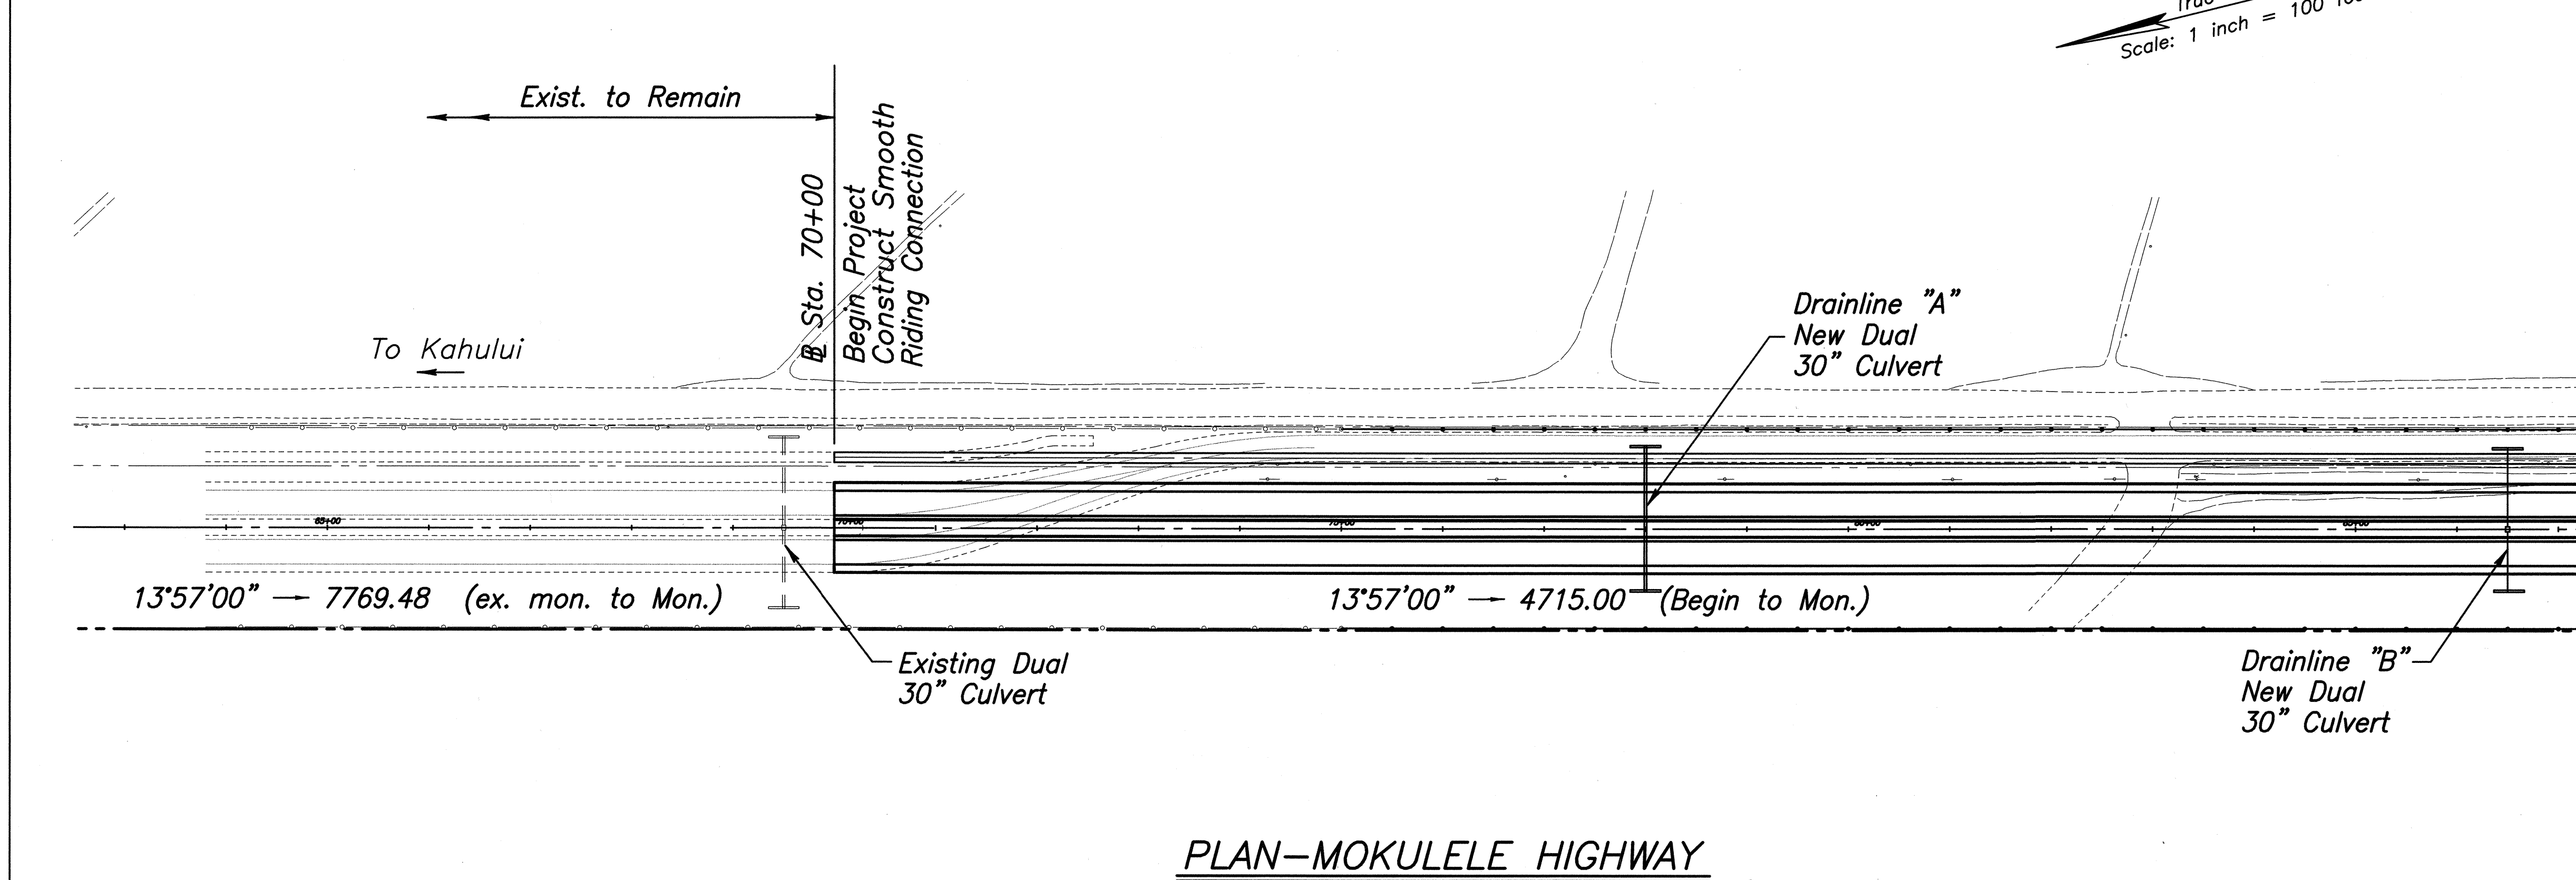

Scale: 1"=100'

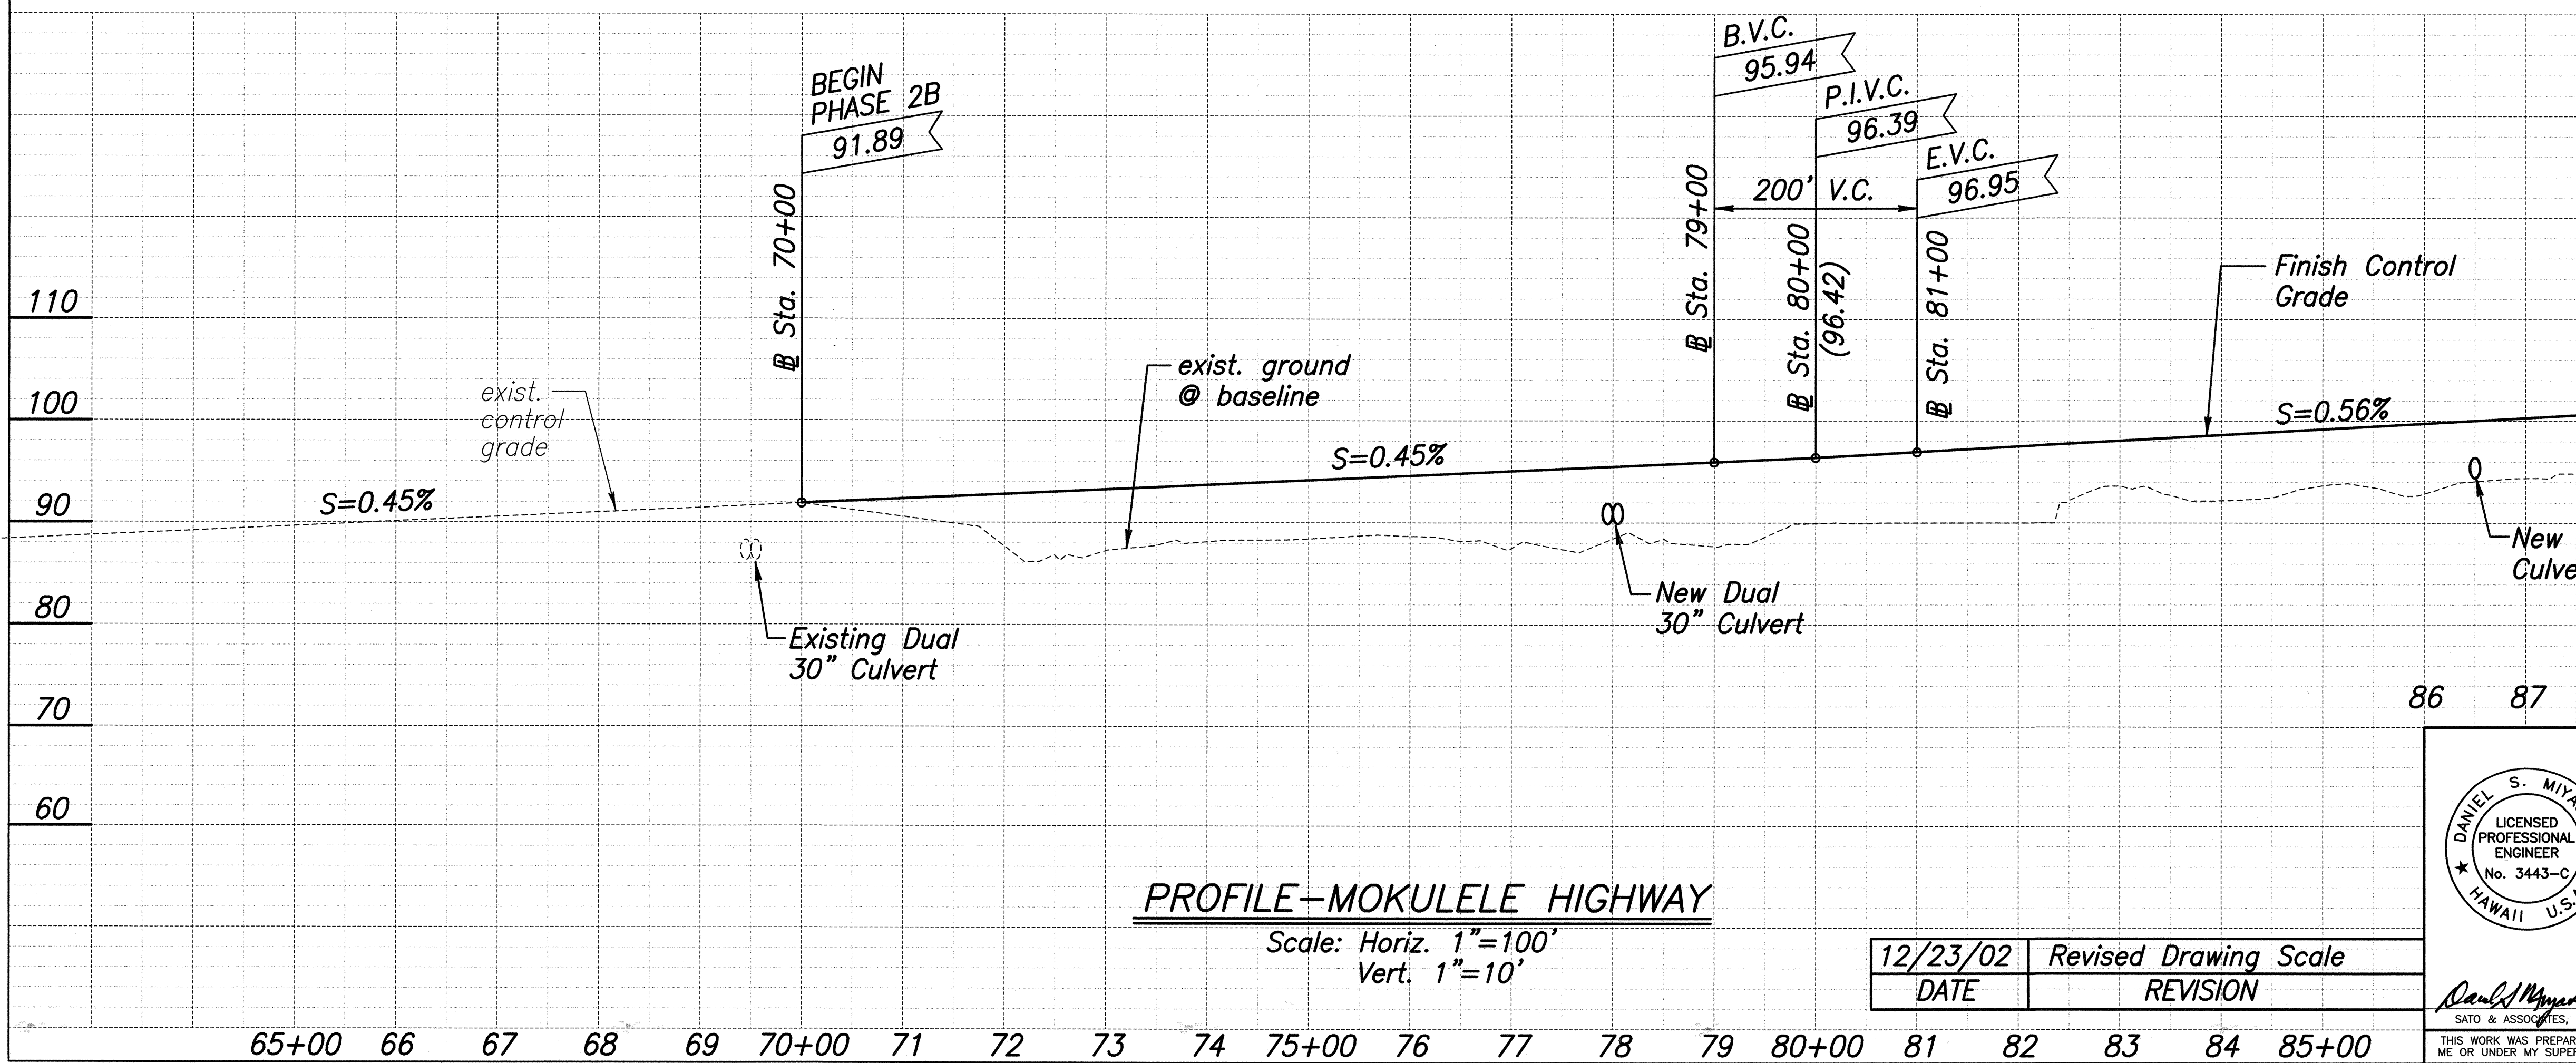

Scale: Horiz. 1"=100'

|          |                       |
|----------|-----------------------|
| 12/23/02 | Revised Drawing Scale |
| DATE     | REVISION              |



DEPARTMENT OF TRANSPORTATION  
HIGHWAYS DIVISION

P/P MOKULELE HIGHWAY-1



MOKULELE HIGHWAY WIDENING  
Vicinity of Cane Haul Road  
To  
Maui Humane Society  
Federal - Aid Project No. NH-0311(5)

Scale: AS NOTED      Date: JUNE 2002

SHEET No. 1 OF 6 SHEETS



| FED. ROAD<br>DIST. NO. | STATE | FEDERAL – AID<br>PROJ. NO. | FISCAL<br>YEAR | SHEET<br>NO. | TOTAL<br>SHEET |
|------------------------|-------|----------------------------|----------------|--------------|----------------|
| HAWAII                 | HAW.  | NH-0311(5)                 | 2003           | 40           | 189            |

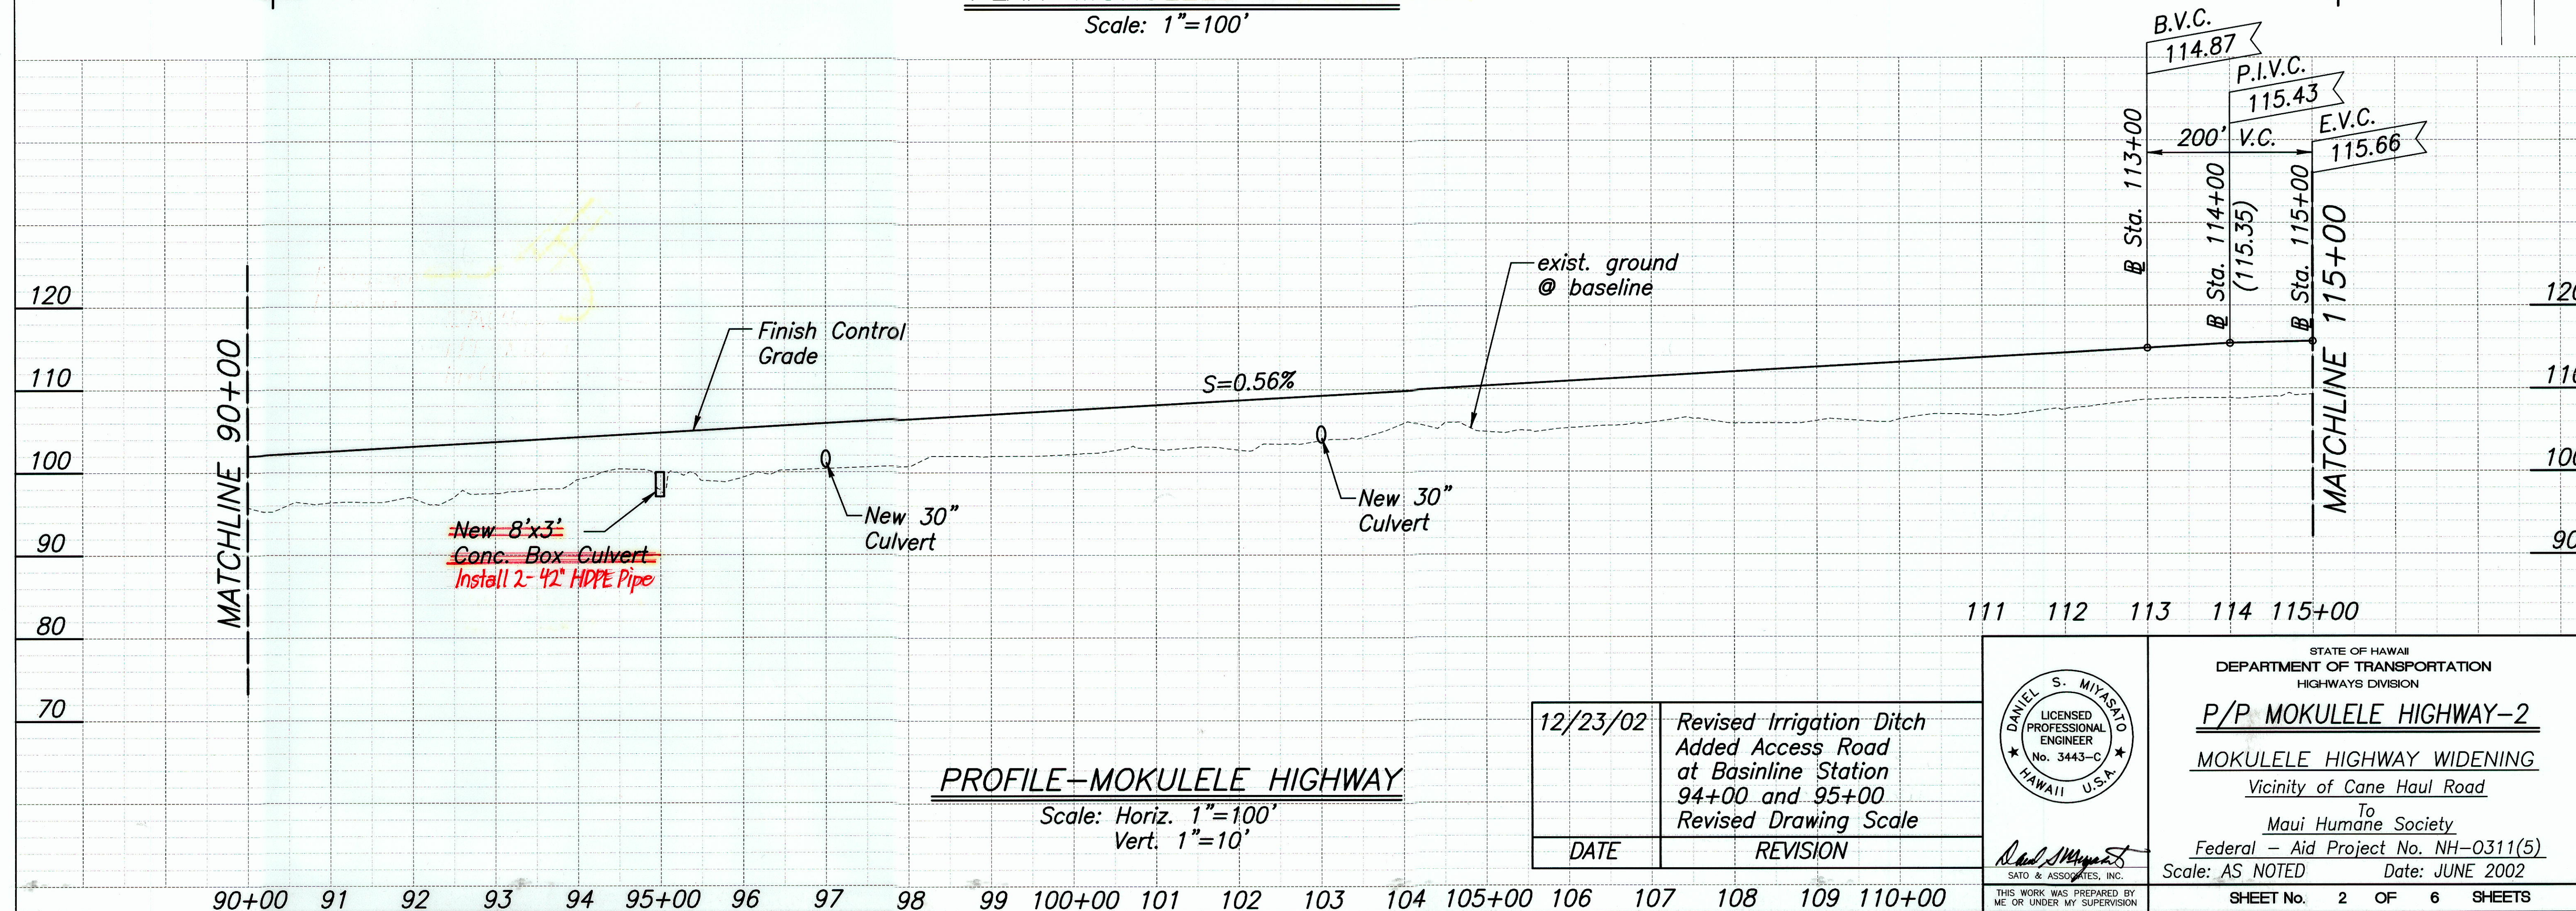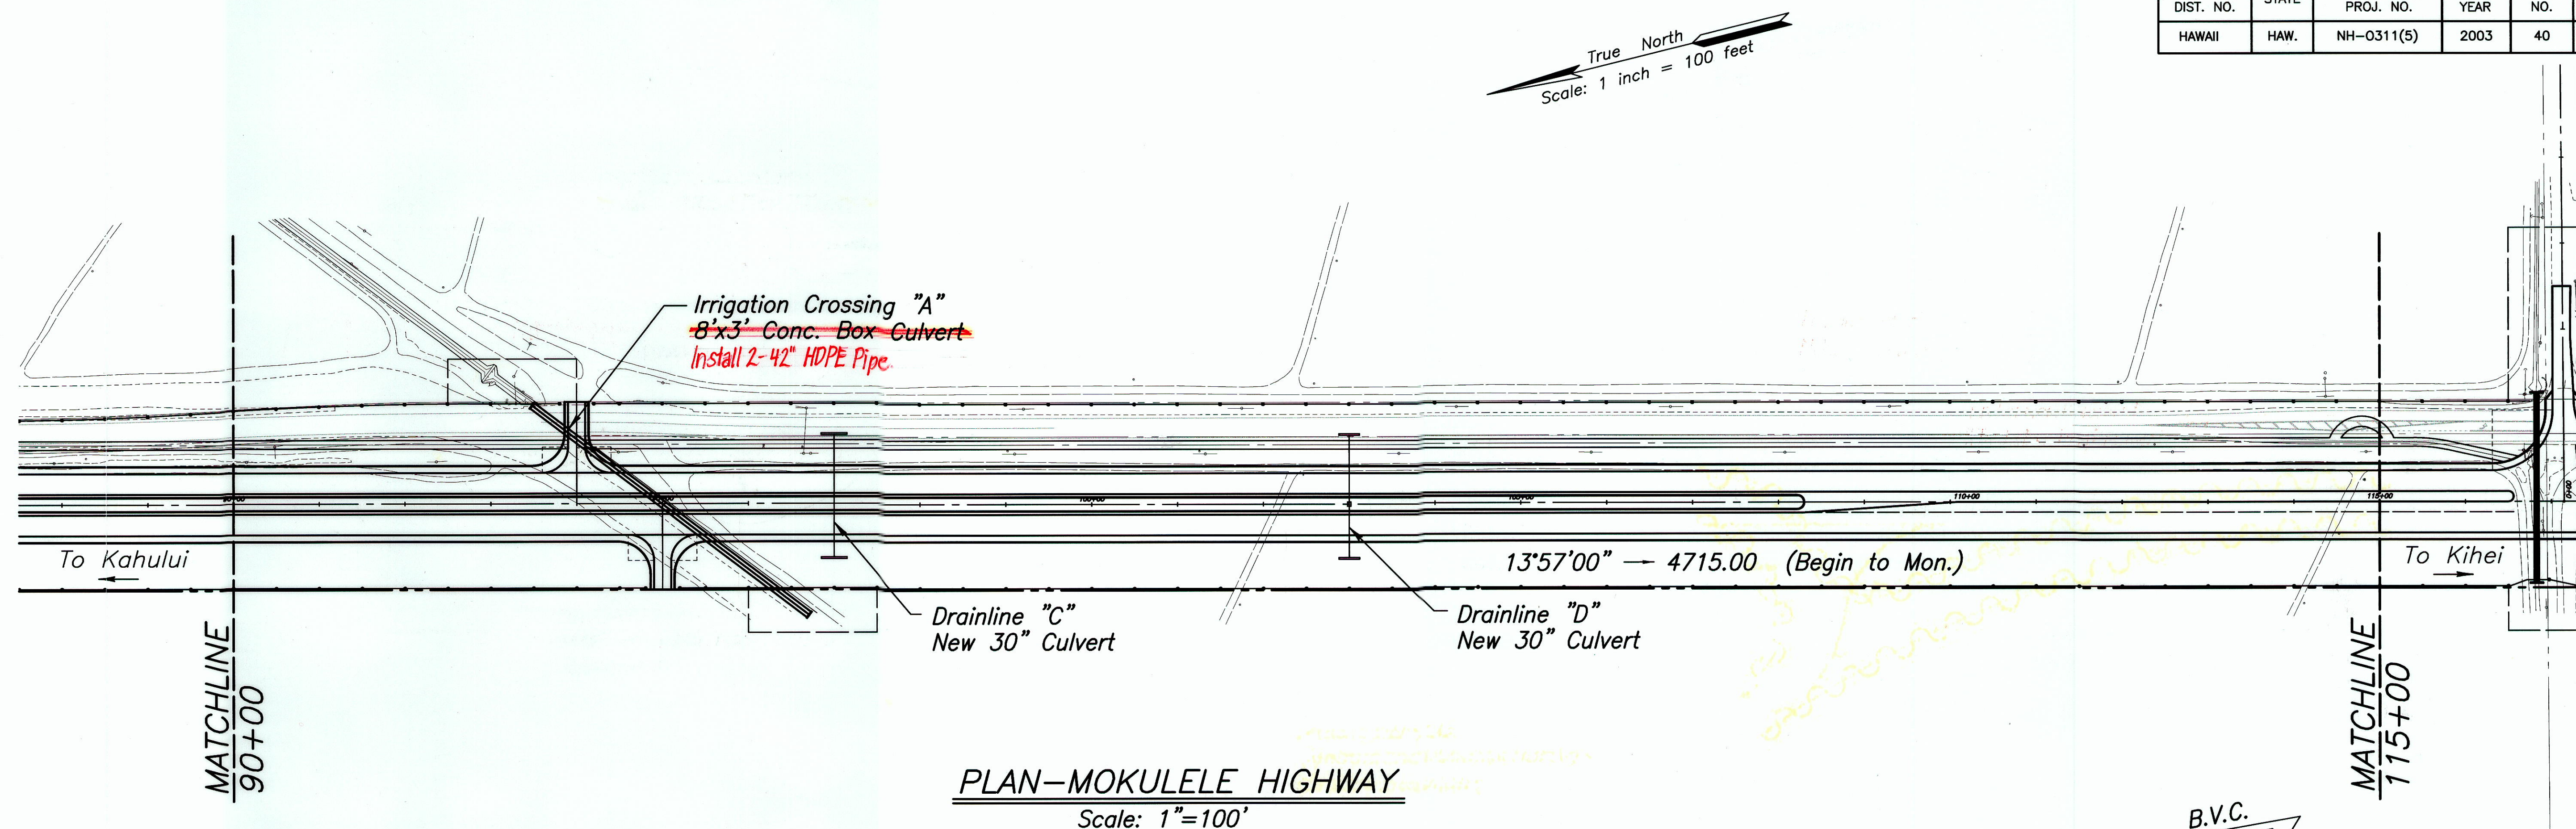


"AS-BUILT"


**ADD. 40**



| FED. ROAD DIST. NO. | STATE | FEDERAL - AID PROJ. NO. | FISCAL YEAR | SHEET NO. | TOTAL SHEETS |
|---------------------|-------|-------------------------|-------------|-----------|--------------|
| HAWAII              | HAW.  | NH-0311(5)              | 2003        | 41        | 189          |

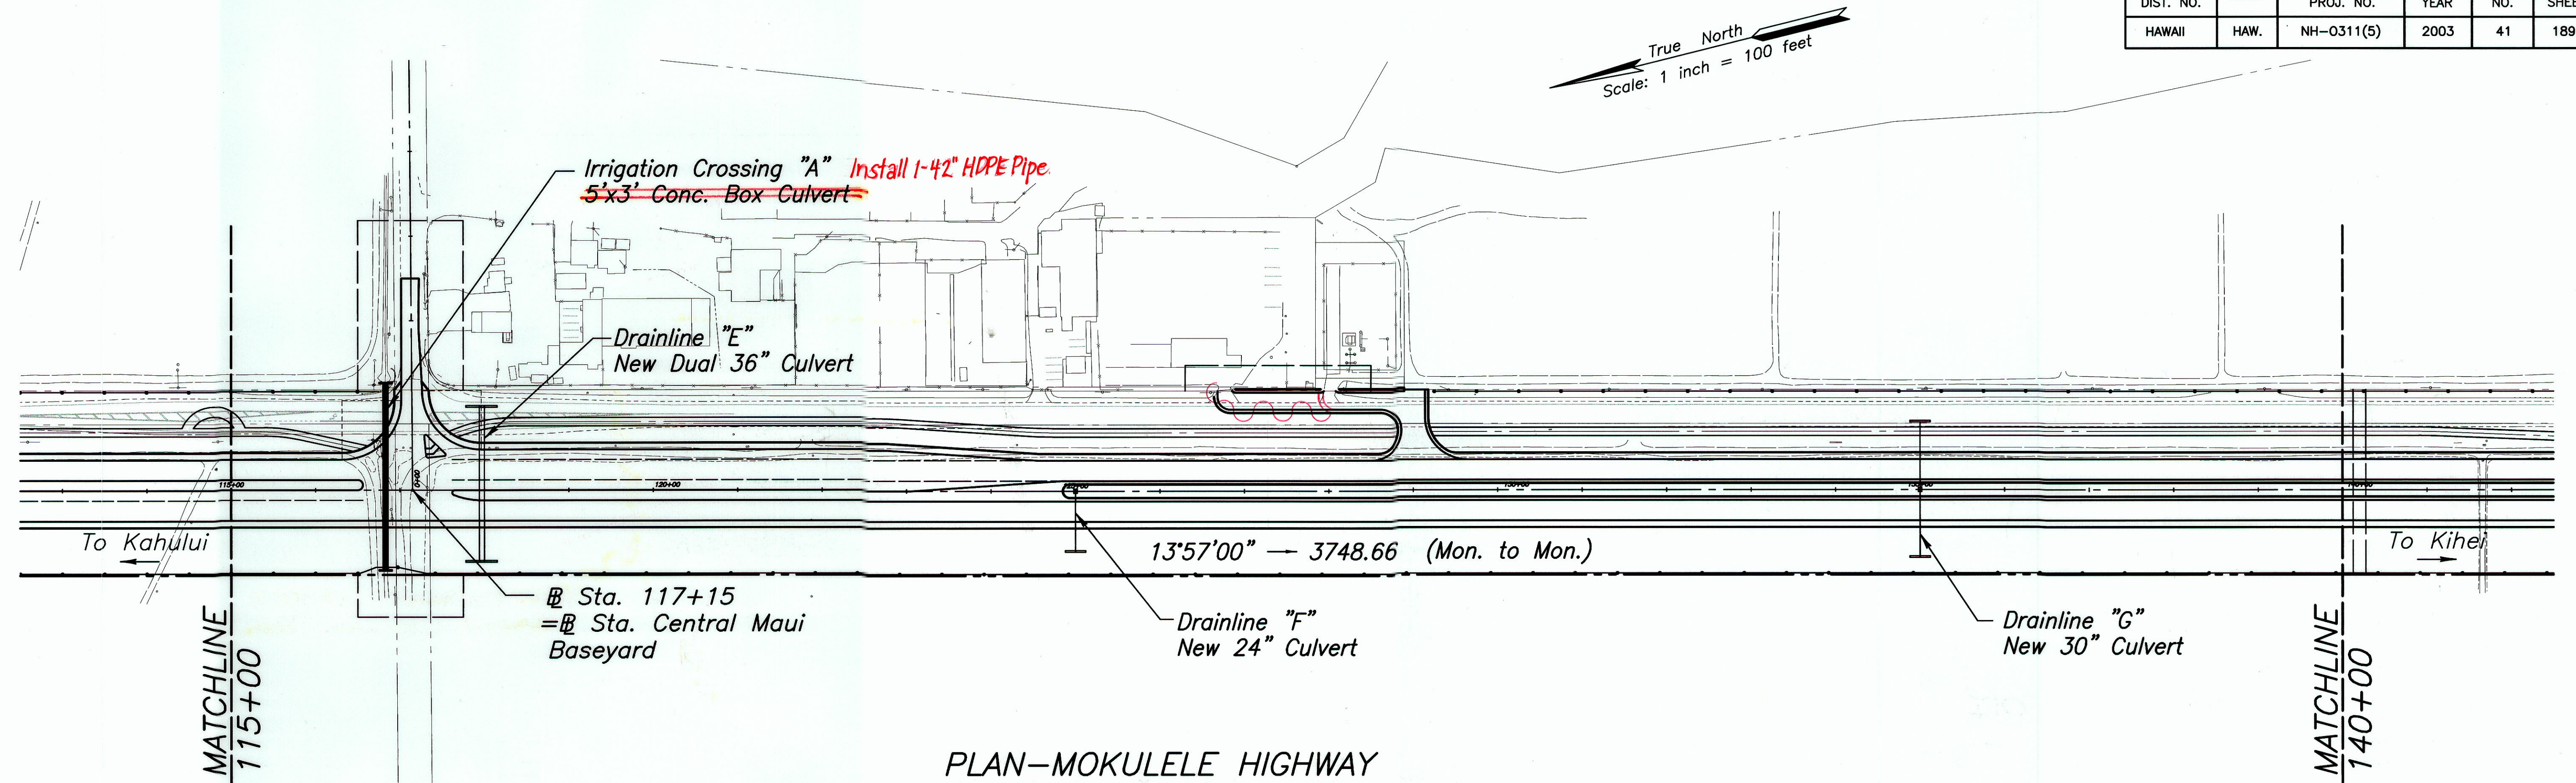


PLAN-MOKULELE HIGHWAY

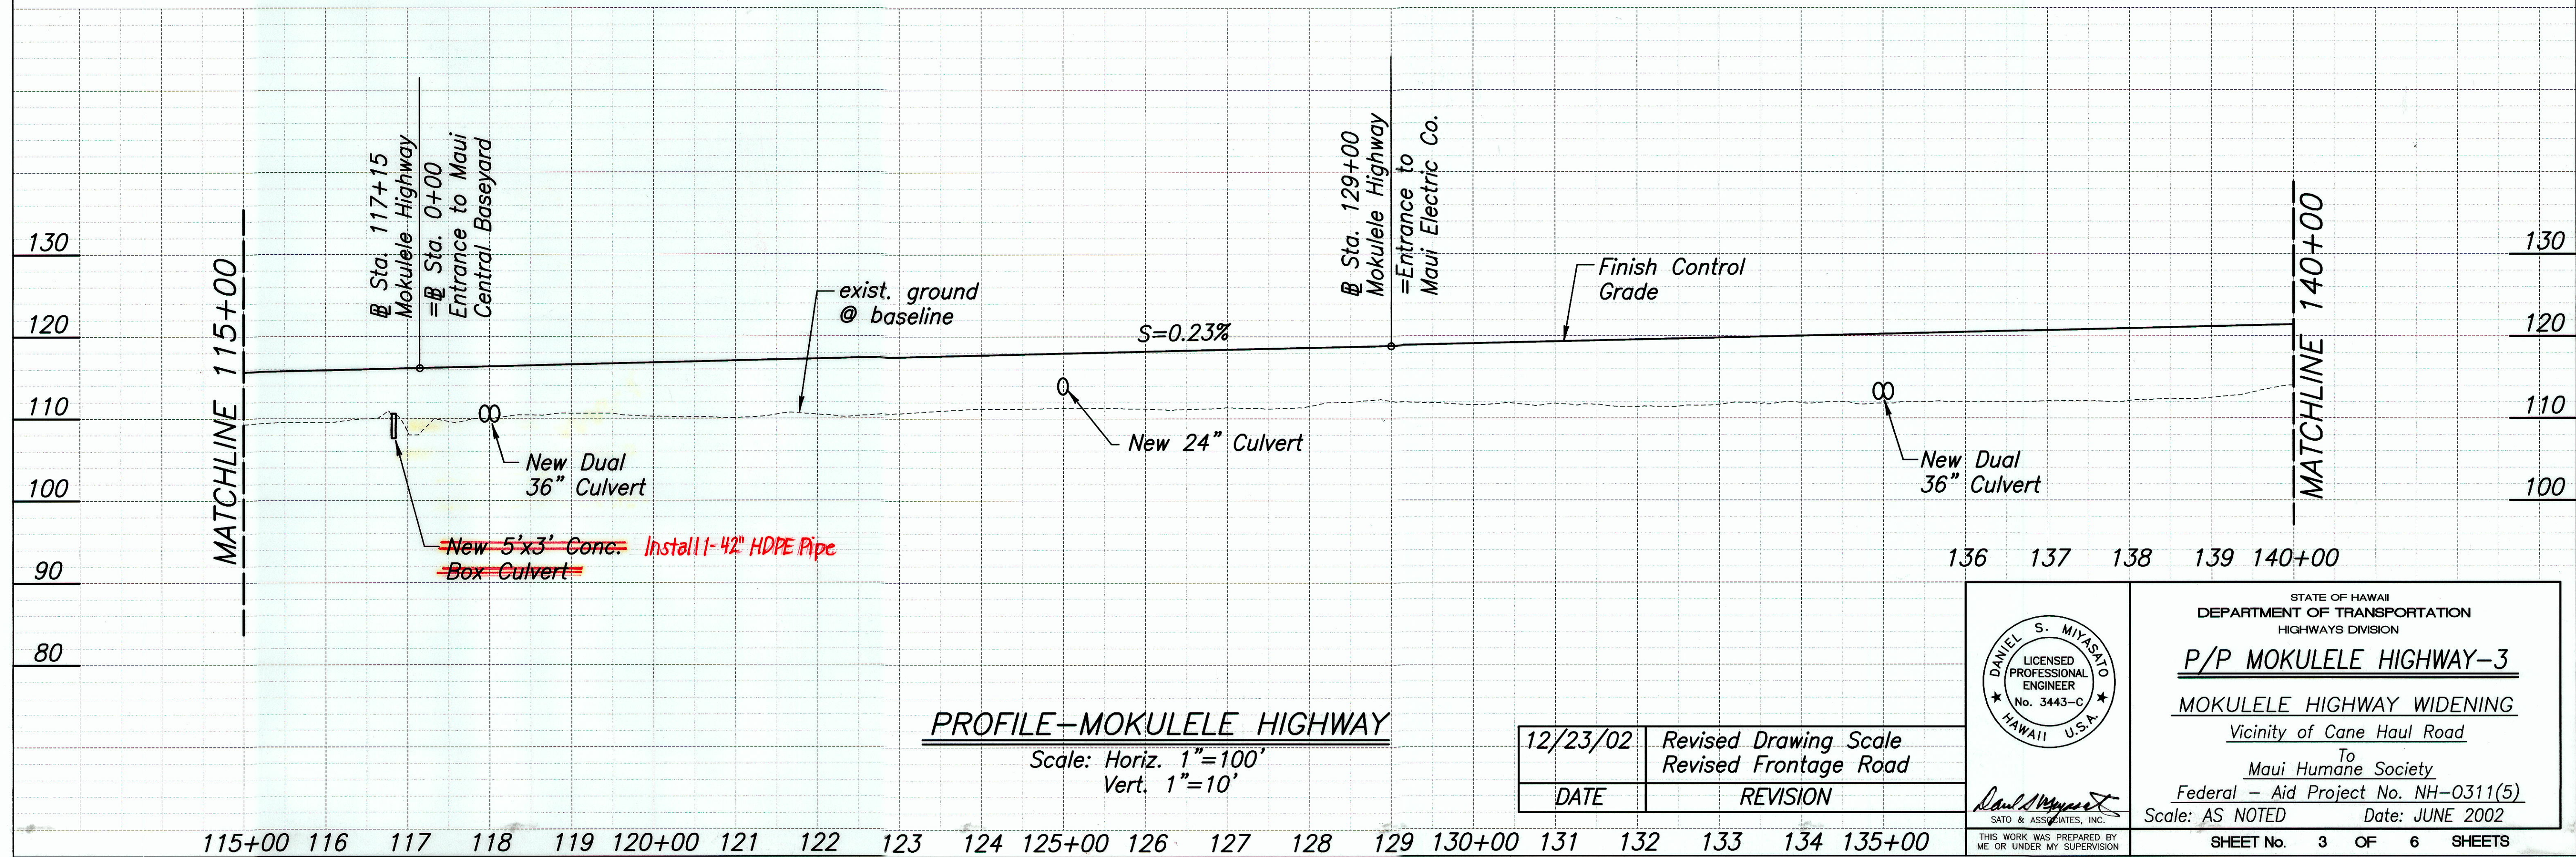

PROFILE-MOKULELE HIGHWAY

Scale: Horiz. 1"=100'  
Vert. 1"=10'

| 12/23/02 | Revised Drawing Scale<br>Revised Frontage Road |
|----------|------------------------------------------------|
| DATE     | REVISION                                       |

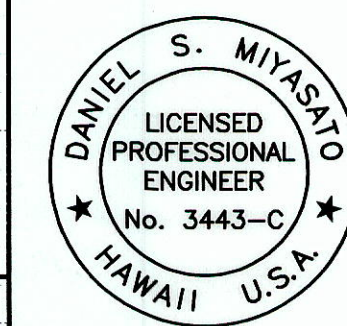

THIS WORK WAS PREPARED BY  
ME OR UNDER MY SUPERVISION

|                                                                      |                 |
|----------------------------------------------------------------------|-----------------|
| STATE OF HAWAII<br>DEPARTMENT OF TRANSPORTATION<br>HIGHWAYS DIVISION |                 |
| <b>P/P MOKULELE HIGHWAY-3</b>                                        |                 |
| MOKULELE HIGHWAY WIDENING                                            |                 |
| Vicinity of Cane Haul Road                                           |                 |
| To<br>Maui Humane Society                                            |                 |
| Federal - Aid Project No. NH-0311(5)                                 |                 |
| Scale: AS NOTED                                                      | Date: JUNE 2002 |
| SHEET No. 3                                                          | OF 6 SHEETS     |



"AS-BUILT"

ADD. 41

|           |                   |      |
|-----------|-------------------|------|
| ORIGINAL  | SURVEY PLOTTED BY | DATE |
| PLAN      | DESIGNED BY       |      |
| NOTE BOOK | TRACED BY         |      |
|           | DESIGNED BY       |      |
|           | QUANTITIES BY     |      |
|           | CHECKED BY        |      |
| No.       |                   |      |



| FED. ROAD<br>DIST. NO. | STATE | FEDERAL - AID<br>PROJ. NO. | FISCAL<br>YEAR | SHEET<br>NO. | TOTAL<br>SHEETS |
|------------------------|-------|----------------------------|----------------|--------------|-----------------|
| HAWAII                 | HAW.  | NH-0311(5)                 | 2003           | 42           | 189             |

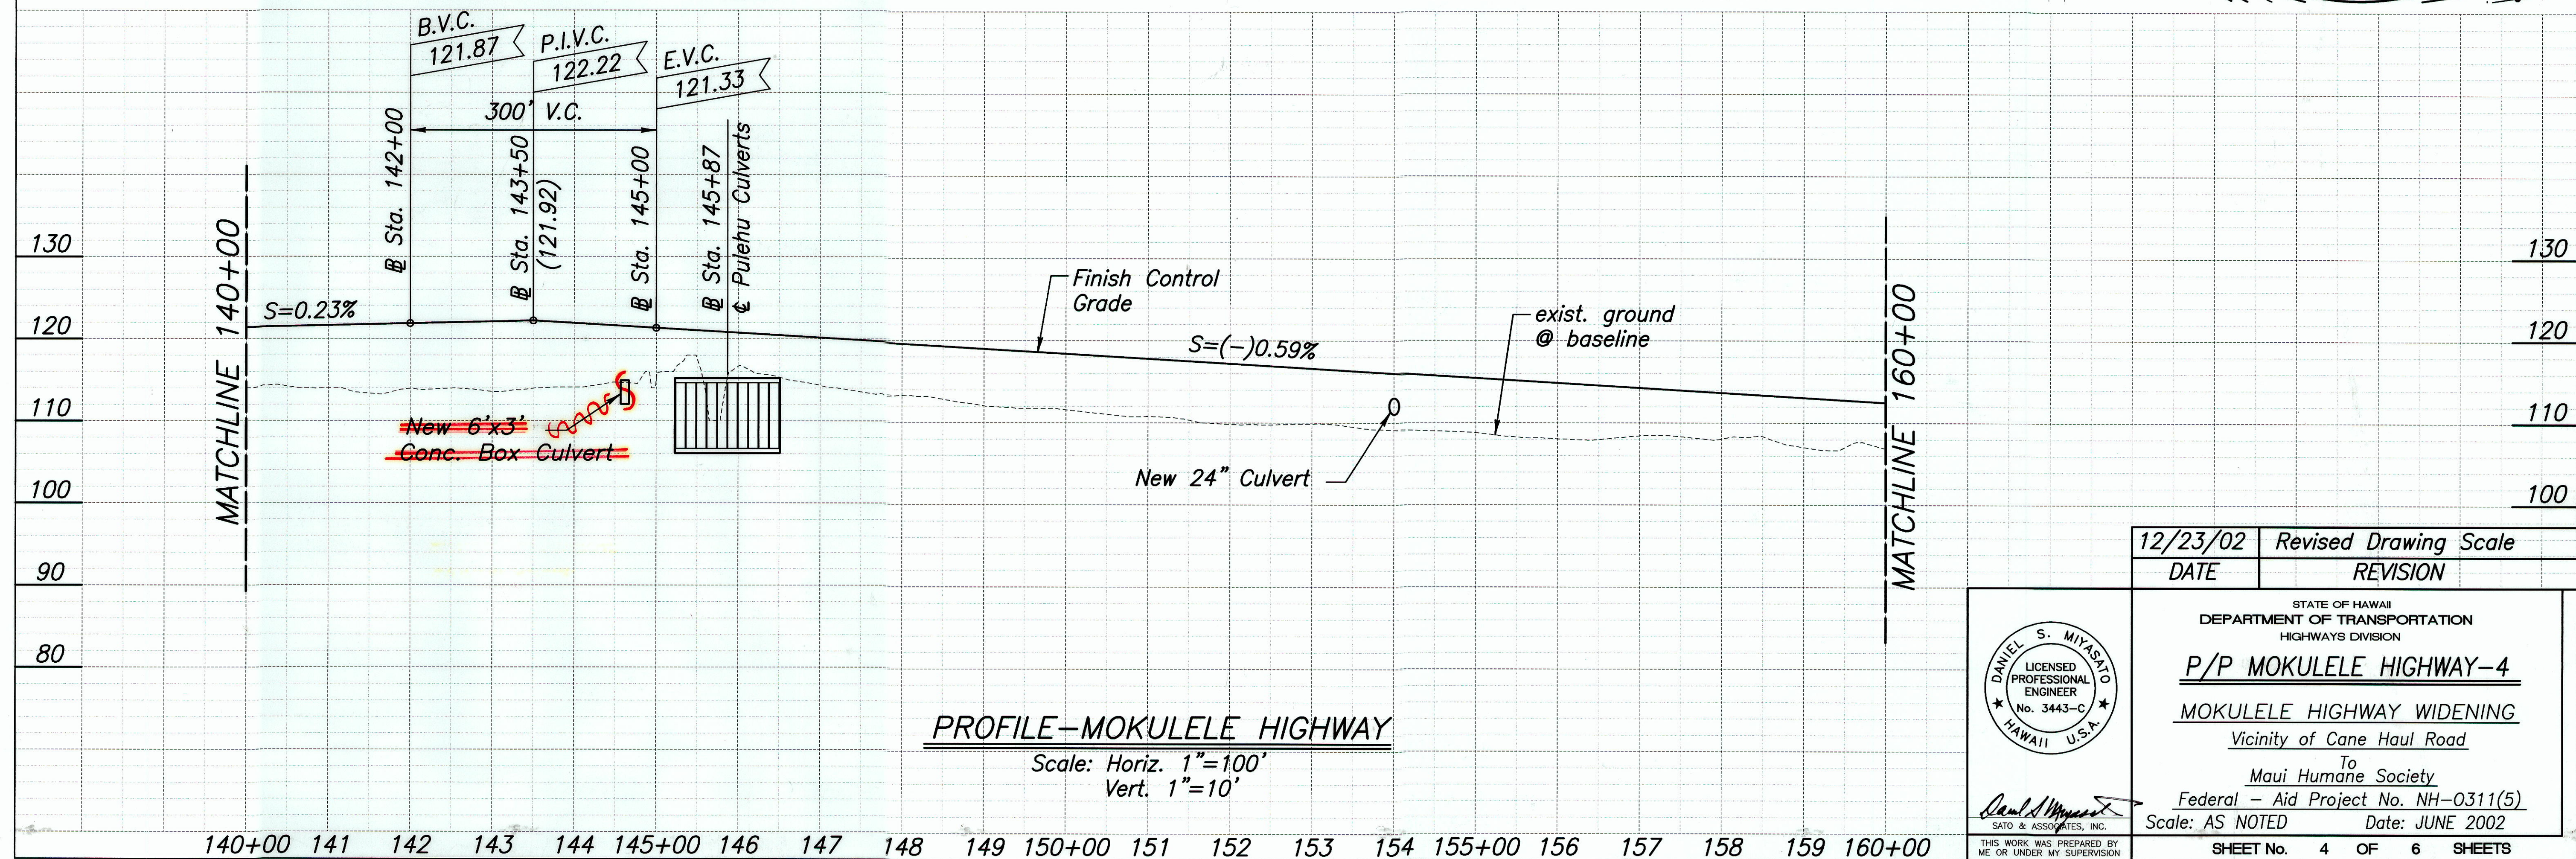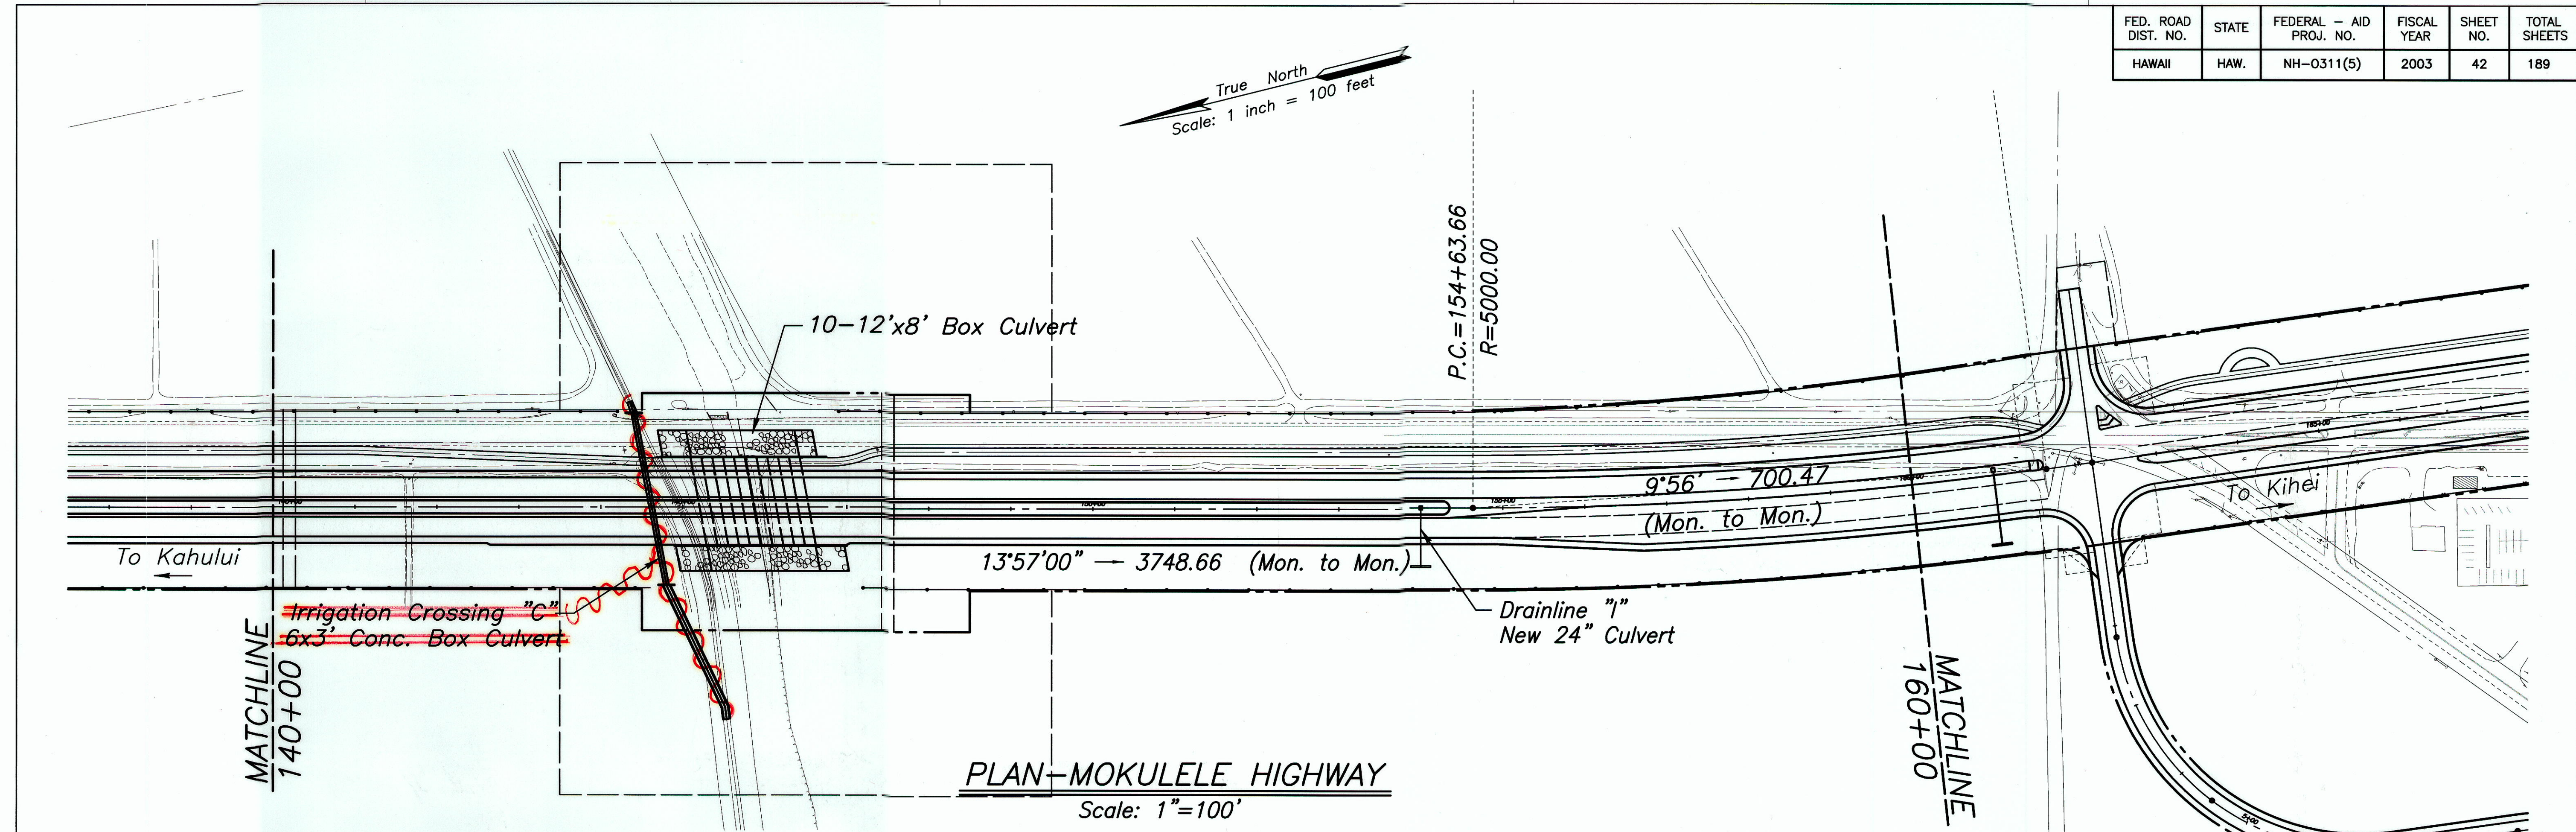


"AS-BUILT"


ADD. 42



| FED. ROAD DIST. NO. | STATE | FEDERAL - AID PROJ. NO. | FISCAL YEAR | SHEET NO. | TOTAL SHEETS |
|---------------------|-------|-------------------------|-------------|-----------|--------------|
| HAWAII              | HAW.  | NH-0311(5)              | 2003        | 43        | 189          |

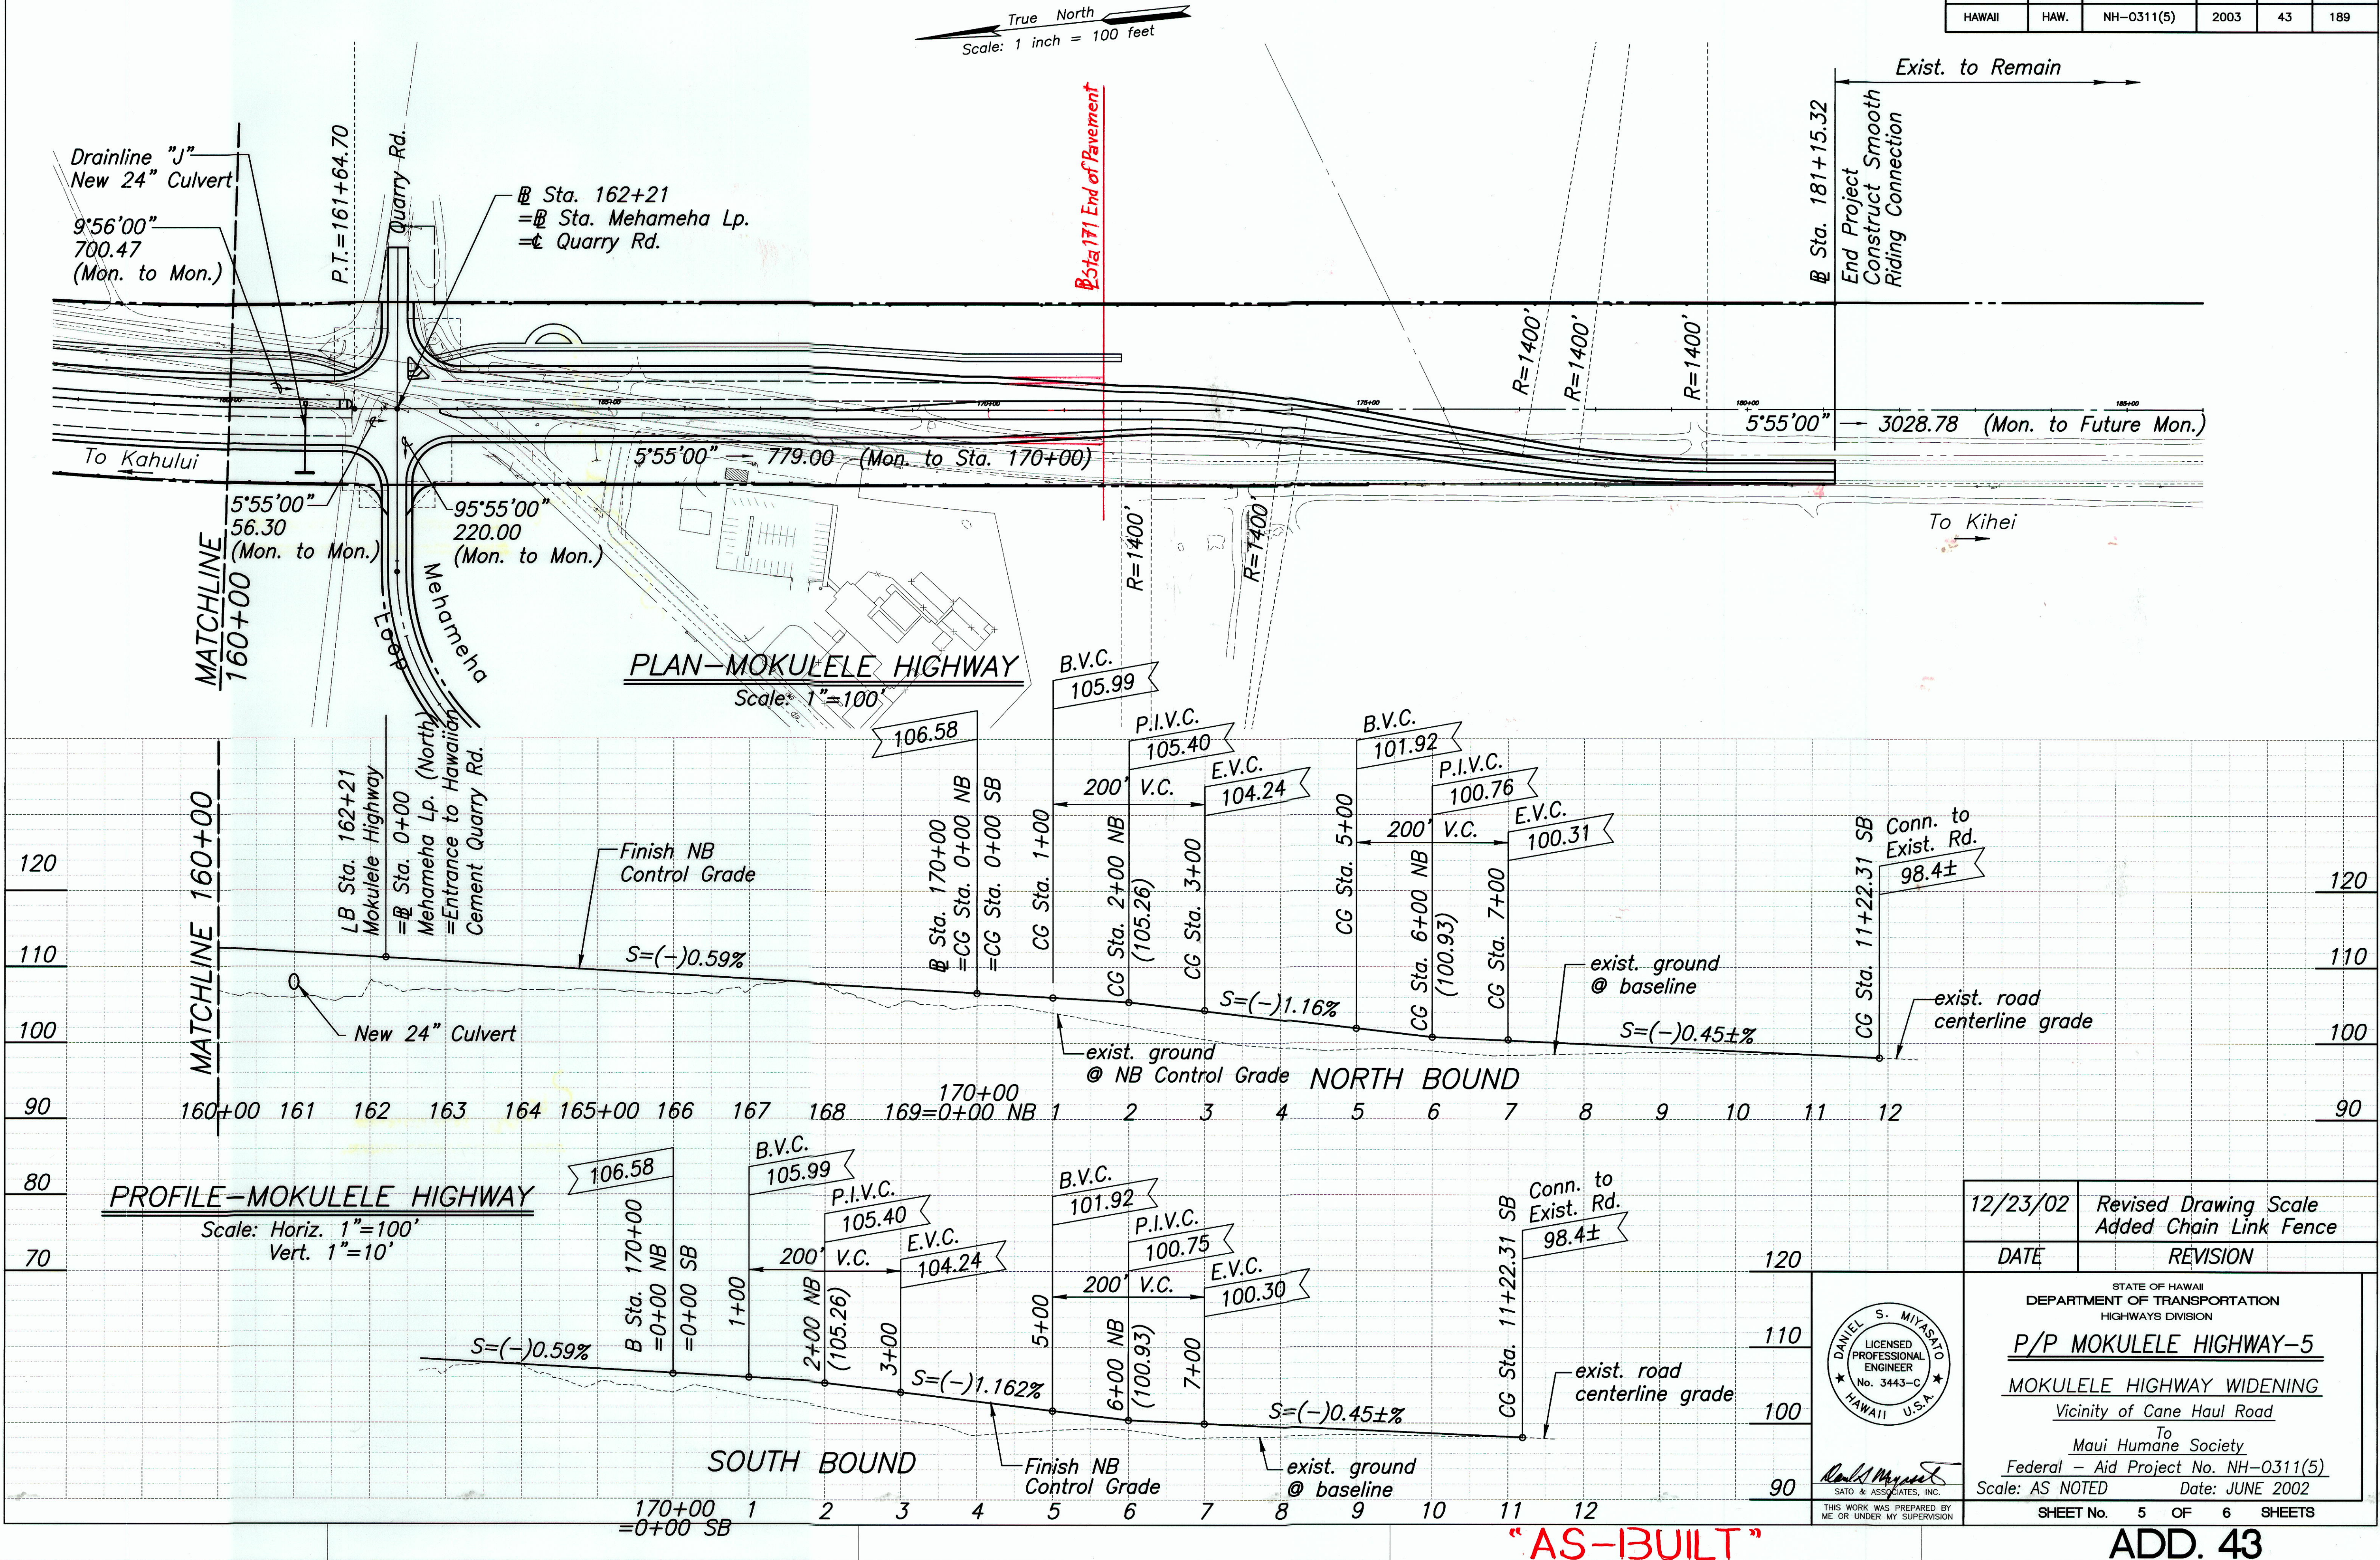

|          |                                                 |
|----------|-------------------------------------------------|
| 12/23/02 | Revised Drawing Scale<br>Added Chain Link Fence |
| DATE     | REVISION                                        |

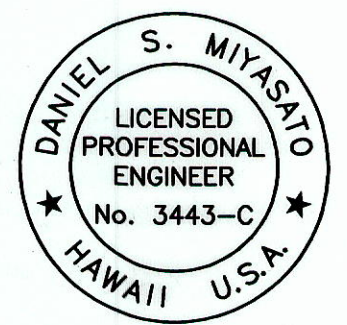


|                                                                      |
|----------------------------------------------------------------------|
| STATE OF HAWAII<br>DEPARTMENT OF TRANSPORTATION<br>HIGHWAYS DIVISION |
| <b>P/P MOKULELE HIGHWAY-5</b>                                        |
| <b>MOKULELE HIGHWAY WIDENING</b>                                     |
| Vicinity of Cane Haul Road                                           |
| To<br>Maui Humane Society                                            |
| Federal - Aid Project No. NH-0311(5)                                 |
| Scale: AS NOTED Date: JUNE 2002                                      |
| SHEET No. 5 OF 6 SHEETS                                              |

ADD. 43

|               |                   |      |
|---------------|-------------------|------|
| ORIGINAL PLAN | SURVEY PLOTTED BY | DATE |
| NOTE BOOK     | DESIGNED BY       |      |
| No.           | QUANTITIES BY     |      |
|               | CHECKED BY        |      |





| FED. ROAD DIST. NO. | STATE | FEDERAL - AID PROJ. NO. | FISCAL YEAR | SHEET NO. | TOTAL SHEETS |
|---------------------|-------|-------------------------|-------------|-----------|--------------|
| HAWAII              | HAW.  | NH-0311(5)              | 2003        | 44        | 189          |

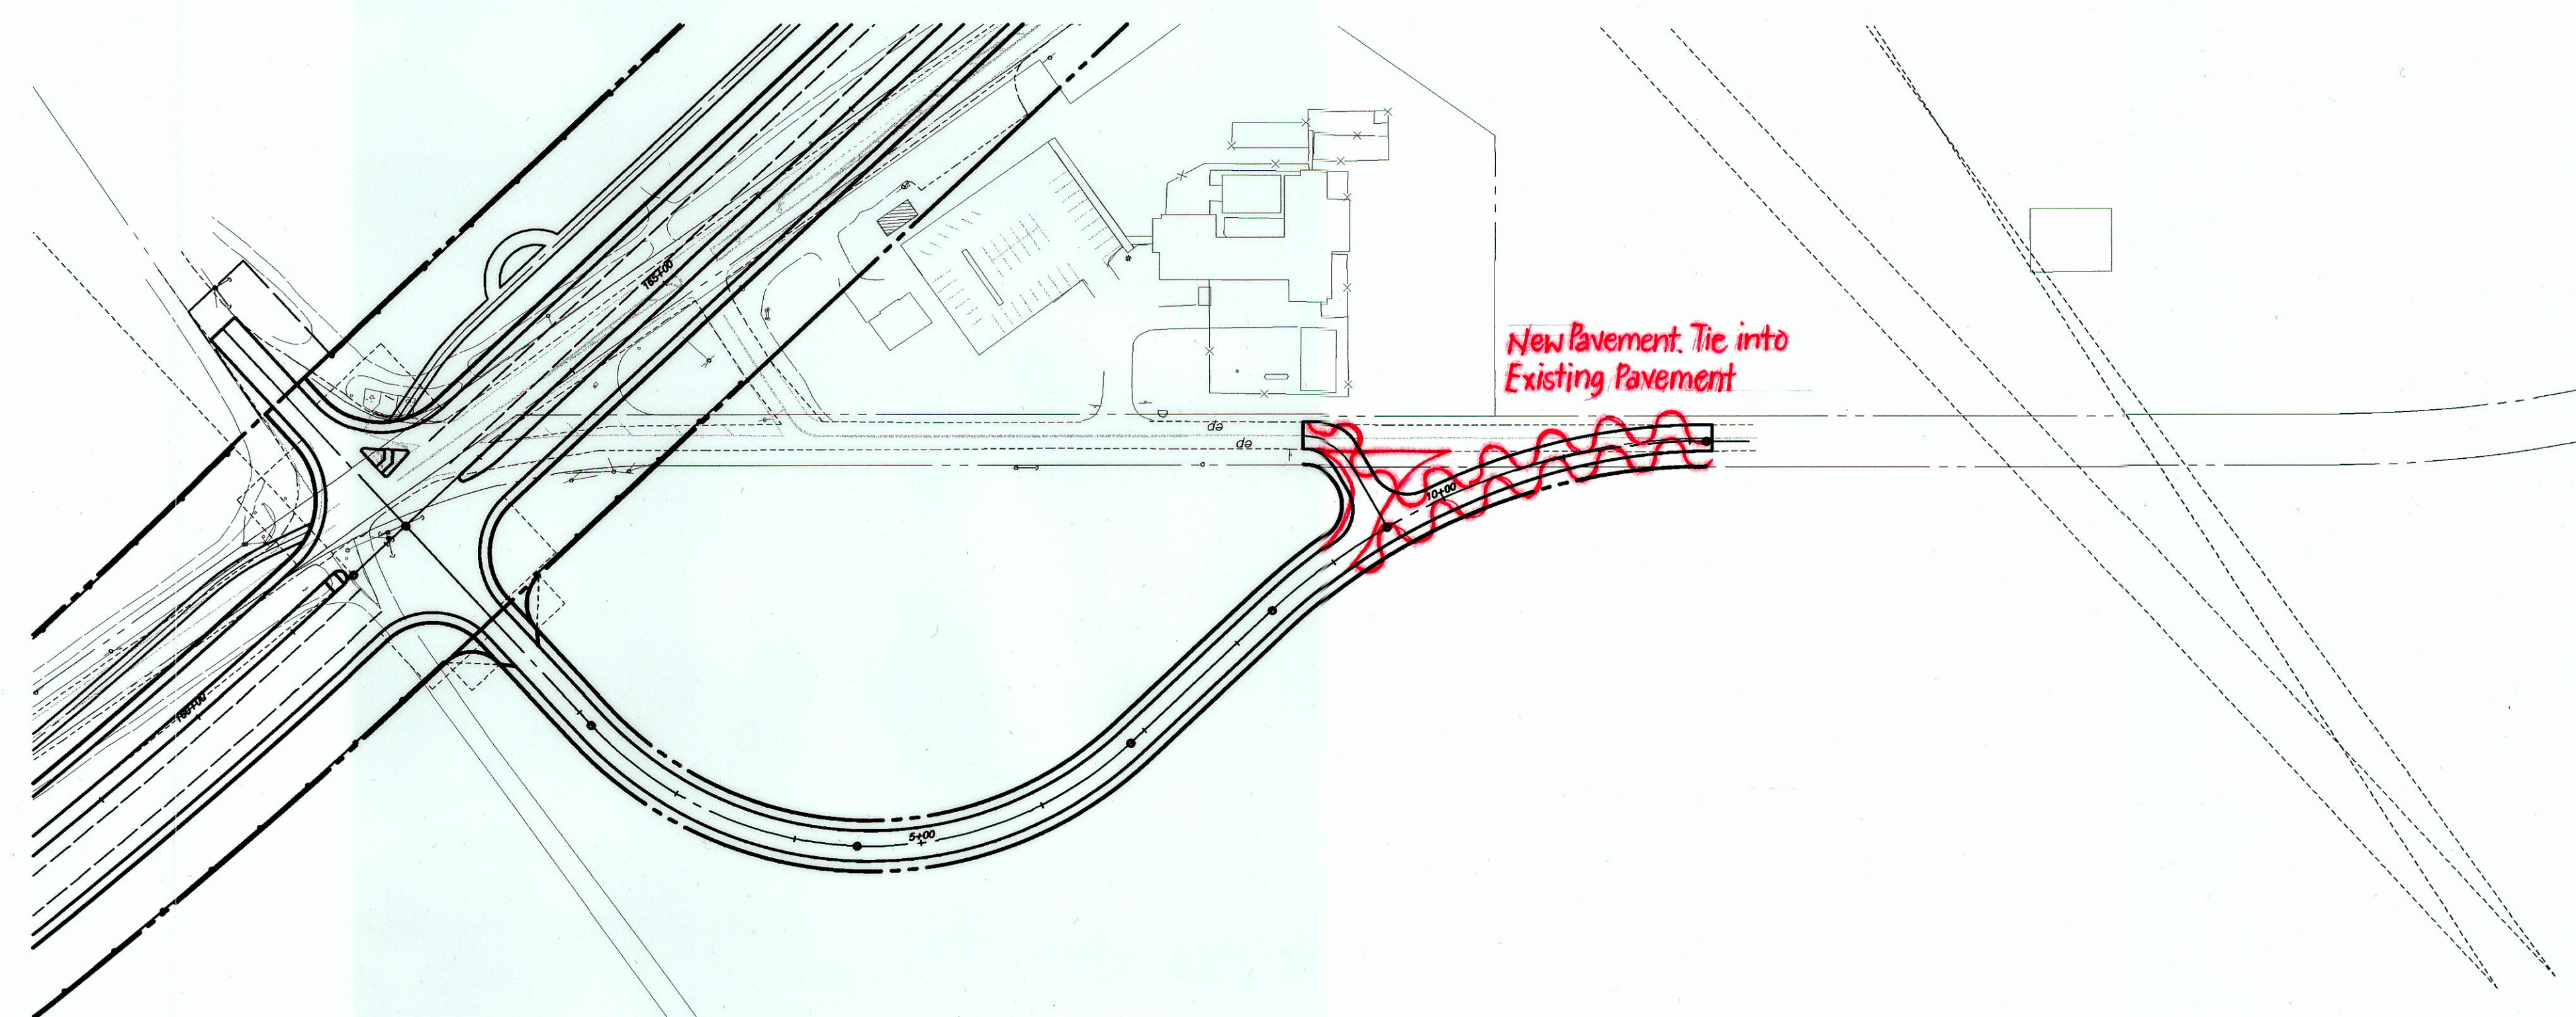

**PLAN-N. MEHAMEHA LOOP**  
Scale: 1"=100'

NOTE:  
FOR CENTRAL MAUI BASEYARD  
PLAN SEE DETAIL PLANS.

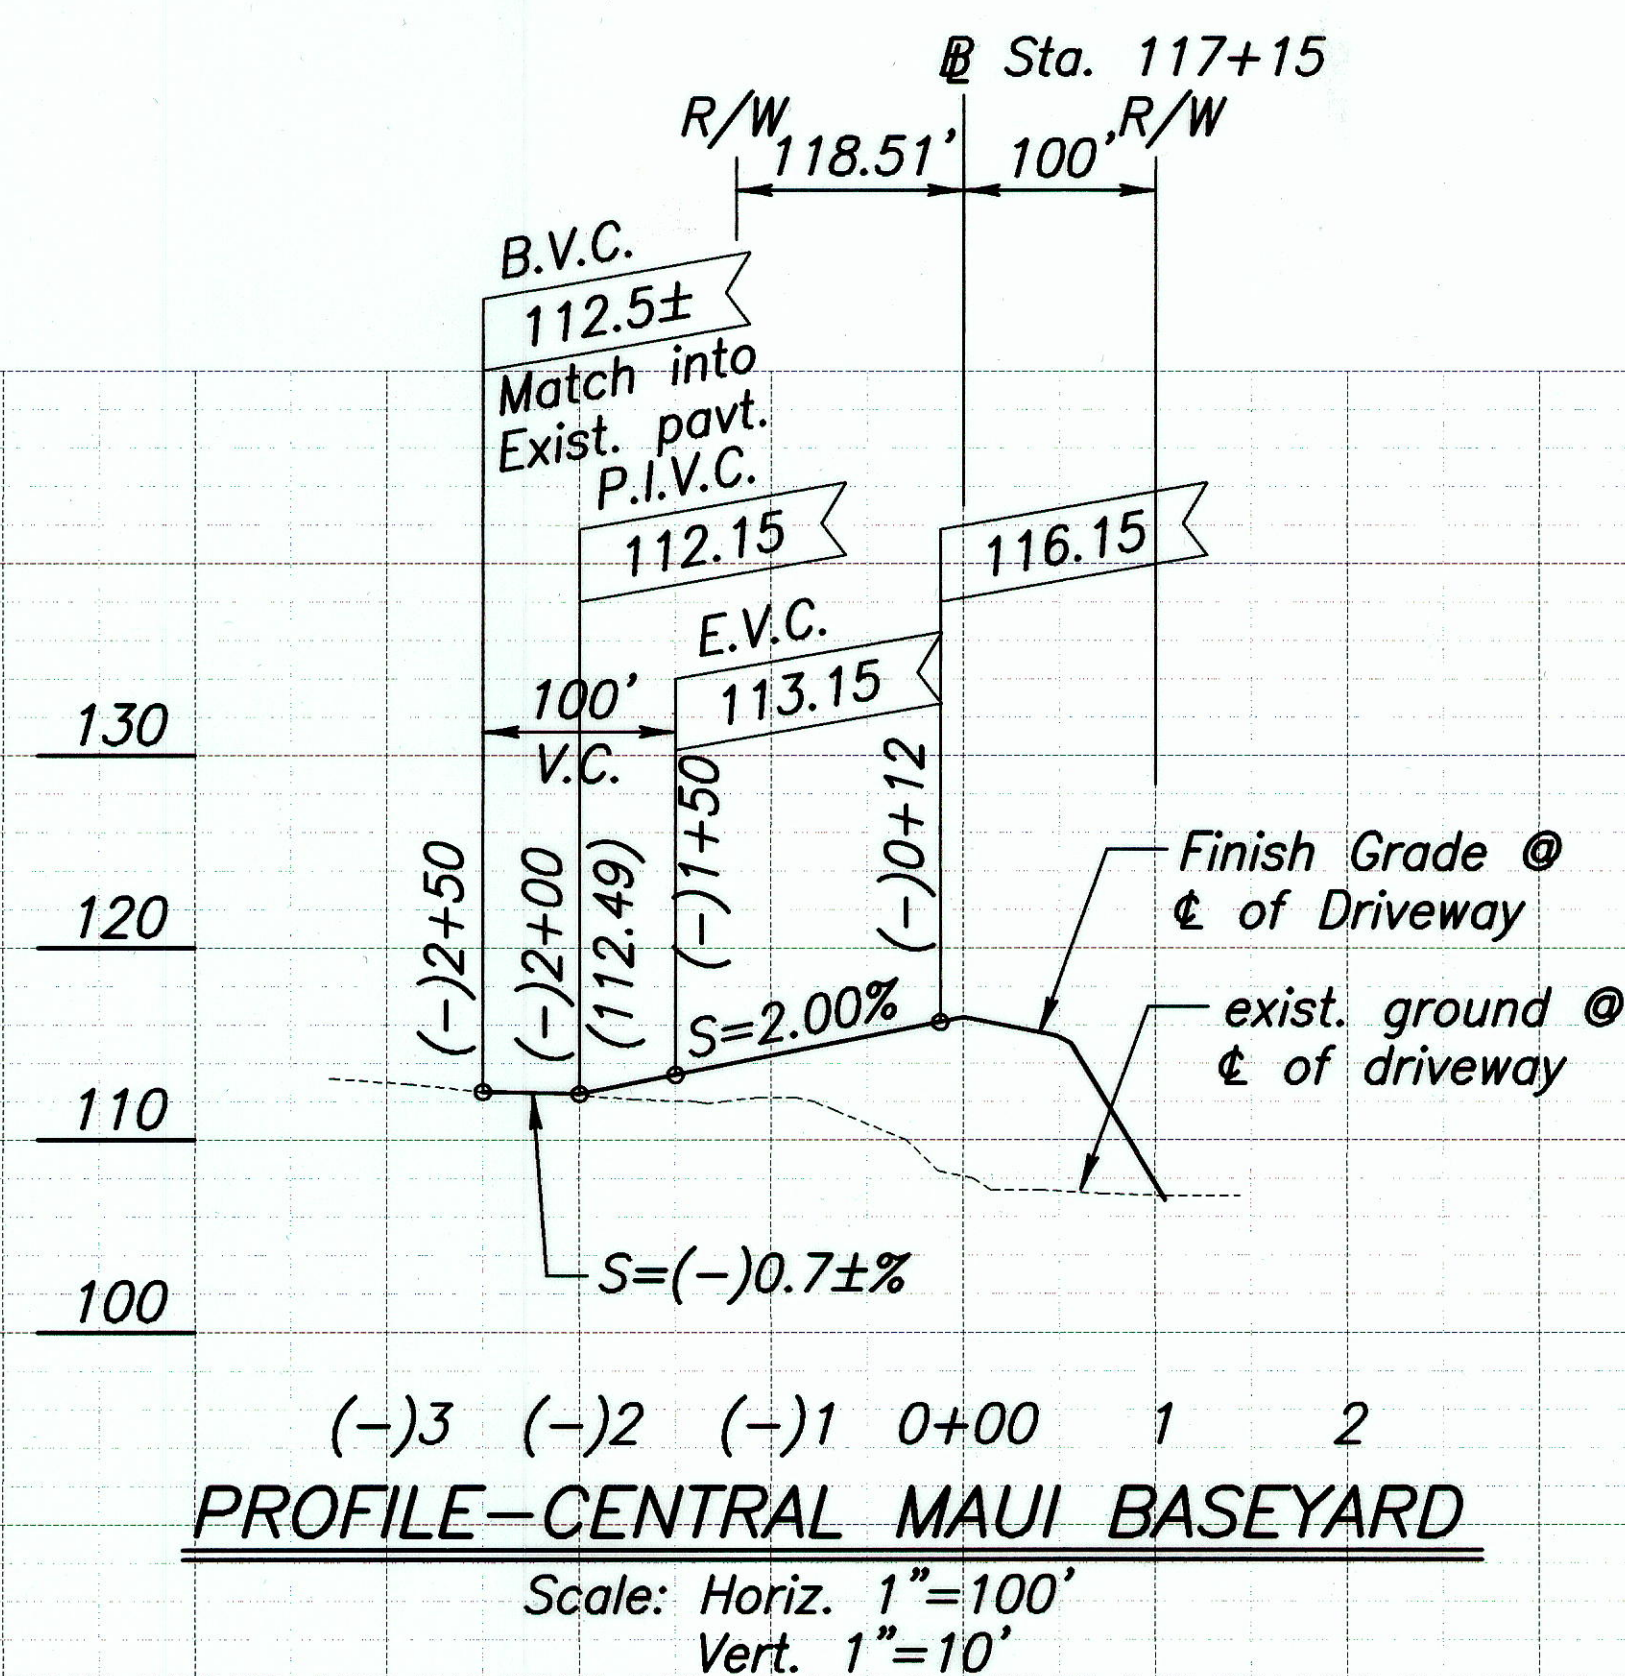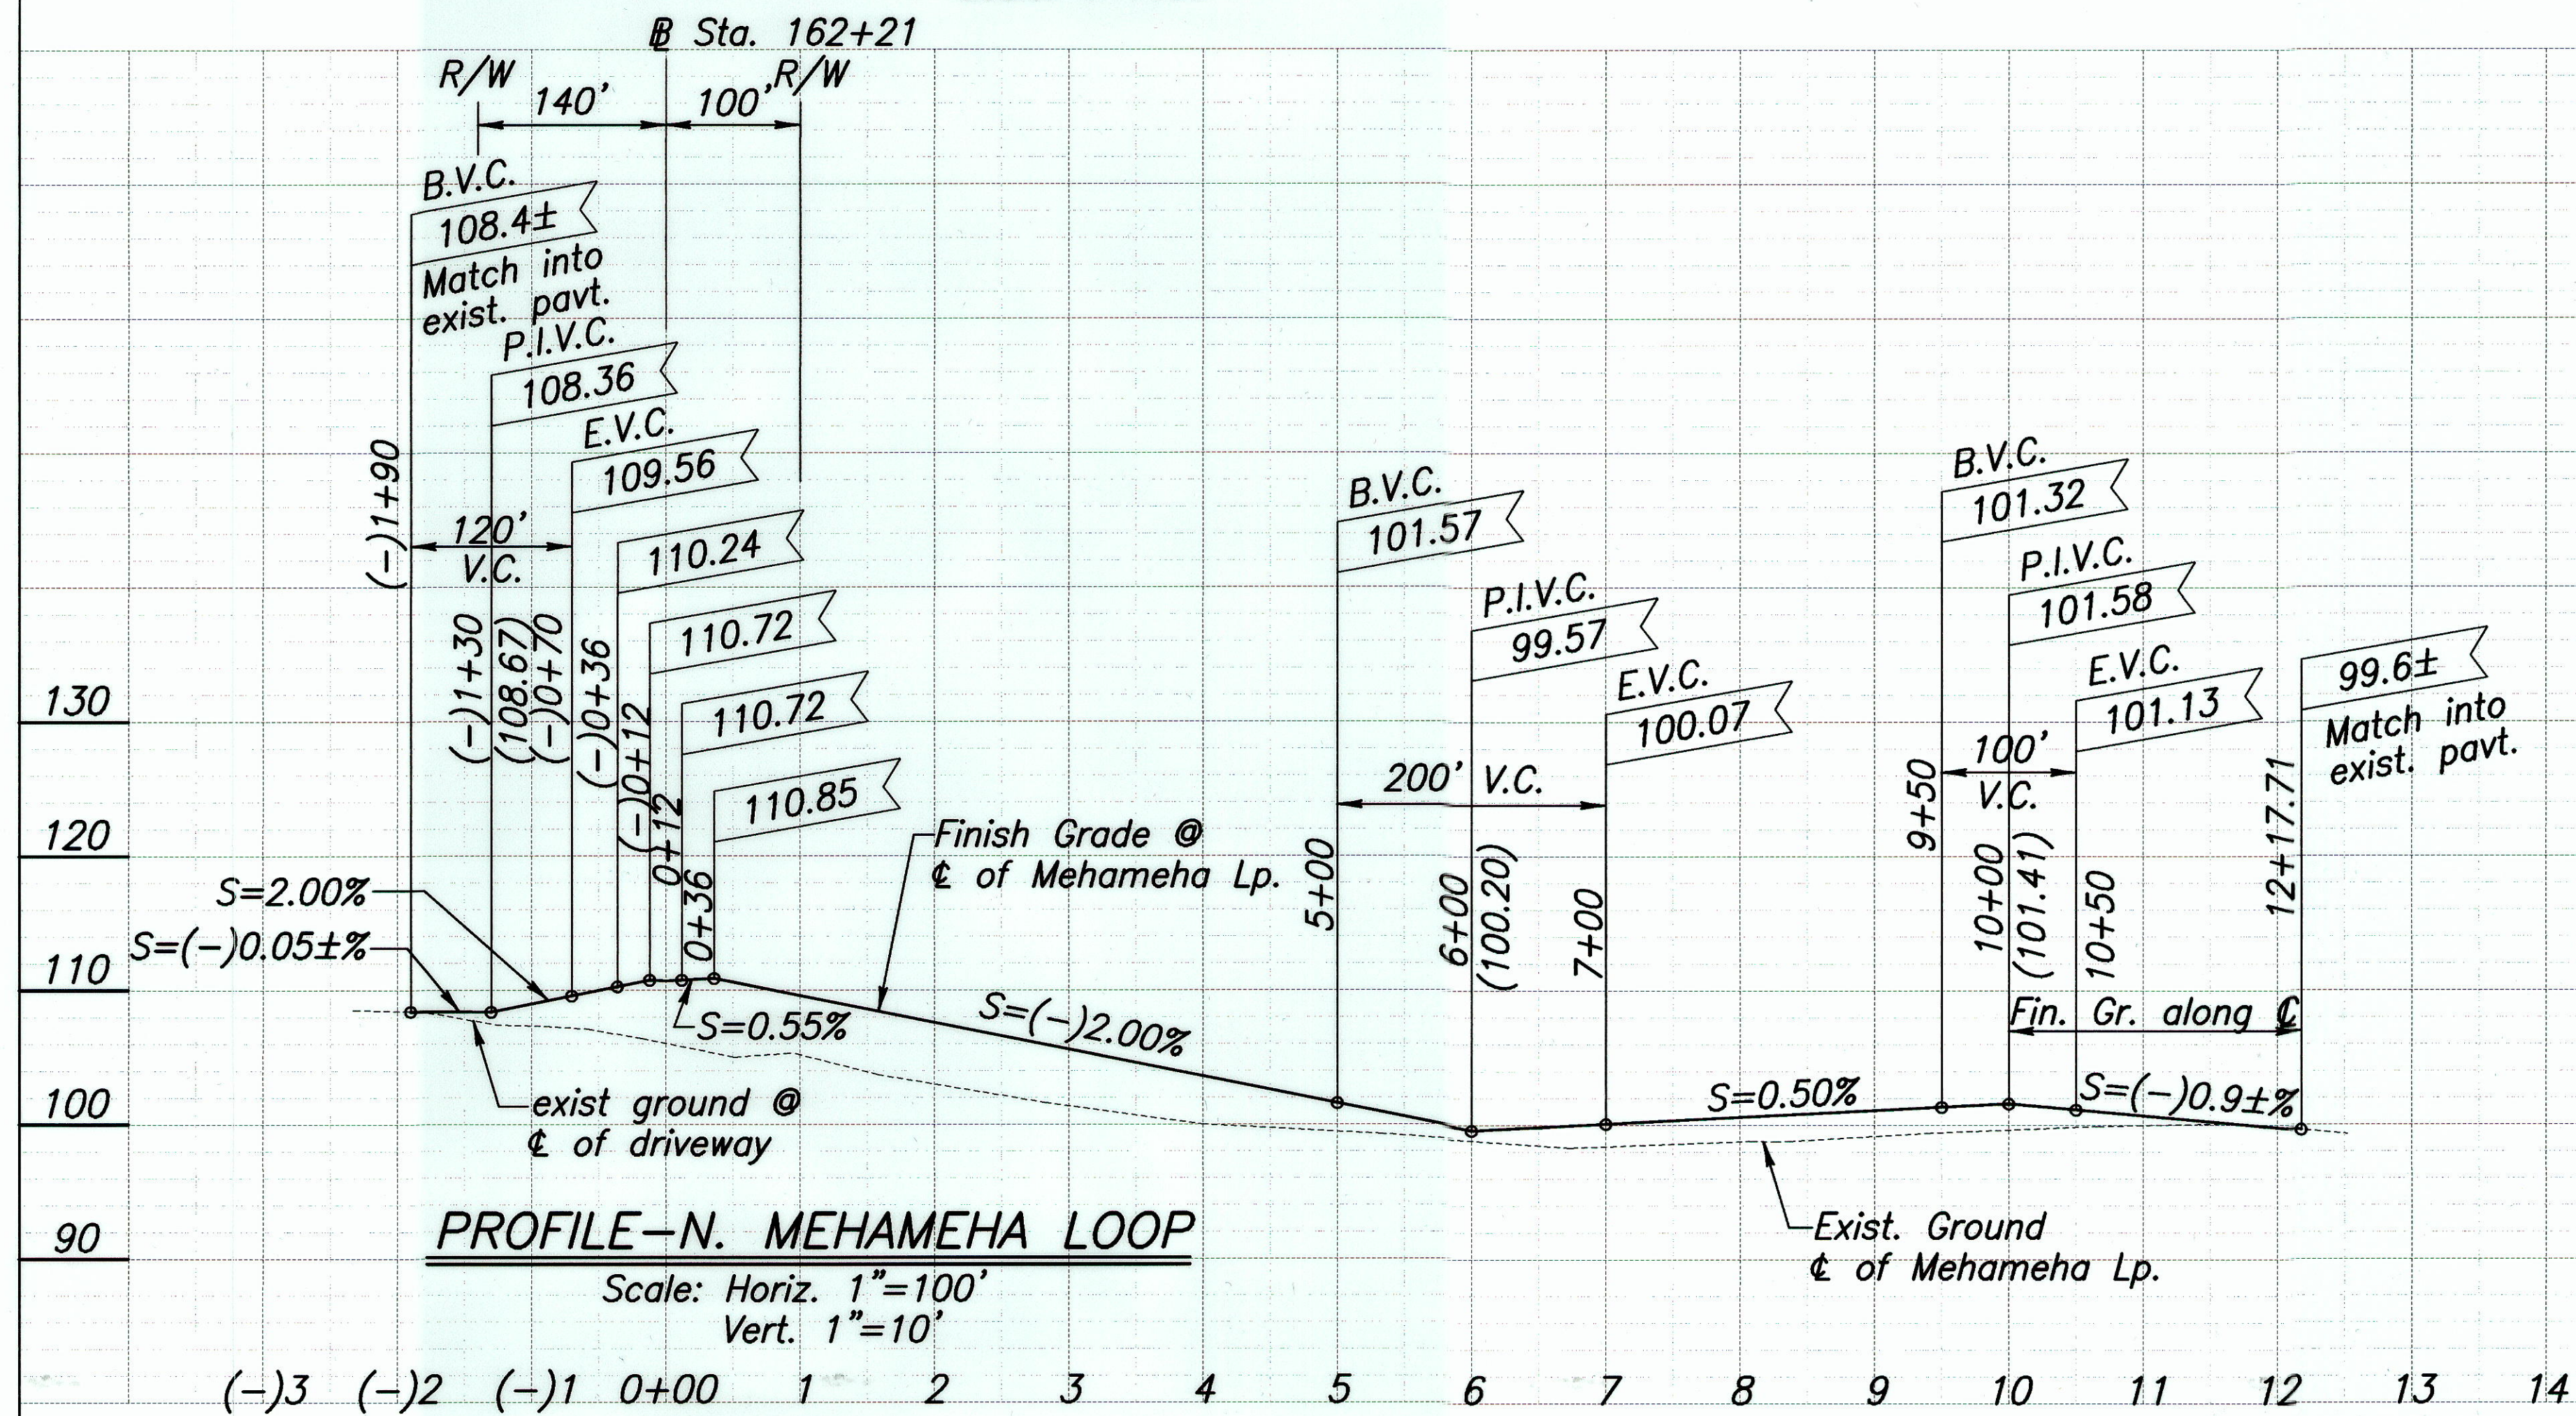

DANIEL S. MIYASATO

LICENSED PROFESSIONAL ENGINEER

No. 3443-C

HAWAII U.S.A.

STATE OF HAWAII  
DEPARTMENT OF TRANSPORTATION  
HIGHWAYS DIVISION

**PLAN and PROFILE**

**MOKULELE HIGHWAY WIDENING**

Vicinity of Cane Haul Road

To  
Maui Humane Society

Federal - Aid Project No. NH-0311(5)

Scale: AS NOTED Date: JUNE 2002

SHEET No. 6 OF 6 SHEETS

"AS-BUILT"