


FED. ROAD DIST. NO.	STATE	FEDERAL - AID PROJ. NO.	FISCAL YEAR	SHEET NO.	TOTAL SHEETS
HAWAII	HAW.	NH-0311(5)	2003	92	189

True North
Scale: 1 inch = 40 feet

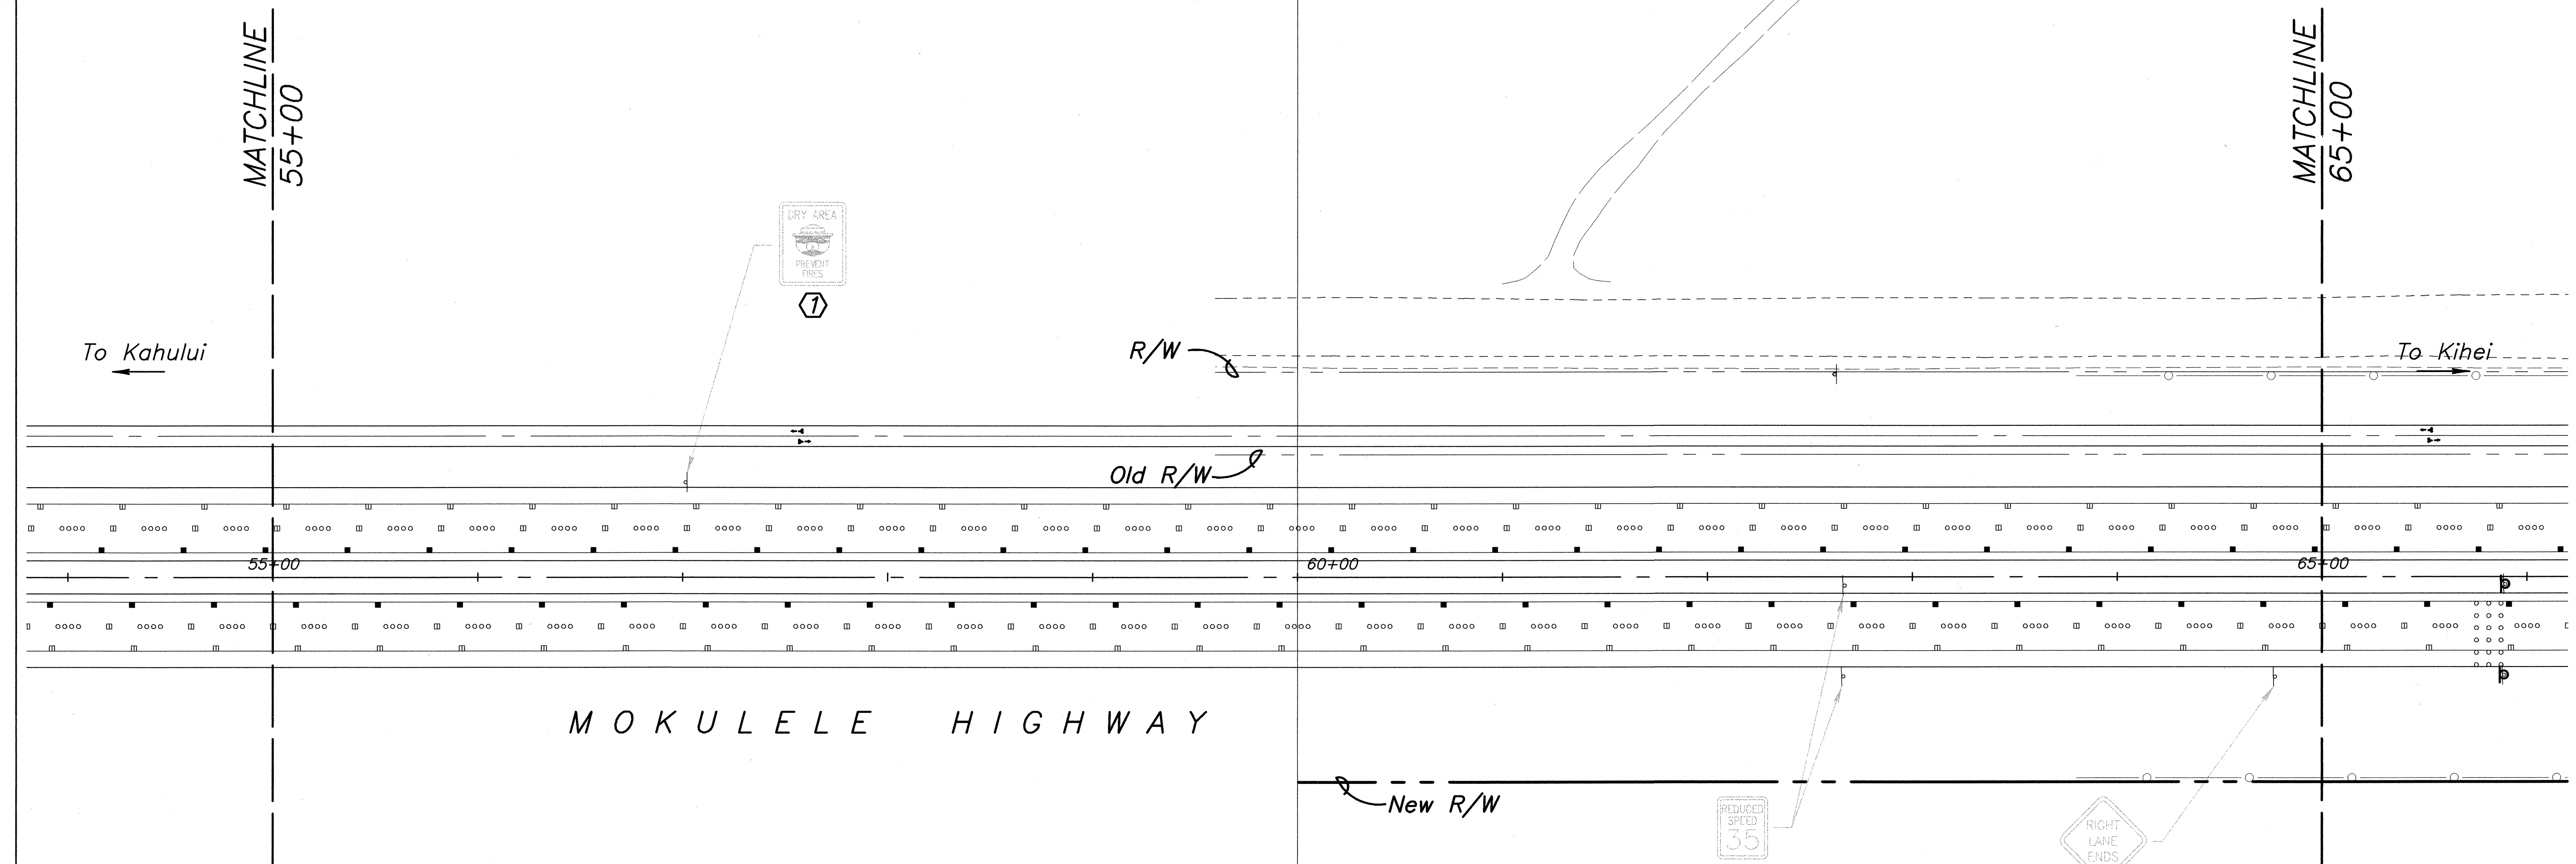

Notes:
Install New Sign(s) & Post(s) as shown unless otherwise specified (1)

- ① Existing sign(s) & post(s) to remain
- ② Remove existing sign(s) & post(s)
- ③ Remove existing & Install New Sign(s) & Post(s)
- ④ Relocate existing sign(s) & post(s)

Neatly bundle signs & posts to be removed and return to Highways Kahului Baseyard
For Details of Signs See Shts. 111

ORIGINAL PLAN	SURVEY PLOTTED BY	DATE
NOTE BOOK	DRAWN BY	
	DESIGNED BY	
	QUANTITIES BY	
	CHECKED BY	
	No.	

DANIEL S. MIYAKAWA
LICENSED PROFESSIONAL ENGINEER
No. 3443-C
HAWAII U.S.A.

SATO & ASSOCIATES, INC.
THIS WORK WAS PREPARED BY ME OR UNDER MY SUPERVISION

STATE OF HAWAII
DEPARTMENT OF TRANSPORTATION
HIGHWAYS DIVISION


STRIPING AND SIGNAGE PLAN

MOKULELE HIGHWAY WIDENING
Vicinity of Cane Haul Road
To
Maui Humane Society
Federal - Aid Project No. NH-0311(5)
Scale: 1"=40' Date: JUNE 2002

SHEET No. 1 OF 14 SHEETS

FED. ROAD DIST. NO.	STATE	FEDERAL - AID PROJ. NO.	FISCAL YEAR	SHEET NO.	TOTAL SHEETS
HAWAII	HAW.	NH-0311(5)	2003	93	189

True North
Scale: 1 inch = 40 feet

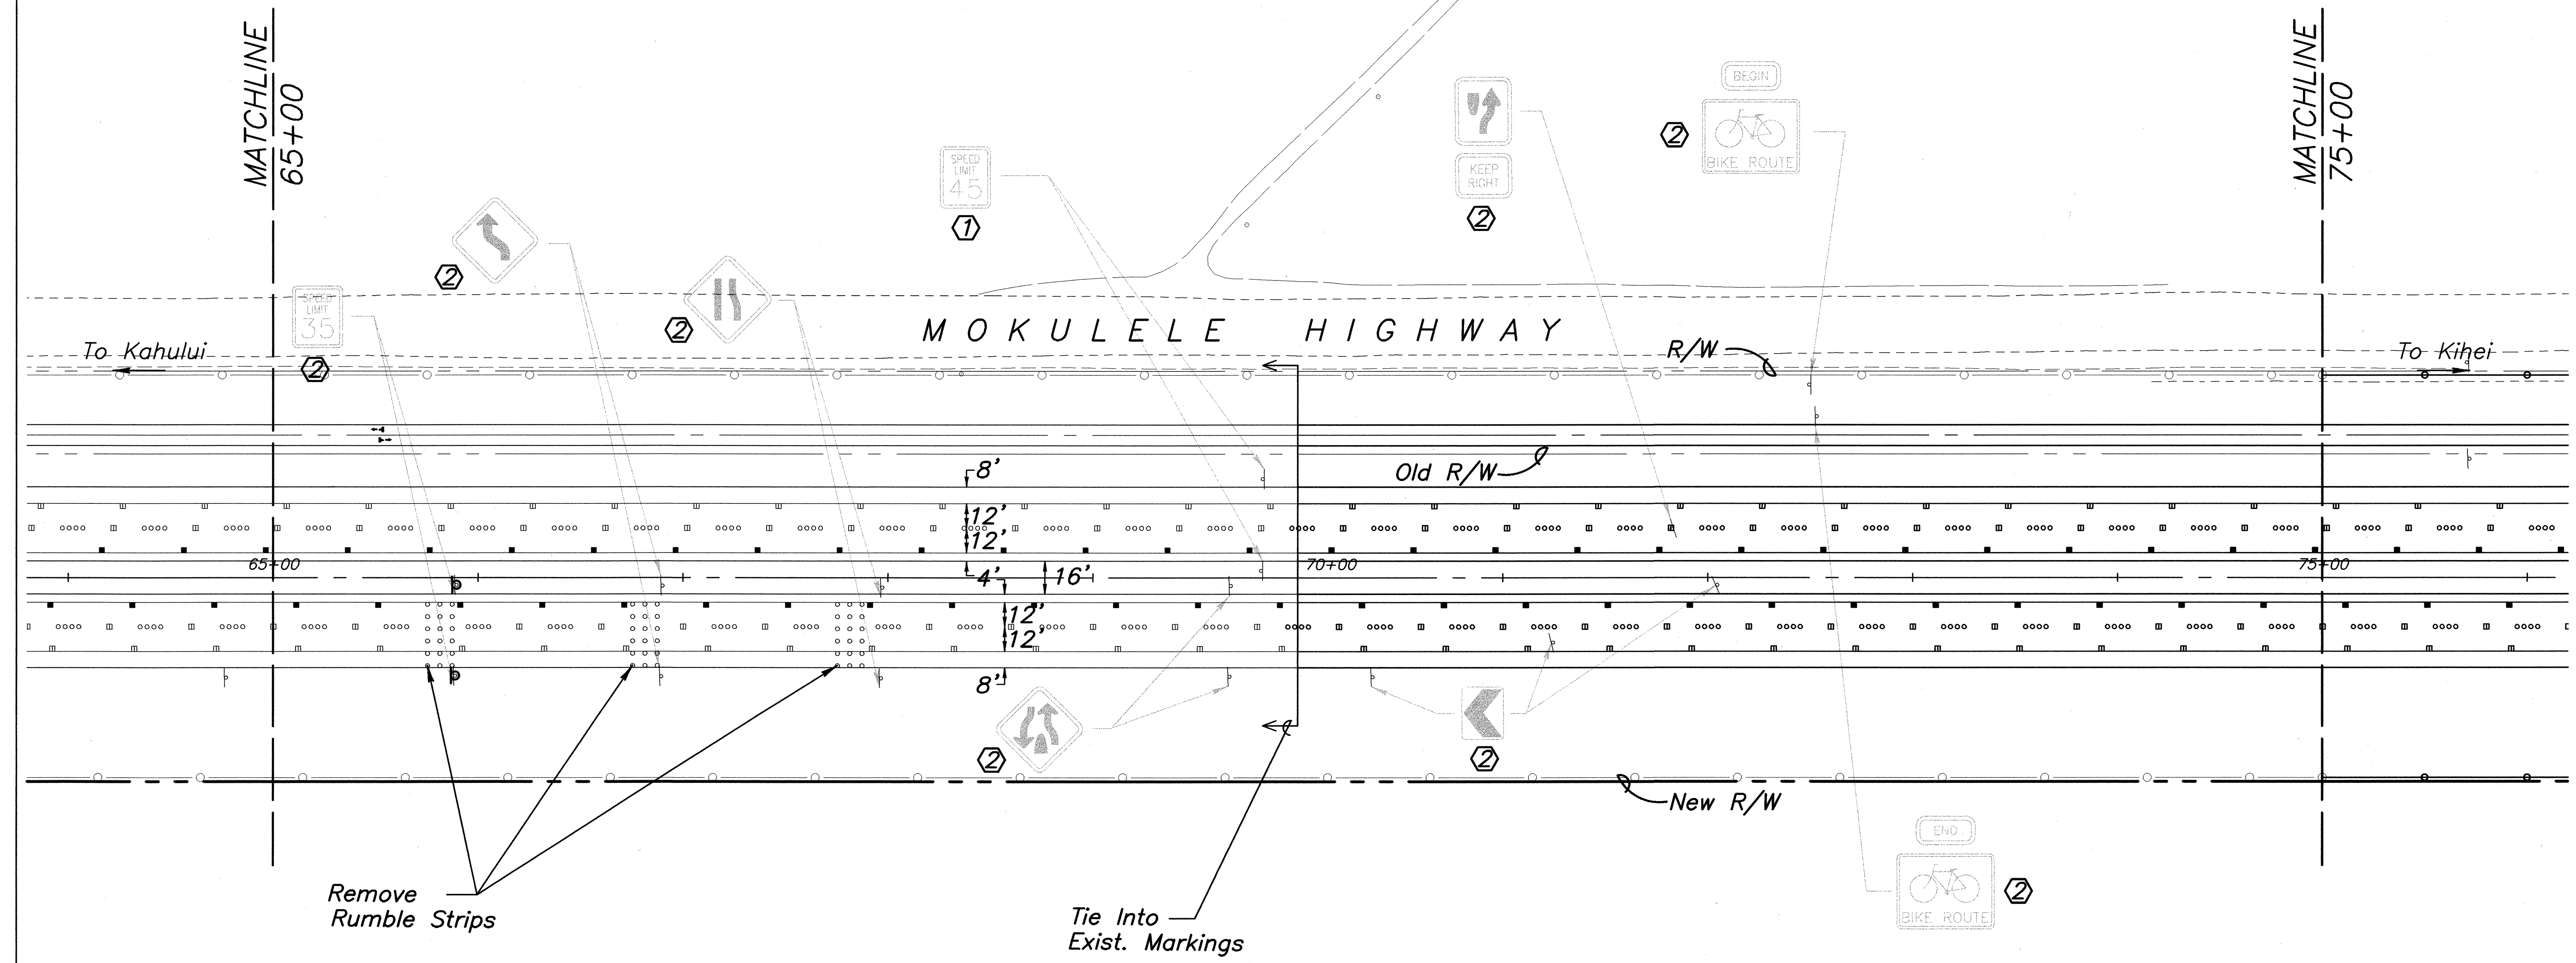

Notes:

- Install New Sign(s) & Post(s) as shown unless otherwise specified (1)
- ① Existing sign(s) & post(s) to remain
 - ② Remove existing sign(s) & post(s)
 - ③ Remove existing & Install New Sign(s) & Post(s)
 - ④ Relocate existing sign(s) & post(s)
- Neatly bundle signs & posts to be removed and return to Highways Kahului Baseyard
For Details of Signs See Shts. 111

ORIGINAL PLAN	SURVEY PLOTTED BY	DATE
NOTE BOOK	DRAWN BY	
	DESIGNED BY	
	QUANTITIES BY	
	CHECKED BY	
No.		

THIS WORK WAS PREPARED BY ME OR UNDER MY SUPERVISION


STATE OF HAWAII
DEPARTMENT OF TRANSPORTATION
HIGHWAYS DIVISION

STRIPING AND SIGNAGE PLAN

MOKULELE HIGHWAY WIDENING
Vicinity of Cane Haul Road
To
Maui Humane Society
Federal - Aid Project No. NH-0311(5)
Scale: 1"=40' Date: JUNE 2002

SHEET No. 2 OF 14 SHEETS

FED. ROAD DIST. NO.	STATE	FEDERAL - AID PROJ. NO.	FISCAL YEAR	SHEET NO.	TOTAL SHEETS
HAWAII	HAW.	NH-0311(5)	2003	94	189

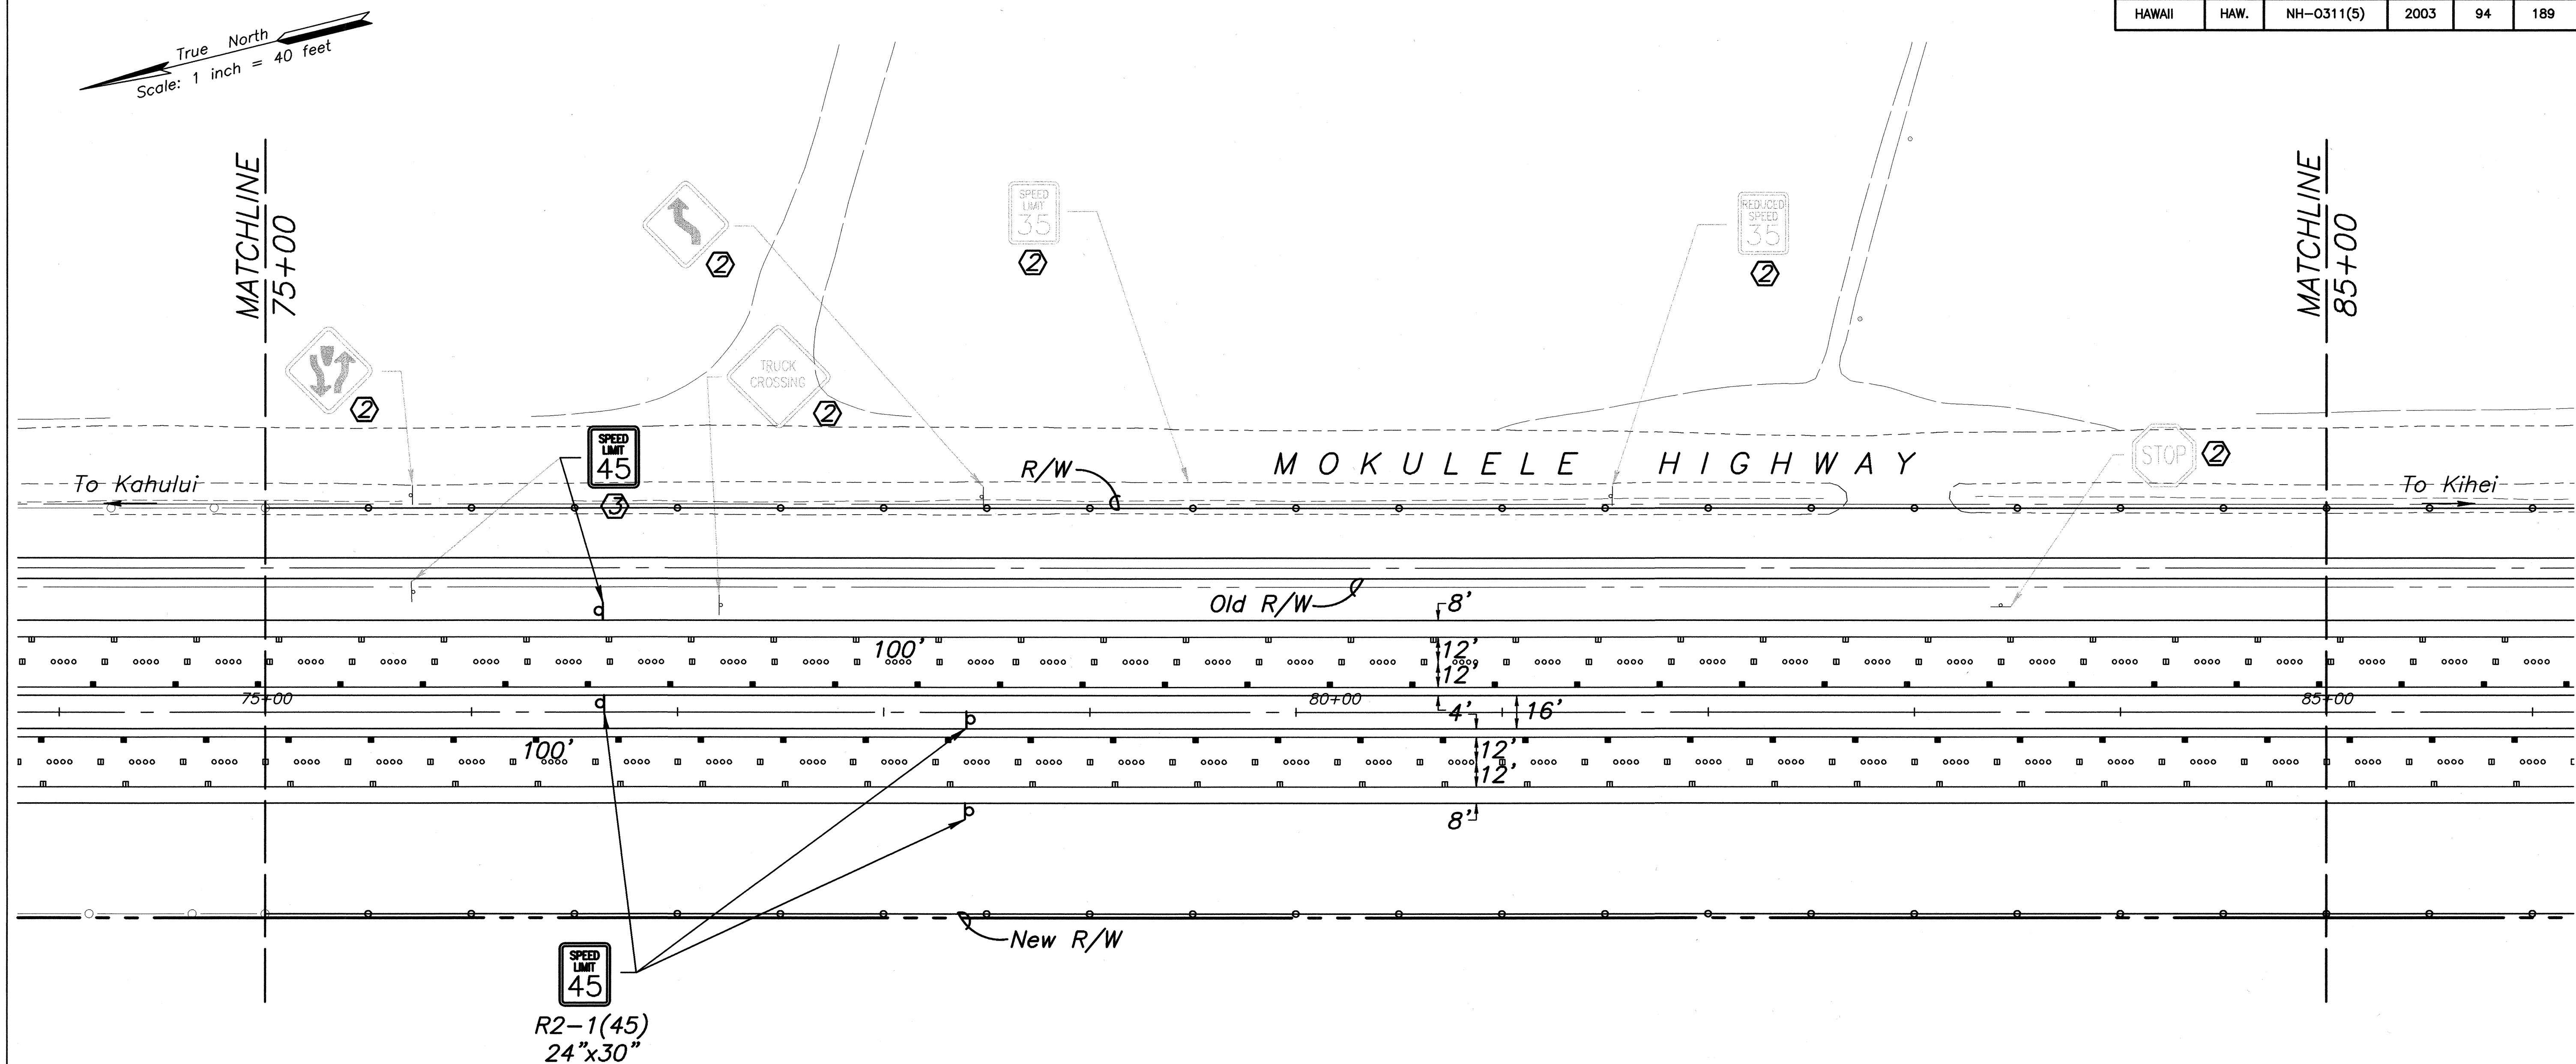


Notes:

Install New Sign(s) & Post(s) as shown
unless otherwise specified (1)

- ① Existing sign(s) & post(s) to remain
- ② Remove existing sign(s) & post(s)
- ③ Remove existing & Install New Sign(s) & Post(s)
- ④ Relocate existing sign(s) & post(s)

Neatly bundle signs & posts to be removed and
return to Highways Kahului Baseyard
For Details of Signs See Shts. 111

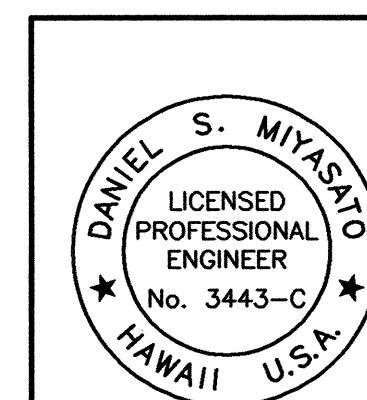

SATO & ASSOCIATES, INC.
THIS WORK WAS PREPARED BY
ME OR UNDER MY SUPERVISION

STATE OF HAWAII
DEPARTMENT OF TRANSPORTATION
HIGHWAYS DIVISION

STRIPING AND SIGNAGE PLAN

MOKULELE HIGHWAY WIDENING

Vicinity of Cane Haul Road

To
Maui Humane Society


Federal - Aid Project No. NH-0311(5)

Scale: 1"=40' Date: JUNE 2002

SHEET No. 3 OF 14 SHEETS

FED. ROAD DIST. NO.	STATE	FEDERAL - AID PROJ. NO.	FISCAL YEAR	SHEET NO.	TOTAL SHEETS
HAWAII	HAW.	NH-0311(5)	2003	95	189

True North
Scale: 1 inch = 40 feet

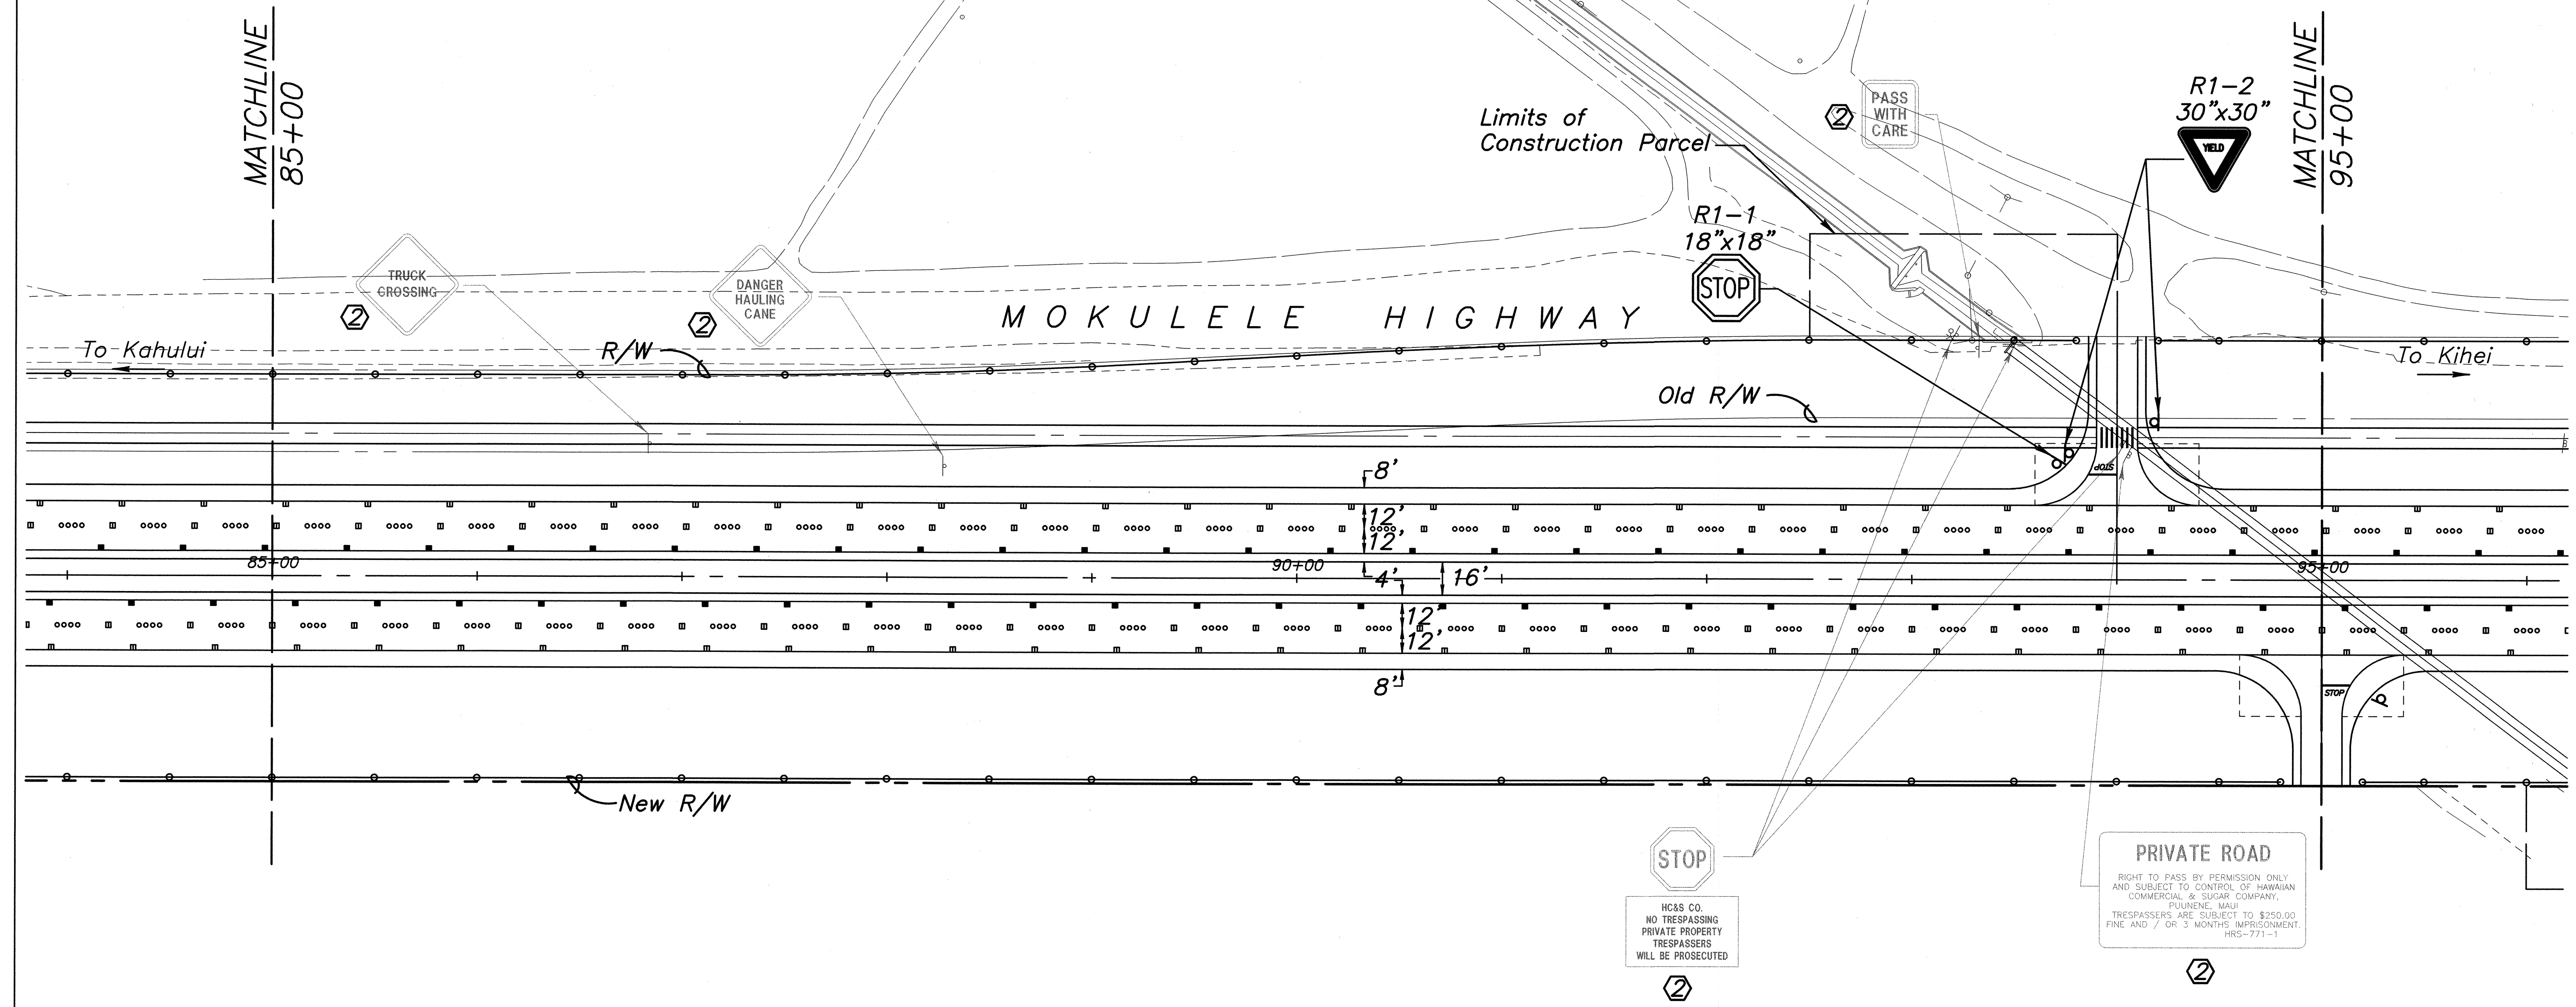


Notes:

Install New Sign(s) & Post(s) as shown unless otherwise specified (1)

- ① Existing sign(s) & post(s) to remain
- ② Remove existing sign(s) & post(s)
- ③ Remove existing & Install New Sign(s) & Post(s)
- ④ Relocate existing sign(s) & post(s)

Neatly bundle signs & posts to be removed and return to Highways Kahului Baseyard
For Details of Signs See Shts. 111

12/23/02	Added Access Road at Baseline Station 94+00 & 95+00, Added Yield and Stop Signs and Striping For Access Road
DATE	REVISION

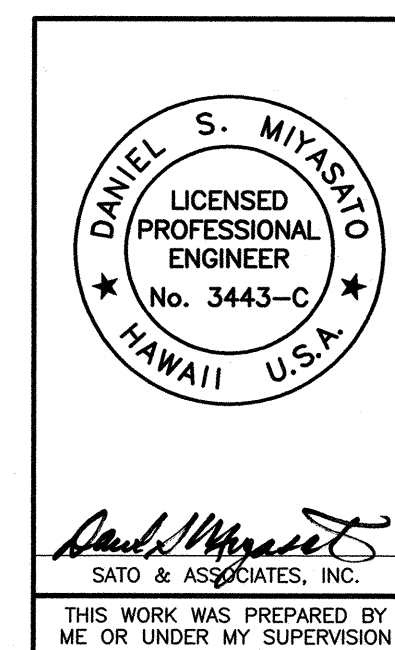

STATE OF HAWAII
DEPARTMENT OF TRANSPORTATION
HIGHWAYS DIVISION

STRIPING AND SIGNAGE PLAN

MOKULELE HIGHWAY WIDENING
Vicinity of Cane Haul Road

To
Maui Humane Society
Federal - Aid Project No. NH-0311(5)
Scale: 1"=40' Date: JUNE 2002


SHEET No. 4 OF 14 SHEETS

ADD. 95

SURVEY PLOTTED BY	DATE
DRAWN BY	
CHECKED BY	
DESIGNED BY	
QUANTITIES BY	
CHECKED BY	
No.	

FED. ROAD DIST. NO.	STATE	FEDERAL - AID PROJ. NO.	FISCAL YEAR	SHEET NO.	TOTAL SHEETS
HAWAII	HAW.	NH-0311(5)	2003	96	189

True North
Scale: 1 inch = 40 feet

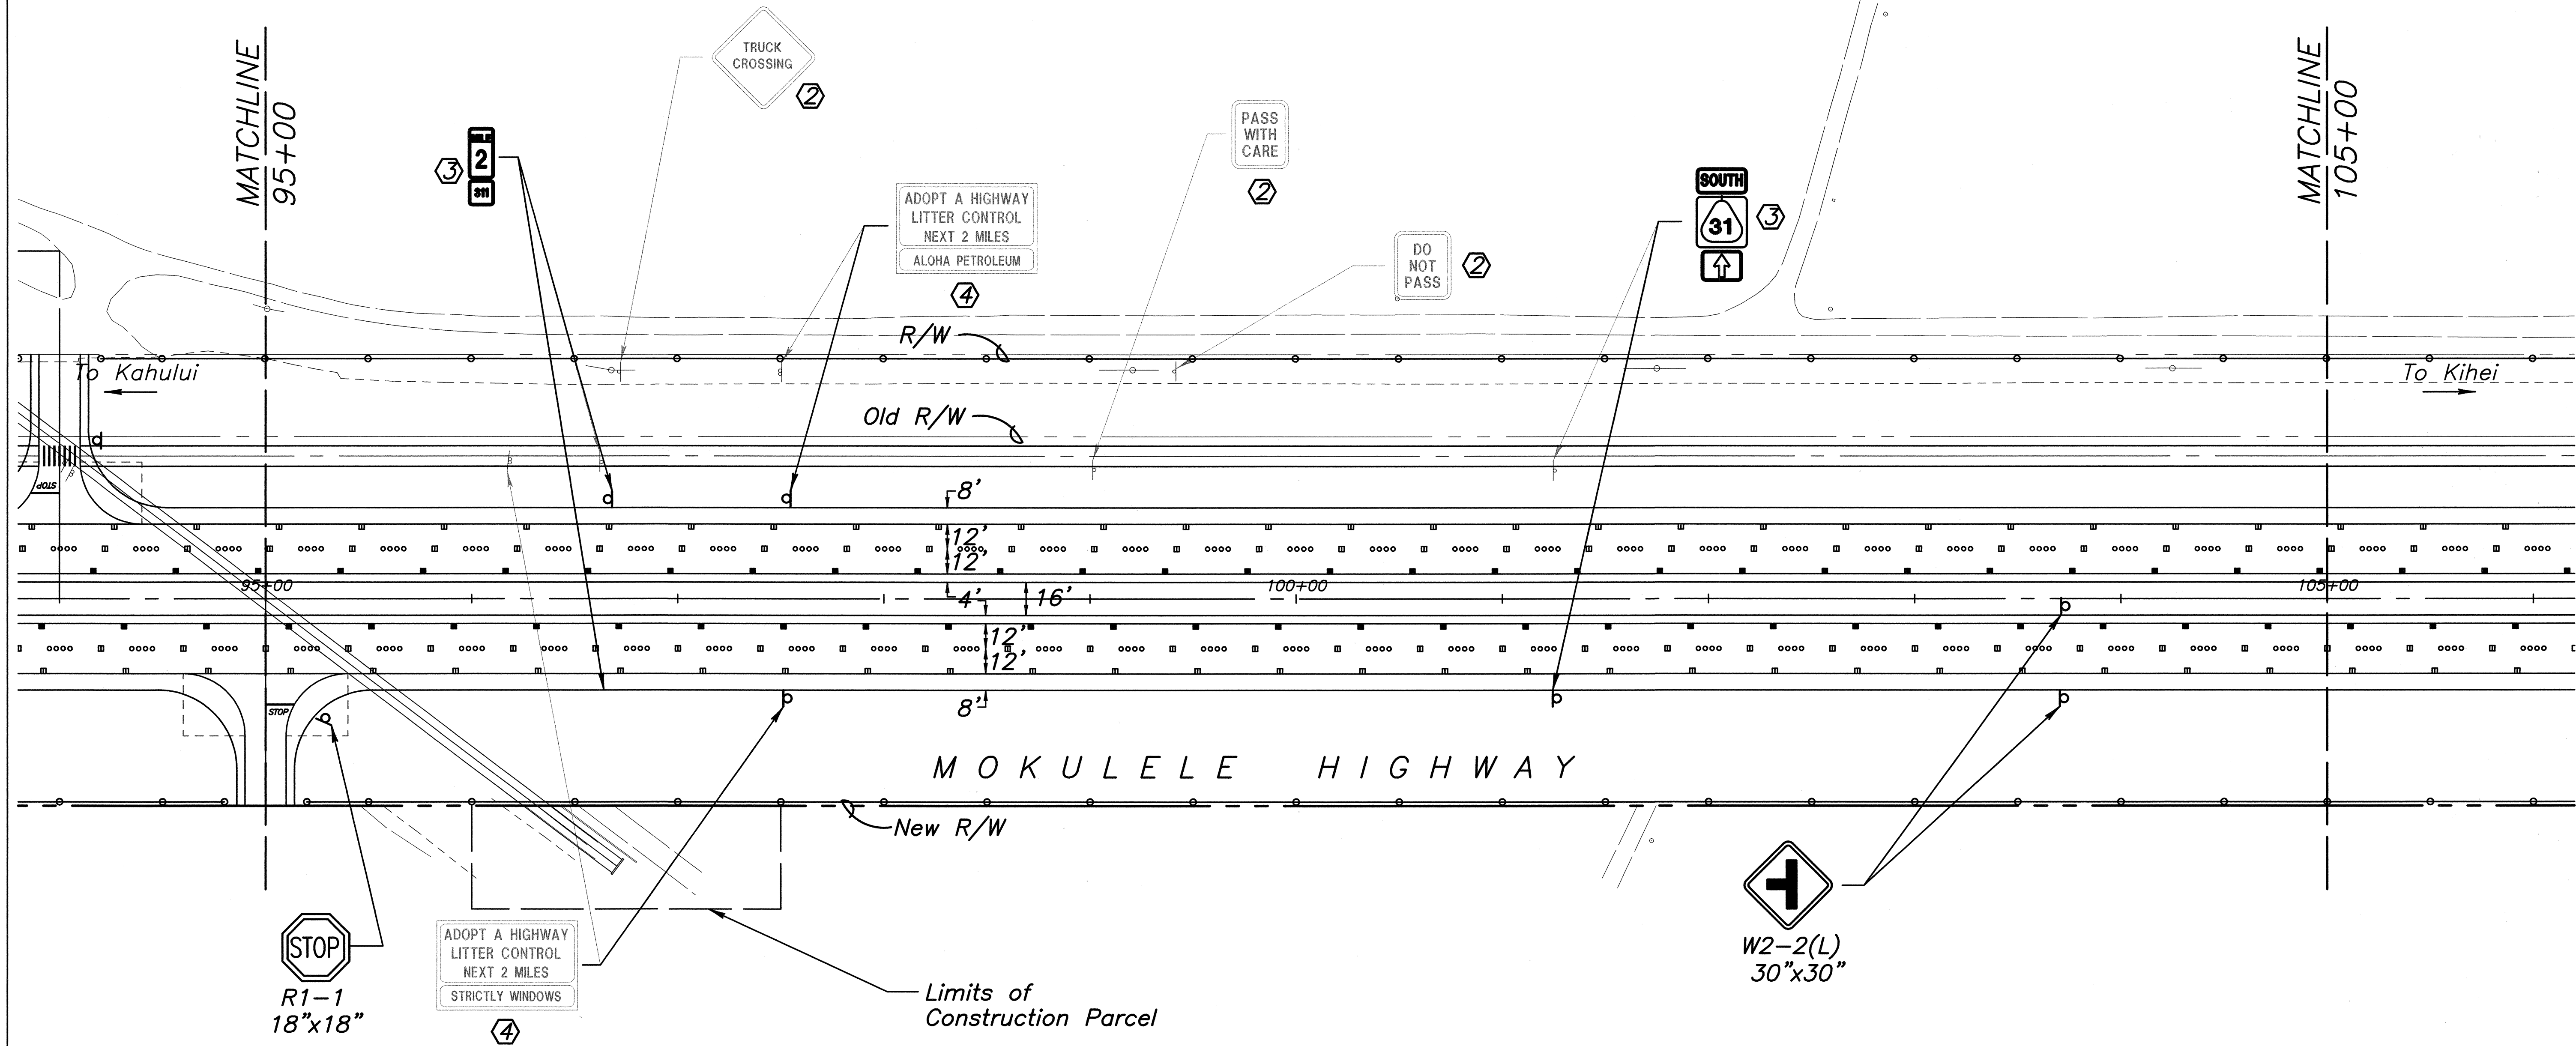

Notes:


Install New Sign(s) & Post(s) as shown unless otherwise specified (1)

- ① Existing sign(s) & post(s) to remain
- ② Remove existing sign(s) & post(s)
- ③ Remove existing & Install New Sign(s) & Post(s)
- ④ Relocate existing sign(s) & post(s)

Neatly bundle signs & posts to be removed and return to Highways Kahului Baseyard
For Details of Signs See Shts. 111

12/23/02	Revised Irrigation Ditch, Added Access Road at Baseline Station 95+00 Added Stop Sign and Striping For Access Road
----------	--

DATE REVISION

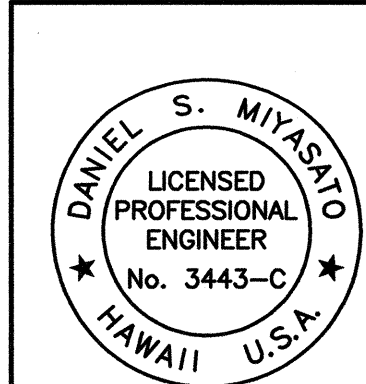

SATO & ASSOCIATES, INC.
THIS WORK WAS PREPARED BY
ME OR UNDER MY SUPERVISION


STATE OF HAWAII
DEPARTMENT OF TRANSPORTATION
HIGHWAYS DIVISION
STRIPING AND SIGNAGE PLAN
MOKULELE HIGHWAY WIDENING
Vicinity of Cane Haul Road
To
Maui Humane Society
Federal - Aid Project No. NH-0311(5)
Scale: 1"=40' Date: JUNE 2002
SHEET No. 5 OF 14 SHEETS

ADD. 96

ORIGINAL PLAN	SURVEY PLOTTED BY	DATE
NOTE BOOK	DRAWN BY	
	TRACED BY	
	QUANTITIES BY	
	CHECKED BY	
No.		

FED. ROAD DIST. NO.	STATE	FEDERAL - AID PROJ. NO.	FISCAL YEAR	SHEET NO.	TOTAL SHEETS
HAWAII	HAW.	NH-0311(5)	2003	97	189

True North
Scale: 1 inch = 40 feet

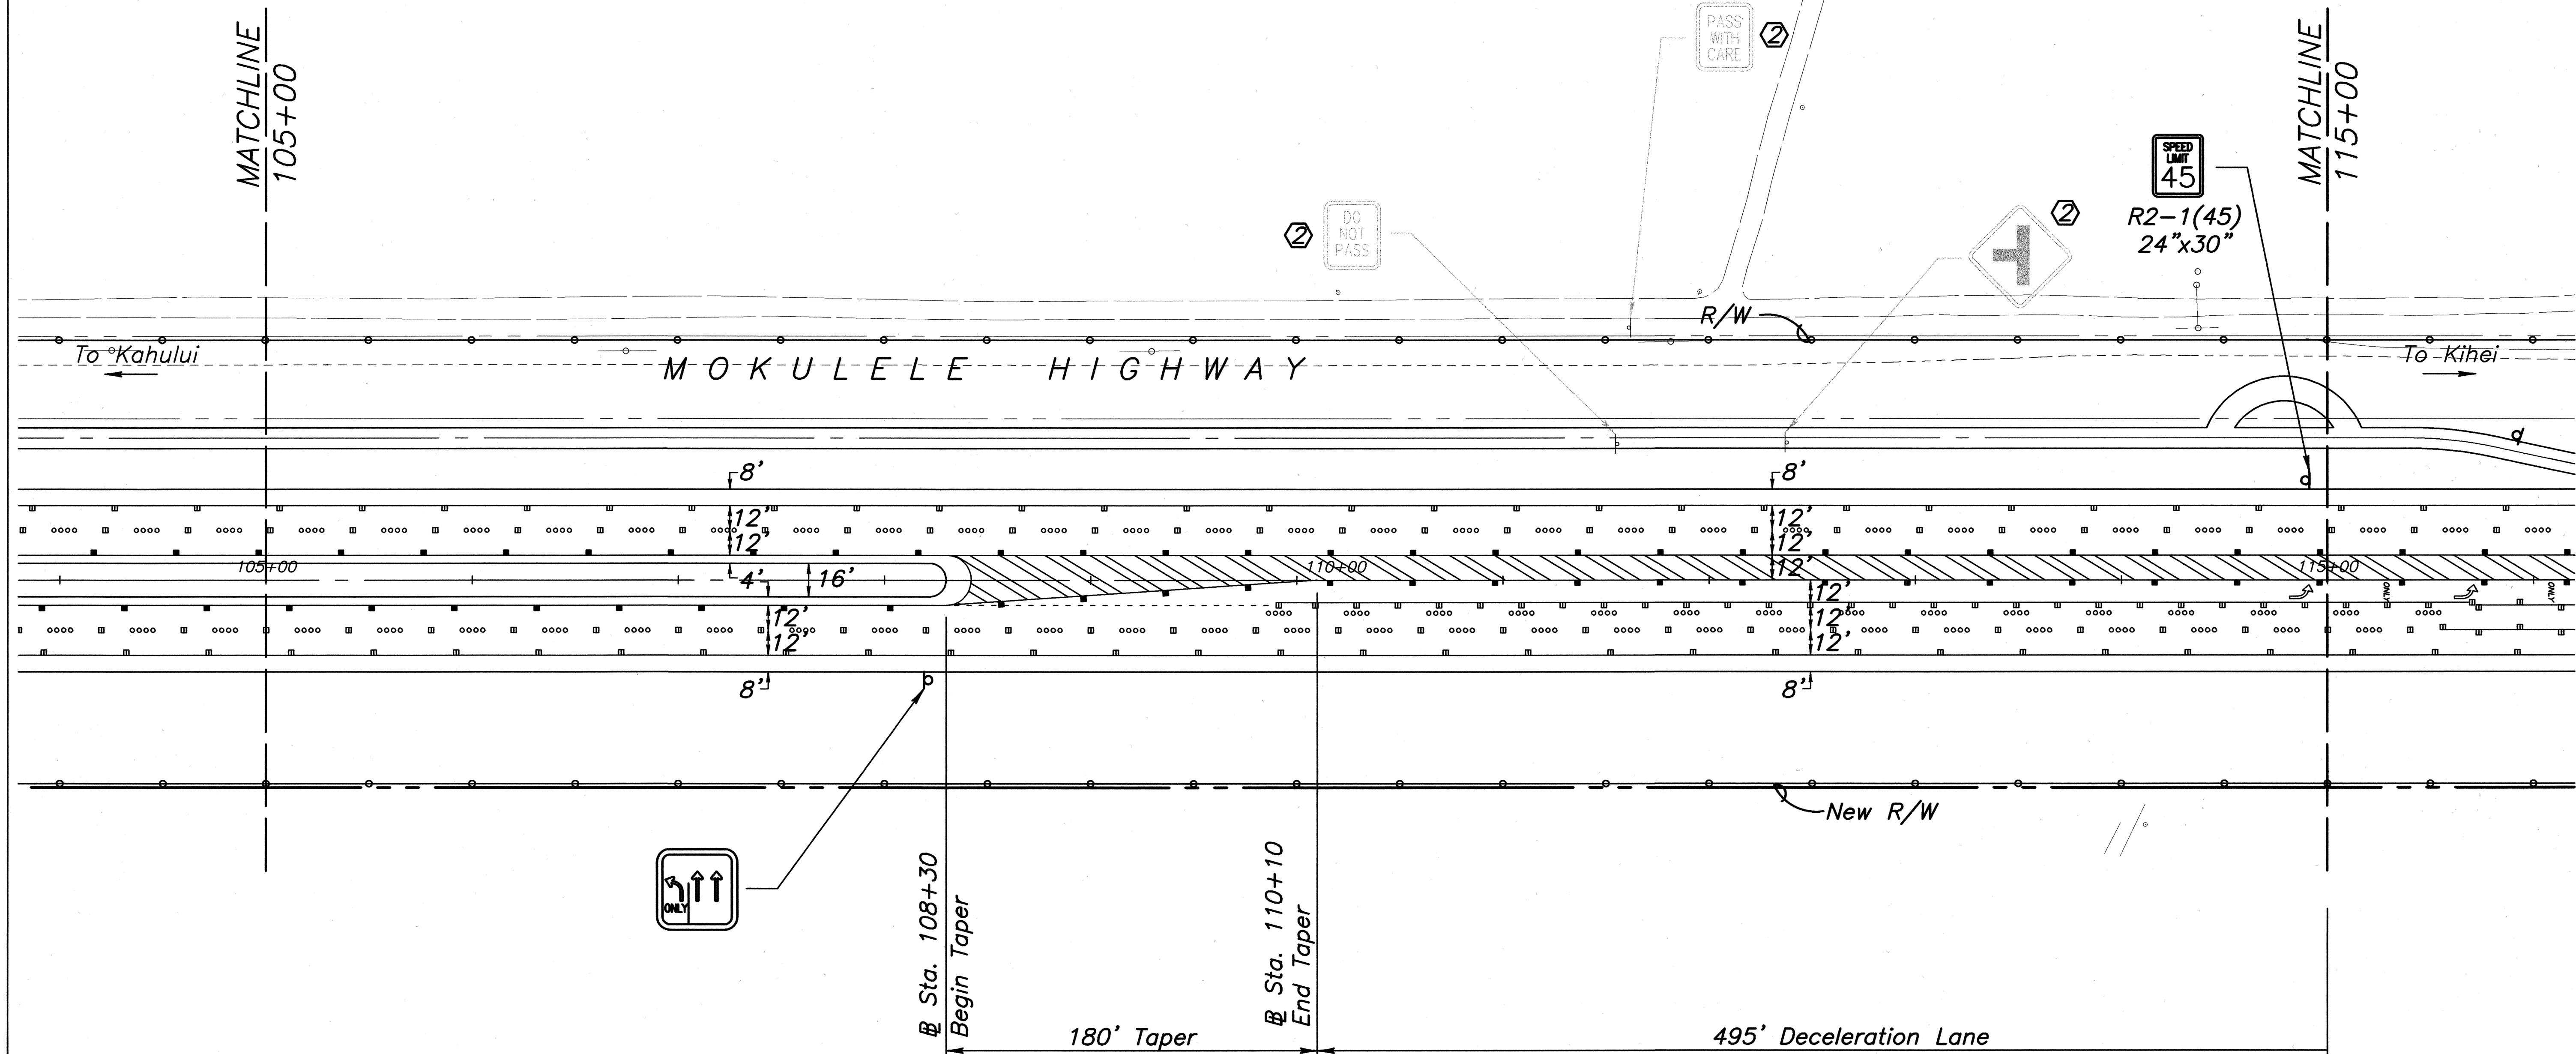

Notes:

Install New Sign(s) & Post(s) as shown
unless otherwise specified (1)

- ① Existing sign(s) & post(s) to remain
- ② Remove existing sign(s) & post(s)
- ③ Remove existing & Install New Sign(s) & Post(s)
- ④ Relocate existing sign(s) & post(s)

Neatly bundle signs & posts to be removed and
return to Highways Kahului Baseyard
For Details of Signs See Shts. 111

ORIGINAL PLAN	SURVEY PLOTTED BY	DATE
NOTE BOOK	DRAWN BY	
	RESCUED BY	
	QUANTITIES BY	
	CHECKED BY	
No.		

DANIEL S. MIYASAKI
LICENSED PROFESSIONAL ENGINEER
No. 3443-C
HAWAII U.S.A.

SATO & ASSOCIATES, INC.
THIS WORK WAS PREPARED BY ME OR UNDER MY SUPERVISION


STATE OF HAWAII
DEPARTMENT OF TRANSPORTATION
HIGHWAYS DIVISION

STRIPING AND SIGNAGE PLAN

MOKULELE HIGHWAY WIDENING
Vicinity of Cane Haul Road
To
Maui Humane Society
Federal - Aid Project No. NH-0311(5)
Scale: 1"=40' Date: JUNE 2002

SHEET No. 6 OF 14 SHEETS

FED. ROAD DIST. NO.	STATE	FEDERAL - AID PROJ. NO.	FISCAL YEAR	SHEET NO.	TOTAL SHEETS
HAWAII	HAW.	NH-0311(5)	2003	98	189

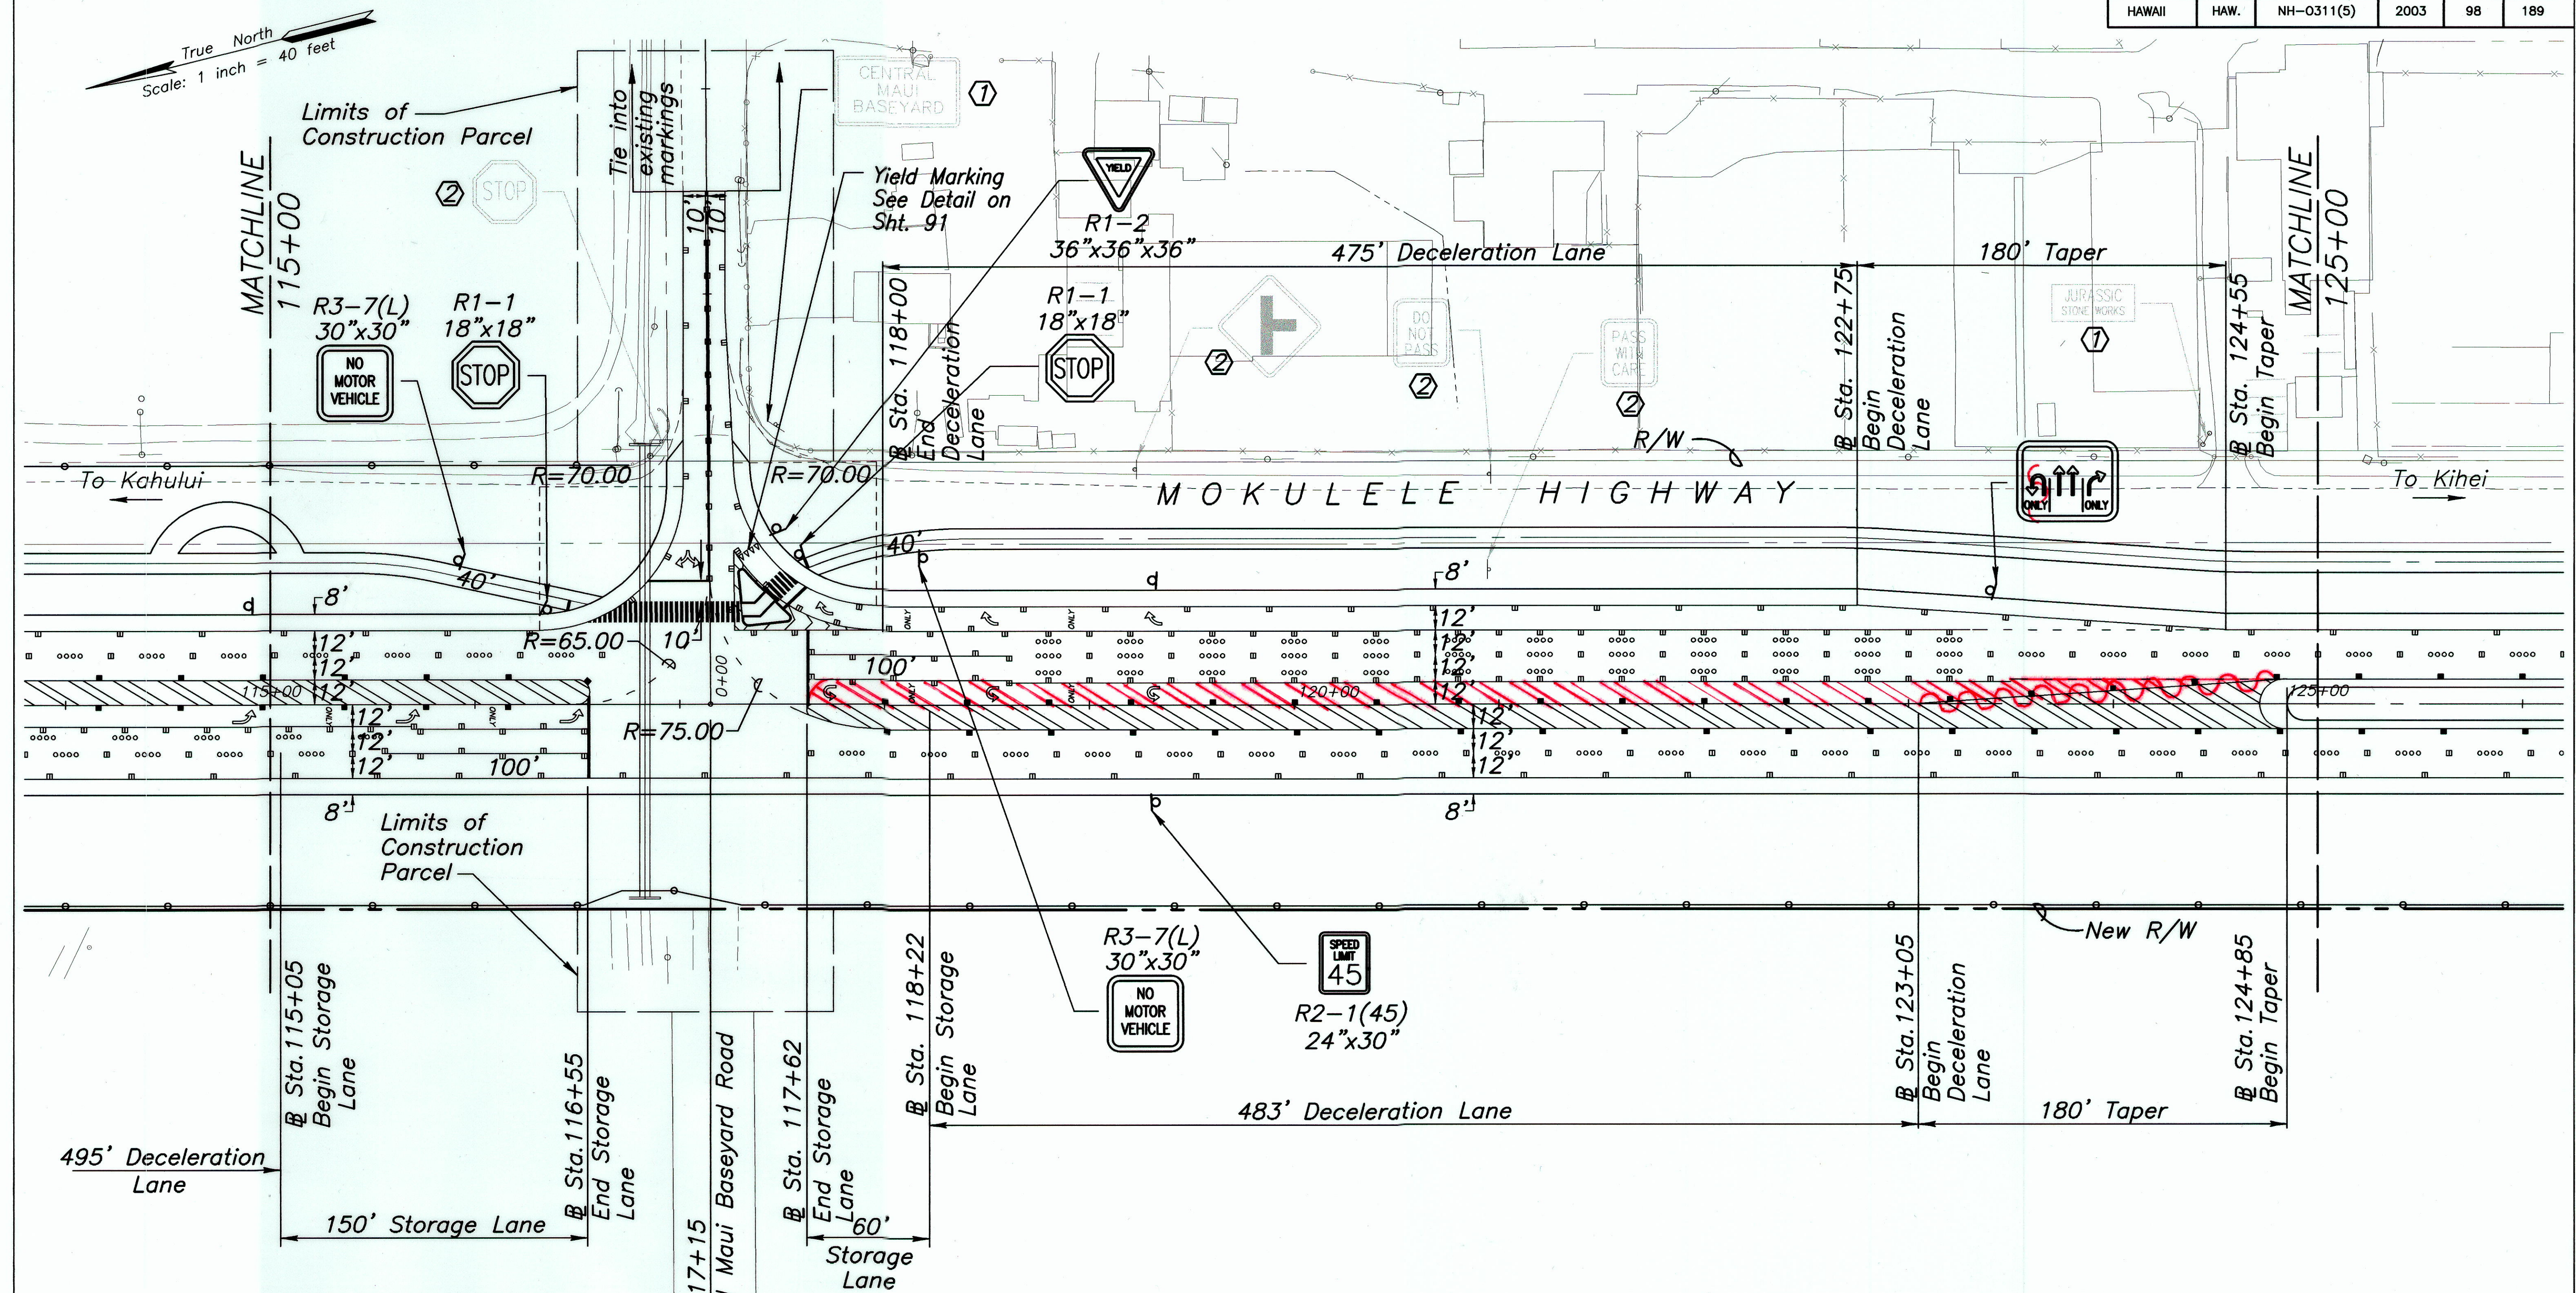

Notes:

Install New Sign(s) & Post(s) as shown unless otherwise specified (1)


- ① Existing sign(s) & post(s) to remain
- ② Remove existing sign(s) & post(s)
- ③ Remove existing & Install New Sign(s) & Post(s)
- ④ Relocate existing sign(s) & post(s)

Neatly bundle signs & posts to be removed and return to Highways Kahului Baseyard
For Details of Signs See Shts. 111

	STATE OF HAWAII DEPARTMENT OF TRANSPORTATION HIGHWAYS DIVISION	
	STRIPING AND SIGNAGE PLAN	
	MOKULELE HIGHWAY WIDENING	
	Vicinity of Cane Haul Road To Maui Humane Society Federal - Aid Project No. NH-0311(5) Scale: 1"=40' Date: JUNE 2002	
SHEET No. 7 OF 14 SHEETS		

"AS-BUILT"

FED. ROAD DIST. NO.	STATE	FEDERAL - AID PROJ. NO.	FISCAL YEAR	SHEET NO.	TOTAL SHEETS
HAWAII	HAW.	NH-0311(5)	2003	99	189

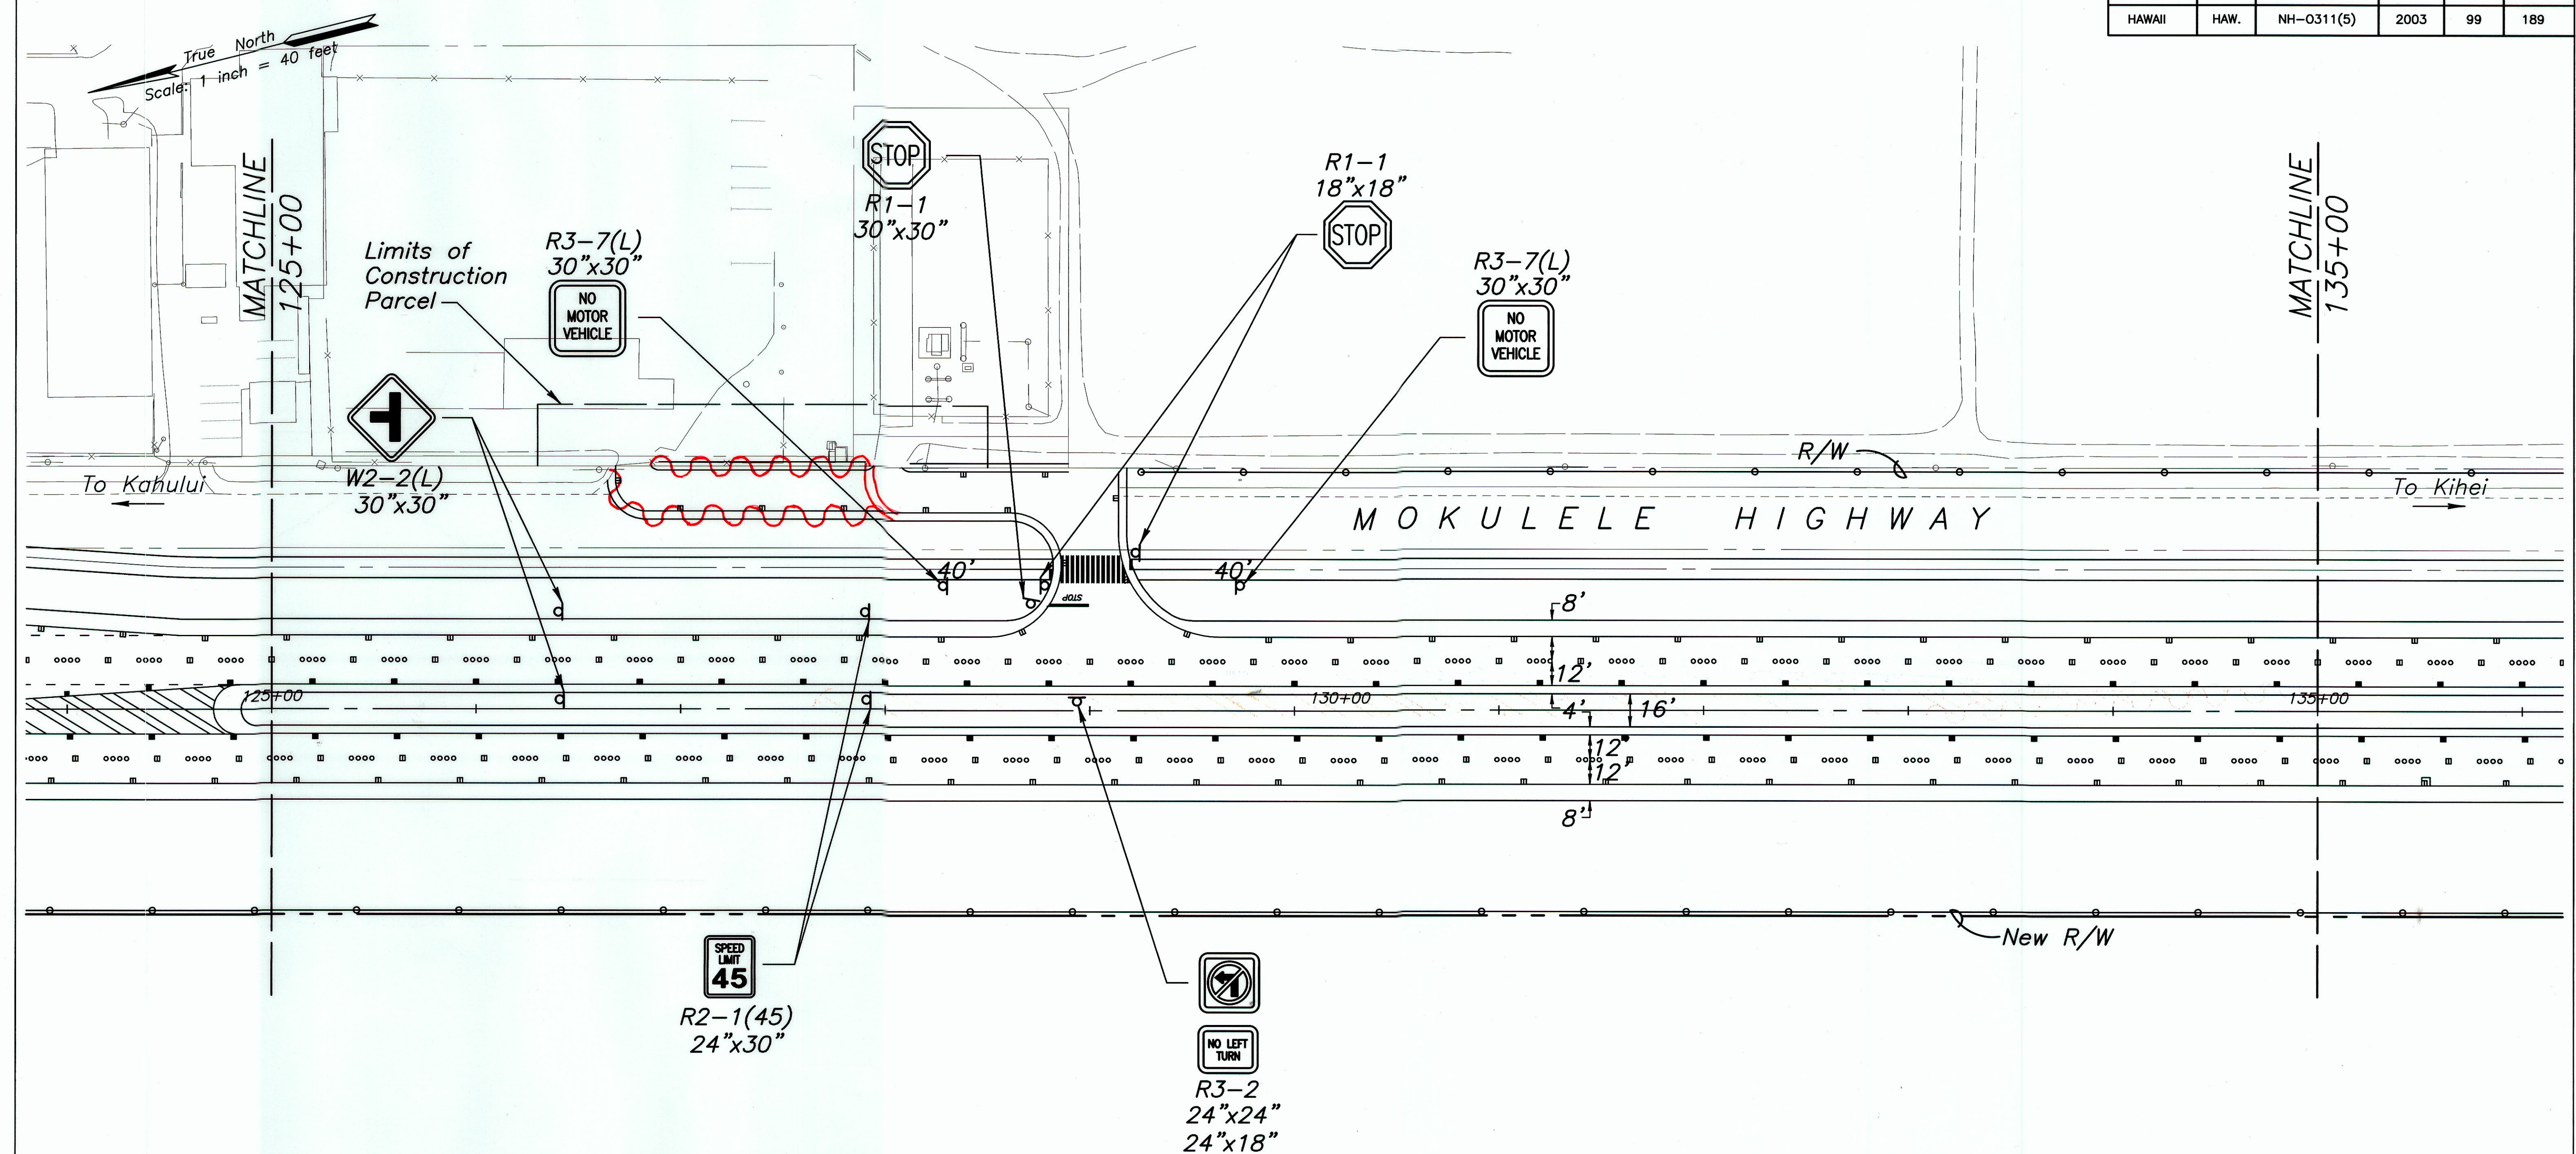


Notes:

Install New Sign(s) & Post(s) as shown unless otherwise specified (1)

- ① Existing sign(s) & post(s) to remain
- ② Remove existing sign(s) & post(s)
- ③ Remove existing & Install New Sign(s) & Post(s)
- ④ Relocate existing sign(s) & post(s)

Neatly bundle signs & posts to be removed and return to Highways Kahului Baseyard
For Details of Signs See Shts. 111

DATE	REVISION
12/23/02	Revised Frontage Road

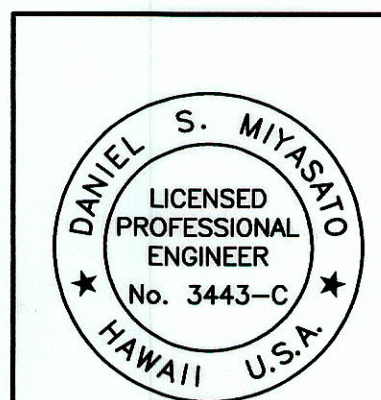

STATE OF HAWAII
DEPARTMENT OF TRANSPORTATION
HIGHWAYS DIVISION

STRIPING AND SIGNAGE PLAN

MOKULELE HIGHWAY WIDENING
Vicinity of Cane Haul Road
To
Maui Humane Society
Federal - Aid Project No. NH-0311(5)
Scale: 1"=40' Date: JUNE 2002

SHEET No. 8 OF 14 SHEETS


"AS-BUILT"

ADD. 99

ORIGINAL PLAN	DATE
SURVEY PLOTTED BY	
DESIGNED BY	
NOTED BY	
CHECKED BY	
NO.	

FED. ROAD DIST. NO.	STATE	FEDERAL - AID PROJ. NO.	FISCAL YEAR	SHEET NO.	TOTAL SHEETS
HAWAII	HAW.	NH-0311(5)	2003	100	189

True North
Scale: 1 inch = 40 feet

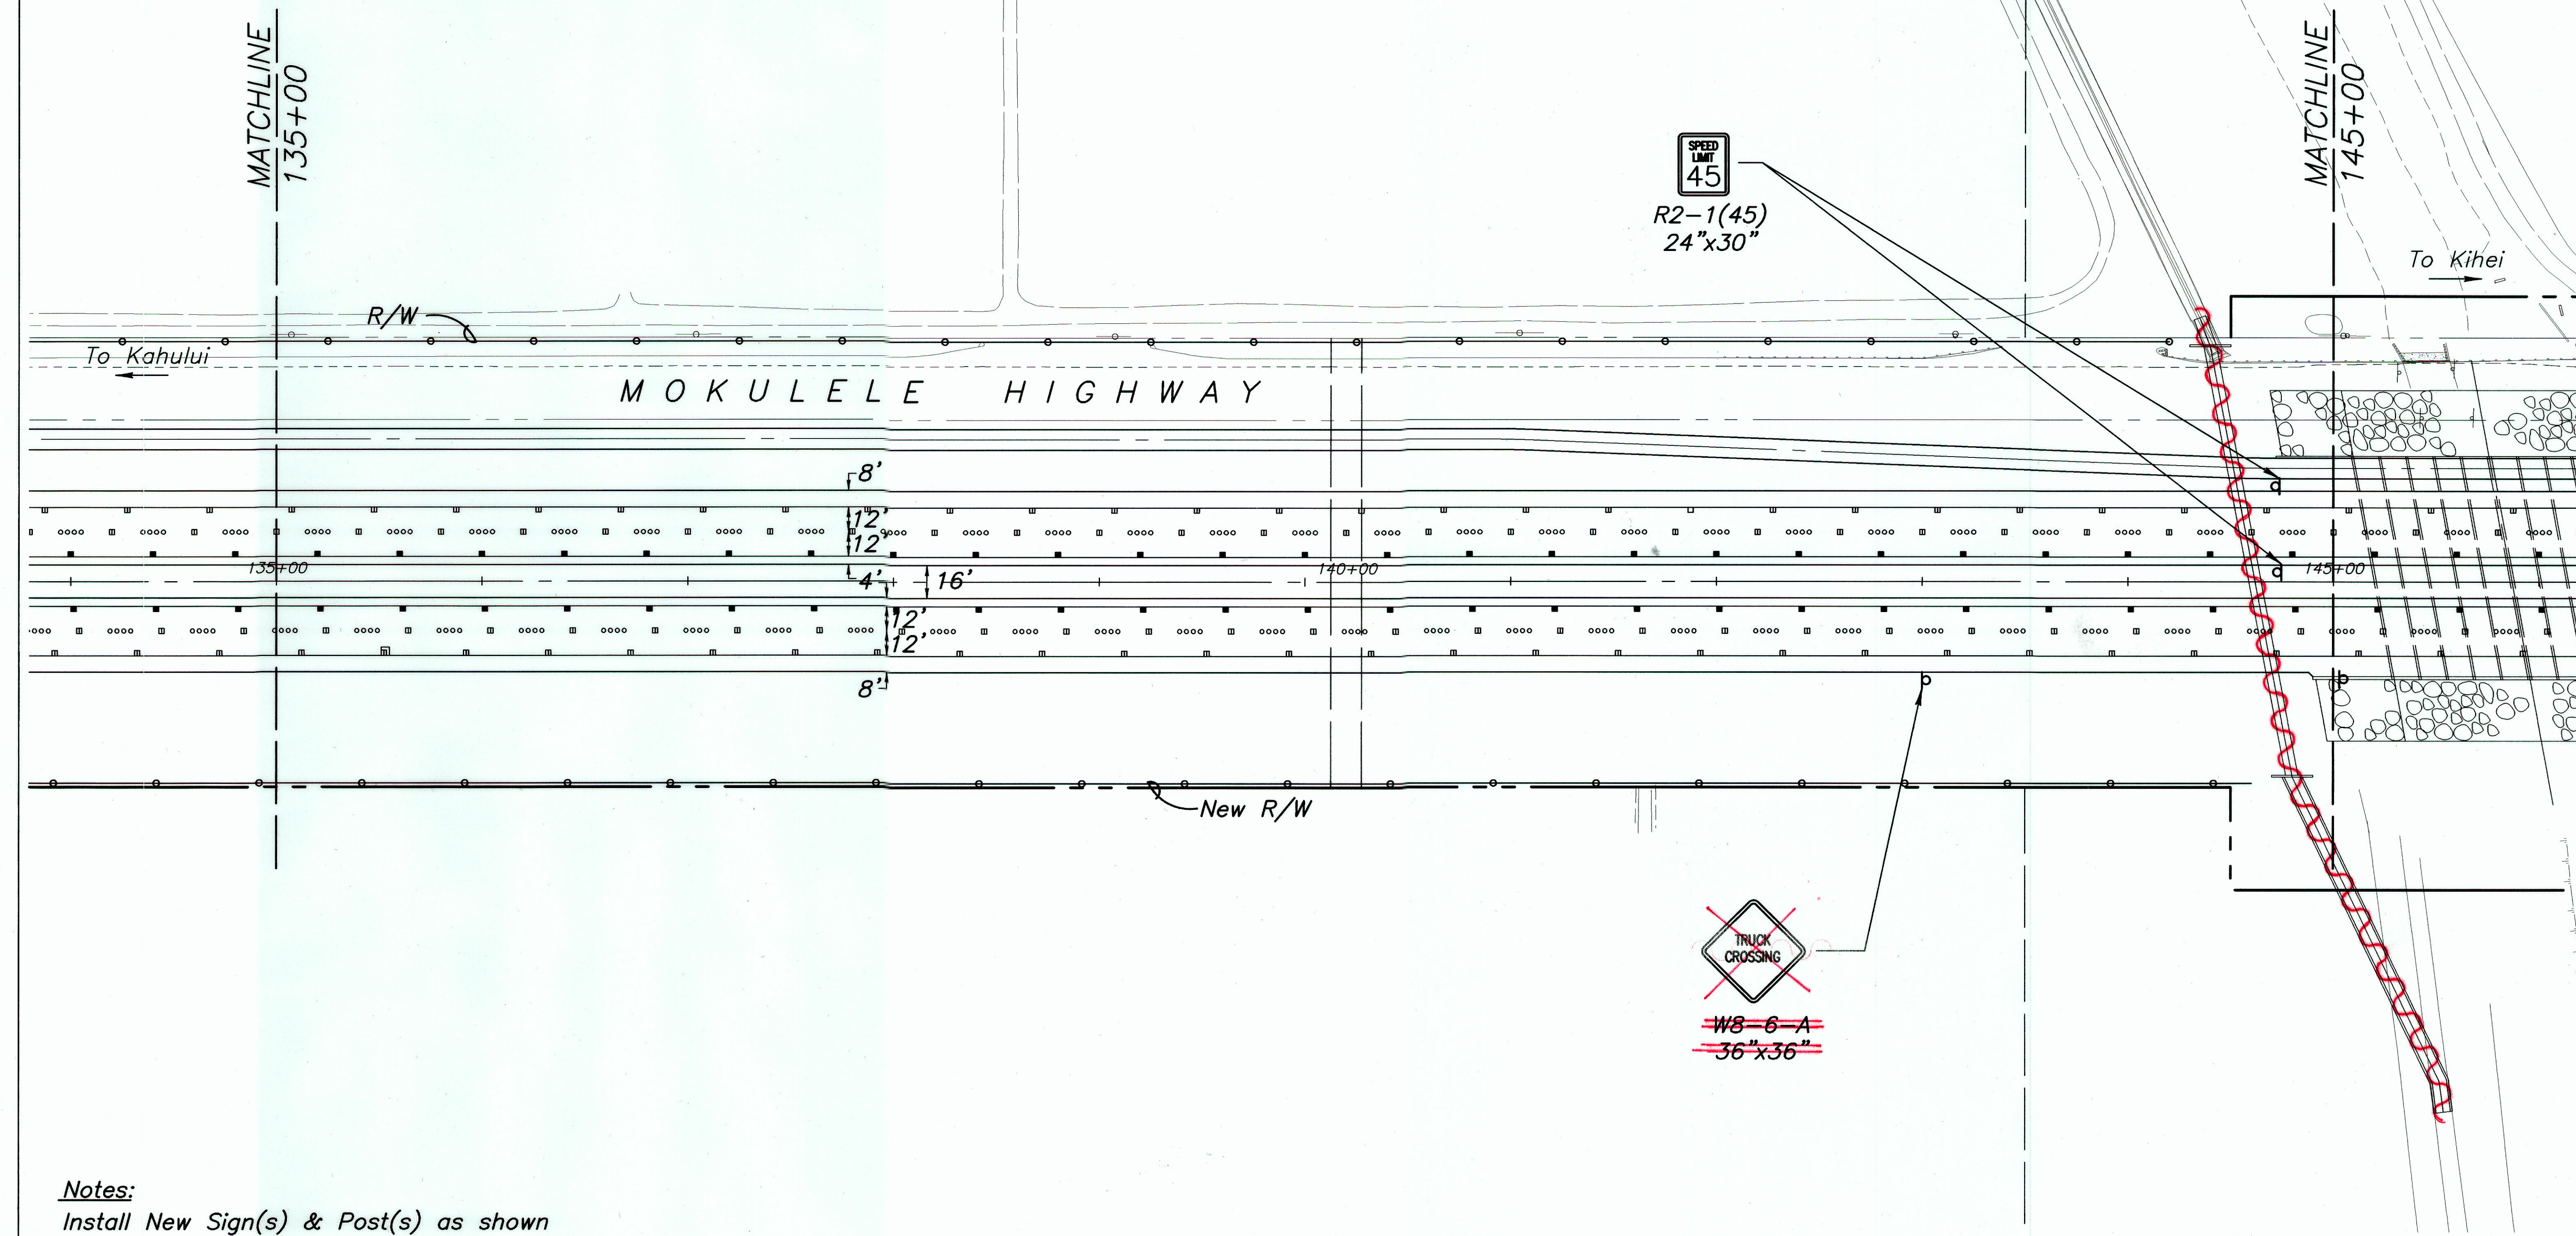

Notes:

Install New Sign(s) & Post(s) as shown unless otherwise specified (1)

- ① Existing sign(s) & post(s) to remain
- ② Remove existing sign(s) & post(s)
- ③ Remove existing & Install New Sign(s) & Post(s)
- ④ Relocate existing sign(s) & post(s)

Neatly bundle signs & posts to be removed and return to Highways Kahului Baseyard
For Details of Signs See Shts. 111

SURVEY PLOTTED BY	DATE
DRAWN BY	
CHECKED BY	
NOTED BY	
QUANTITIES BY	
CHECKED BY	
No.	

DANIEL S. MIYASATO
LICENSED PROFESSIONAL ENGINEER
No. 3443-C
HAWAII U.S.A.

Daniel Miyasato
SATO & ASSOCIATES, INC.

THIS WORK WAS PREPARED BY ME OR UNDER MY SUPERVISION

STATE OF HAWAII
DEPARTMENT OF TRANSPORTATION
HIGHWAYS DIVISION


STRIPING AND SIGNAGE PLAN

MOKULELE HIGHWAY WIDENING
Vicinity of Cane Haul Road
To
Maui Humane Society
Federal - Aid Project No. NH-0311(5)
Scale: 1"=40' Date: JUNE 2002

SHEET No. 9 OF 14 SHEETS

"AS-BUILT"

FED. ROAD DIST. NO.	STATE	FEDERAL - AID PROJ. NO.	FISCAL YEAR	SHEET NO.	TOTAL SHEETS
HAWAII	HAW.	NH-0311(5)	2003	101	189

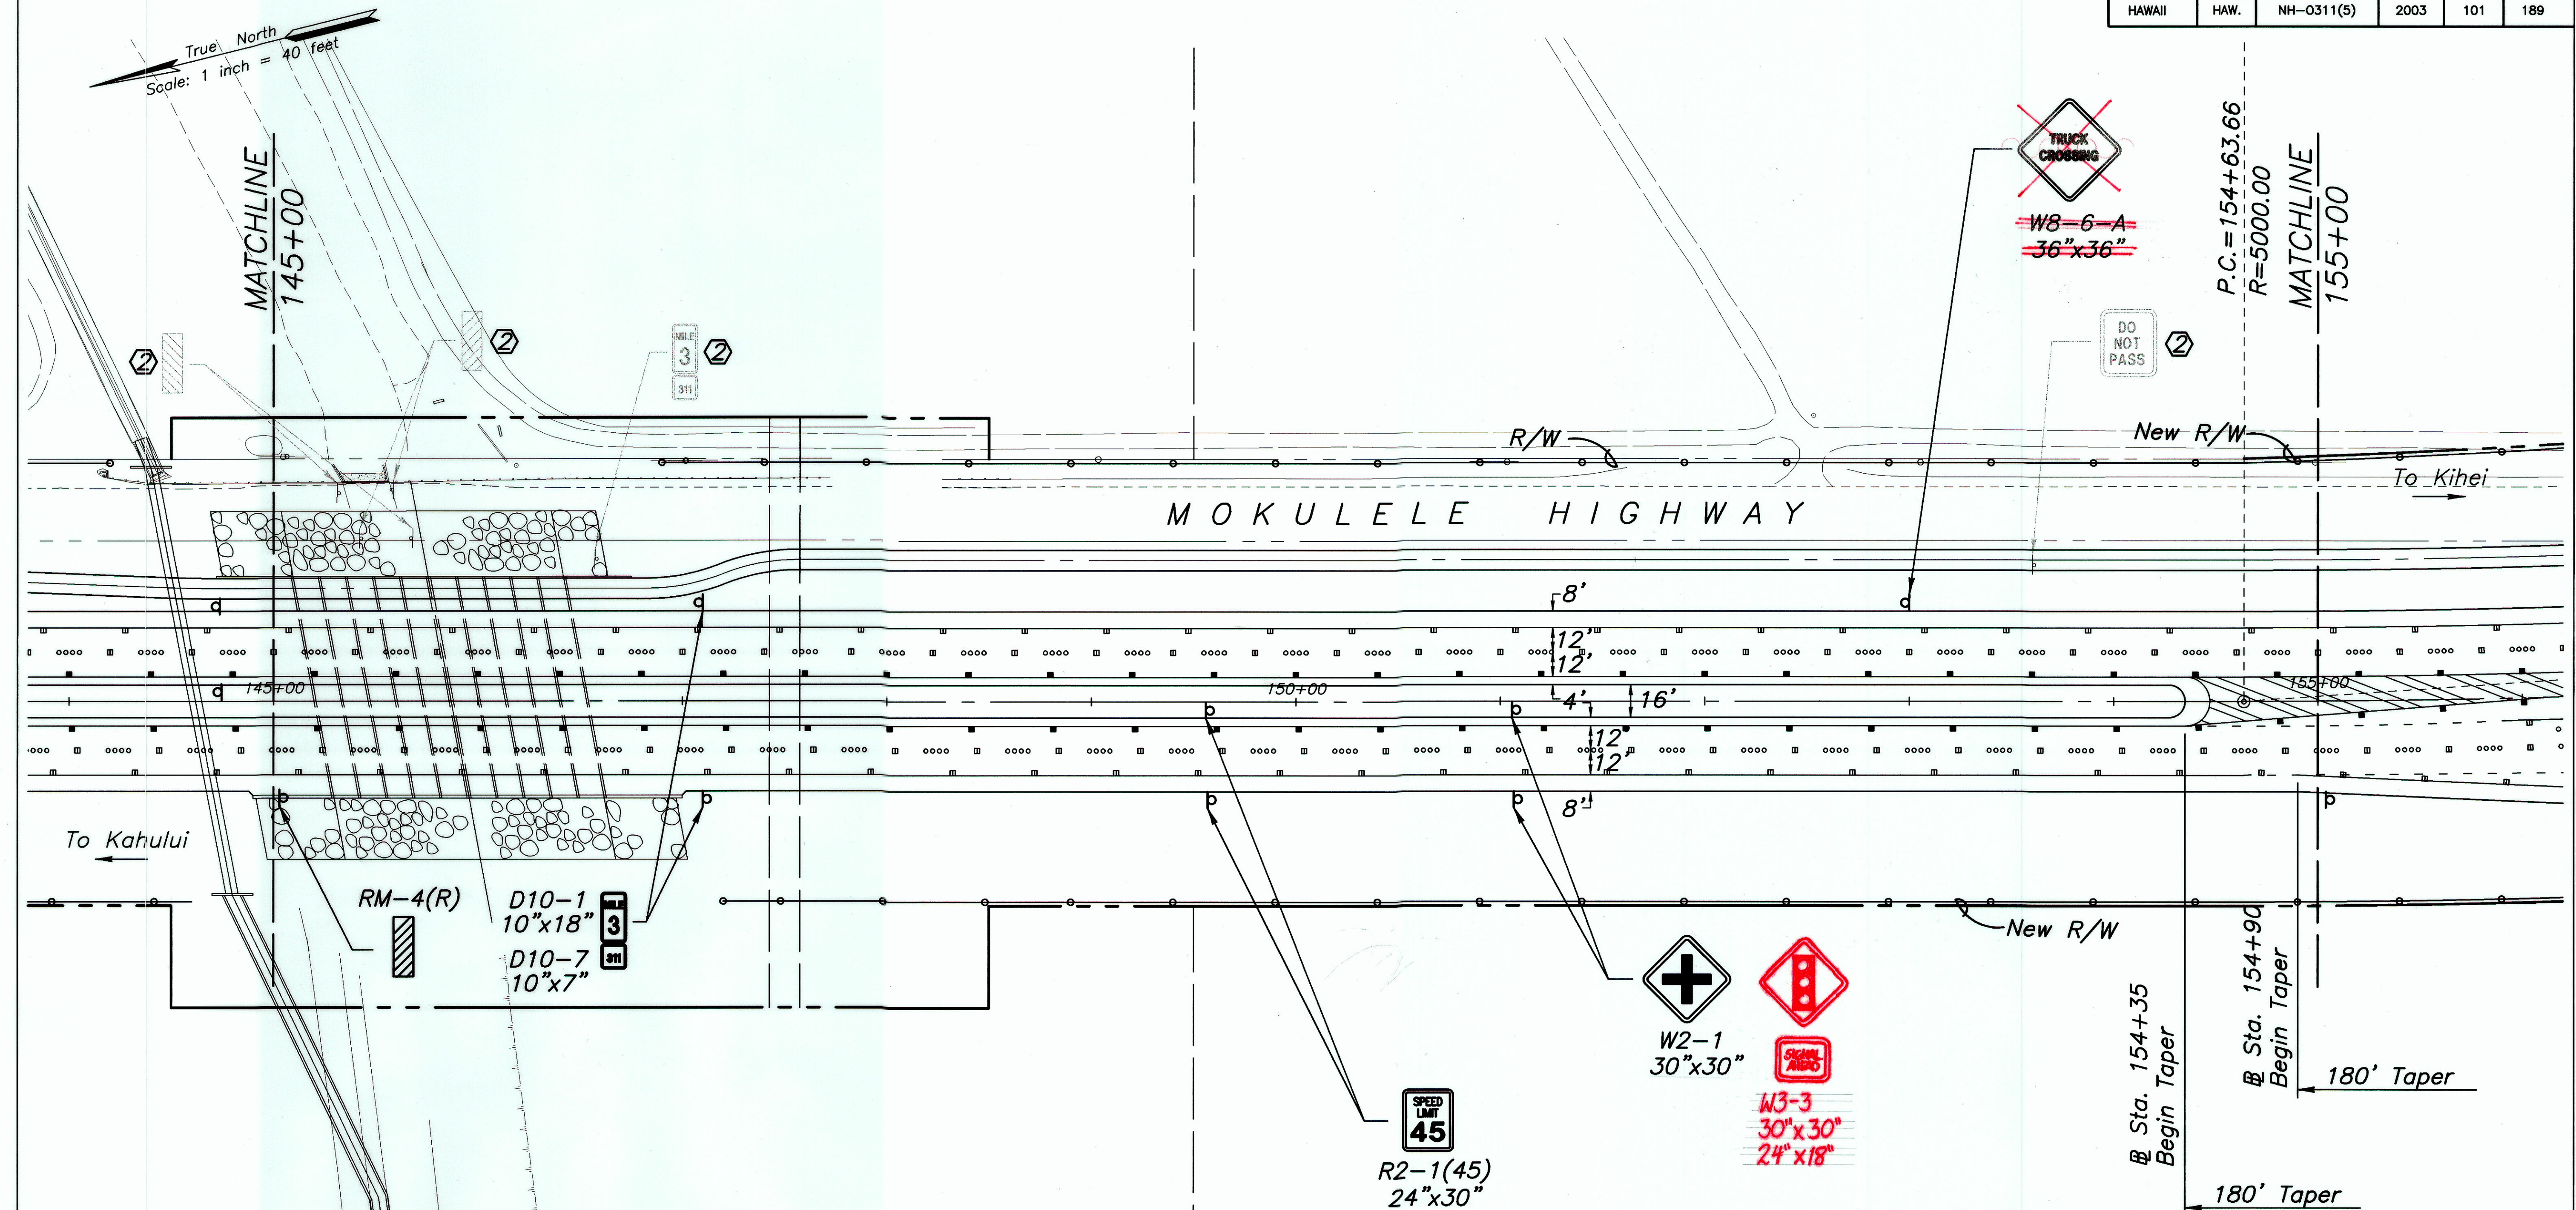

Notes:

Install New Sign(s) & Post(s) as shown unless otherwise specified (1)

- ① Existing sign(s) & post(s) to remain
- ② Remove existing sign(s) & post(s)
- ③ Remove existing & Install New Sign(s) & Post(s)
- ④ Relocate existing sign(s) & post(s)

Neatly bundle signs & posts to be removed and return to Highways Kahului Baseyard
For Details of Signs See Shts. 111

STATE OF HAWAII
DEPARTMENT OF TRANSPORTATION
HIGHWAYS DIVISION

STRIPING AND SIGNAGE PLAN

MOKULELE HIGHWAY WIDENING

Vicinity of Cane Haul Road

To
Maui Humane Society

Federal - Aid Project No. NH-0311(5)

Scale: 1"=40' Date: JUNE 2002

SHEET No. 10 OF 14 SHEETS

DANIEL S. MIYASATO
LICENSED PROFESSIONAL ENGINEER
No. 3443-C
HAWAII U.S.A.


Daniel Miyasato
SATO & ASSOCIATES, INC.

THIS WORK WAS PREPARED BY ME OR UNDER MY SUPERVISION

AS-BUILT

ORIGINAL PLAN	DATE
DESIGNED BY	
CHECKED BY	
NOTE BOOK	
QUANTITIES BY	
NO.	

FED. ROAD DIST. NO.	STATE	FEDERAL - AID PROJ. NO.	FISCAL YEAR	SHEET NO.	TOTAL SHEETS
HAWAII	HAW.	NH-0311(5)	2003	102	189

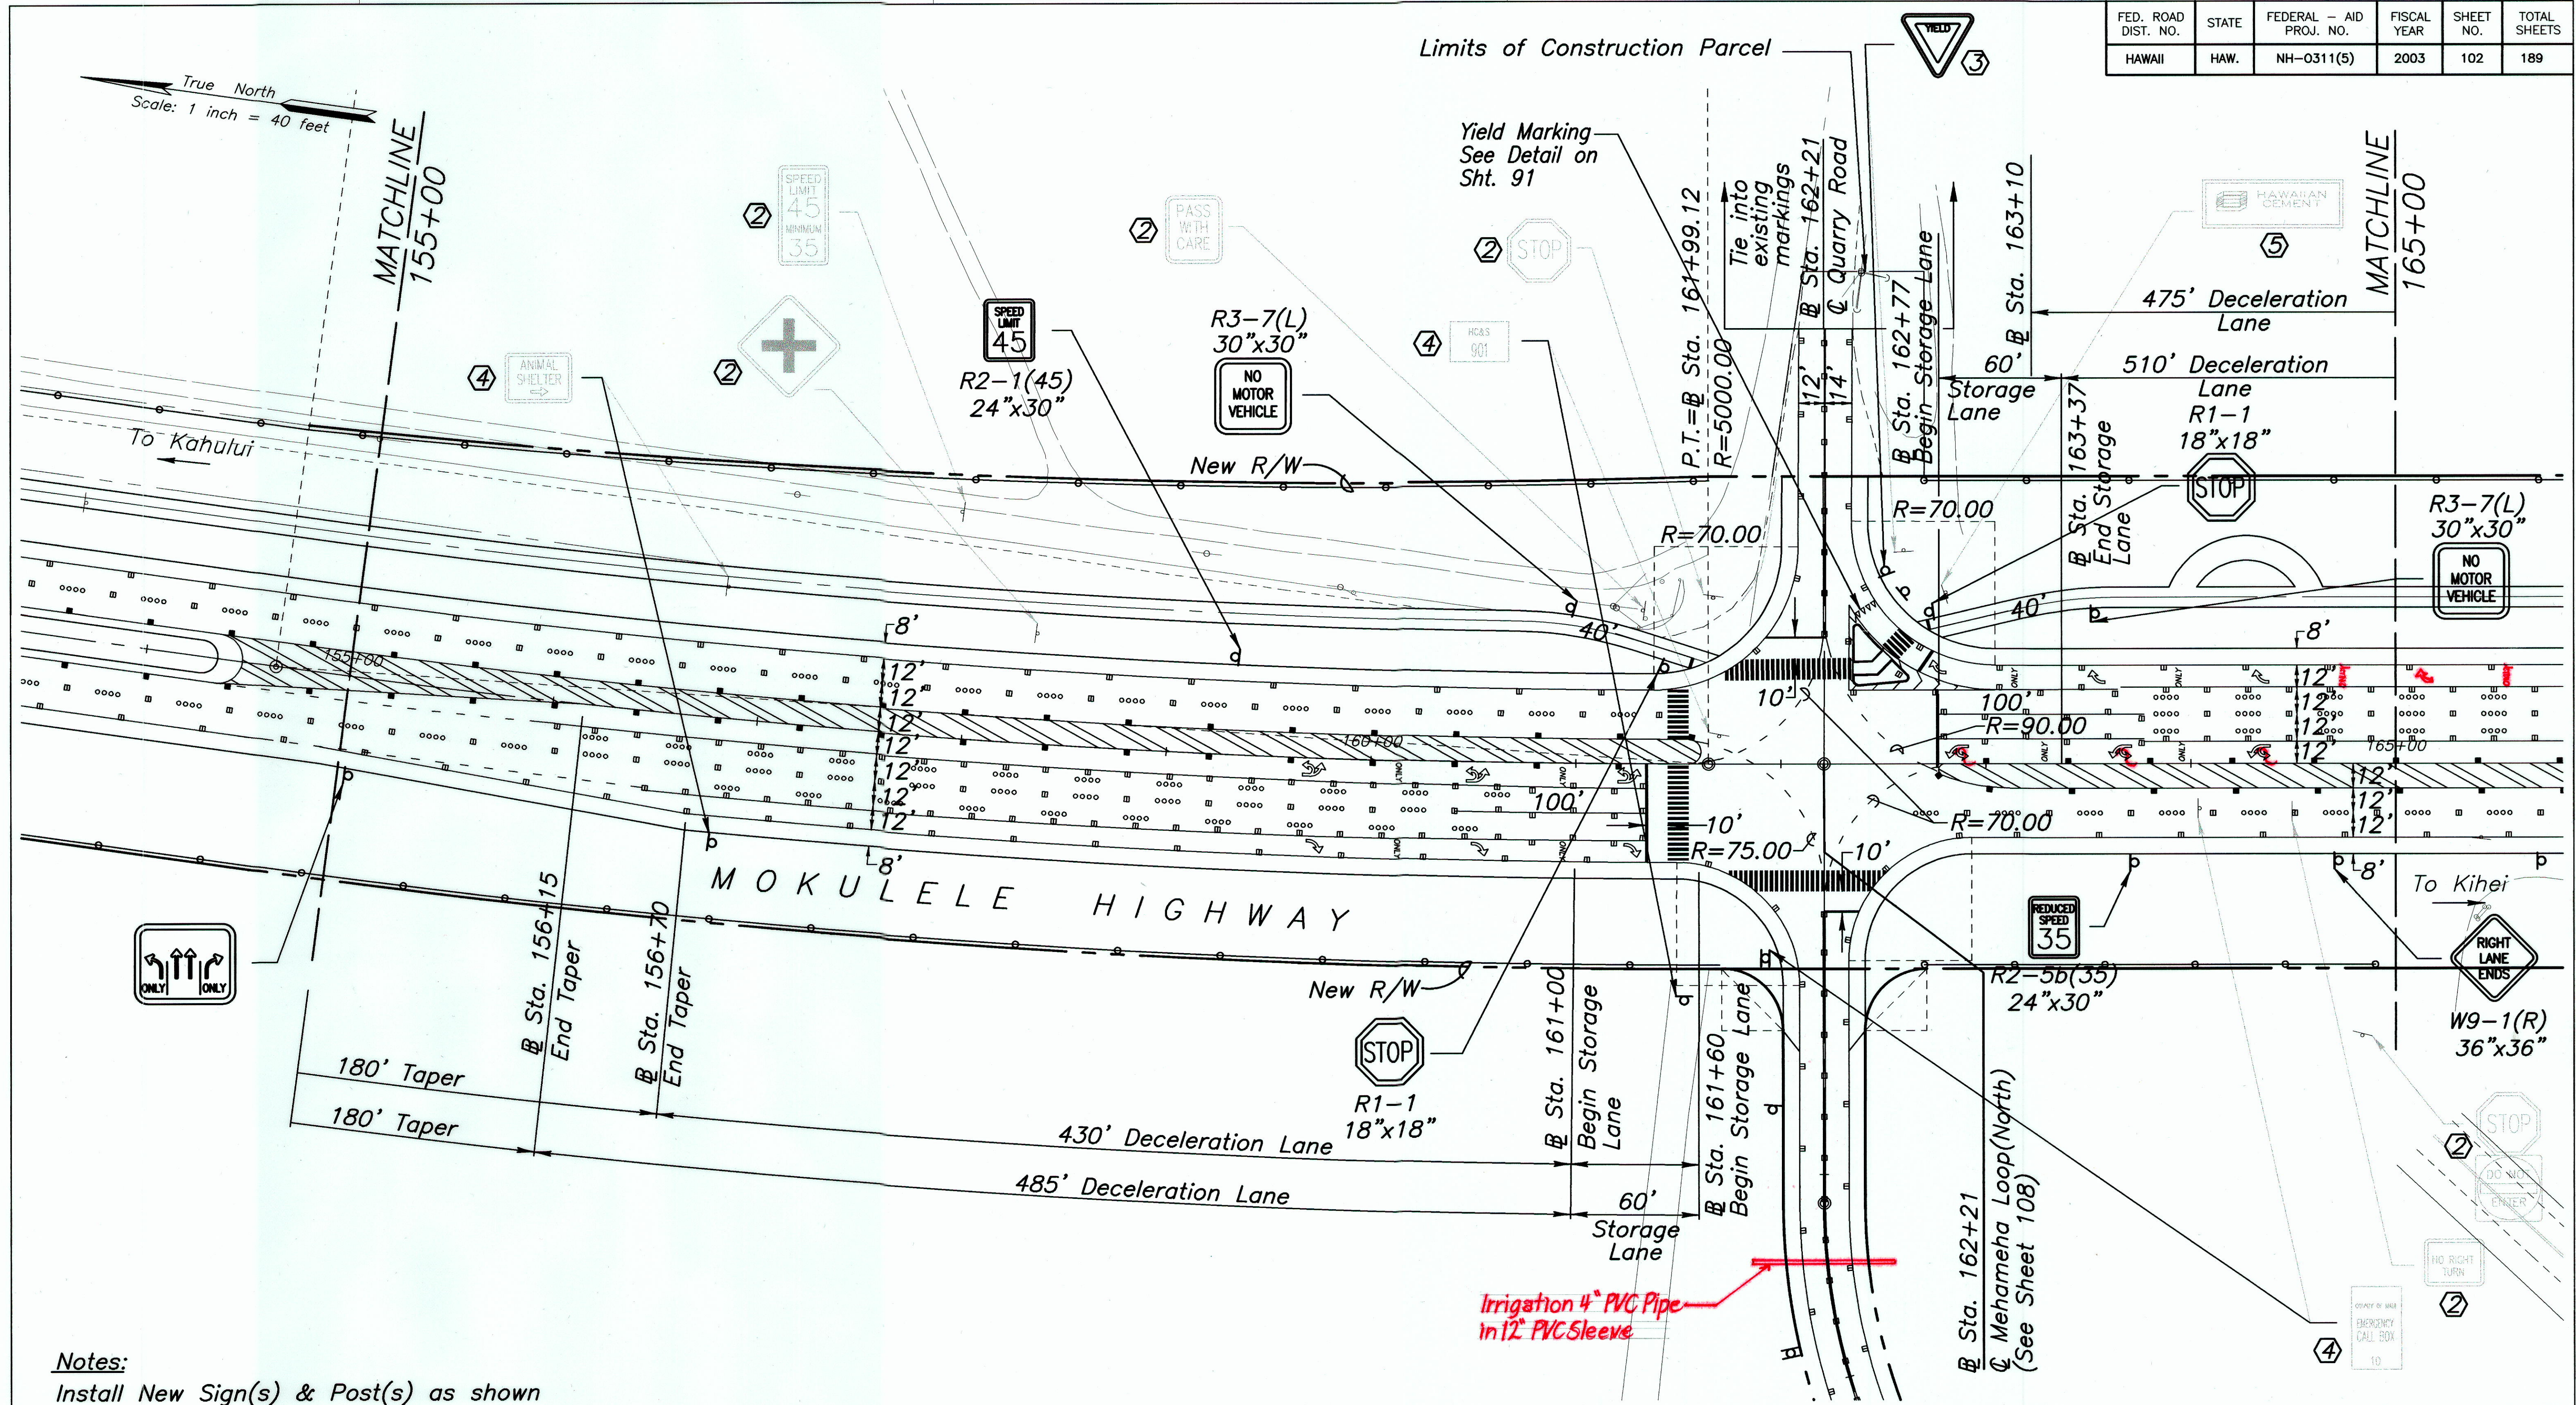

Notes:

Install New Sign(s) & Post(s) as shown unless otherwise specified (1)

- ① Existing sign(s) & post(s) to remain
- ② Remove existing sign(s) & post(s)
- ③ Remove existing & Install New Sign(s) & Post(s)
- ④ Relocate existing sign(s) & post(s)

Neatly bundle signs & posts to be removed and return to Highways Kahului Baseyard
For Details of Signs See Shts. 111

- ⑤ This is a private sign that needs to be relocated. Contractor shall coordinate with Hawaiian Cement and the Engineer to determine new sign location.



STATE OF HAWAII
DEPARTMENT OF TRANSPORTATION
HIGHWAYS DIVISION

STRIPING AND SIGNAGE PLAN

MOKULELE HIGHWAY WIDENING


Vicinity of Cane Haul Road
To
Maui Humane Society
Federal - Aid Project No. NH-0311(5)
Scale: 1"=40' Date: JUNE 2002

SHEET No. 11 OF 14 SHEETS

"AS-BUILT"

ORIGINAL	DATE
DESIGNED BY	
TRACED BY	
NOTED BY	
CHECKED BY	
NO.	

FED. ROAD DIST. NO.	STATE	FEDERAL - AID PROJ. NO.	FISCAL YEAR	SHEET NO.	TOTAL SHEETS
HAWAII	HAW.	NH-0311(5)	2003	103	189

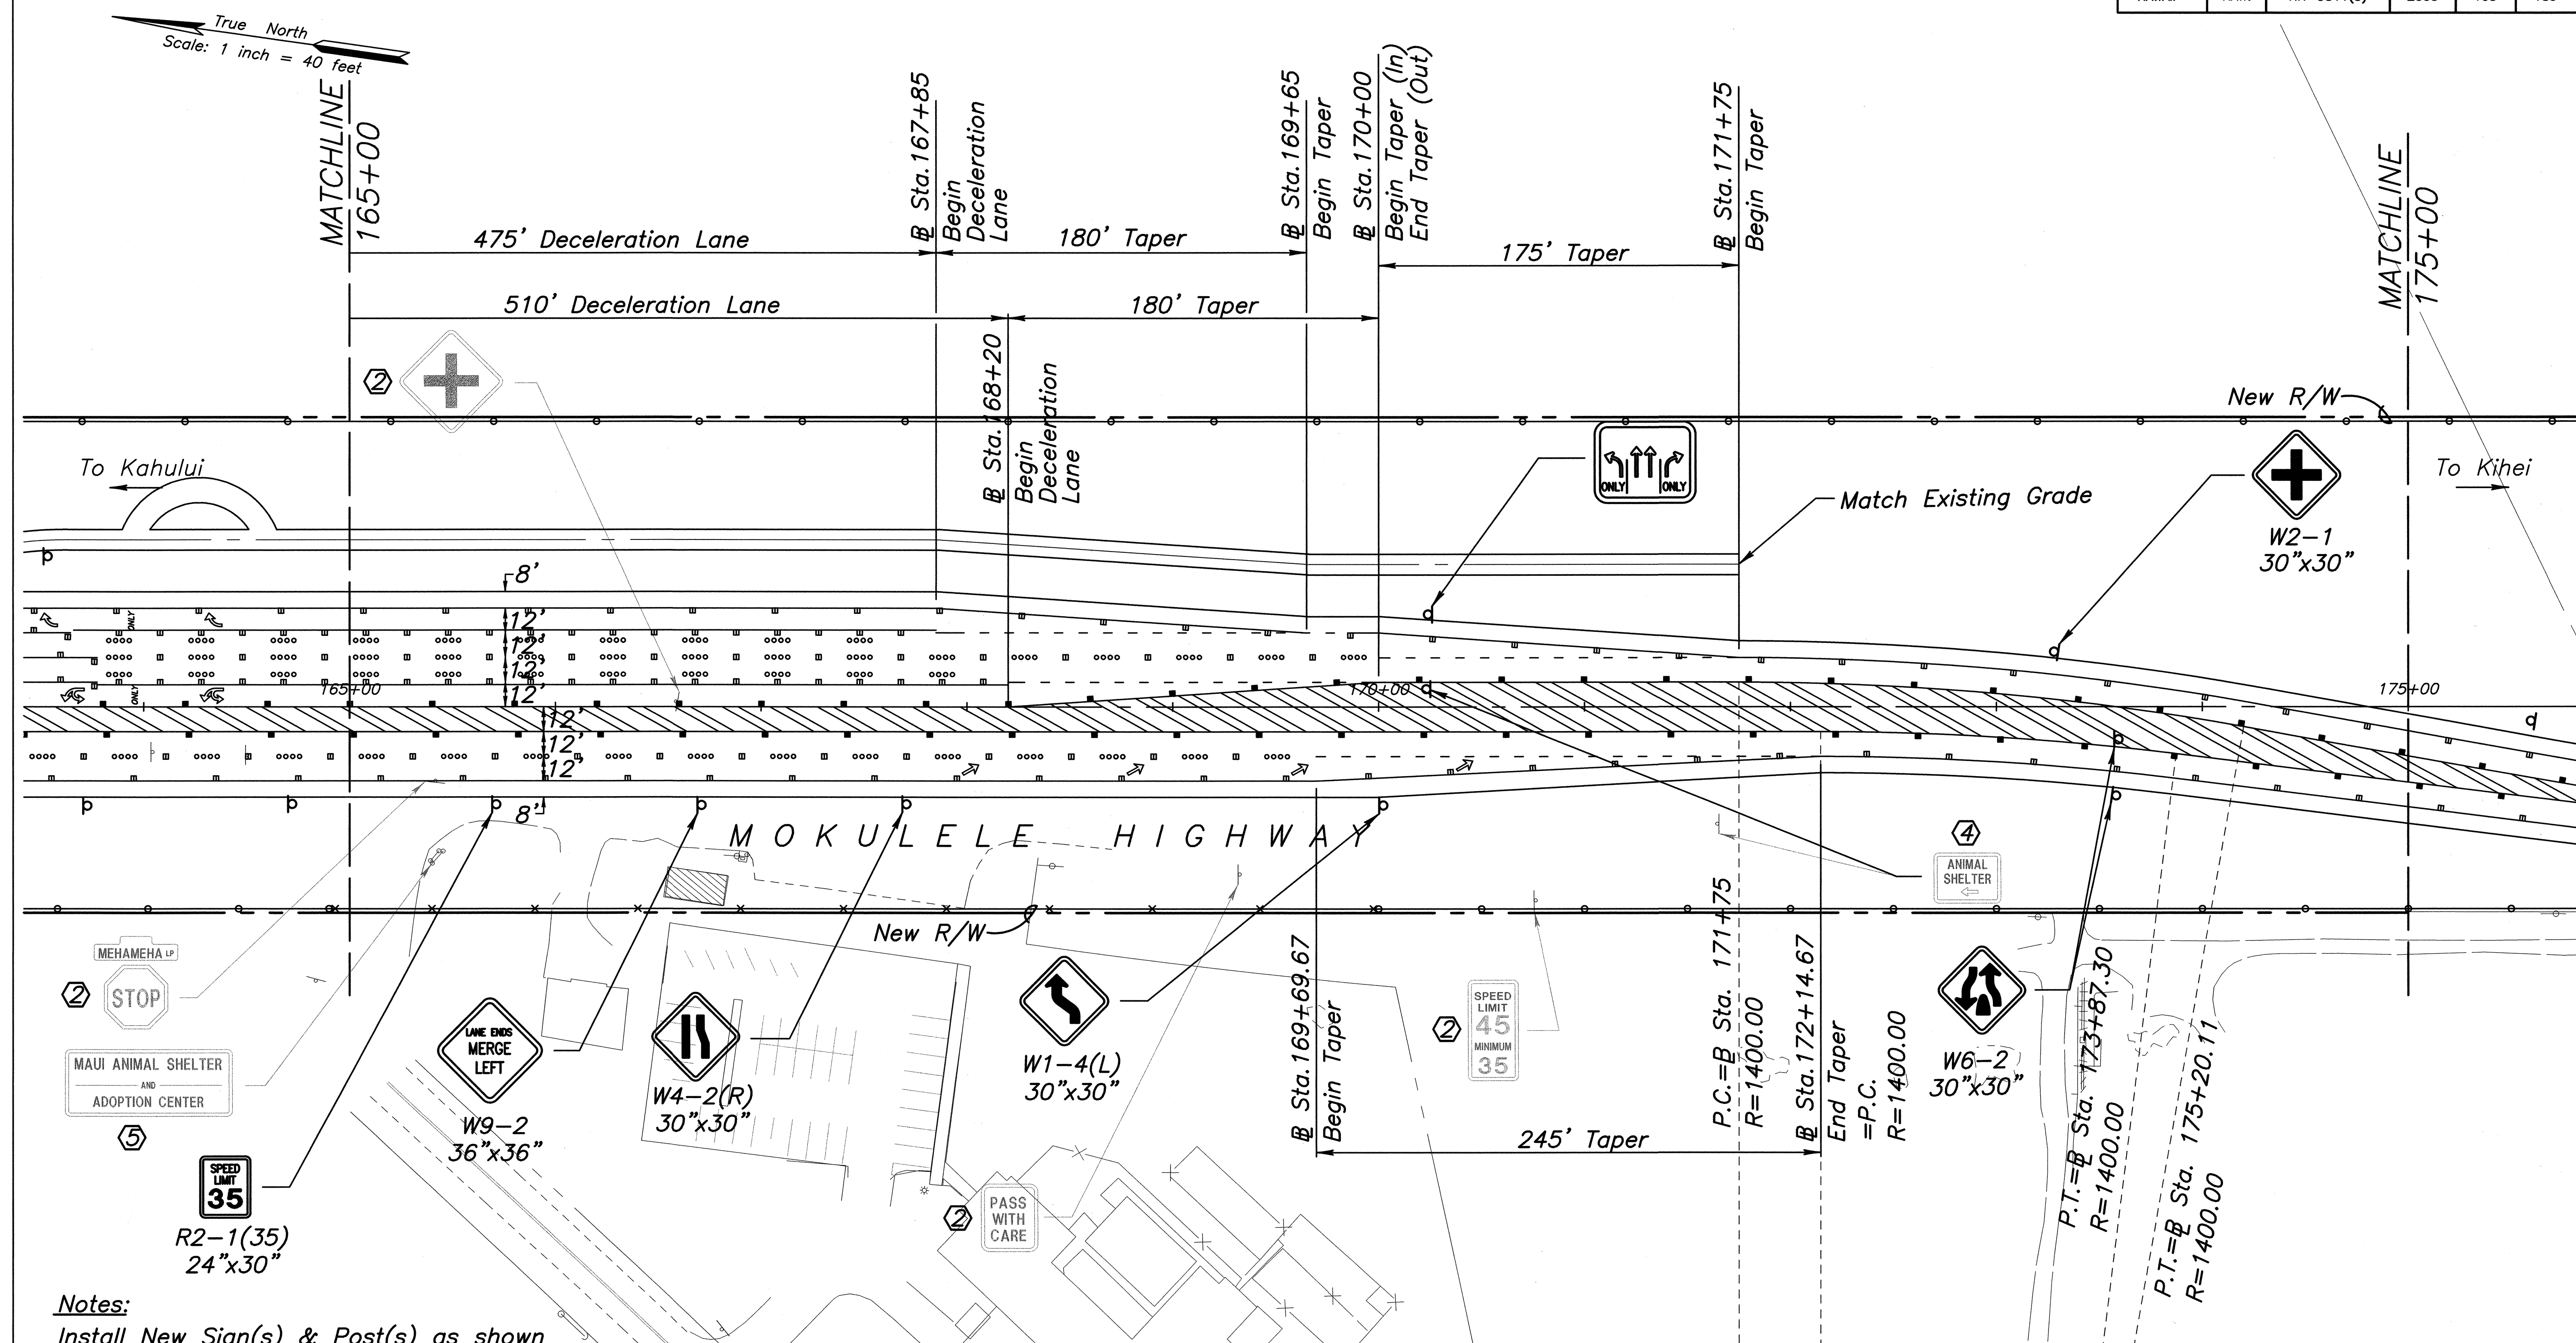

Notes:

Install New Sign(s) & Post(s) as shown unless otherwise specified (1)

- ① Existing sign(s) & post(s) to remain
- ② Remove existing sign(s) & post(s)
- ③ Remove existing & Install New Sign(s) & Post(s)
- ④ Relocate existing sign(s) & post(s)

Neatly bundle signs & posts to be removed and return to Highways Kahului Baseyard
For Details of Signs See Shts. 111

- ⑤ This is a private sign that needs to be relocated. Contractor shall coordinate with Maui Humane Society and the Engineer to determine new sign location.


12/23/02	Added Chain Link Fence
DATE	REVISION



STATE OF HAWAII DEPARTMENT OF TRANSPORTATION HIGHWAYS DIVISION	
STRIPING AND SIGNAGE PLAN	
MOKULELE HIGHWAY WIDENING	
Vicinity of Cane Haul Road	
To Maui Humane Society	
Federal - Aid Project No. NH-0311(5)	
Scale: 1"=40'	Date: JUNE 2002
SHEET No. 12	OF 14 SHEETS

ADD. 103

FED. ROAD DIST. NO.	STATE	FEDERAL - AID PROJ. NO.	FISCAL YEAR	SHEET NO.	TOTAL SHEETS
HAWAII	HAW.	NH-0311(5)	2003	104	189

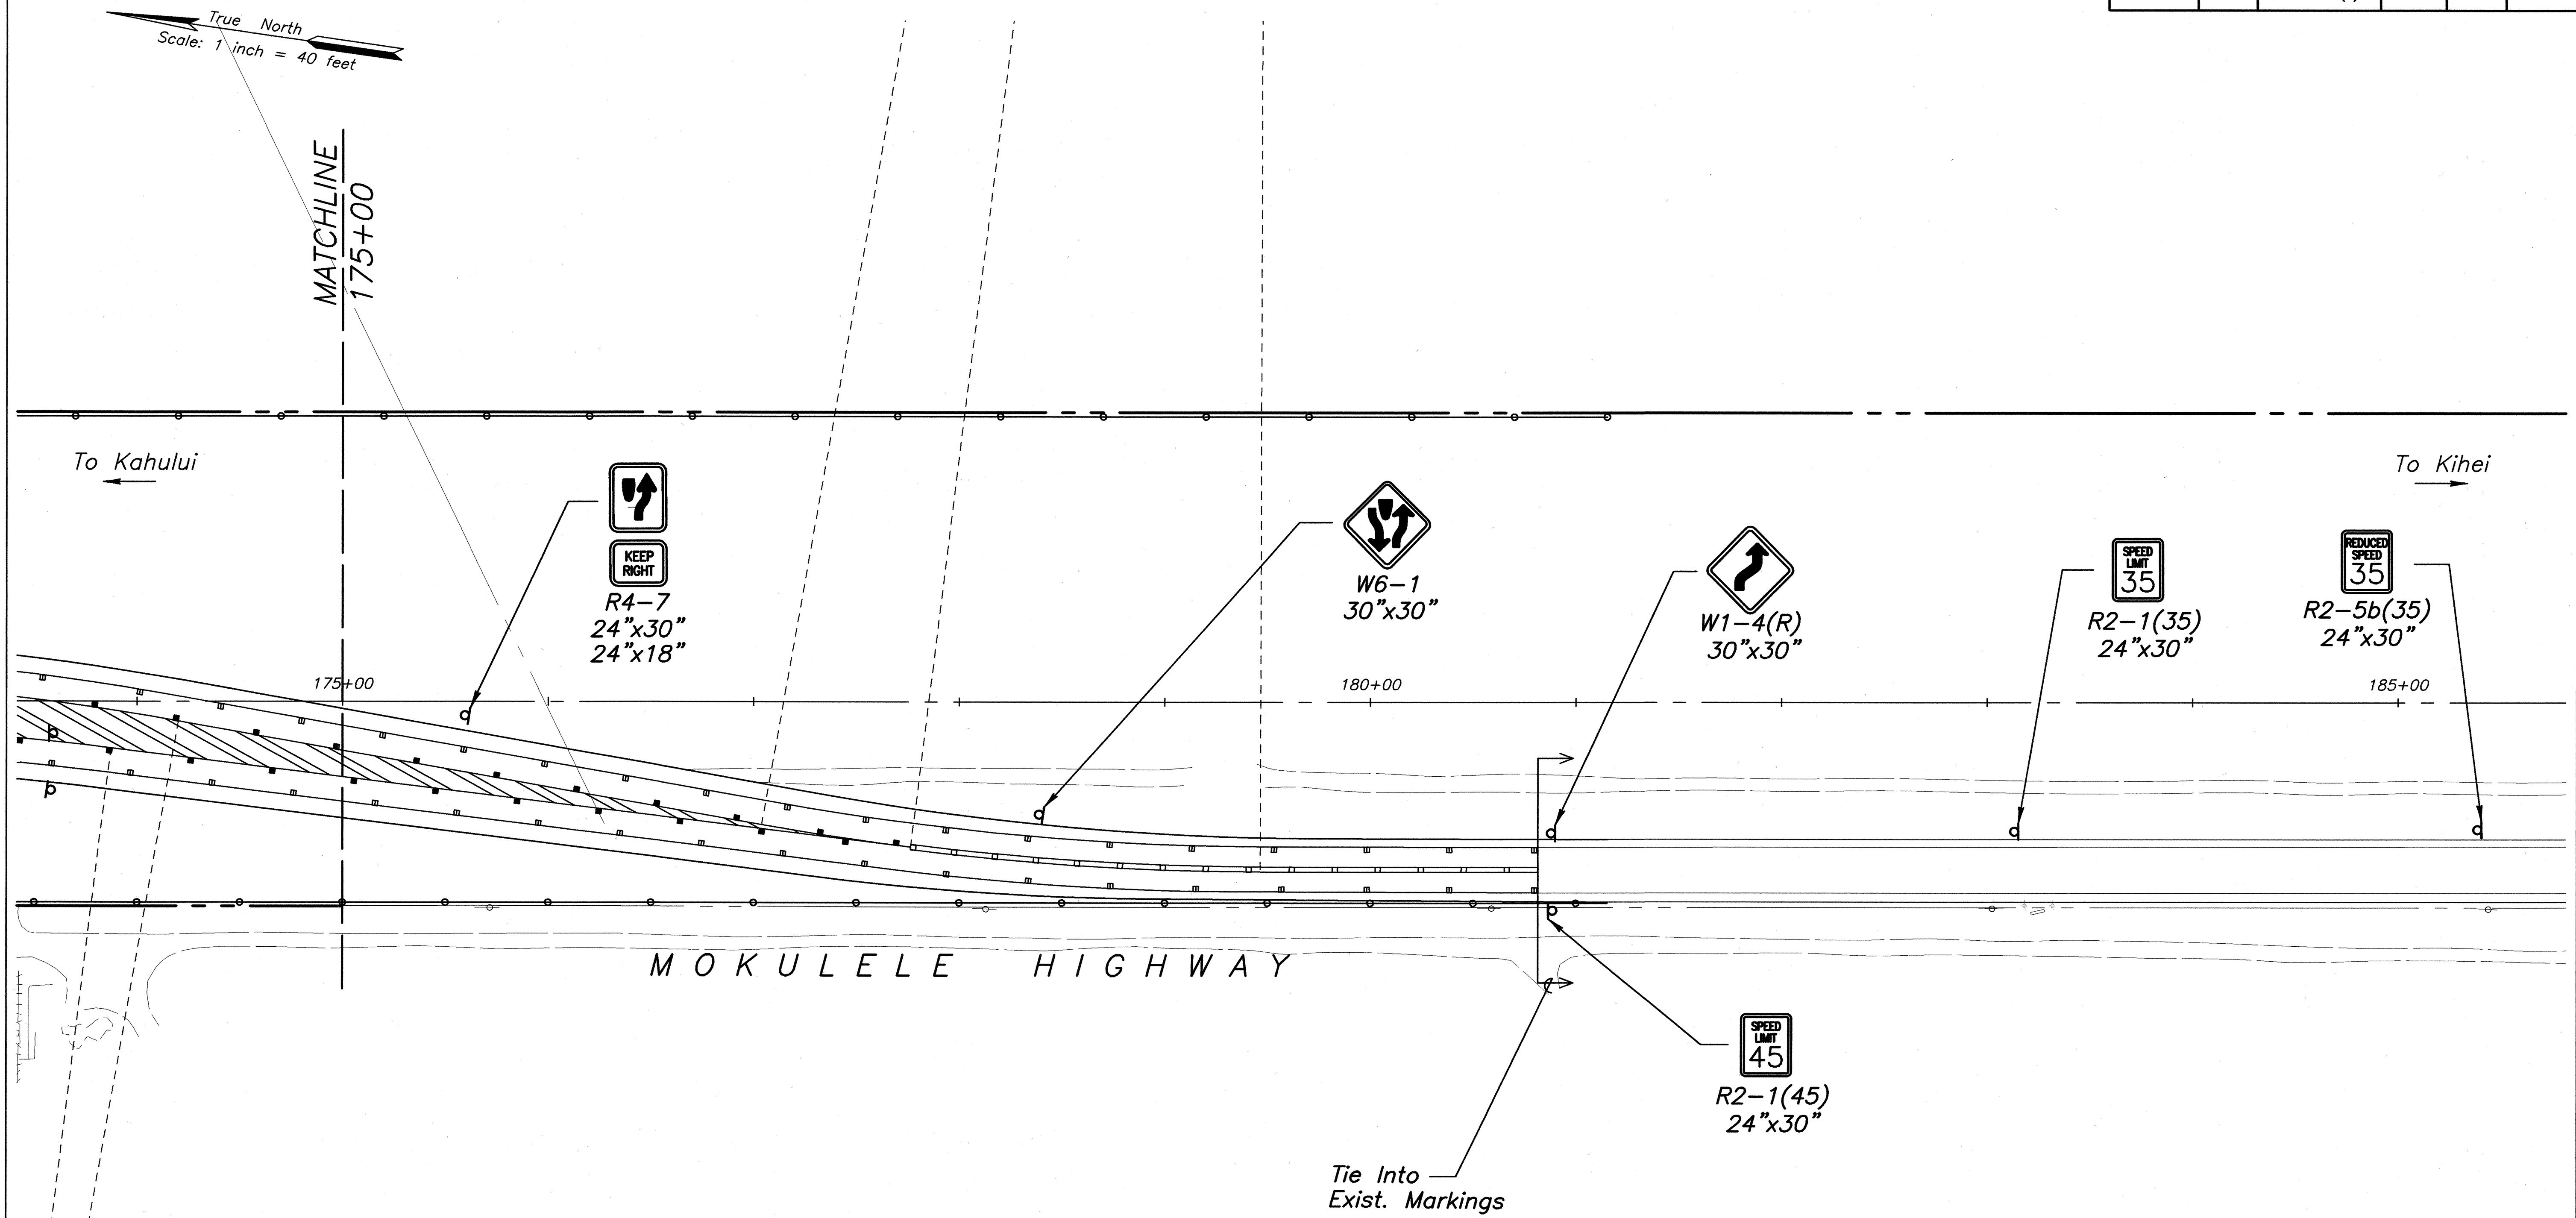

Notes:
 Install New Sign(s) & Post(s) as shown
 unless otherwise specified (1)

- ① Existing sign(s) & post(s) to remain
- ② Remove existing sign(s) & post(s)
- ③ Remove existing & Install New Sign(s) & Post(s)
- ④ Relocate existing sign(s) & post(s)

Neatly bundle signs & posts to be removed and
 return to Highways Kahului Baseyard
 For Details of Signs See Shts. 111

ORIGINAL PLAN	SURVEY PLOTTED BY	DATE
NOTE BOOK	DRAWN BY	..
	DESIGNED BY	..
	CHECKED BY	..
	No.	..

DANIEL S. MIYASATO
 LICENSED PROFESSIONAL ENGINEER
 No. 3443-C
 HAWAII U.S.A.

Daniel S. Miyasato
 SATO & ASSOCIATES, INC.
THIS WORK WAS PREPARED BY ME OR UNDER MY SUPERVISION

STATE OF HAWAII
 DEPARTMENT OF TRANSPORTATION
 HIGHWAYS DIVISION

STRIPING AND SIGNAGE PLAN


MOKULELE HIGHWAY WIDENING

Vicinity of Cane Haul Road
 To
 Maui Humane Society
 Federal - Aid Project No. NH-0311(5)

Scale: 1"=40' Date: JUNE 2002

SHEET No. 13 OF 14 SHEETS

FED. ROAD DIST. NO.	STATE	FEDERAL - AID PROJ. NO.	FISCAL YEAR	SHEET NO.	TOTAL SHEETS
HAWAII	HAW.	NH-0311(5)	2003	105	189

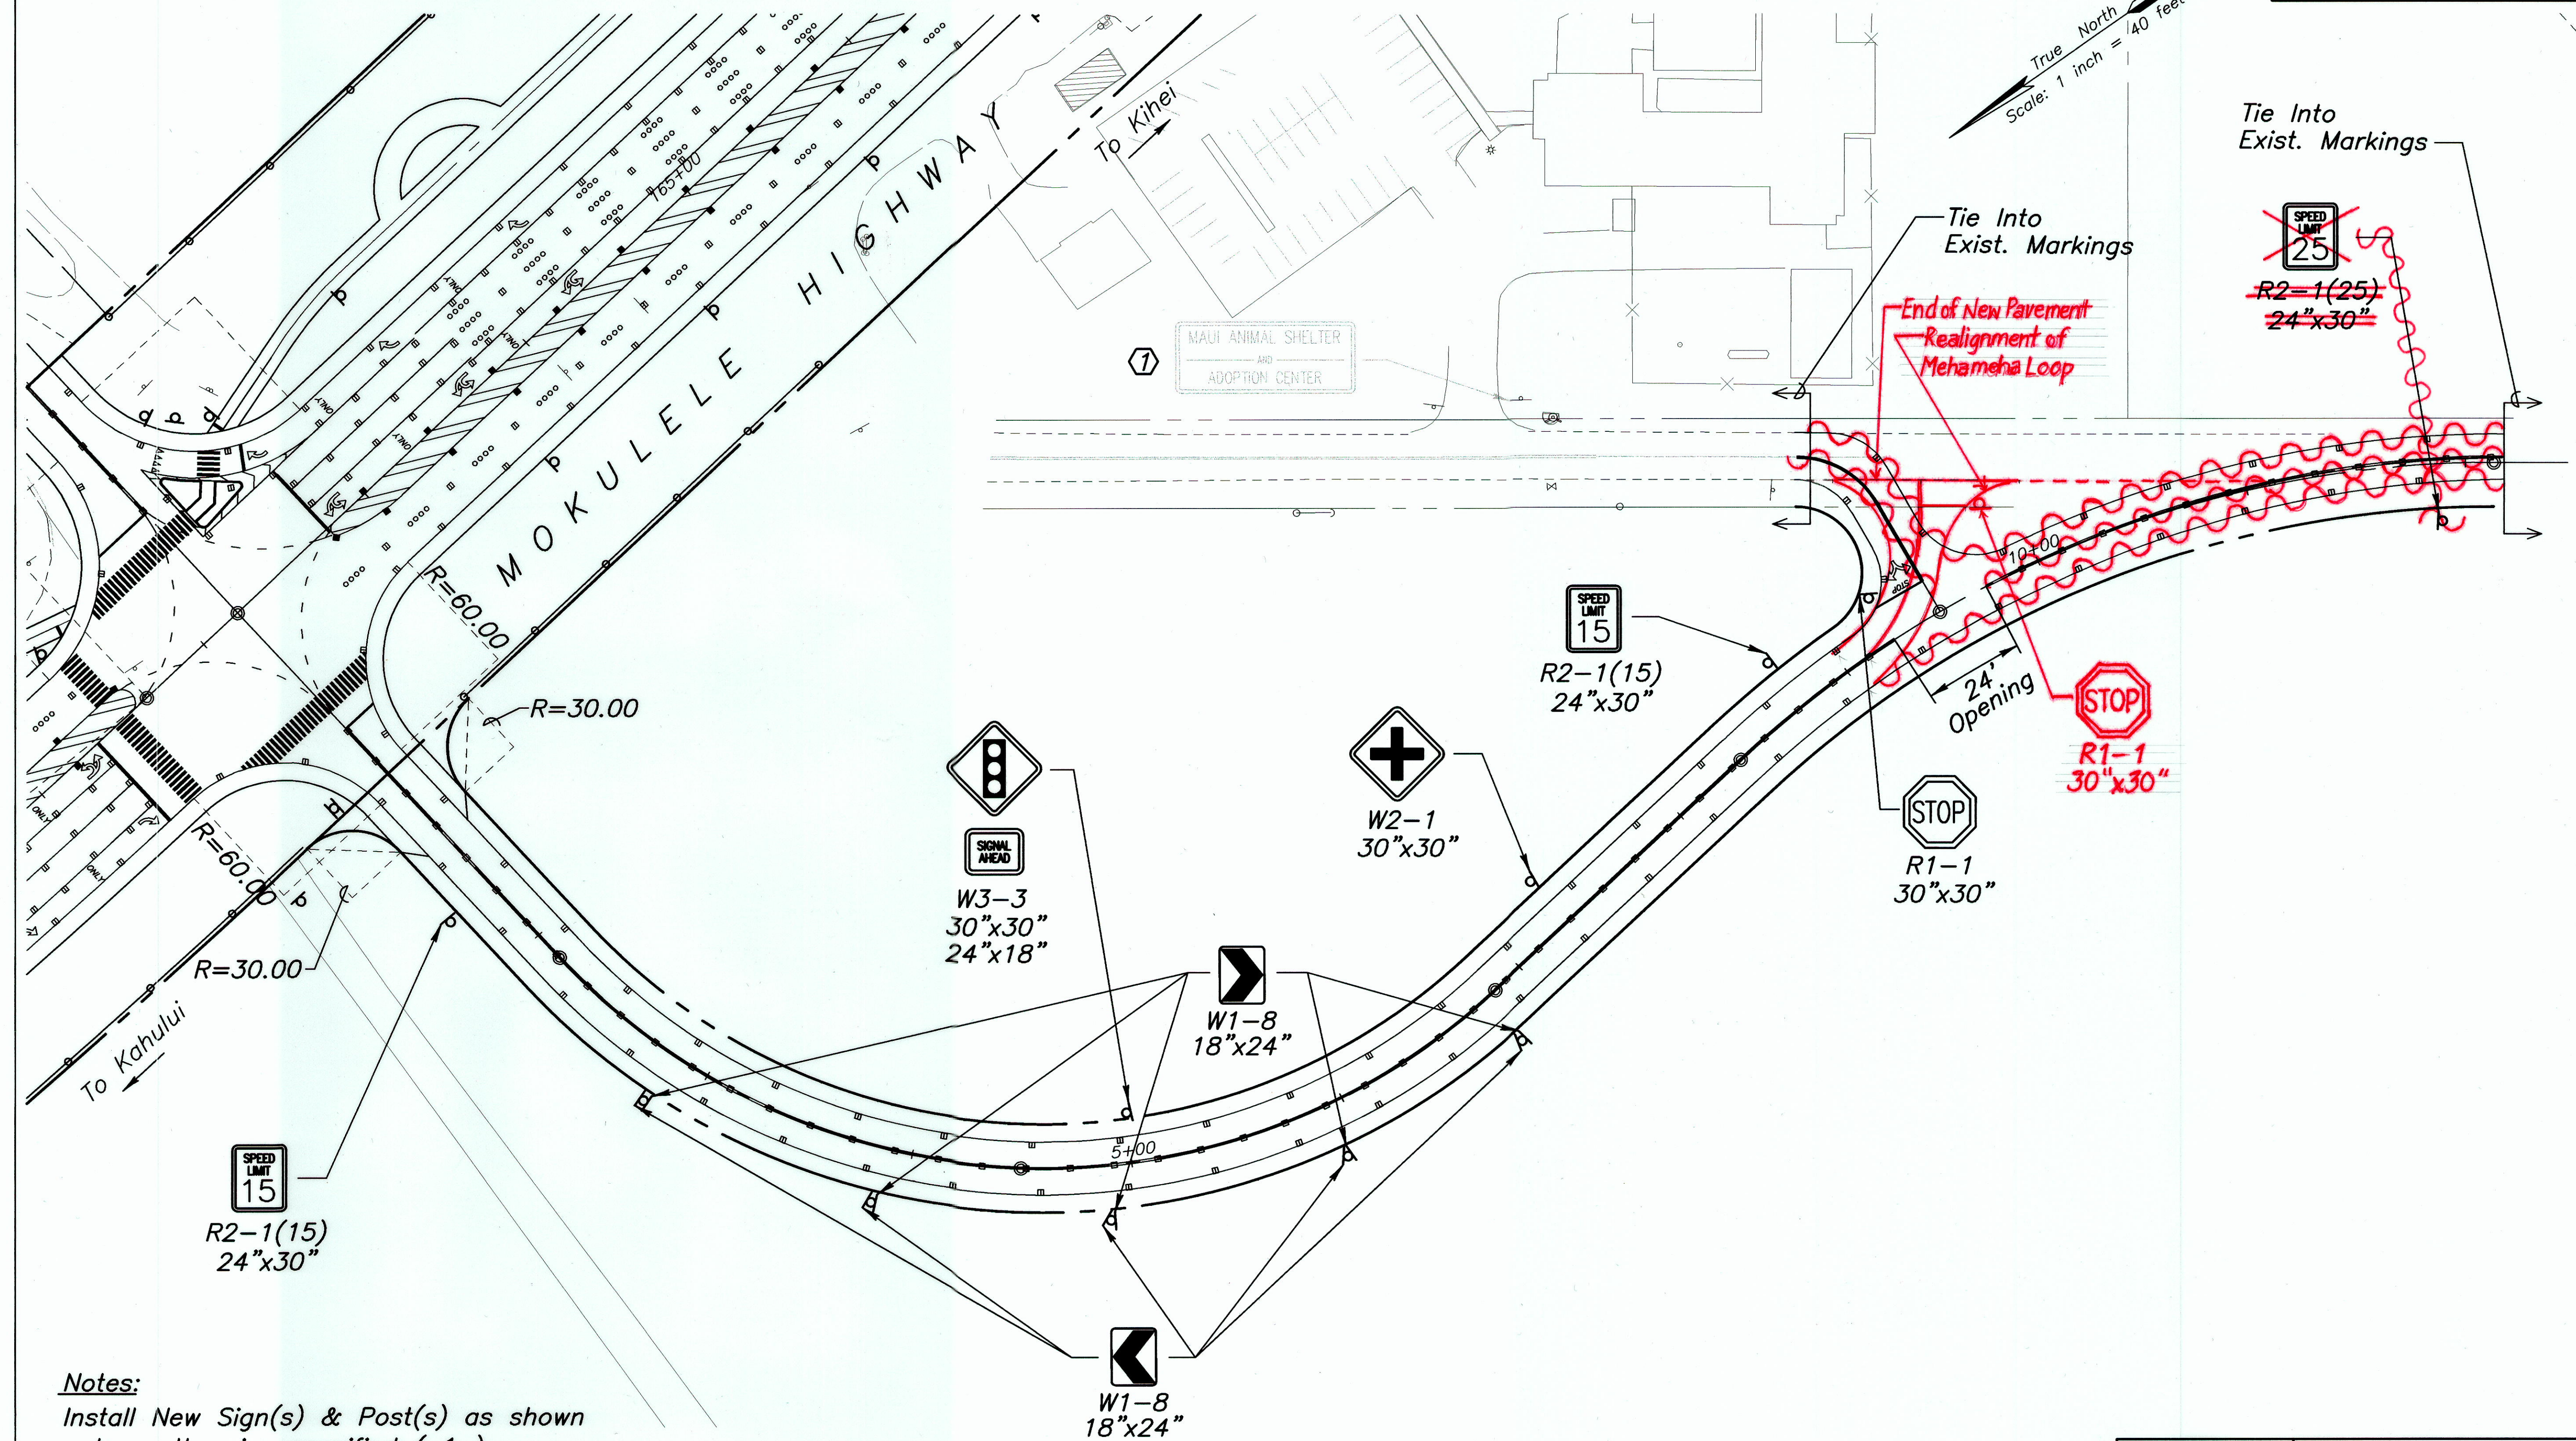

Notes:

Install New Sign(s) & Post(s) as shown unless otherwise specified (1)

- ① Existing sign(s) & post(s) to remain
- ② Remove existing sign(s) & post(s)
- ③ Remove existing & Install New Sign(s) & Post(s)
- ④ Relocate existing sign(s) & post(s)

Neatly bundle signs & posts to be removed and return to Highways Kahului Baseyard
For Details of Signs See Shts. 111

	STATE OF HAWAII DEPARTMENT OF TRANSPORTATION HIGHWAYS DIVISION	
	STRIPING AND SIGNAGE PLAN	
	MOKULELE HIGHWAY WIDENING	
	Vicinity of Cane Haul Road To Maui Humane Society Federal - Aid Project No. NH-0311(5) Scale: 1"=40' Date: JUNE 2002	
SHEET No. 14 OF 14 SHEETS		

"AS-BUILT"