

RAISED PAVEMENT MARKERS AND STRIPING SUMMARY

ORIGINAL PLAN	SURVEY PLOTTED BY _____	DATE _____
NOTE BOOK	DRAWN BY _____	" "
	TRACED BY _____	" "
	DESIGNED BY _____	" "
	QUANTITIES BY _____	" "
No. _____	CHECKED BY _____	" "



Paul J. Myers
SATO & ASSOCIATES, INC.
THIS WORK WAS PREPARED
ME OR UNDER MY SUPERVIS

RAISED PAVEMENT MARKERS AND STRIPING SUMMARY

ORIGINAL PLAN	SURVEY PLOTTED BY _____ DATE _____
NOTE BOOK	DRAWN BY _____ "
	TRACED BY _____ "
	DESIGNED BY _____ "
	QUANTITIES BY _____ "
No. _____	CHECKED BY _____



Paul J. Miyamoto
SATO & ASSOCIATES, INC.
THIS WORK WAS PREPARED
ME OR UNDER MY SUPERVIS

ORIGINAL PLAN	SURVEY PLOTTED BY	DATE
	DRAWN BY	
	DESIGNED BY	
	NOTED BY	
	CHECKED BY	
NOTE BOOK	No.	

RAISED PAVEMENT MARKERS AND STRIPING SUMMARY

FED. ROAD DIST. NO.	STATE	FEDERAL - AID PROJ. NO.	FISCAL YEAR	SHEET NO.	TOTAL SHEETS
HAWAII	HAW.	NH-0311(5)	2003	108	189

STATION TO STATION	PAVEMENT STRIPING					DISTANCE (L.F.)	PAVEMENT MARKERS (EA.)					STOP BAR WHITE 12" (L.F.)	LETTERING		SYMBOLS ARROW EA.	YIELD MARKING LANE	CROSS WALK LANE	COMMENTS
	4" YELLOW (L.F.)	12" YELLOW	4" WHITE	8" WHITE	12" WHITE		TYPE "A"	TYPE "C"	TYPE "D"	TYPE "H"	TYPE "J"		STOP	ONLY				
	DOUBLE	SINGLE	L.F.	L.F.	L.F.								EA.	EA.				
CENTRAL MAUI BASEYARD ROAD																		
CENTERLINE																		
Sta. 0+00 TO Sta. 2+50	195			195					10			51			1	1	3	
EDGE OF STRIPING																		
Sta. 0+00 TO Sta. 2+50				495				12				10						
TRAFFIC ISLAND																		
Sta. 0+36 TO Sta. 0+75					191	76		10										
MEHAMEHA LOOP																		
CENTERLINE																		
Sta. 0+00 TO Sta. 12+18	1218								58			25	1				2	
EDGE STRIPING																		
Sta. 0+00 TO Sta. 12+18				2560				64										
QUARRY ROAD																		
CENTERLINE																		
Sta. 0+00 TO Sta. 2+12	151			181					8			41				1	3	
EDGE OF STRIPING																		
Sta. 0+36 TO Sta. 2+12				500				11				10						
TRAFFIC ISLAND																		
Sta. 0+36 TO Sta. 0+77					198	56		10										
SHEET TOTAL	1,564			3,931	389	132		107	76			137	1		1	2	8	
TOTAL	9,523	13,682	3,349	30,875	1,634	132	2,400	1,385	92	611		396	4	14	26	2	16	

12/23/02	Revised Quantities for Stop Bar, Stop Lettering, and Crosswalk Marking
DATE	REVISION

DANIEL S. MIYASATO

LICENSED PROFESSIONAL ENGINEER

No. 3443-C

HAWAII U.S.A.



SATO & ASSOCIATES, INC.

THIS WORK WAS PREPARED BY ME OR UNDER MY SUPERVISION

STATE OF HAWAII
DEPARTMENT OF TRANSPORTATION
HIGHWAYS DIVISION

STRIPING AND SIGNAGE SUMMARY

MOKULELE HIGHWAY WIDENING

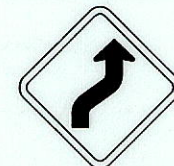
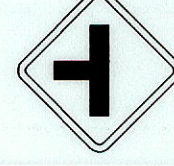
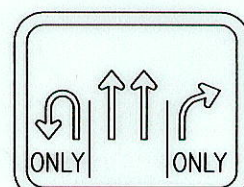
Vicinity of Cane Haul Road

To
Maui Humane Society

Federal - Aid Project No. NH-0311(5)

Scale: None Date: JUNE 2002

SHEET No. 3 OF 5 SHEETS

TRAFFIC SIGN SUMMARY			
SIGN NO.	MESSAGE	QUANTITY	
		10 SQ. FT. OR LESS W/POST	GREATER THAN 10 SQ. FT. W/POST
MOKULELE HWY.			
R1-2	YIELD	2	
R2-1 (35)	SPEED LIMIT 35	2	
R2-1 (45)	SPEED LIMIT 45	14	
R2-5B (35)	REDUCE SPEED 35	2	
R1-1	STOP	2	
W1-4 (R)		1	
W1-4 (L)		1	
W2-1		3 *See Note for the Change	*Traffic Signal Ahead. W3-3. For the Deleted 2 at Sta.173+50Lt. @ 161+10Rt,
W2-2		4	
W4-2 (R)		1	
W6-1		1	
W6-2		2	
W8-6-A		2	
W9-1(R)	RIGHT LANE ENDS	1	
W9-2		1	
		2	
		1	
W1-2 (L)		1	

FED. ROAD DIST. NO.	STATE	FEDERAL - AID PROJ. NO.	FISCAL YEAR	SHEET NO.	TOTAL SHEETS
HAWAII	HAW.	NH-0311(5)	2003	109	189

TRAFFIC SIGN SUMMARY			
SIGN NO.	MESSAGE	QUANTITY	
		10 SQ. FT. OR LESS W/POST	GREATER THAN 10 SQ. FT. W/POST
MOKULELE HWY.			
R3-2	 	1	
R4-7	 	1	
RM-4		1	
TOTAL		44	

SURVEY PLOTTED BY	DATE
ORIGINAL PLAN	
DESIGNED BY	
TRACED BY	
NOTED BY	
CHECKED BY	
No.	

12/23/02	Added Stop Sign Quantity
DATE	REVISION

"AS-BUILT"



DANIEL S. MIYASATO
LICENSED PROFESSIONAL ENGINEER
No. 3443-C
HAWAII, U.S.A.

Daniel S. Miyasato
SATO & ASSOCIATES, INC.
THIS WORK WAS PREPARED BY ME OR UNDER MY SUPERVISION

STATE OF HAWAII
DEPARTMENT OF TRANSPORTATION
HIGHWAYS DIVISION

STRIPING AND SIGNAGE SUMMARY

MOKULELE HIGHWAY WIDENING
Vicinity of Cane Haul Road
To
Maui Humane Society
Federal - Aid Project No. NH-0311(5)
Scale: None Date: JUNE 2002

SHEET No. 4 OF 5 SHEETS

ADD. 109

ORIGINAL PLAN	SURVEY PLOTTED BY	DATE
	DRAWN BY	
	DESIGNED BY	
	CHECKED BY	
NOTE BOOK	QUANTITIES BY	
	CHECKED BY	
No.		

TRAFFIC SIGN SUMMARY			
SIGN NO.	MESSAGE	QUANTITY	
		10 SQ. FT. OR LESS W/POST	GREATER THAN 10 SQ. FT. W/POST
MEHAMEHA LOOP			
R1-1	STOP	1	
R2-1 (15)	SPEED LIMIT 15	2	
R2-1 (25)	SPEED LIMIT 25	1	
W2-1		1	
W3-3	SIGNAL AHEAD	1	
W1-8		5	
W1-8		5	
TOTAL		16	

TRAFFIC SIGN SUMMARY			
SIGN NO.	MESSAGE	QUANTITY	
		10 SQ. FT. OR LESS W/POST	GREATER THAN 10 SQ. FT. W/POST
PATHWAY			
R1-1	STOP	6	
R3-7 (L)	NO MOTOR VEHICLE	6	
R1-2	YIELD	2	
TOTAL		14	

FED. ROAD DIST. NO.	STATE	FEDERAL - AID PROJ. NO.	FISCAL YEAR	SHEET NO.	TOTAL SHEETS
HAWAII	HAW.	NH-0311(5)	2003	110	189

MILEPOST MARKER SUMMARY			
LOCATION	SIGN NO. AND MESSAGE	TYPE A ASSEMBLY B-DIRECTIONAL W/ POST	HIGHWAY ROUTE NUMBER PLATE MESSAGE
MOKULELE HIGHWAY Sta. 95+65 Rt.	D10-1 MILE 2	1	311
MOKULELE HIGHWAY Sta. 95+65 Lt.	D10-1 MILE 2	1	311
MOKULELE HIGHWAY Sta. 147+10 Rt.	D10-1 MILE 3	1	311
MOKULELE HIGHWAY Sta. 147+10 Lt.	D10-1 MILE 3	1	311
TOTAL		4	

ROUTE MARKER SUMMARY					
SIGN ASSEMBLY	SIGN NO. AND MESSAGE	TYPE A ASSEMBLY		TYPE B ASSEMBLY	
		W/ POST	W/O POST	W/ POST	W/O POST
	MOKULELE HIGHWAY				
SRM-1	 M3-3 M1-6 (31) M6-3	1			
TOTAL		1			

DANIEL S. MIYASATO
LICENSED PROFESSIONAL ENGINEER
No. 3443-C
HAWAII U.S.A.

Daniel Miyasato
SATO & ASSOCIATES, INC.
THIS WORK WAS PREPARED BY ME OR UNDER MY SUPERVISION

STATE OF HAWAII
DEPARTMENT OF TRANSPORTATION
HIGHWAYS DIVISION

STRIPING AND SIGNAGE SUMMARY

MOKULELE HIGHWAY WIDENING
Vicinity of Cane Haul Road
To
Maui Humane Society
Federal - Aid Project No. NH-0311(5)
Scale: None Date: JUNE 2002

SHEET No. 5 OF 5 SHEETS