


FED. ROAD DIST. NO.	STATE	FEDERAL - AID PROJ. NO.	FISCAL YEAR	SHEET NO.	TOTAL SHEETS
HAWAII	HAW.	NH-A311(6)R	2008	116	173

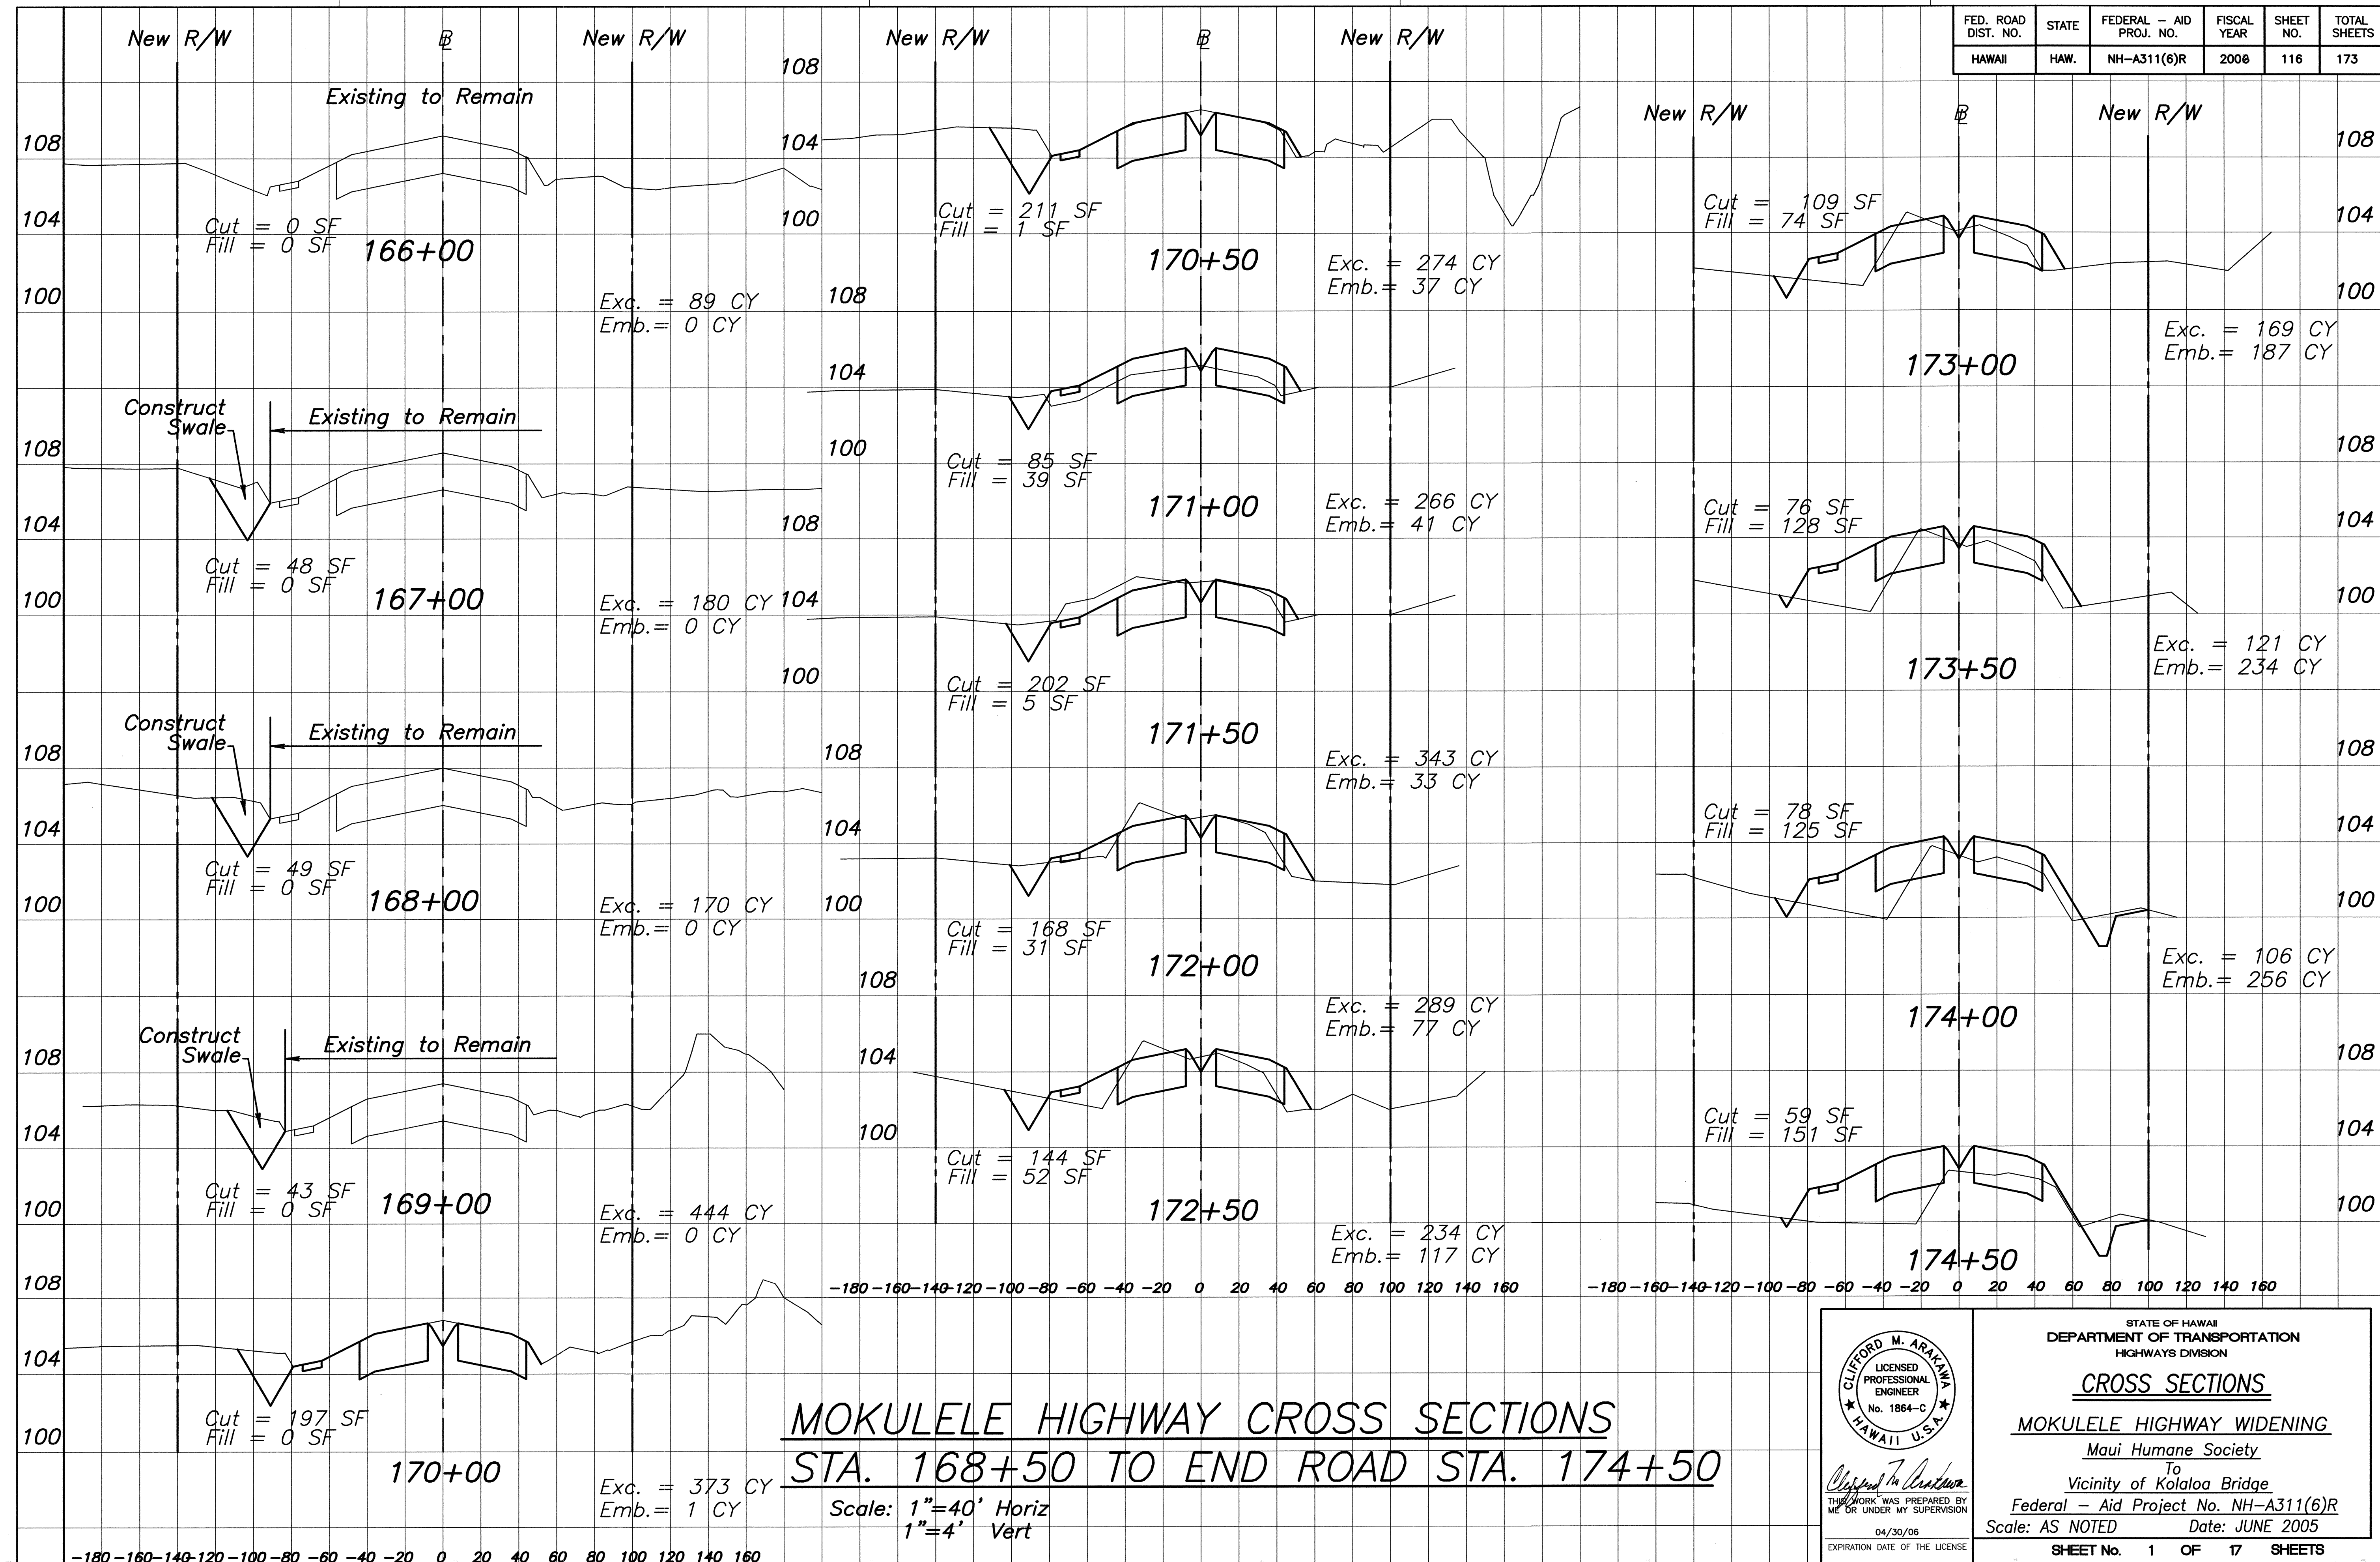

DATE: _____

SURVEY PLOTTED BY: _____

DRAWN BY: _____

TRACED BY: _____

DESIGNED BY: _____

CHECKED BY: _____

NOTE BOOK: _____

QUANTITIES BY: _____

NO. _____

MOKULELE HIGHWAY CROSS SECTIONS STA. 168+50 TO END ROAD STA. 174+50 Scale: 1"=40' Horiz 1"=4' Vert

CLIFFORD M. ARAKAWA
 LICENSED PROFESSIONAL ENGINEER
 No. 1864-C
 HAWAII, U.S.A.


STATE OF HAWAII
 DEPARTMENT OF TRANSPORTATION
 HIGHWAYS DIVISION

CROSS SECTIONS

MOKULELE HIGHWAY WIDENING
 Maui Humane Society
 To
 Vicinity of Kolaloa Bridge
 Federal - Aid Project No. NH-A311(6)R
 Scale: AS NOTED Date: JUNE 2005


SHEET No. 1 OF 17 SHEETS

ORIGINAL PLAN	SURVEY PLOTTED BY	DATE
	DRAWN BY	
	TRACED BY	
	NOTE BOOK	
No.	QUANTITIES BY	
	CHECKED BY	

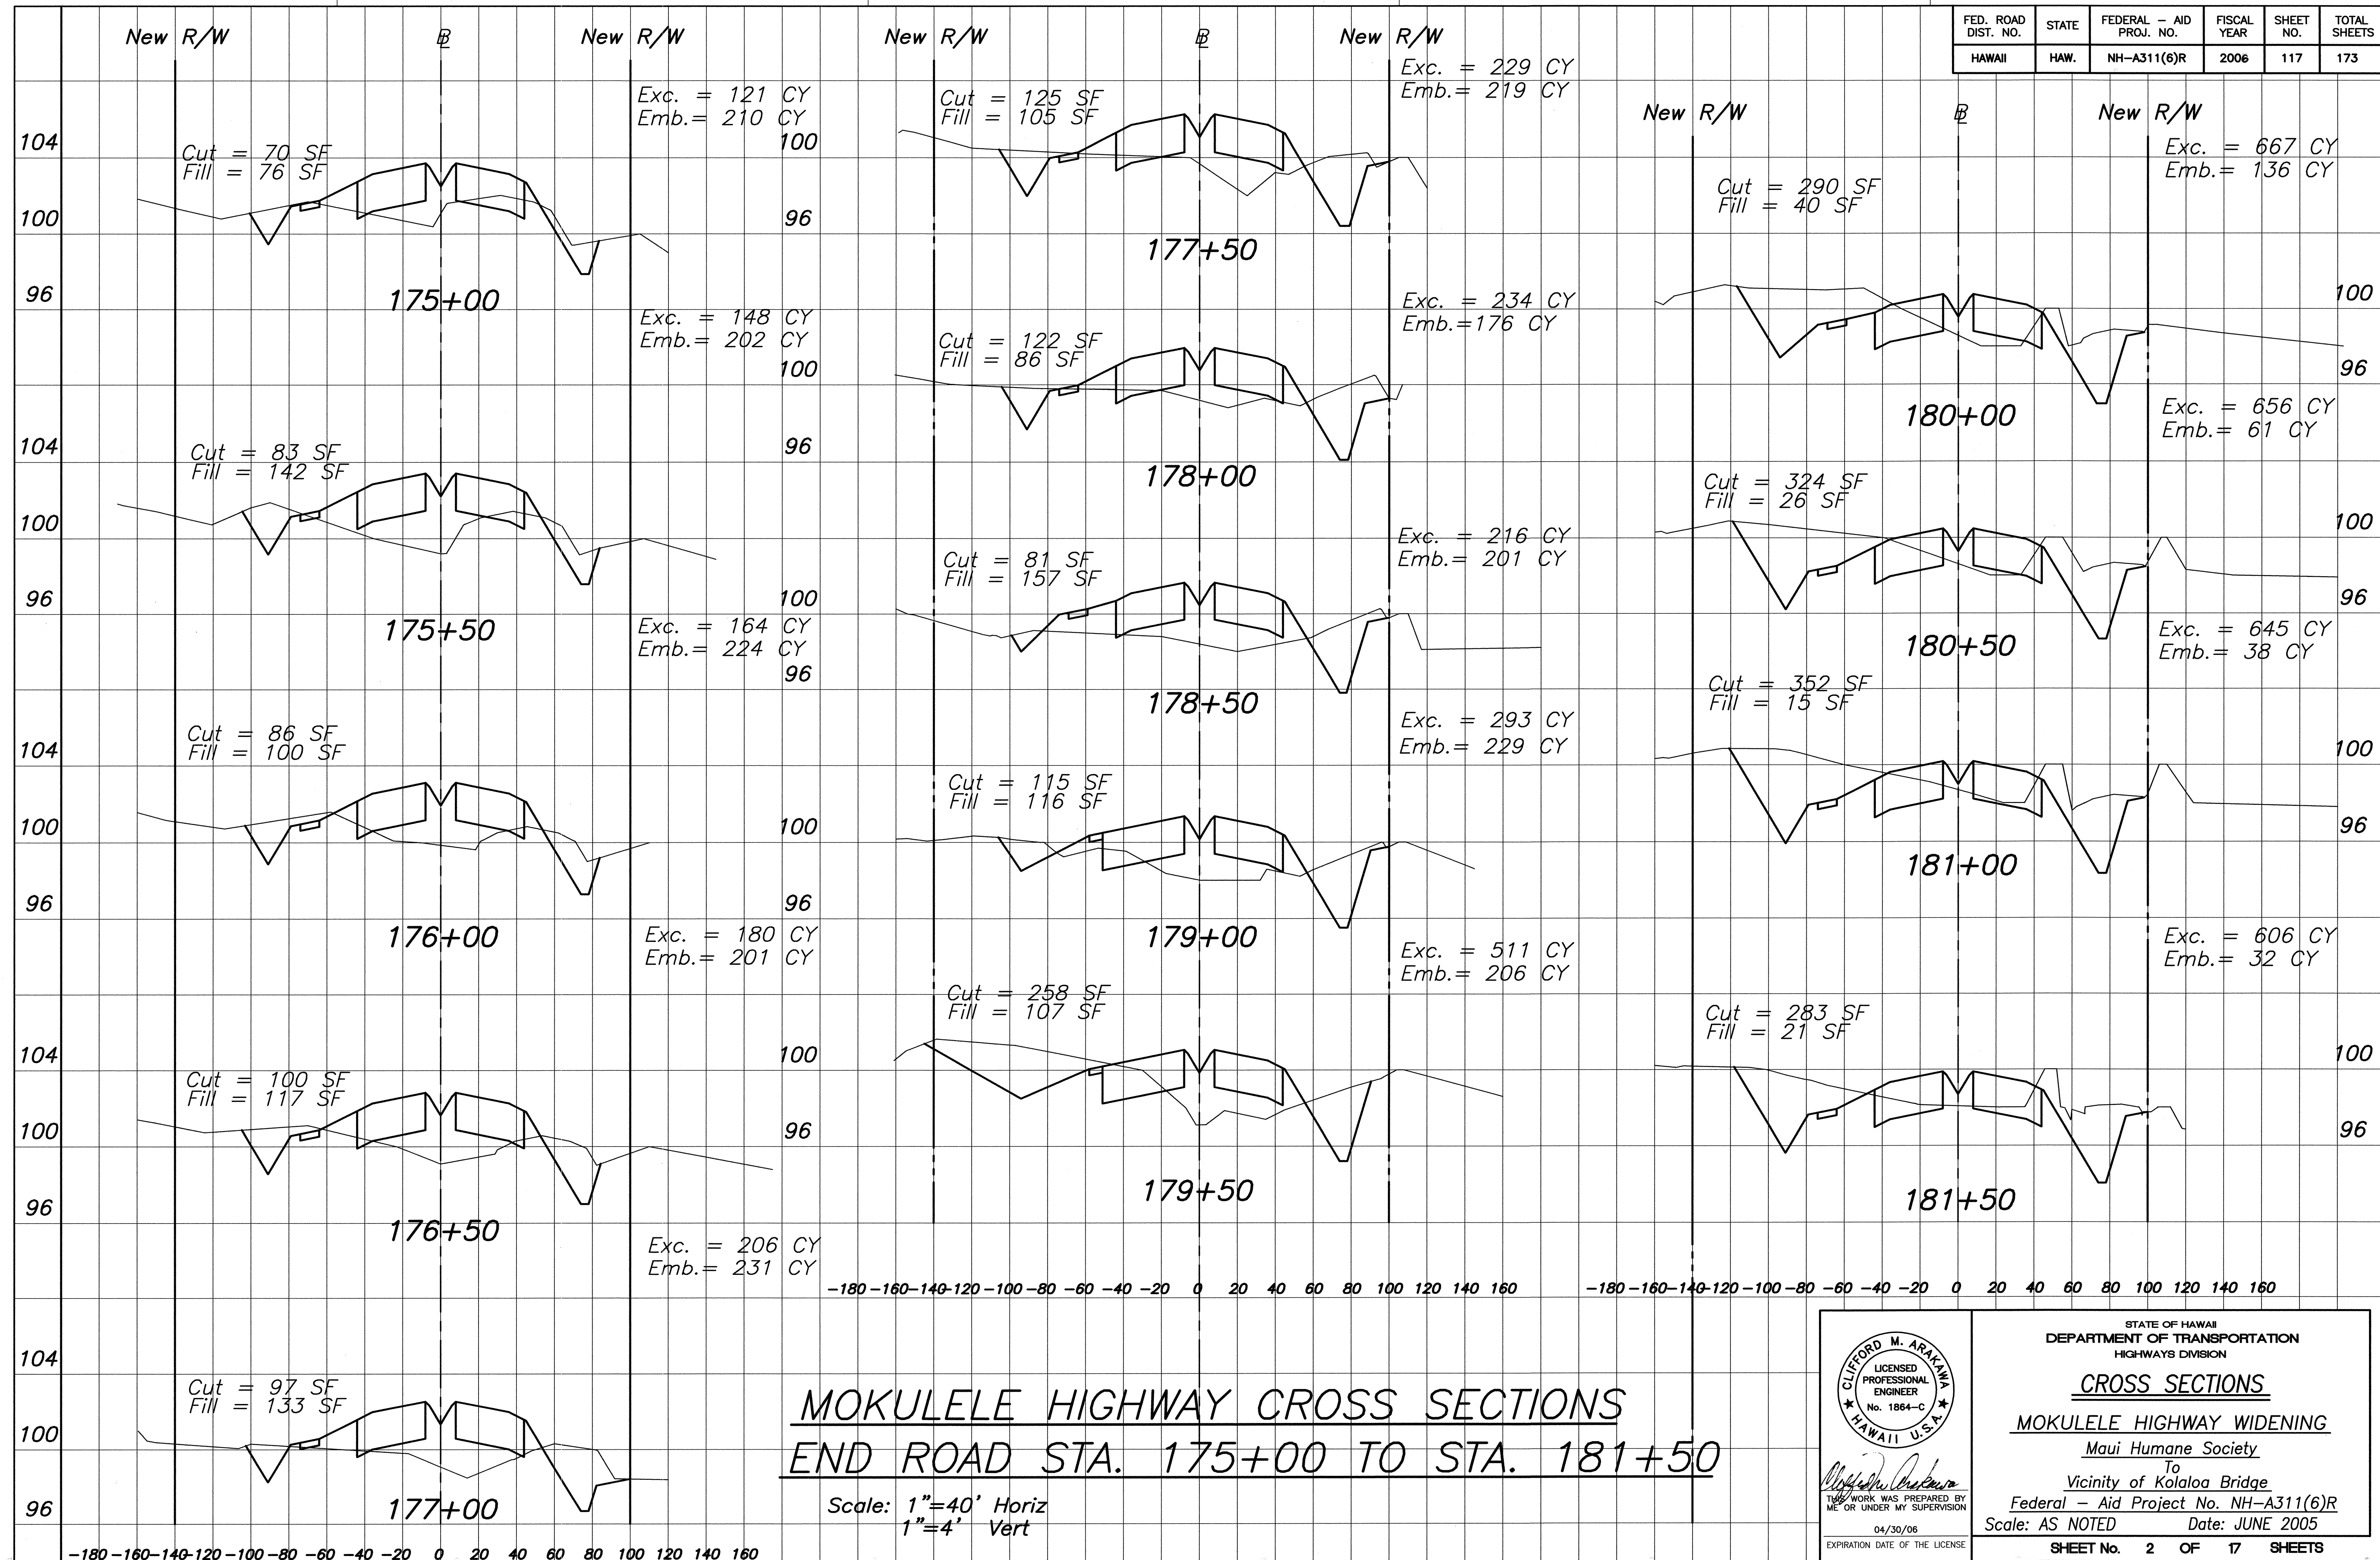

	STATE OF HAWAII
	DEPARTMENT OF TRANSPORTATION
	HIGHWAYS DIVISION
	CROSS SECTIONS
	MOKULELE HIGHWAY WIDENING
	Maui Humane Society
	To
	Vicinity of Kolaloa Bridge
	Federal - Aid Project No. NH-A311(6)R
	Scale: AS NOTED Date: JUNE 2005
	SHEET No. 2 OF 17 SHEETS

FED. ROAD DIST. NO.	STATE	FEDERAL - AID PROJ. NO.	FISCAL YEAR	SHEET NO.	TOTAL SHEETS
HAWAII	HAW.	NH-A311(6)R	2006	118	173

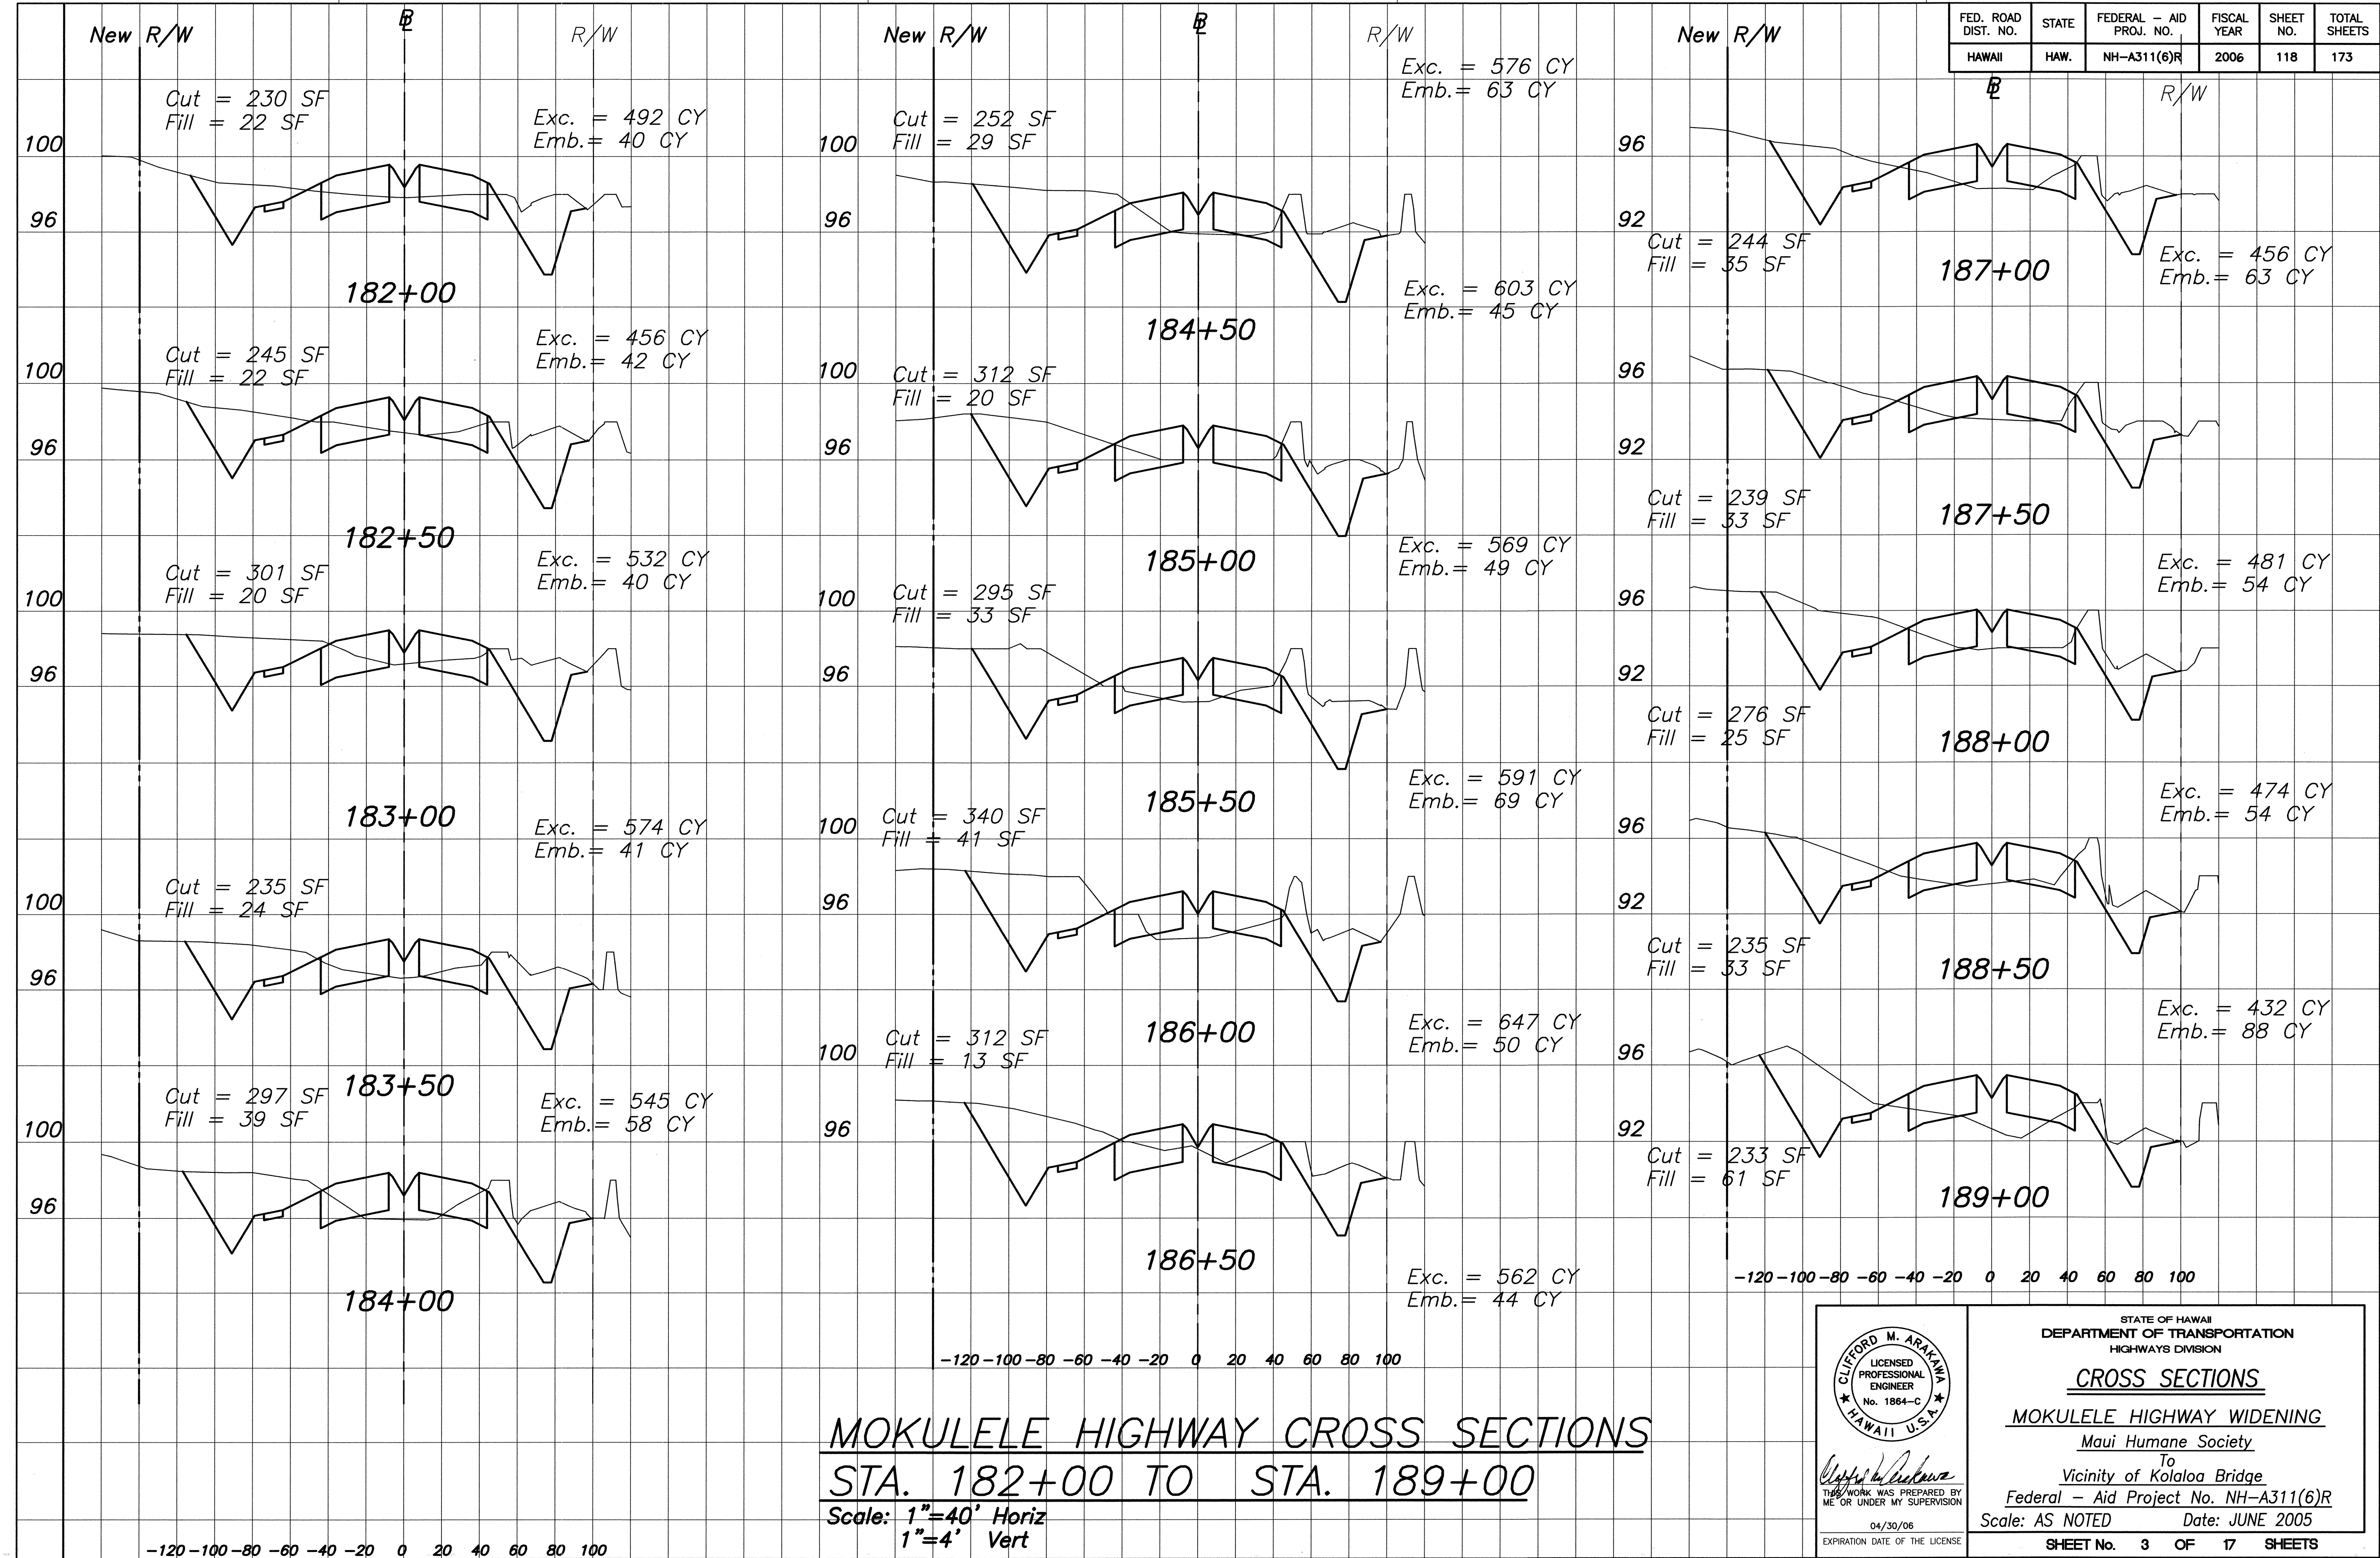

DATE: _____
SURVEY PLOTTED BY: _____
DRAWN BY: _____
CHECKED BY: _____
NOTE BOOK: _____
No. _____

CLIFFORD M. ARAKAWA
LICENSED PROFESSIONAL ENGINEER
No. 1864-C
HAWAII U.S.A.

STATE OF HAWAII
DEPARTMENT OF TRANSPORTATION
HIGHWAYS DIVISION

CROSS SECTIONS


MOKULELE HIGHWAY WIDENING

Maui Humane Society
To
Vicinity of Kolaloa Bridge
Federal - Aid Project No. NH-A311(6)R

Scale: AS NOTED Date: JUNE 2005

SHEET No. 3 OF 17 SHEETS

ORIGINAL PLAN	SURVEY PLOTTED BY	DATE
	DRAWN BY	
	NOTED BY	
	CHECKED BY	

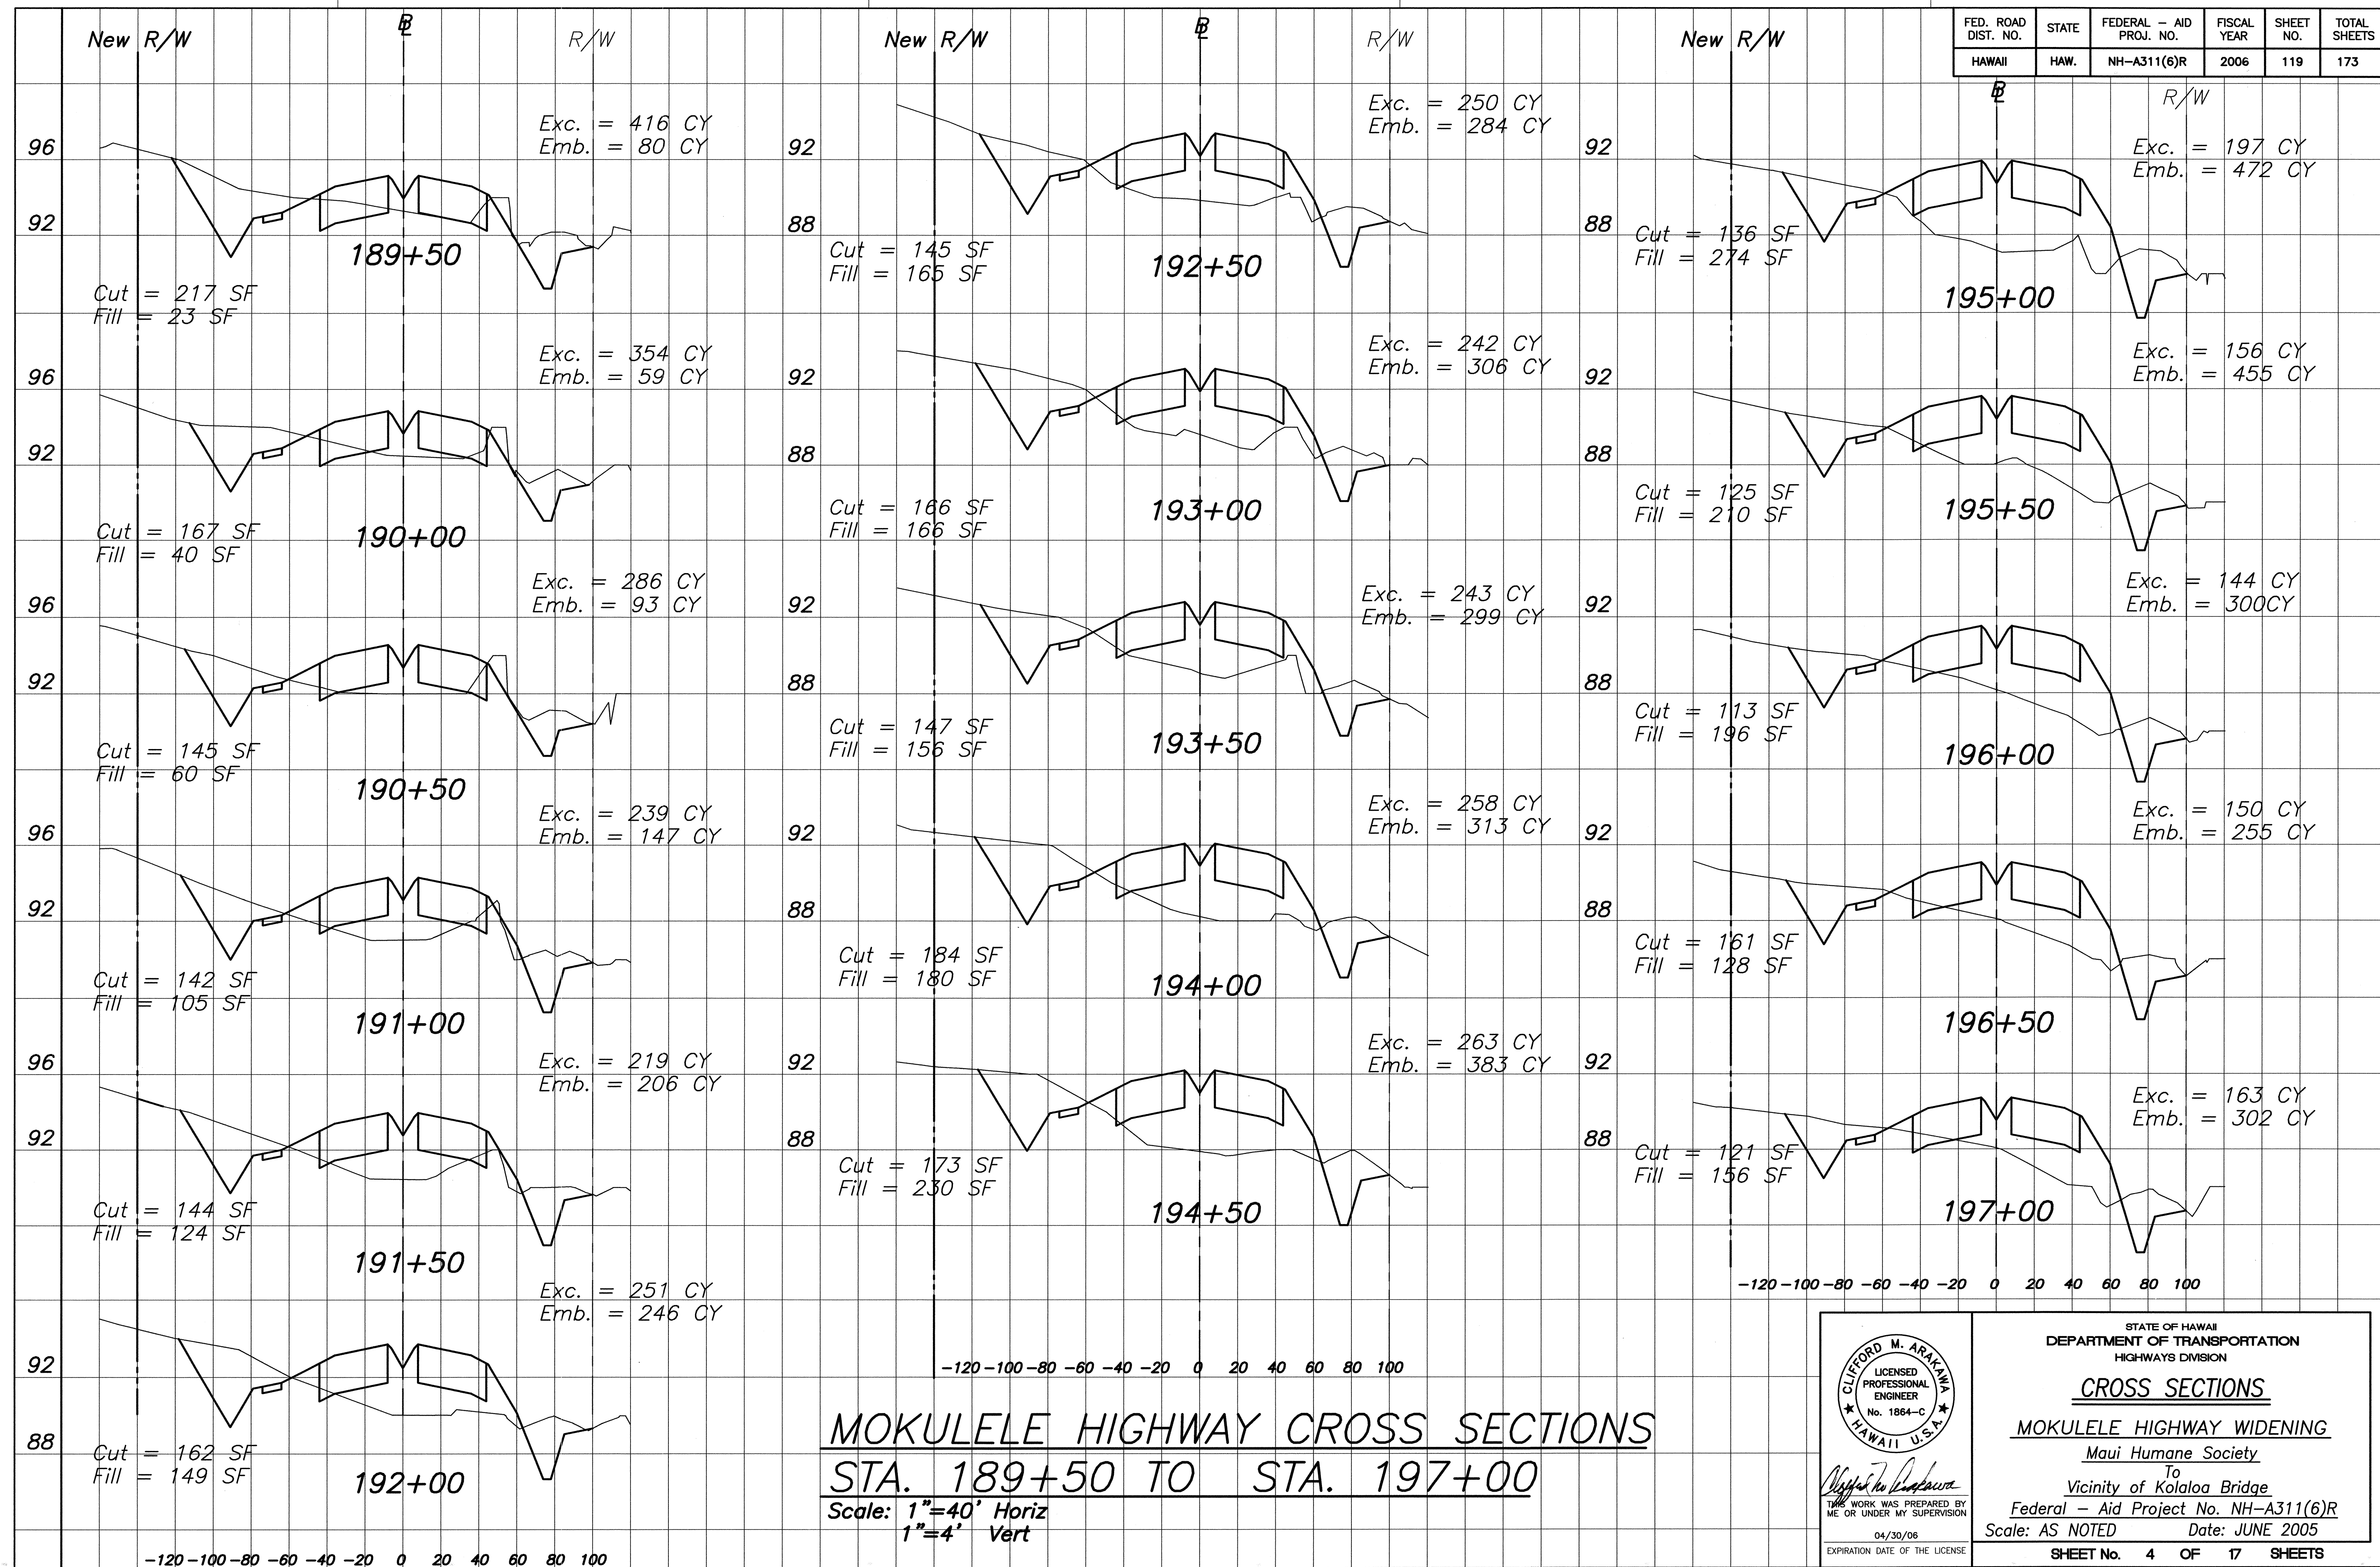

STATE OF HAWAII
DEPARTMENT OF TRANSPORTATION
HIGHWAYS DIVISION

CROSS SECTIONS


MOKULELE HIGHWAY WIDENING

Maui Humane Society
To
Vicinity of Kolaloa Bridge
Federal - Aid Project No. NH-A311(6)R

Scale: AS NOTED Date: JUNE 2005

SHEET No. 4 OF 17 SHEETS

FED. ROAD DIST. NO.	STATE	FEDERAL - AID PROJ. NO.	FISCAL YEAR	SHEET NO.	TOTAL SHEETS
HAWAII	HAW.	NH-A311(6)R	2006	120	173

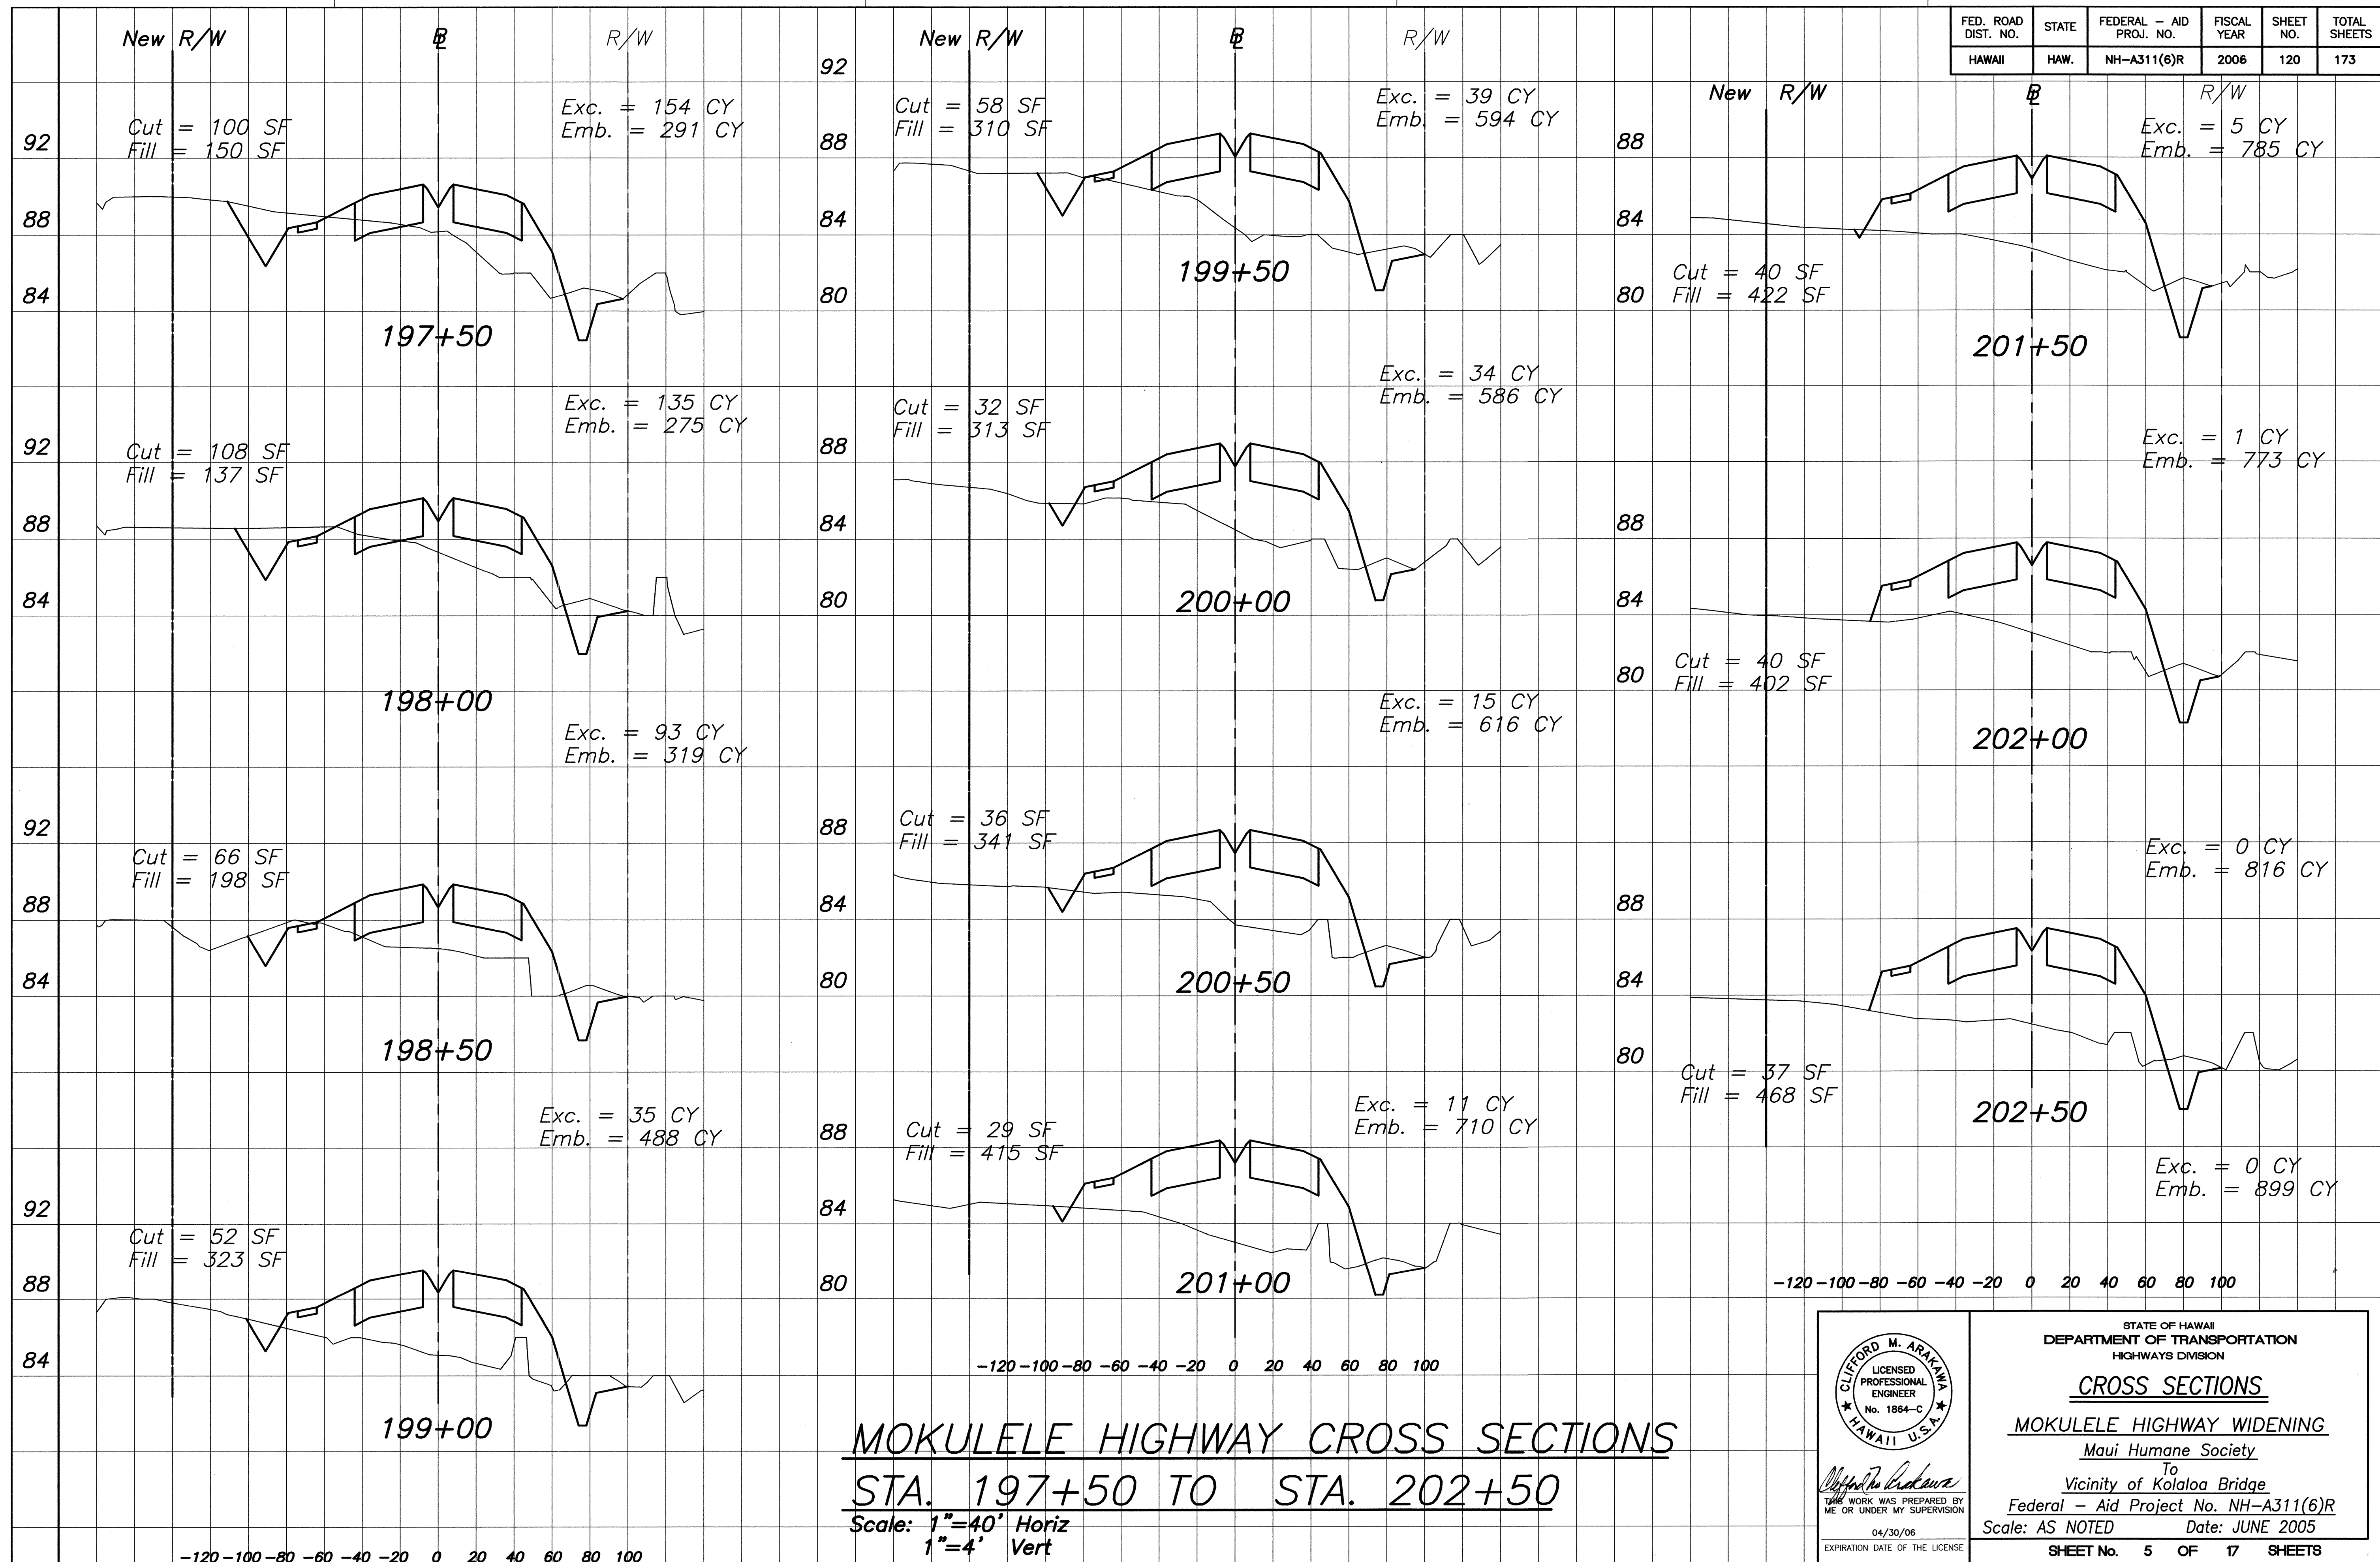

CLIFFORD M. ARAKAWA
LICENSED PROFESSIONAL ENGINEER
No. 1864-C
HAWAII U.S.A.

THIS WORK WAS PREPARED BY ME OR UNDER MY SUPERVISION
04/30/06
EXPIRATION DATE OF THE LICENSE

STATE OF HAWAII
DEPARTMENT OF TRANSPORTATION
HIGHWAYS DIVISION


CROSS SECTIONS

MOKULELE HIGHWAY WIDENING

Maui Humane Society
To
Vicinity of Kolaloa Bridge
Federal - Aid Project No. NH-A311(6)R
Scale: AS NOTED Date: JUNE 2005



SHEET No. 5 OF 17 SHEETS

FED. ROAD DIST. NO.	STATE	FEDERAL - AID PROJ. NO.	FISCAL YEAR	SHEET NO.	TOTAL SHEETS
HAWAII	HAW.	NH-A311(6)R	2006	121	173

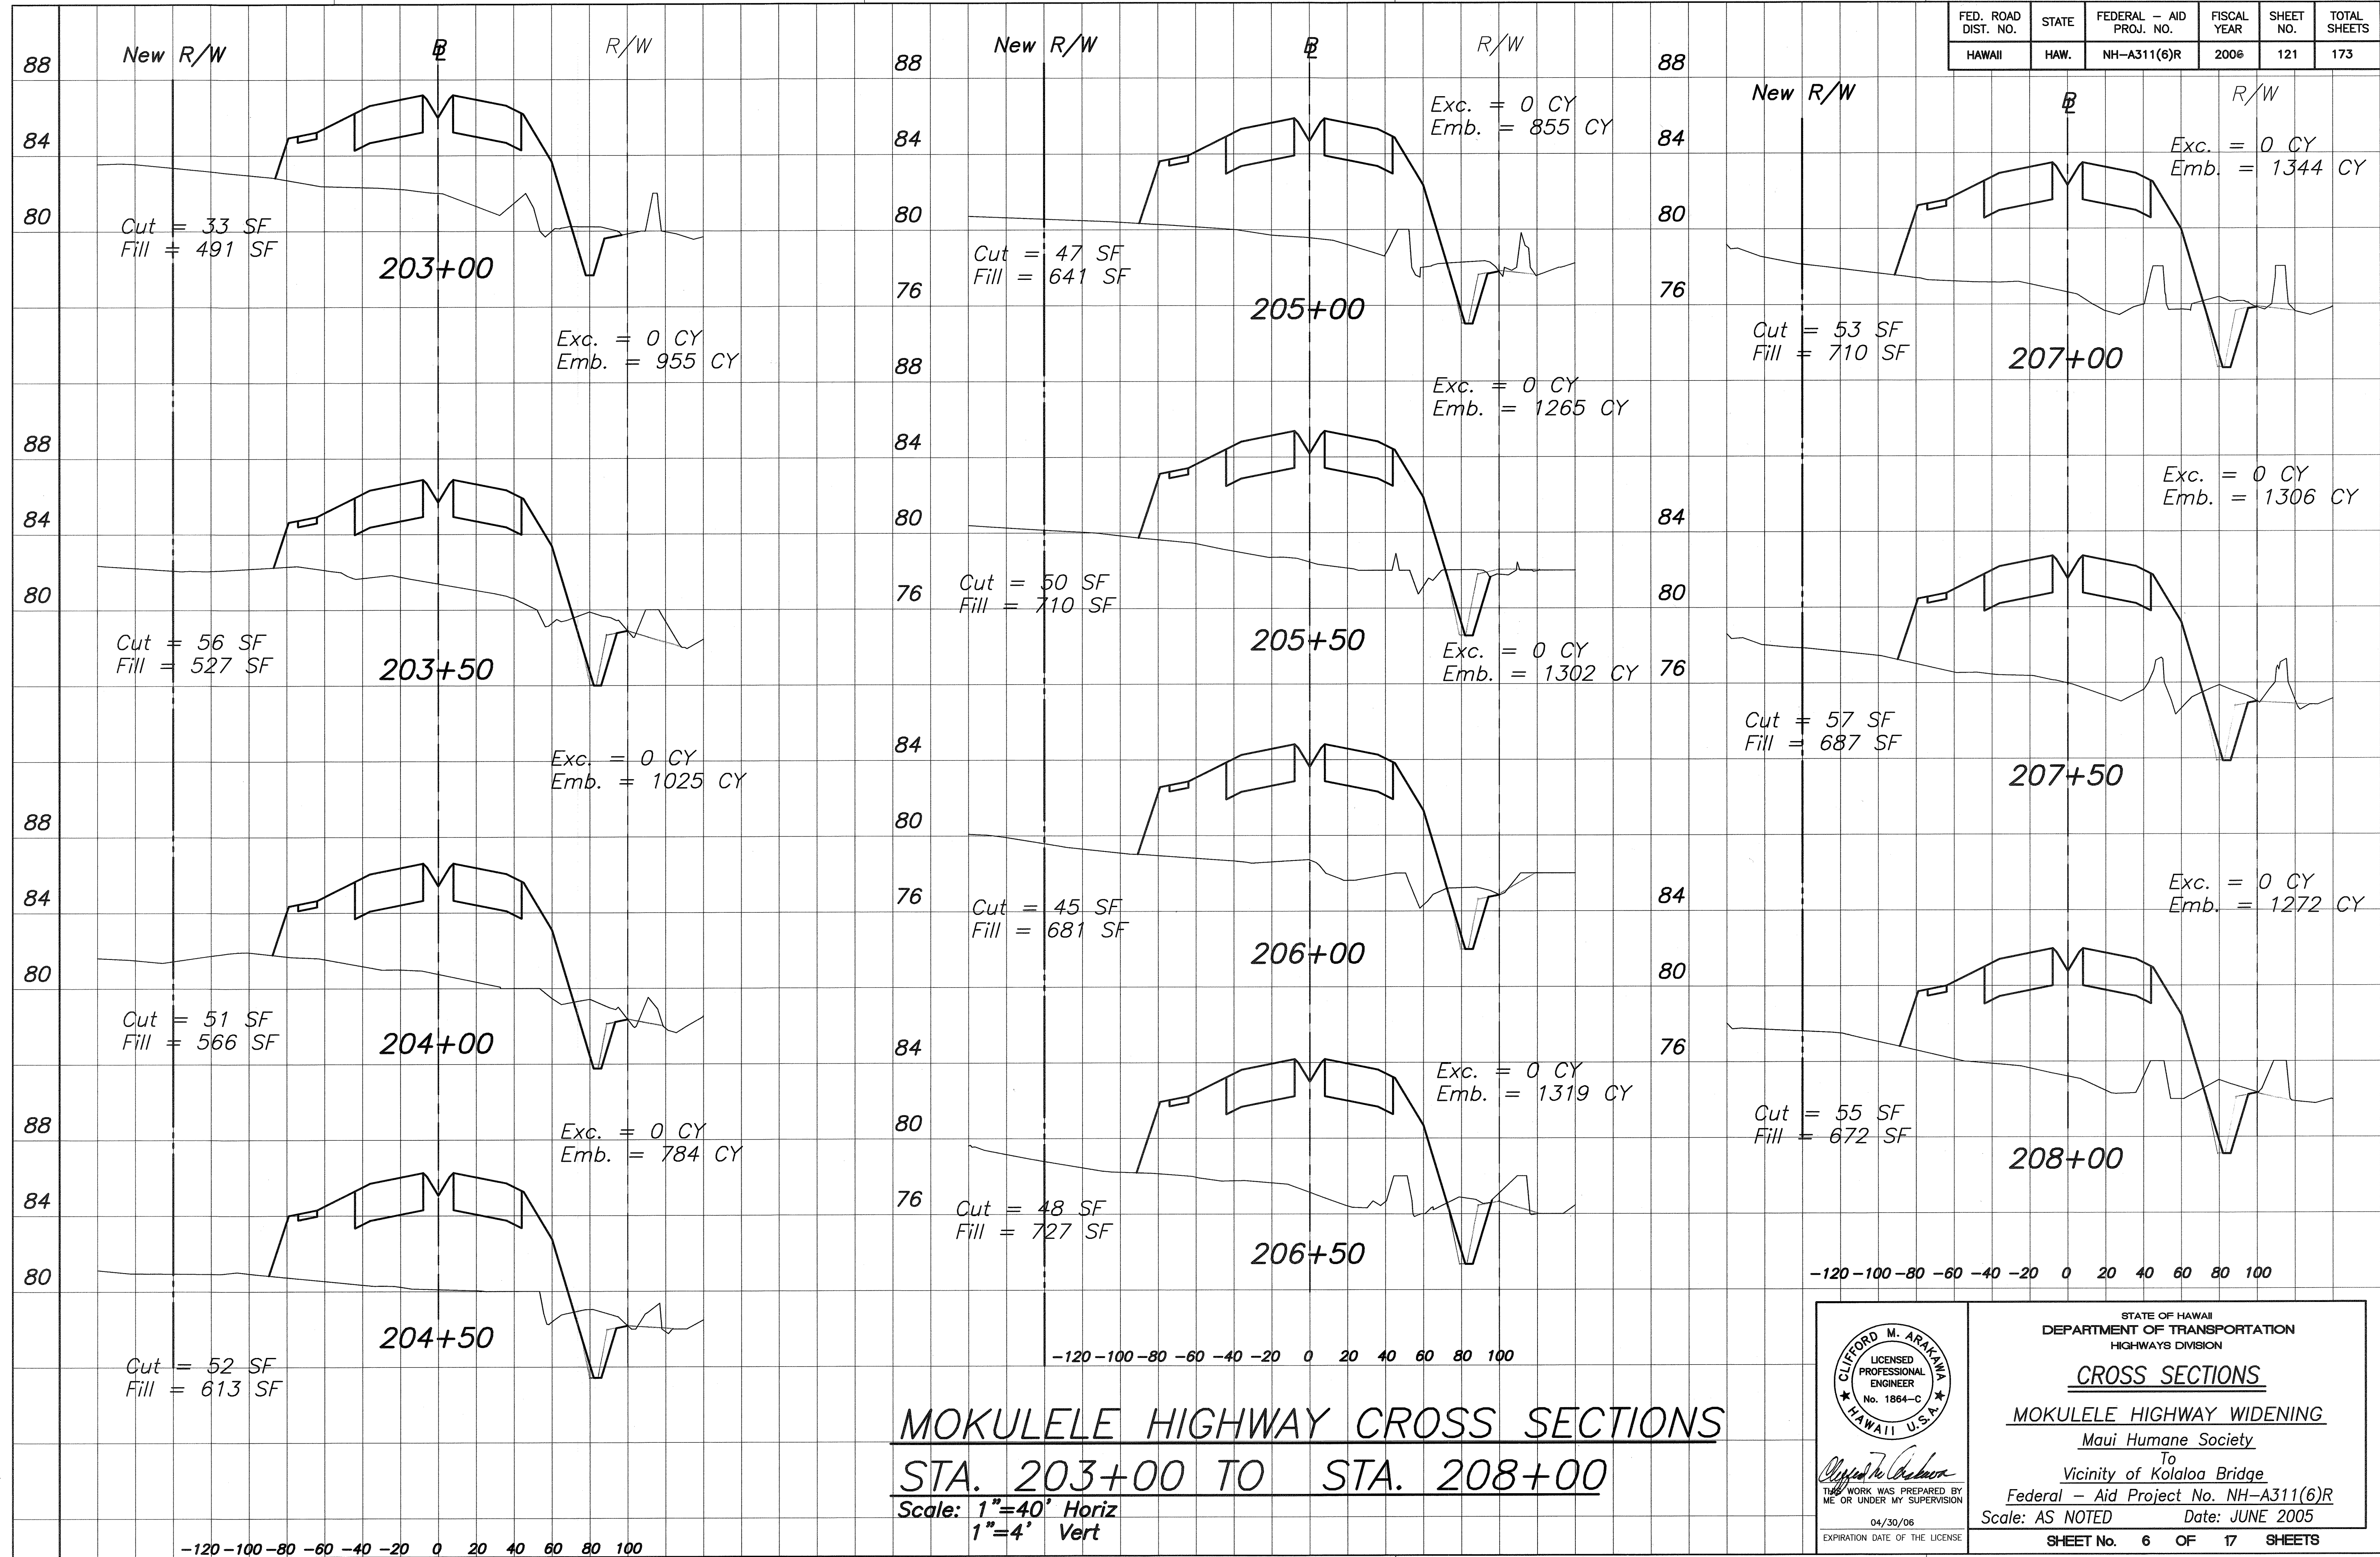

SURVEY PLOTTED BY	DATE
DRIVEN BY	
TRACED BY	
DESIGNED BY	
CHECKED BY	
ORIGINAL PLAN	No.

FED. ROAD DIST. NO.	STATE	FEDERAL - AID PROJ. NO.	FISCAL YEAR	SHEET NO.	TOTAL SHEETS
HAWAII	HAW.	NH-A311(6)R	2006	122	173

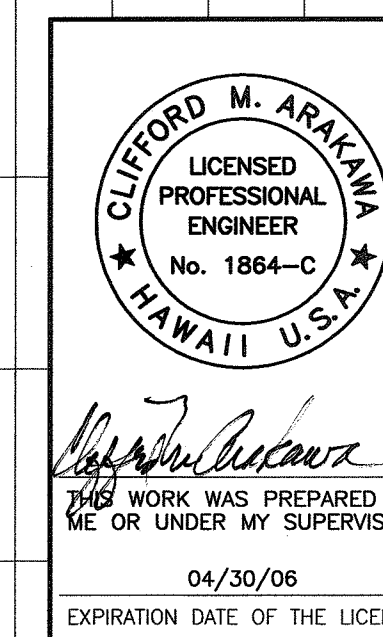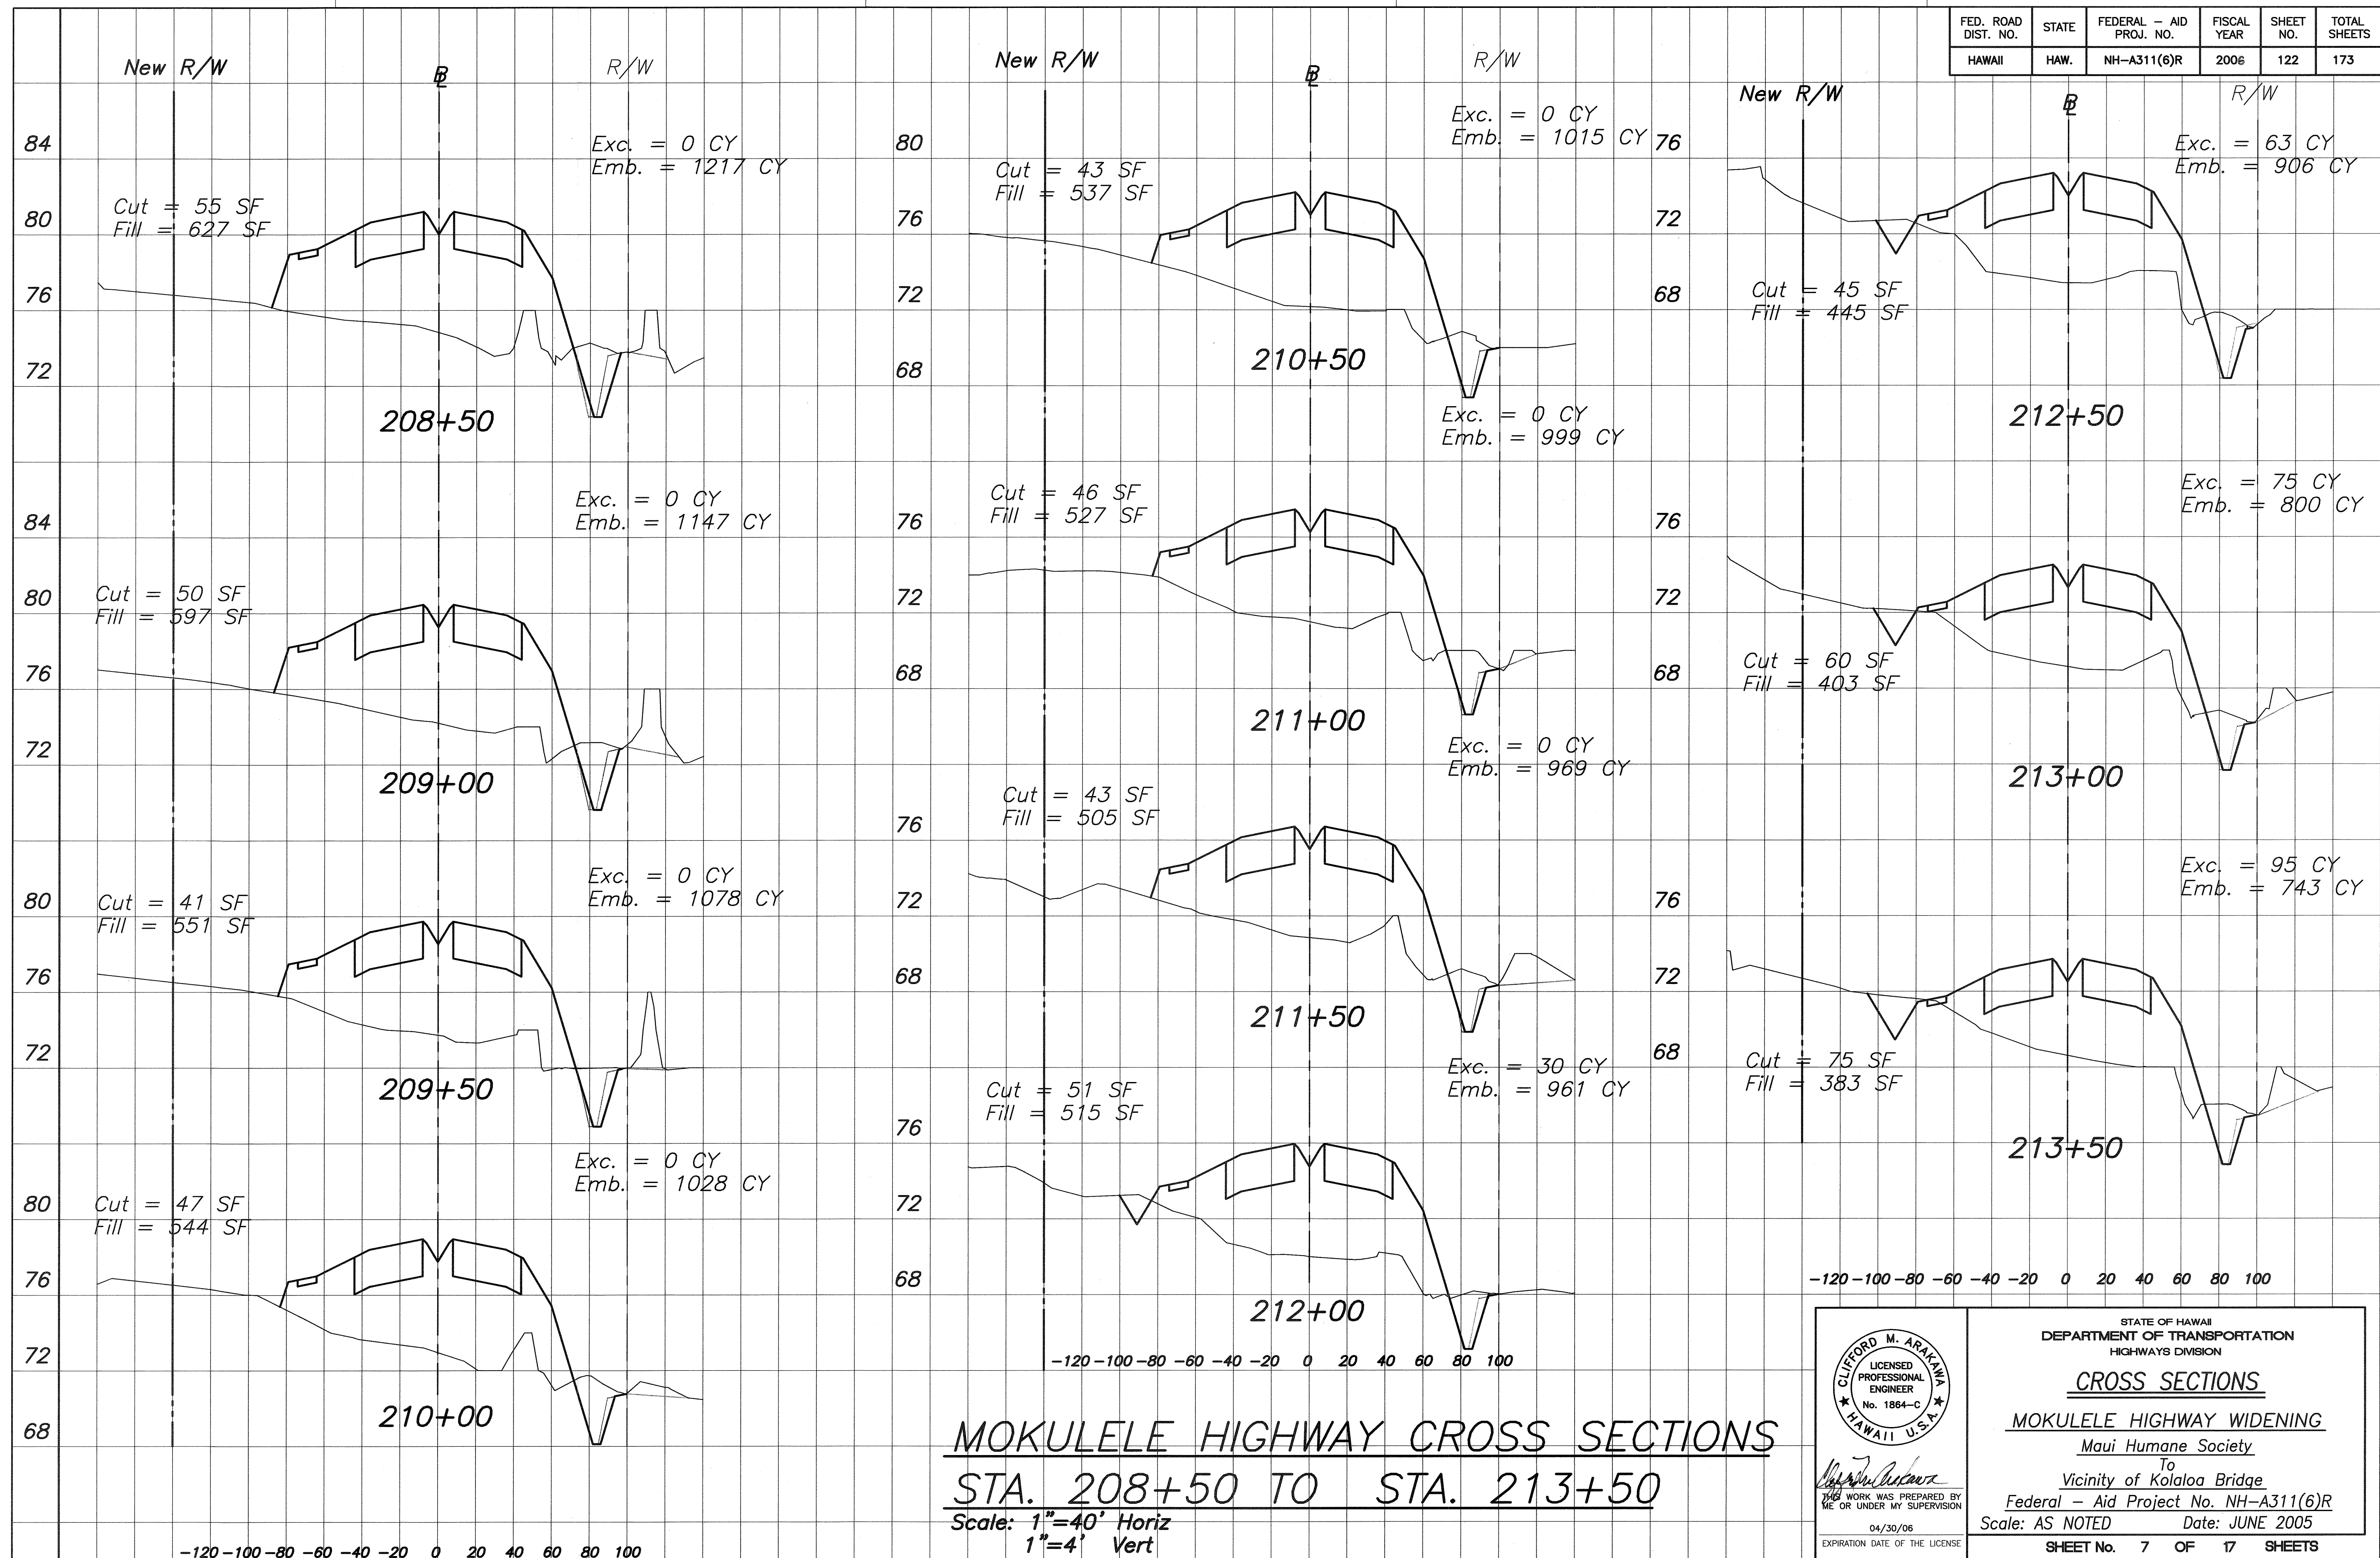



STATE OF HAWAII
 DEPARTMENT OF TRANSPORTATION
 HIGHWAYS DIVISION

CROSS SECTIONS
MOKULELE HIGHWAY WIDENING
 Maui Humane Society
 To
 Vicinity of Kolaloa Bridge
 Federal - Aid Project No. NH-A311(6)R
 Scale: AS NOTED Date: JUNE 2005
 SHEET No. 7 OF 17 SHEETS

"AS-BUILT"

SURVEY PLOTTED BY	DATE
DRAWN BY	
TRACED BY	
QUANTITIES BY	
CHECKED BY	
ORIGINAL PLAN	No.

FED. ROAD DIST. NO.	STATE	FEDERAL - AID PROJ. NO.	FISCAL YEAR	SHEET NO.	TOTAL SHEETS
HAWAII	HAW.	NH-A311(6)R	2006	123	173

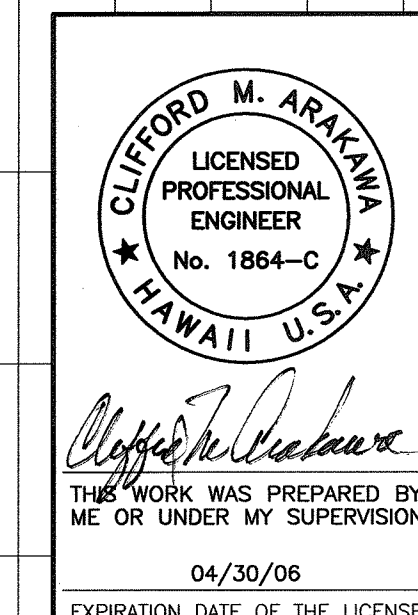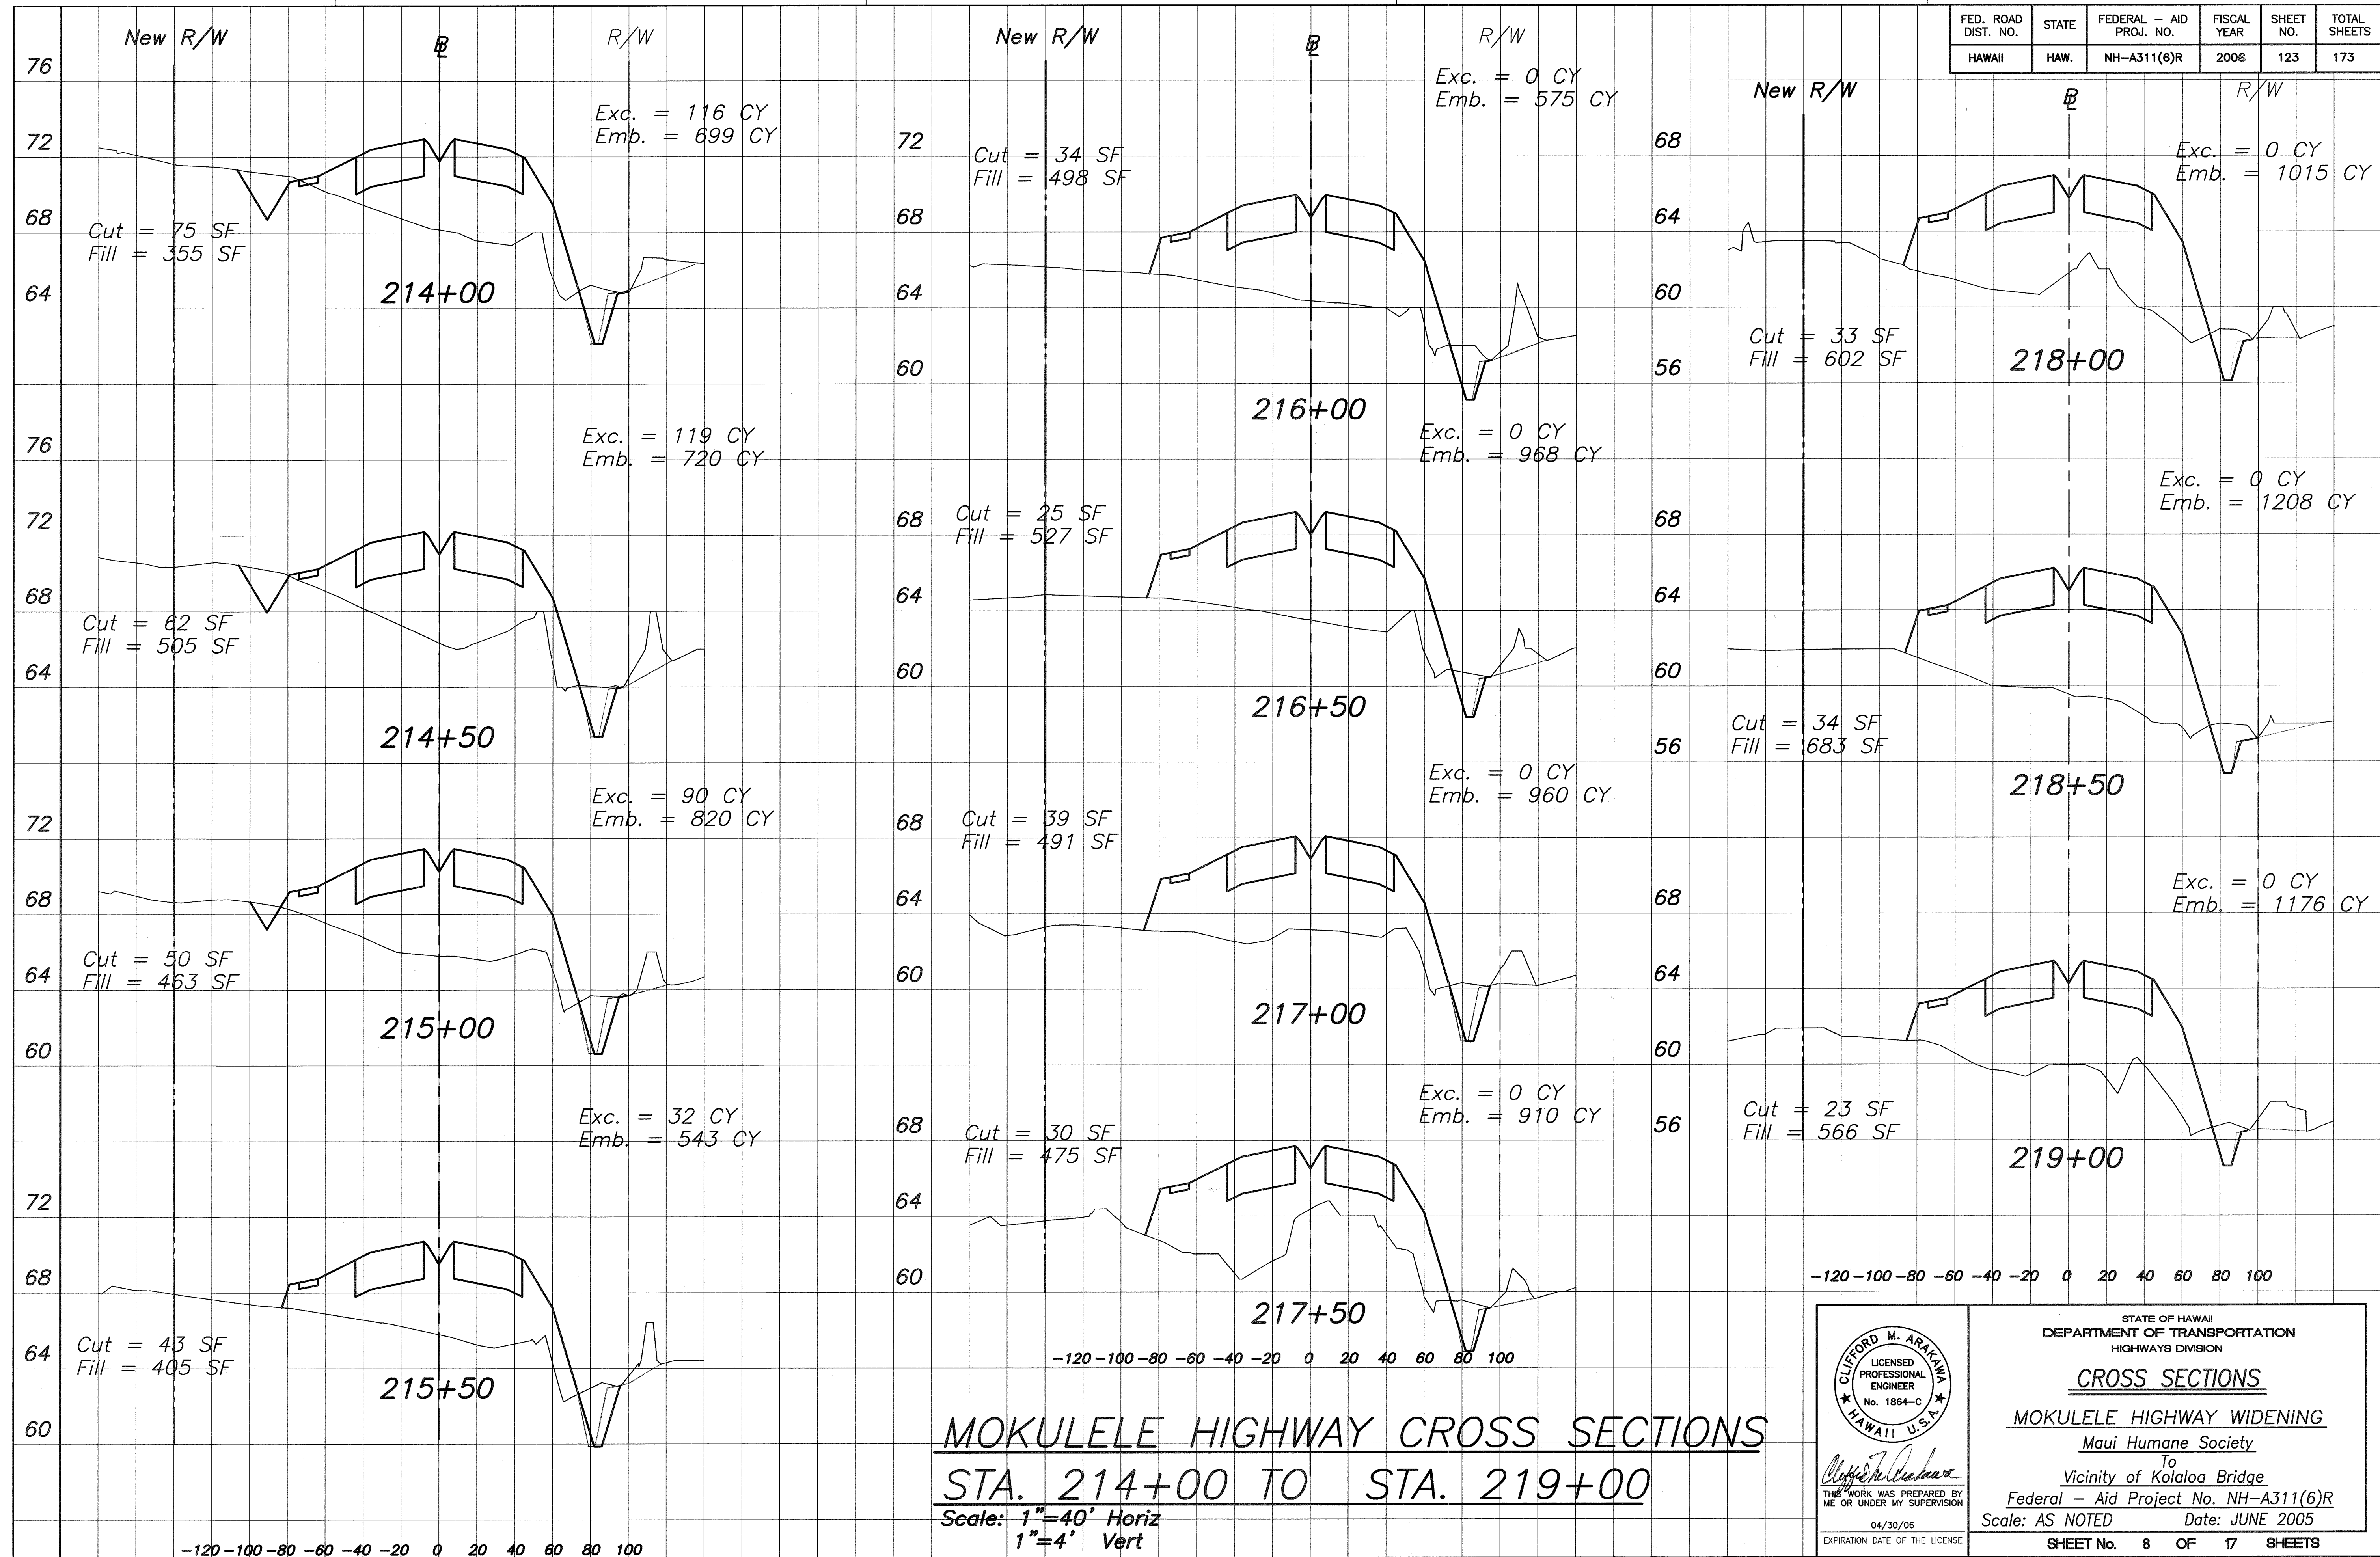

STATE OF HAWAII
DEPARTMENT OF TRANSPORTATION
HIGHWAYS DIVISION

CROSS SECTIONS

MOKULELE HIGHWAY WIDENING

Maui Humane Society

To

Vicinity of Kolaloa Bridge

Federal - Aid Project No. NH-A311(6)R

Scale: AS NOTED


Date: JUNE 2005

SHEET No. 8 OF 17 SHEETS


"AS-BUILT"


SURVEY PLOTTED BY	DATE
DRAWN BY	
TRACED BY	
DESIGNED BY	
CHECKED BY	
ORIGINAL PLAN	No.
NOTE BOOK	

ORIGINAL PLAN	SURVEY PLOTTED BY	DATE
	DRAWN BY	
	DESIGNED BY	
	NOTED BY	
	CHECKED BY	
NOTE BOOK	NO.	

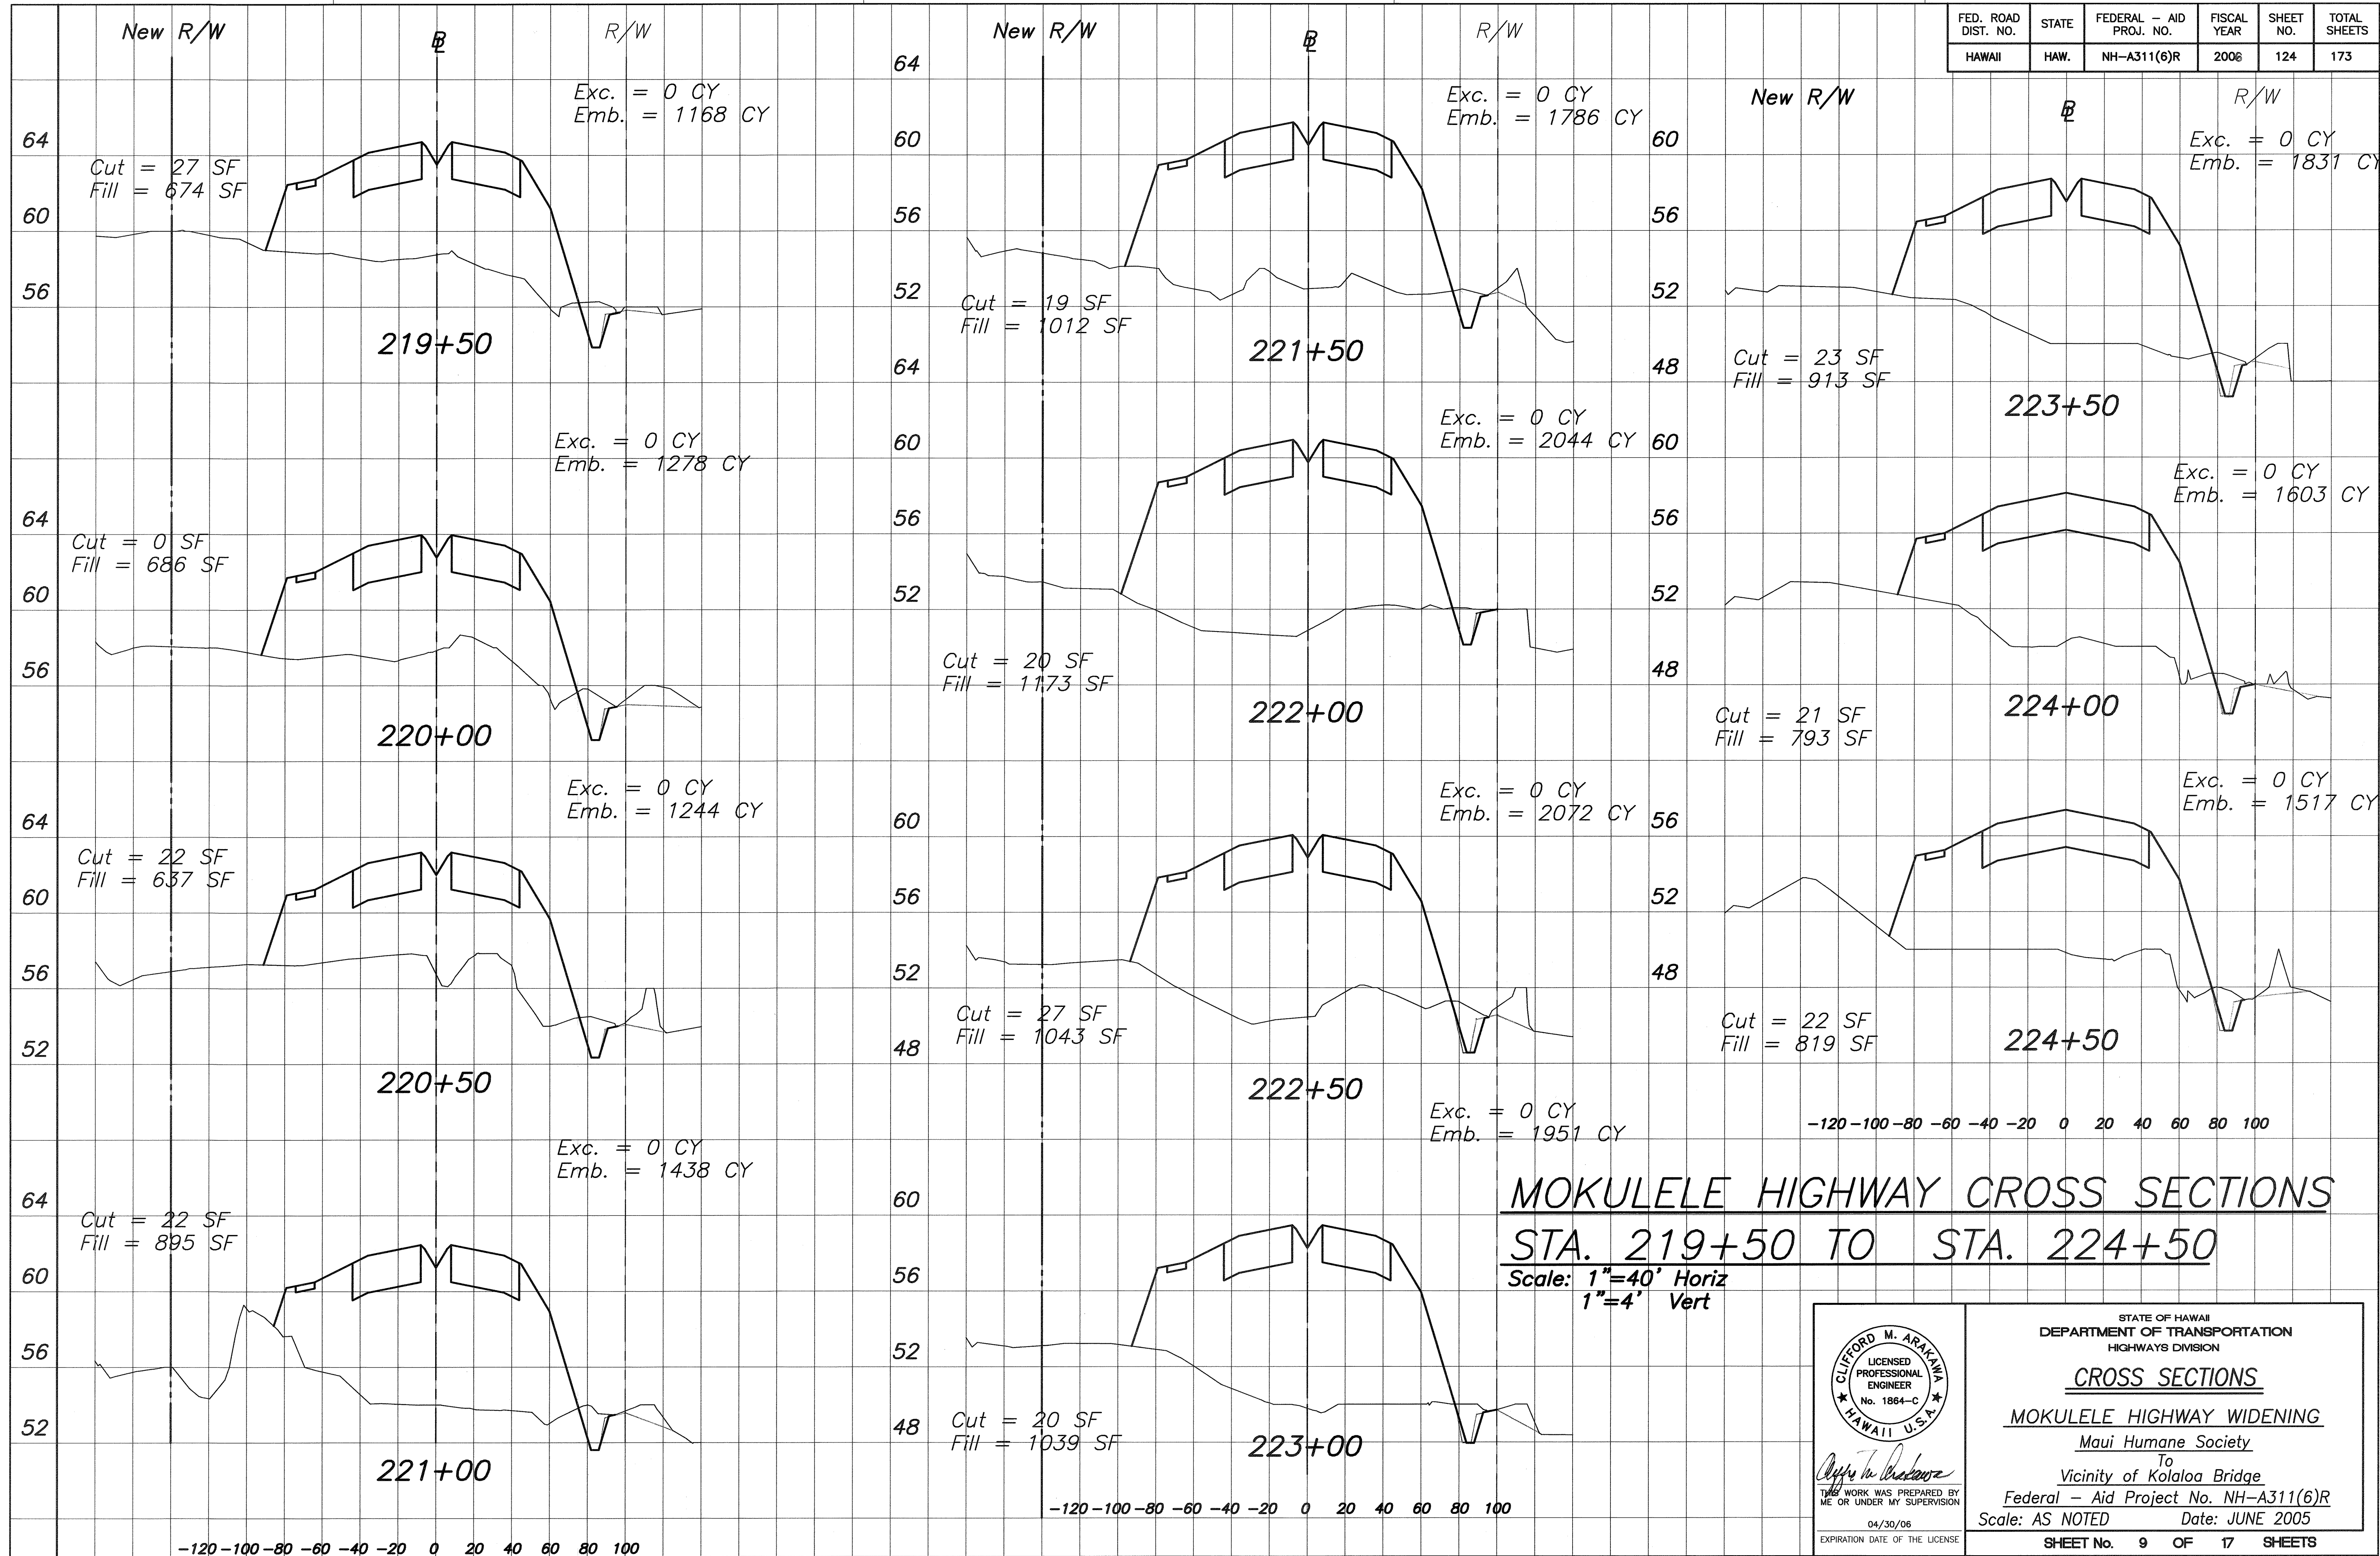

ORIGINAL PLAN	SURVEY PLOTTED BY	DATE
	DRAWN BY	
	DESIGNED BY	
	CHECKED BY	
NOTE BOOK	NO. _____	
	QUANTITIES BY	
	CHECKED BY	

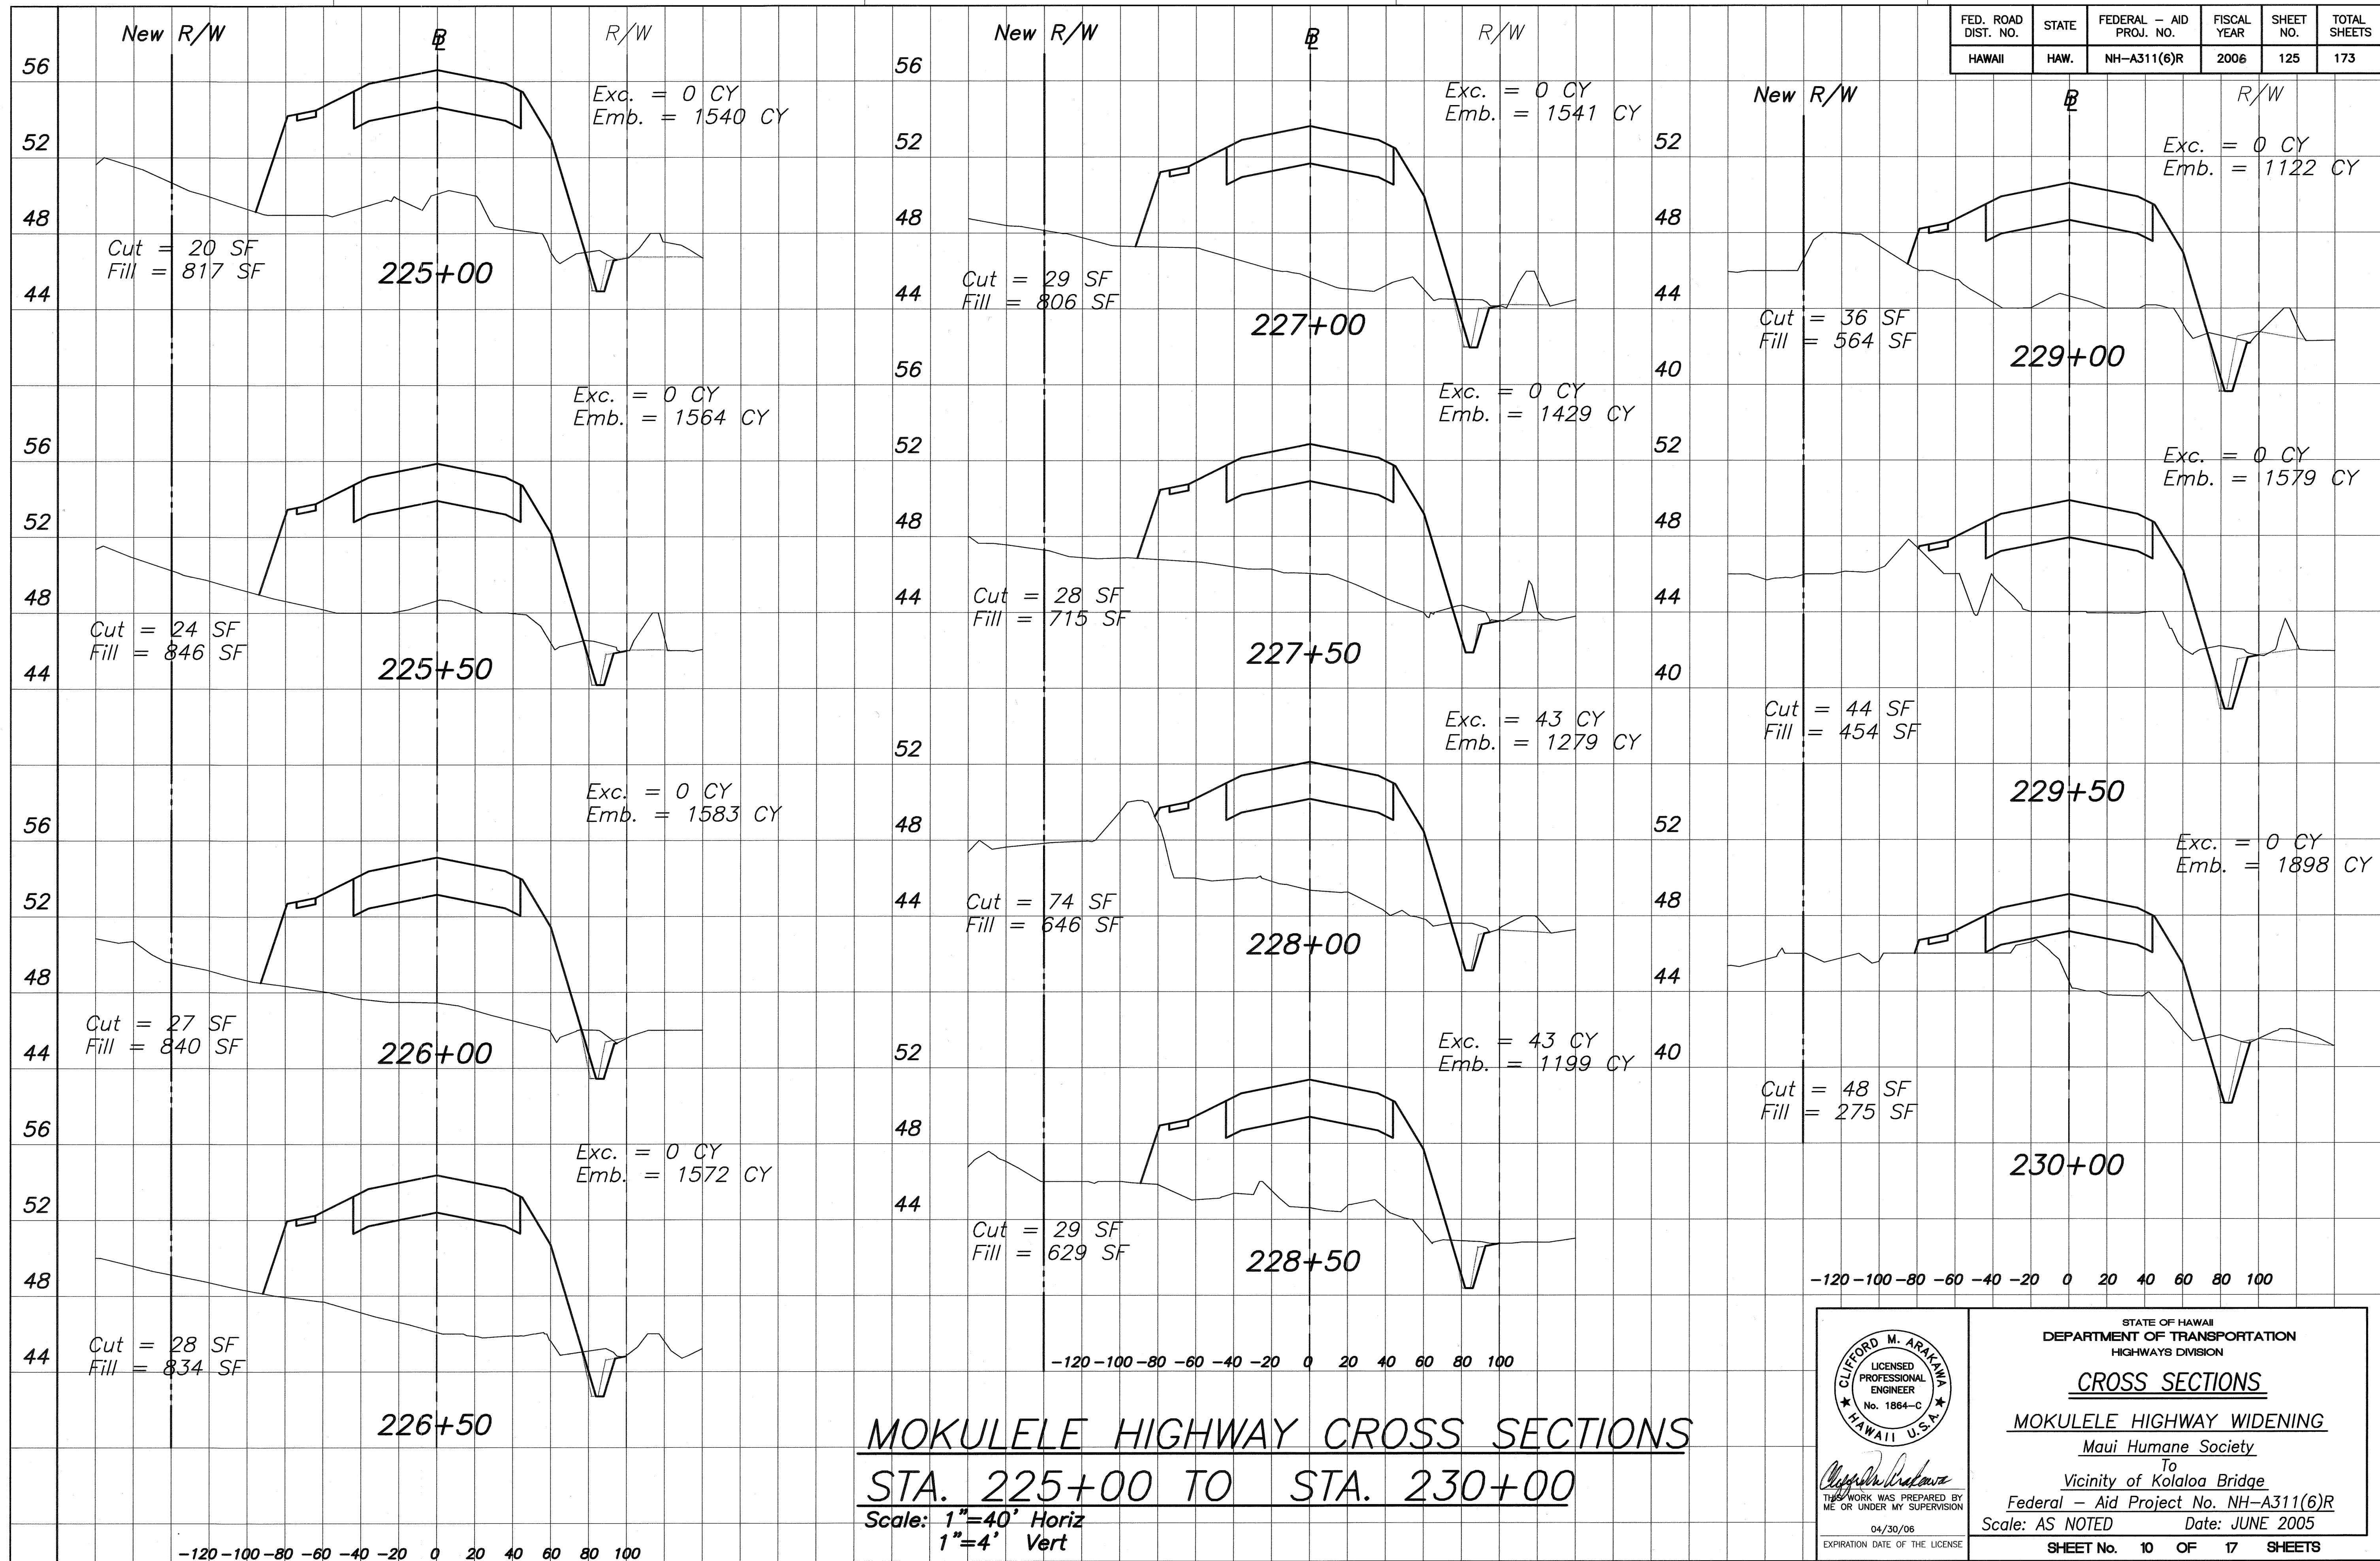

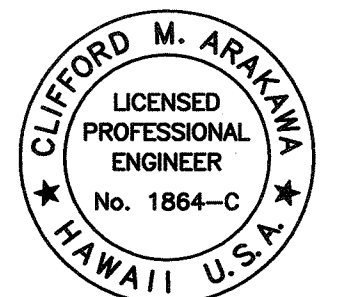



THIS WORK WAS PREPARED BY ME OR UNDER MY SUPERVISION
 04/30/06
 EXPIRATION DATE OF THE LICENSE

STATE OF HAWAII
 DEPARTMENT OF TRANSPORTATION
 HIGHWAYS DIVISION

CROSS SECTIONS
 MOKULELE HIGHWAY WIDENING
 Maui Humane Society
 To
 Vicinity of Kolaloa Bridge
 Federal - Aid Project No. NH-A311(6)R
 Scale: AS NOTED Date: JUNE 2005

SHEET No. 10 OF 17 SHEETS

FED. ROAD DIST. NO.	STATE	FEDERAL - AID PROJ. NO.	FISCAL YEAR	SHEET NO.	TOTAL SHEETS
HAWAII	HAW.	NH-A311(6)R	2006	126	173

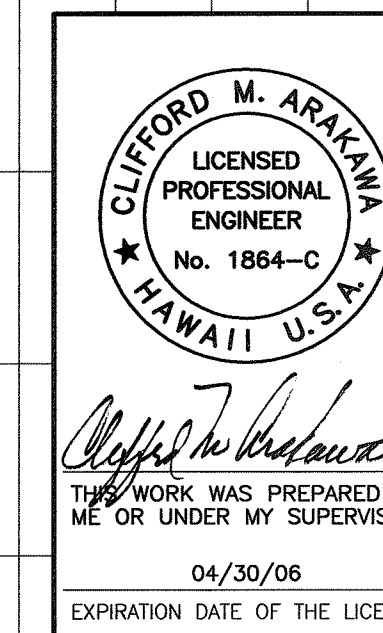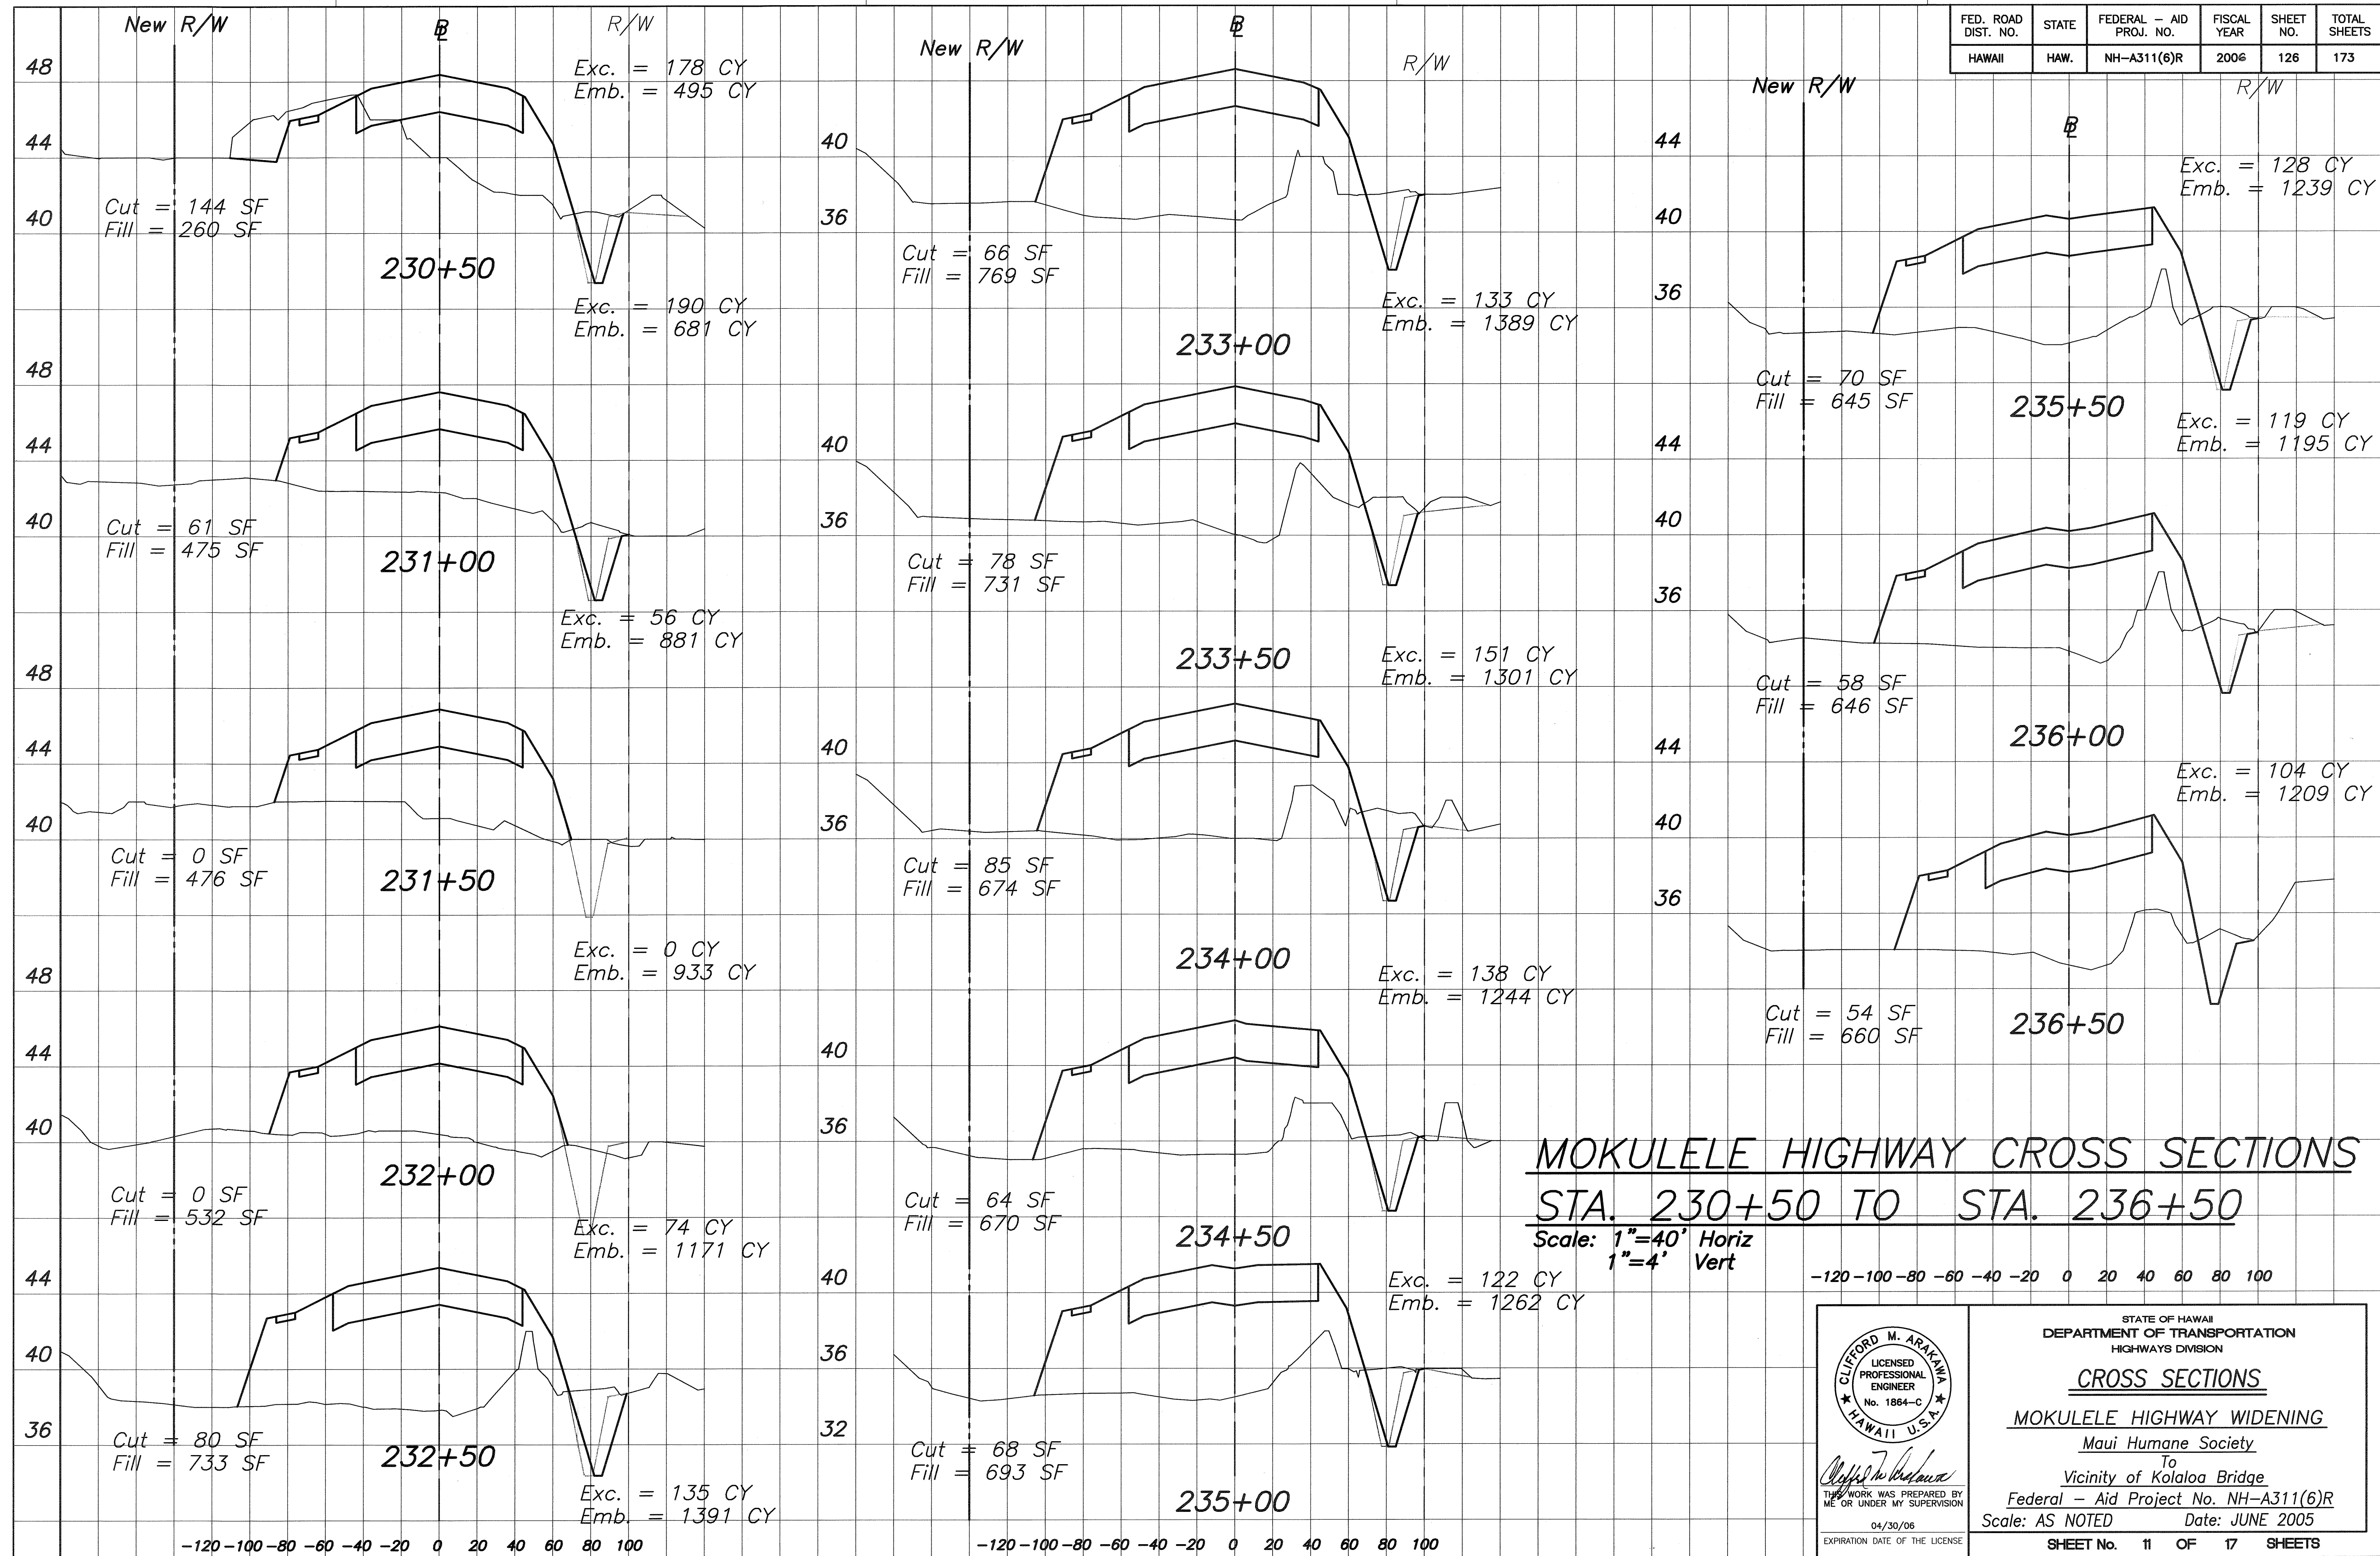

STATE OF HAWAII
 DEPARTMENT OF TRANSPORTATION
 HIGHWAYS DIVISION

CROSS SECTIONS

MOKULELE HIGHWAY WIDENING
 Maui Humane Society
 To
 Vicinity of Kolaloa Bridge
 Federal - Aid Project No. NH-A311(6)R


Scale: AS NOTED Date: JUNE 2005

SHEET No. 11 OF 17 SHEETS


"AC-BUILT"

SURVEY PLOTTED BY	DATE
DRAWN BY	
TRACED BY	
DESIGNED BY	
CHECKED BY	
ORIGINAL PLAN	No.
NOTE BOOK	


ORIGINAL PLAN	SURVEY PLOTTED BY	DATE
	DRAWN BY	
	NOTED BY	
	CHECKED BY	
NOTE BOOK		
No.		

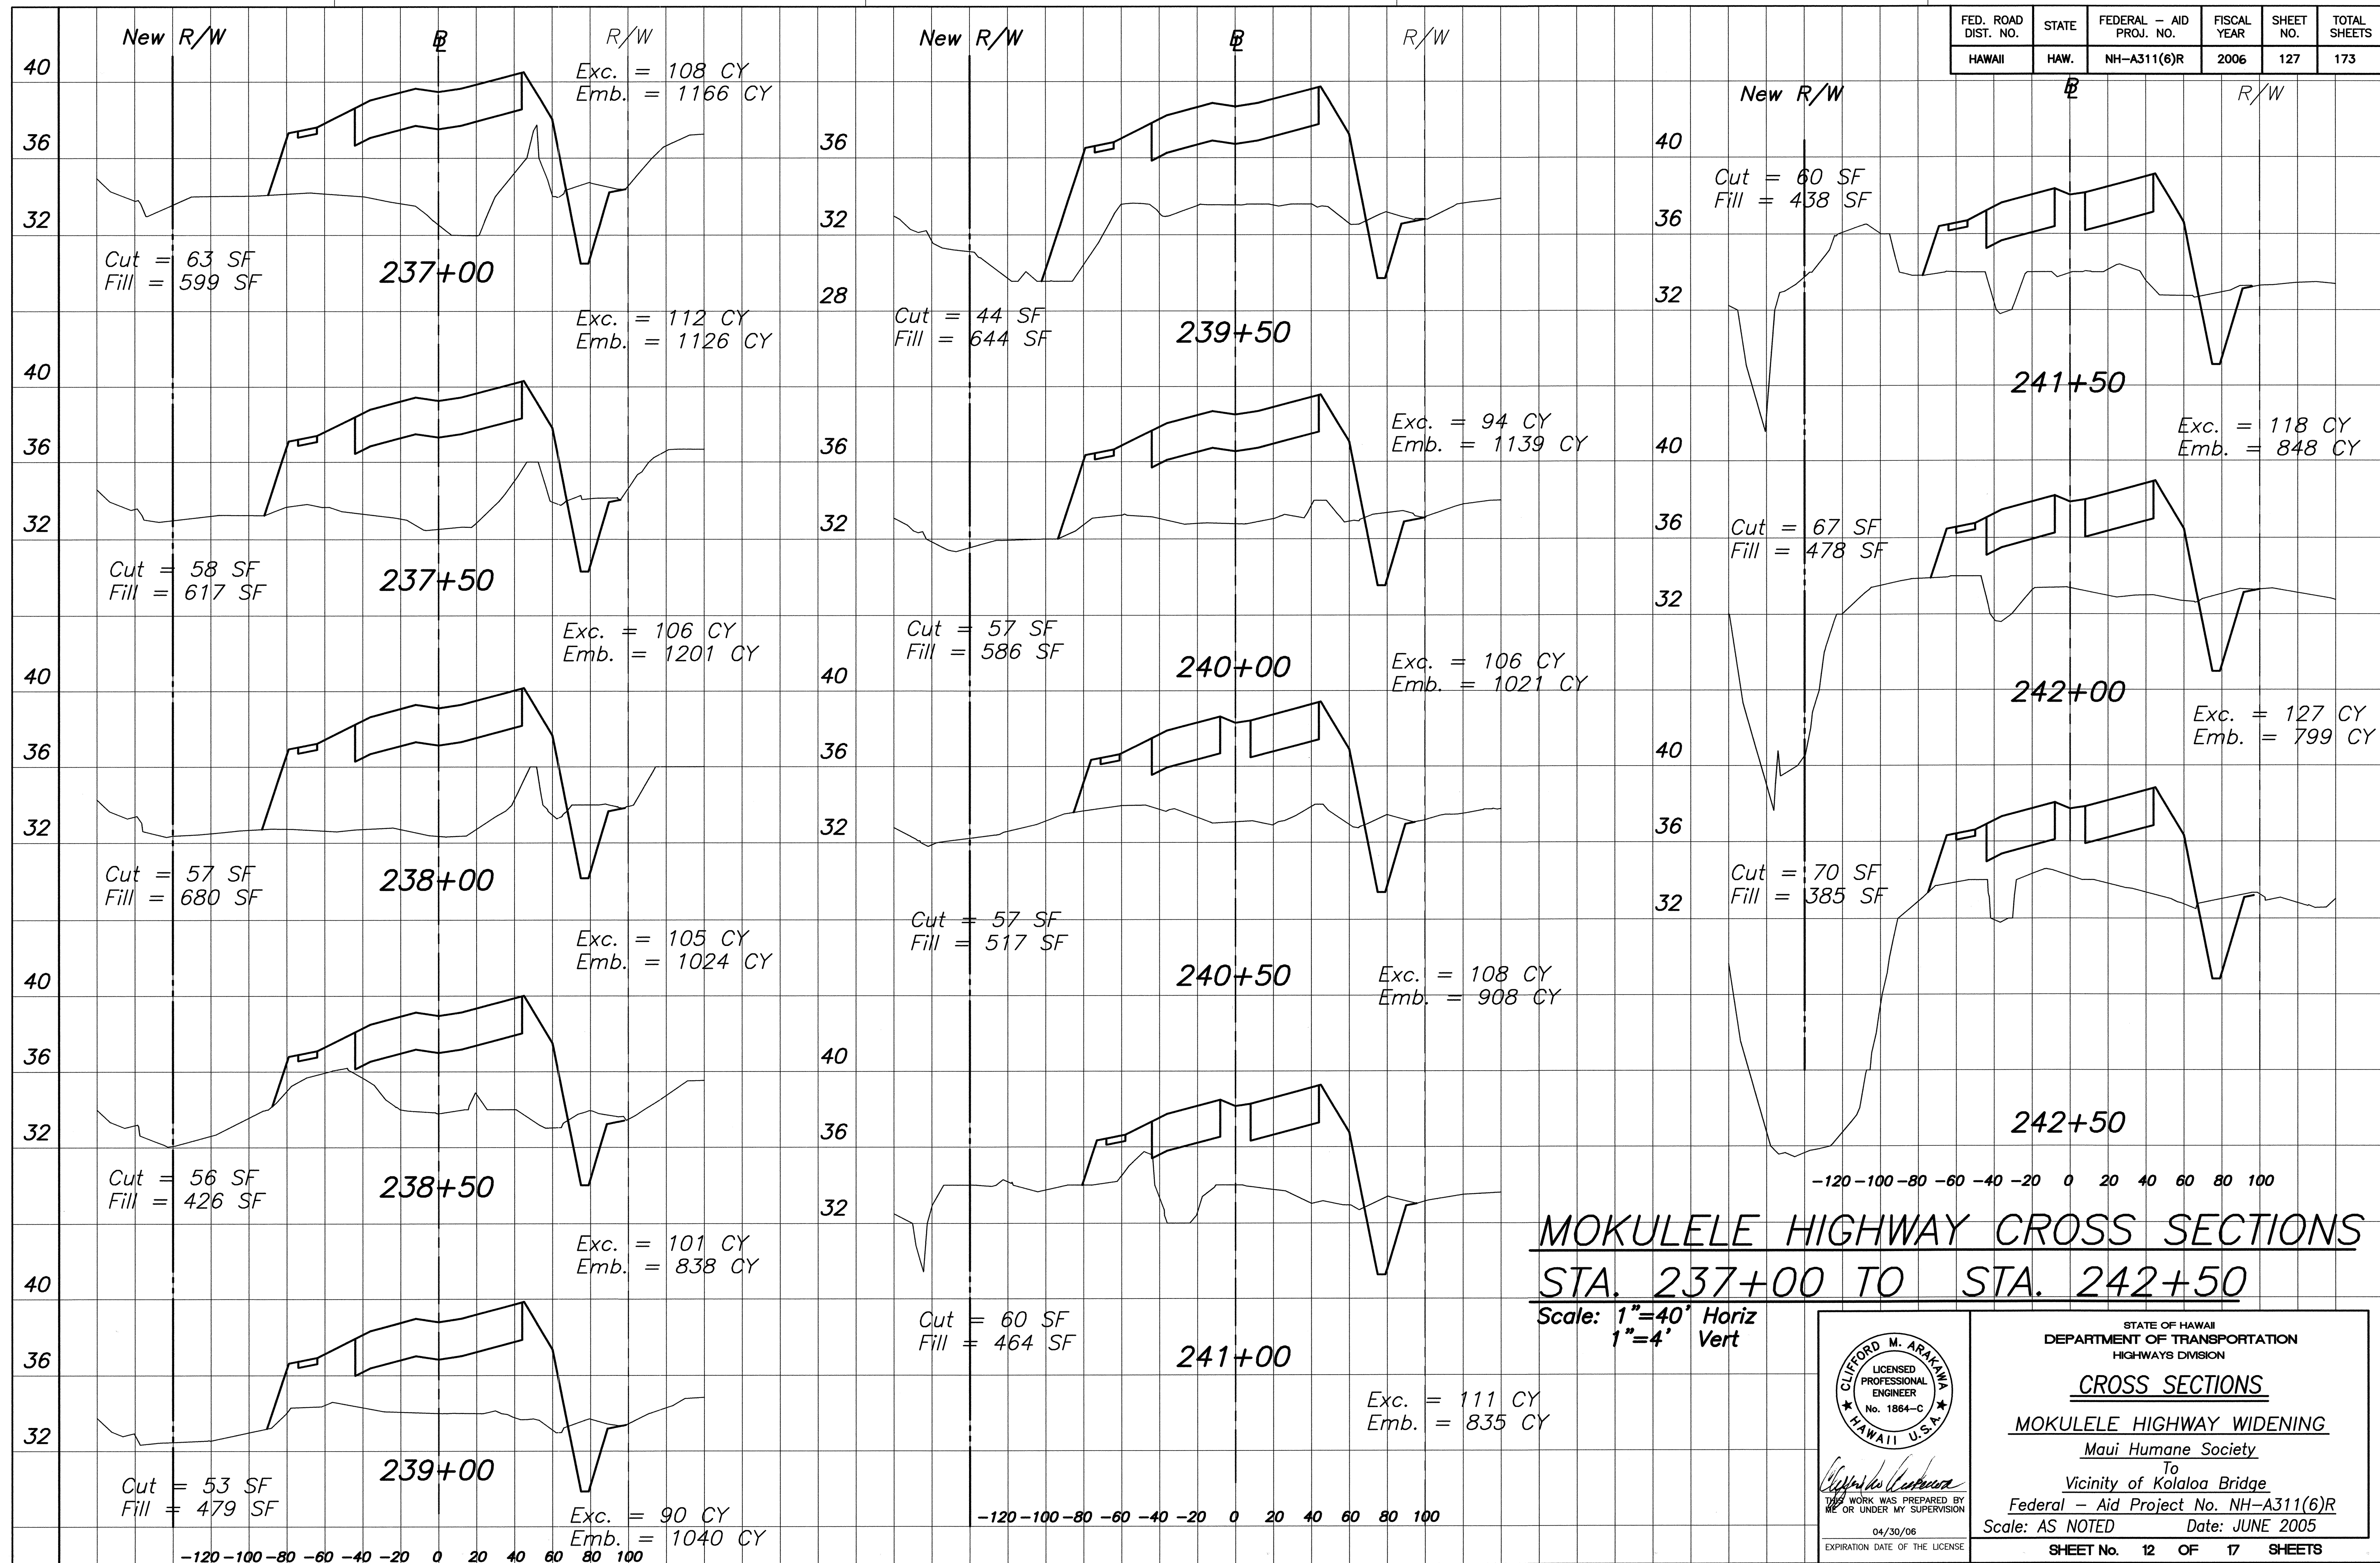

SURVEY PLOTTED BY	DATE
DRAWN BY	
DESIGNED BY	
CHECKED BY	
ORIGINAL PLAN	
NOTE BOOK	
No.	

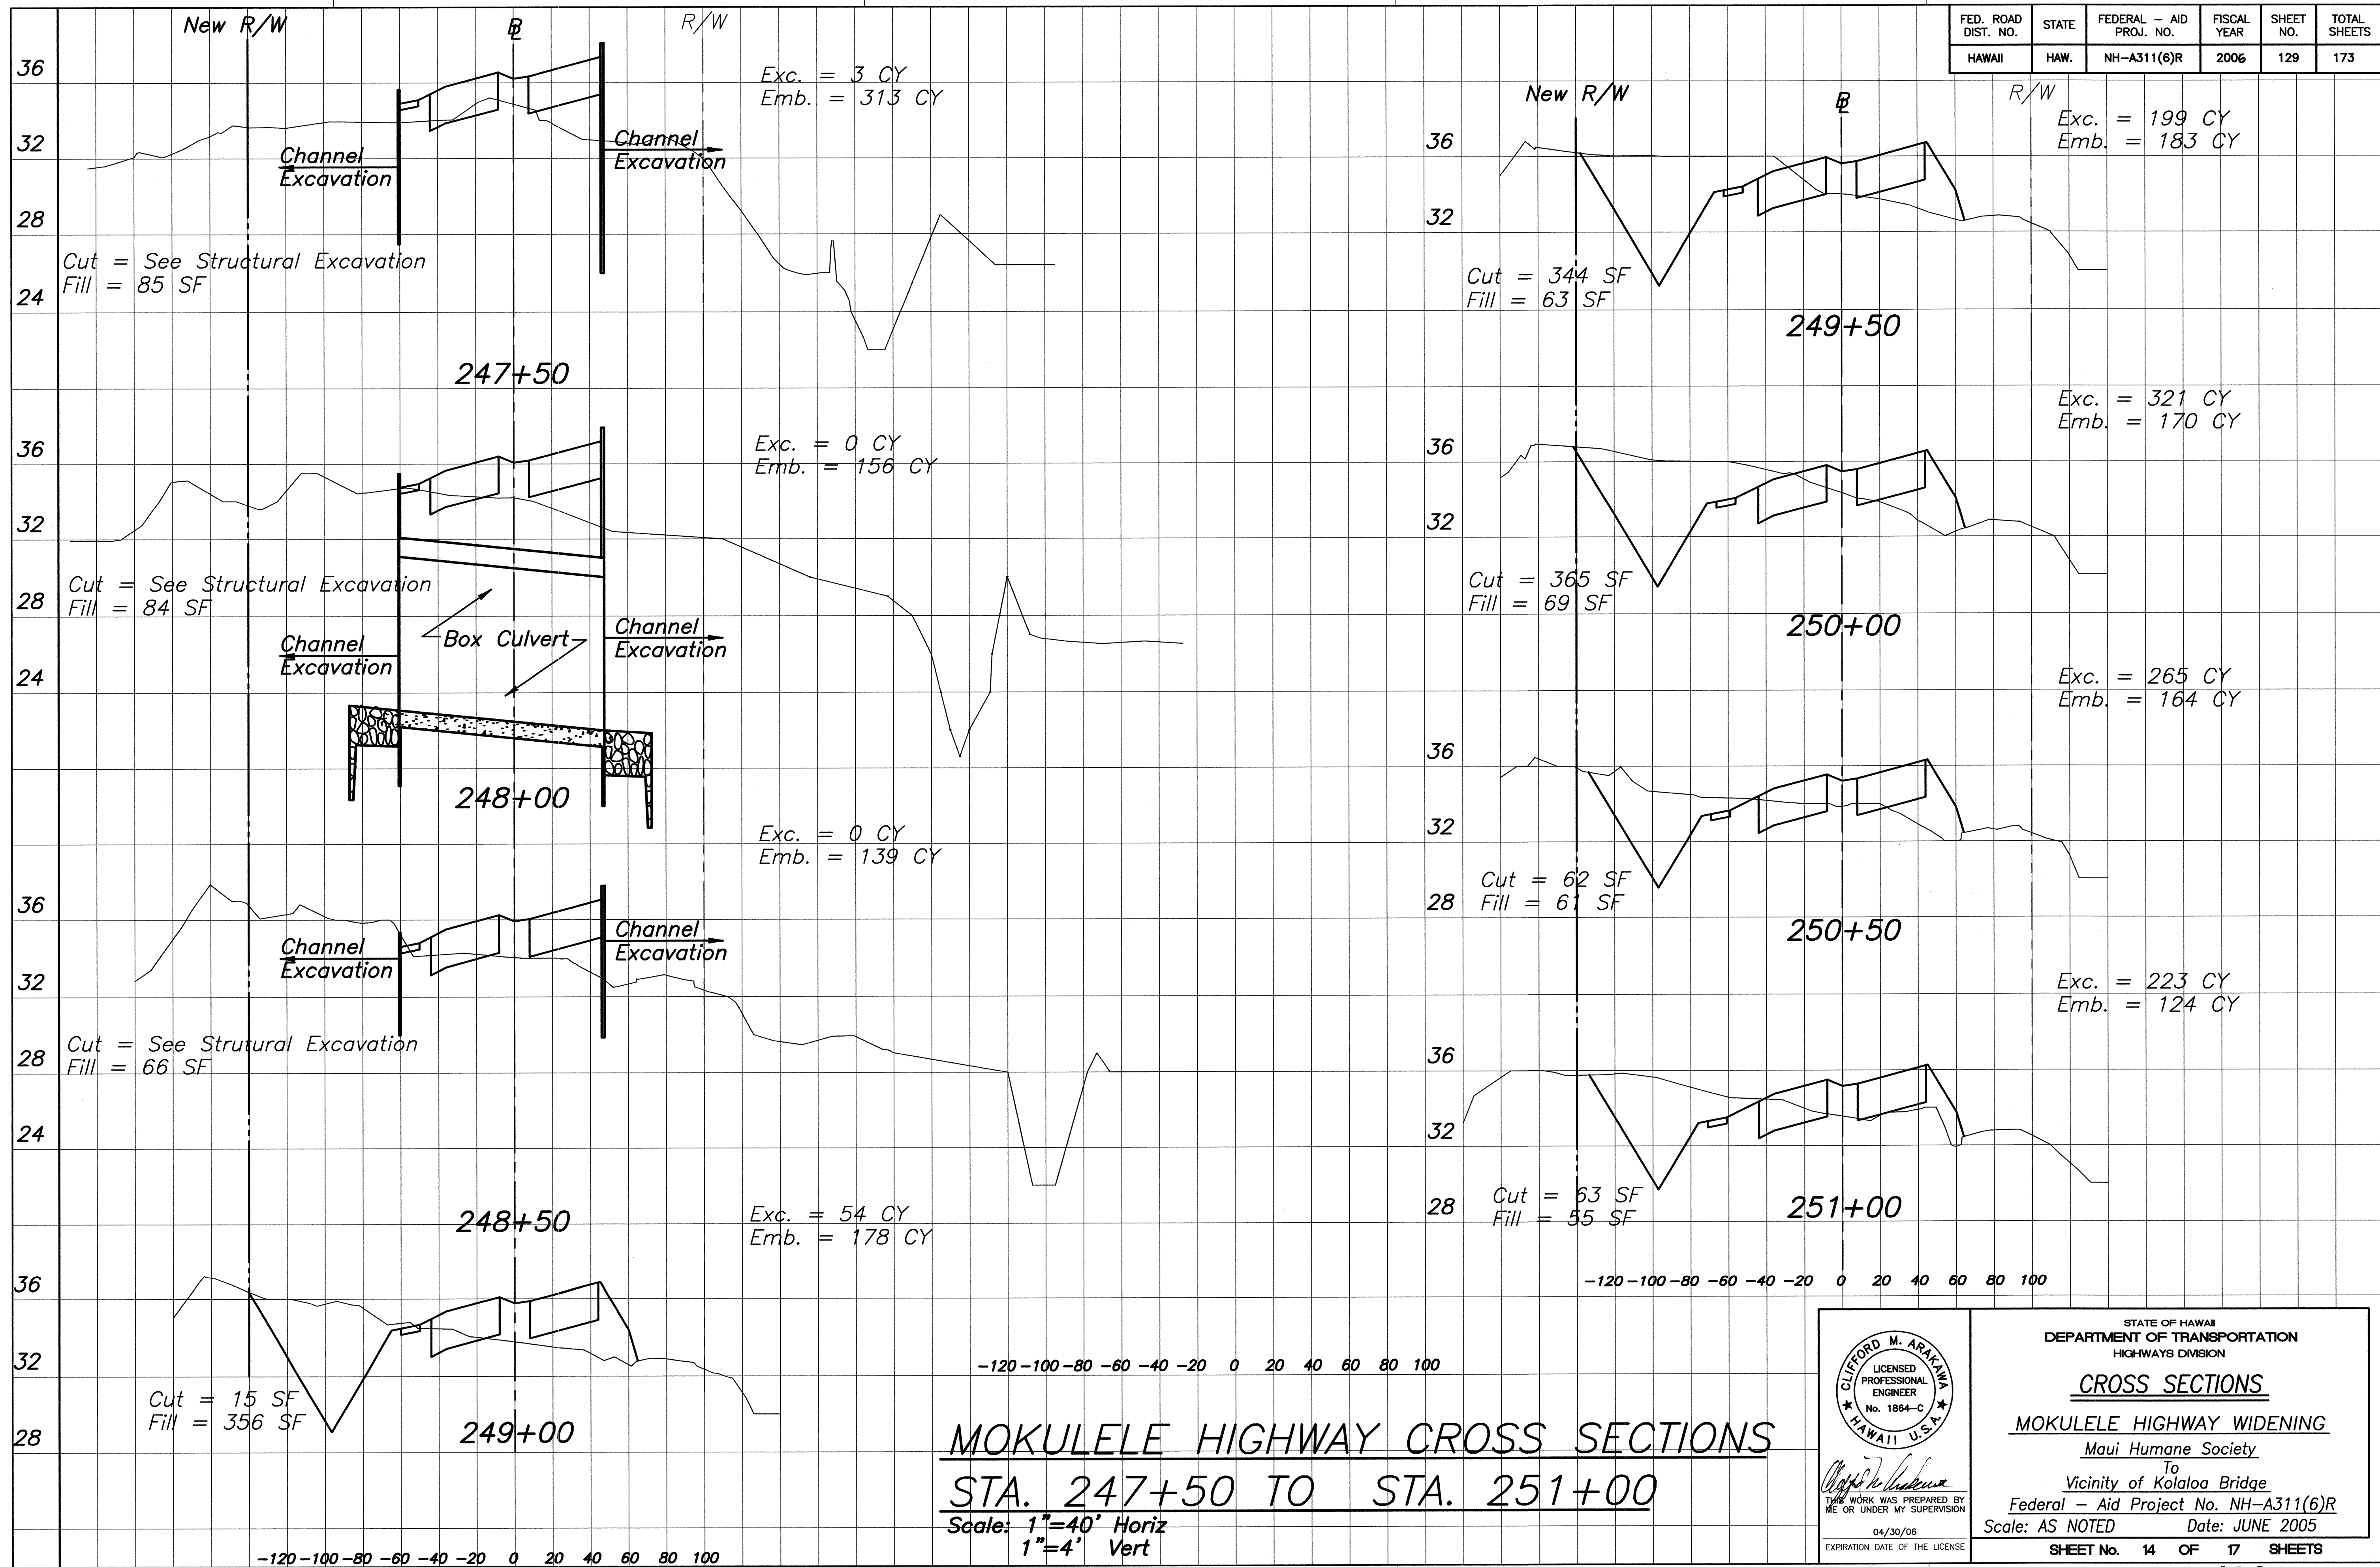

FED. ROAD DIST. NO.	STATE	FEDERAL - AID PROJ. NO.	FISCAL YEAR	SHEET NO.	TOTAL SHEETS
HAWAII	HAW.	NH-A311(6)R	2006	130	173

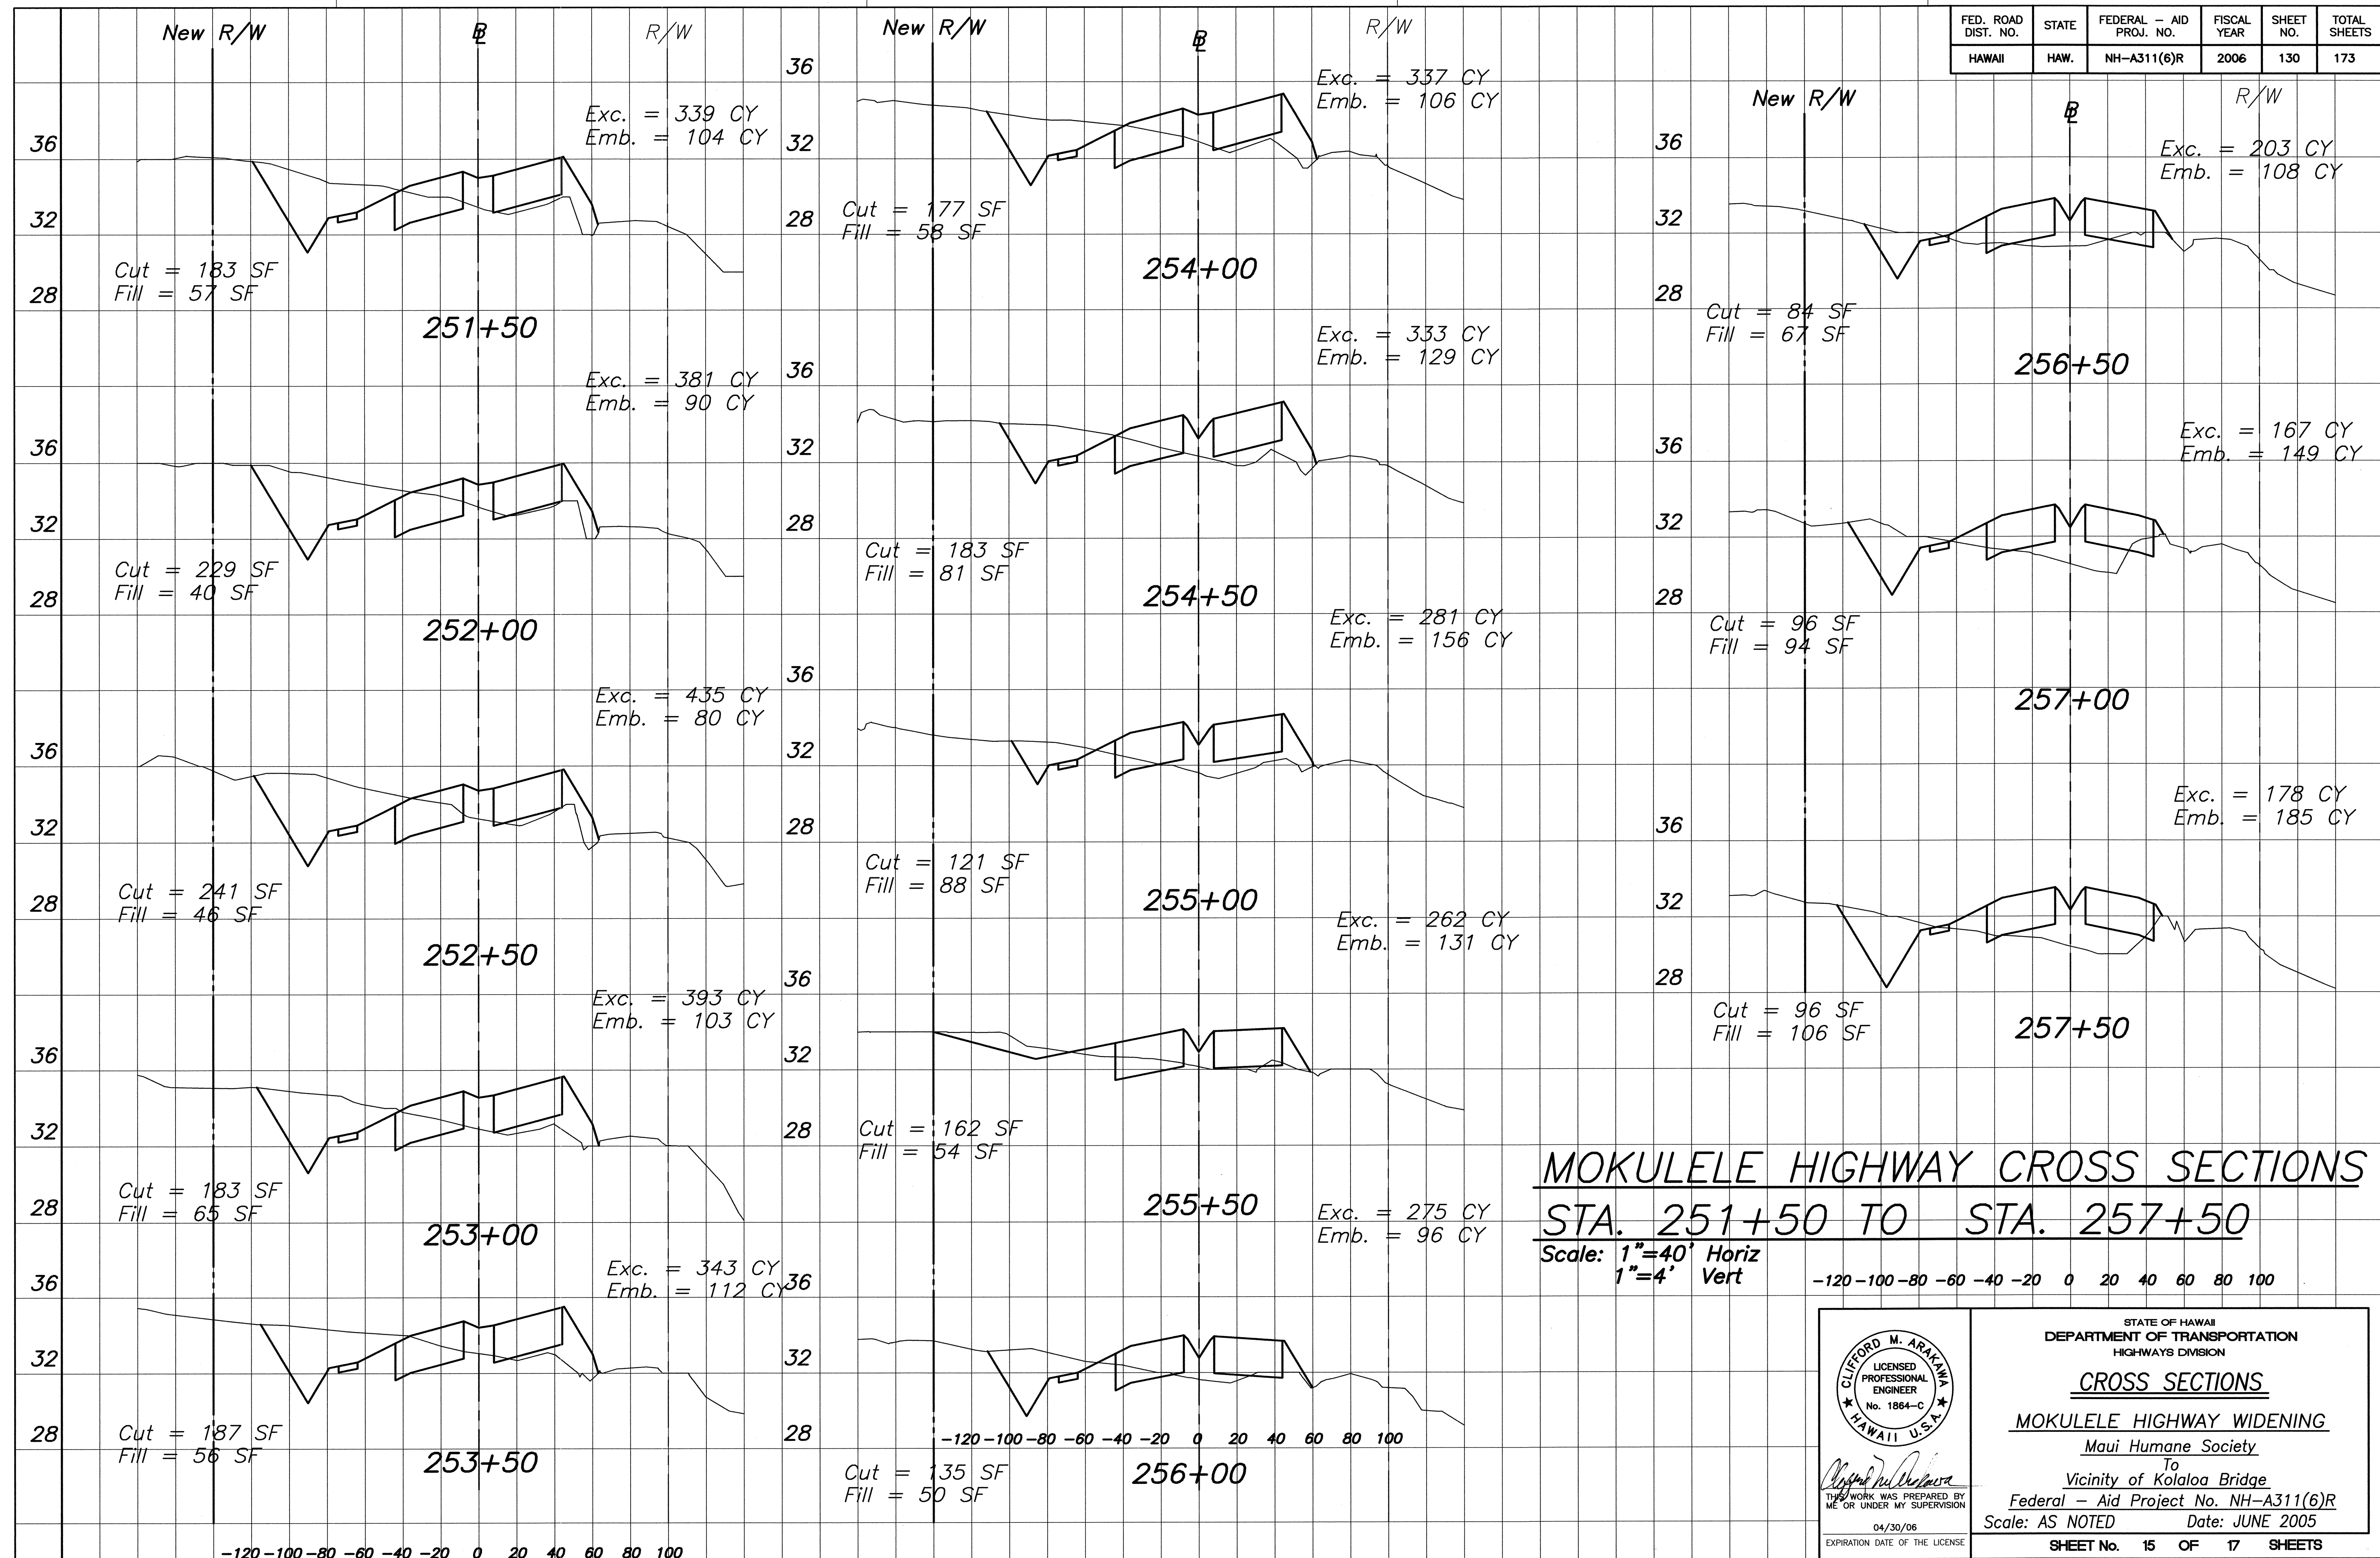

CLIFFORD M. ARAKAWA
 LICENSED PROFESSIONAL ENGINEER
 No. 1864-C
 HAWAII U.S.A.

THE WORK WAS PREPARED BY ME OR UNDER MY SUPERVISION
 04/30/06
 EXPIRATION DATE OF THE LICENSE

STATE OF HAWAII
 DEPARTMENT OF TRANSPORTATION
 HIGHWAYS DIVISION


CROSS SECTIONS

MOKULELE HIGHWAY WIDENING

Maui Humane Society
 To
 Vicinity of Kolaloa Bridge
 Federal - Aid Project No. NH-A311(6)R
 Scale: AS NOTED Date: JUNE 2005

SHEET No. 15 OF 17 SHEETS

FED. ROAD DIST. NO.	STATE	FEDERAL - AID PROJ. NO.	FISCAL YEAR	SHEET NO.	TOTAL SHEETS
HAWAII	HAW.	NH-A311(6)R	2006	131	173

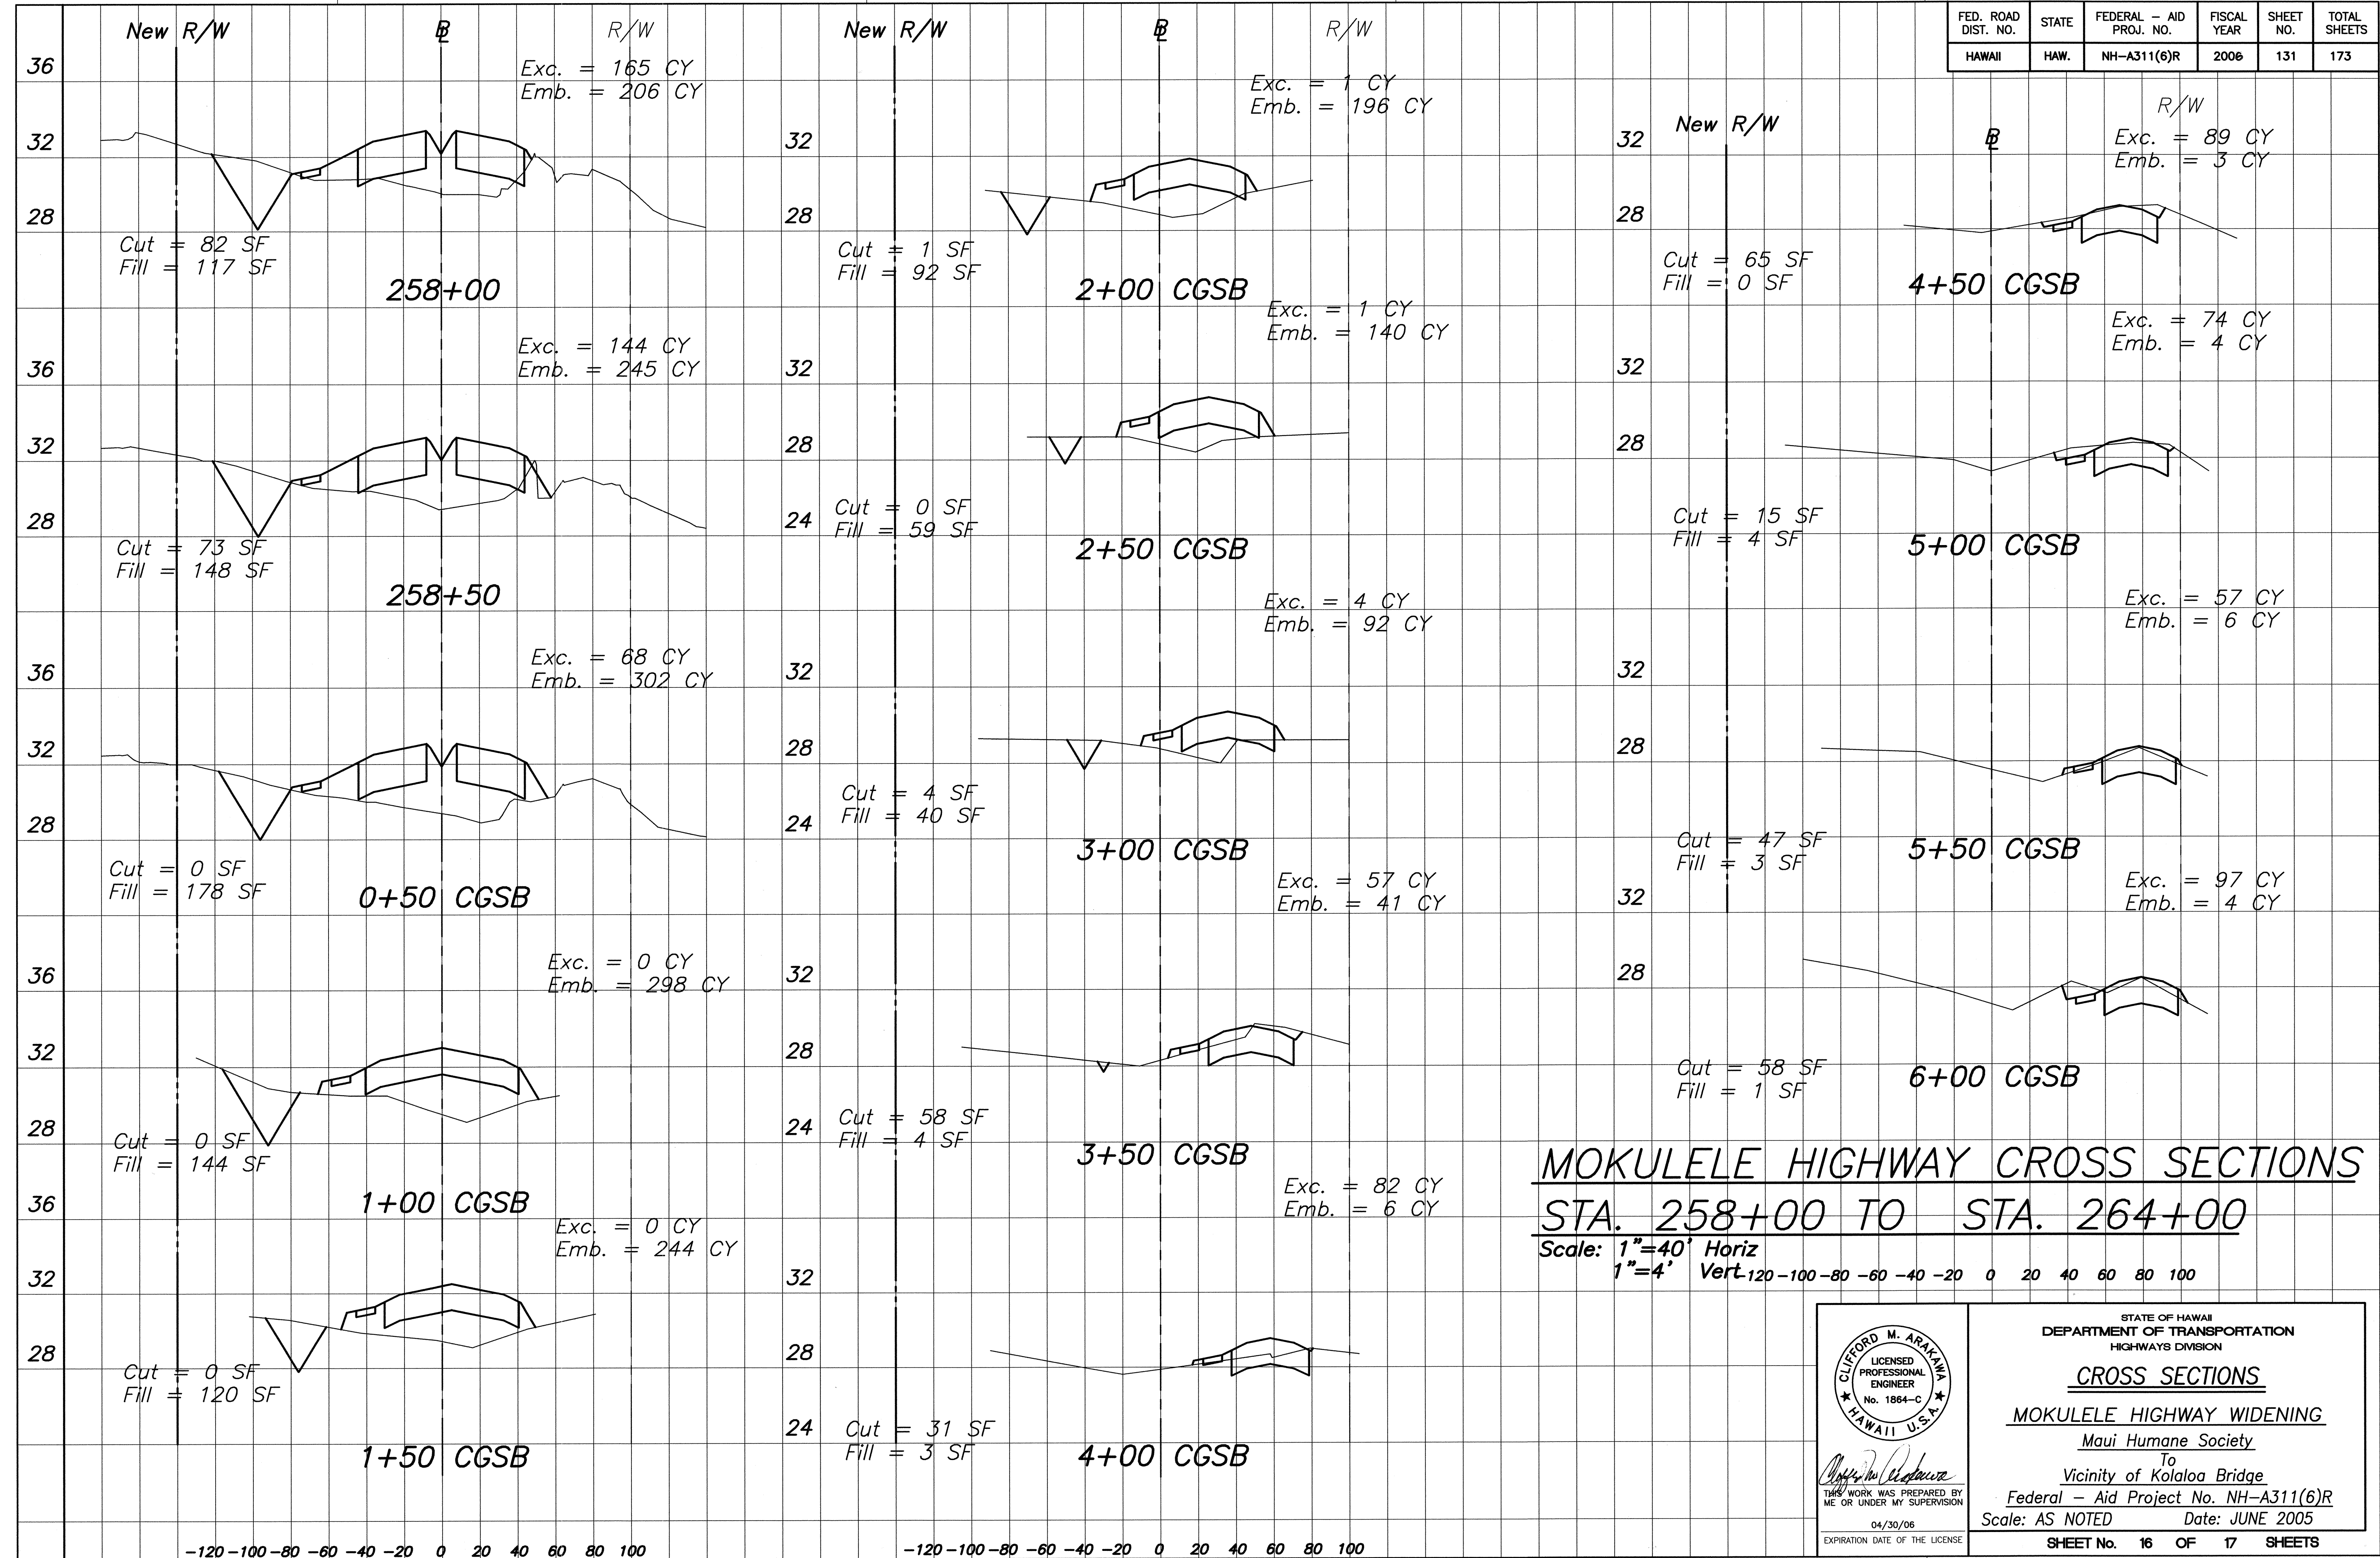

SURVEY PLOTTED BY: _____ DATE: _____
DRAWN BY: _____
CHECKED BY: _____
NOTE BOOK: _____
No. _____

CLIFFORD M. ARAKAWA
LICENSED PROFESSIONAL ENGINEER
No. 1864-C
HAWAII U.S.A.

STATE OF HAWAII
DEPARTMENT OF TRANSPORTATION
HIGHWAYS DIVISION

CROSS SECTIONS

MOKULELE HIGHWAY WIDENING

Maui Humane Society
To
Vicinity of Kolaloa Bridge
Federal - Aid Project No. NH-A311(6)R
Scale: AS NOTED Date: JUNE 2005

04/30/06
EXPIRATION DATE OF THE LICENSE

SHEET No. 16 OF 17 SHEETS

ORIGINAL PLAN	SURVEY PLOTTED BY _____	DATE _____
	DRAWN BY _____	_____
	DESIGNED BY _____	_____
	CHECKED BY _____	_____
NOTE BOOK	No. _____	

