







FED. ROAD DIST. NO.	STATE	FEDERAL - AID PROJ. NO.	FISCAL YEAR	SHEET NO.	TOTAL SHEETS
HAWAII	HAW.	NH-A311(6)R	2006	78	173

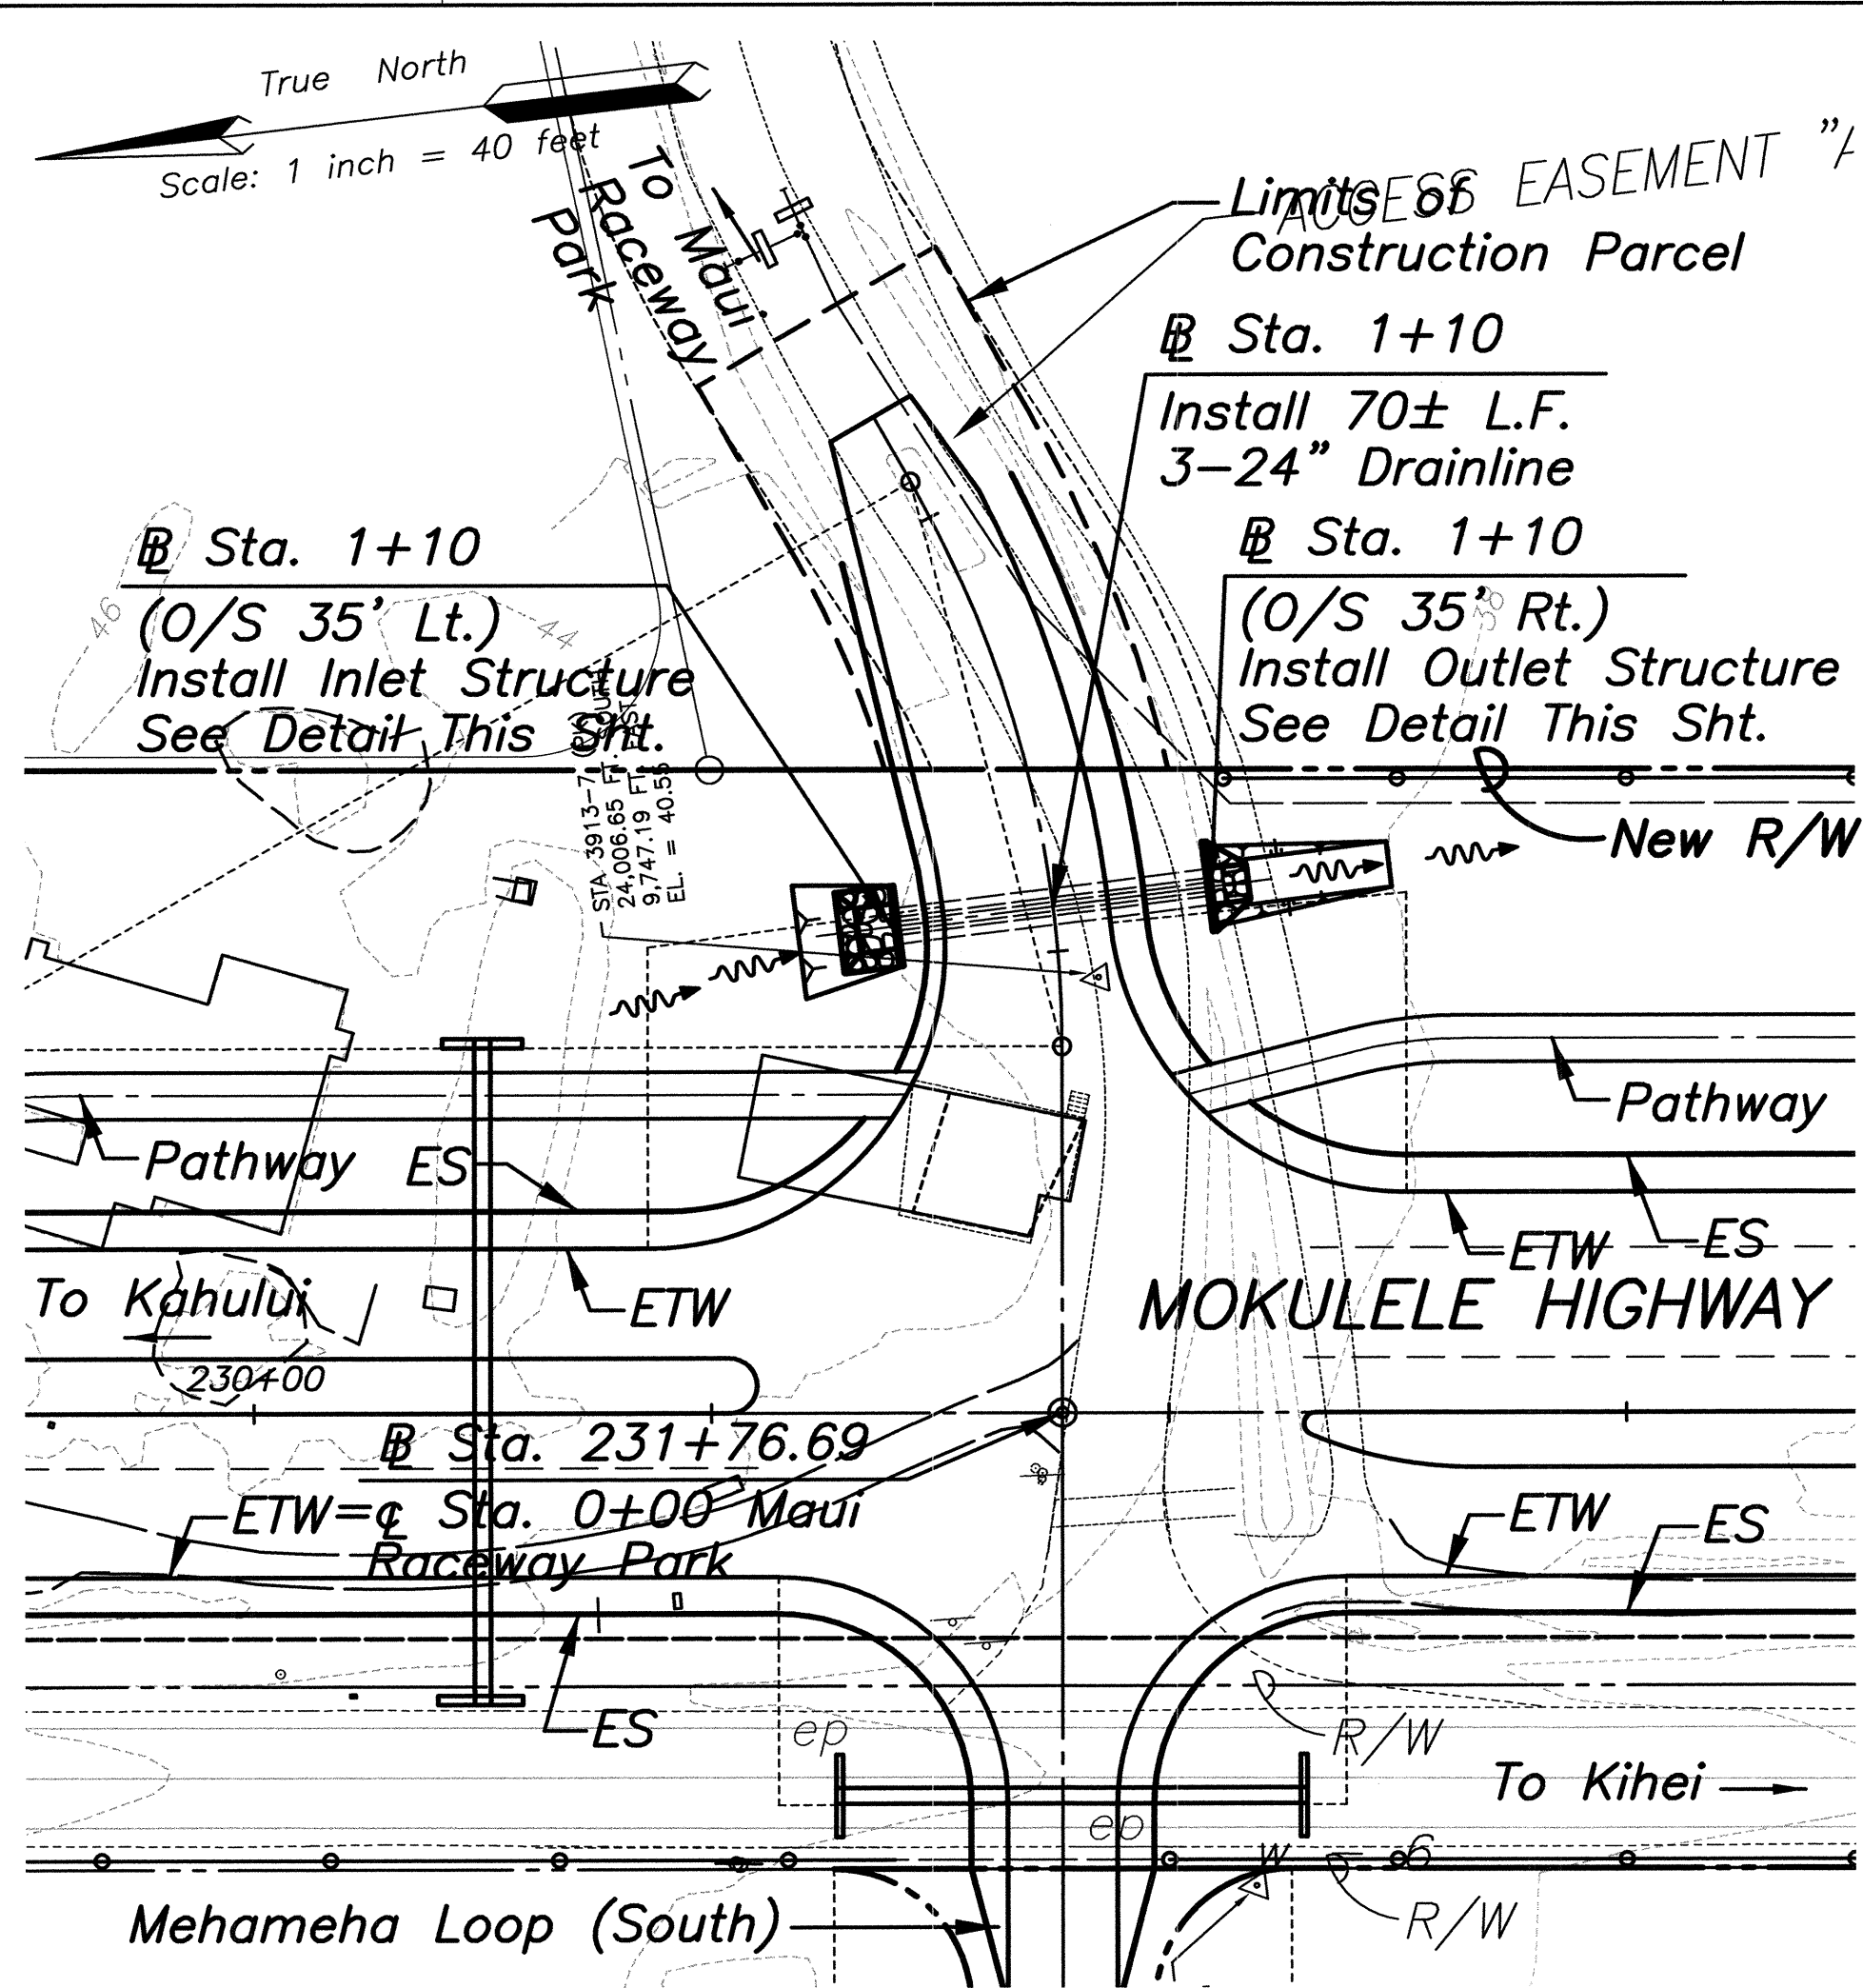

PLAN - CULVERTS AT STA. 1+10 MAUI RACEWAY PARK
Scale: 1"=40'

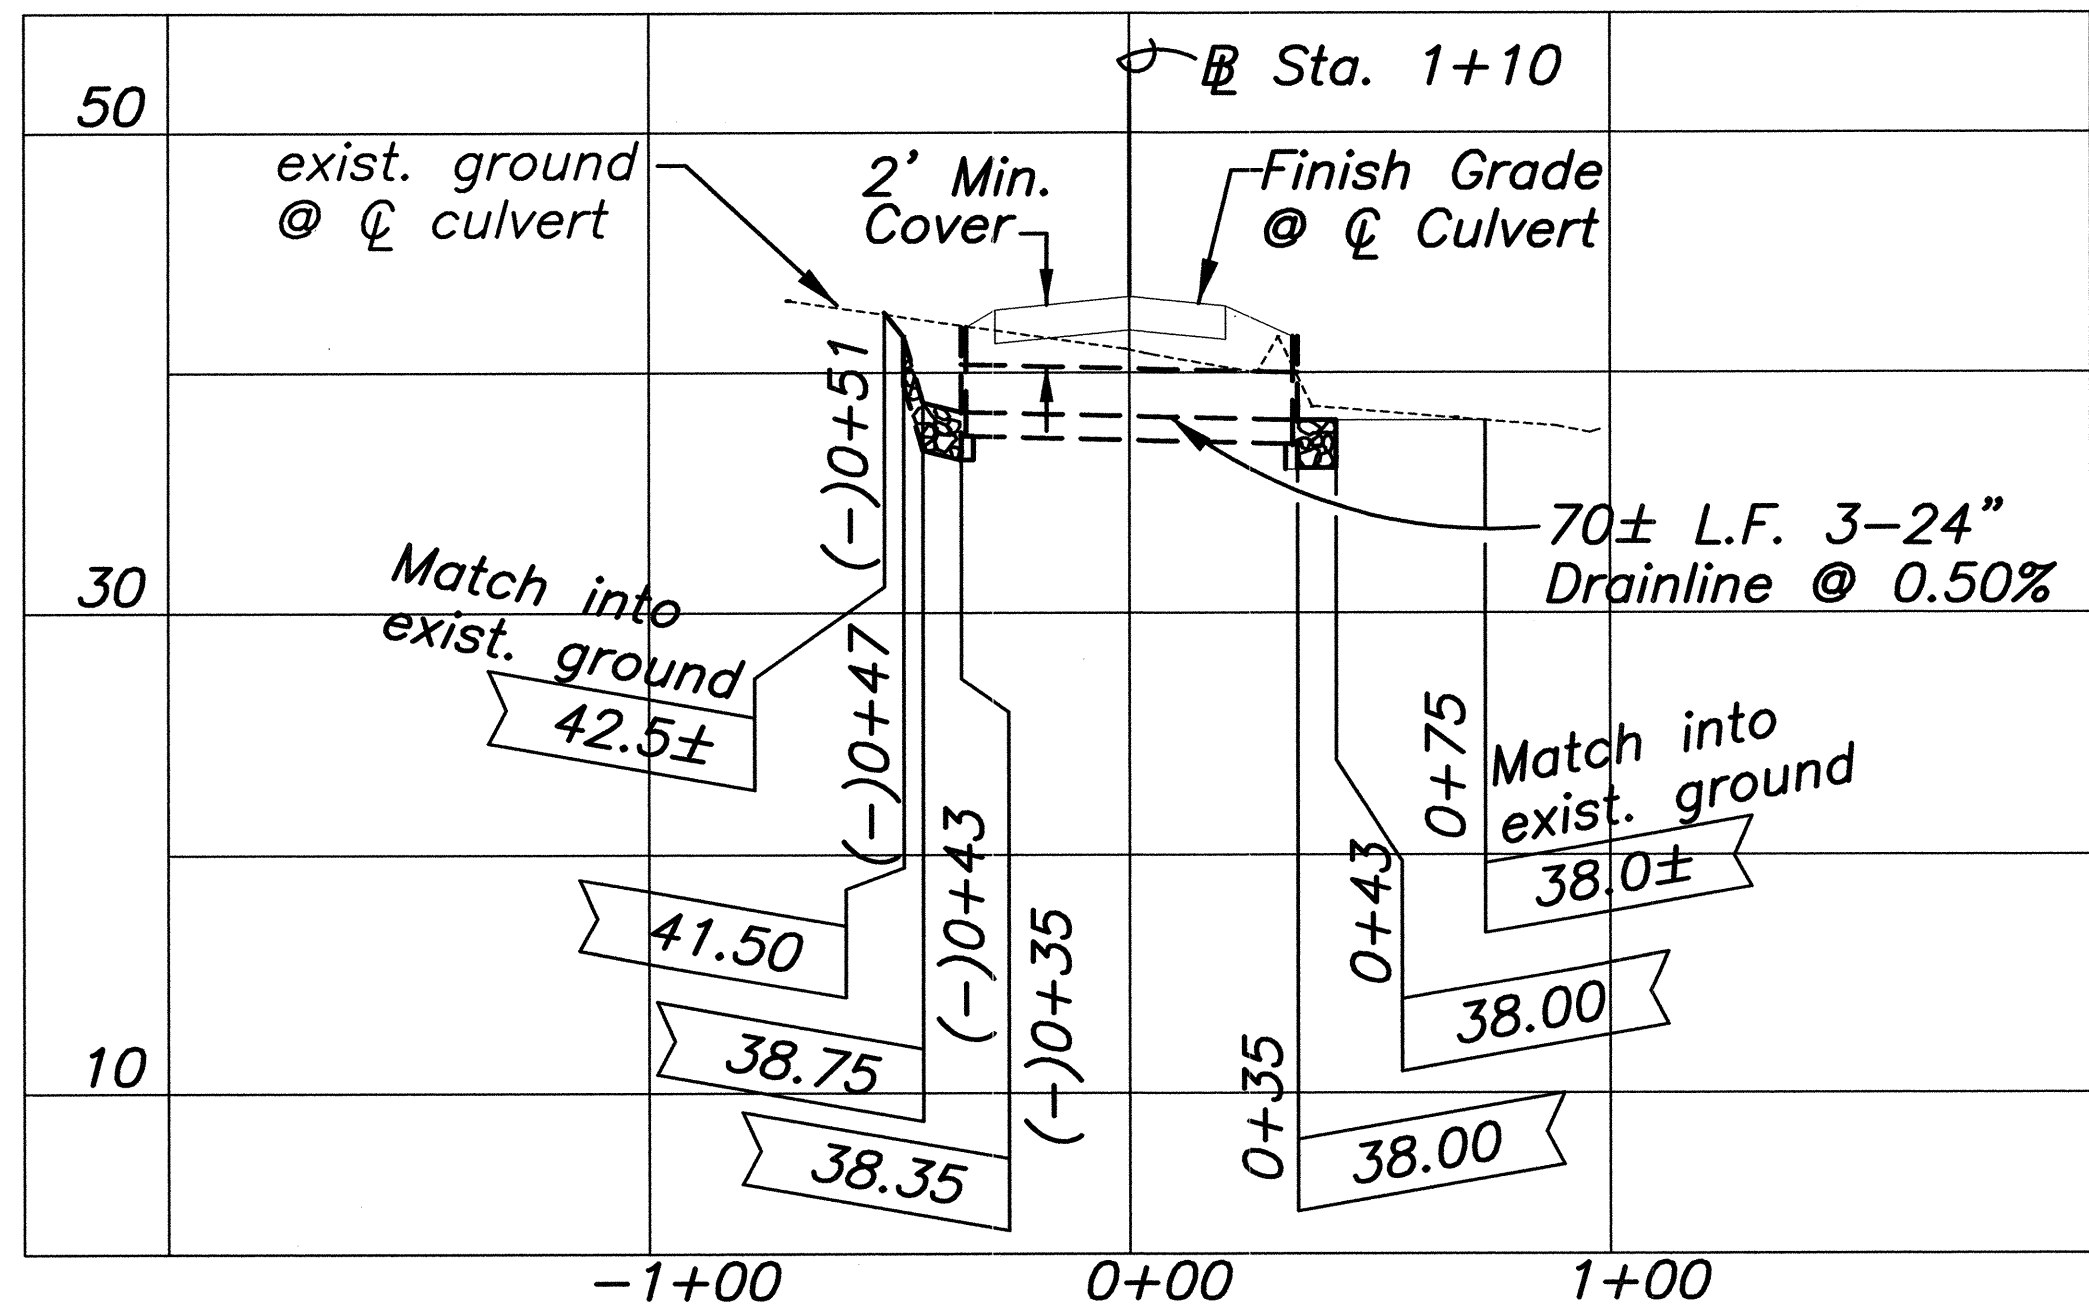

PROFILE - CULVERTS AT STA. 1+10 MAUI RACEWAY PARK
Scale: Horiz. 1"=40'
Vert. 1"=8'

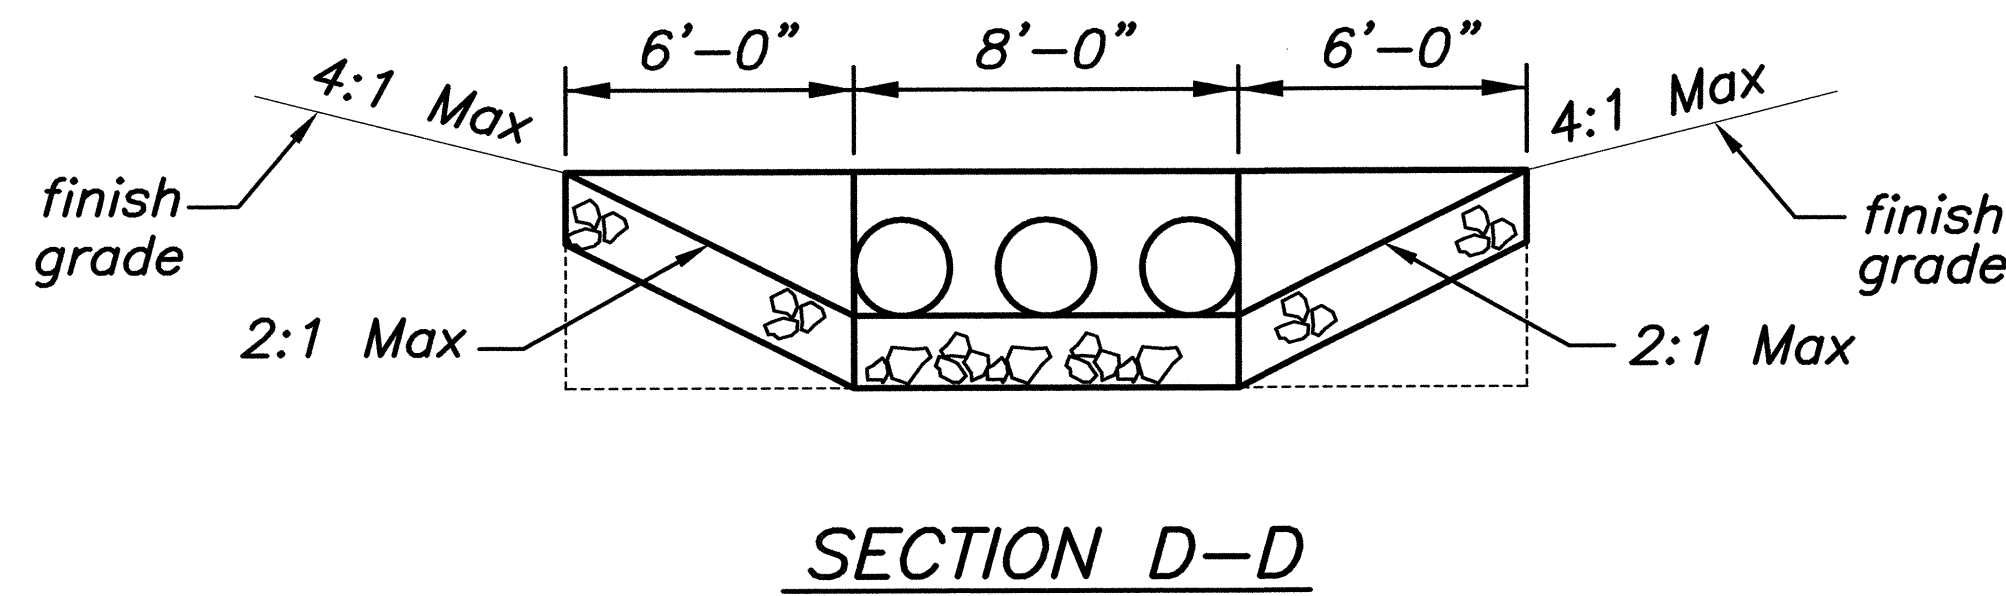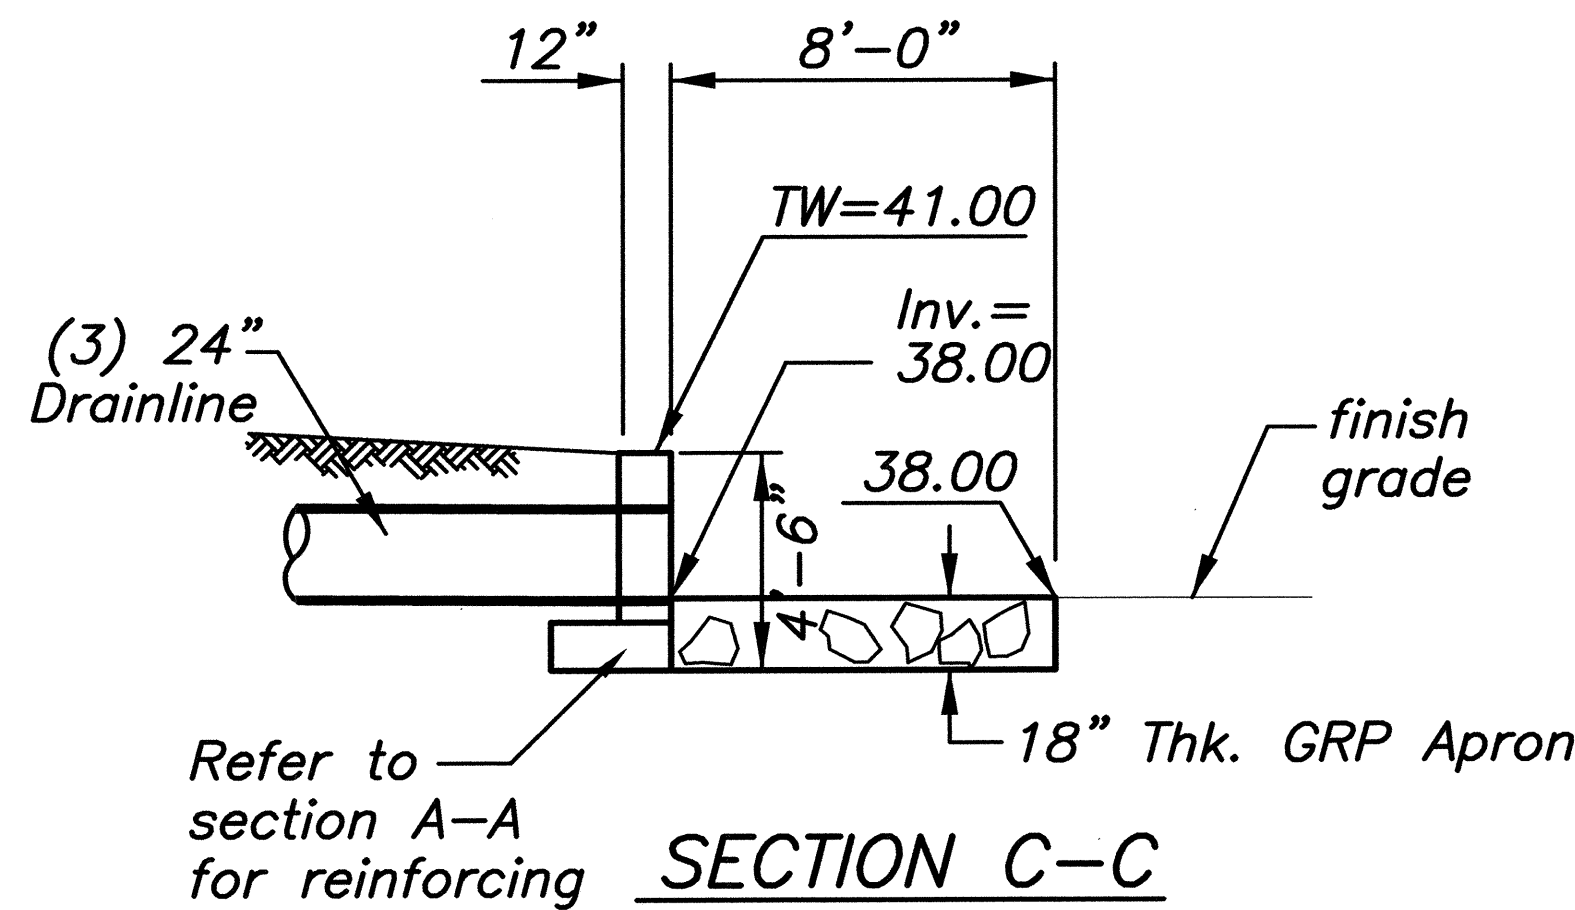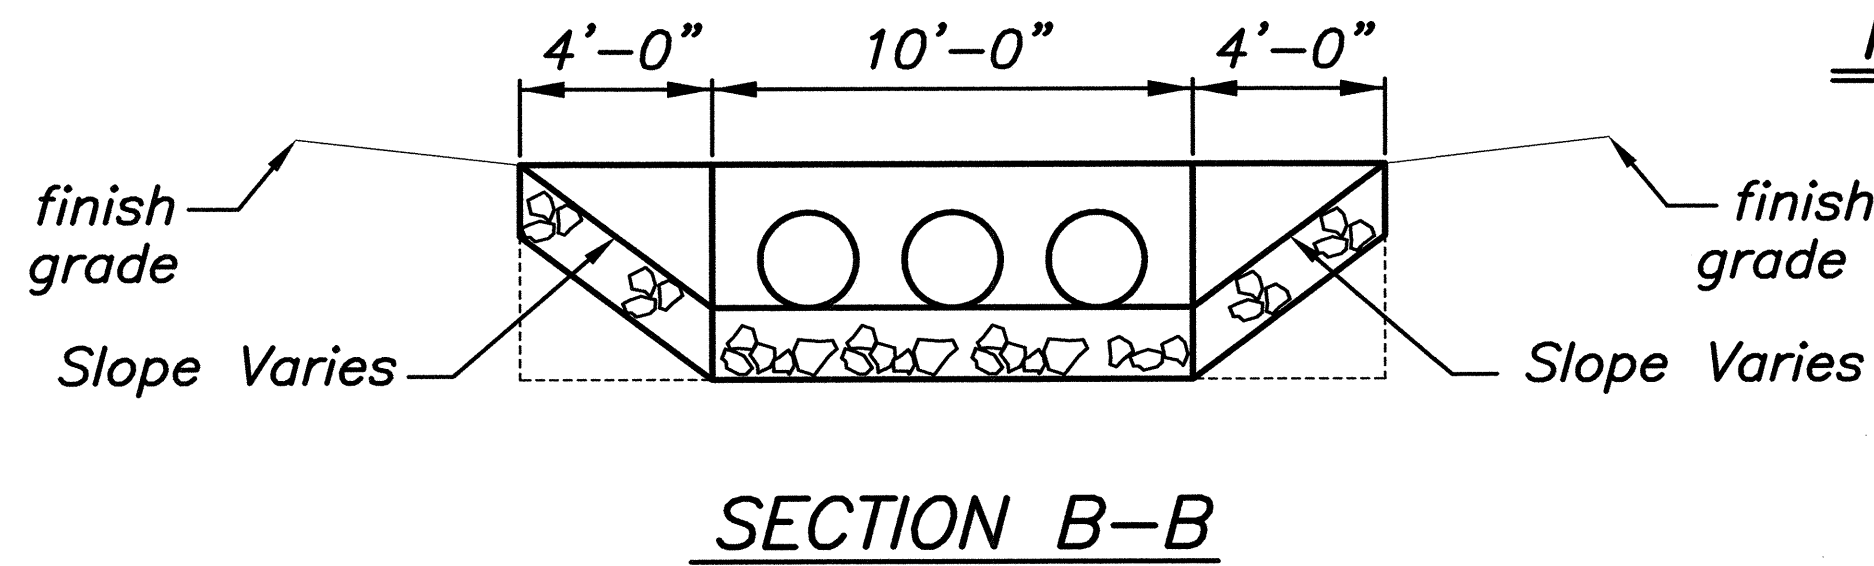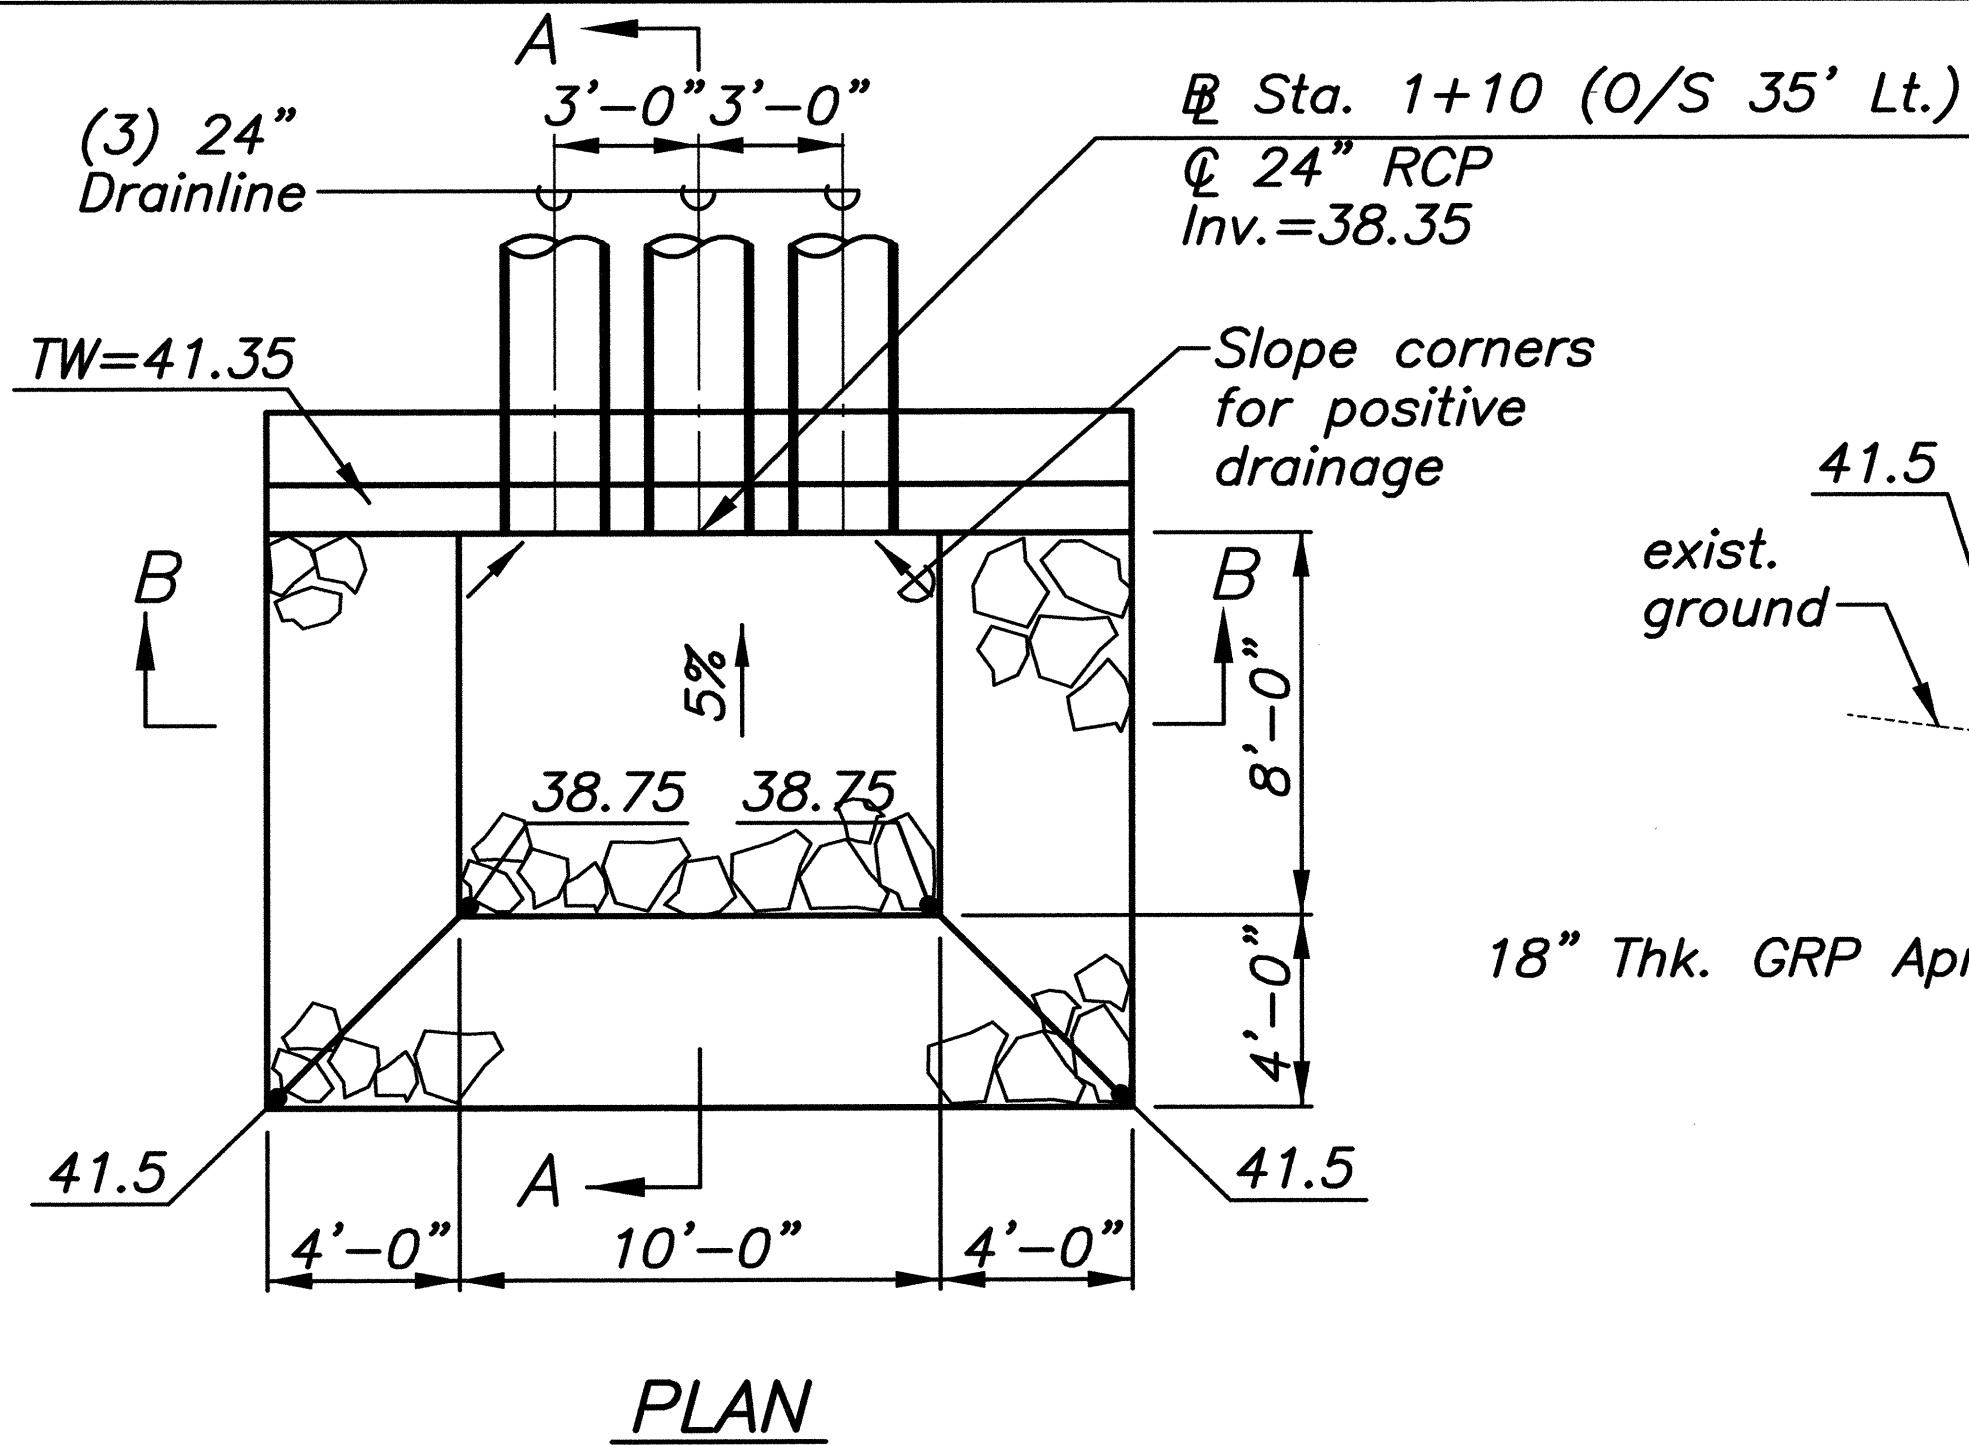

INLET STRUCTURE DETAILS
SCALE: 1/4"=1'-0"

OUTLET STRUCTURE DETAILS
SCALE: 1/4"=1'-0"

CLIFFORD M. ARAKAWA
LICENSED PROFESSIONAL ENGINEER
No. 1864-C
HAWAII, U.S.A.

STATE OF HAWAII
DEPARTMENT OF TRANSPORTATION
HIGHWAYS DIVISION

DRAINAGE CULVERT

MOKULELE HIGHWAY WIDENING
Maui Humane Society
To
Vicinity of Kolaloa Bridge
Federal - Aid Project No. NH-A311(6)R
Scale: AS NOTED Date: JUNE 2005

SHEET No. 1 OF 2 SHEETS

